

**MONROE  
TOWNSHIP**

**1951**

## INDEX

VIRGINIA  
MILITARY  
SURVEYS

	PAGE
5864	1
8303}	2
8485)	
6449	2
6762	2
4957	3
9793	4
10853	4
4493)	5
4525)	
12099	6
9592)	
9618	7
10075)	
3242	7
3138	8
4497	8
9878)	
10109	9
10718	
10719)	
3222	10
3221	11

VIRGINIA  
MILITARY  
SURVEYS

	PAGE
3159	12
4676	12
7318	12
6516	13
4479	14
2220	15
6487	15
10091	15
3224	16
3223	17
4570 — N. PART	18
4570 — S. PART	19
4492 — W. PART	20
4492 — E. PART	21
3225	22
3226	23
3227	24
3228	25
9676	25
3229	26
3230	27
5042	28
5044	28

SECTION      TOWN      RANGE      PAGE


19	4	14	29
24	5	13	29
17	5	13	30
23	5	13	30
16	5	13	31
22	5	13	31
21	5	13	32
15	5	13	33

PICKRELL TOWN      34

MONROE TOWNSHIP  
INDEX MAP

PAGE 0

CORRECTED TO  
Jan. - 6 - 1955  
Jan. 1 - 1956  
Jan. 1 - 1957  
Jan. 1 - 1958

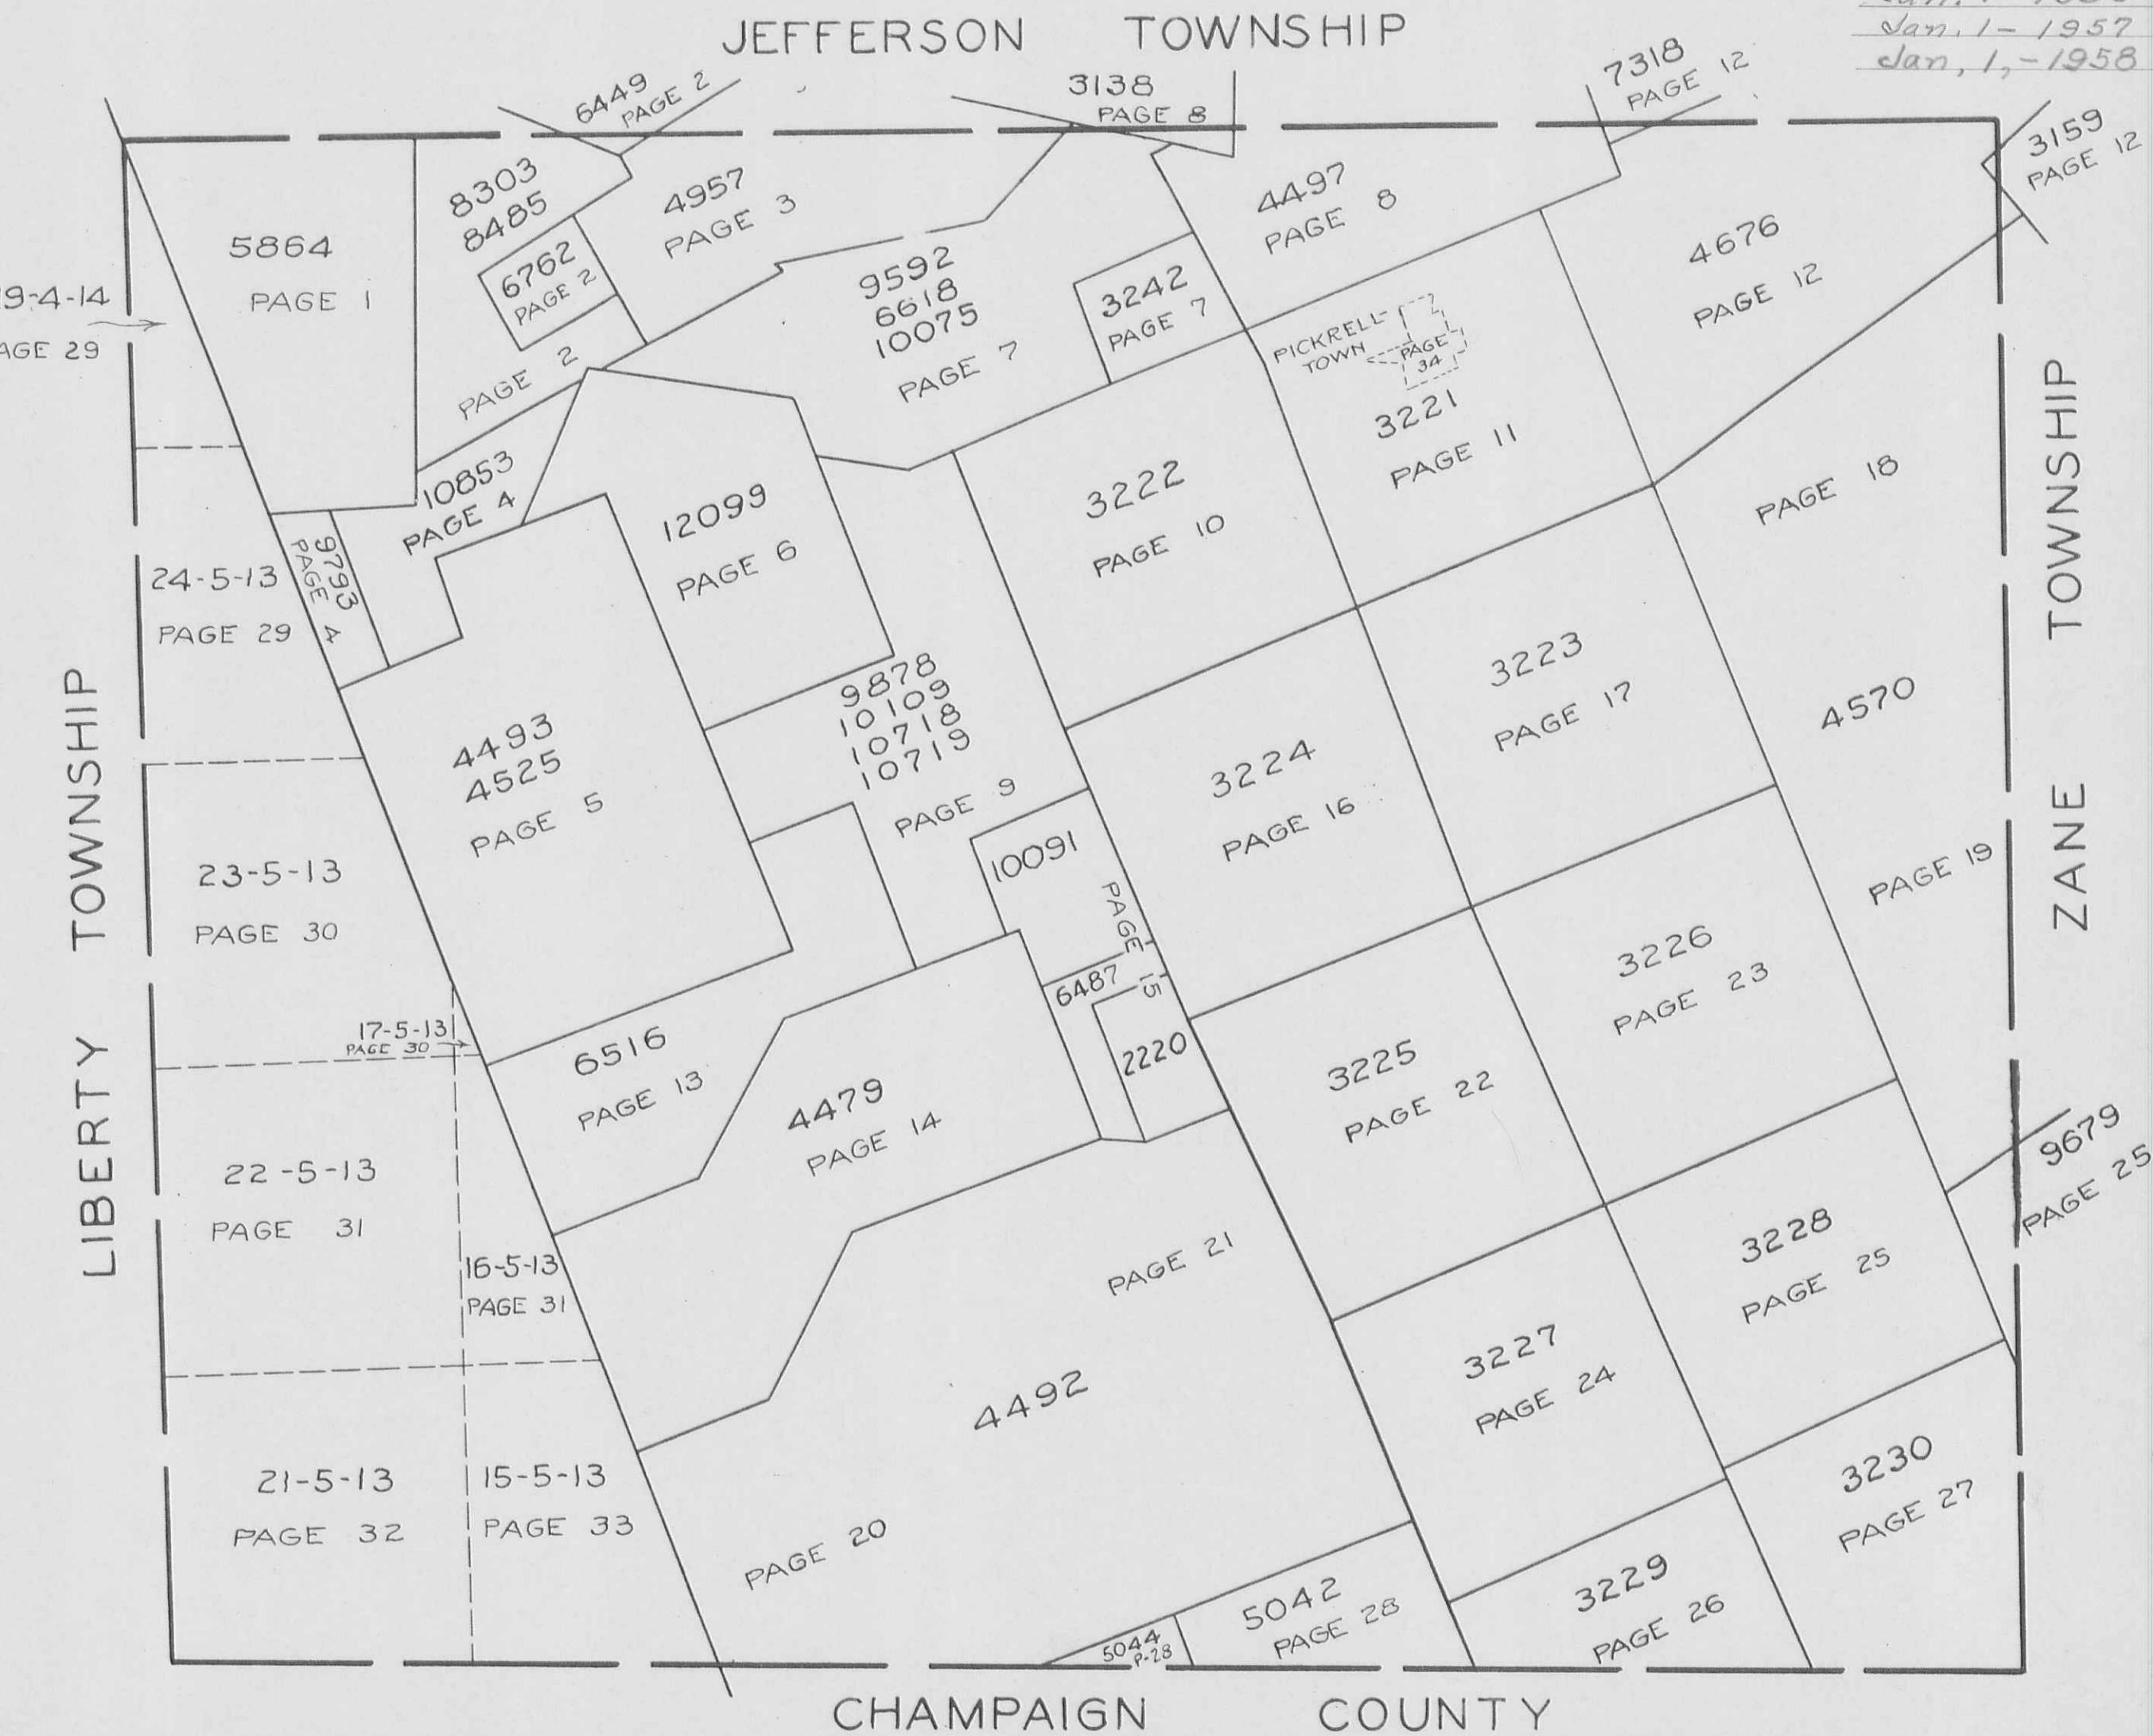

## VIRGINIA MILITARY SURVEY 5864

SCALE 10 CHAINS TO THE INCH




MONROE TOWNSHIP 8303  
VIRGINIA MILITARY SURVEYS 18485  
6449

SCALE 10 CHAINS TO THE INCH

PAGE

2

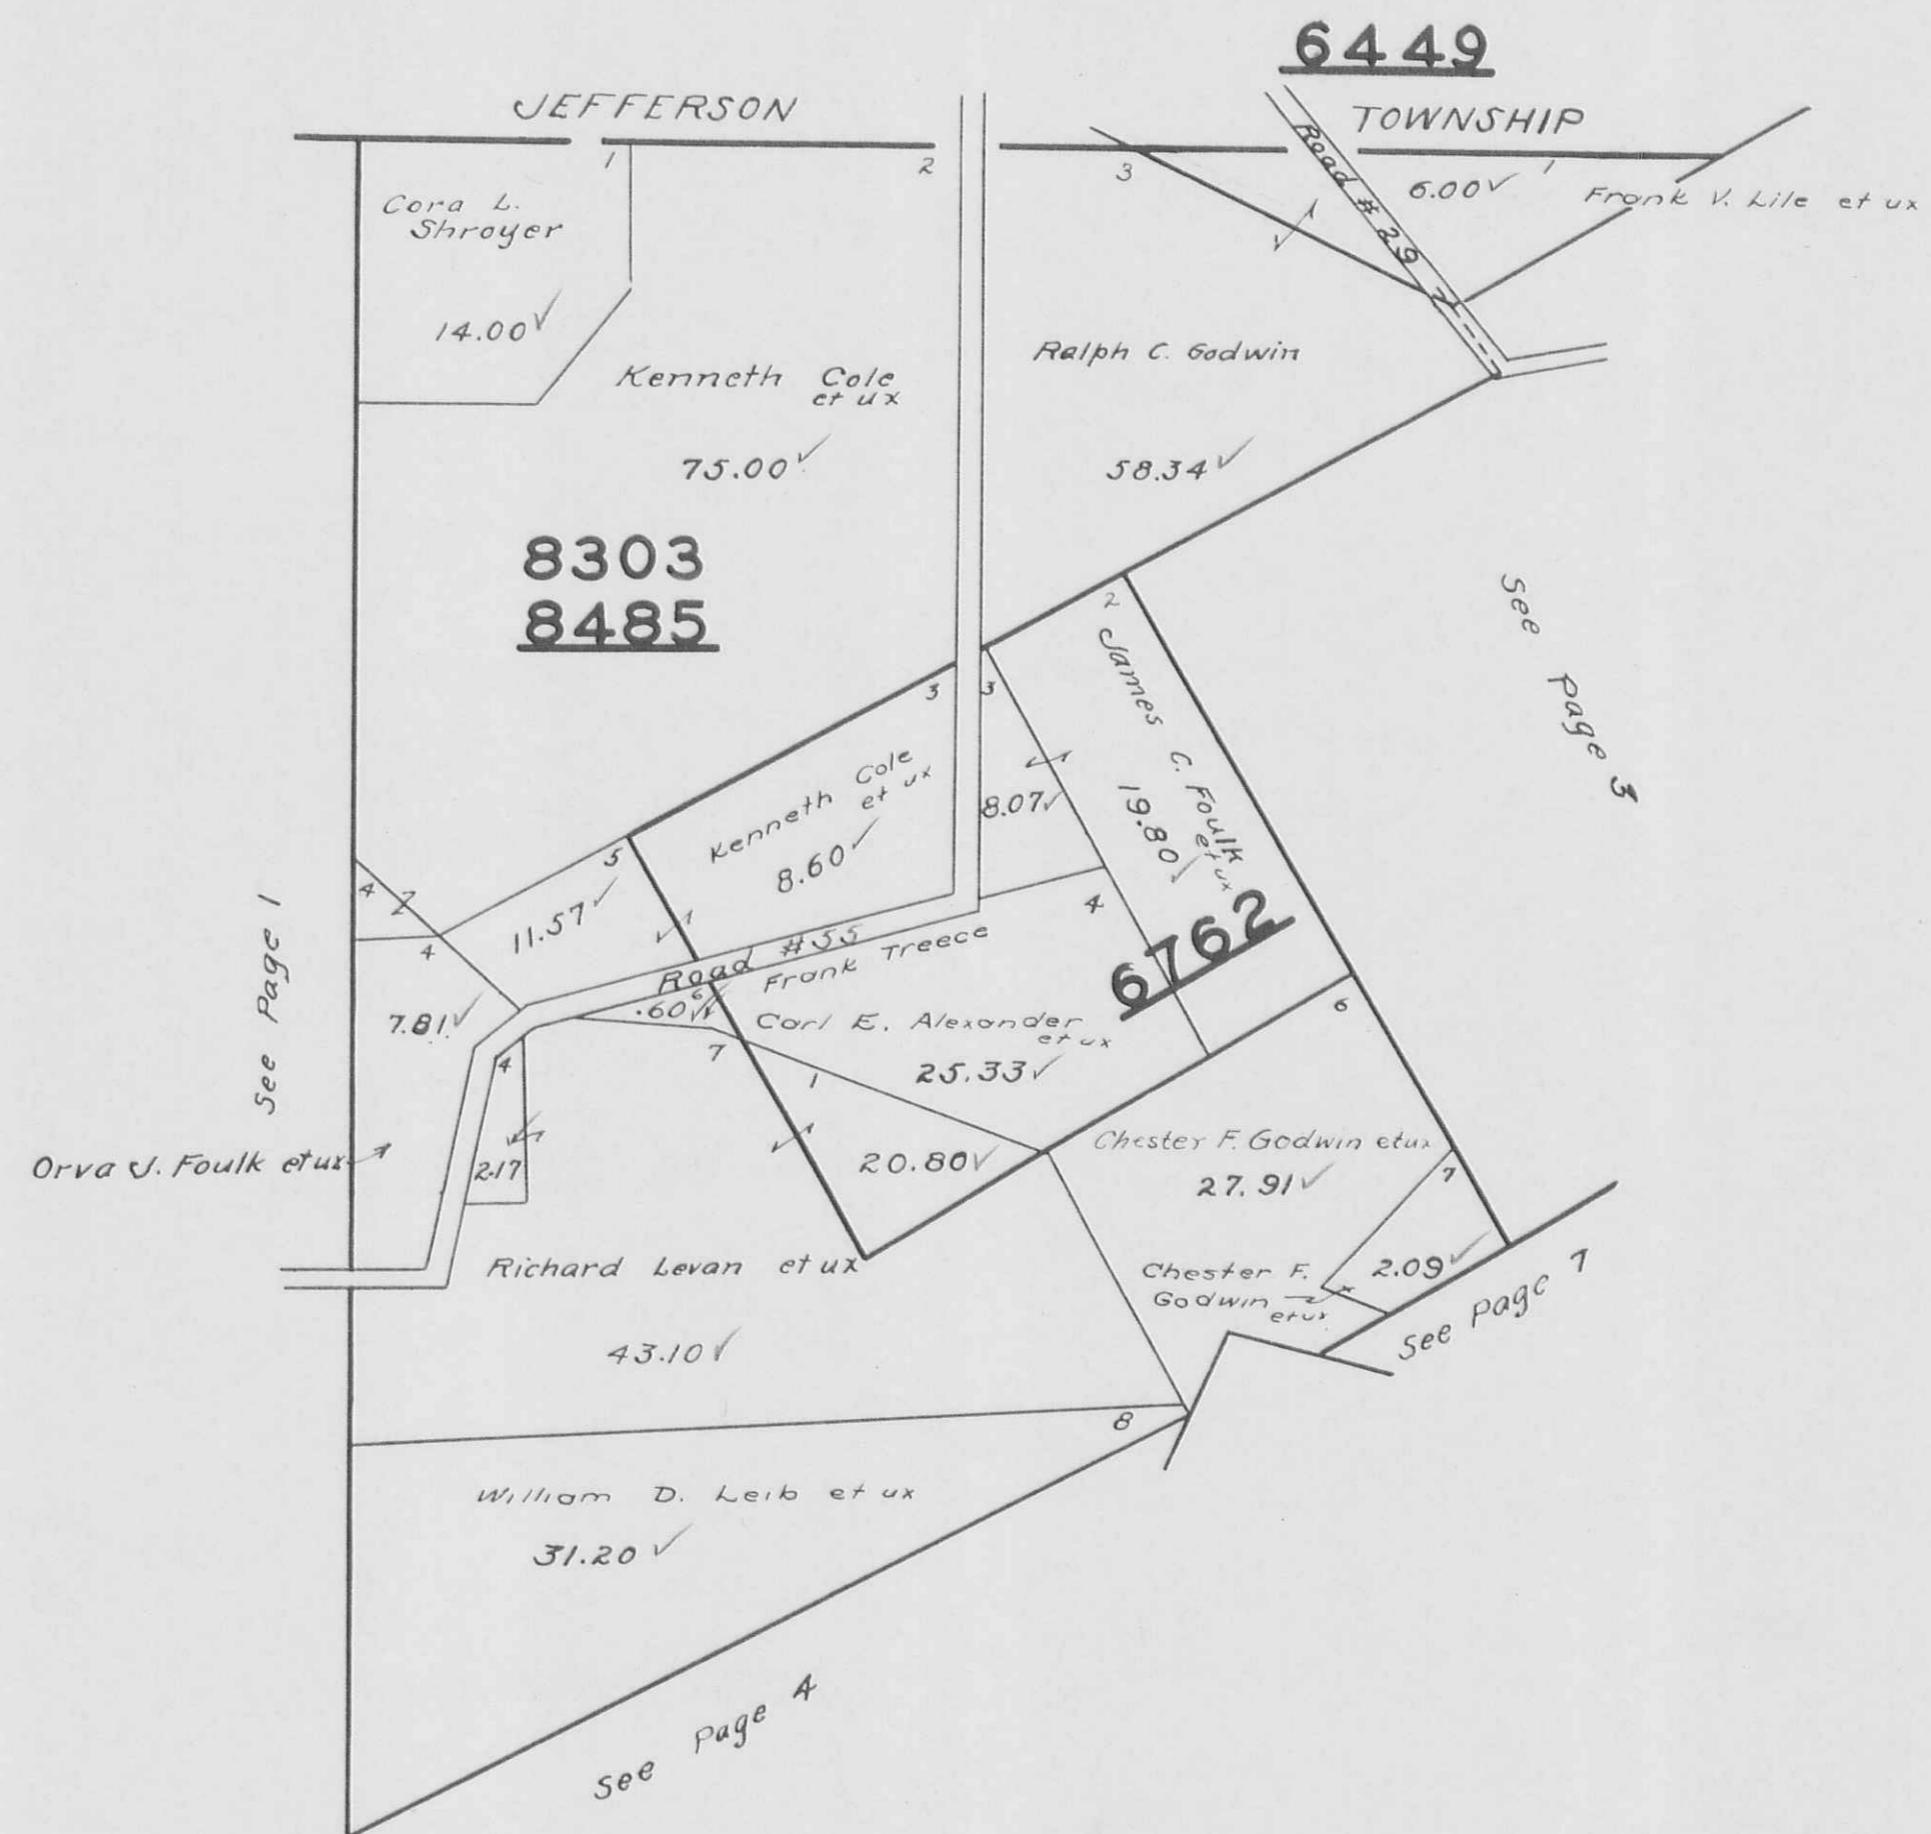

MONROE


TOWNSHIP

PAGE

3

## VIRGINIA MILITARY SURVEY 4957

SCALE 10 CHAINS TO THE INCH

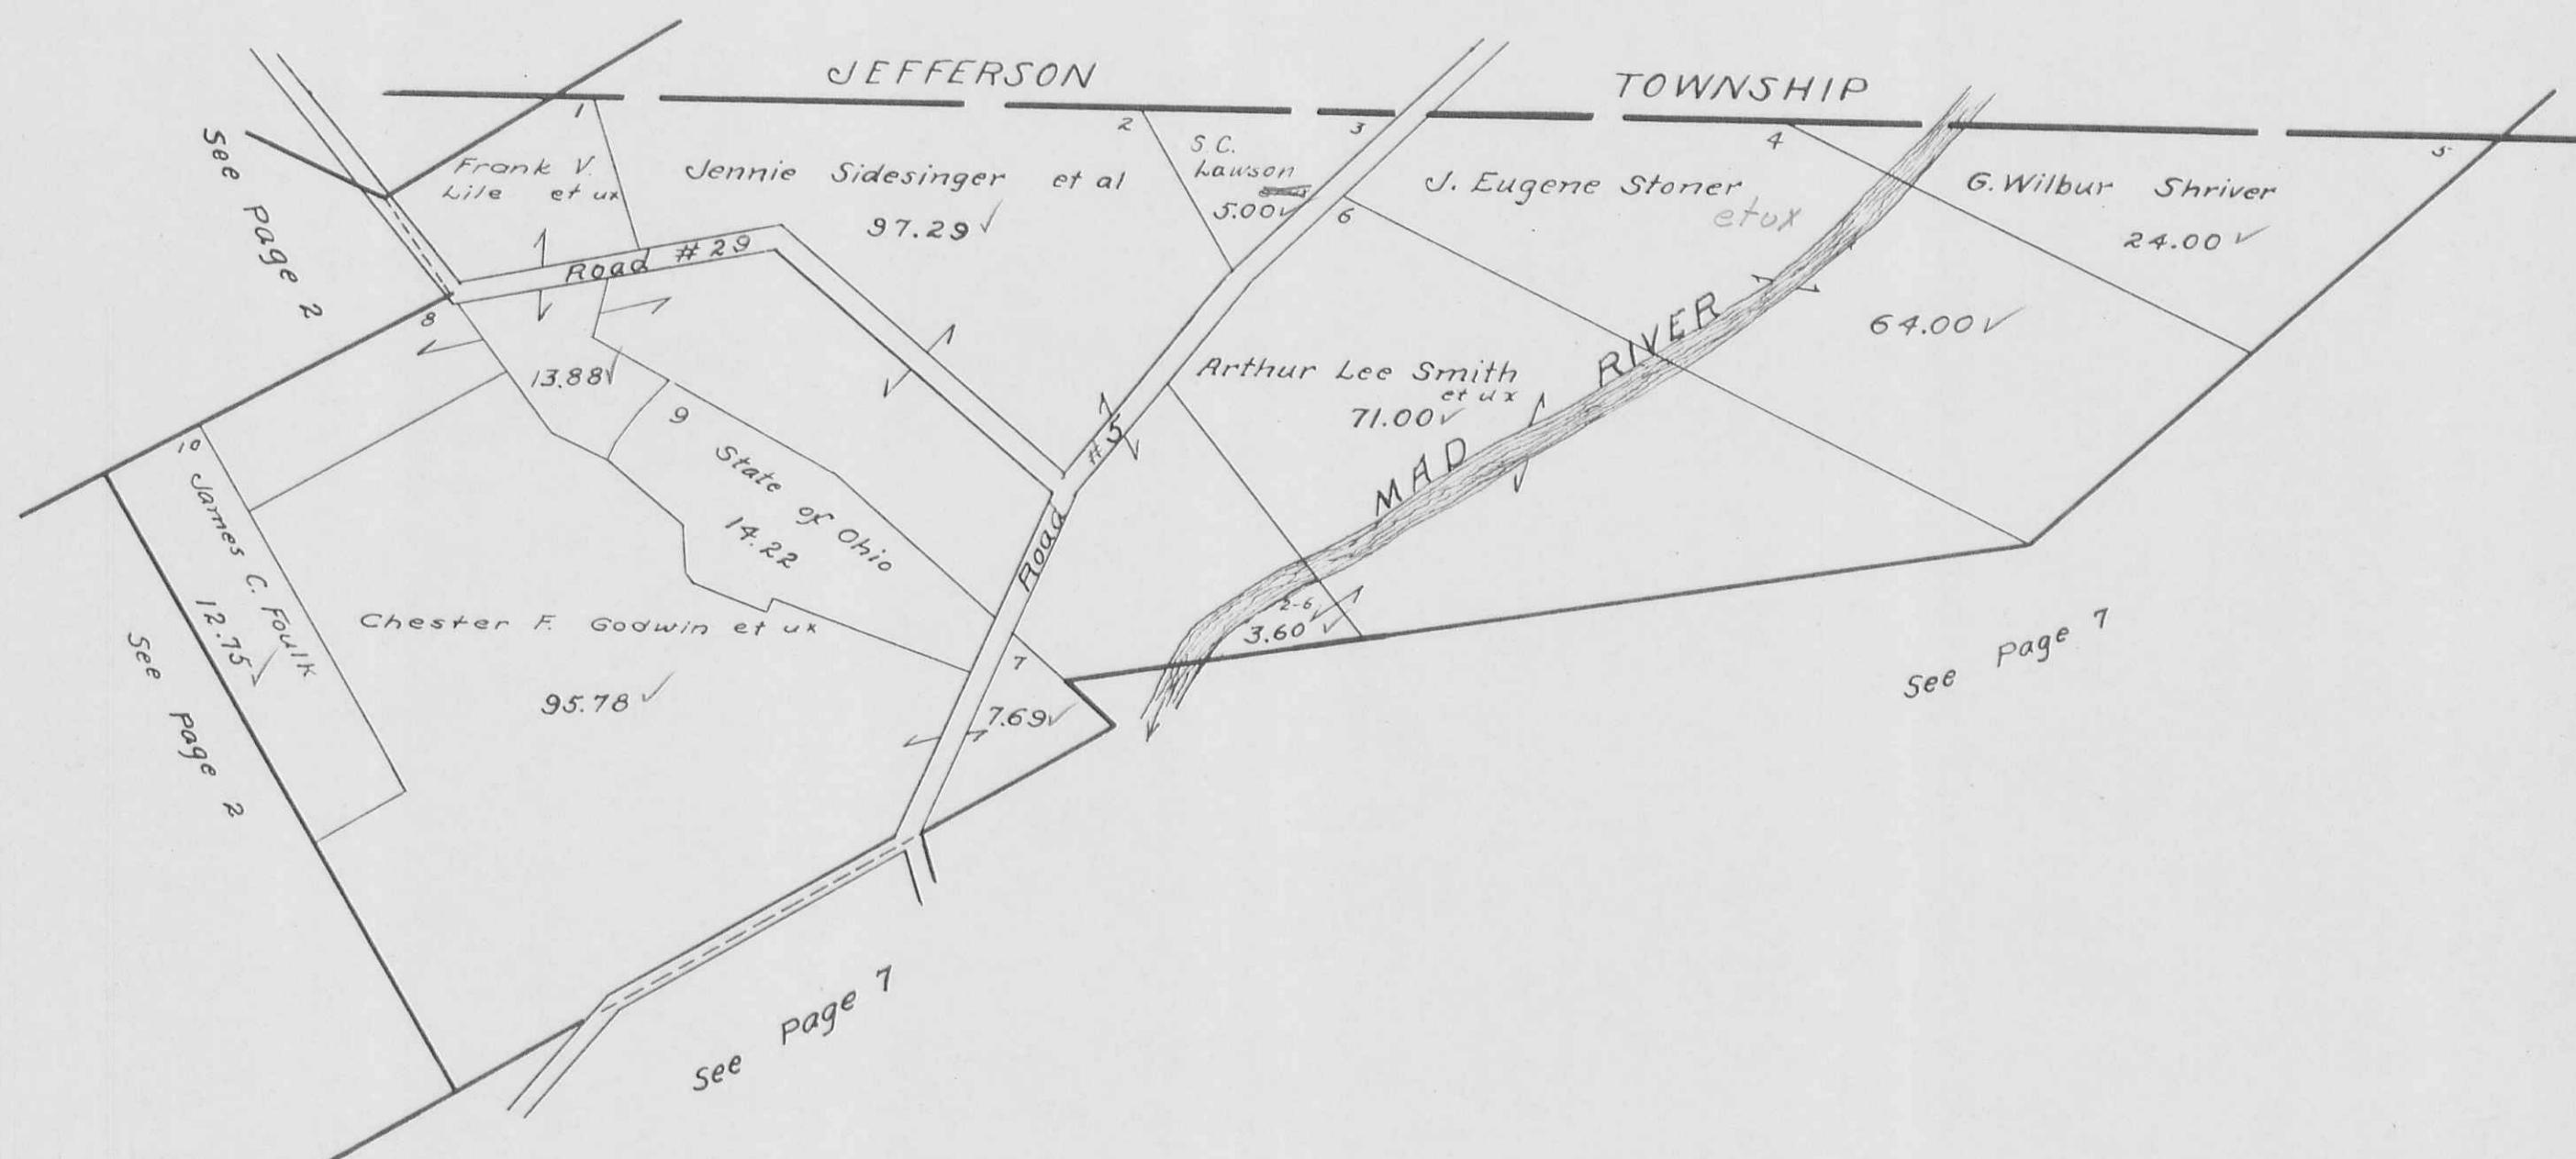


MONROE TOWNSHIP  
VIRGINIA MILITARY SURVEYS 9793  
10853

SCALE 10 CHAINS TO THE INCH


PAGE

4

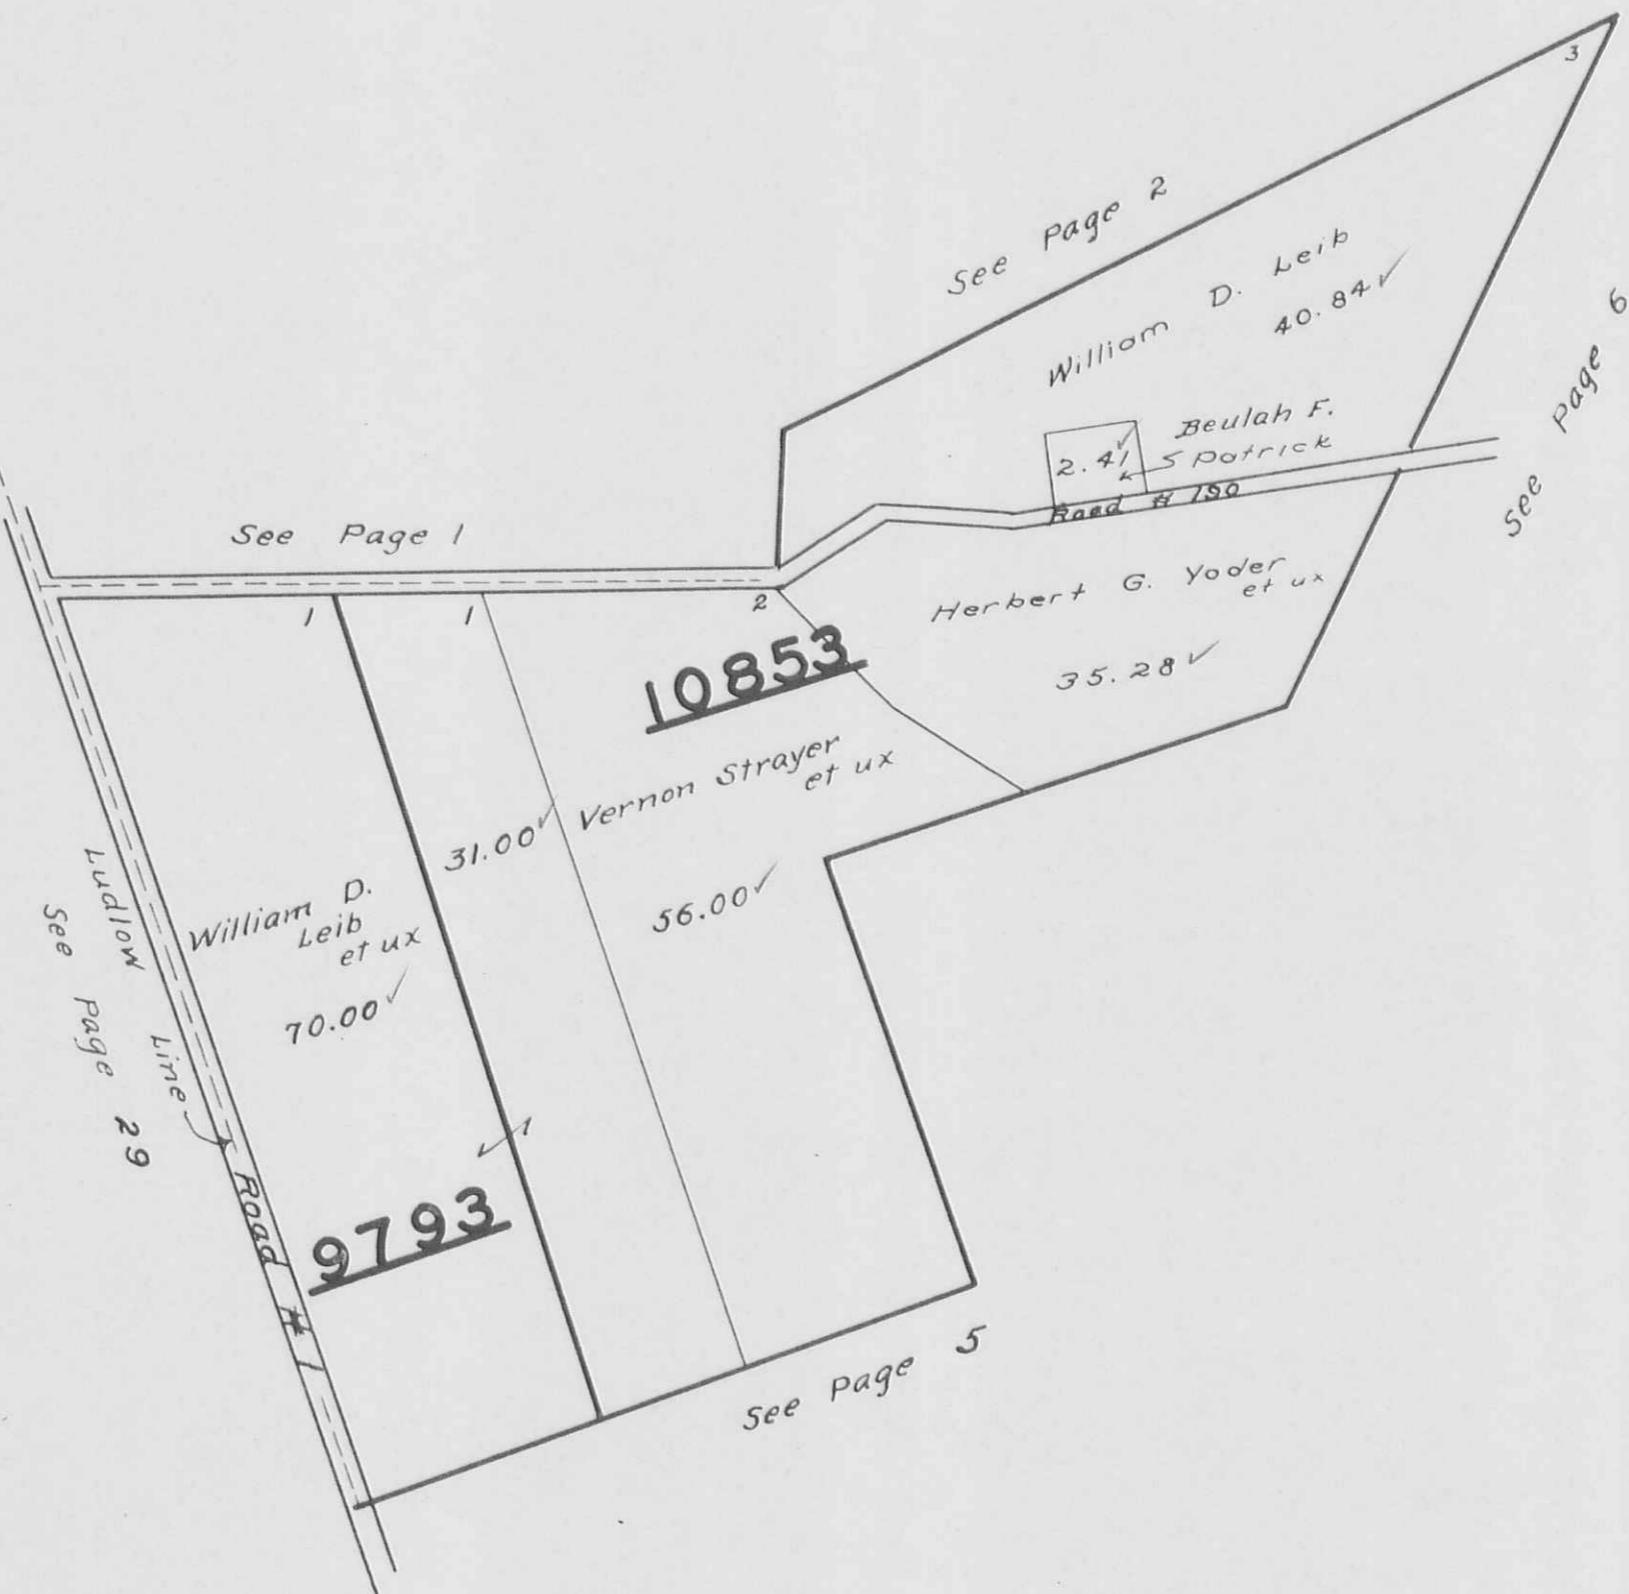

MONROE  
VIRGINIA      TOWNSHIP  
MILITARY SURVEYS {4493  
{4525


SCALE 10 CHAINS TO THE INCH

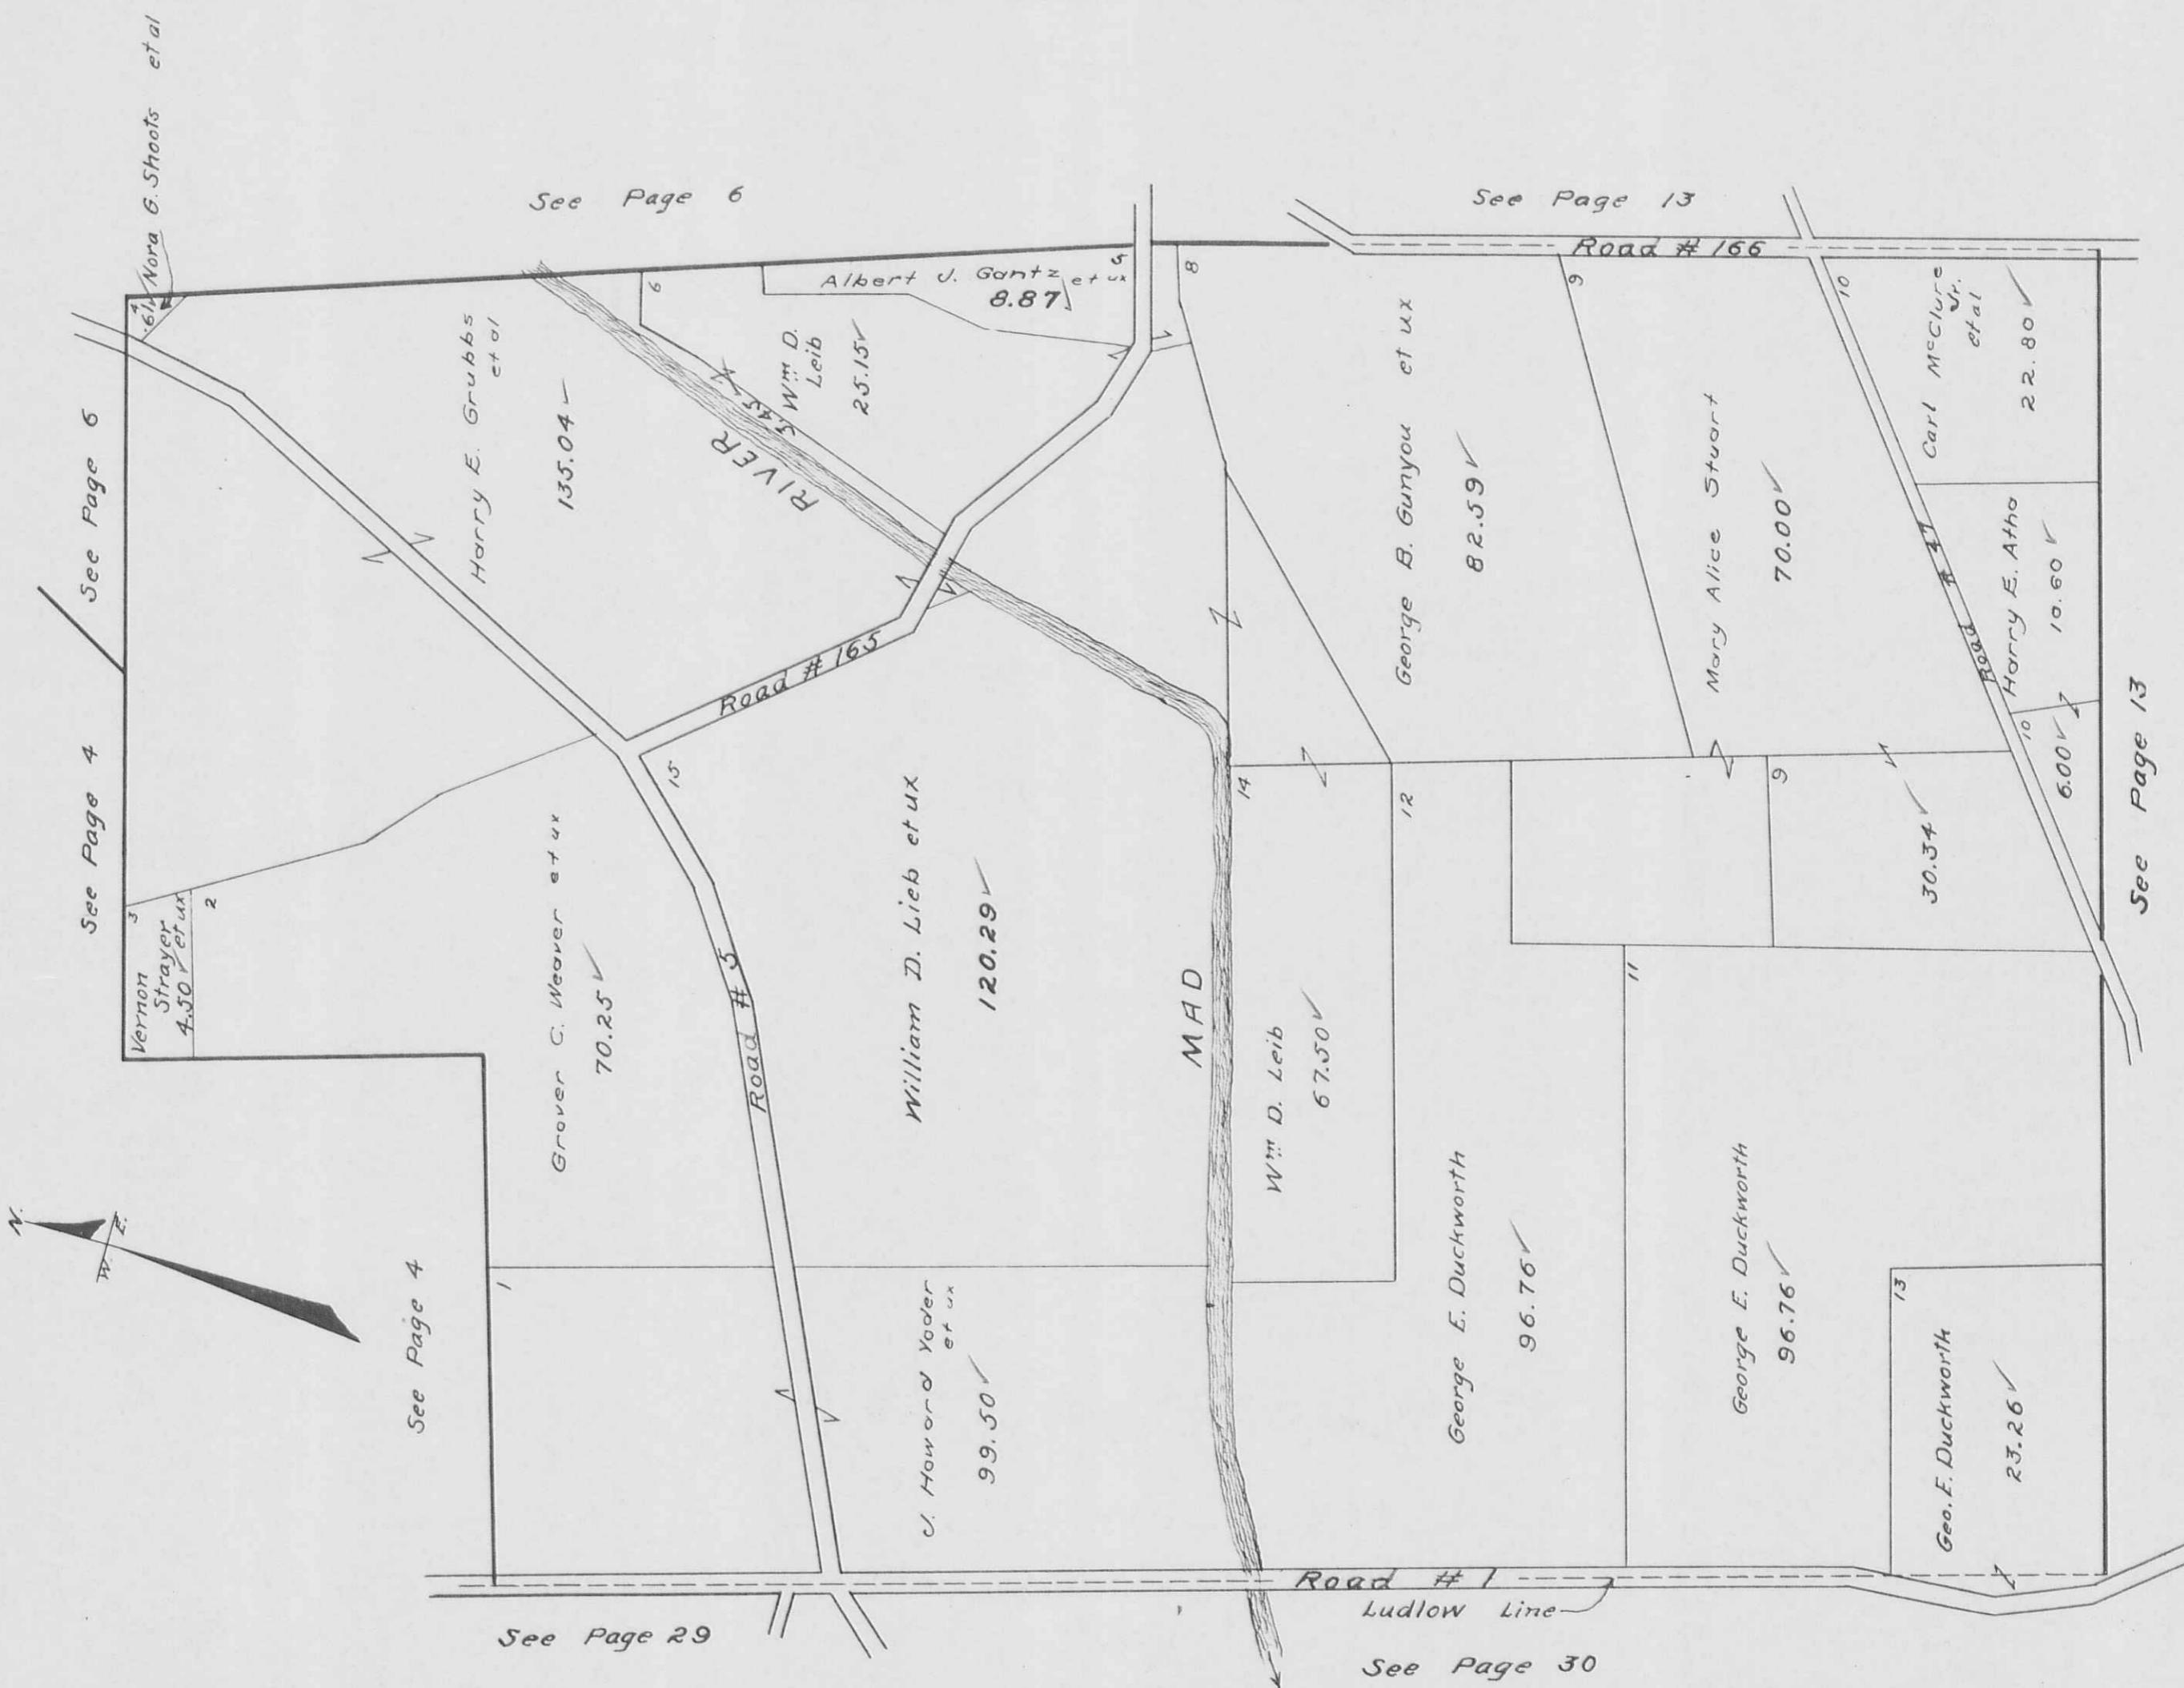

MONROE TOWNSHIP  
VIRGINIA MILITARY SURVEY 12099

SCALE 10 CHAINS TO THE INCH

PAGE 6

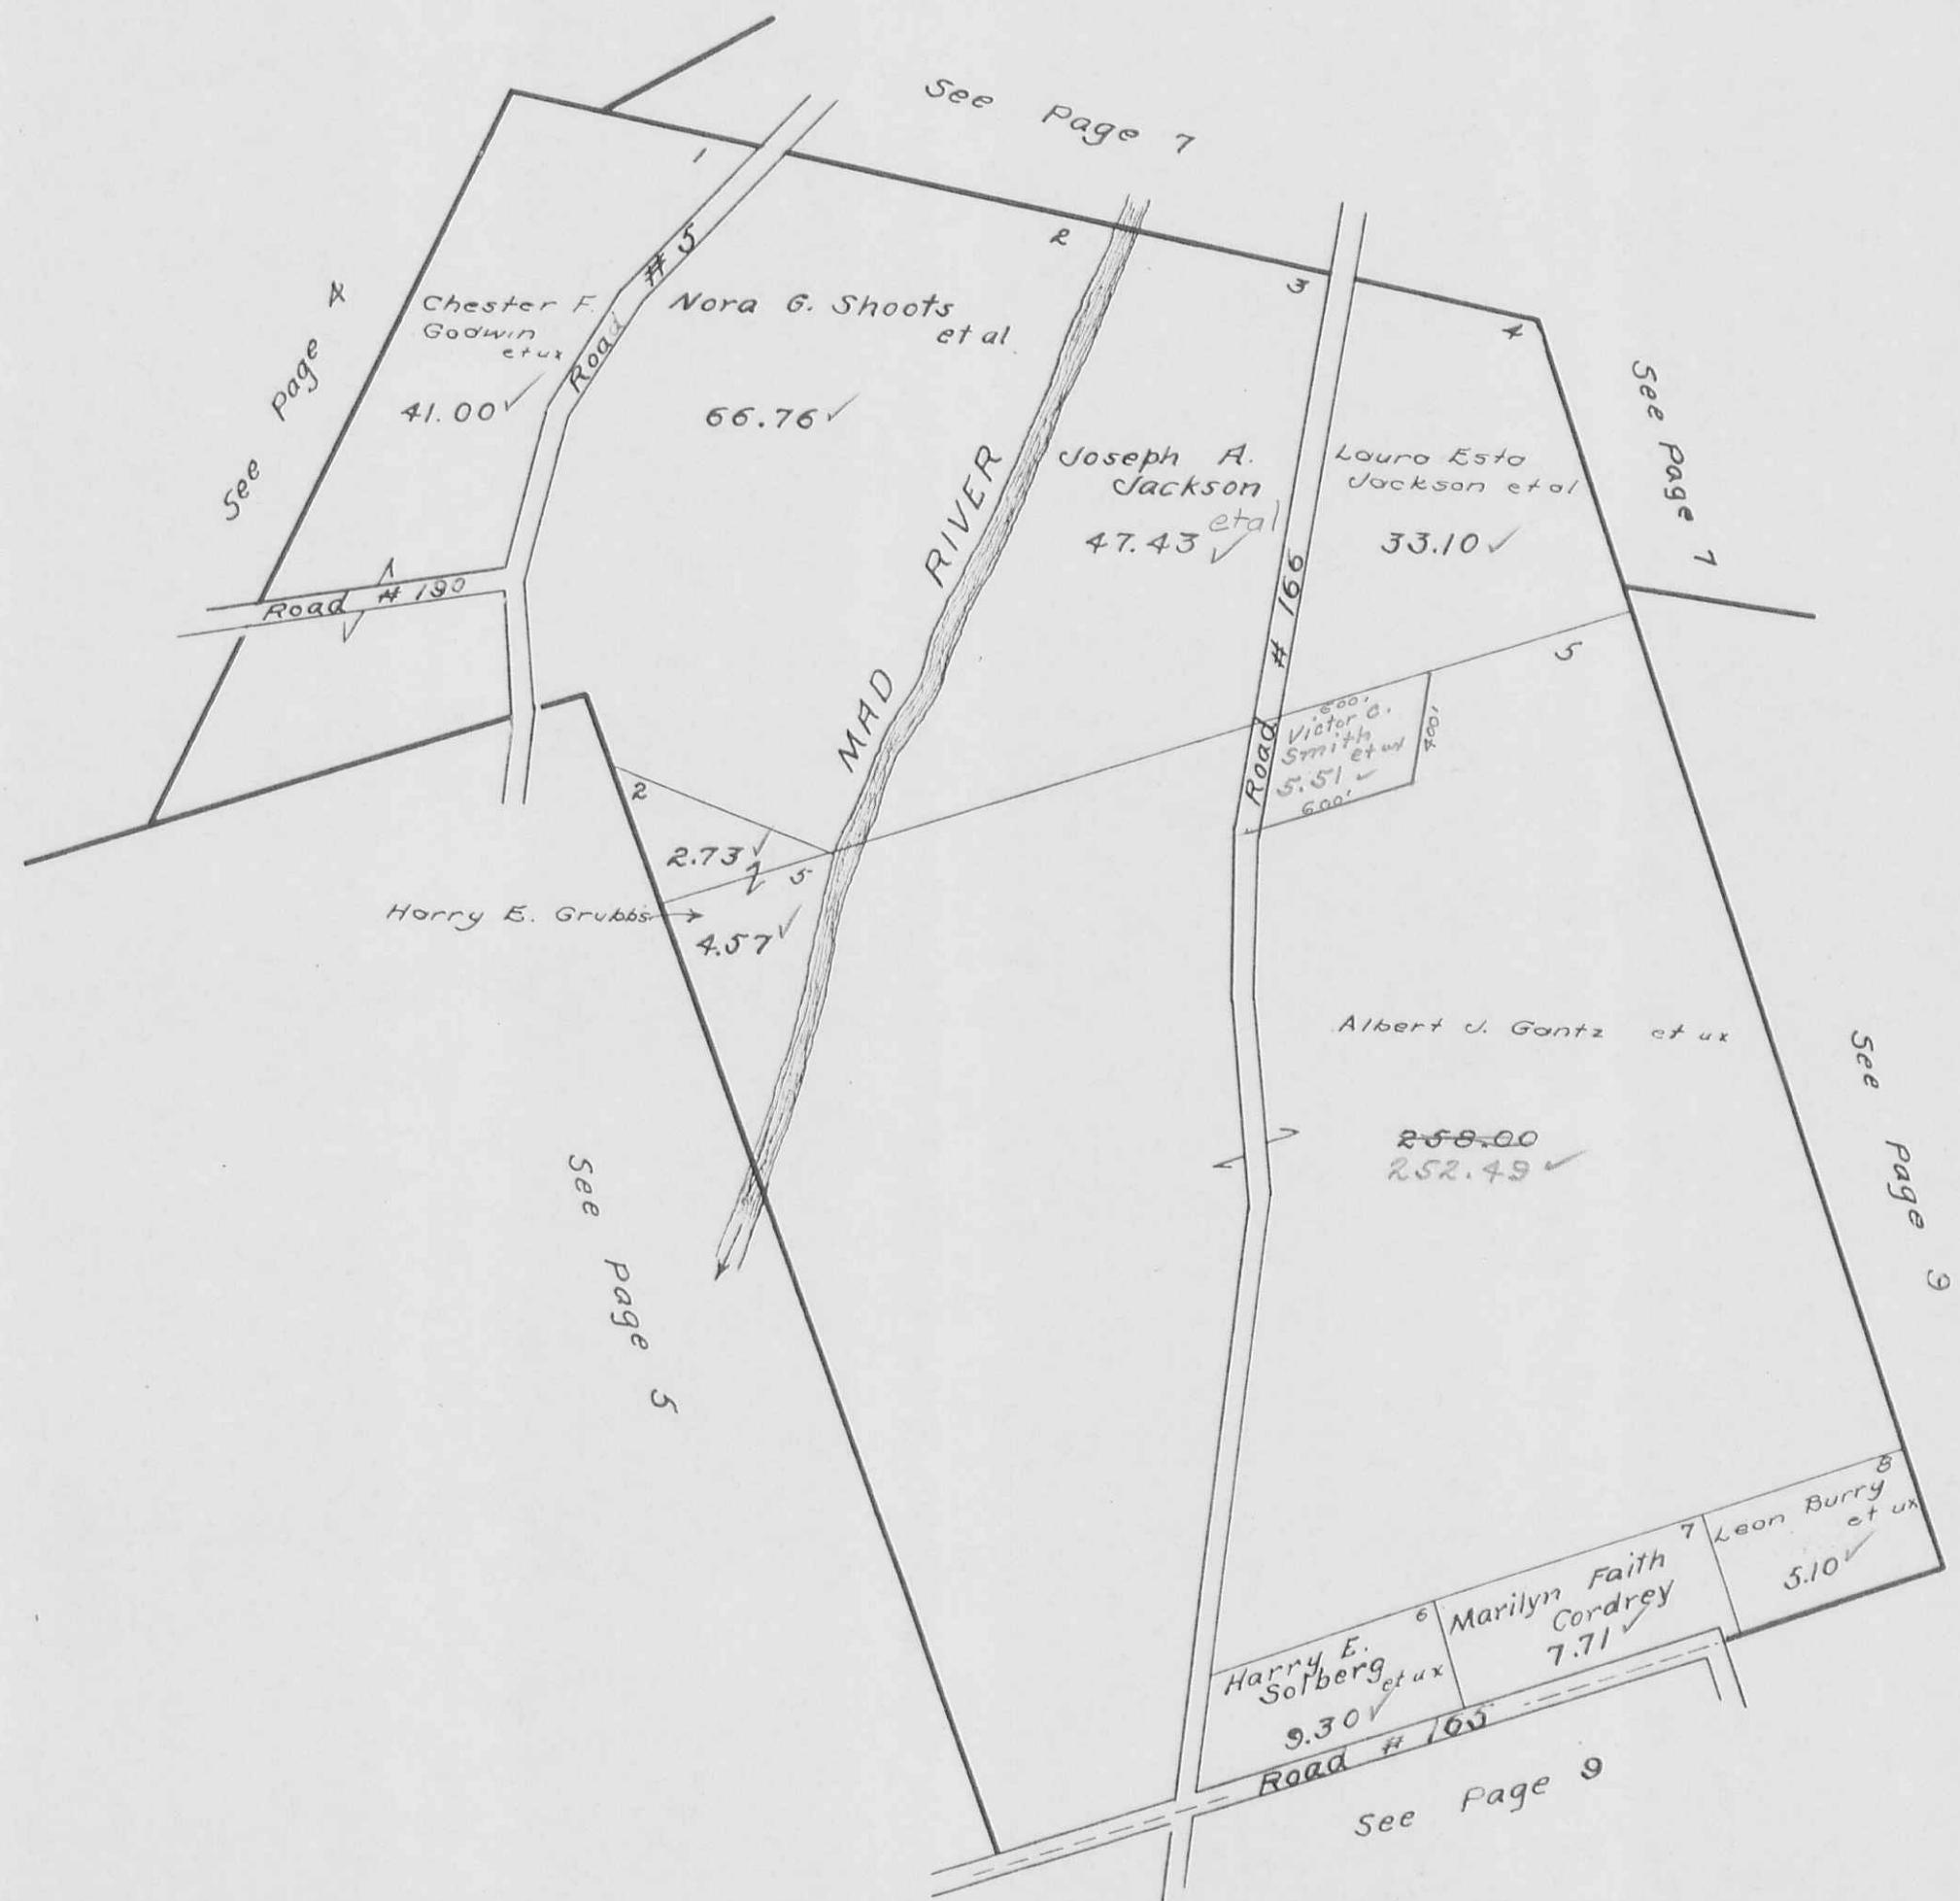

MONROE TOWNSHIP  
VIRGINIA MILITARY SURVEYS

SCALE 10 CHAINS TO THE INCH

PAGE

7

{ 9592  
9618  
10075  
3242




VIRGINIA

MILITARY SURVEYS

3138  
4497

SCALE 10 CHAINS TO THE INCH

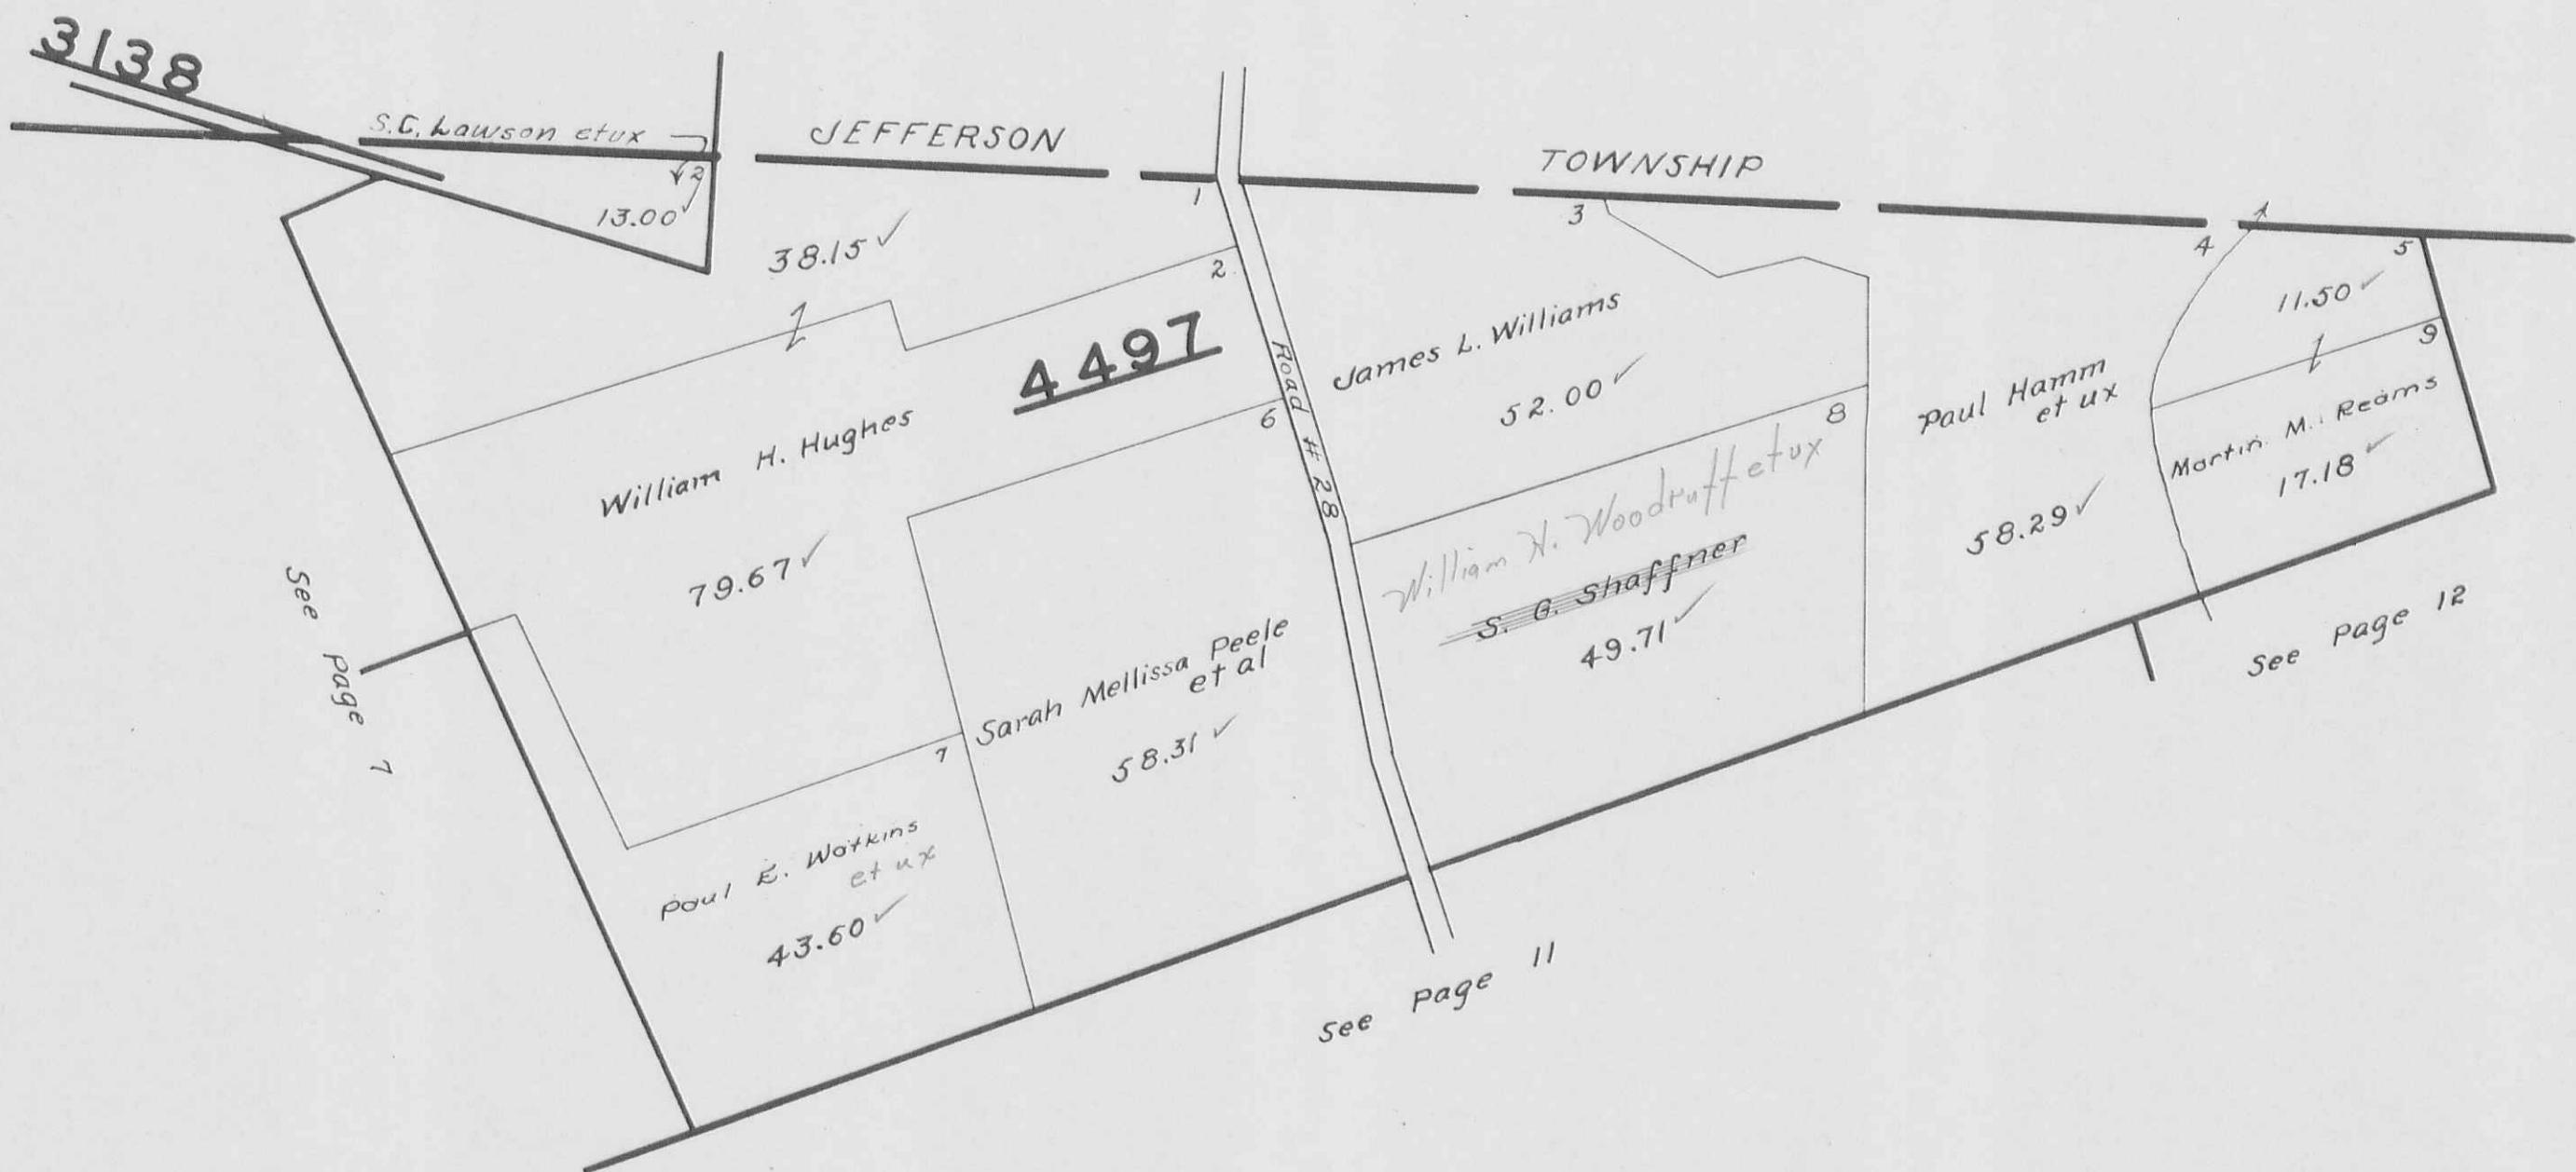

MONROE TOWNSHIP  
VIRGINIA MILITARY SURVEYS

SCALE 10 CHAINS TO THE INCH

9878  
10109  
0718  
10719

PAGE

9




MONROE TOWNSHIP  
VIRGINIA MILITARY SURVEY 3222

SCALE 10 CHAINS TO THE INCH

PAGE

10

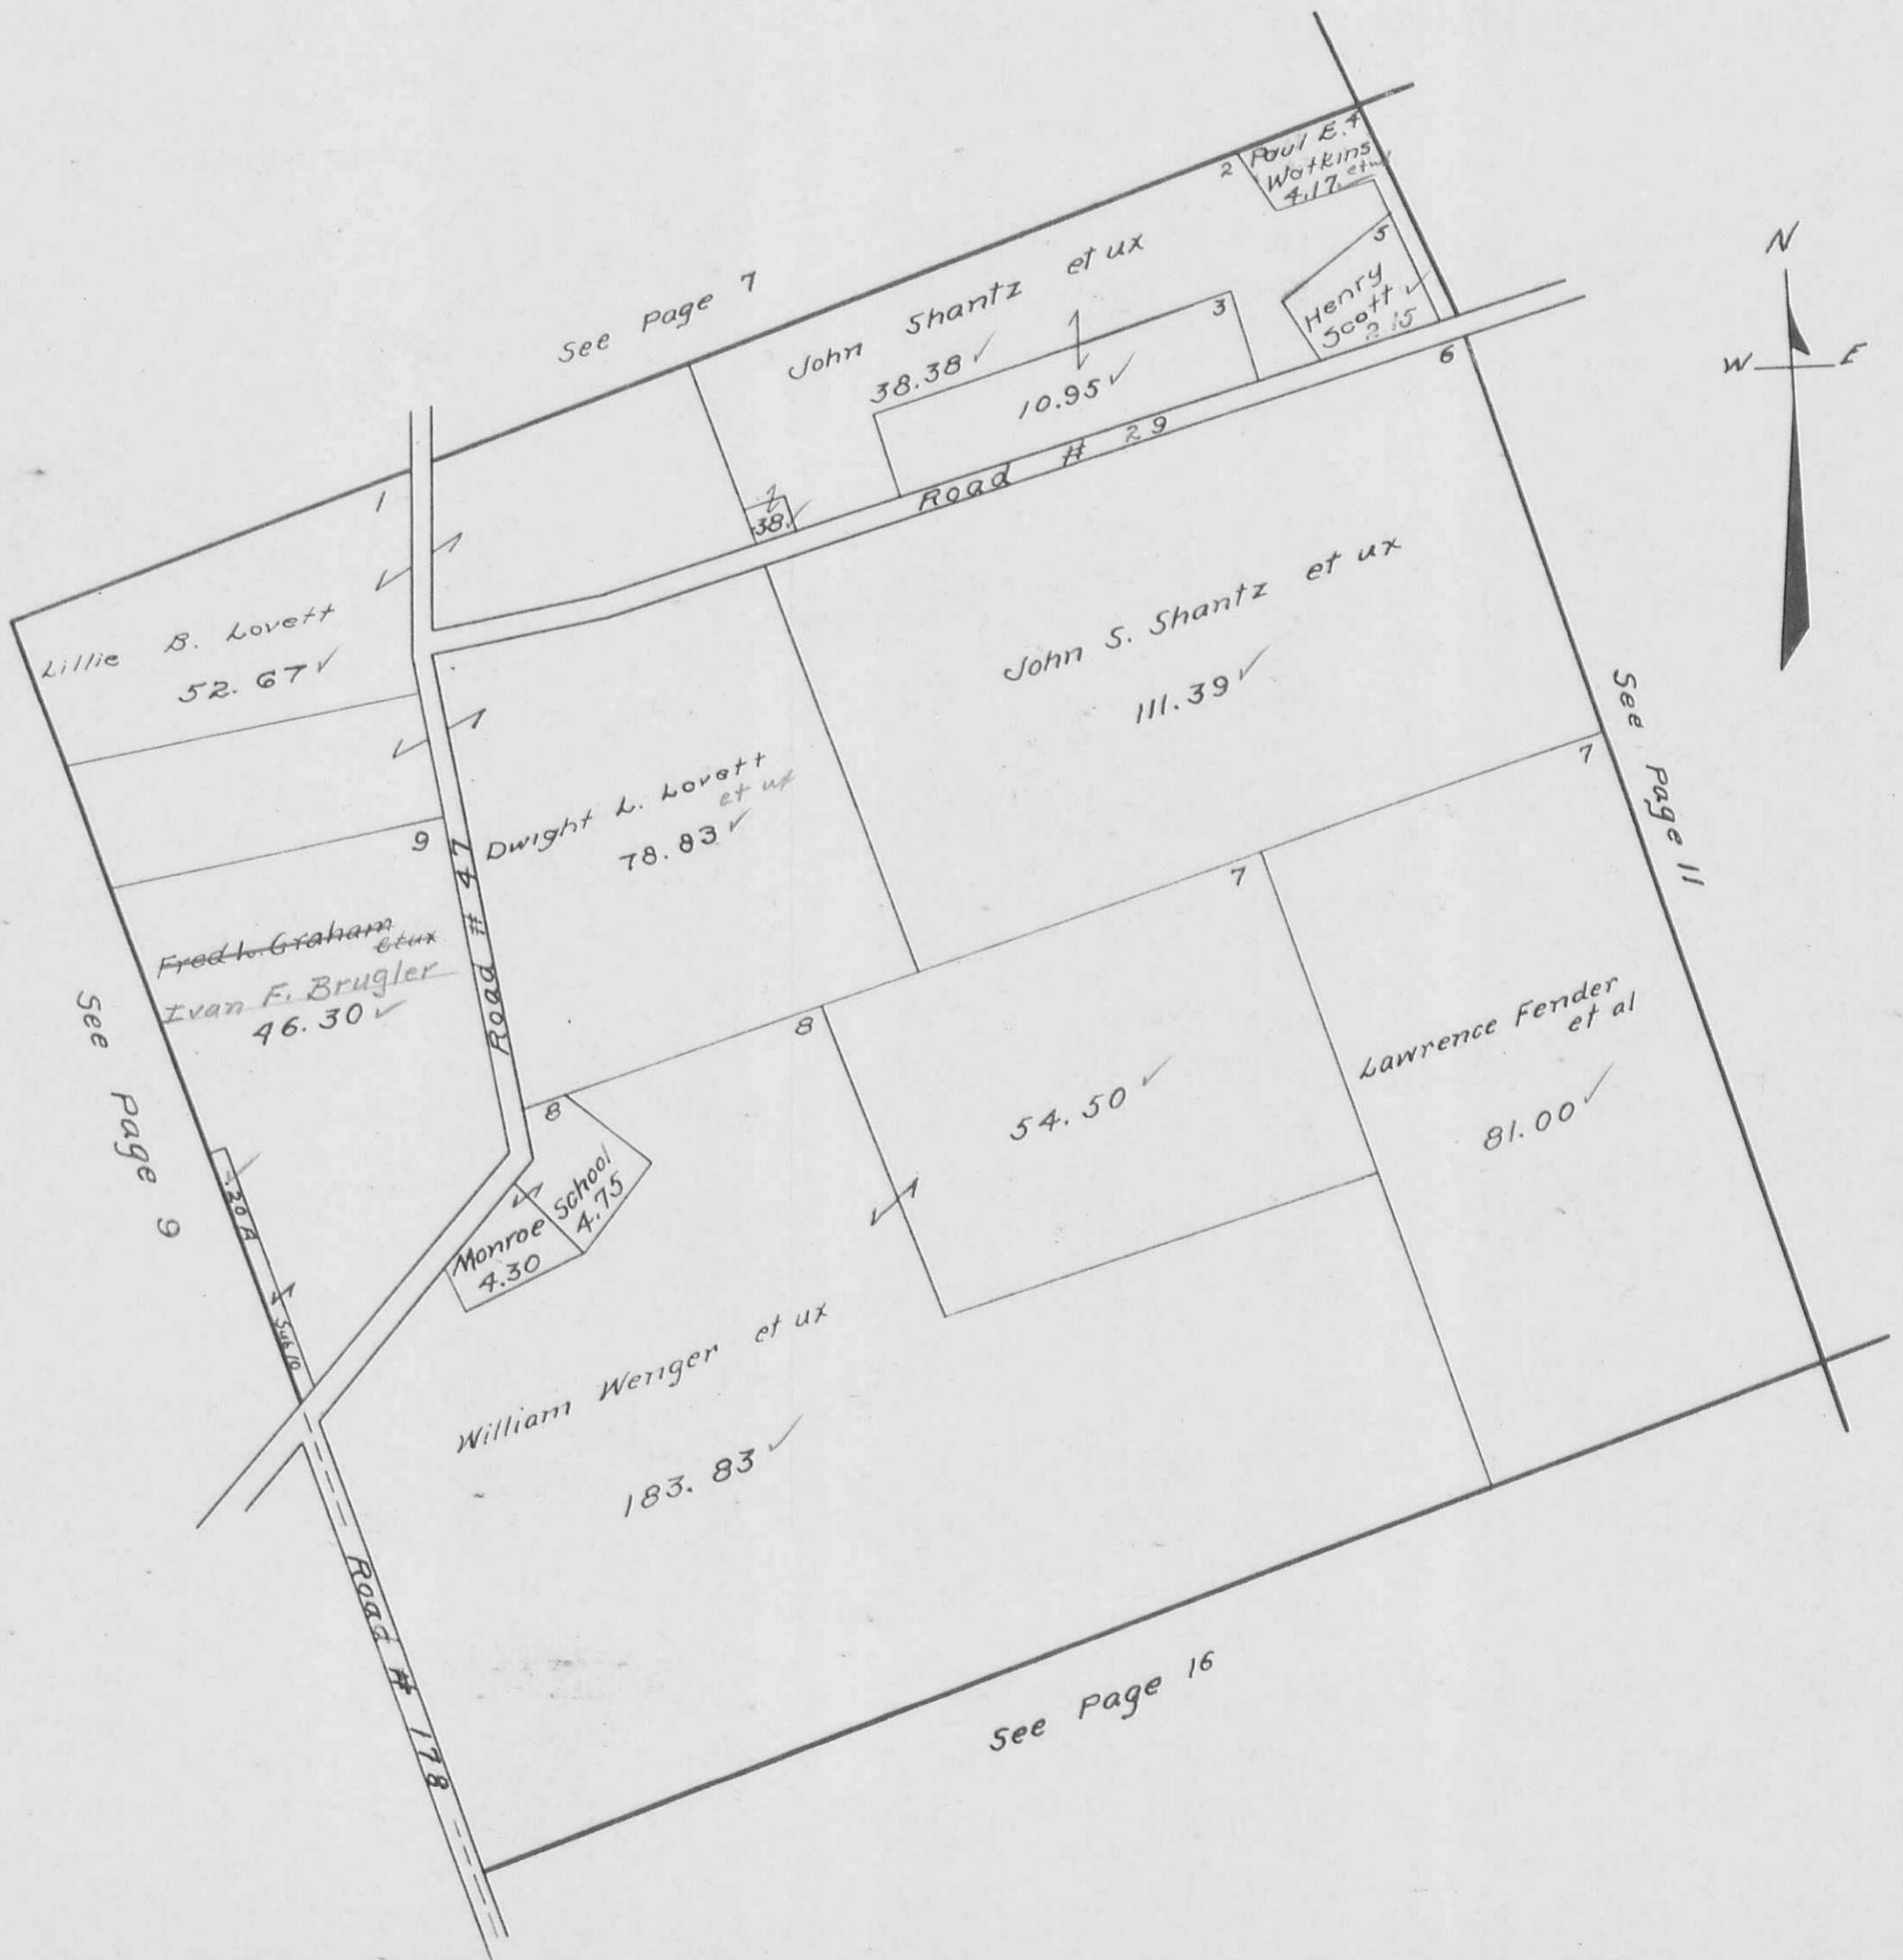

MONROE

TOWNSHIP

PAGE 11

## VIRGINIA MILITARY SURVEY 3221

SCALE 10 CHAINS TO THE INCH



VIRGINIA

MILITARY SURVEYS

3159

4676


7318

SCALE 10 CHAINS TO THE INCH



## VIRGINIA MILITARY SURVEY 6516

SCALE 10 CHAINS TO THE INCH

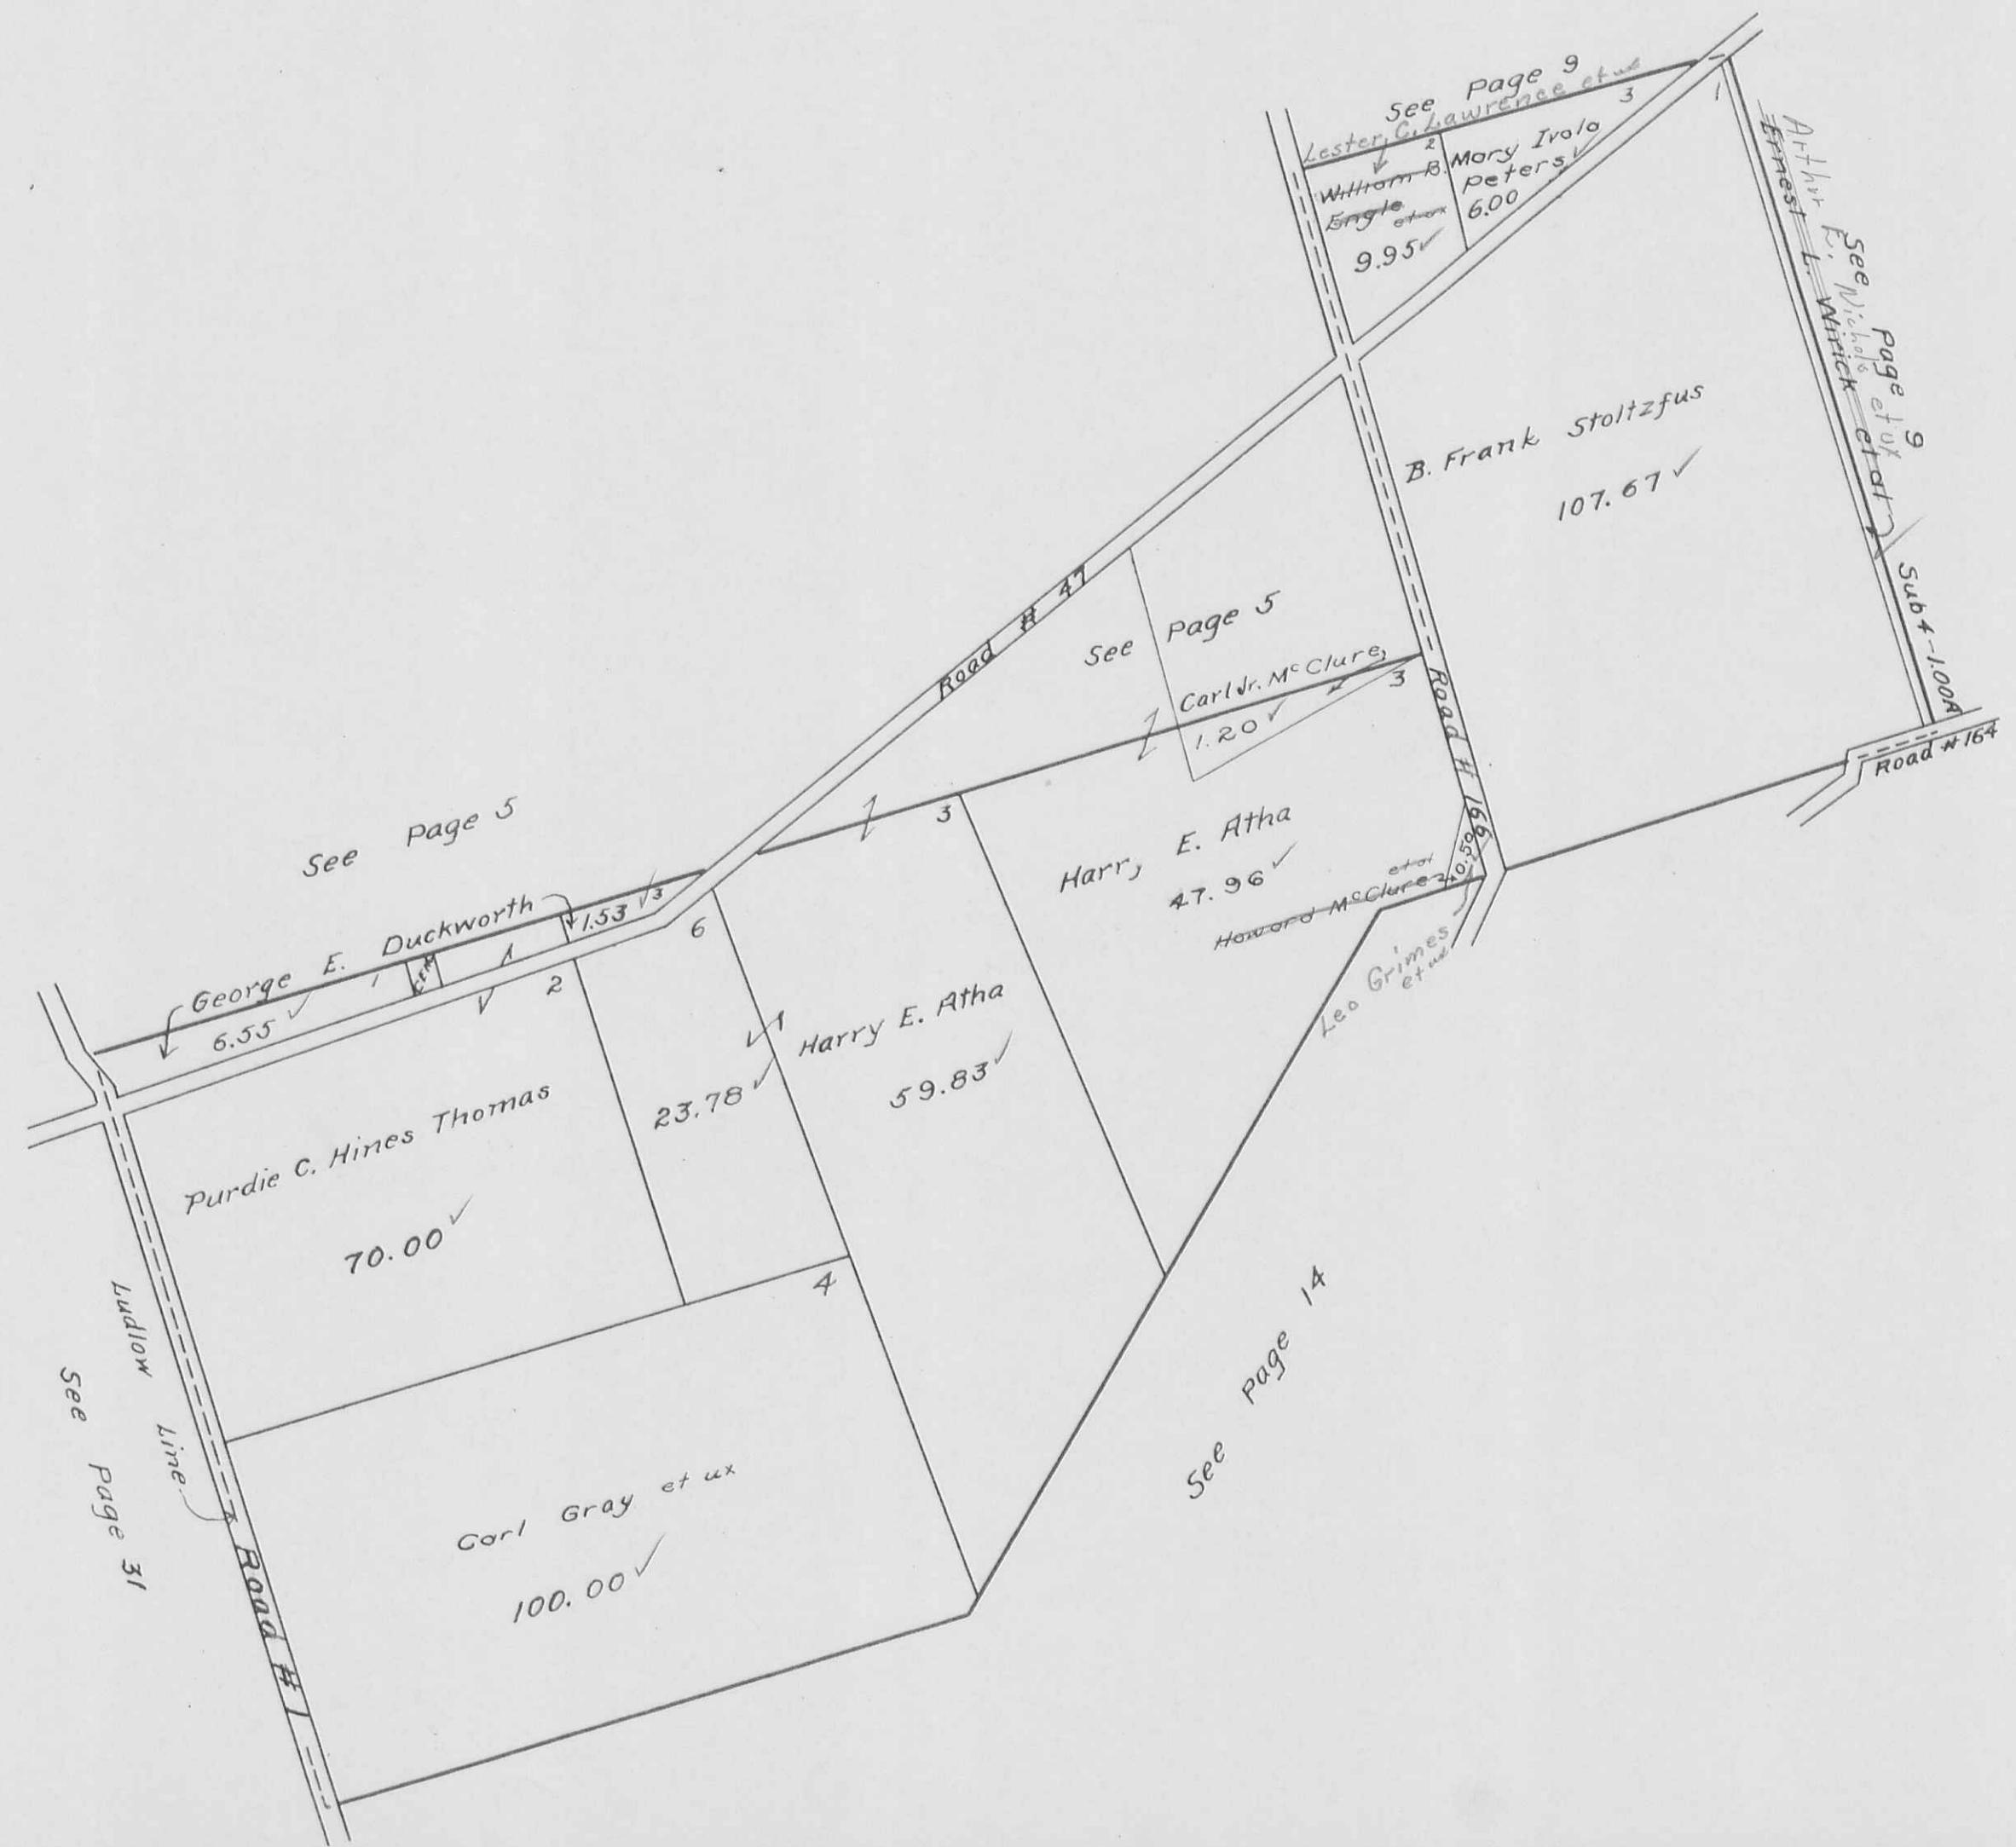

MONROE

## TOWNSHIP

PAGE 14

VIRGINIA MILITARY SURVEY 4479

SCALE 10 CHAINS TO THE INCH




MONROE TOWNSHIP  
VIRGINIA MILITARY SURVEYS

SCALE 10 CHAINS TO THE INCH


10091  
6487  
2220

PAGE 15

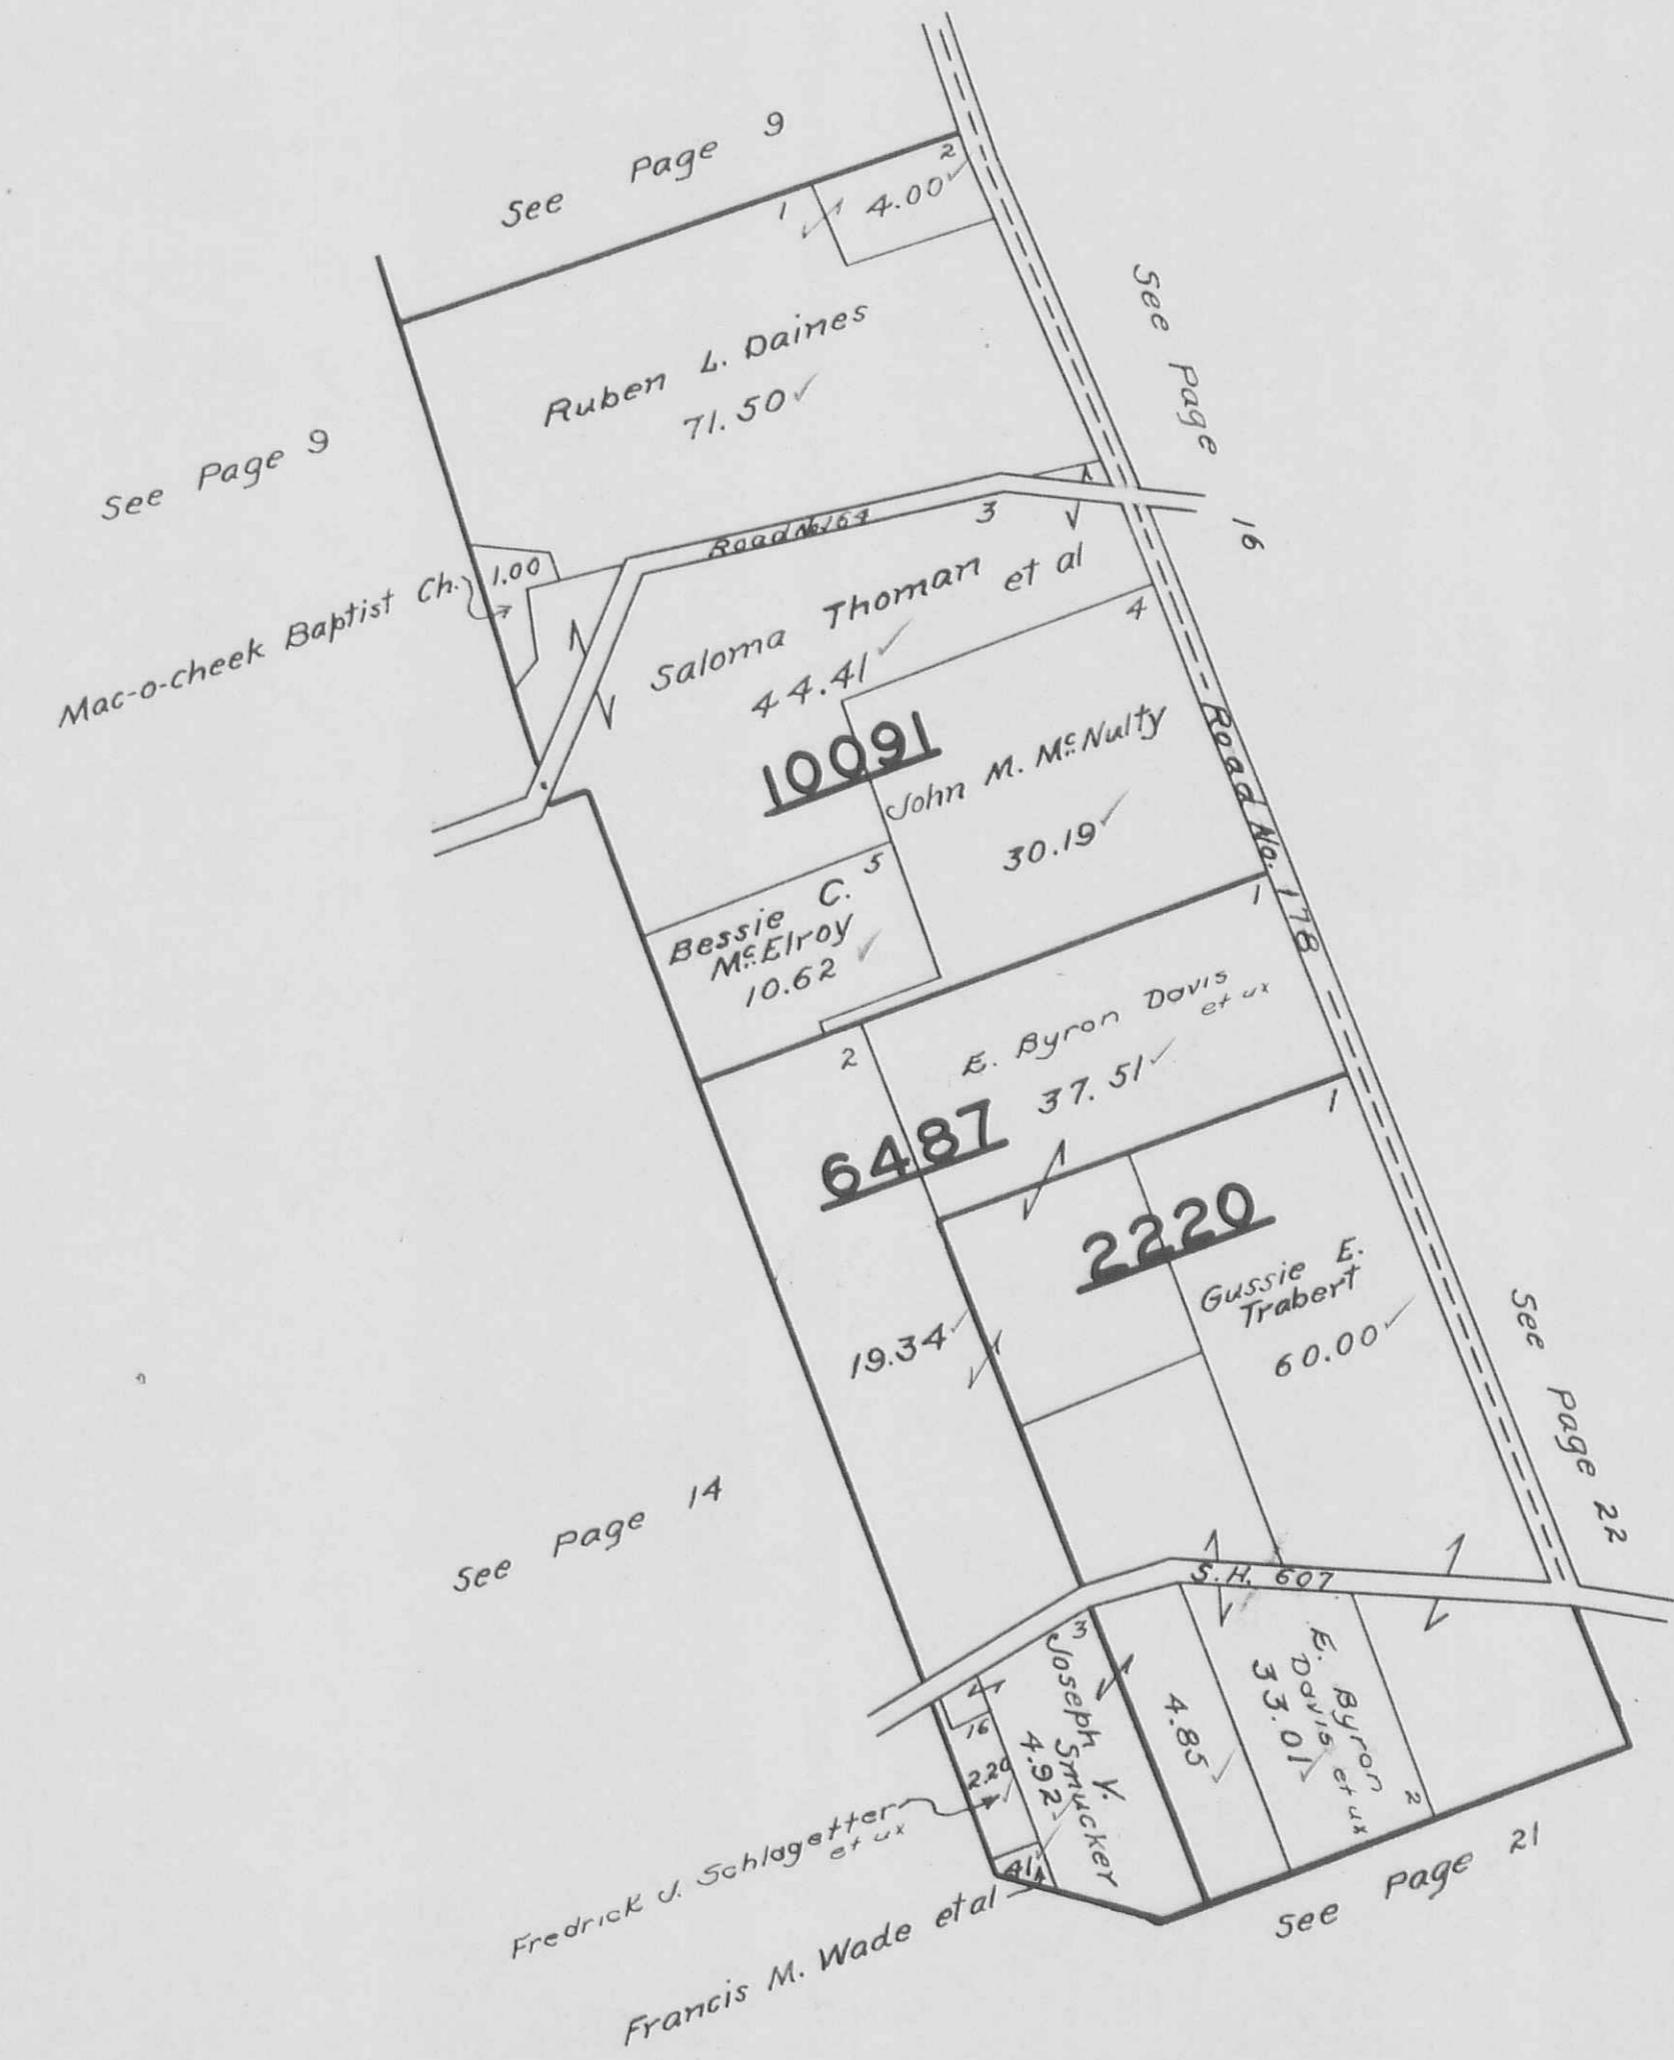

## VIRGINIA MILITARY SURVEY 3224


SCALE 10 CHAINS TO THE INCH

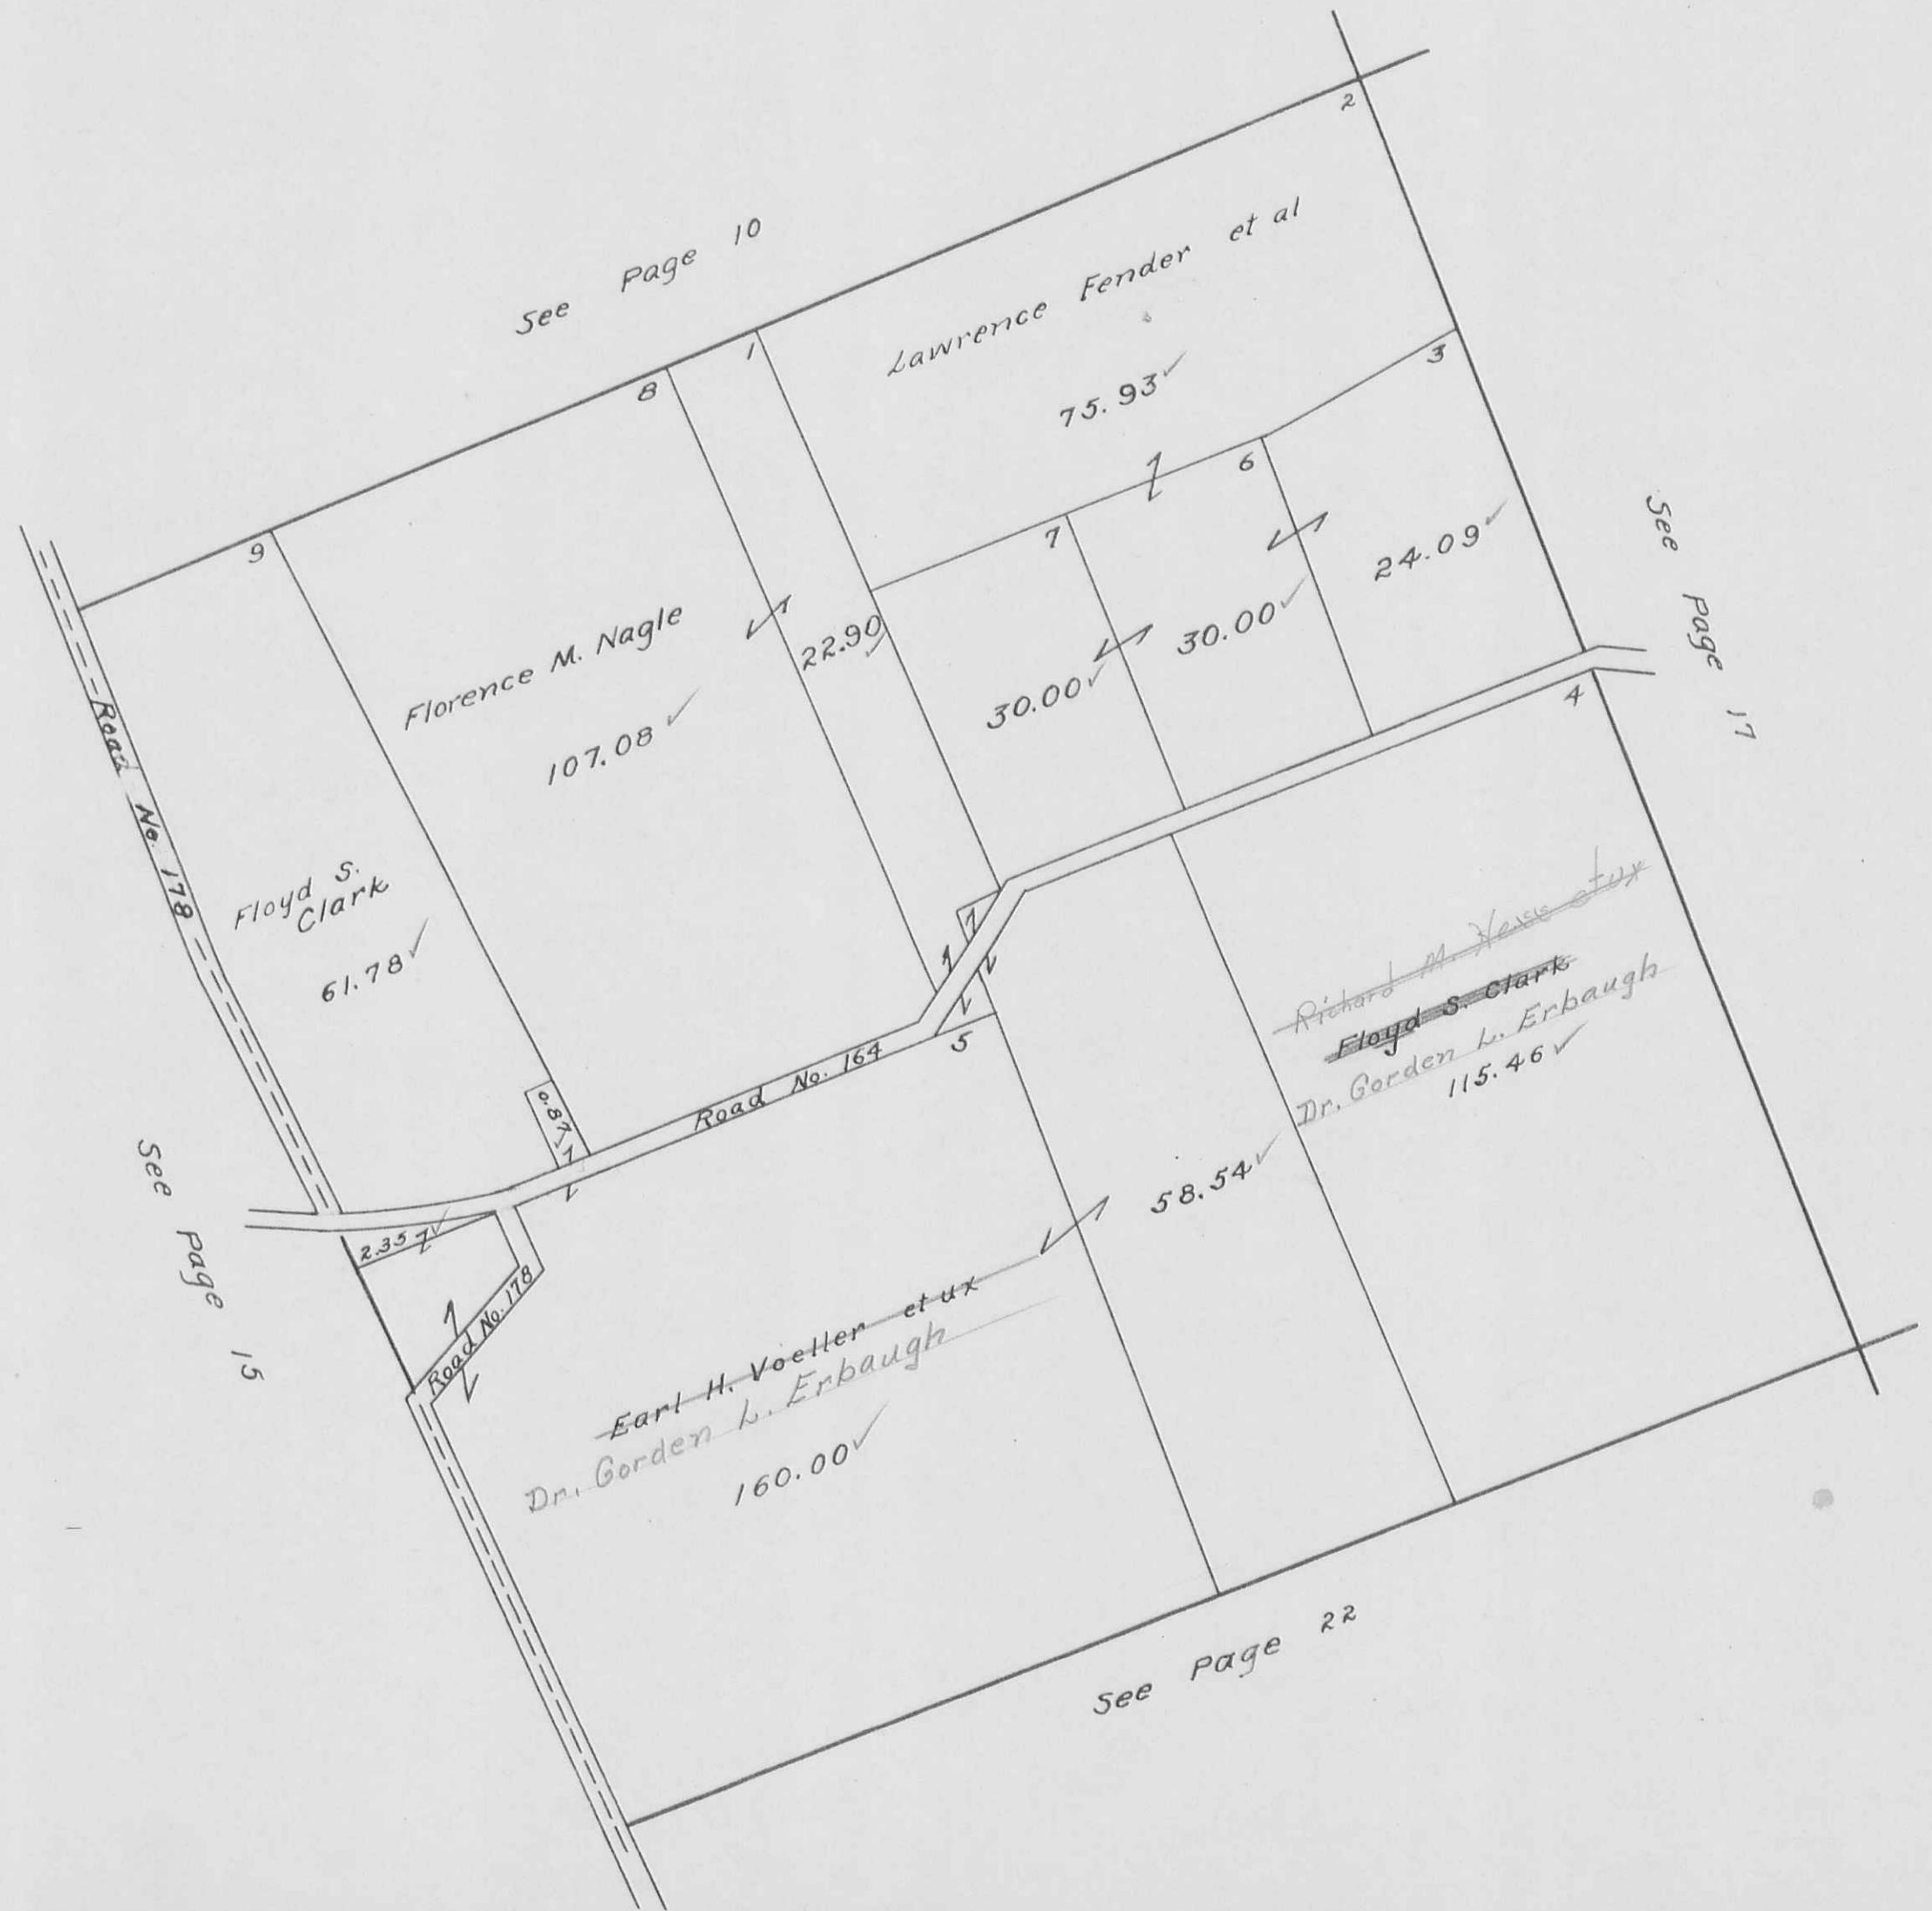

MONROE TOWNSHIP  
VIRGINIA MILITARY SURVEY 3223


SCALE 10 CHAINS TO THE INCH

PAGE 17 ✓

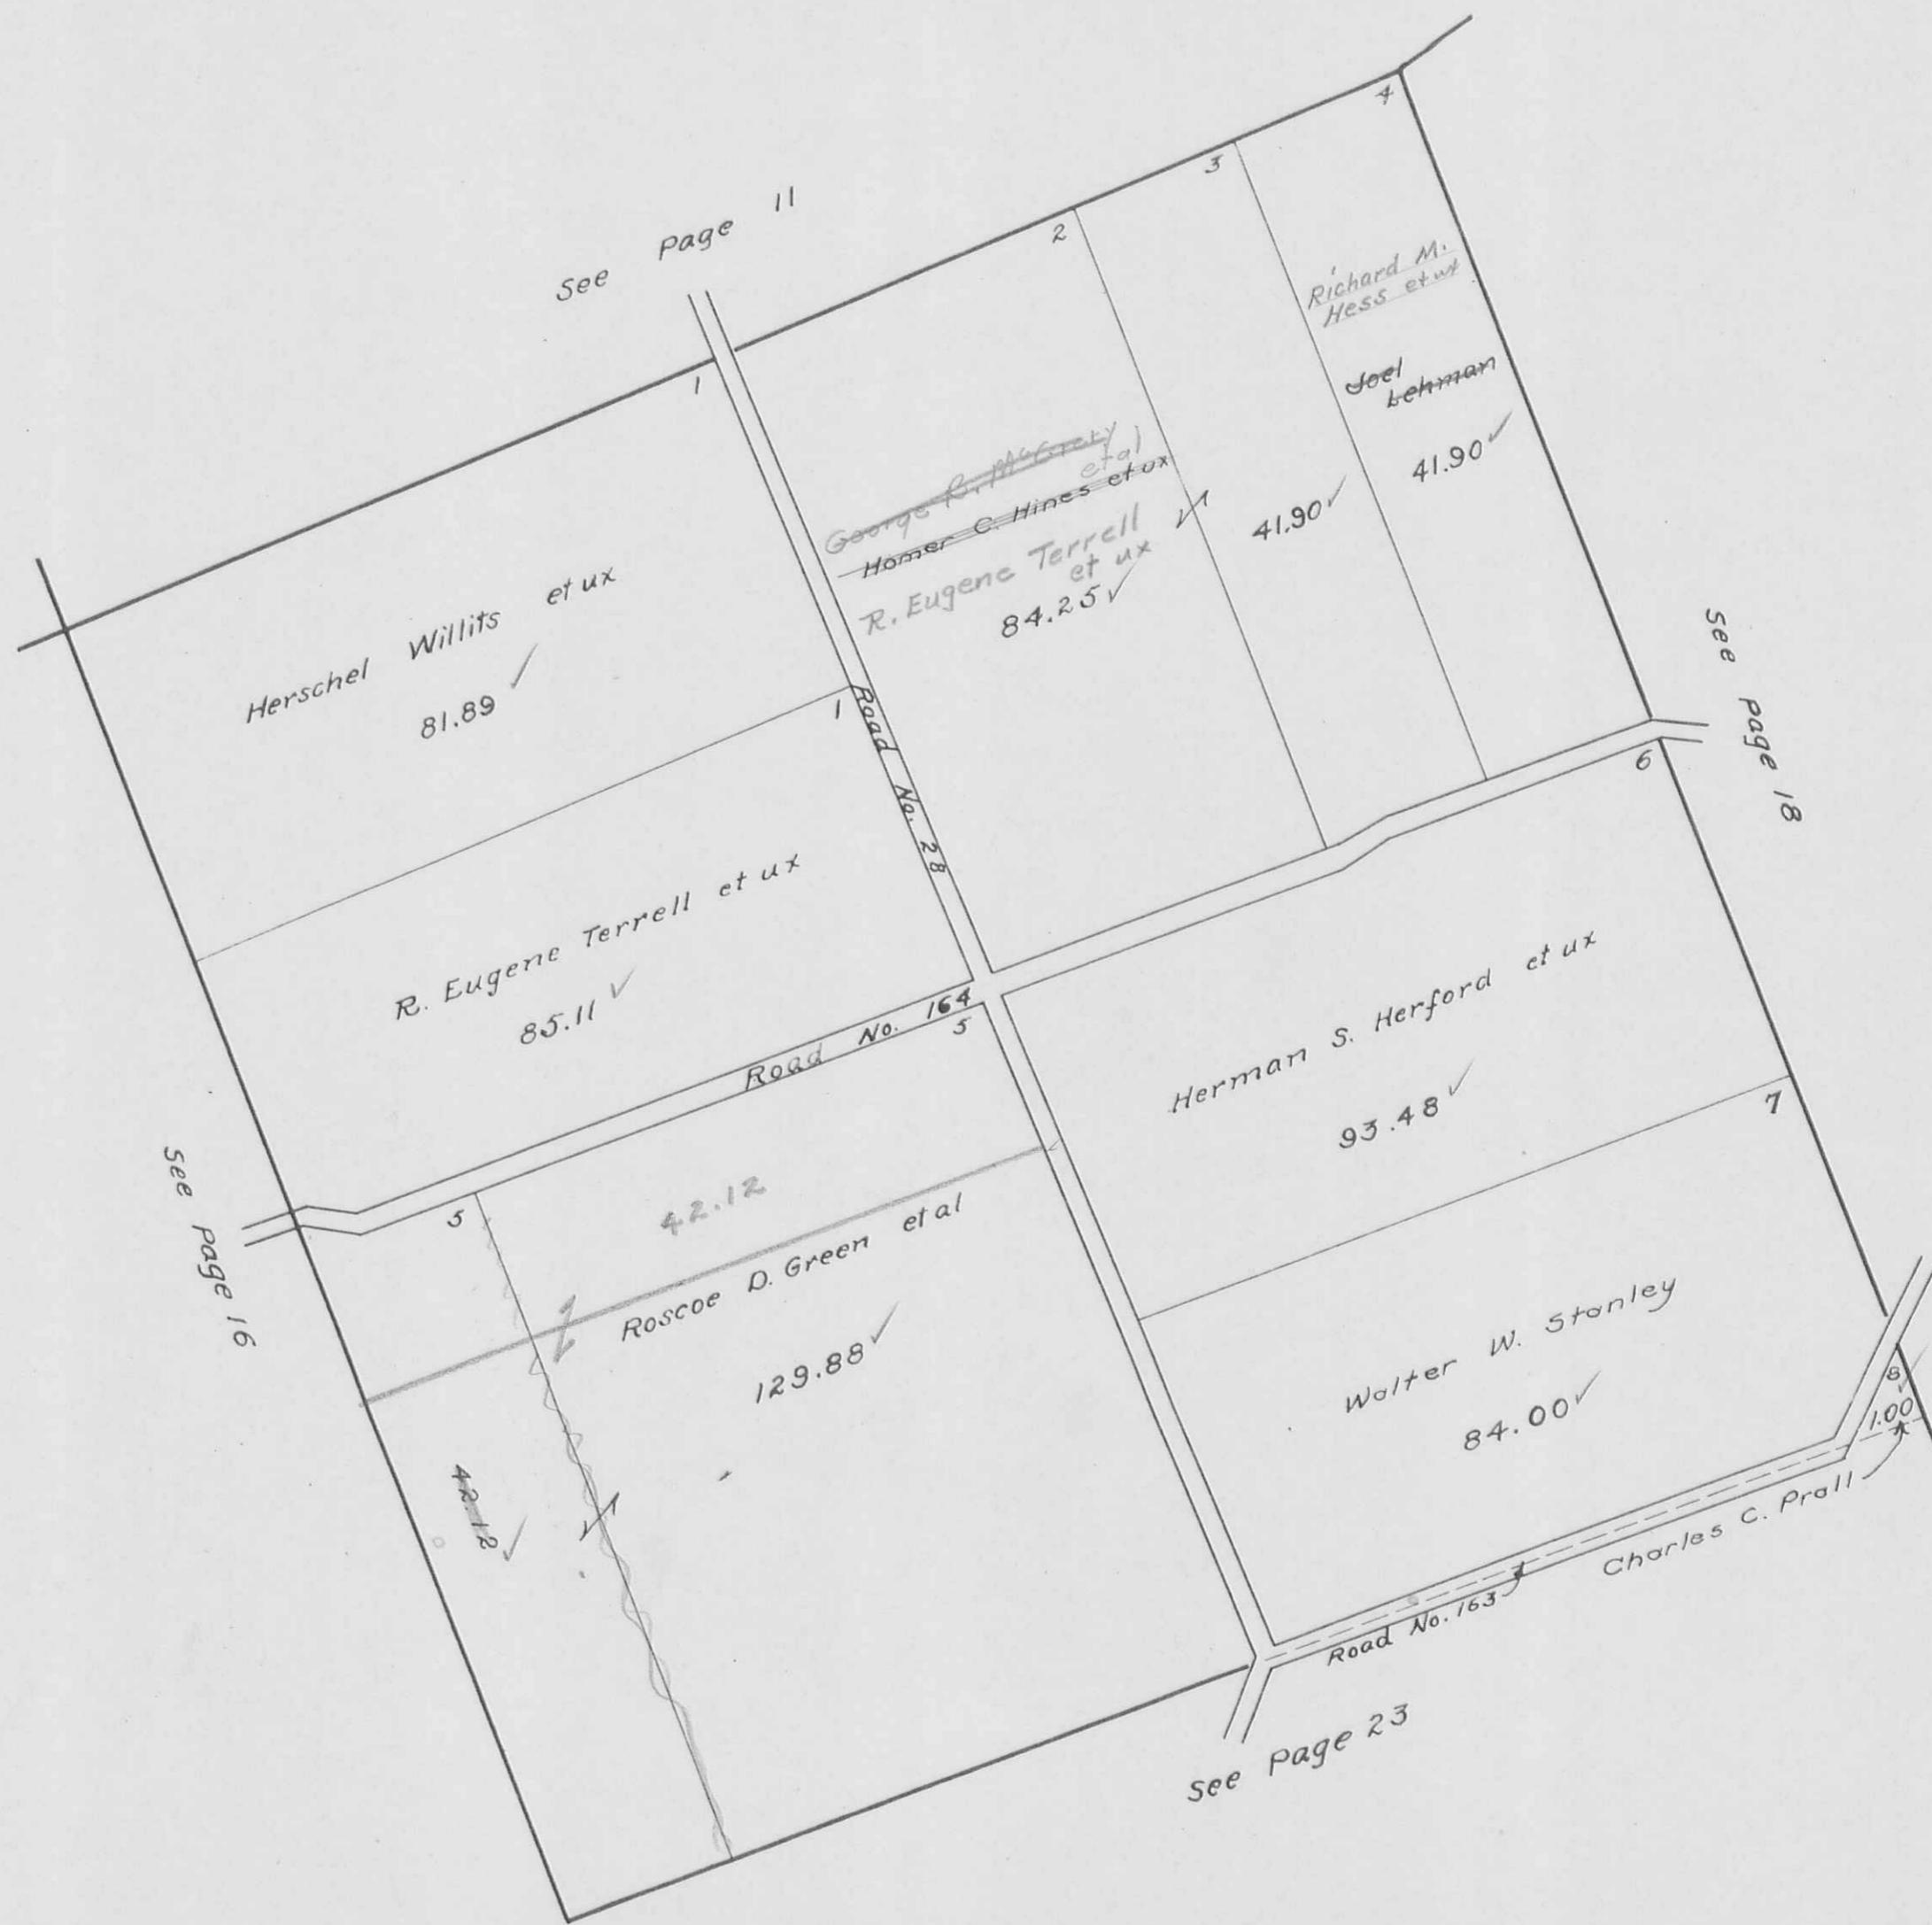

## VIRGINIA MILITARY SURVEY N. PART 4570


SCALE 10 CHAINS TO THE INCH

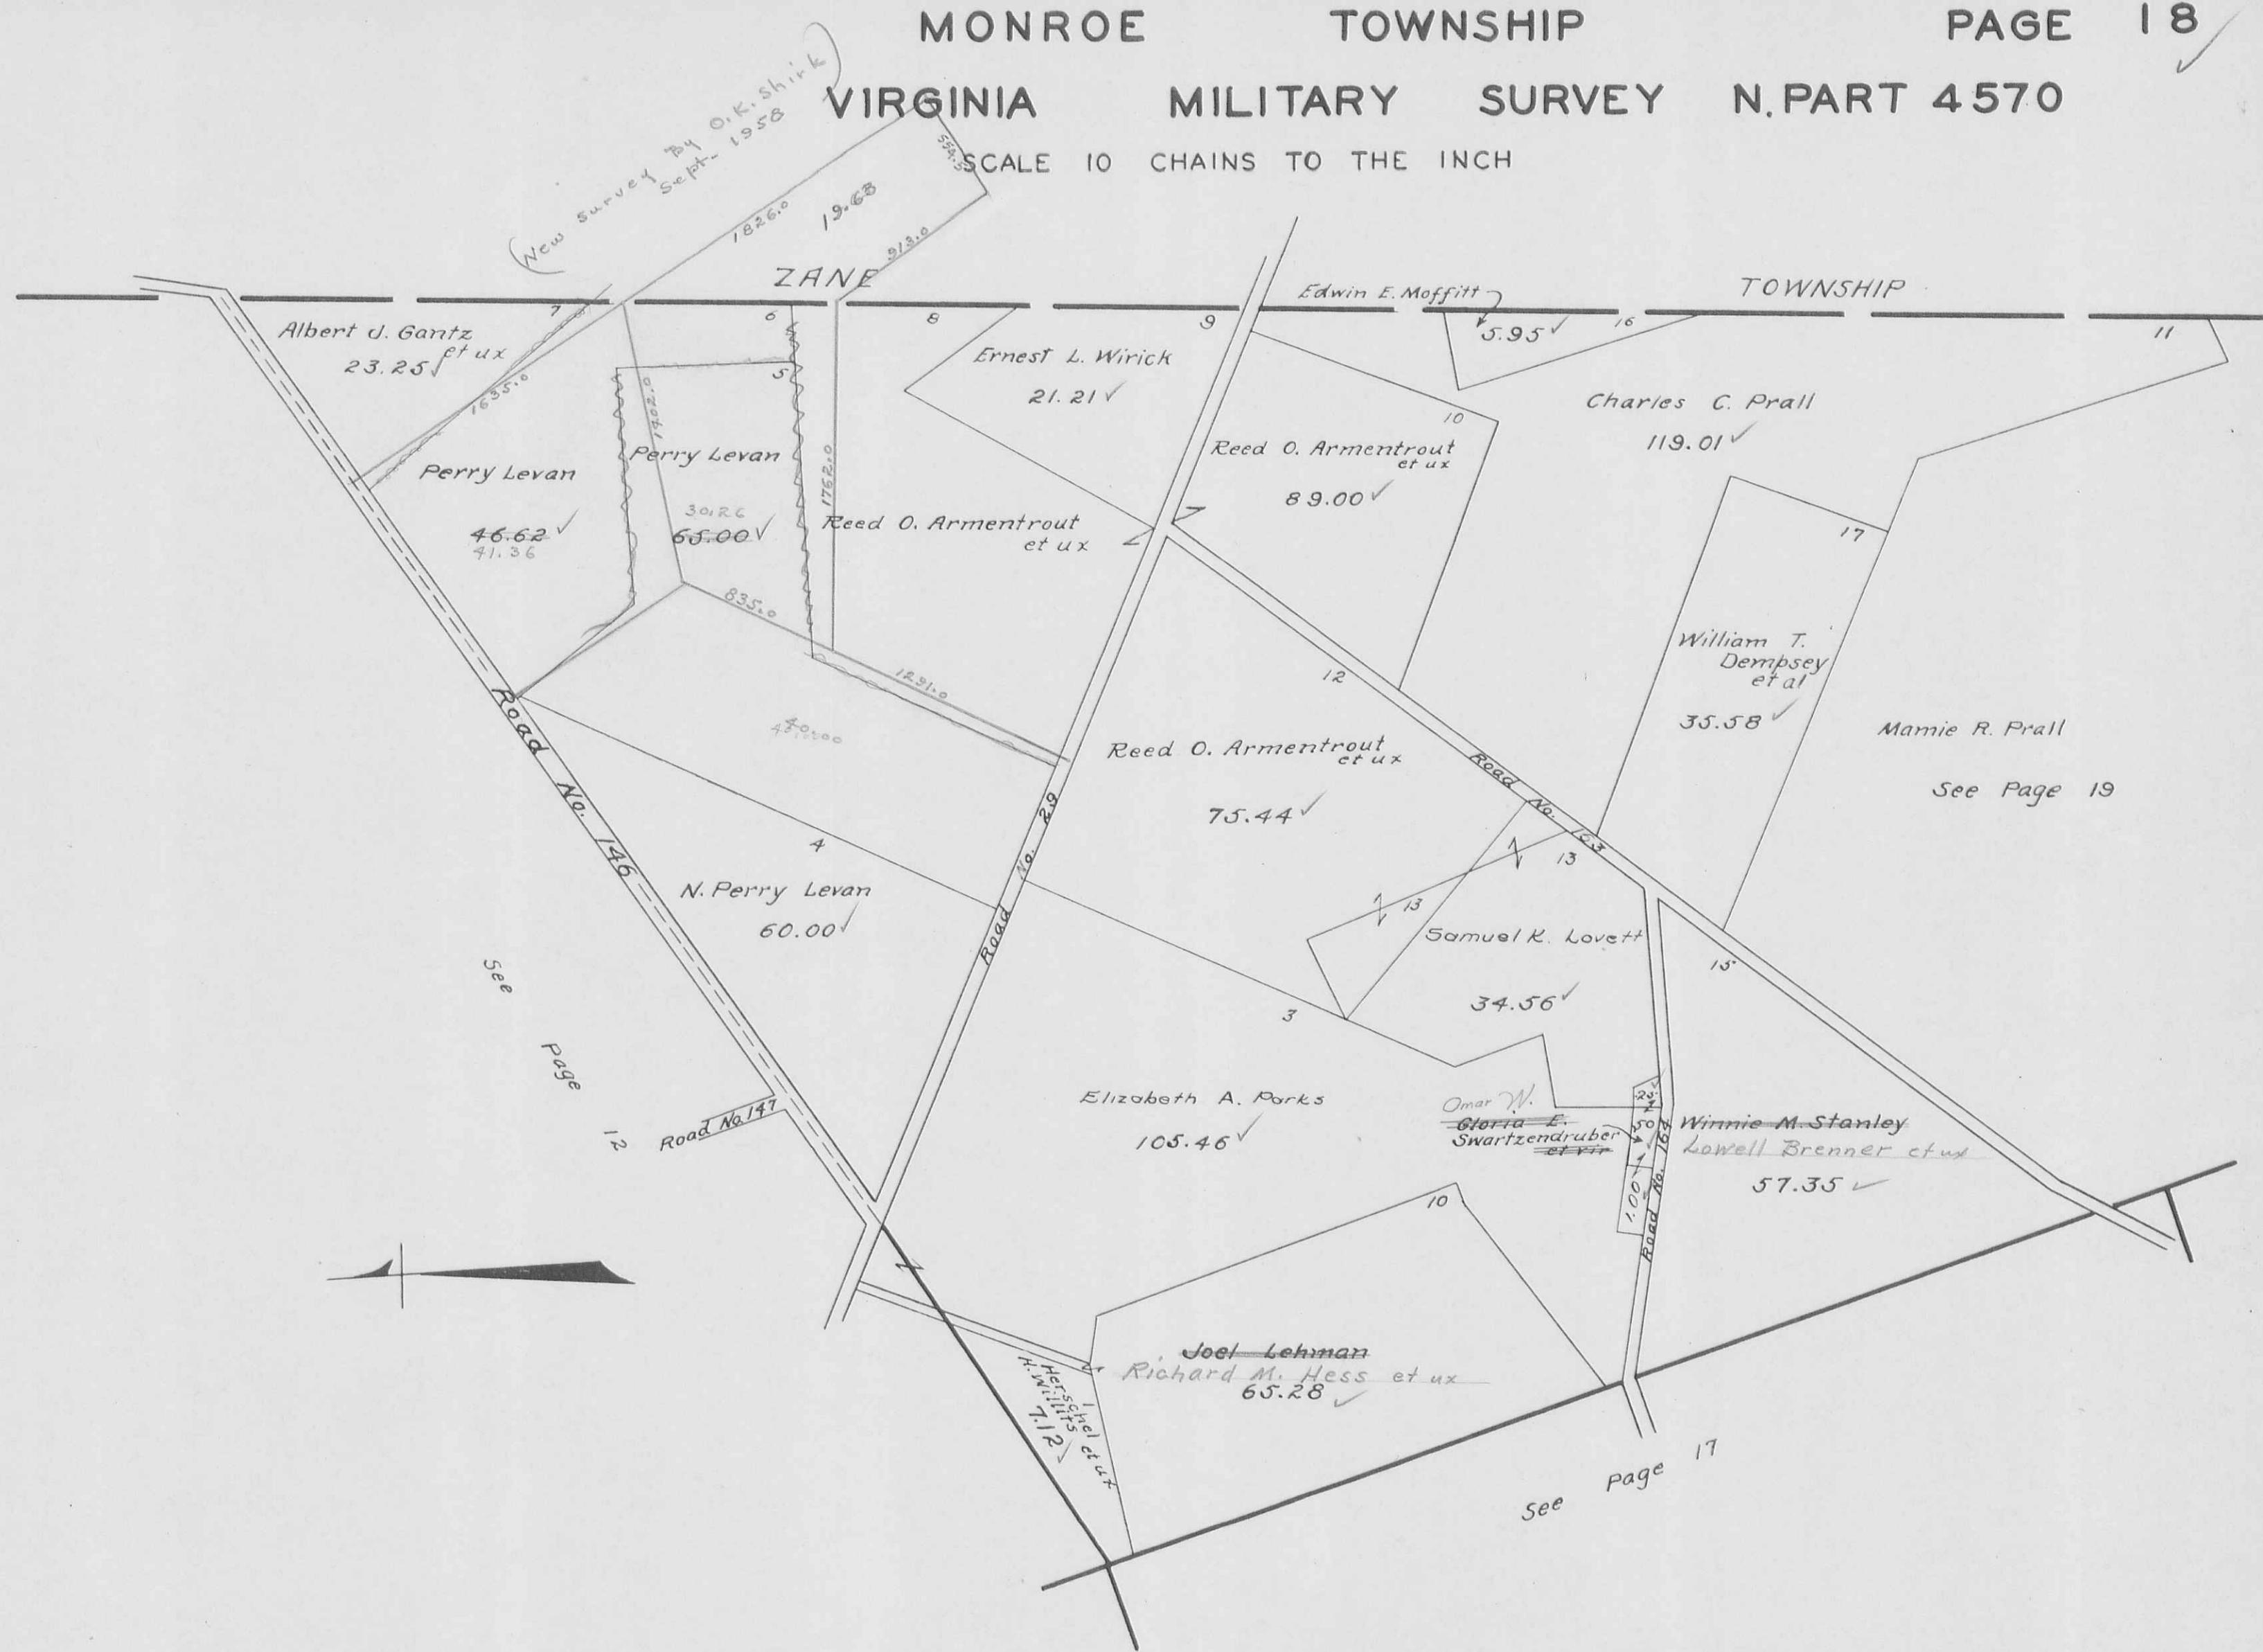

MONROE TOWNSHIP  
VIRGINIA MILITARY SURVEY S.PART 4570


SCALE 10 CHAINS TO THE INCH

PAGE 19 ✓

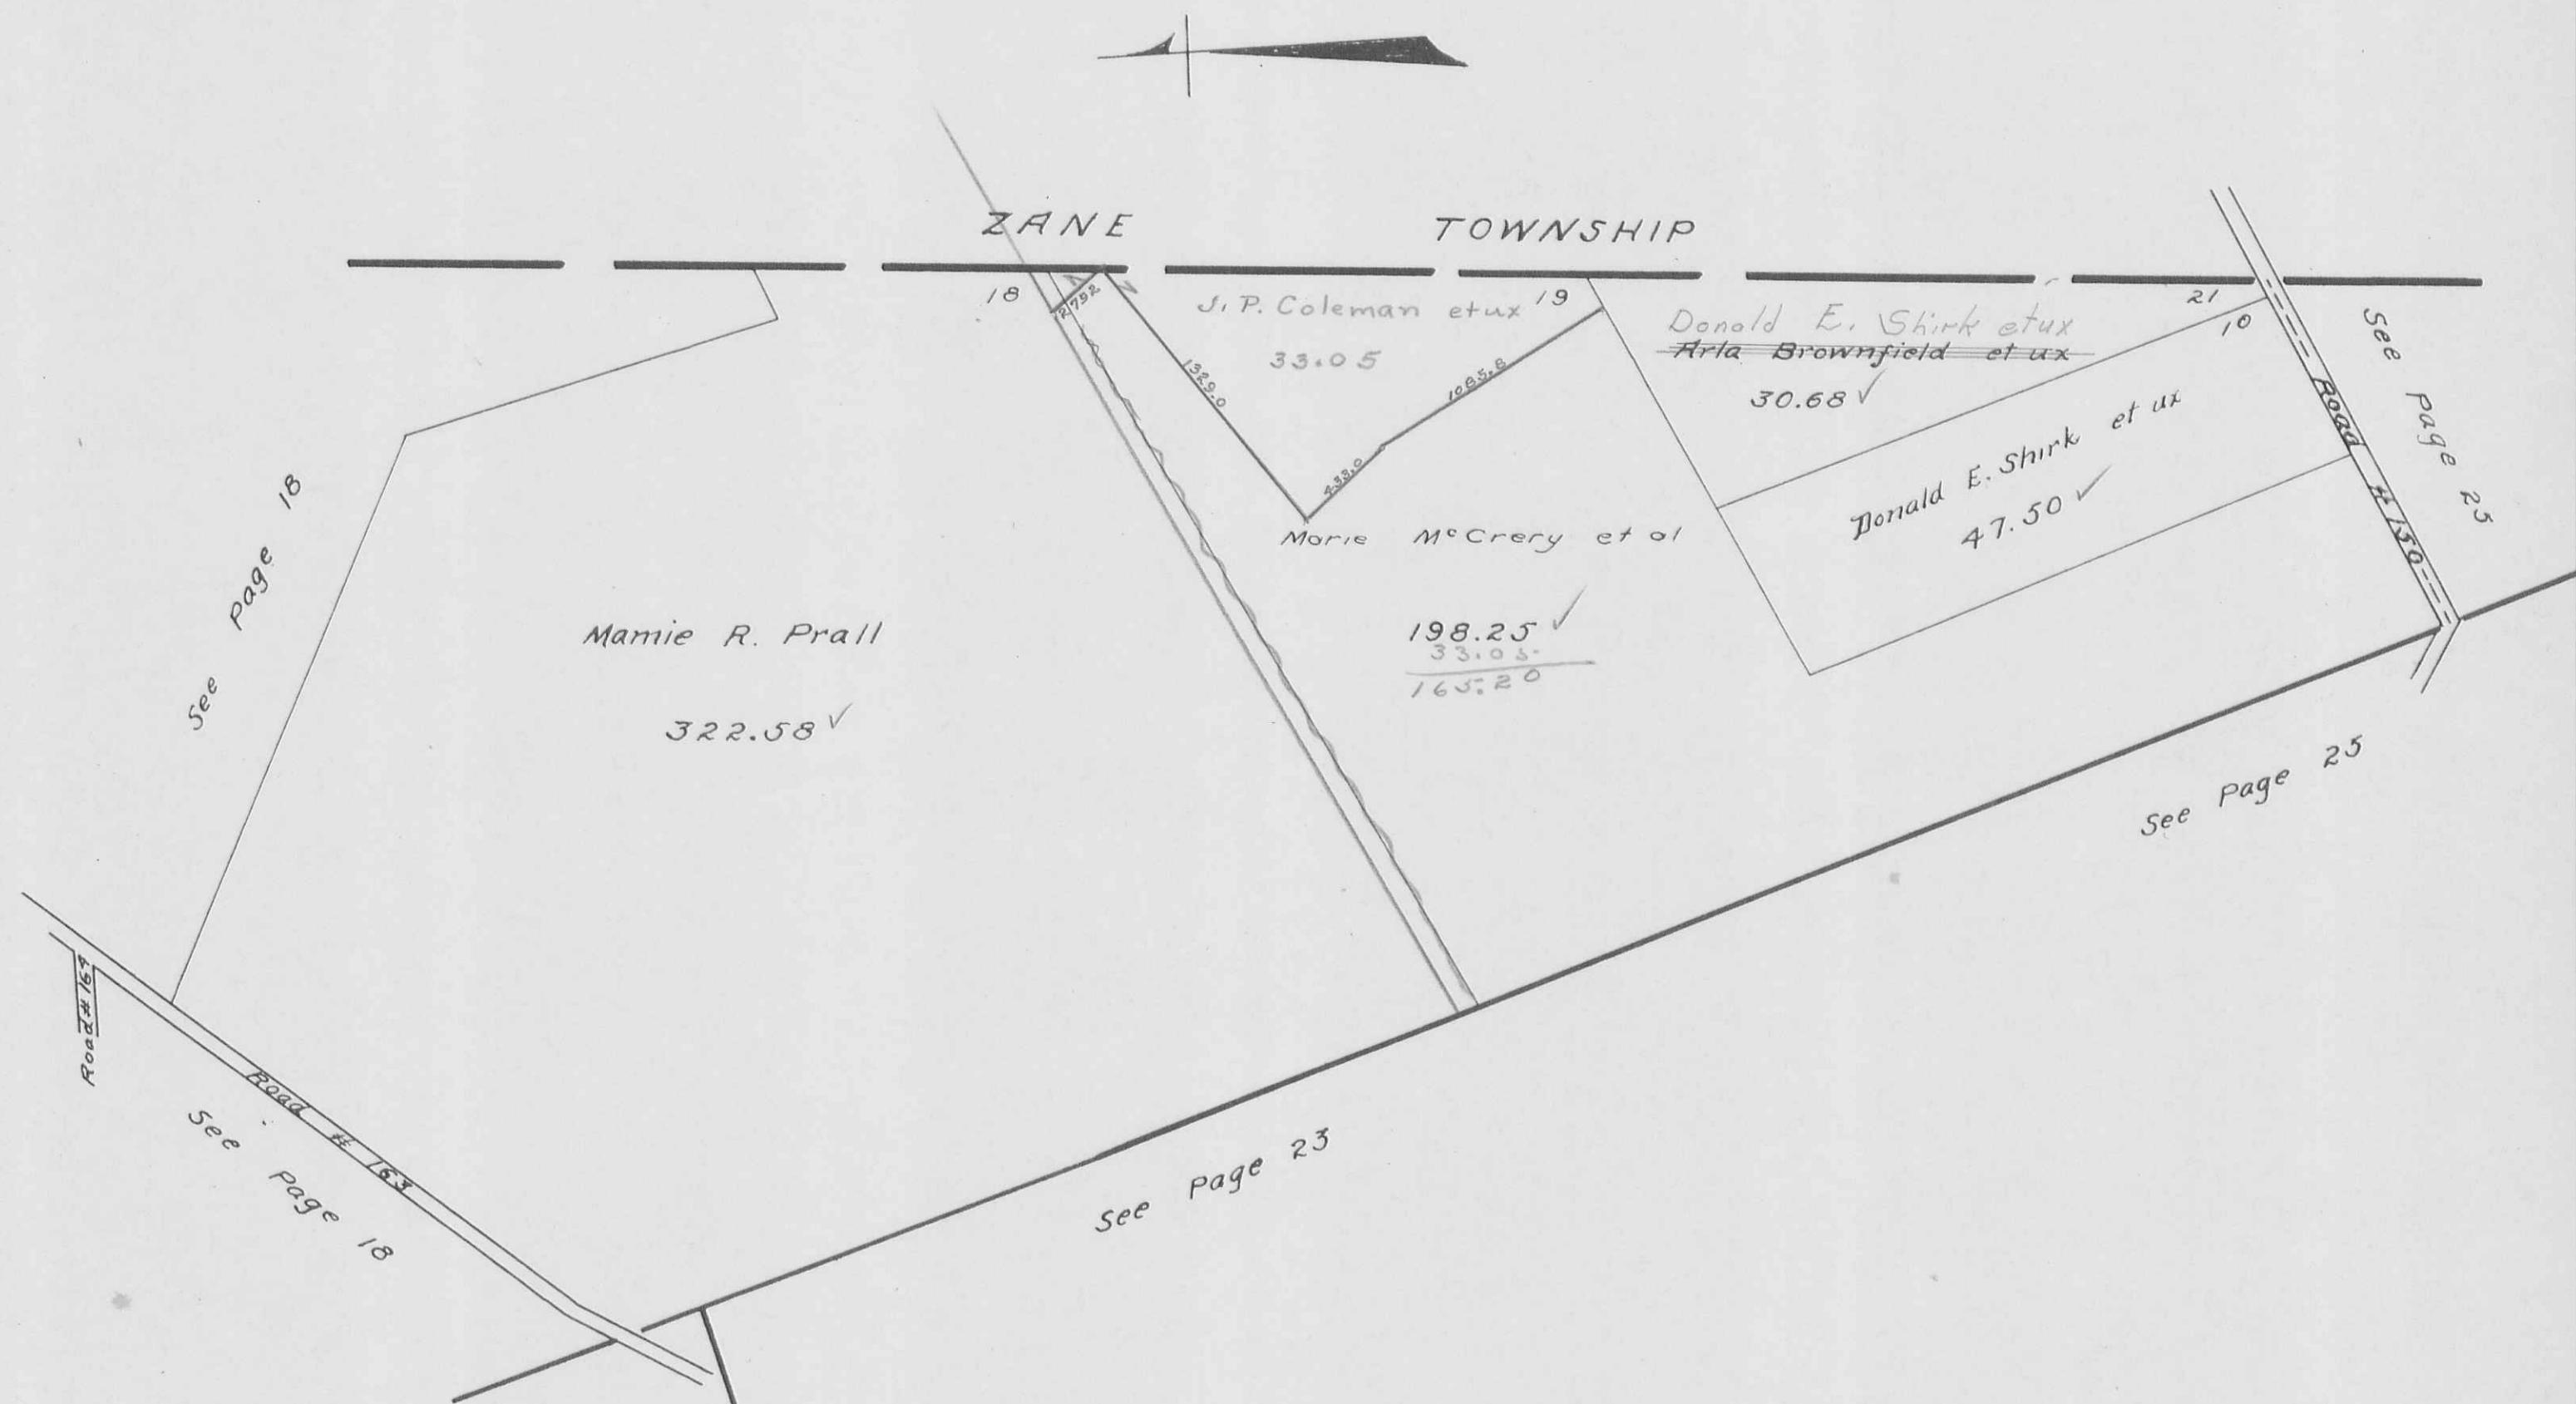

## VIRGINIA MILITARY SURVEY W.PART 4492

SCALE 10 CHAINS TO THE INCH

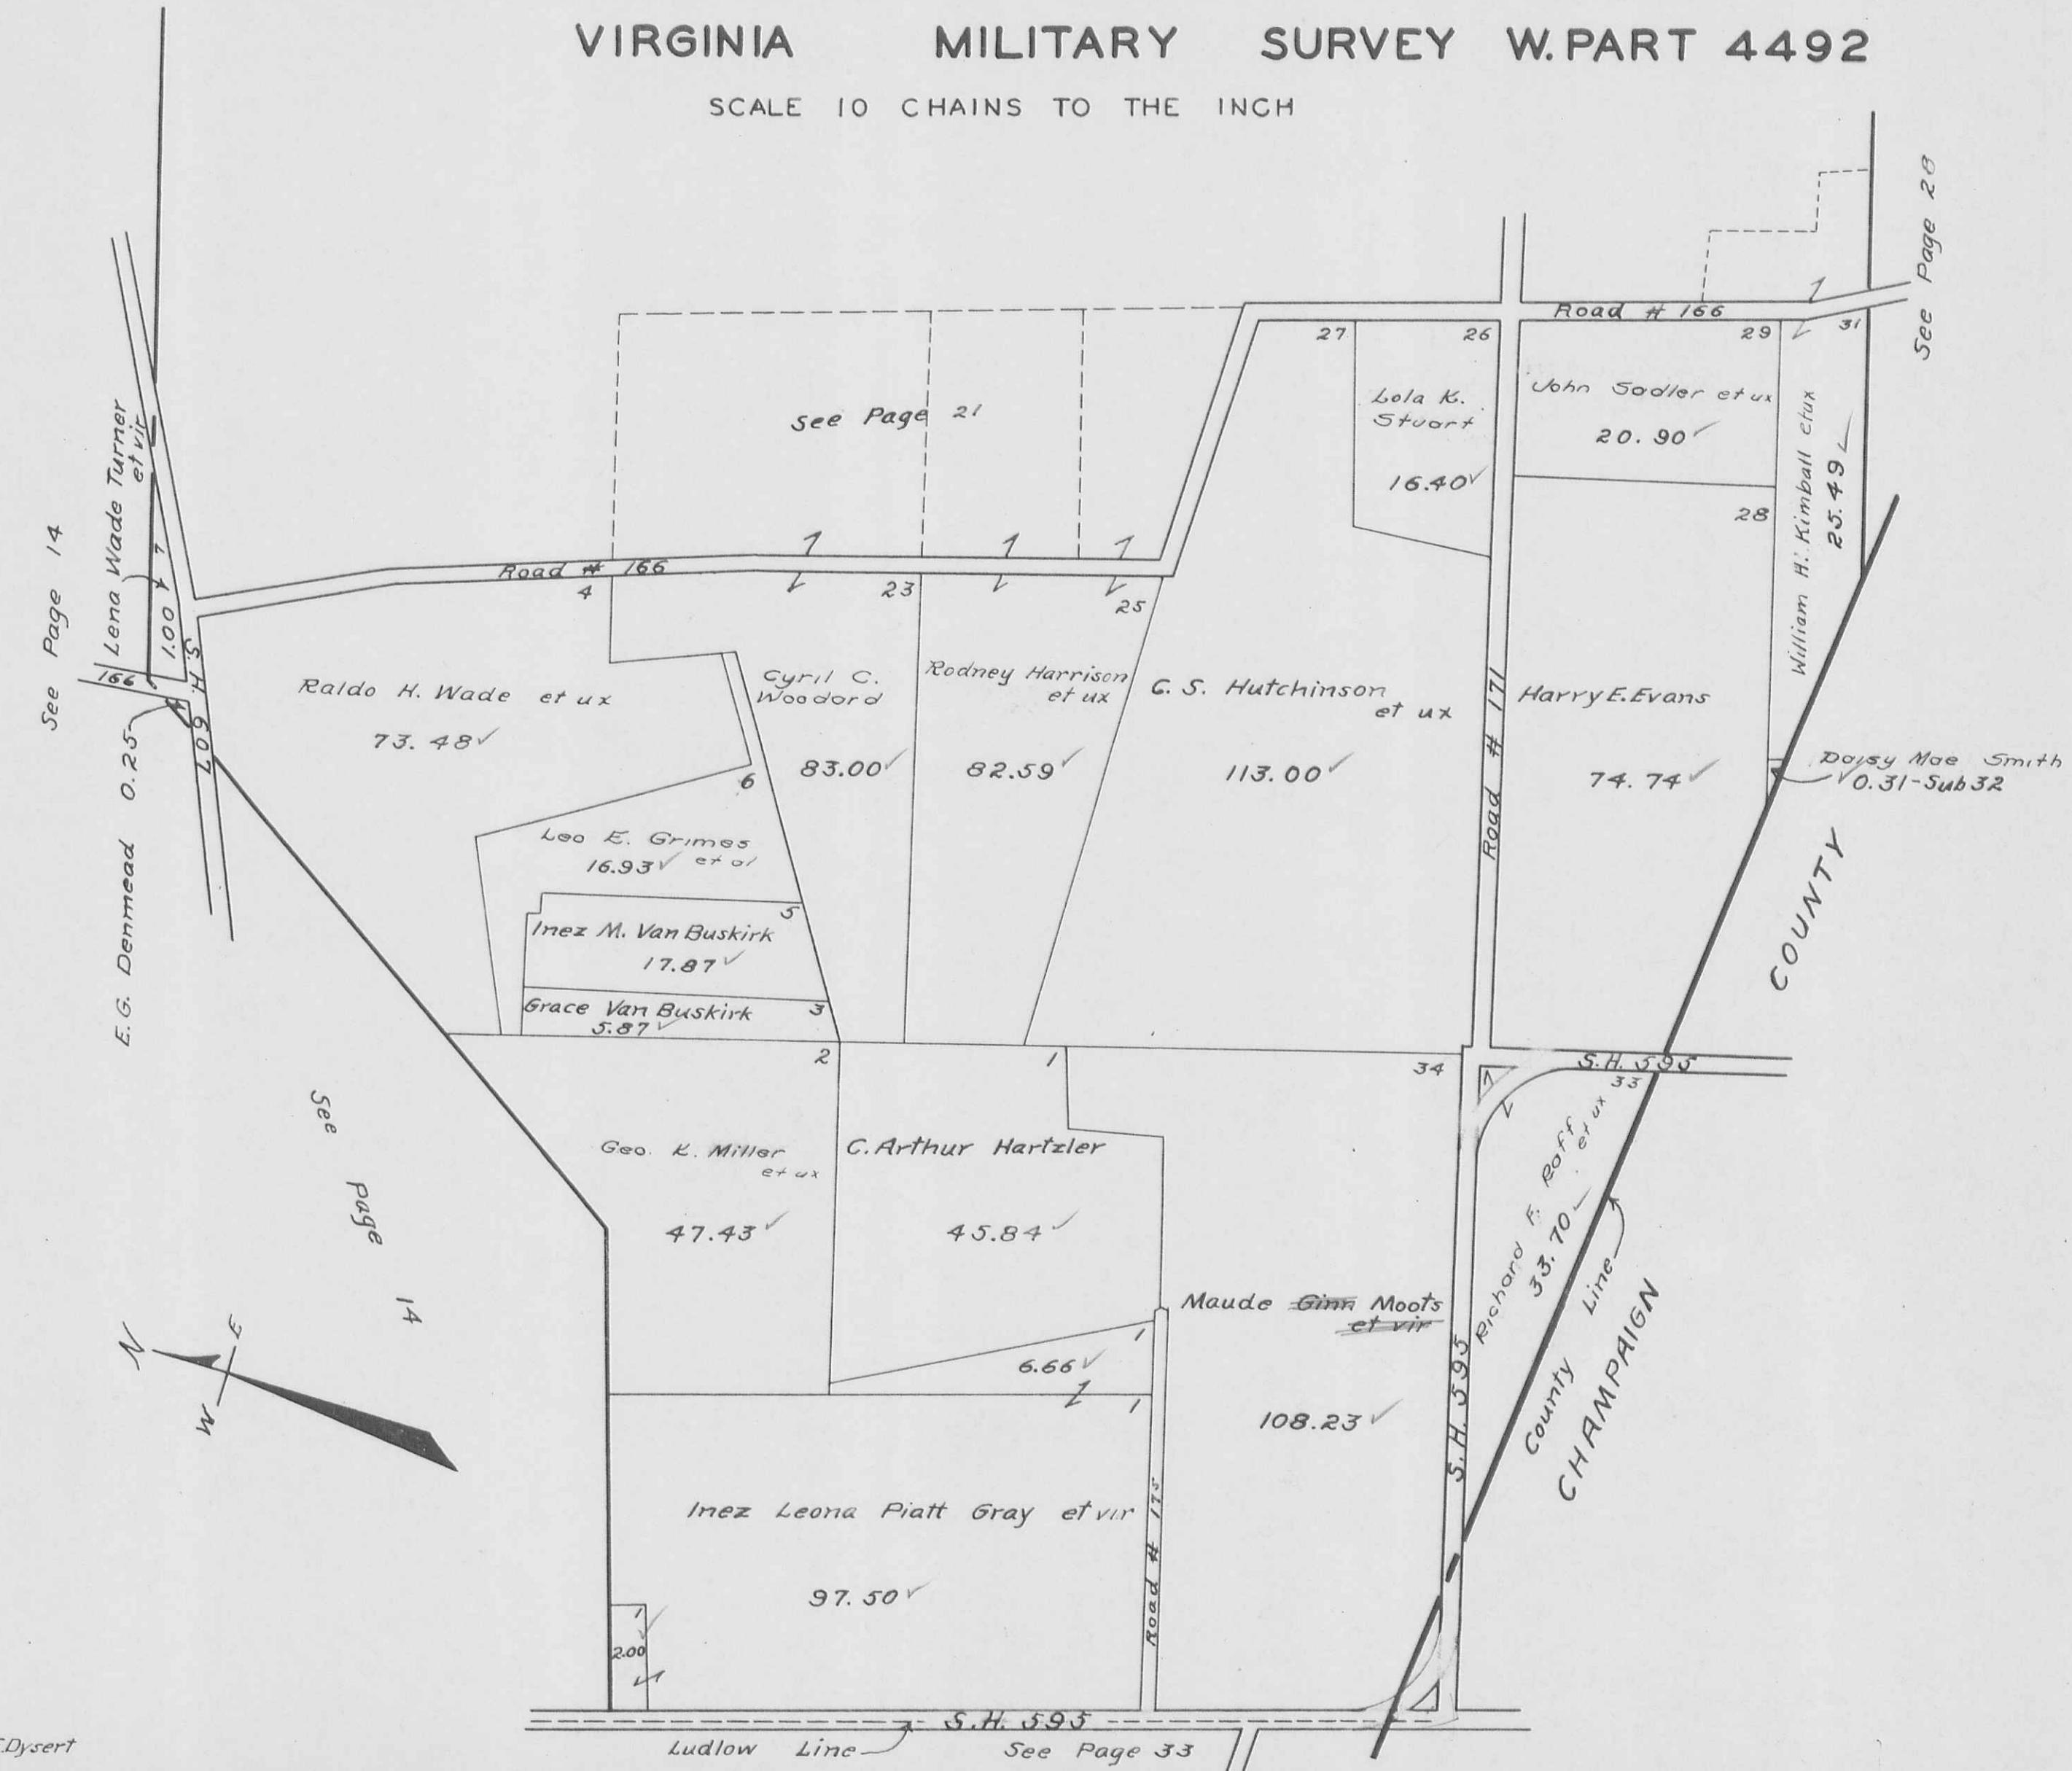


## VIRGINIA MILITARY SURVEY E.PART 4492

SCALE 10 CHAINS TO THE INCH



MONROE TOWNSHIP  
VIRGINIA MILITARY SURVEY 3225

SCALE 10 CHAINS TO THE INCH

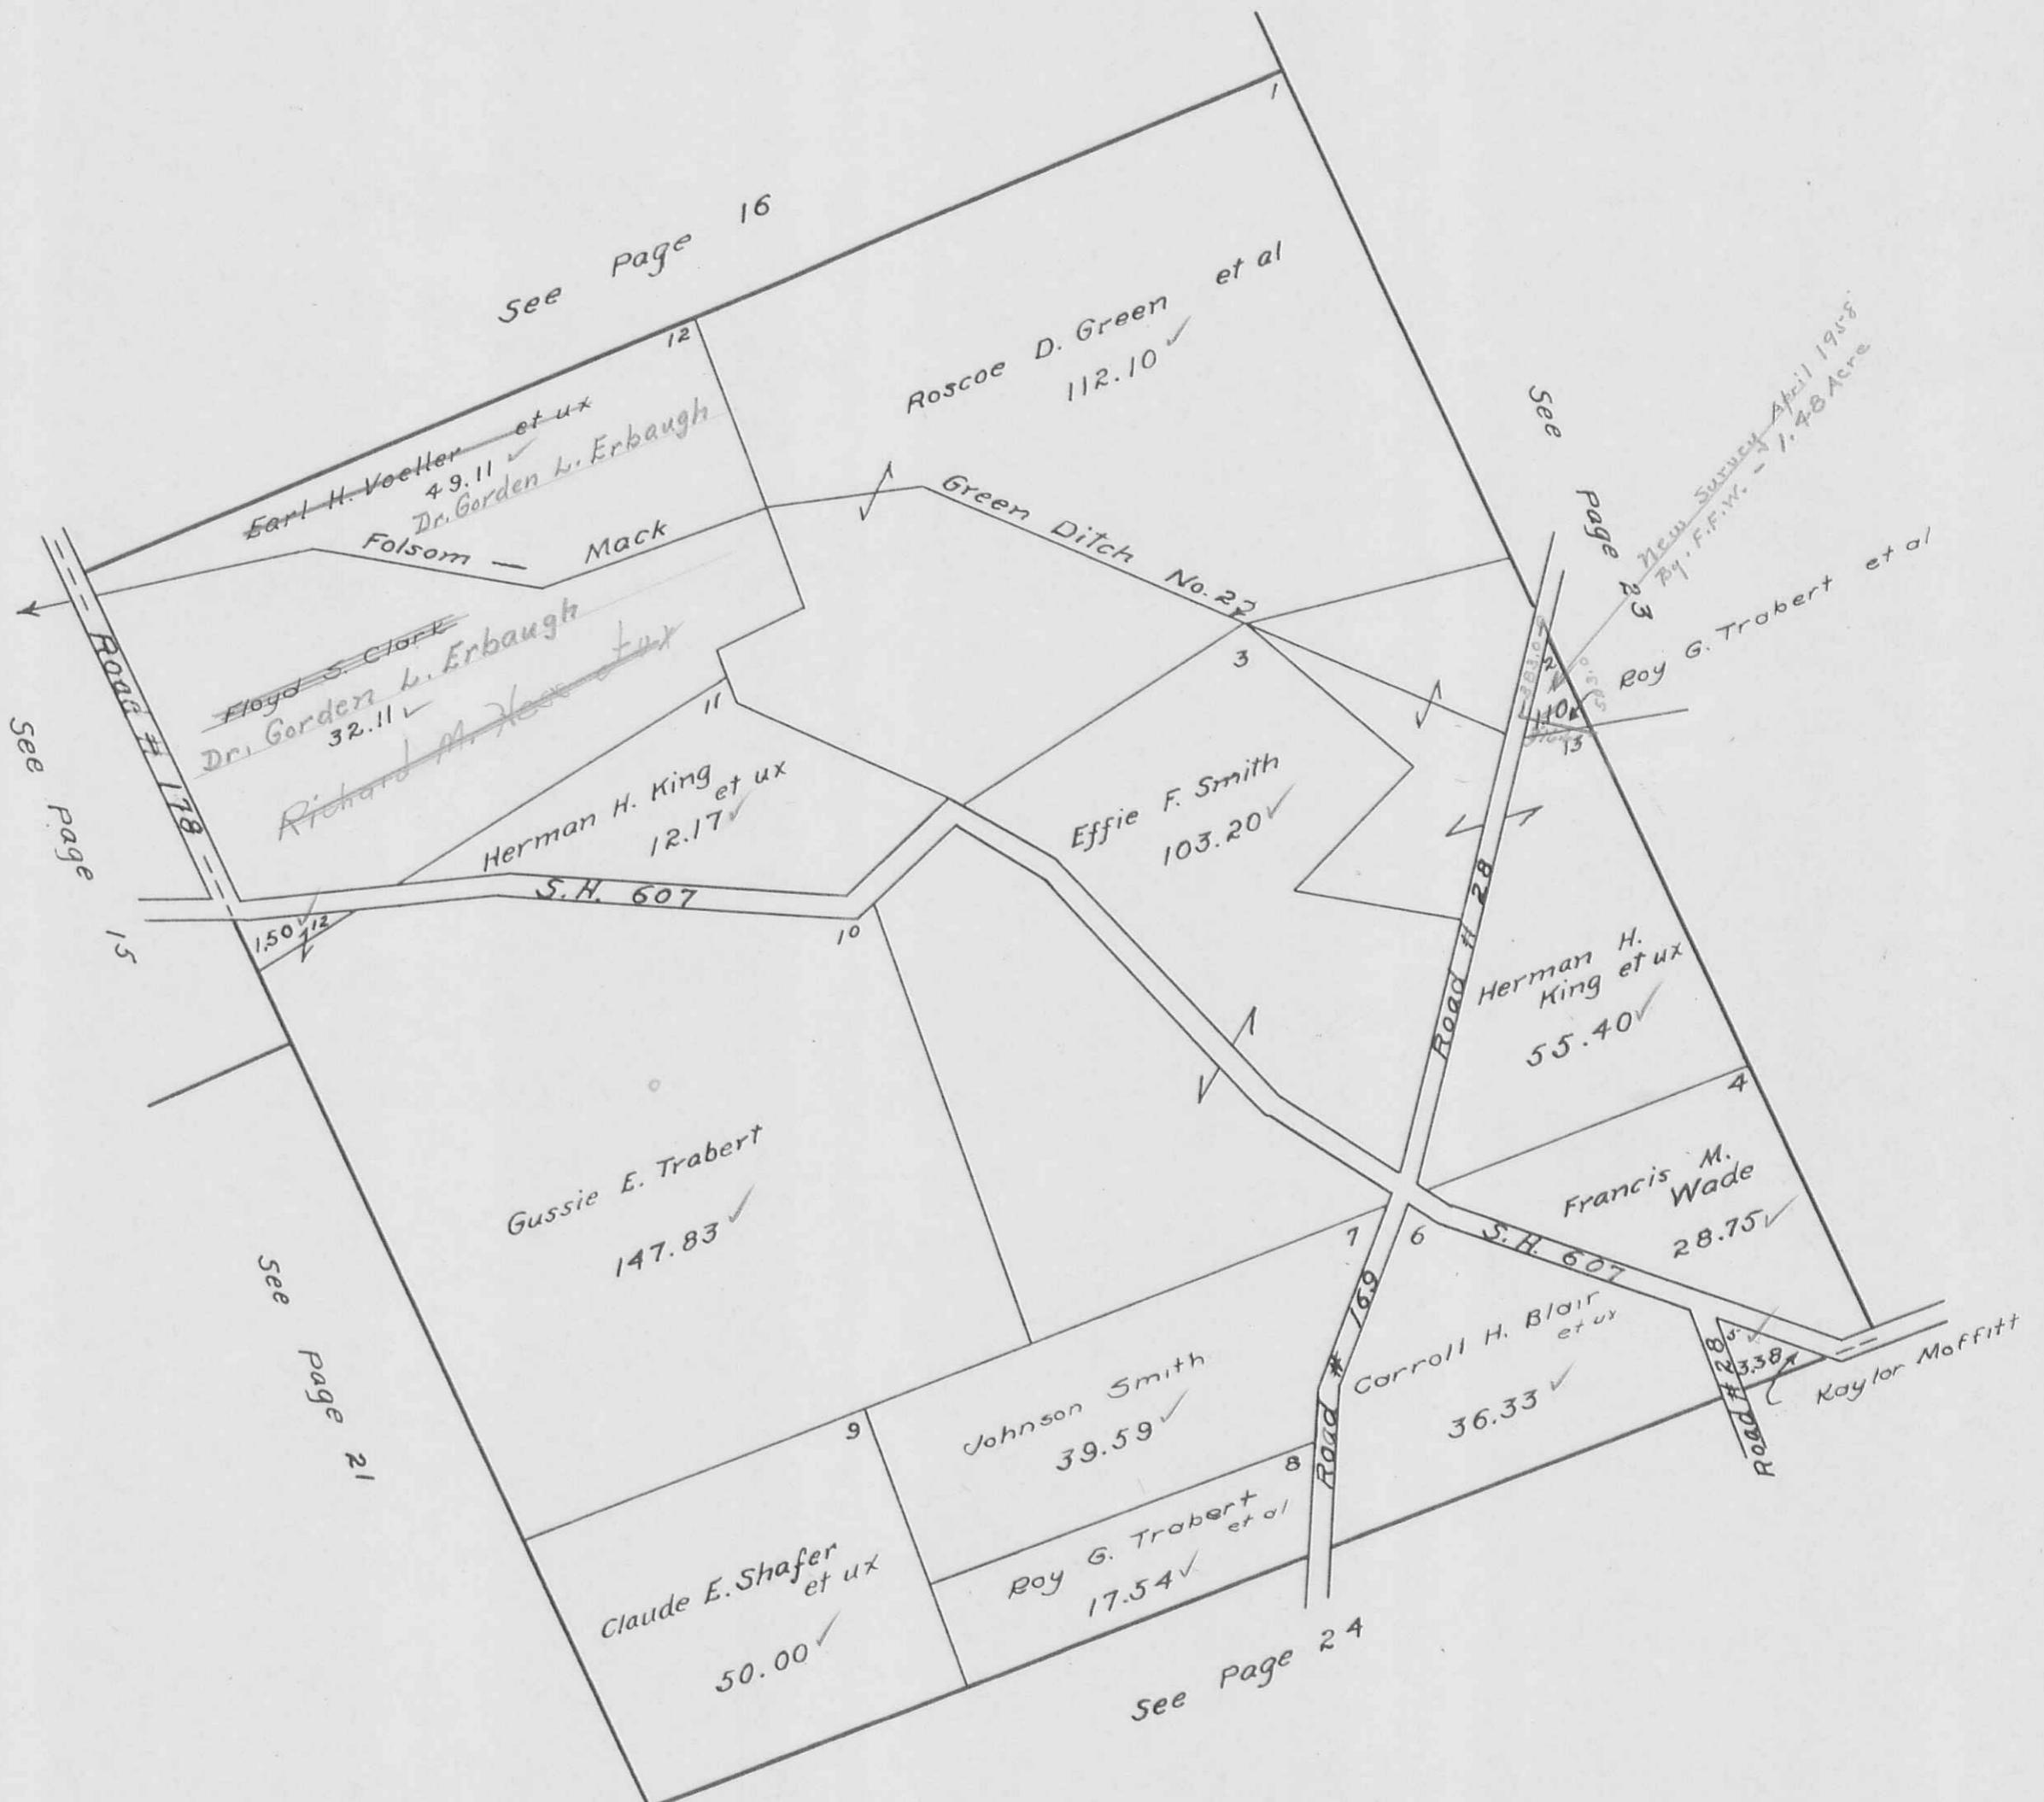

## VIRGINIA MILITARY SURVEY 3226

SCALE 10 CHAINS TO THE INCH



MONROE TOWNSHIP  
VIRGINIA MILITARY SURVEY 3227

SCALE 10 CHAINS TO THE INCH

PAGE 24 ✓



## VIRGINIA MILITARY SURVEYS

SCALE 10 CHAINS TO THE INCH

3228


9679



MONROE TOWNSHIP  
VIRGINIA MILITARY SURVEY 3229


SCALE 10 CHAINS TO THE INCH

PAGE 26 ✓

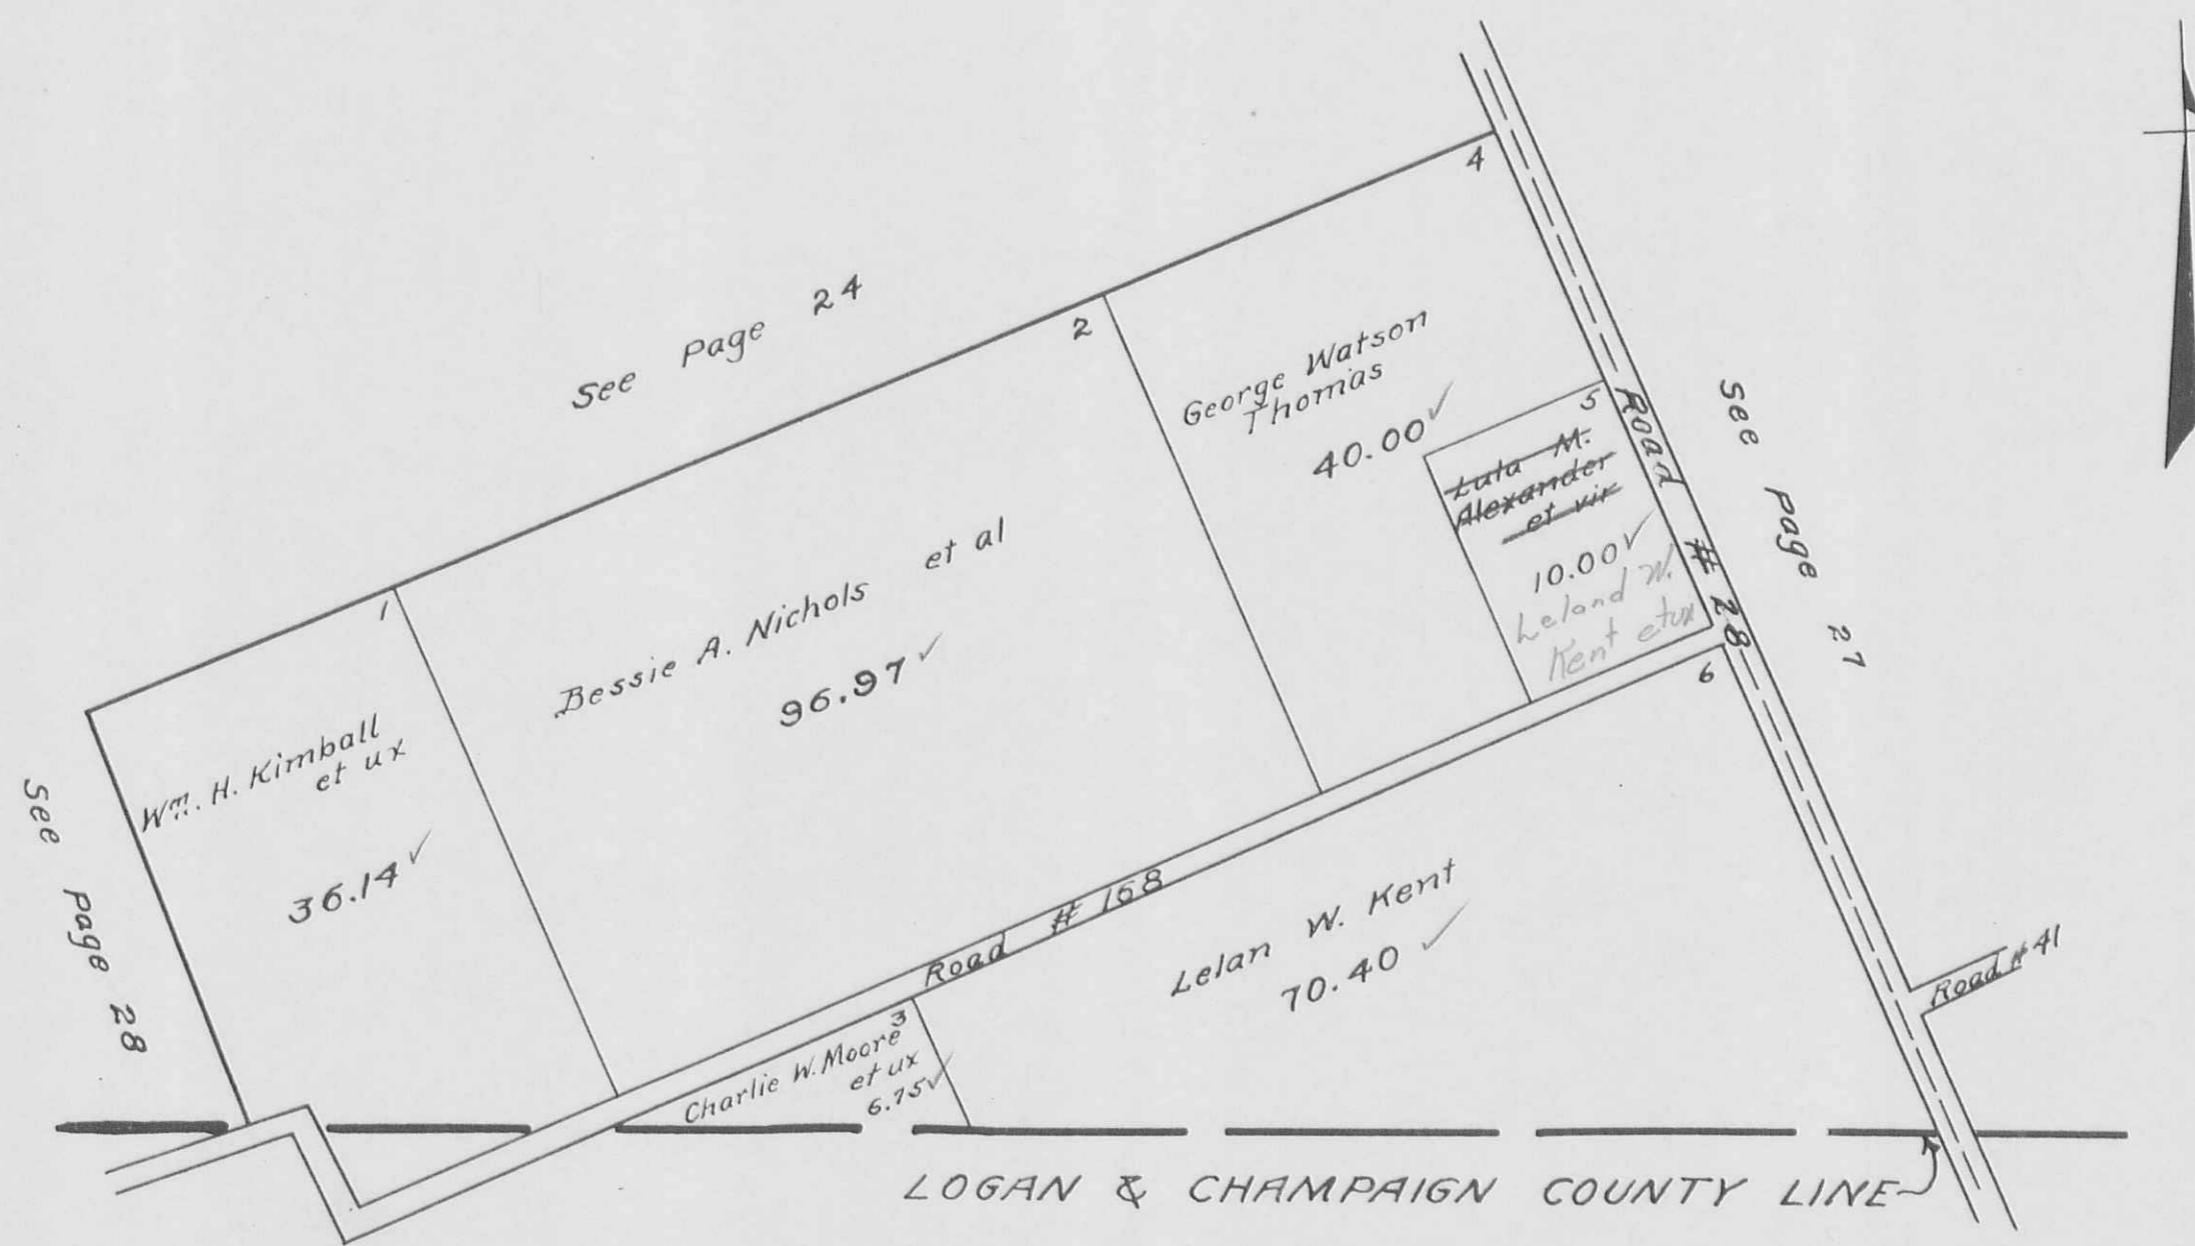

## VIRGINIA MILITARY SURVEY 3230

SCALE 10 CHAINS TO THE INCH

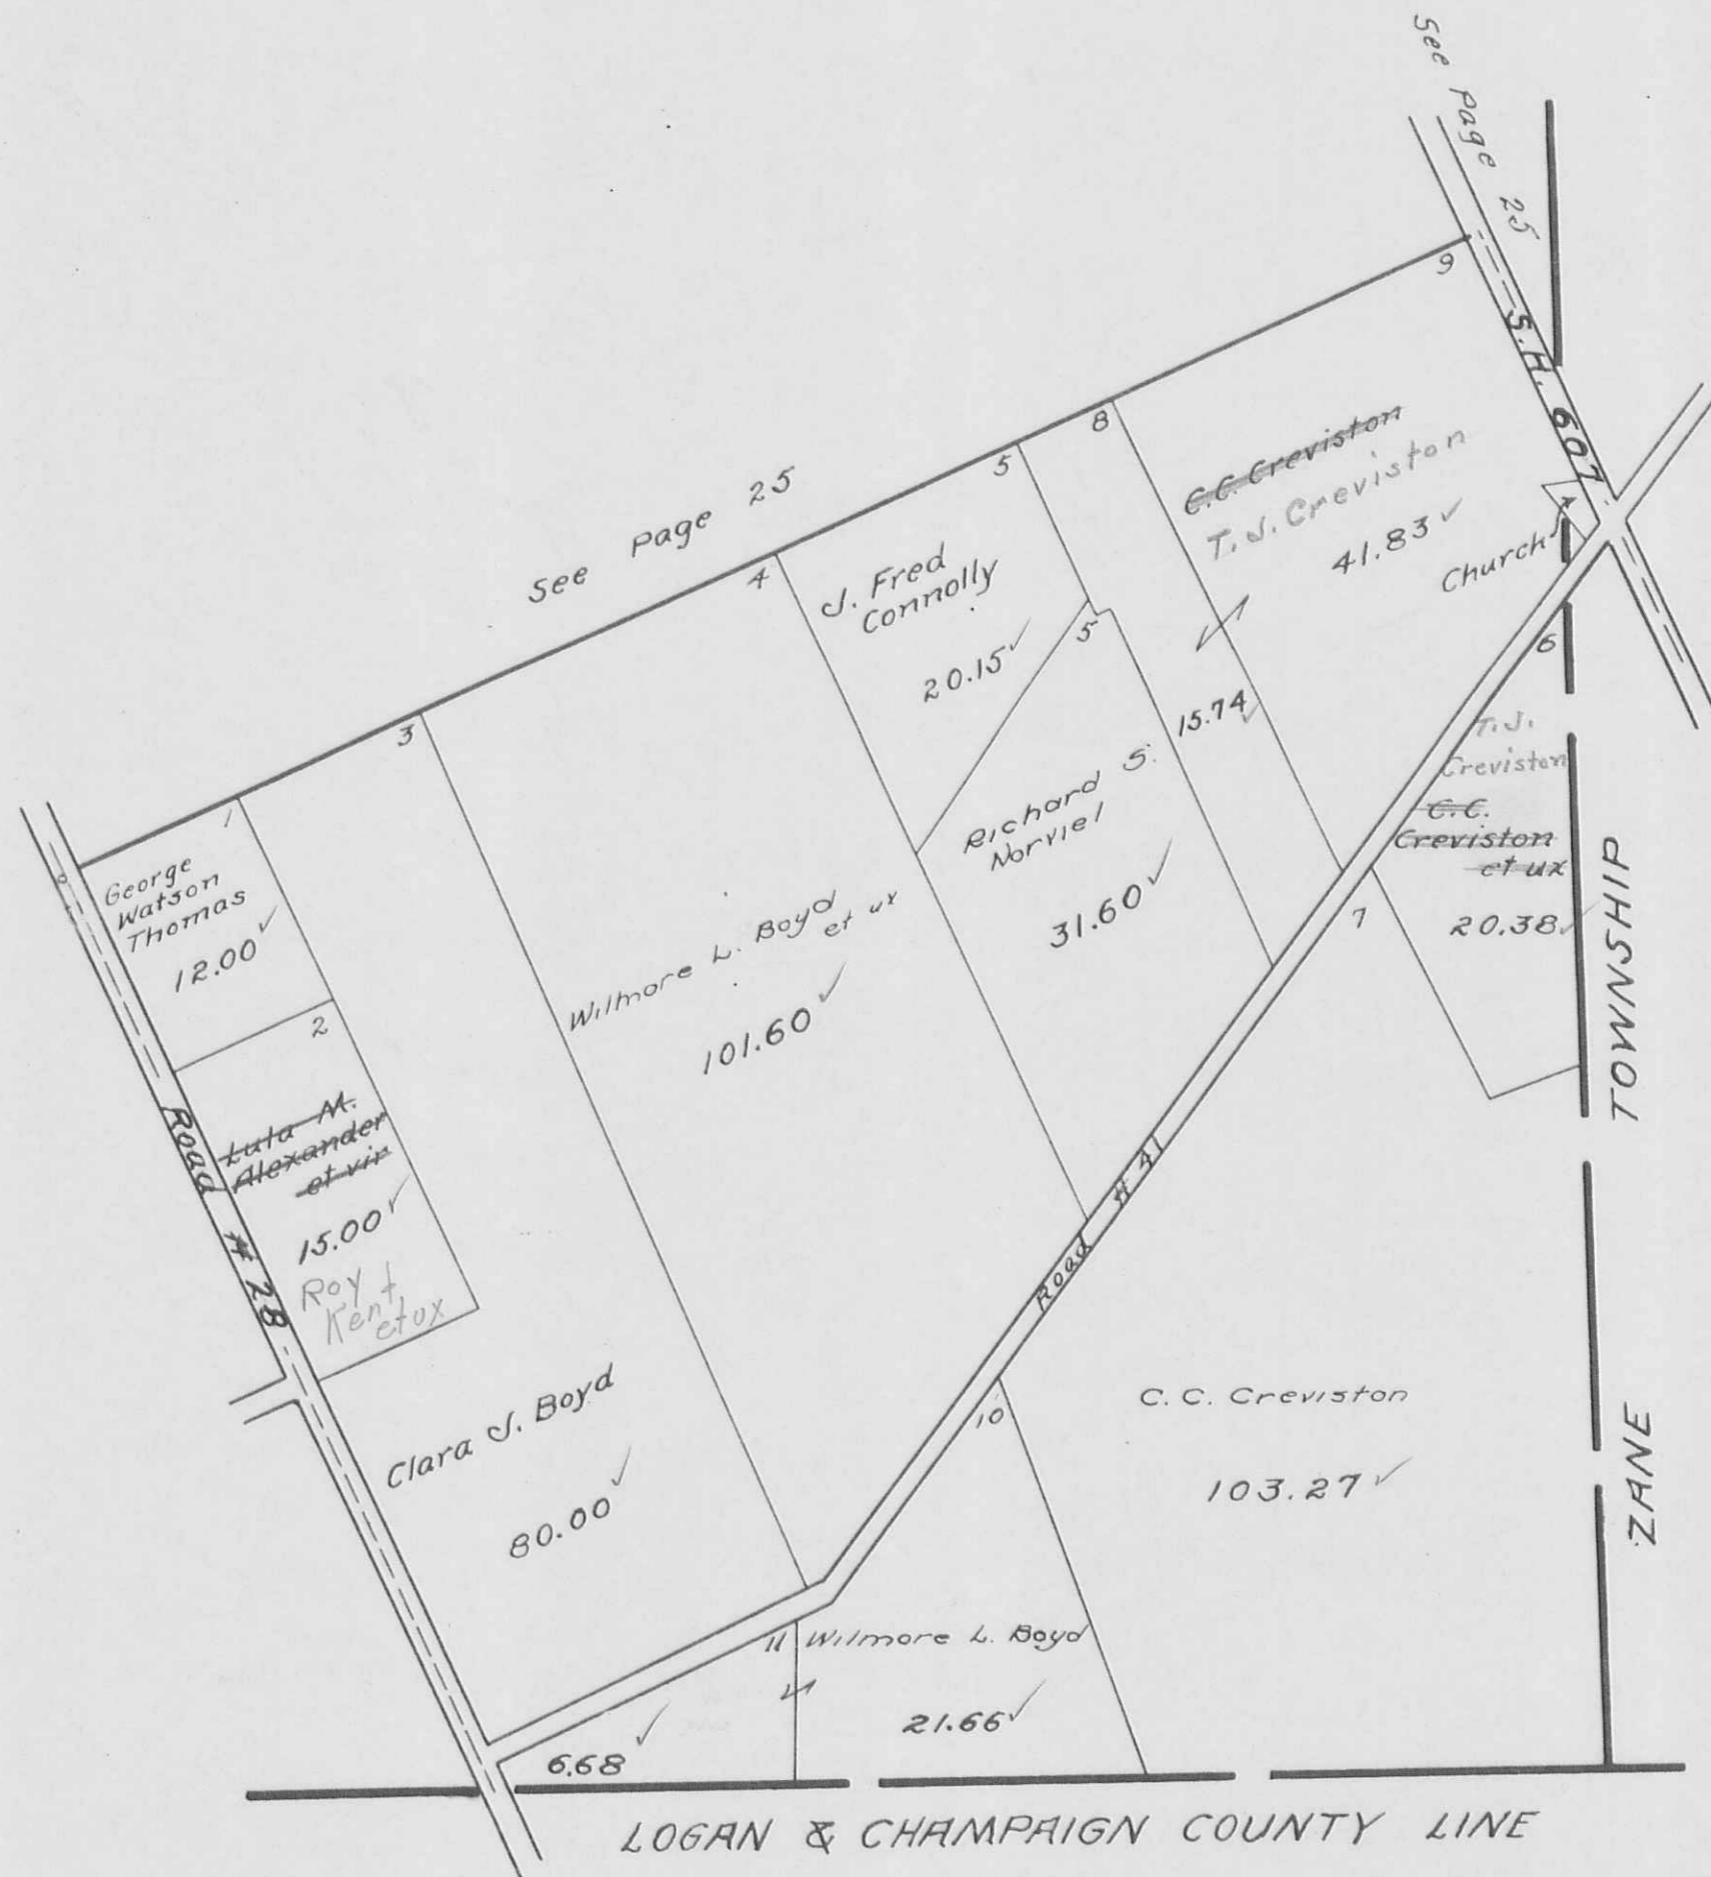

MONROE

TOWNSHIP


PAGE 28

VIRGINIA

MILITARY SURVEYS

5042  
5044


SCALE 10 CHAINS TO THE INCH

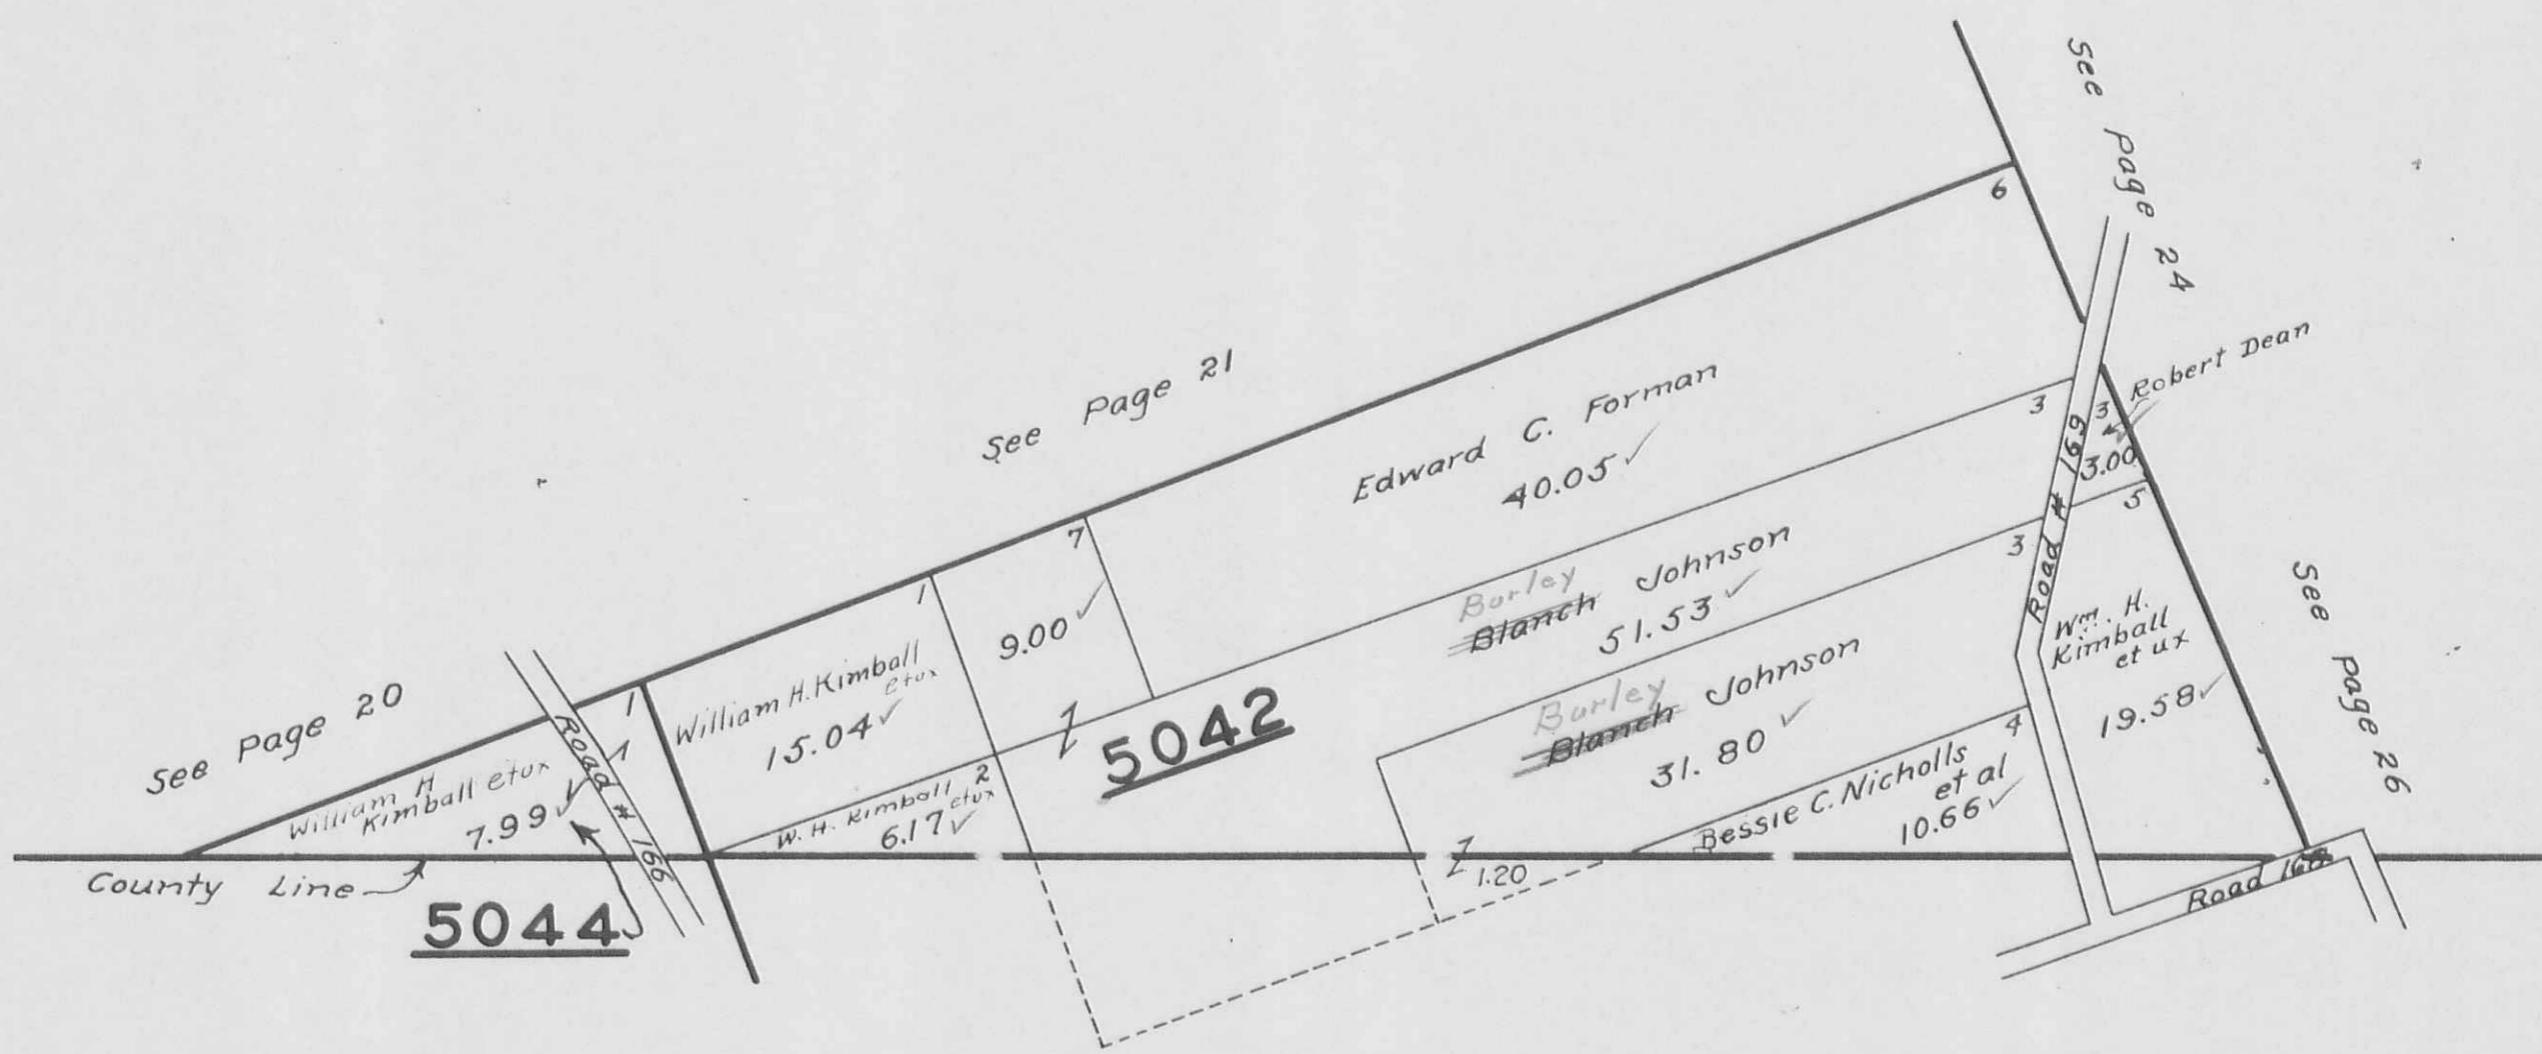

MONROE TOWNSHIP  
 SECTION 19 TOWN 4 RANGE 14  
 SECTION 24 TOWN 5 RANGE 13


PAGE 29

SCALE 10 CHAINS TO THE INCH

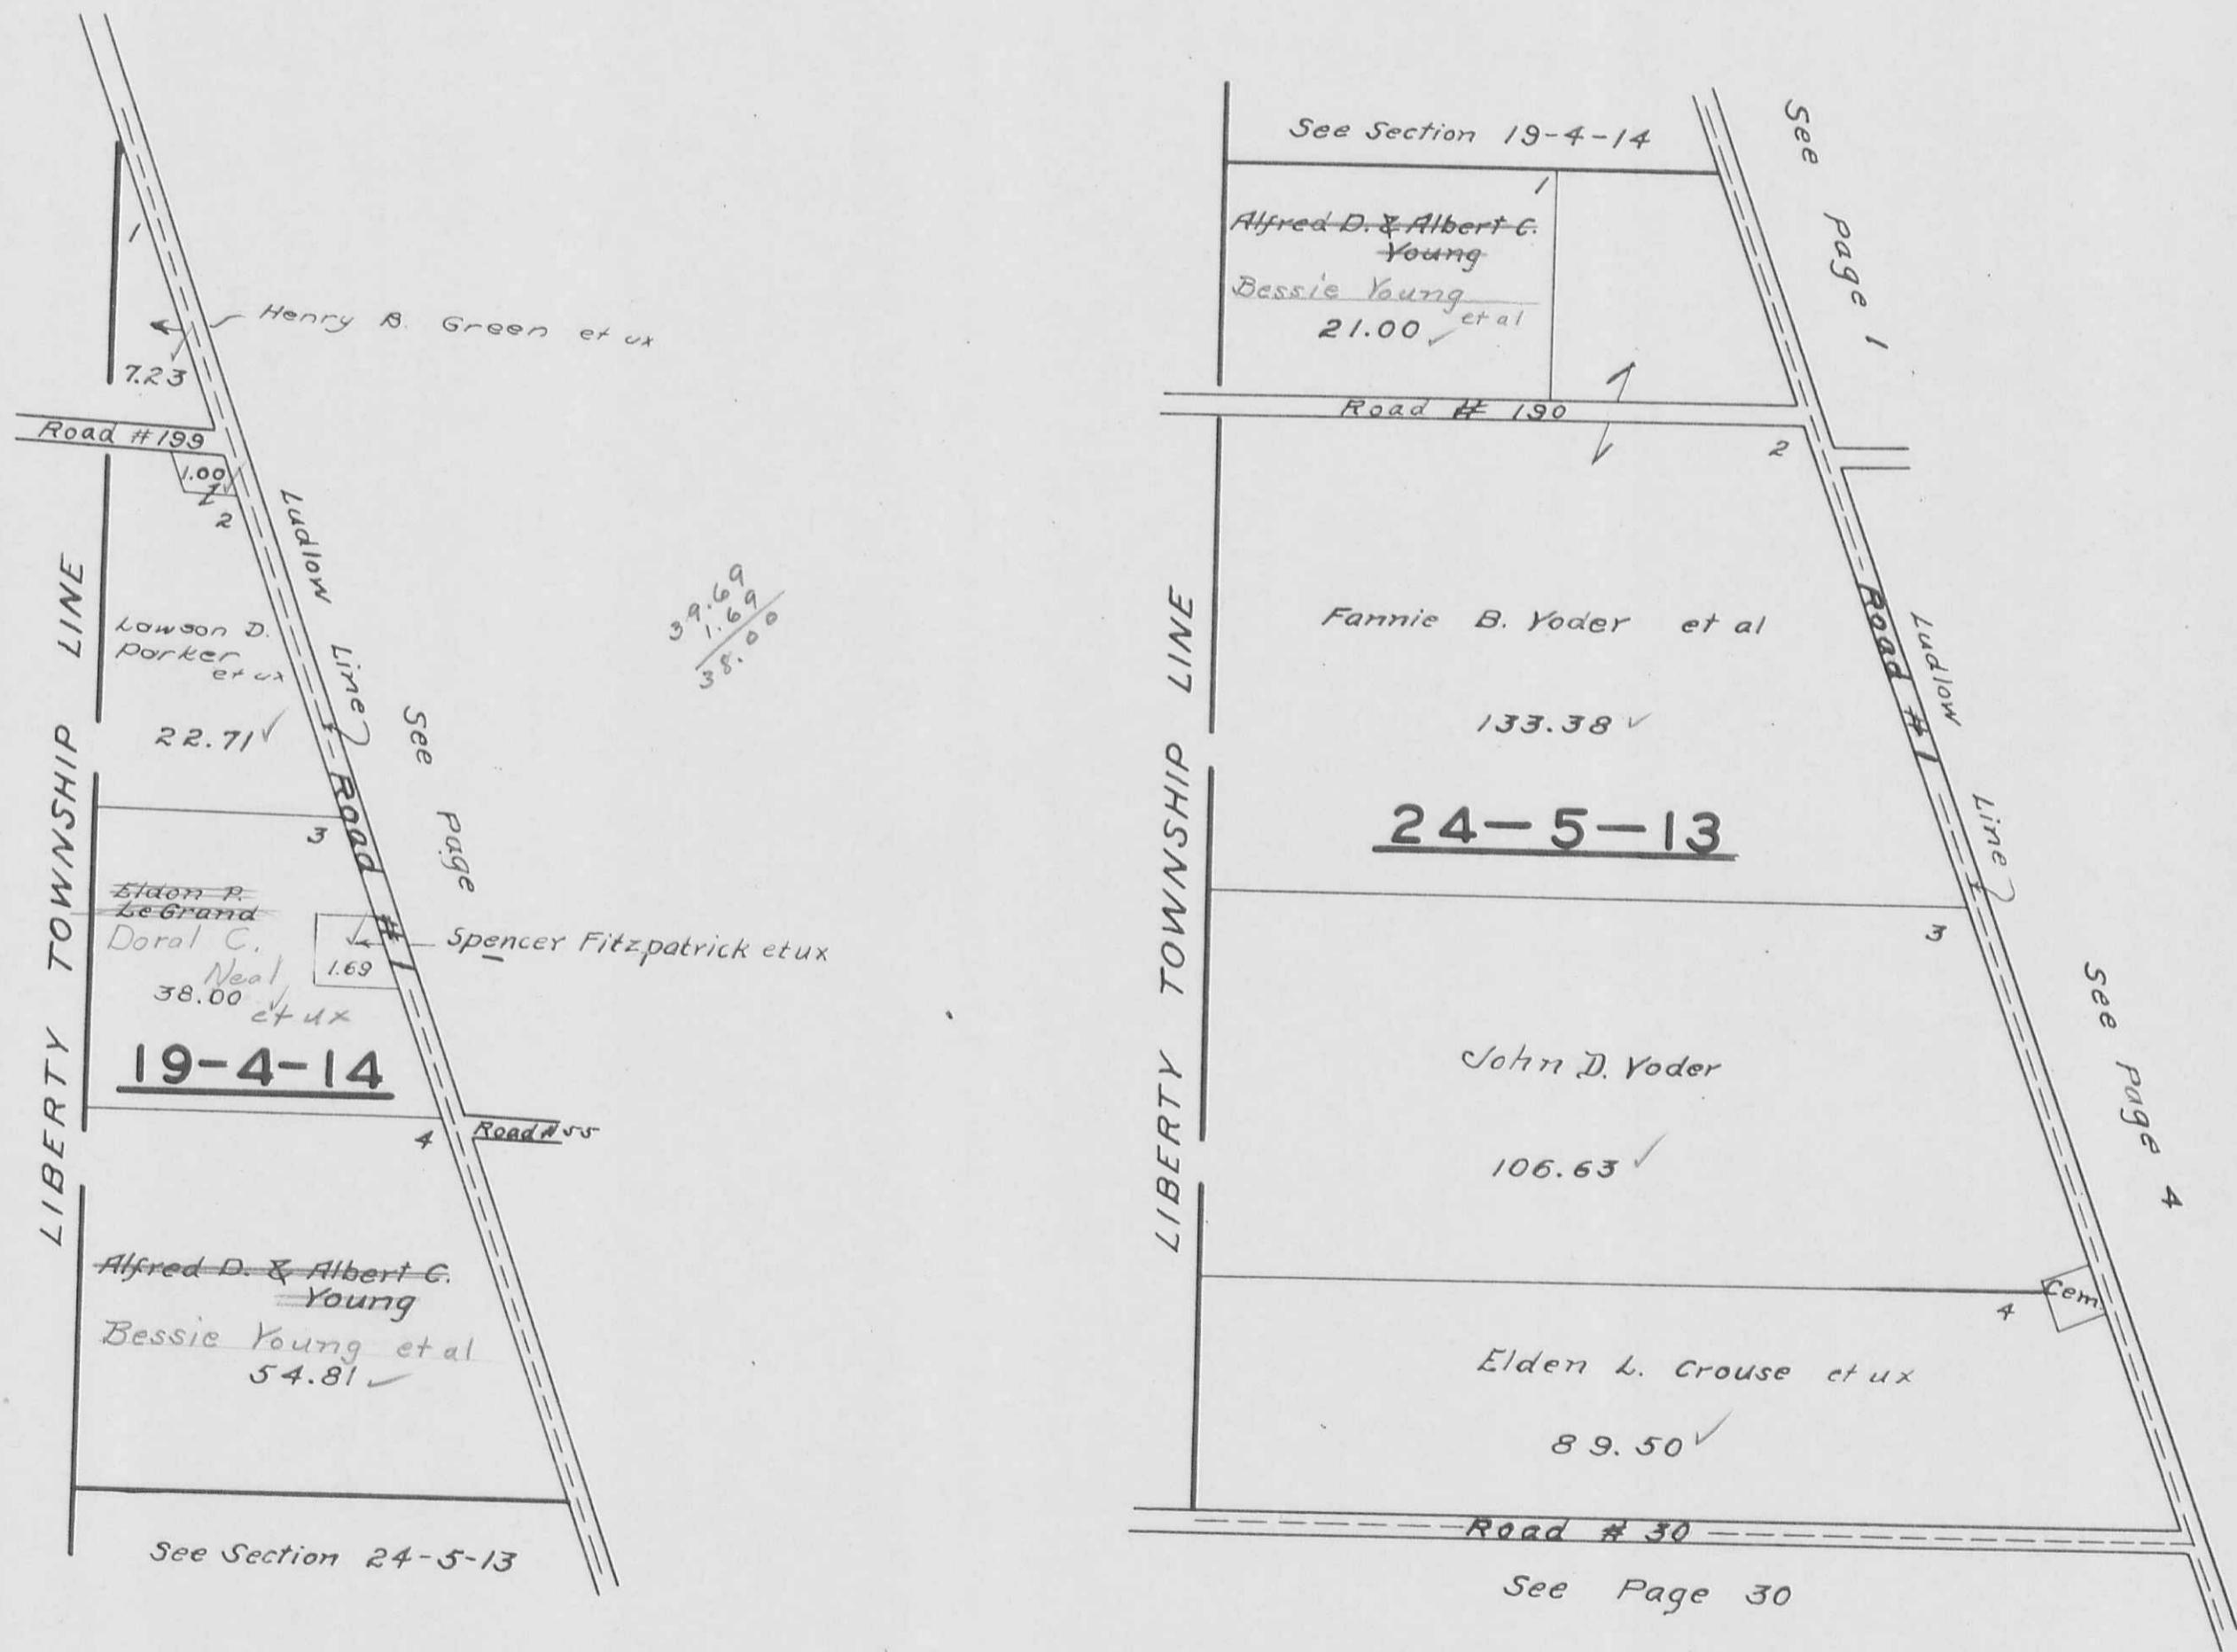

SECTION 17 TOWN 5 RANGE 13  
SECTION 23 TOWN 5 RANGE 13

SCALE 10 CHAINS TO THE INCH

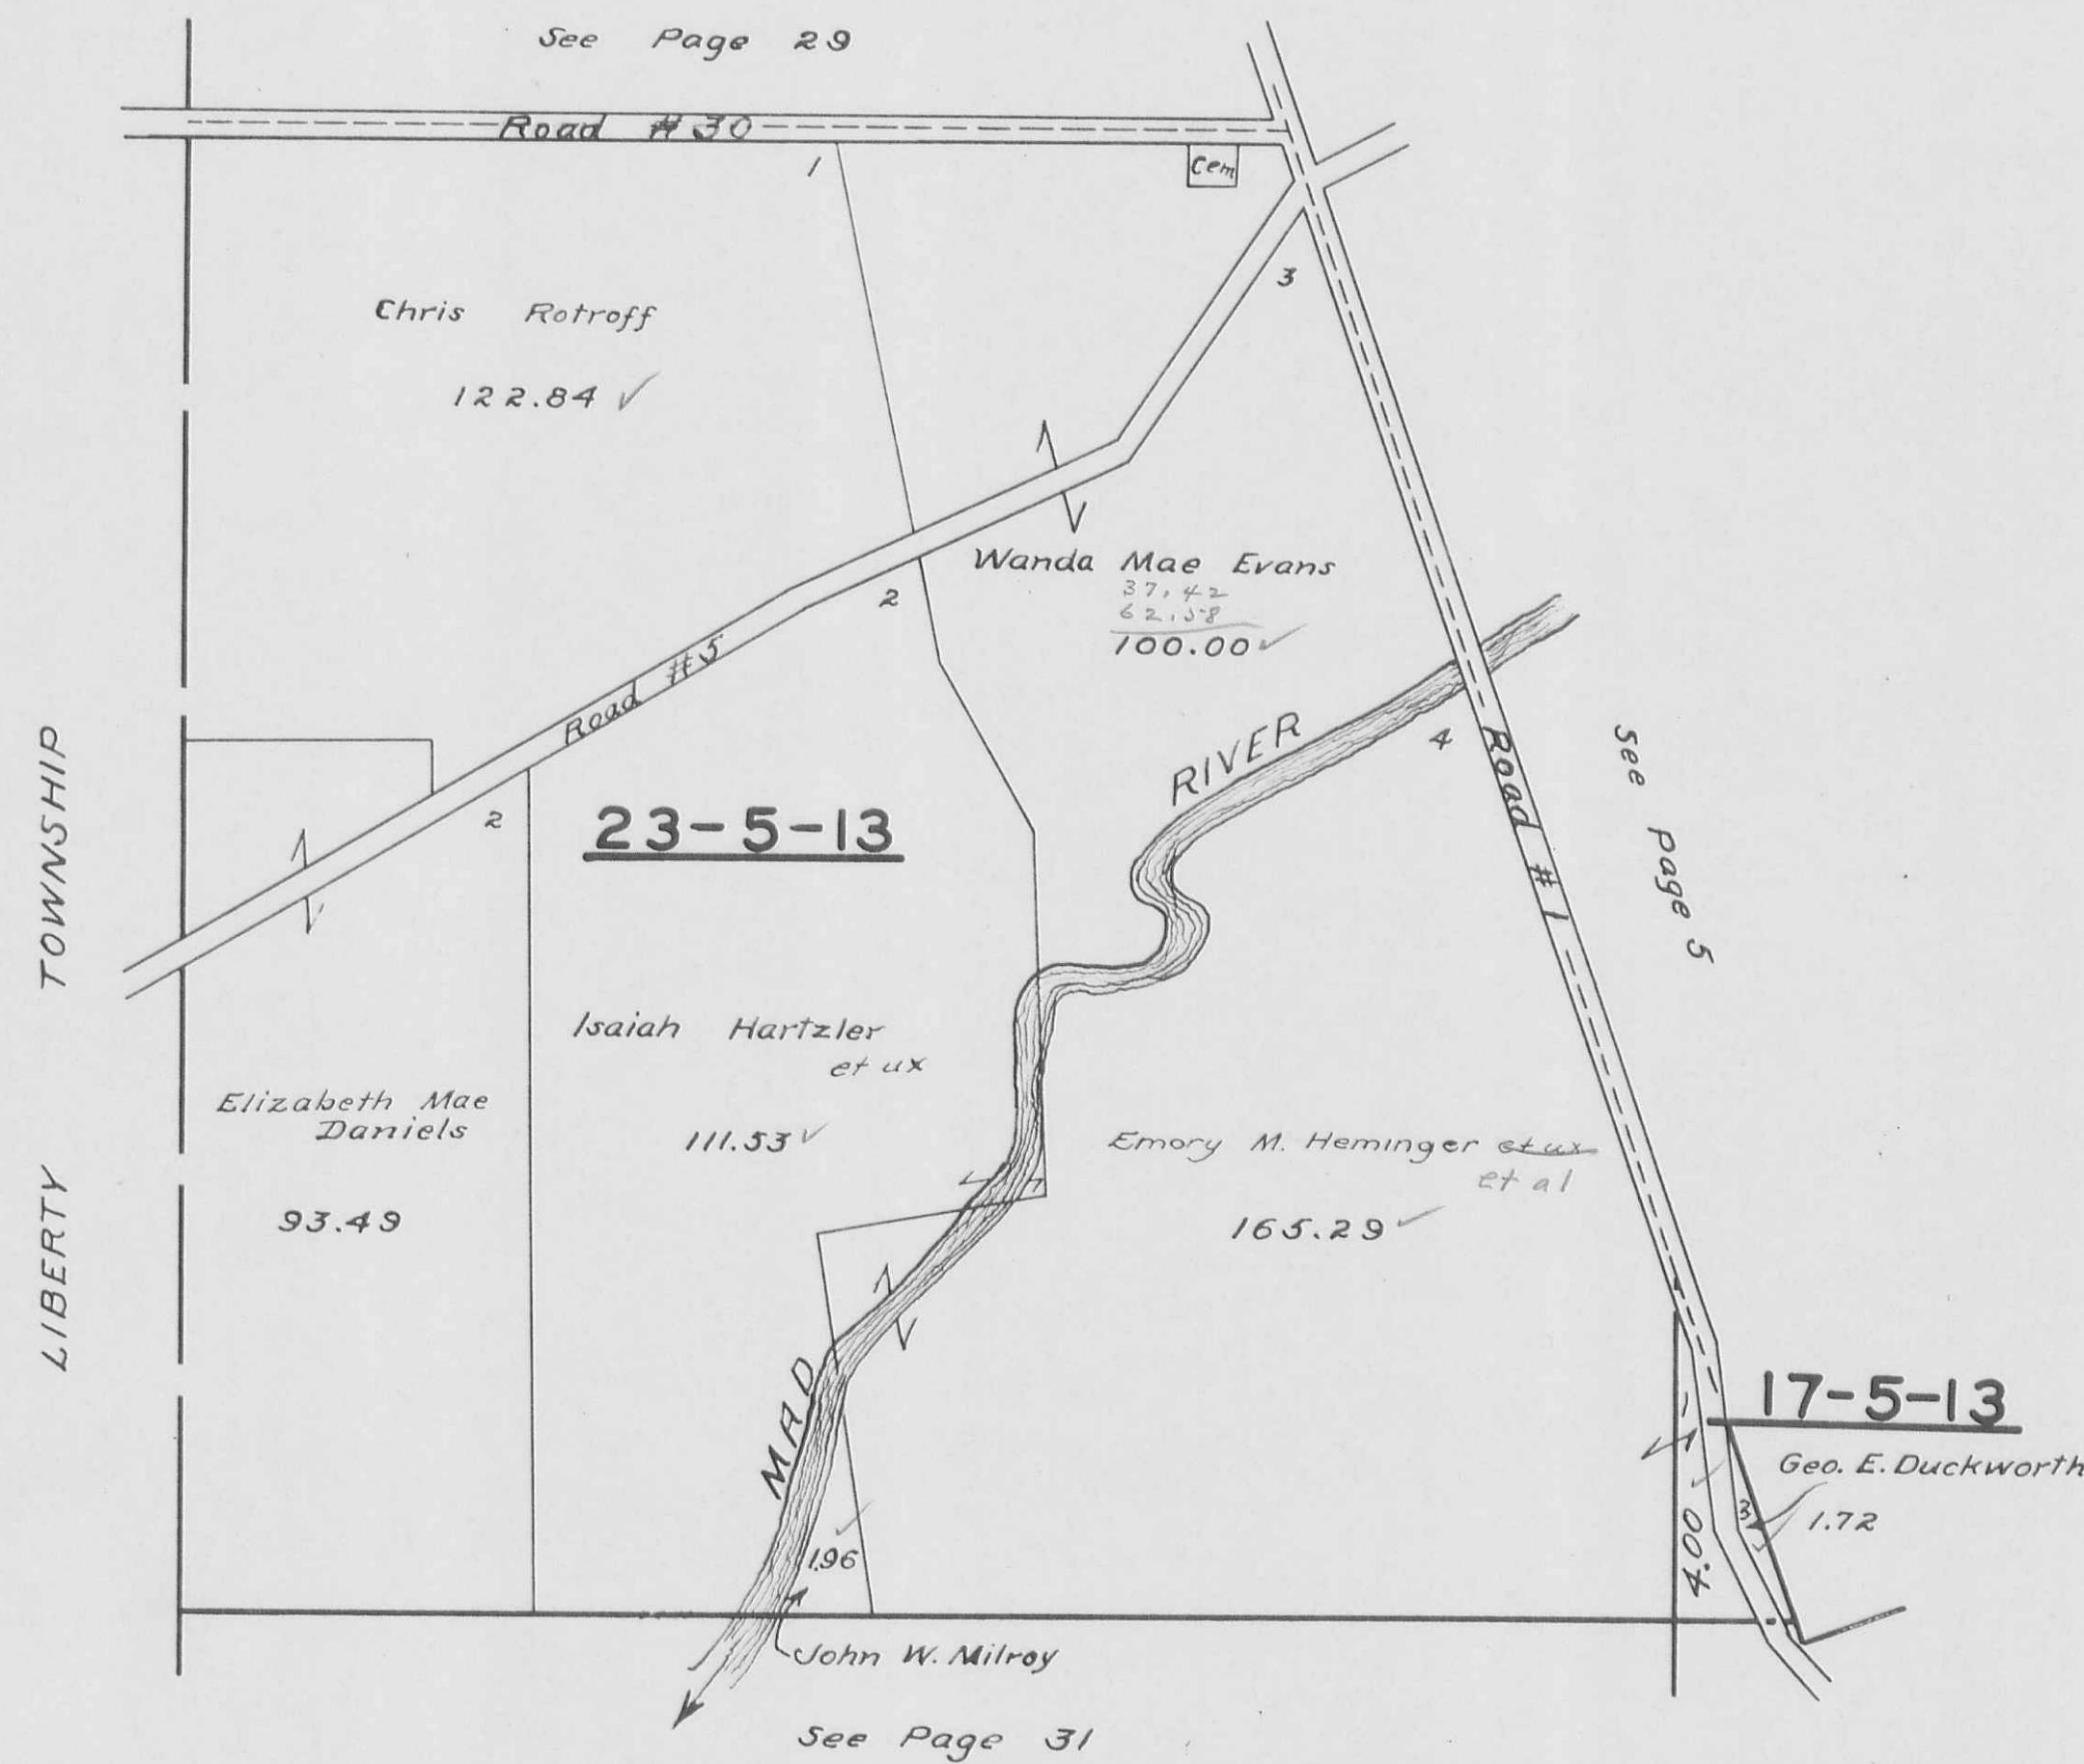

# MONROE TOWNSHIP

PAGE 31

SECTION 22 TOWN 5 RANGE 13  
SECTION 16 TOWN 5 RANGE 13


SCALE 10 CHAINS TO THE INCH



MONROE TOWNSHIP  
SECTION 21 TOWN 5 RANGE 13

PAGE 32


SCALE 10 CHAINS TO THE INCH

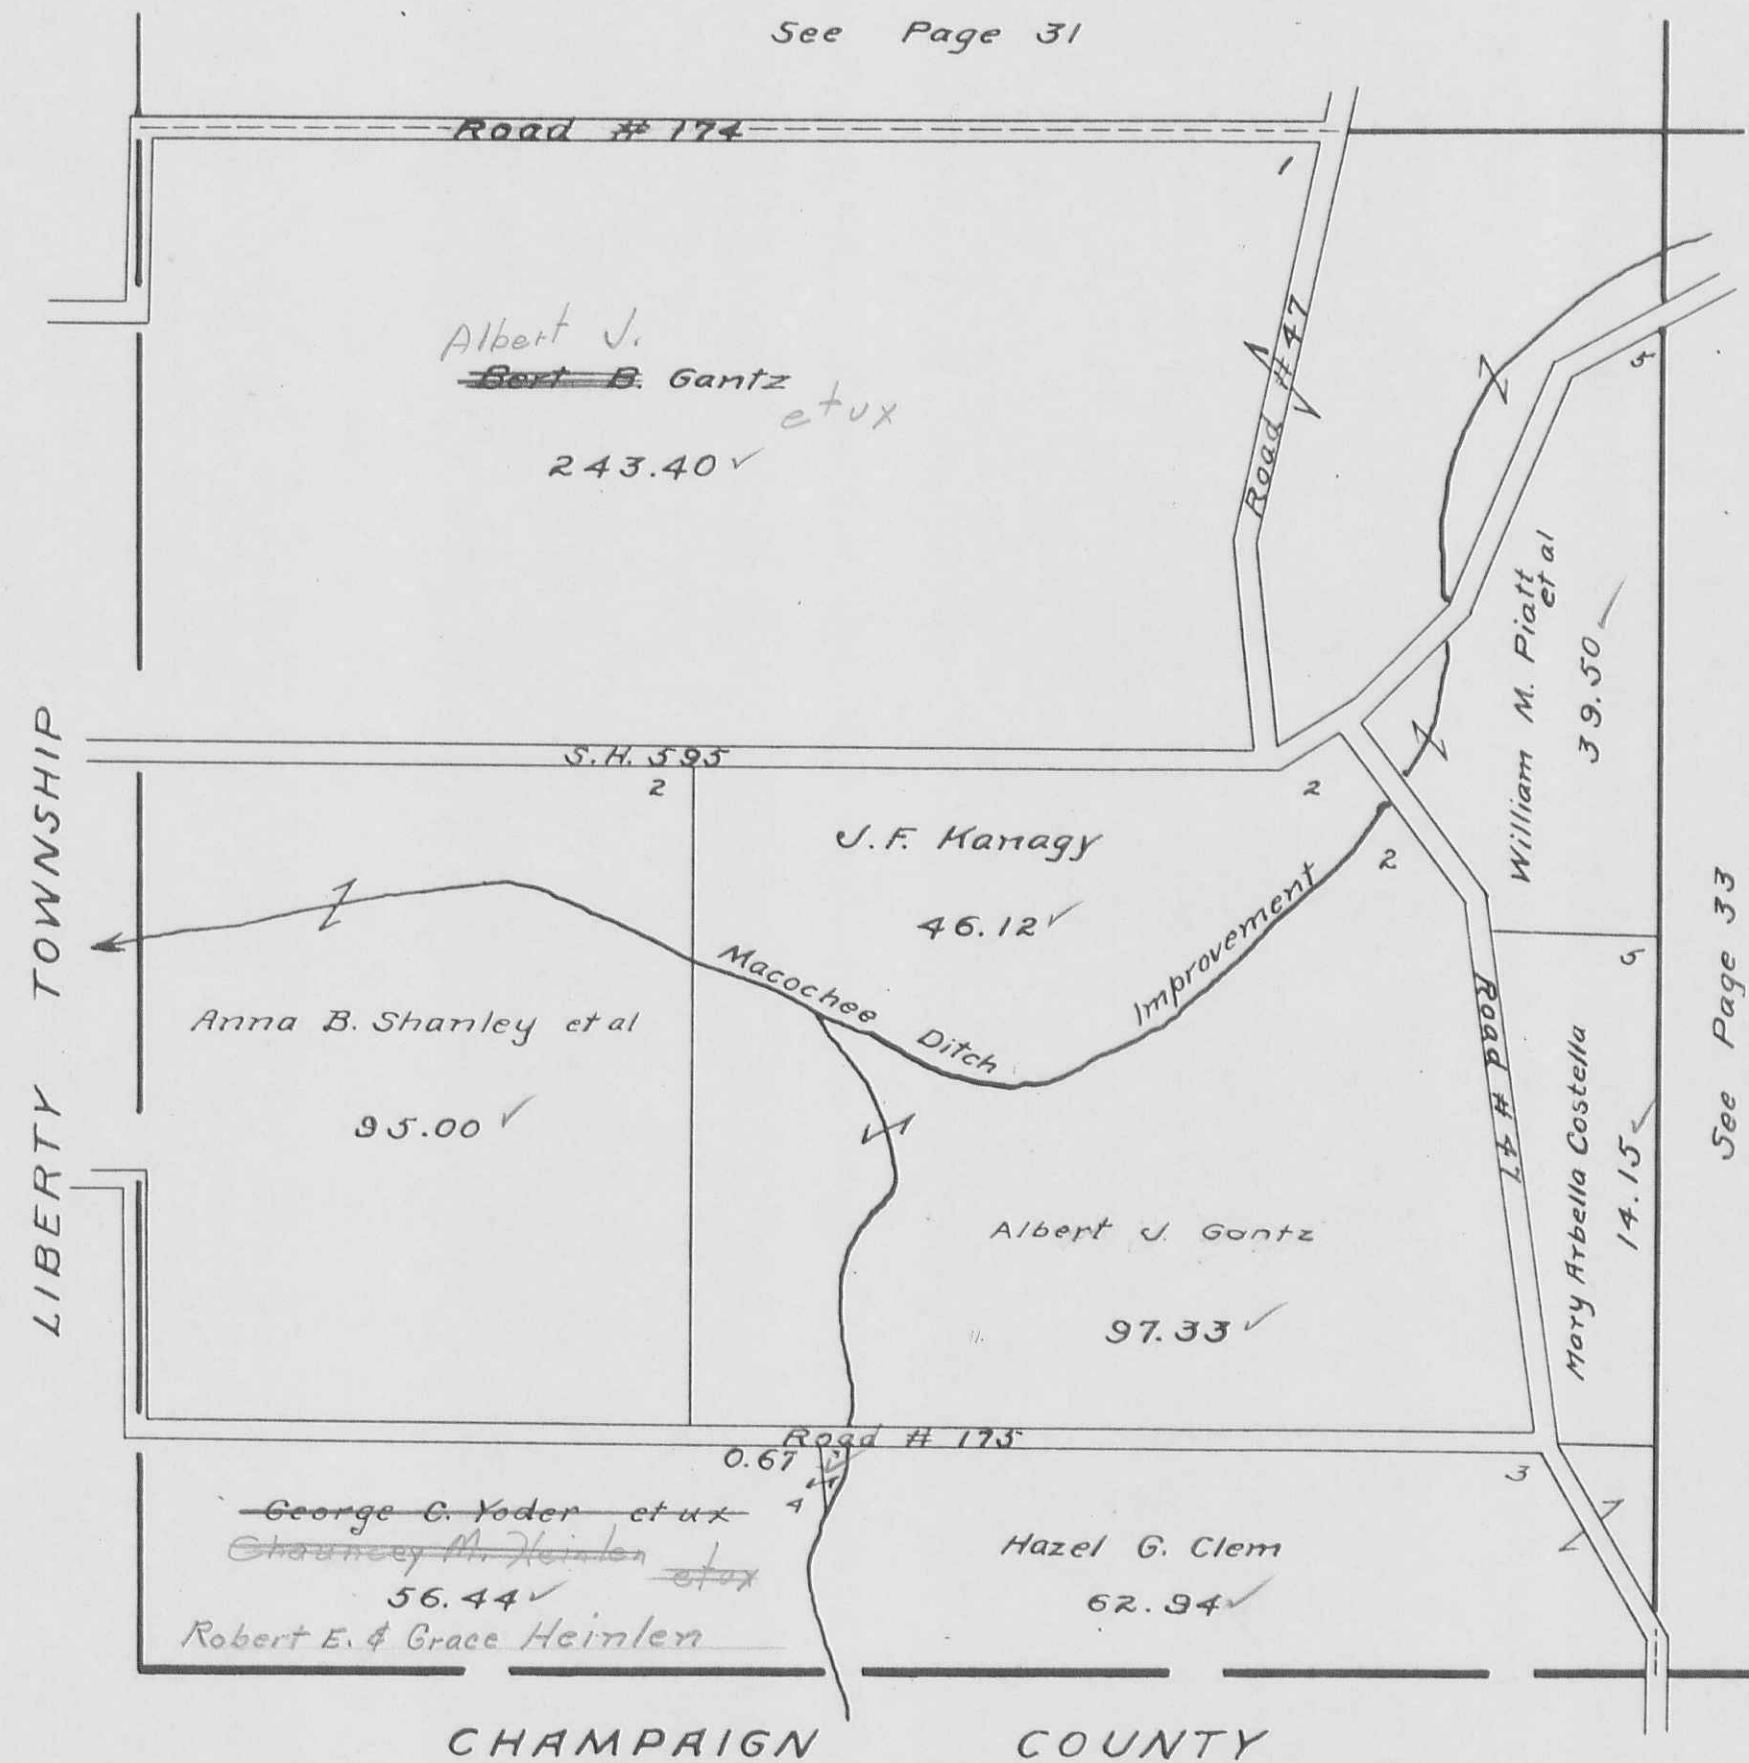

MONROE TOWNSHIP  
SECTION 15 TOWN 5 RANGE 13

PAGE 33

SCALE 10 CHAINS TO THE INCH

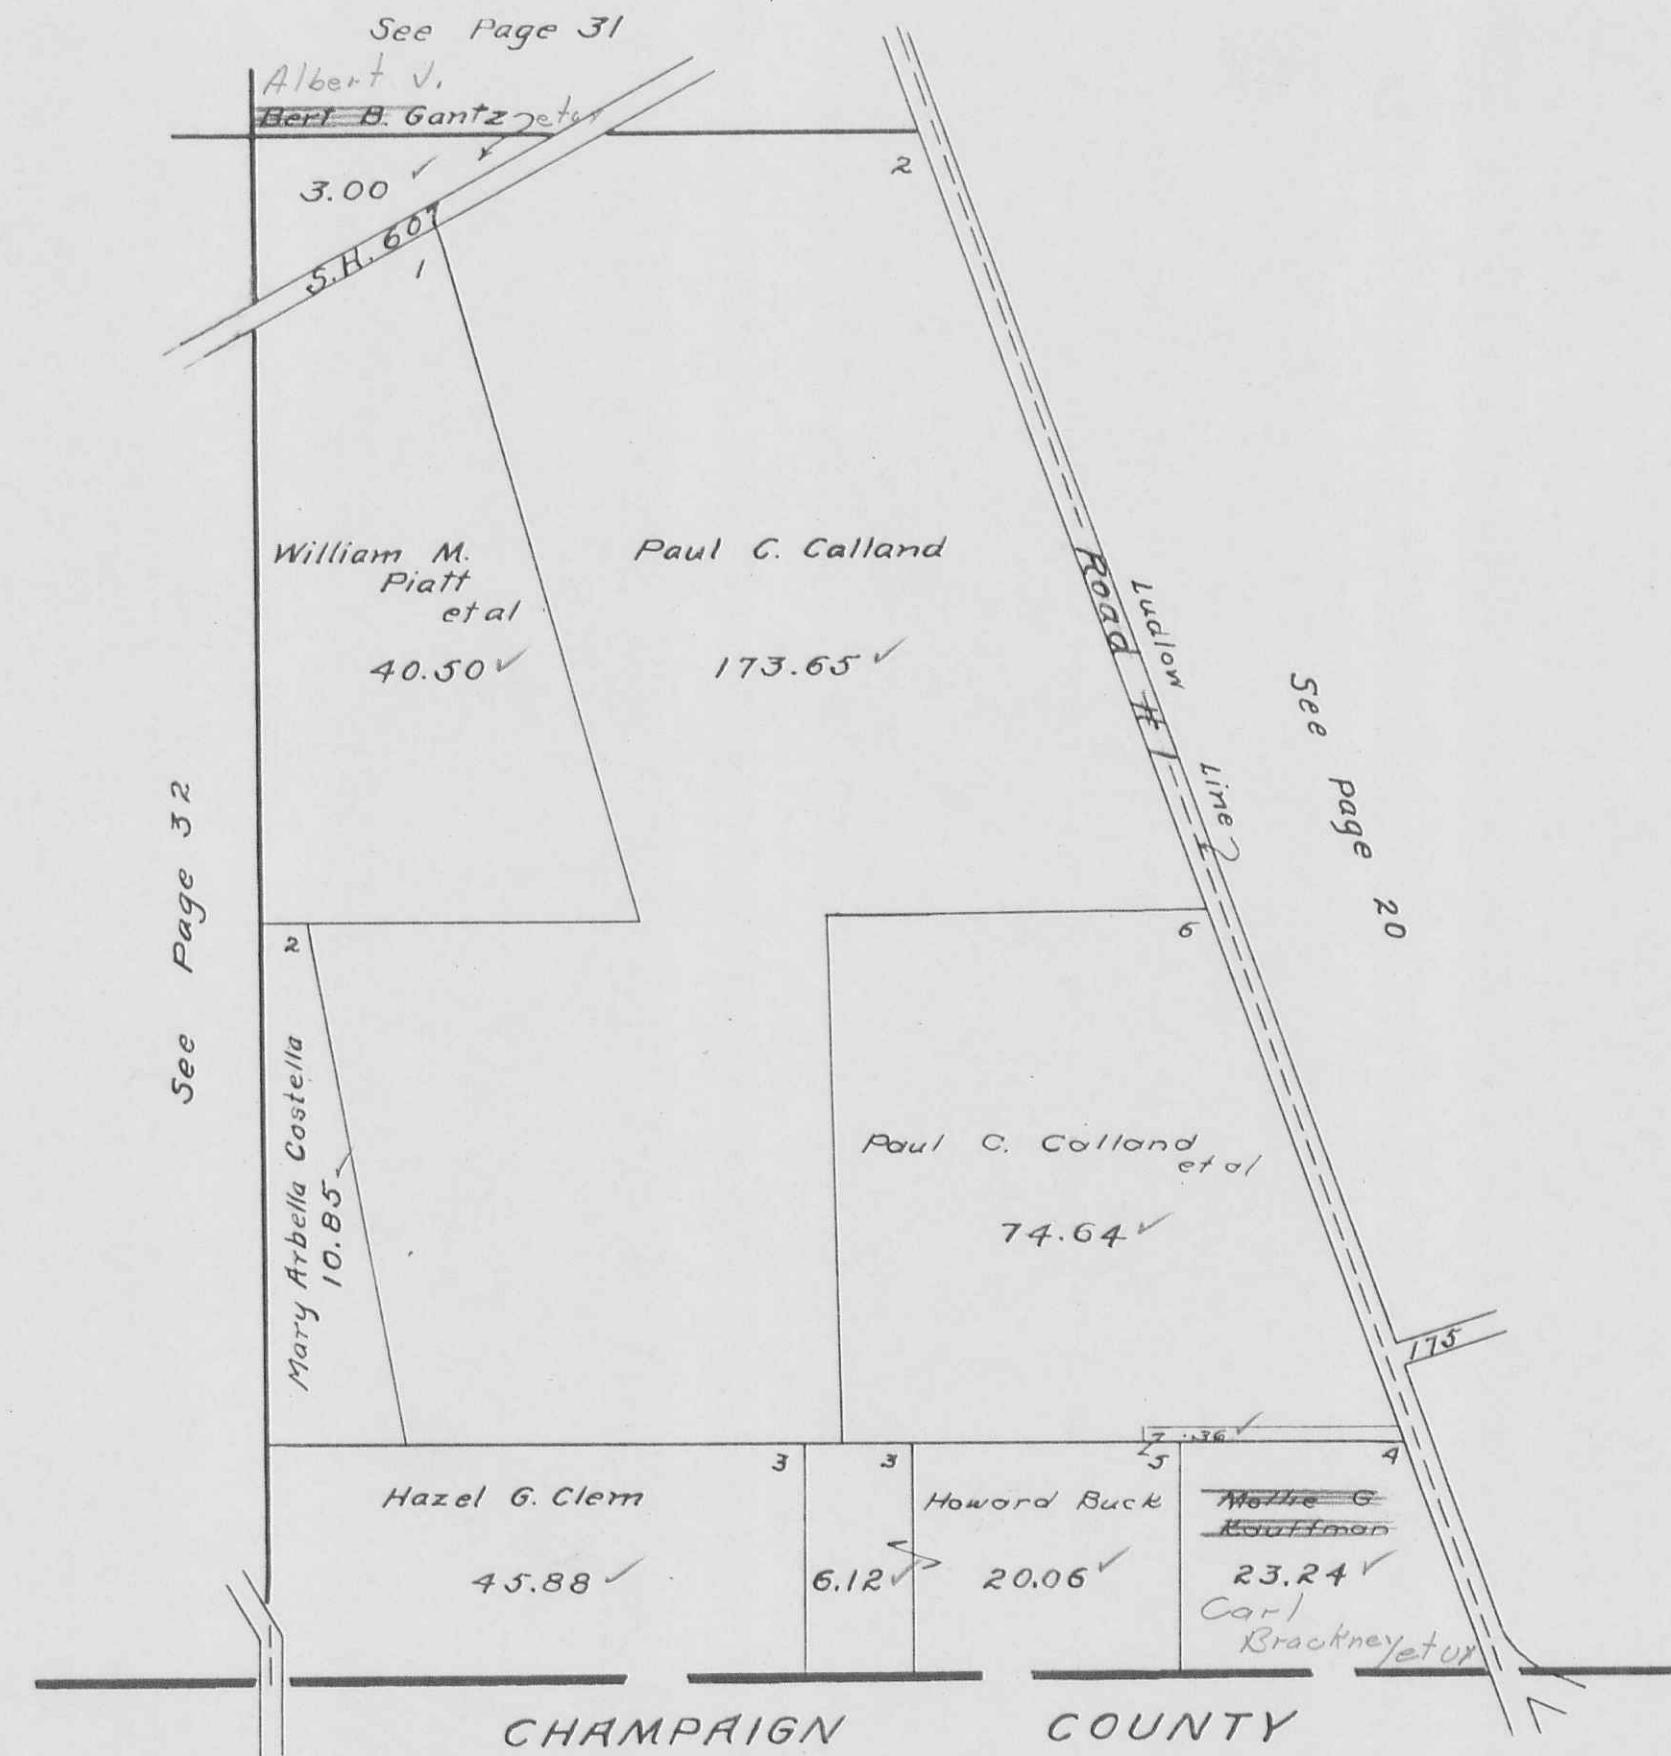

**MONROE TOWNSHIP**  
**PICKRELLTOWN**

PAGE 34

SCALE 100 FEET TO THE INCH

322

