

PERRY
TOWNSHIP

1951

PERRY TOWNSHIP
INDEX

PAGE A

VIRGINIA
MILITARY
SURVEYS

	PAGE
842	1
5288	1
5209	2
{ 775	3
6155	3
13068	3
3436	4
5089	4
4210	5
5092 N. PART	6
5092 S. PART	7
4995	7
5091	8
13432	9
13529	9
14894	9
{ 12103	10
13528	10
13557	10
13558	10
4813	11
4815	11
5088	12
9198	12
9370	12
9372	12
5875	13
5883	13
7288	13

VIRGINIA
MILITARY
SURVEYS

	PAGE
3159	14
3161	14
3753	14
4661	14
4676	14
4682	14
{ 9371	14
12174	14
9676	14
4655	15
3164	16
4689	17
4810	18
6232	19
3154	20
4811	21
5275	22
12283	23
14755	23
545	24
{ 12399	24
12404	24
12395	24
12427	24
12428	24

PAGE

	PAGE
WEST MANSFIELD CORPORATION	25
EAST LIBERTY NORTH EAST PART	26
EAST LIBERTY NORTH WEST PART	27
EAST LIBERTY SOUTH PART	28
GREENFIELD LOTS	29

PERRY


TOWNSHIP

INDEX

MAP

PAGE

Corrected To:
 January 1, 1955
 January 1-1956
 January 1-1957
 January 1-1958

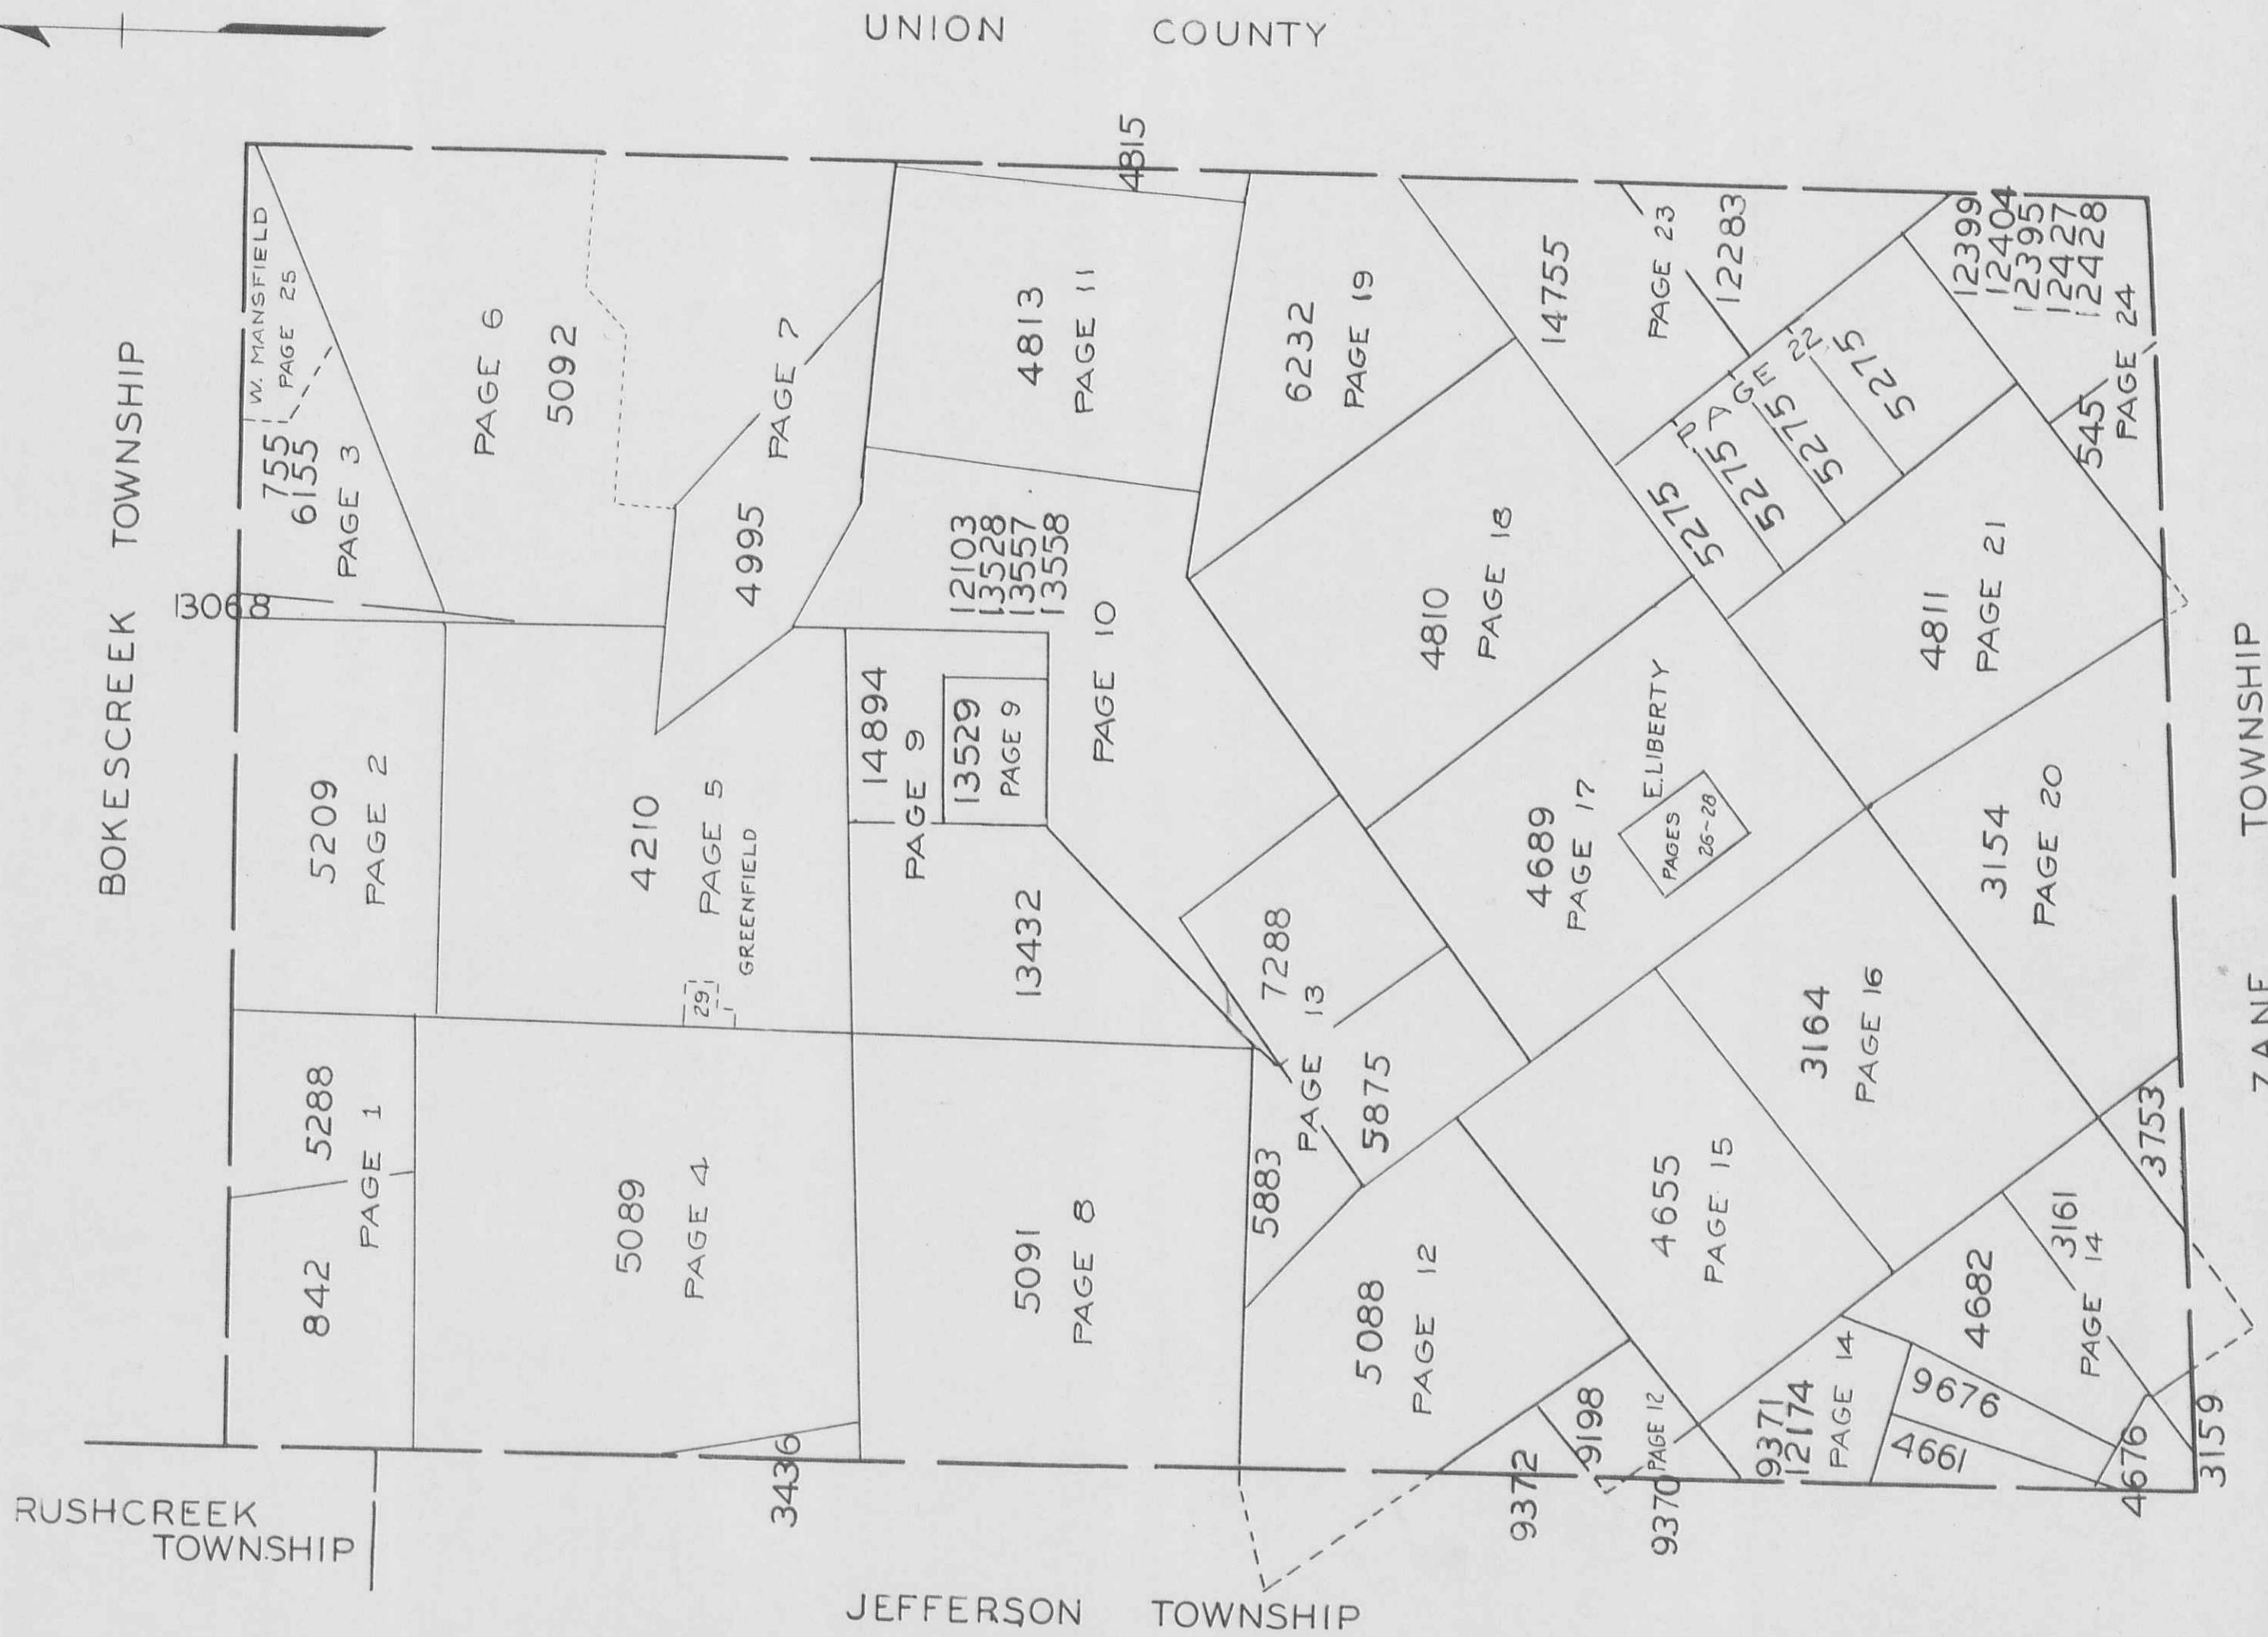

PERRY

TOWNSHIP

PAGE
1


VIRGINIA

MILITARY SURVEYS

842
5288

SCALE 10 CHAINS TO THE INCH

BOKESCREEN TOWNSHIP

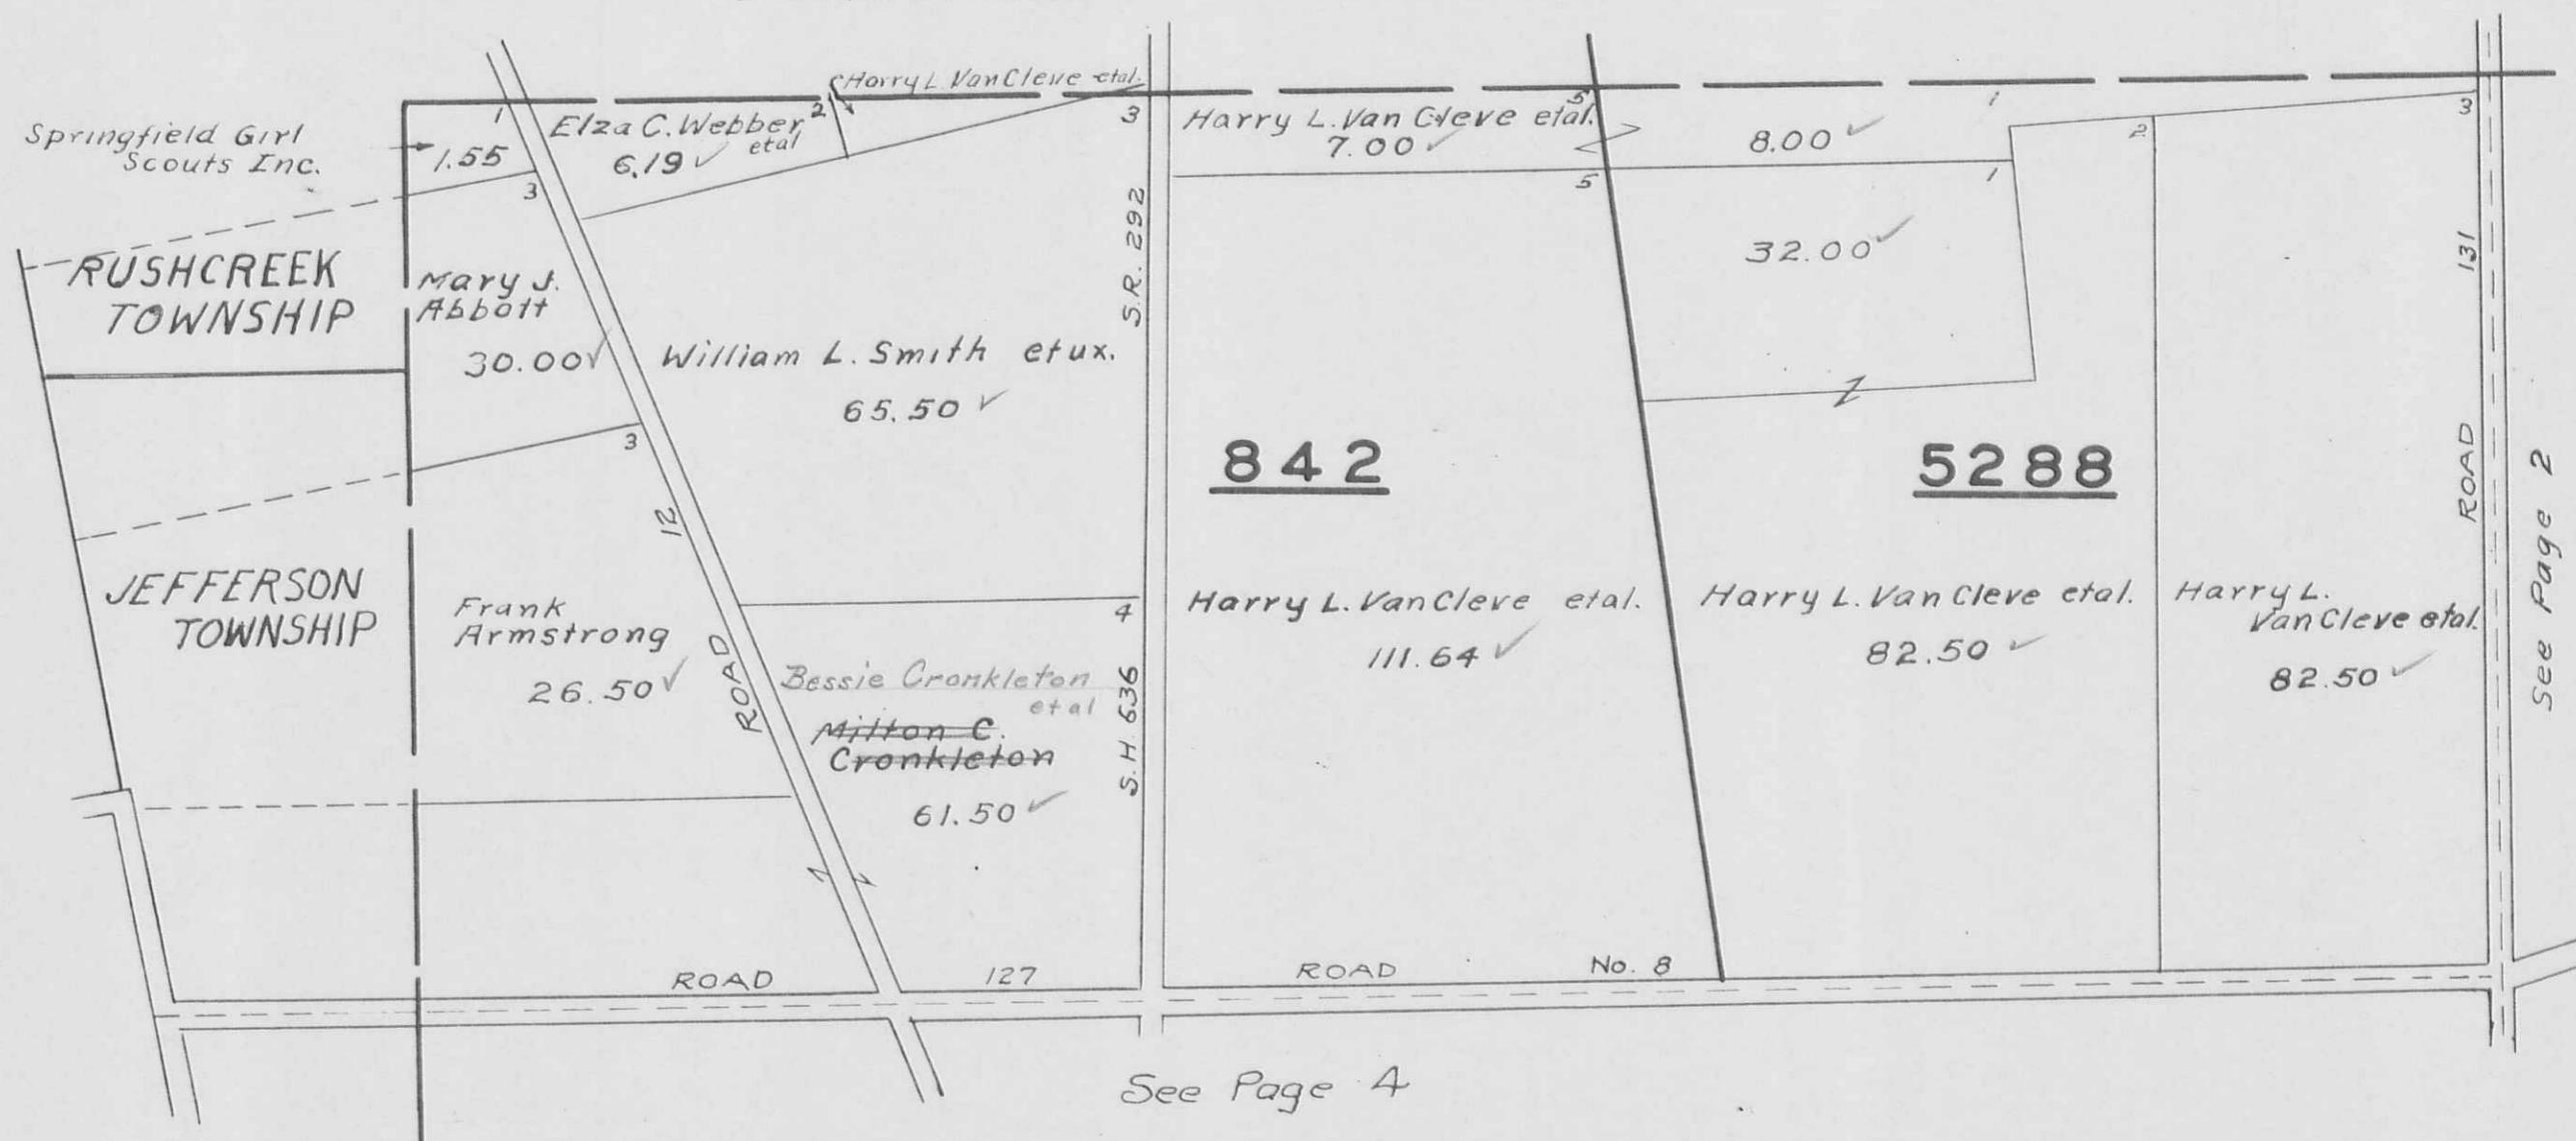


See Page 4

VIRGINIA MILITARY SURVEY 5209

SCALE 10 CHAINS TO THE INCH

BOKESCREEK TOWNSHIP

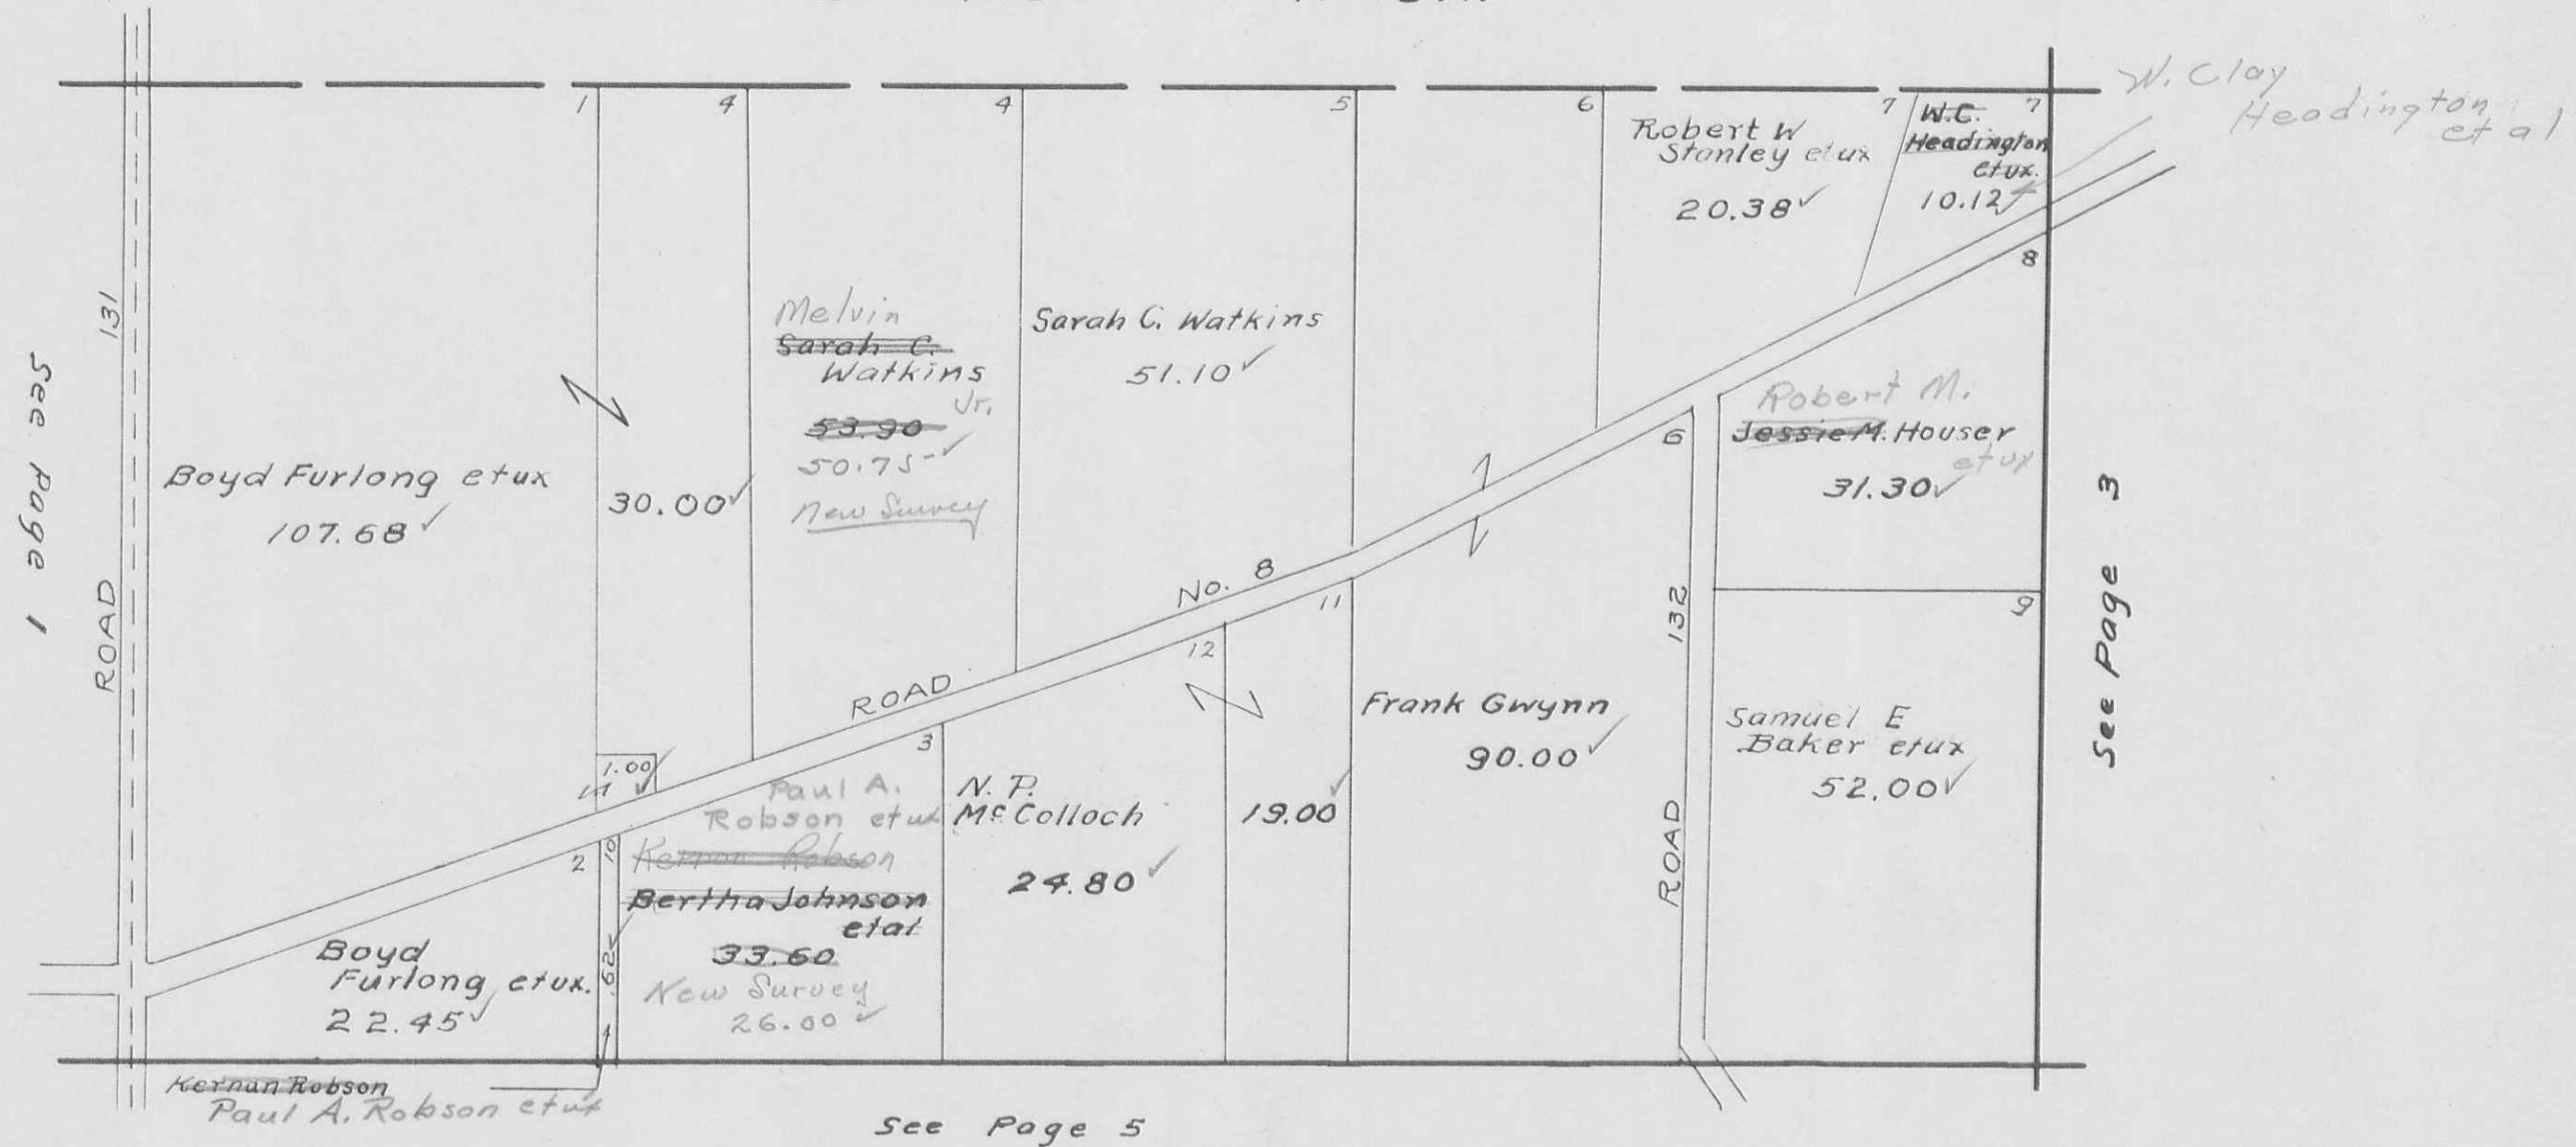

PERRY

TOWNSHIP

VIRGINIA

MILITARY SURVEYS

PAGE

3


SCALE 10 CHAINS TO THE INCH

{ 775
6155
13068

BOKESCREEK TOWNSHIP

WEST MANSFIELD

UNION COUNTY

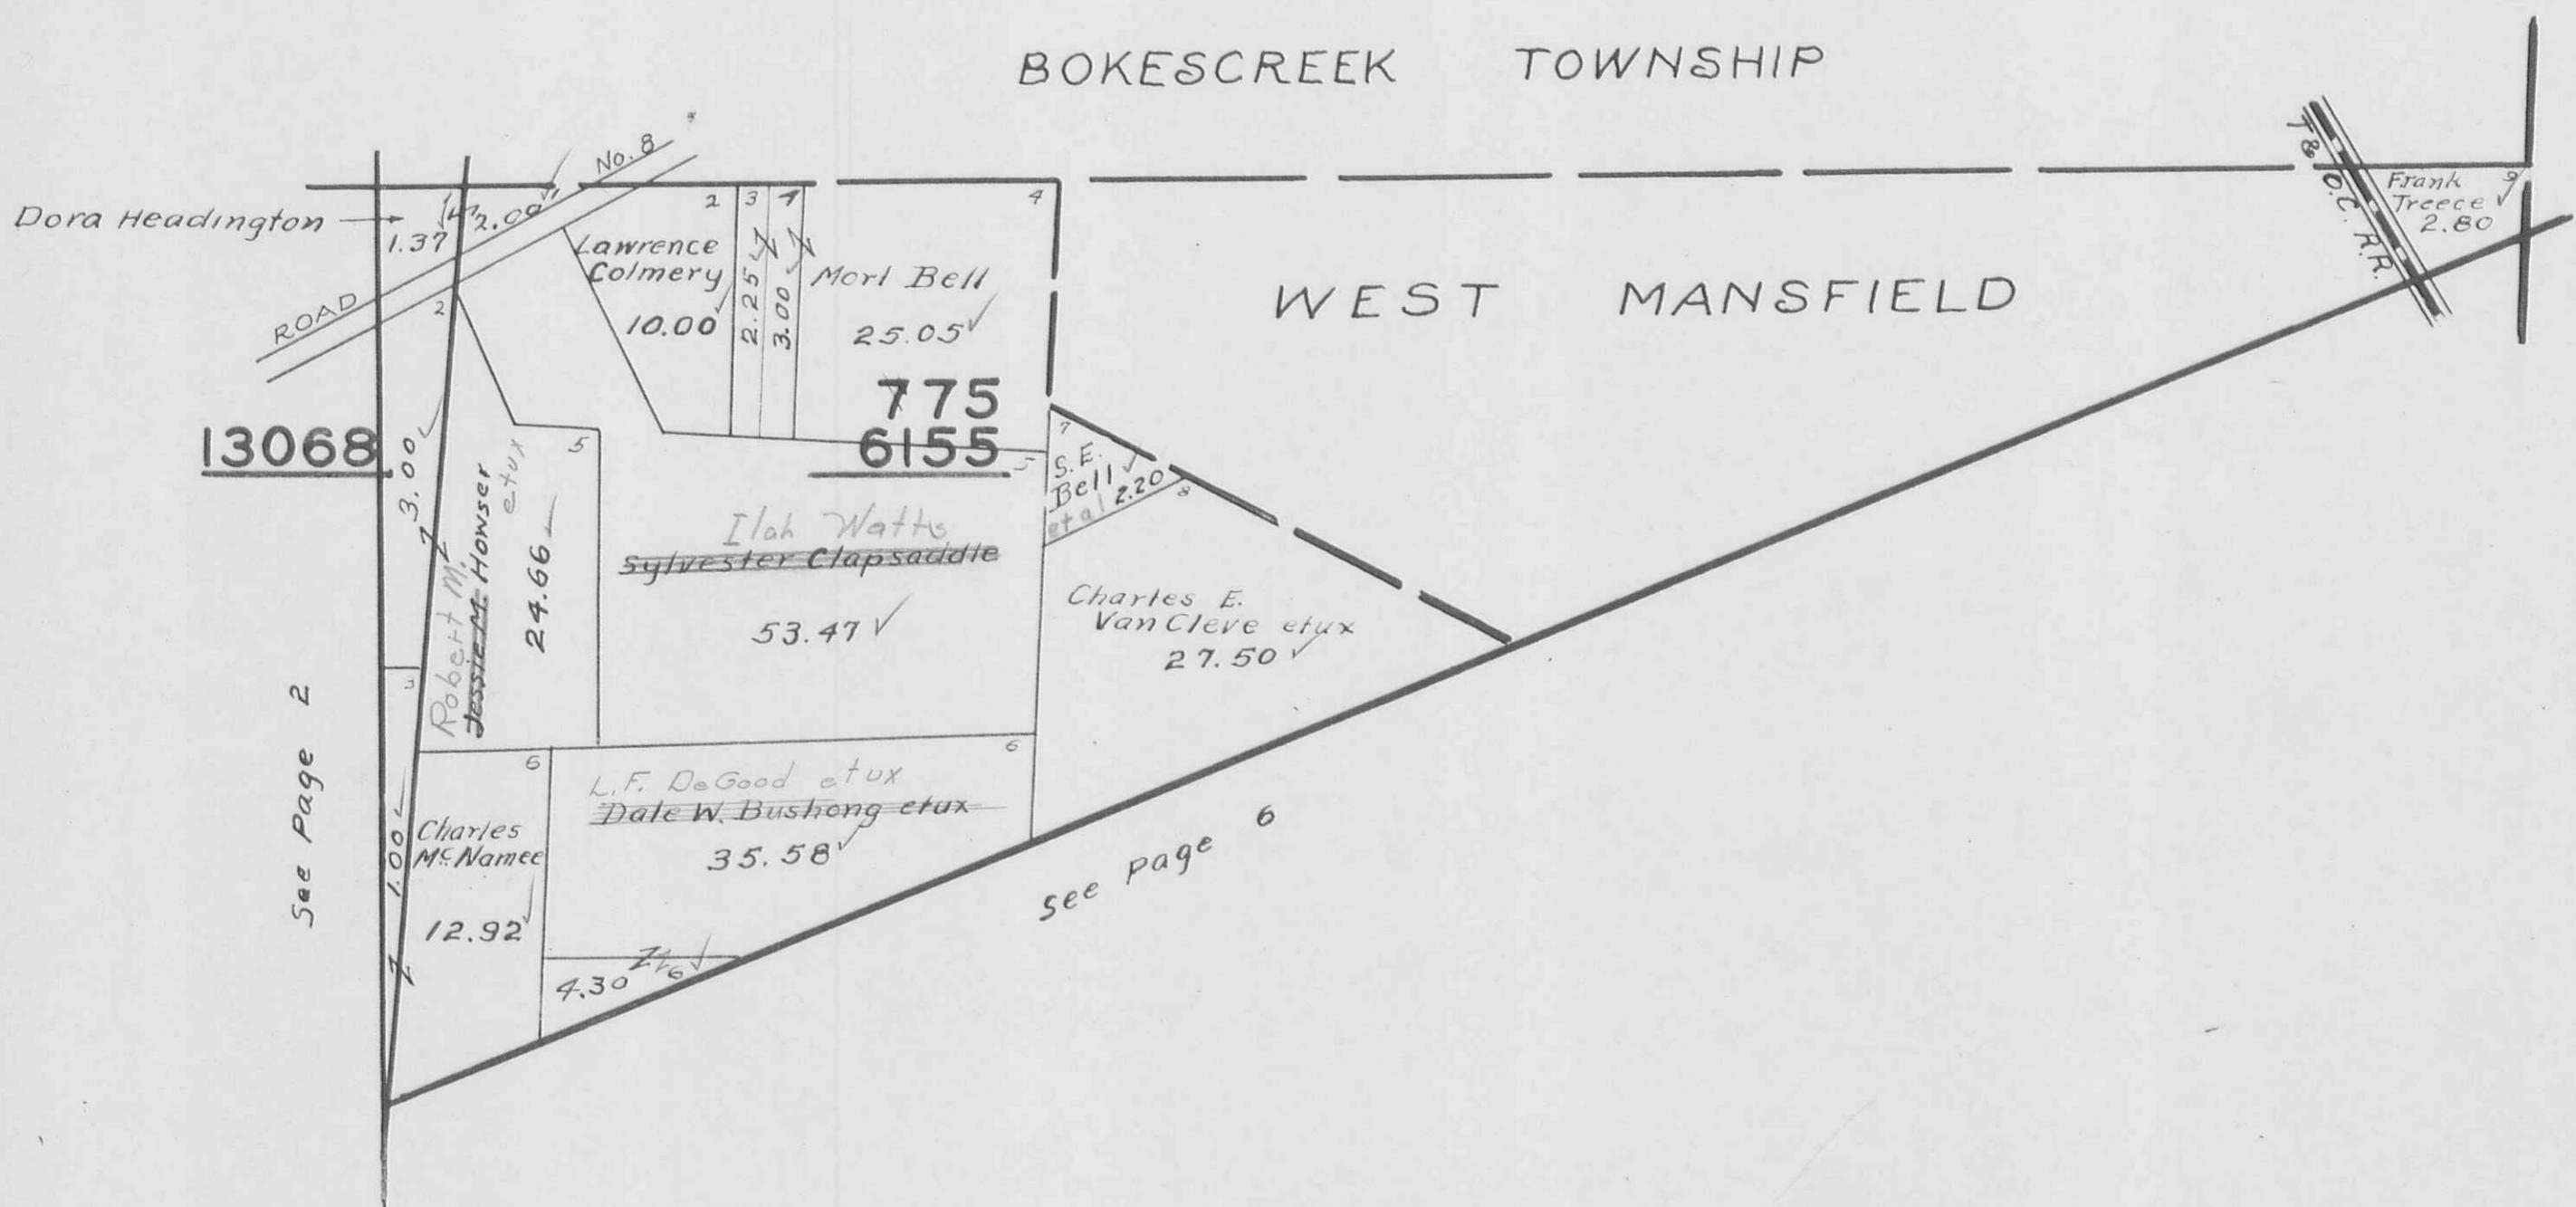

PERRY

TOWNSHIP

PAGE

VIRGINIA

MILITARY SURVEYS

3436
5089

4

see

Page 1
ROAD

127

SCALE

10 CHAINS TO THE INCH

ROAD

No. 8



PERRY

TOWNSHIP

PAGE


5

VIRGINIA

MILITARY SURVEYS 4210
4995

SCALE 10 CHAINS TO THE INCH

See Page 2

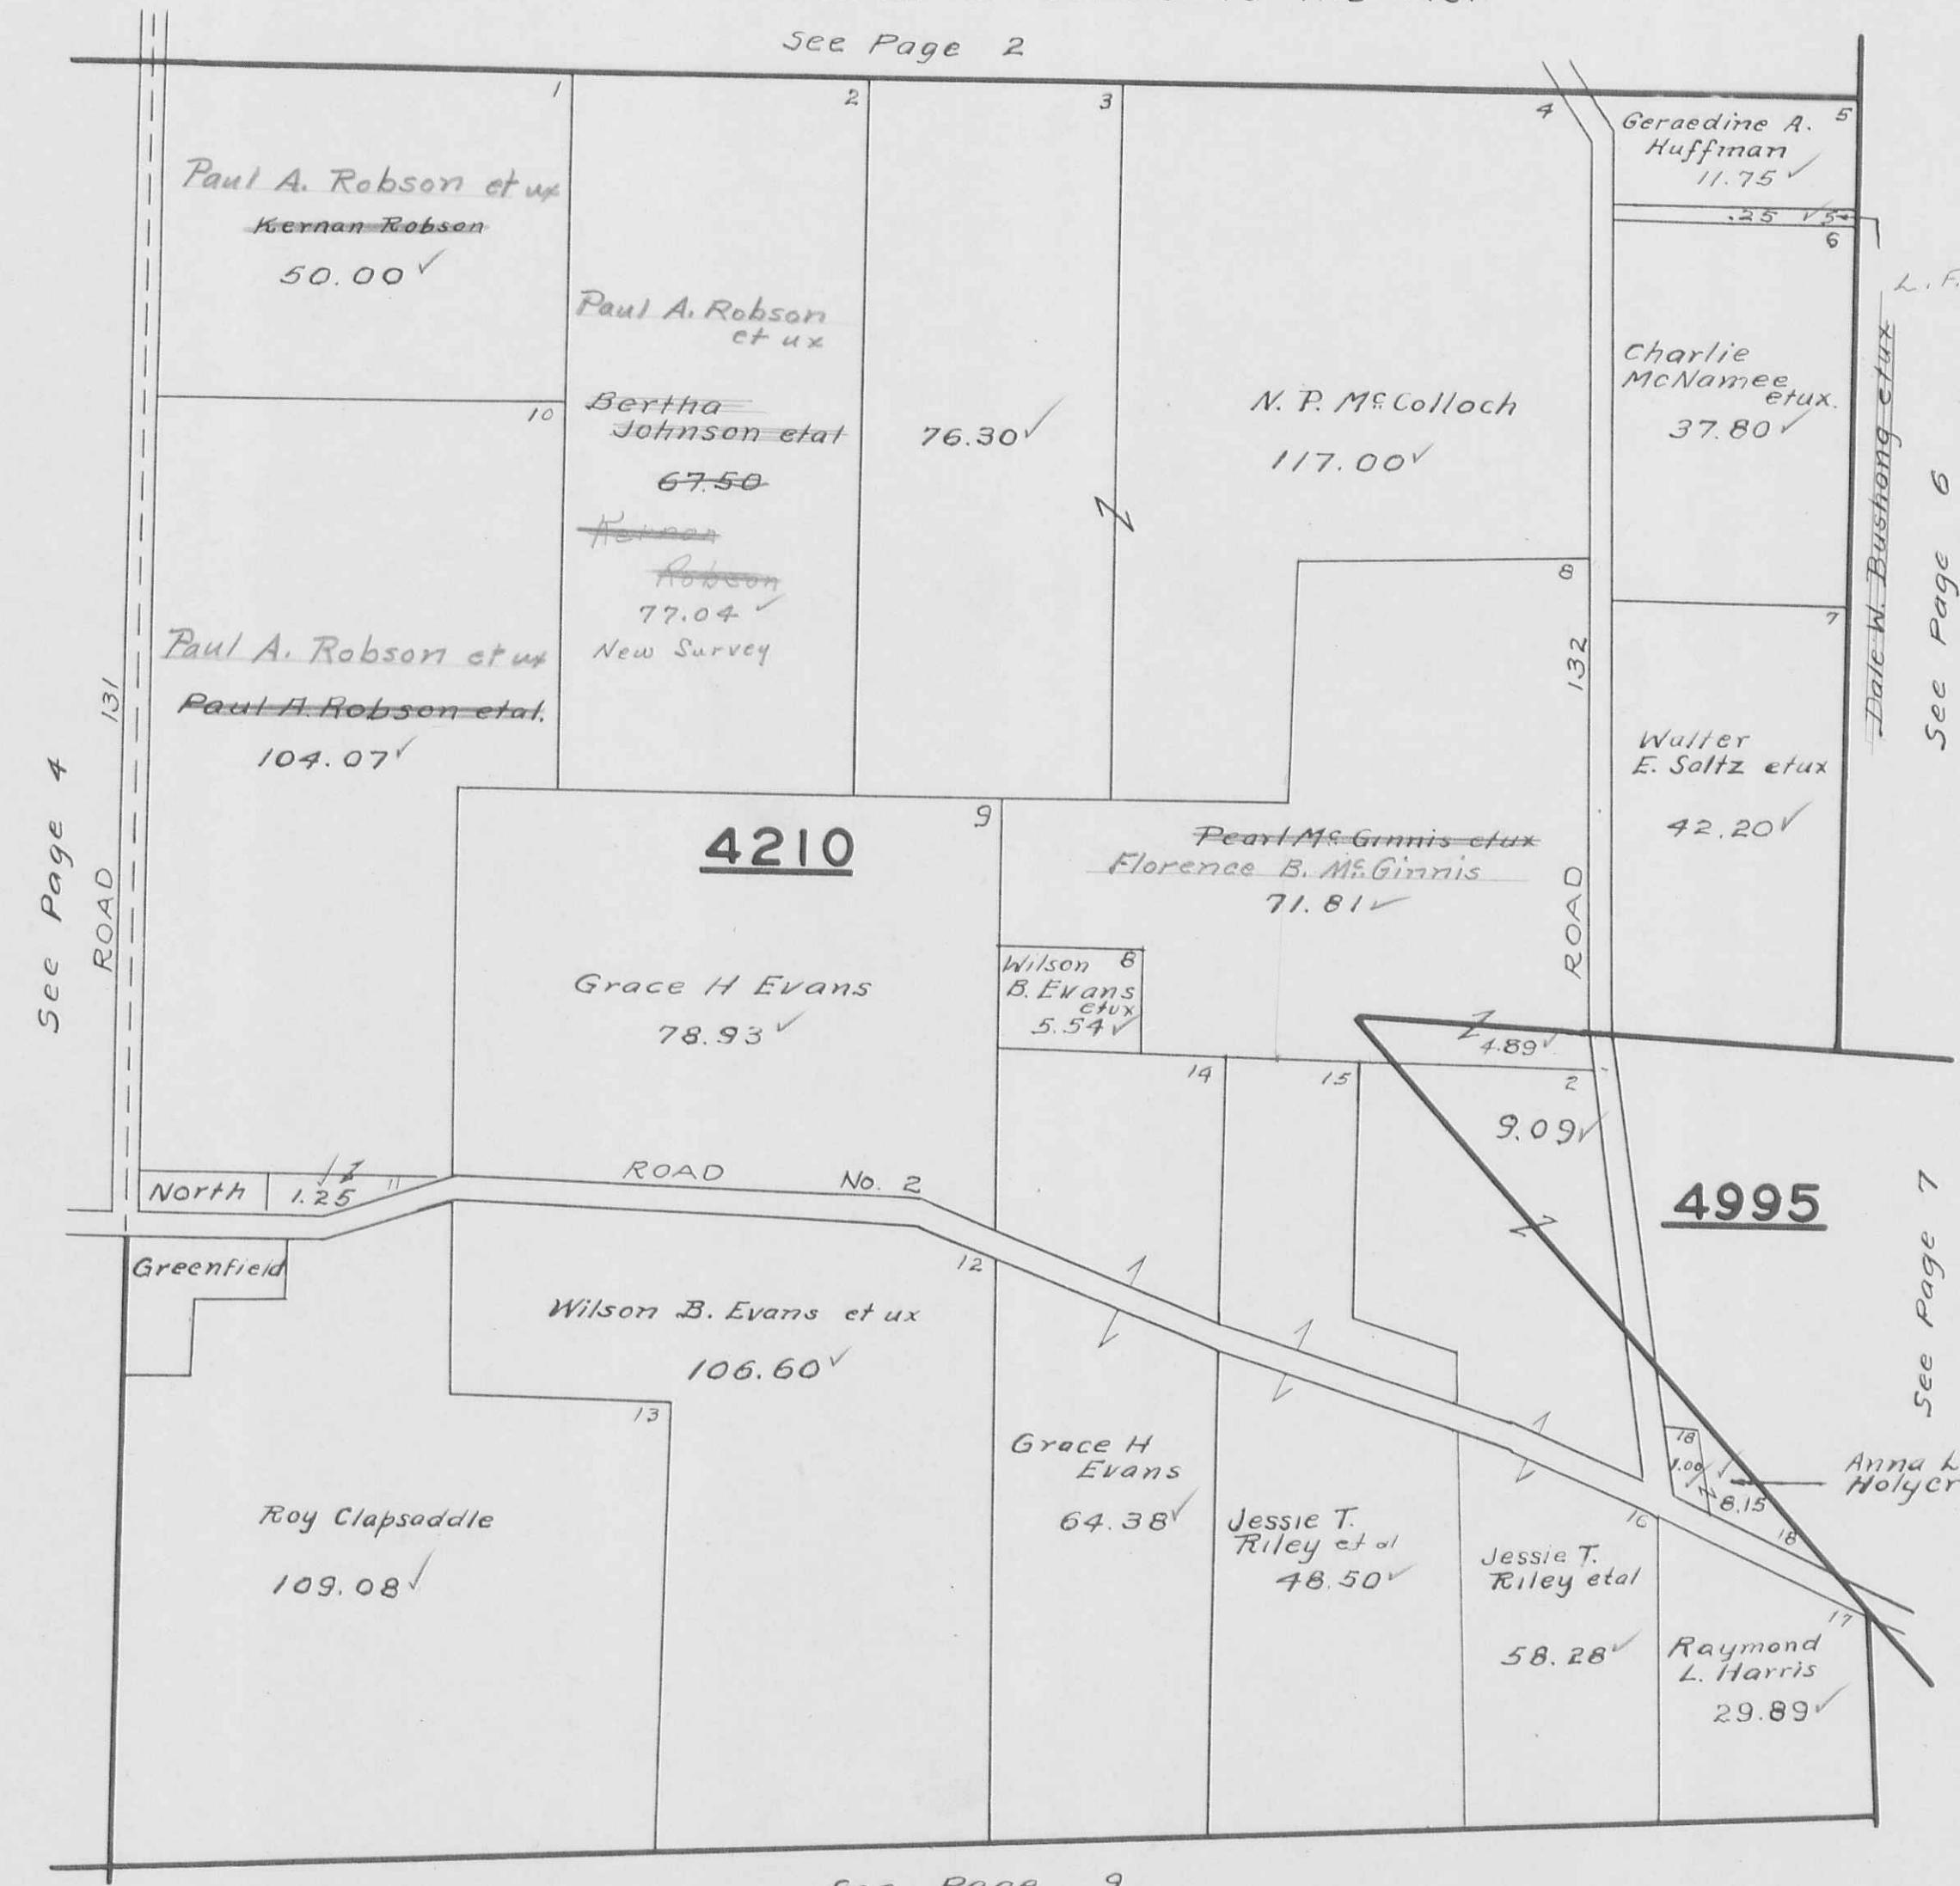

PERRY

TOWNSHIP

PAGE

6

VIRGINIA MILITARY SURVEY N.PART 5092

SCALE 10 CHAINS TO THE INCH



PERRY

TOWNSHIP

PAGE

7

VIRGINIA MILITARY SURVEYS 4995
S.PART 5092

SCALE 10 CHAINS TO THE INCH


UNION COUNTY



VIRGINIA MILITARY SURVEY 5091

SCALE 10 CHAINS TO THE INCH

See Page 4

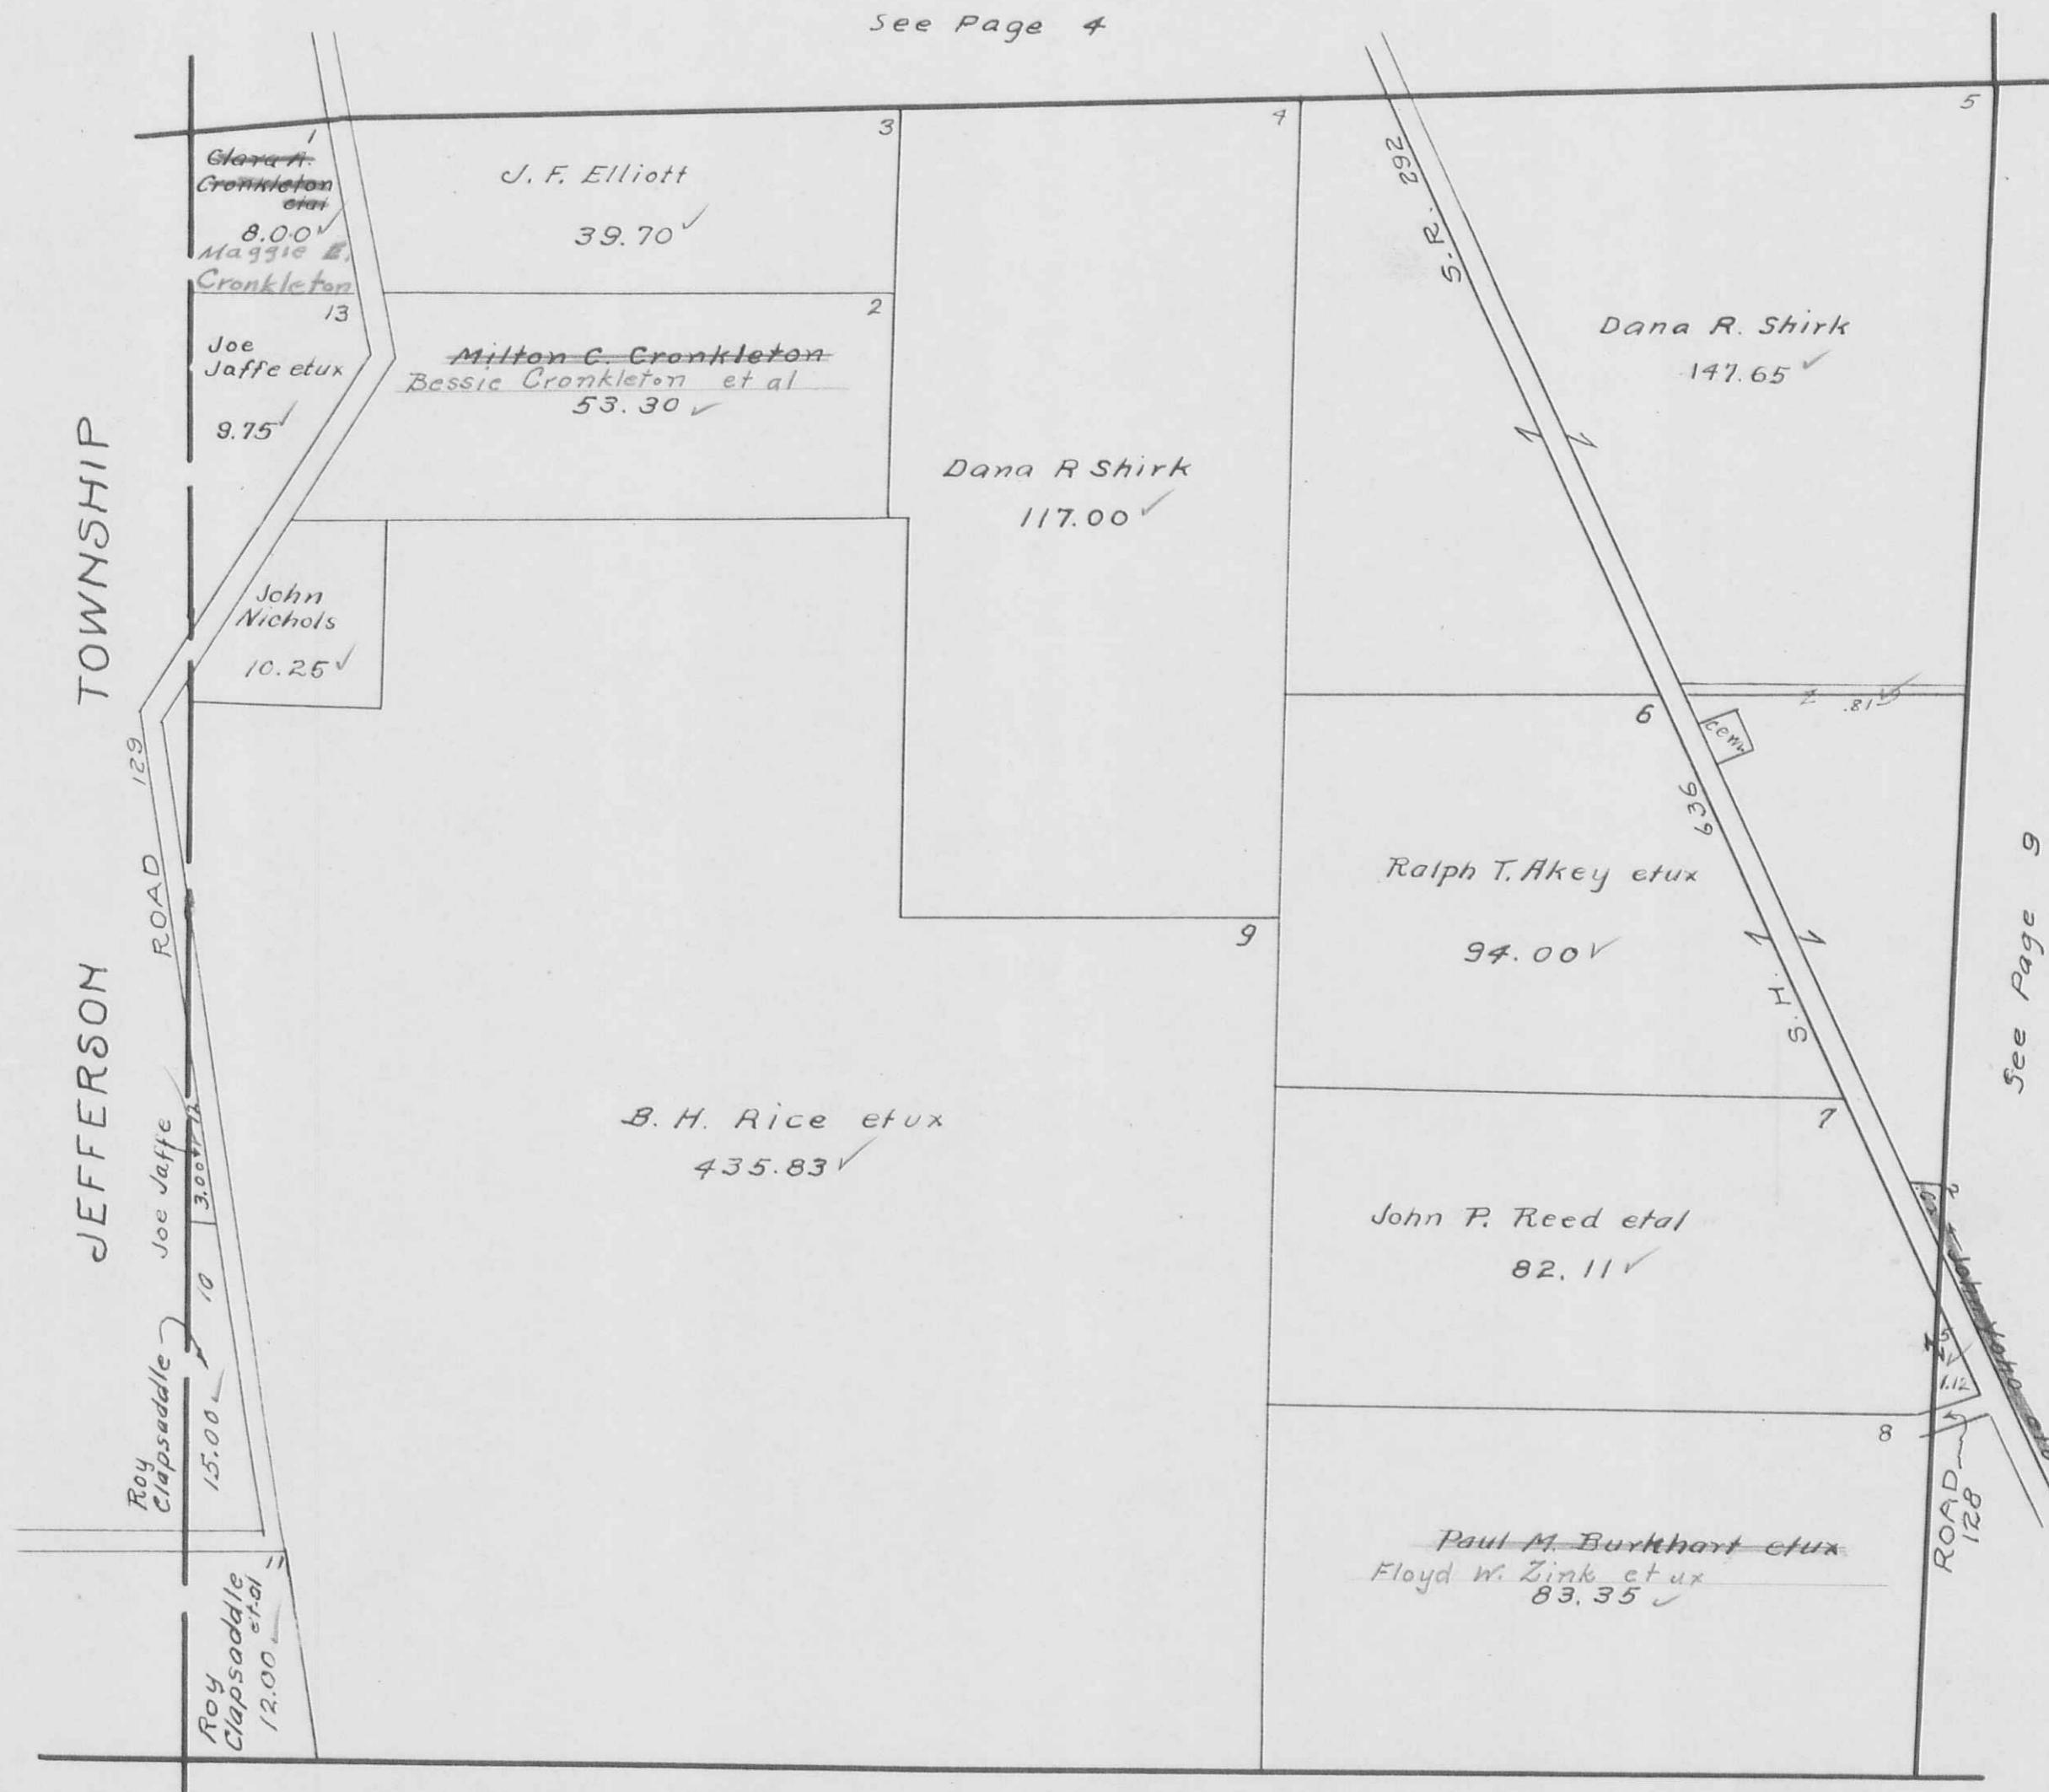

PERRY TOWNSHIP
VIRGINIA MILITARY SURVEYS

SCALE 10 CHAINS TO THE INCH

13432
13529
14894

PAGE

9

See Page 5

Ralph T. Akey etux
102.17✓

13432

Ralph T. Akey etux
102.17✓

John P. Reed etal
75.00✓

John Yoho etutx.
76.18✓

John Yoho etutx.
48.10✓

John Yoho etutx.
7.69✓

Lucille Meddles et al
3.98✓

Jessie T. Riley etal
73.00✓

14894

John Yoho etux. W. P. Haynes
etal.
57.50✓

52.10✓

Raymond
L. Harris
35.15✓

13529

John Yoho etux. W. P. Haynes
etal.
57.50✓


52.10✓

22.17✓

See Page 10

See Page 10

See Page 8

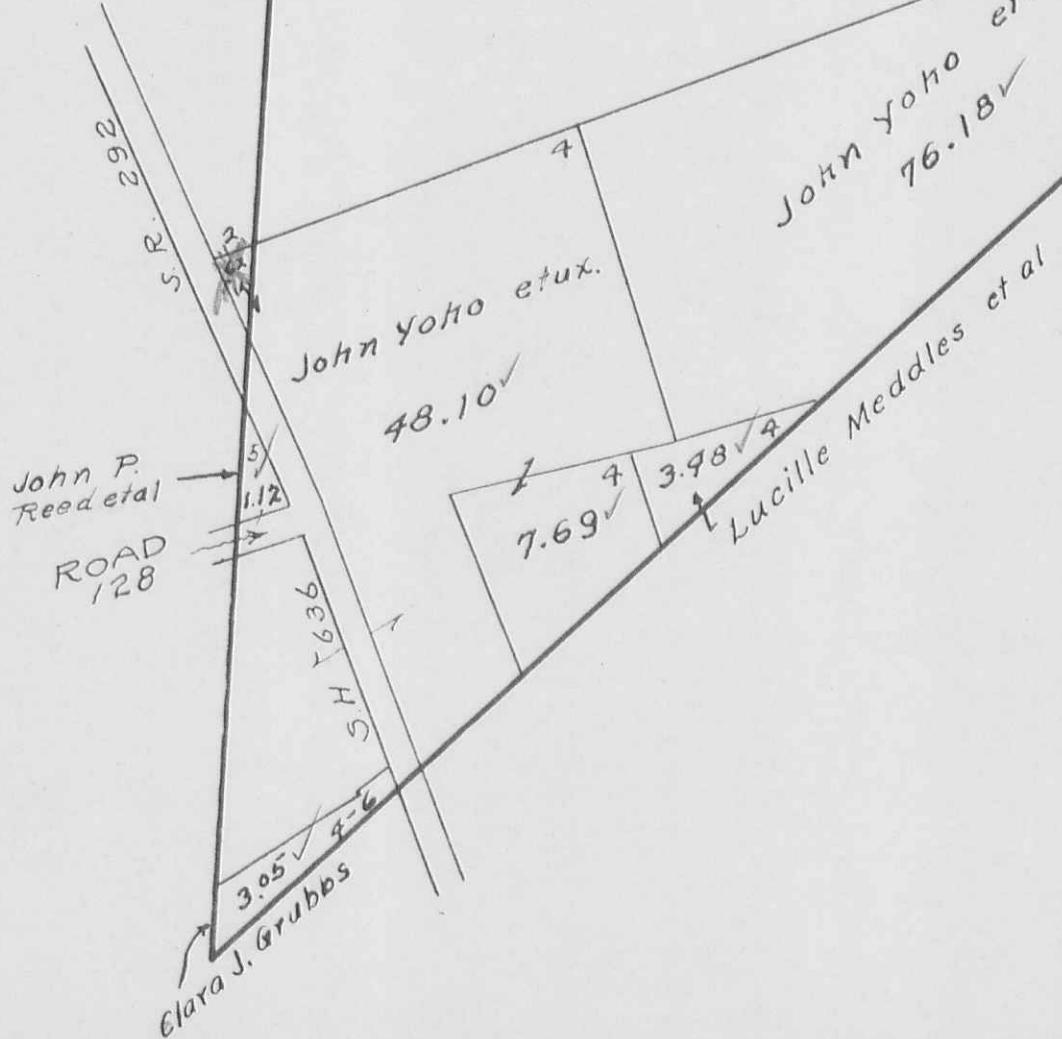

PERRY

TOWNSHIP

VIRGINIA


MILITARY SURVEYS

PAGE

10

SCALE 10 CHAINS TO THE INCH

12103
13528
13557
13558

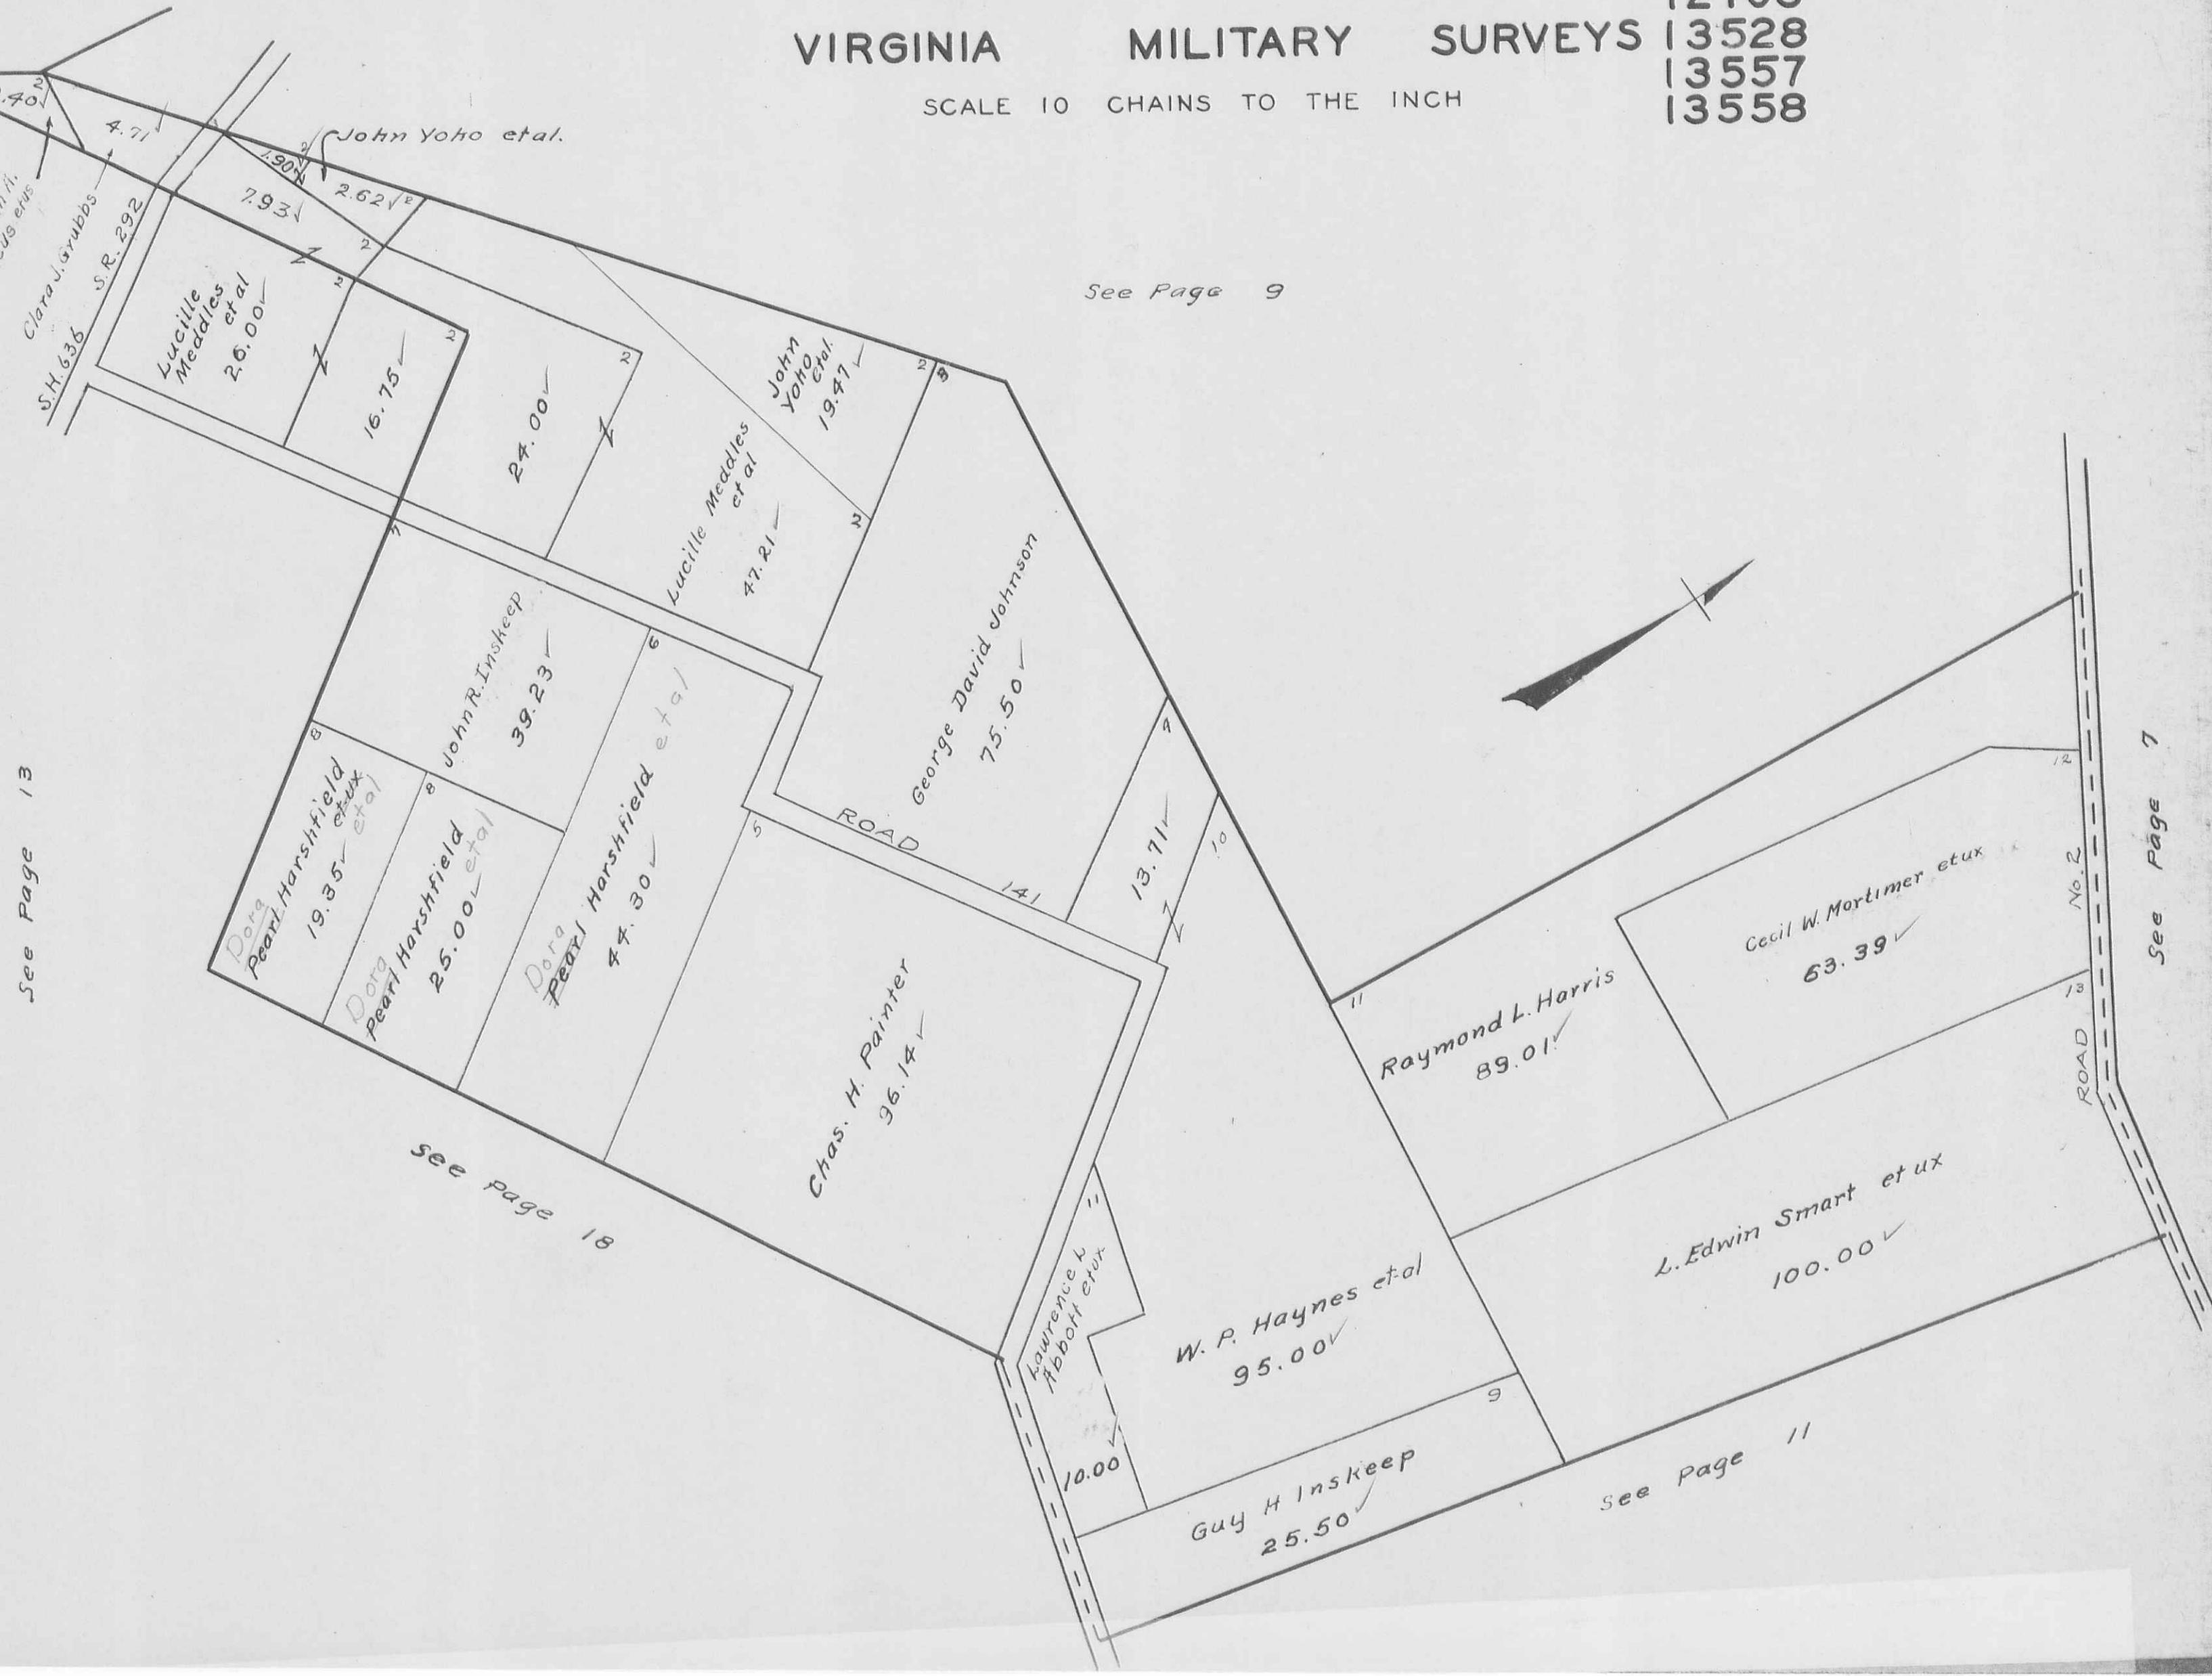

PERRY

TOWNSHIP

PAGE 11

VIRGINIA

MILITARY

SURVEYS 4813

4815

SCALE 10 CHAINS TO THE INCH




PERRY TOWNSHIP
VIRGINIA MILITARY SURVEYS
SCALE 10 CHAINS TO THE INCH

PAGE

12

5088
9198
9370
9372

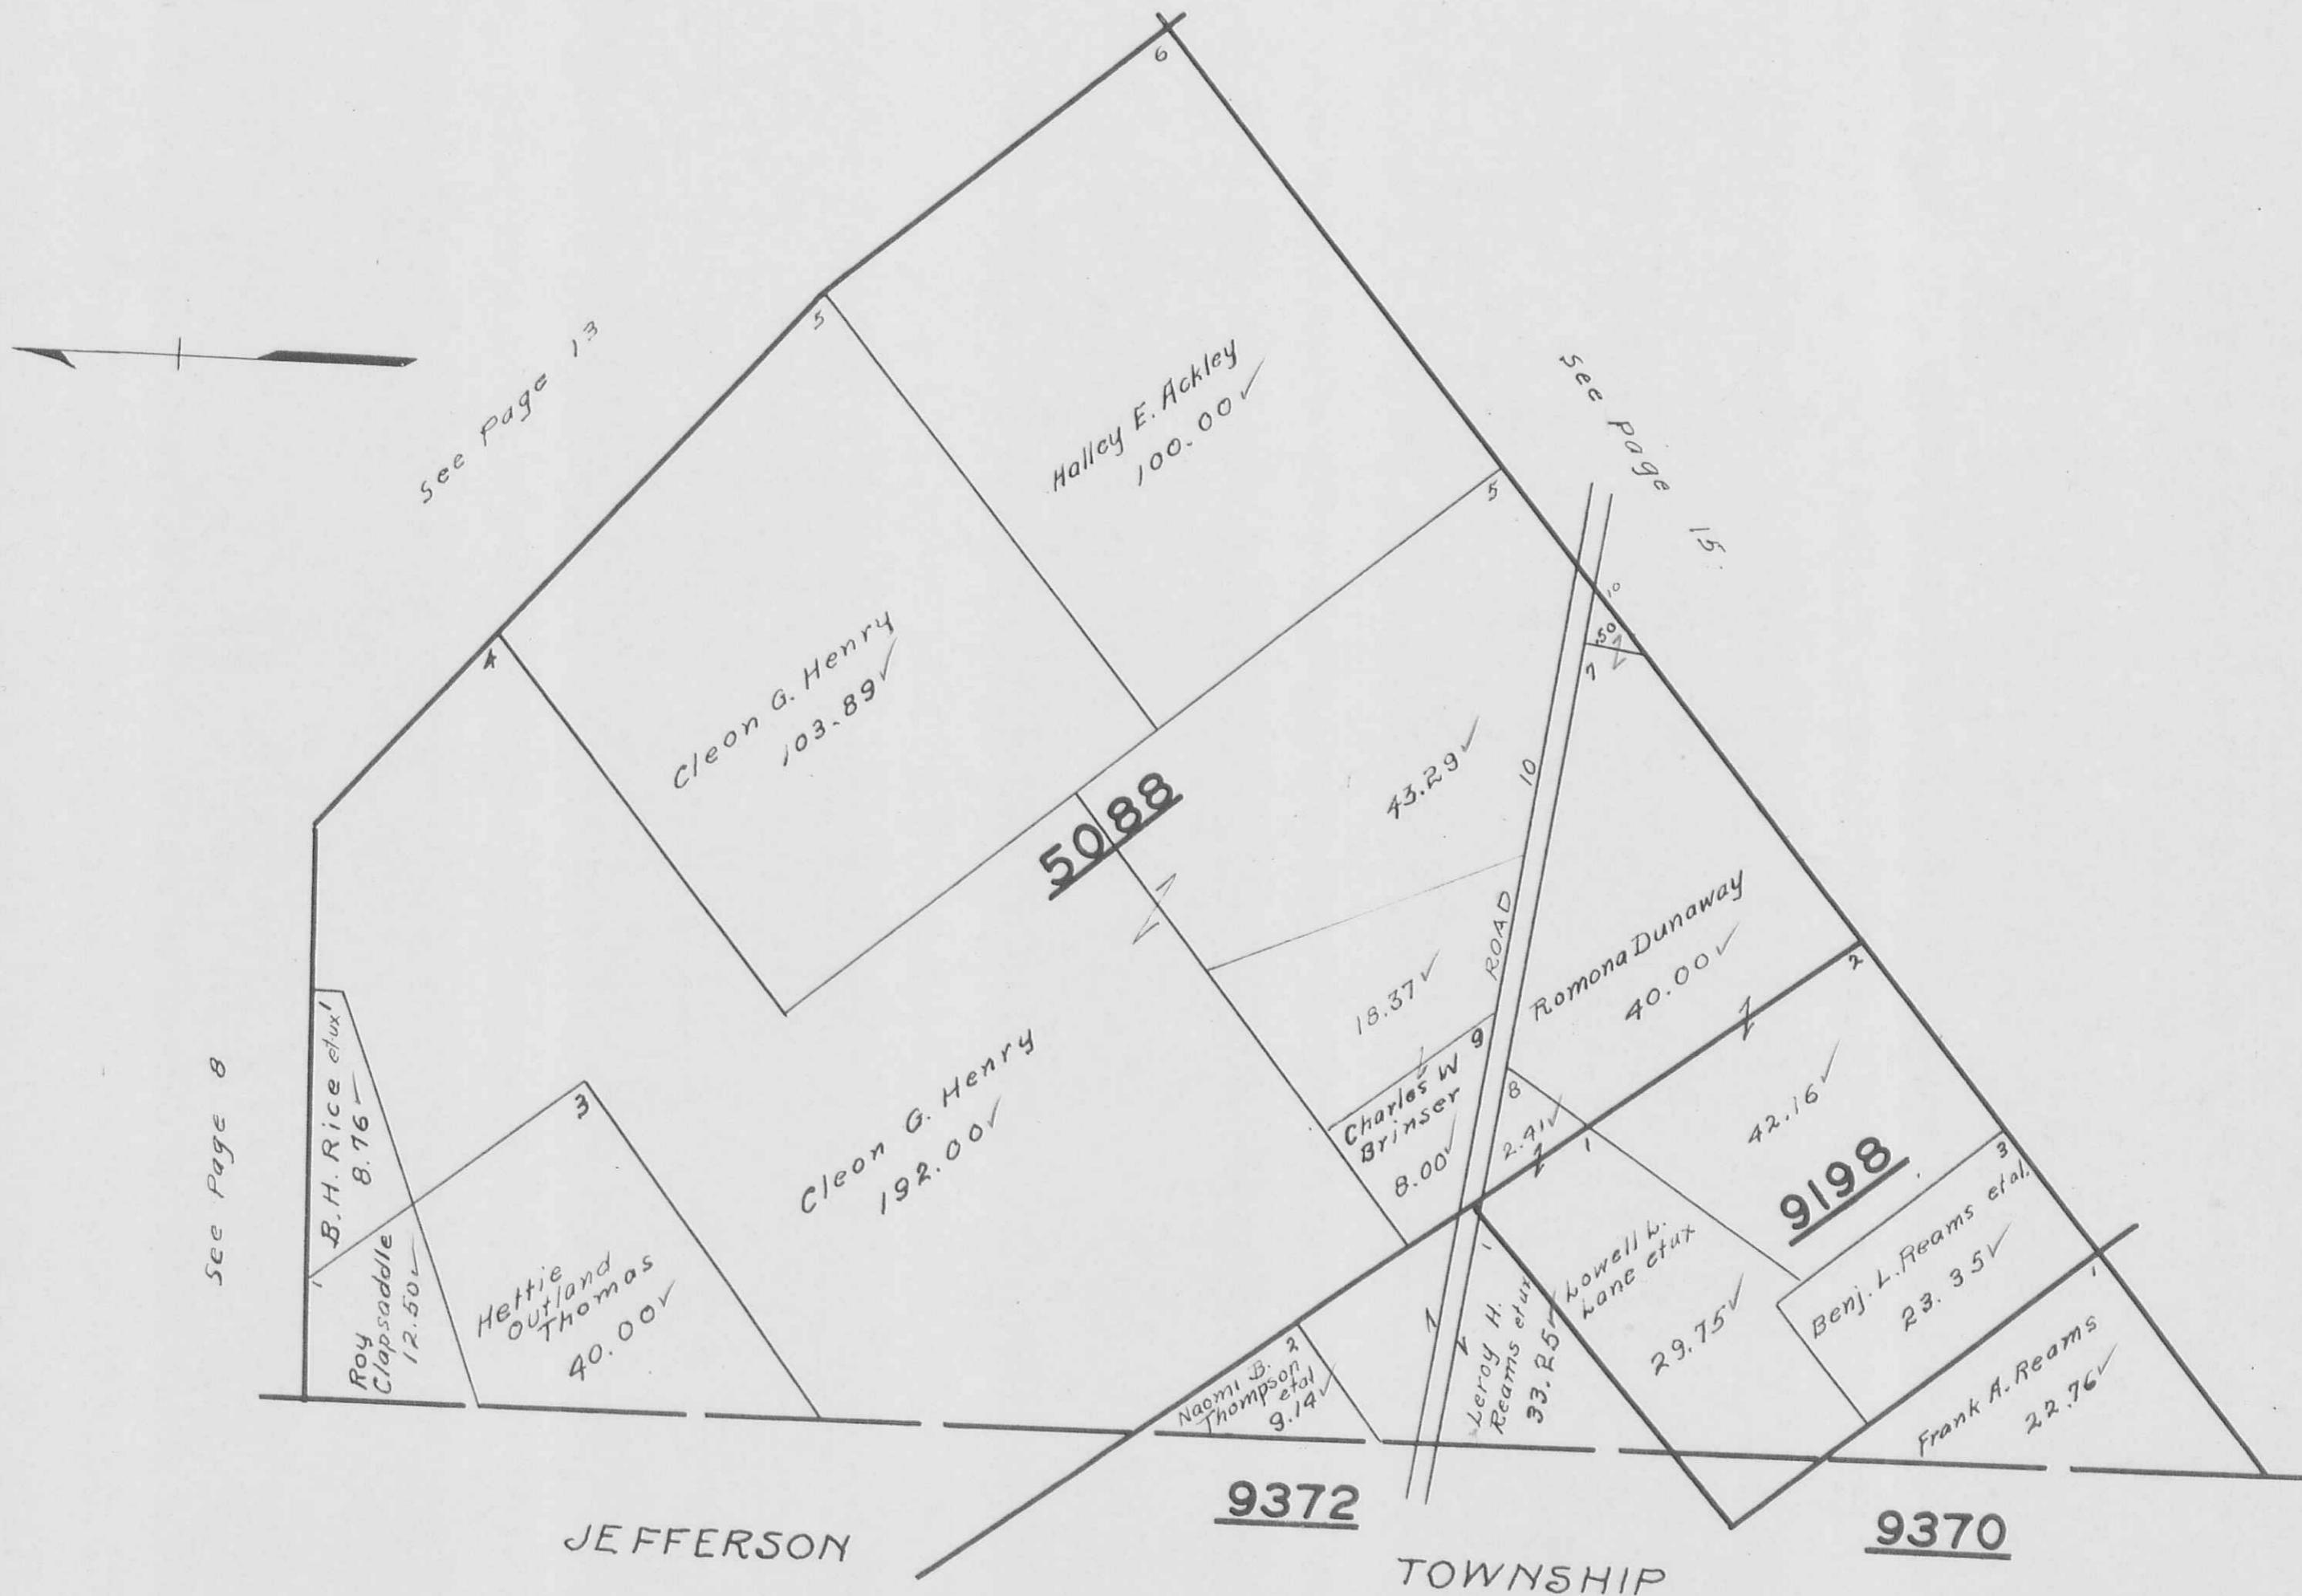

PERRY

TOWNSHIP

VIRGINIA

MILITARY SURVEYS

5883

5875

7288

PAGE


13

SCALE 10 CHAINS TO THE INCH



See Page 15

See Page 16

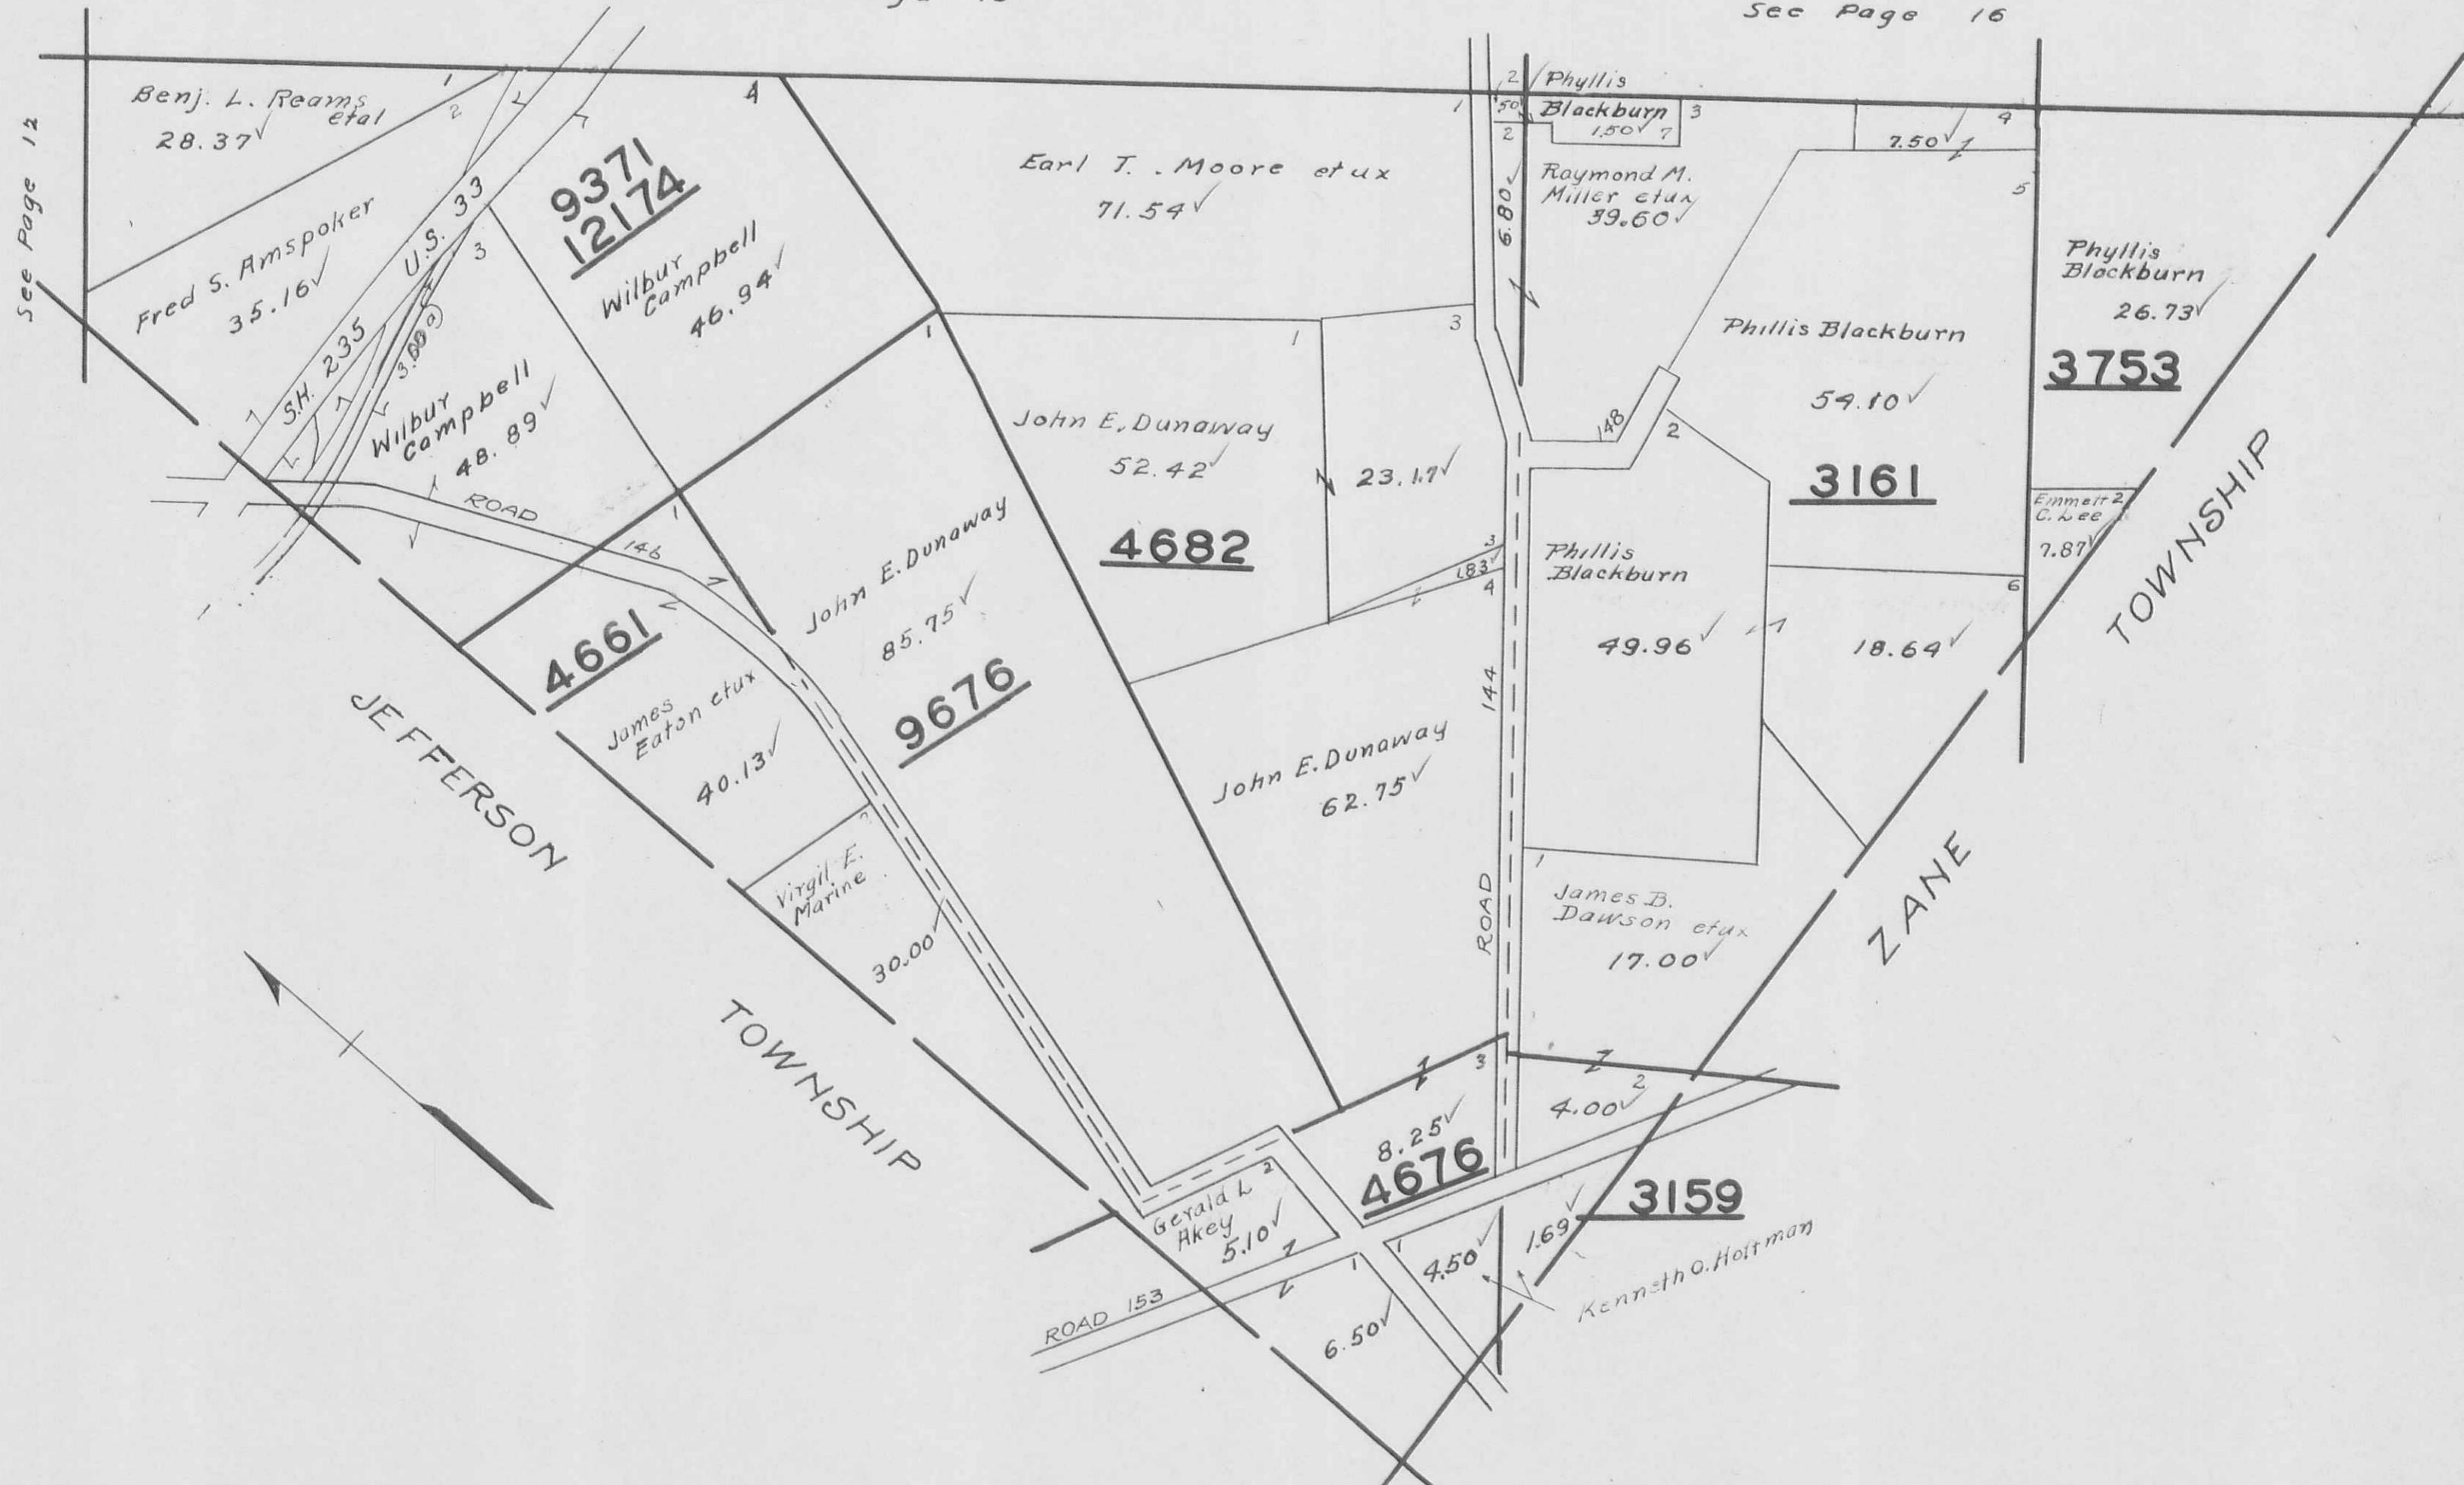

PERRY

TOWNSHIP


PAGE 15

VIRGINIA

MILITARY SURVEY

4655

SCALE 10 CHAINS TO THE INCH

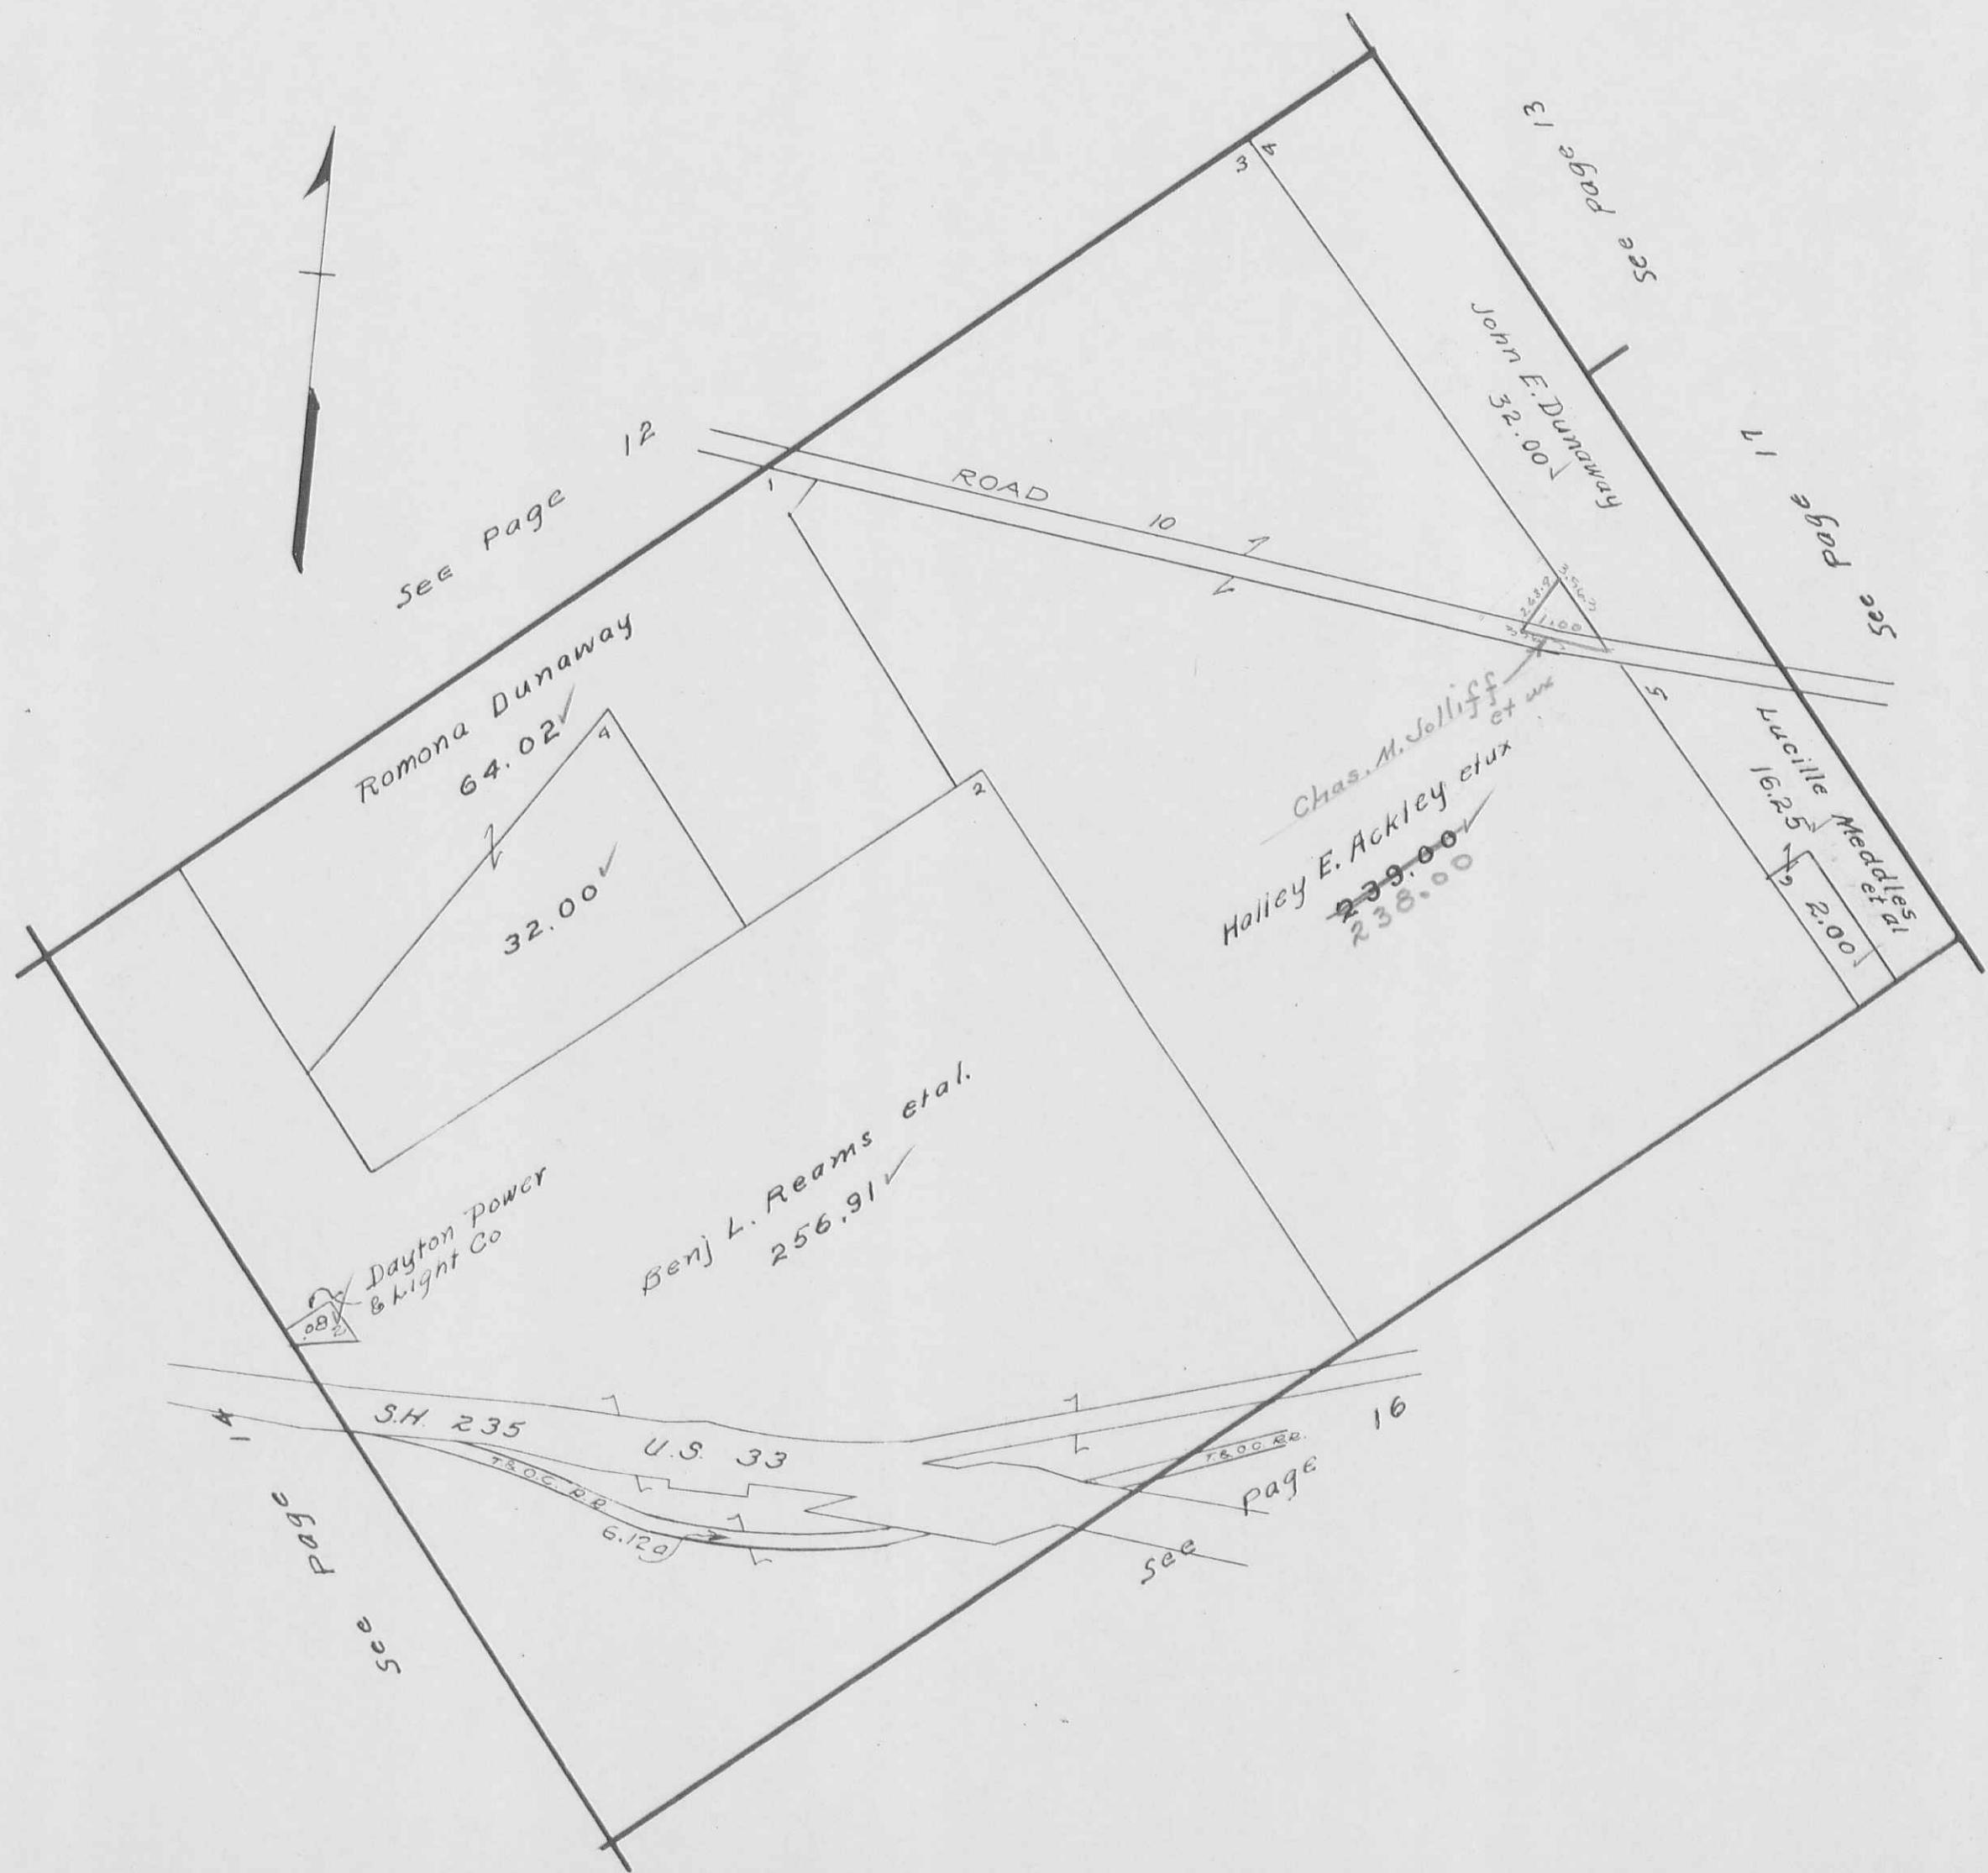


PERRY

TOWNSHIP

PAGE 16

VIRGINIA MILITARY SURVEY 3164

SCALE 10 CHAINS TO THE INCH

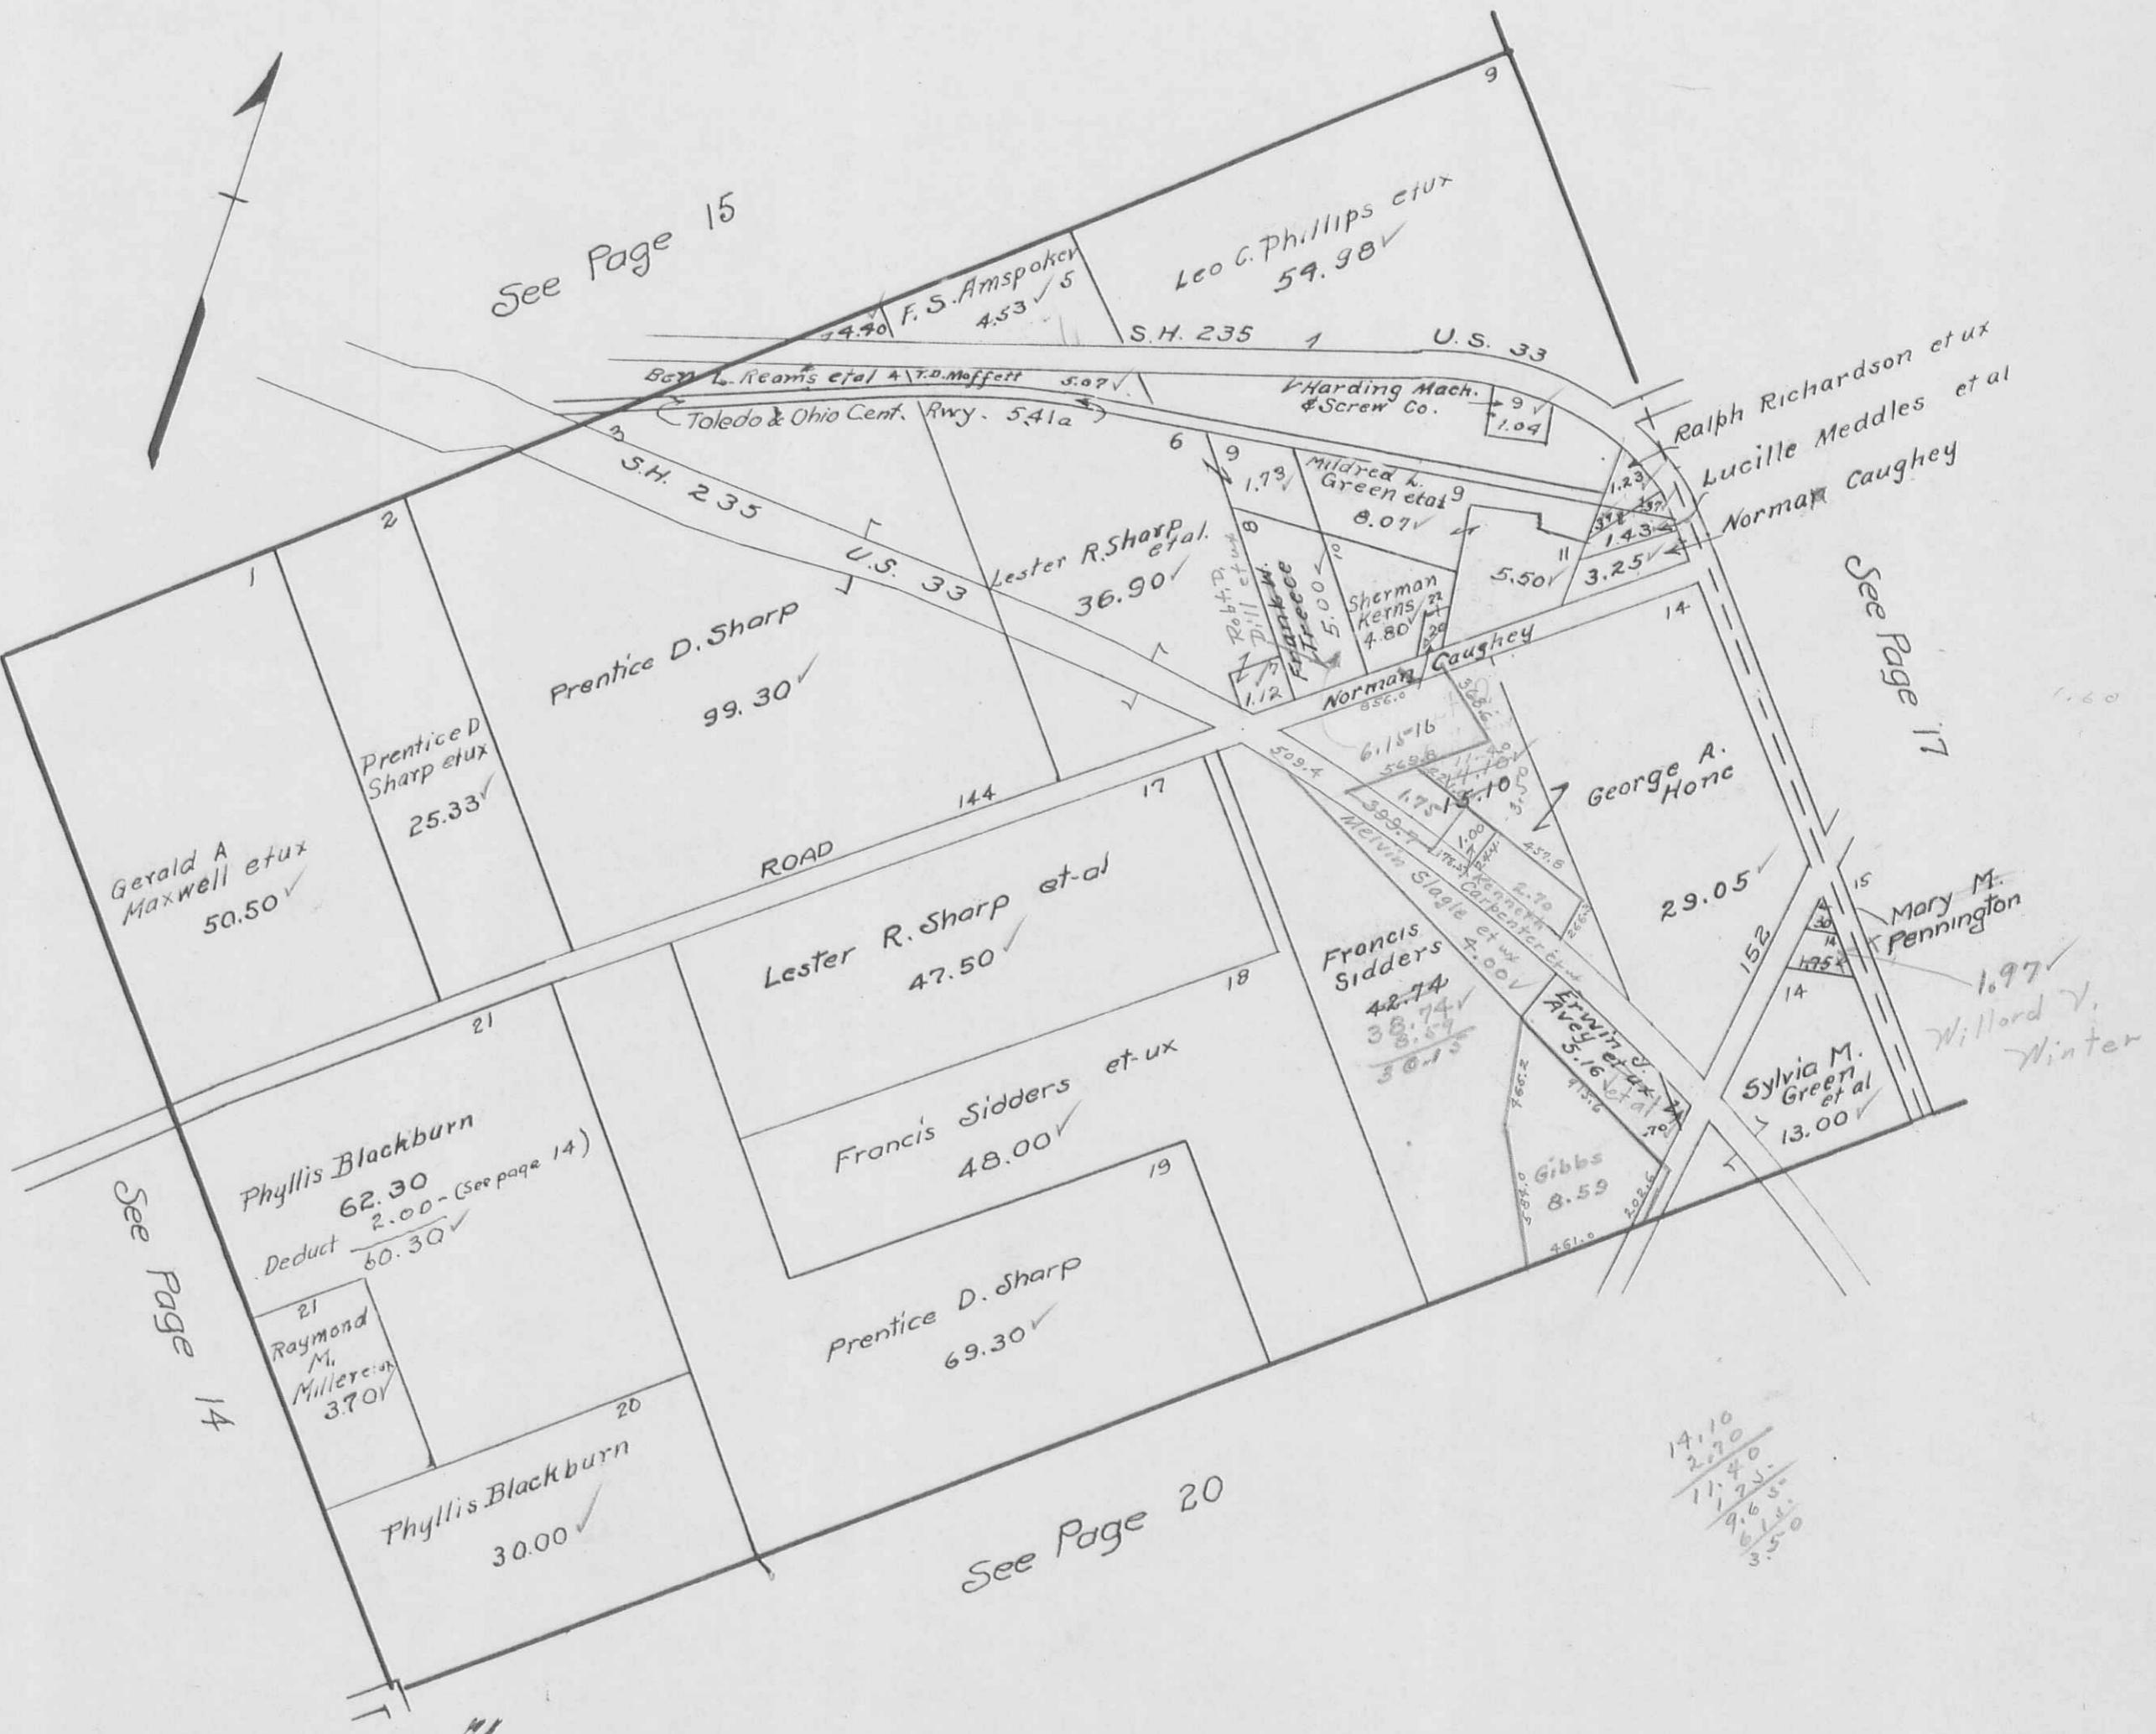

PERRY

TOWNSHIP


PAGE

17

VIRGINIA MILITARY SURVEY 4689

SCALE 10 CHAINS TO THE INCH


Sec Page 15

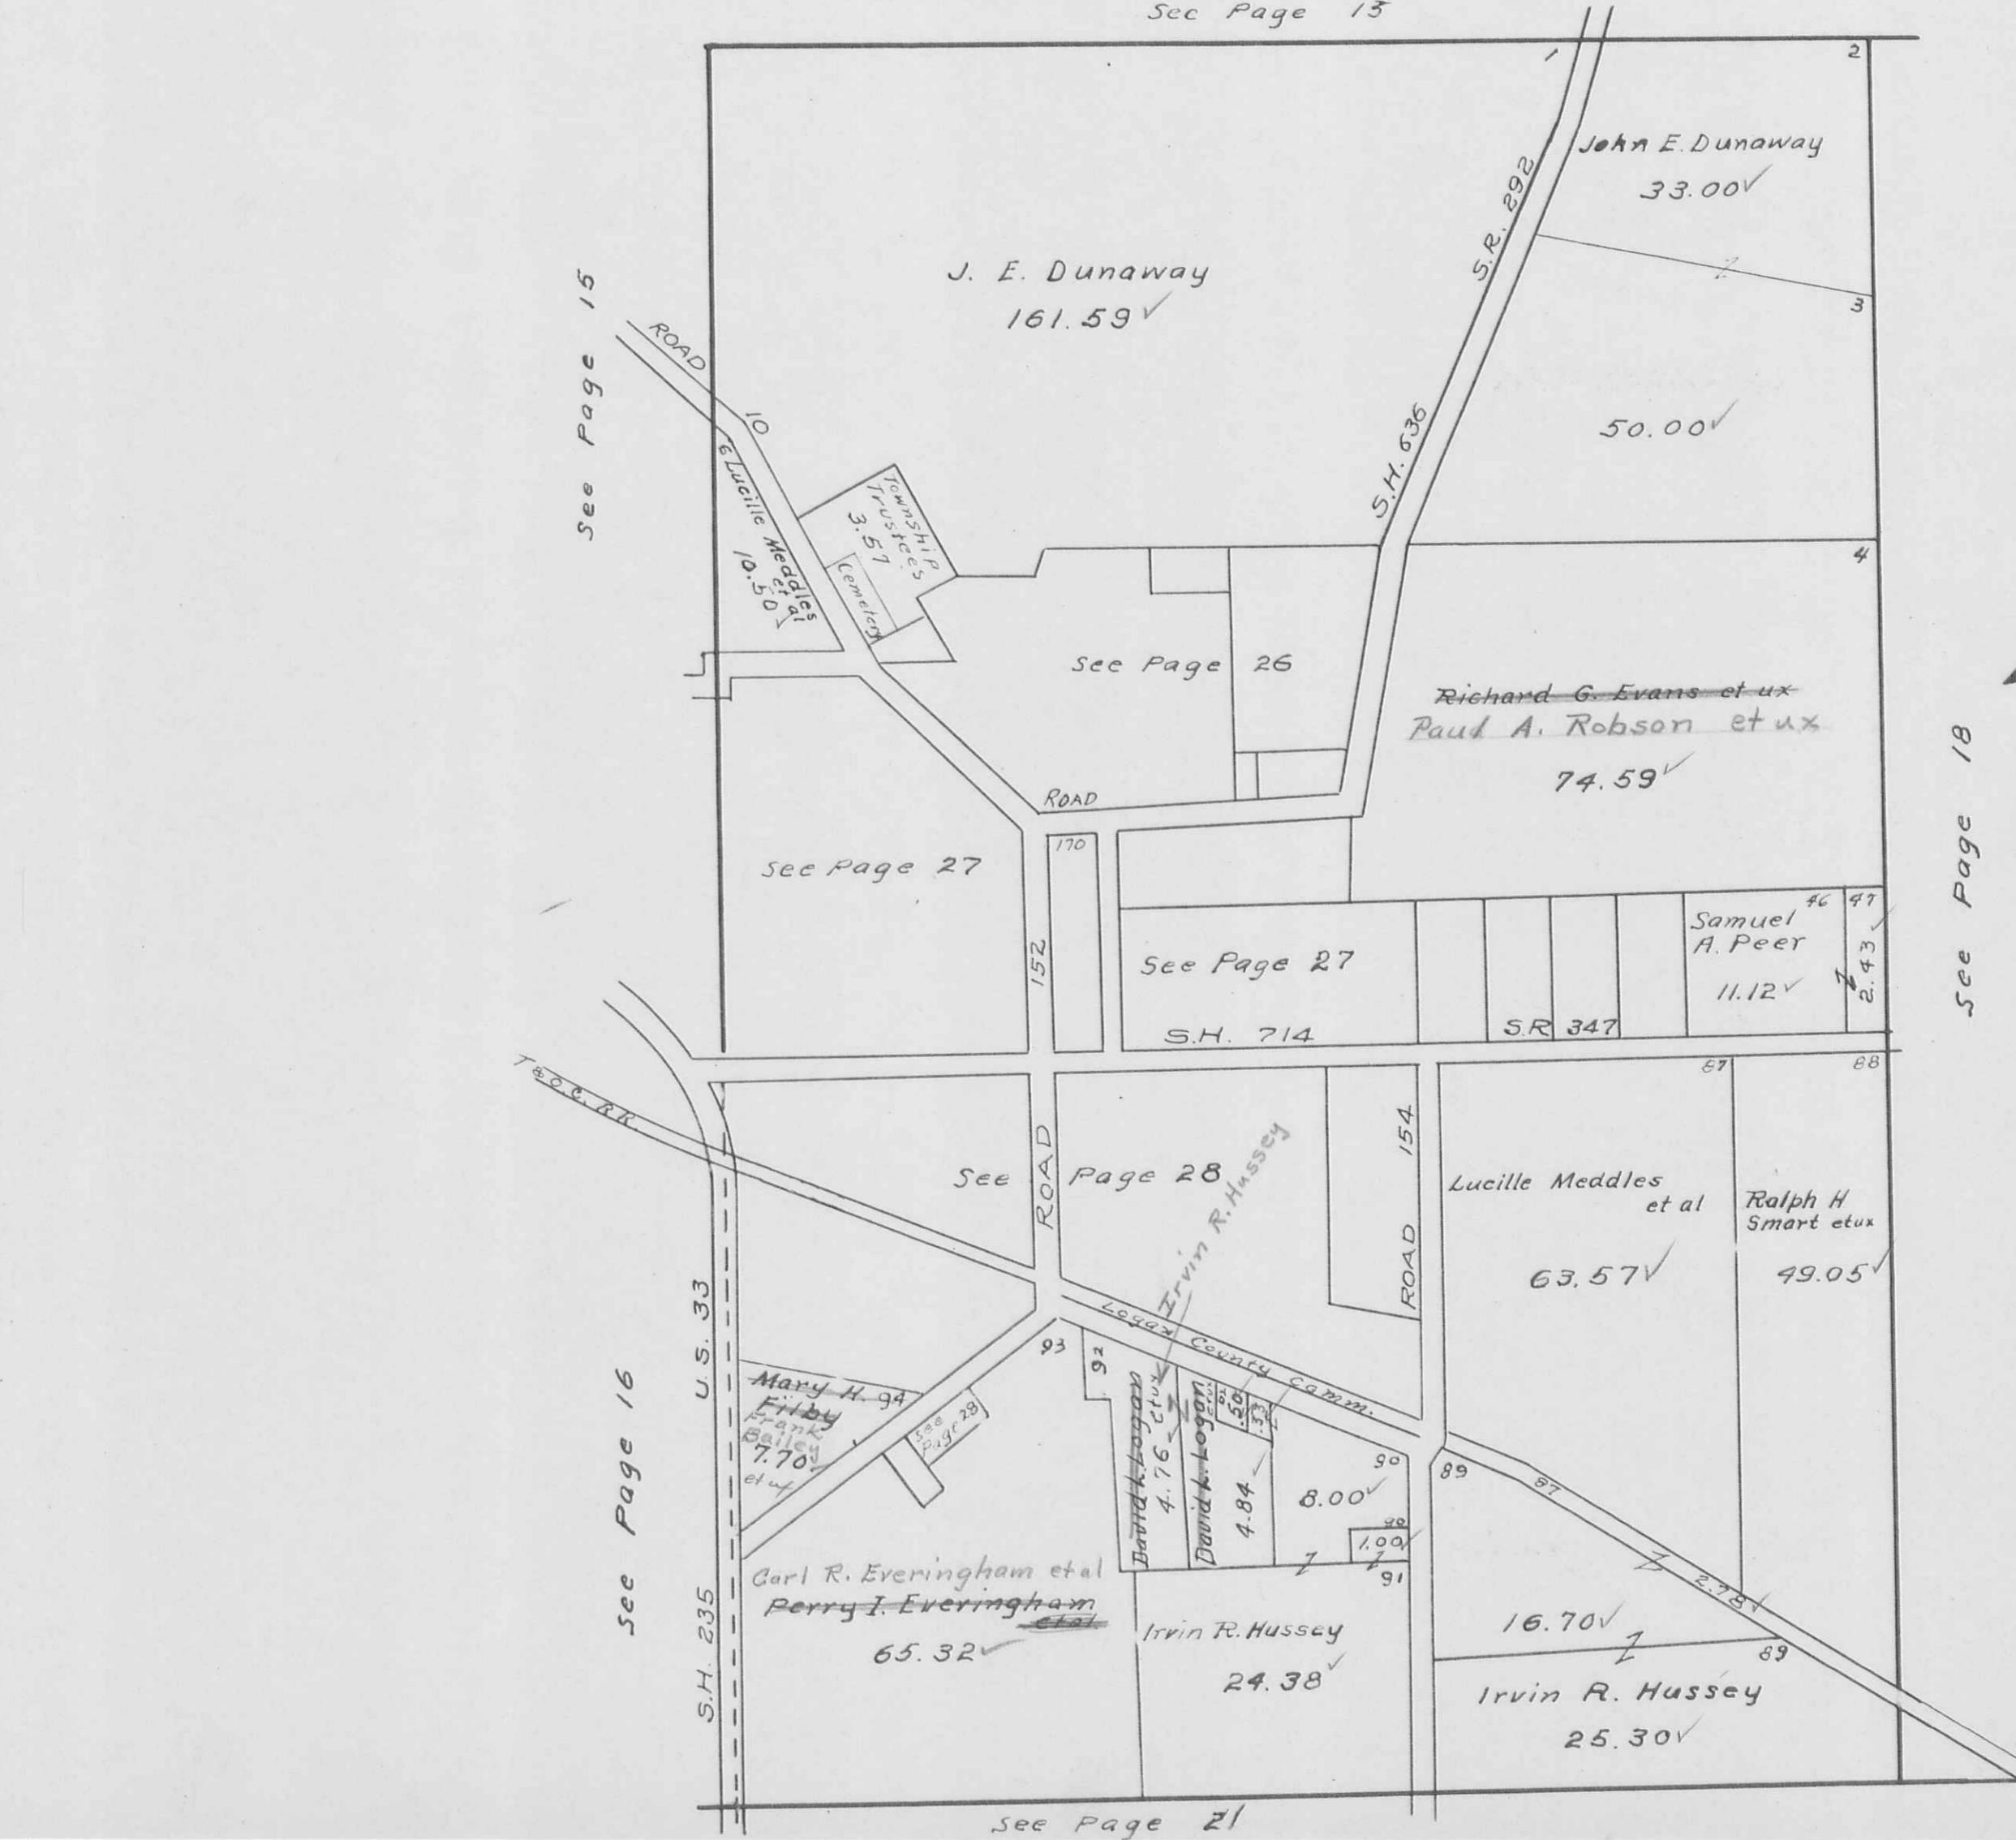

VIRGINIA MILITARY SURVEY 4810

SCALE 10 CHAINS TO THE INCH

See Page 19

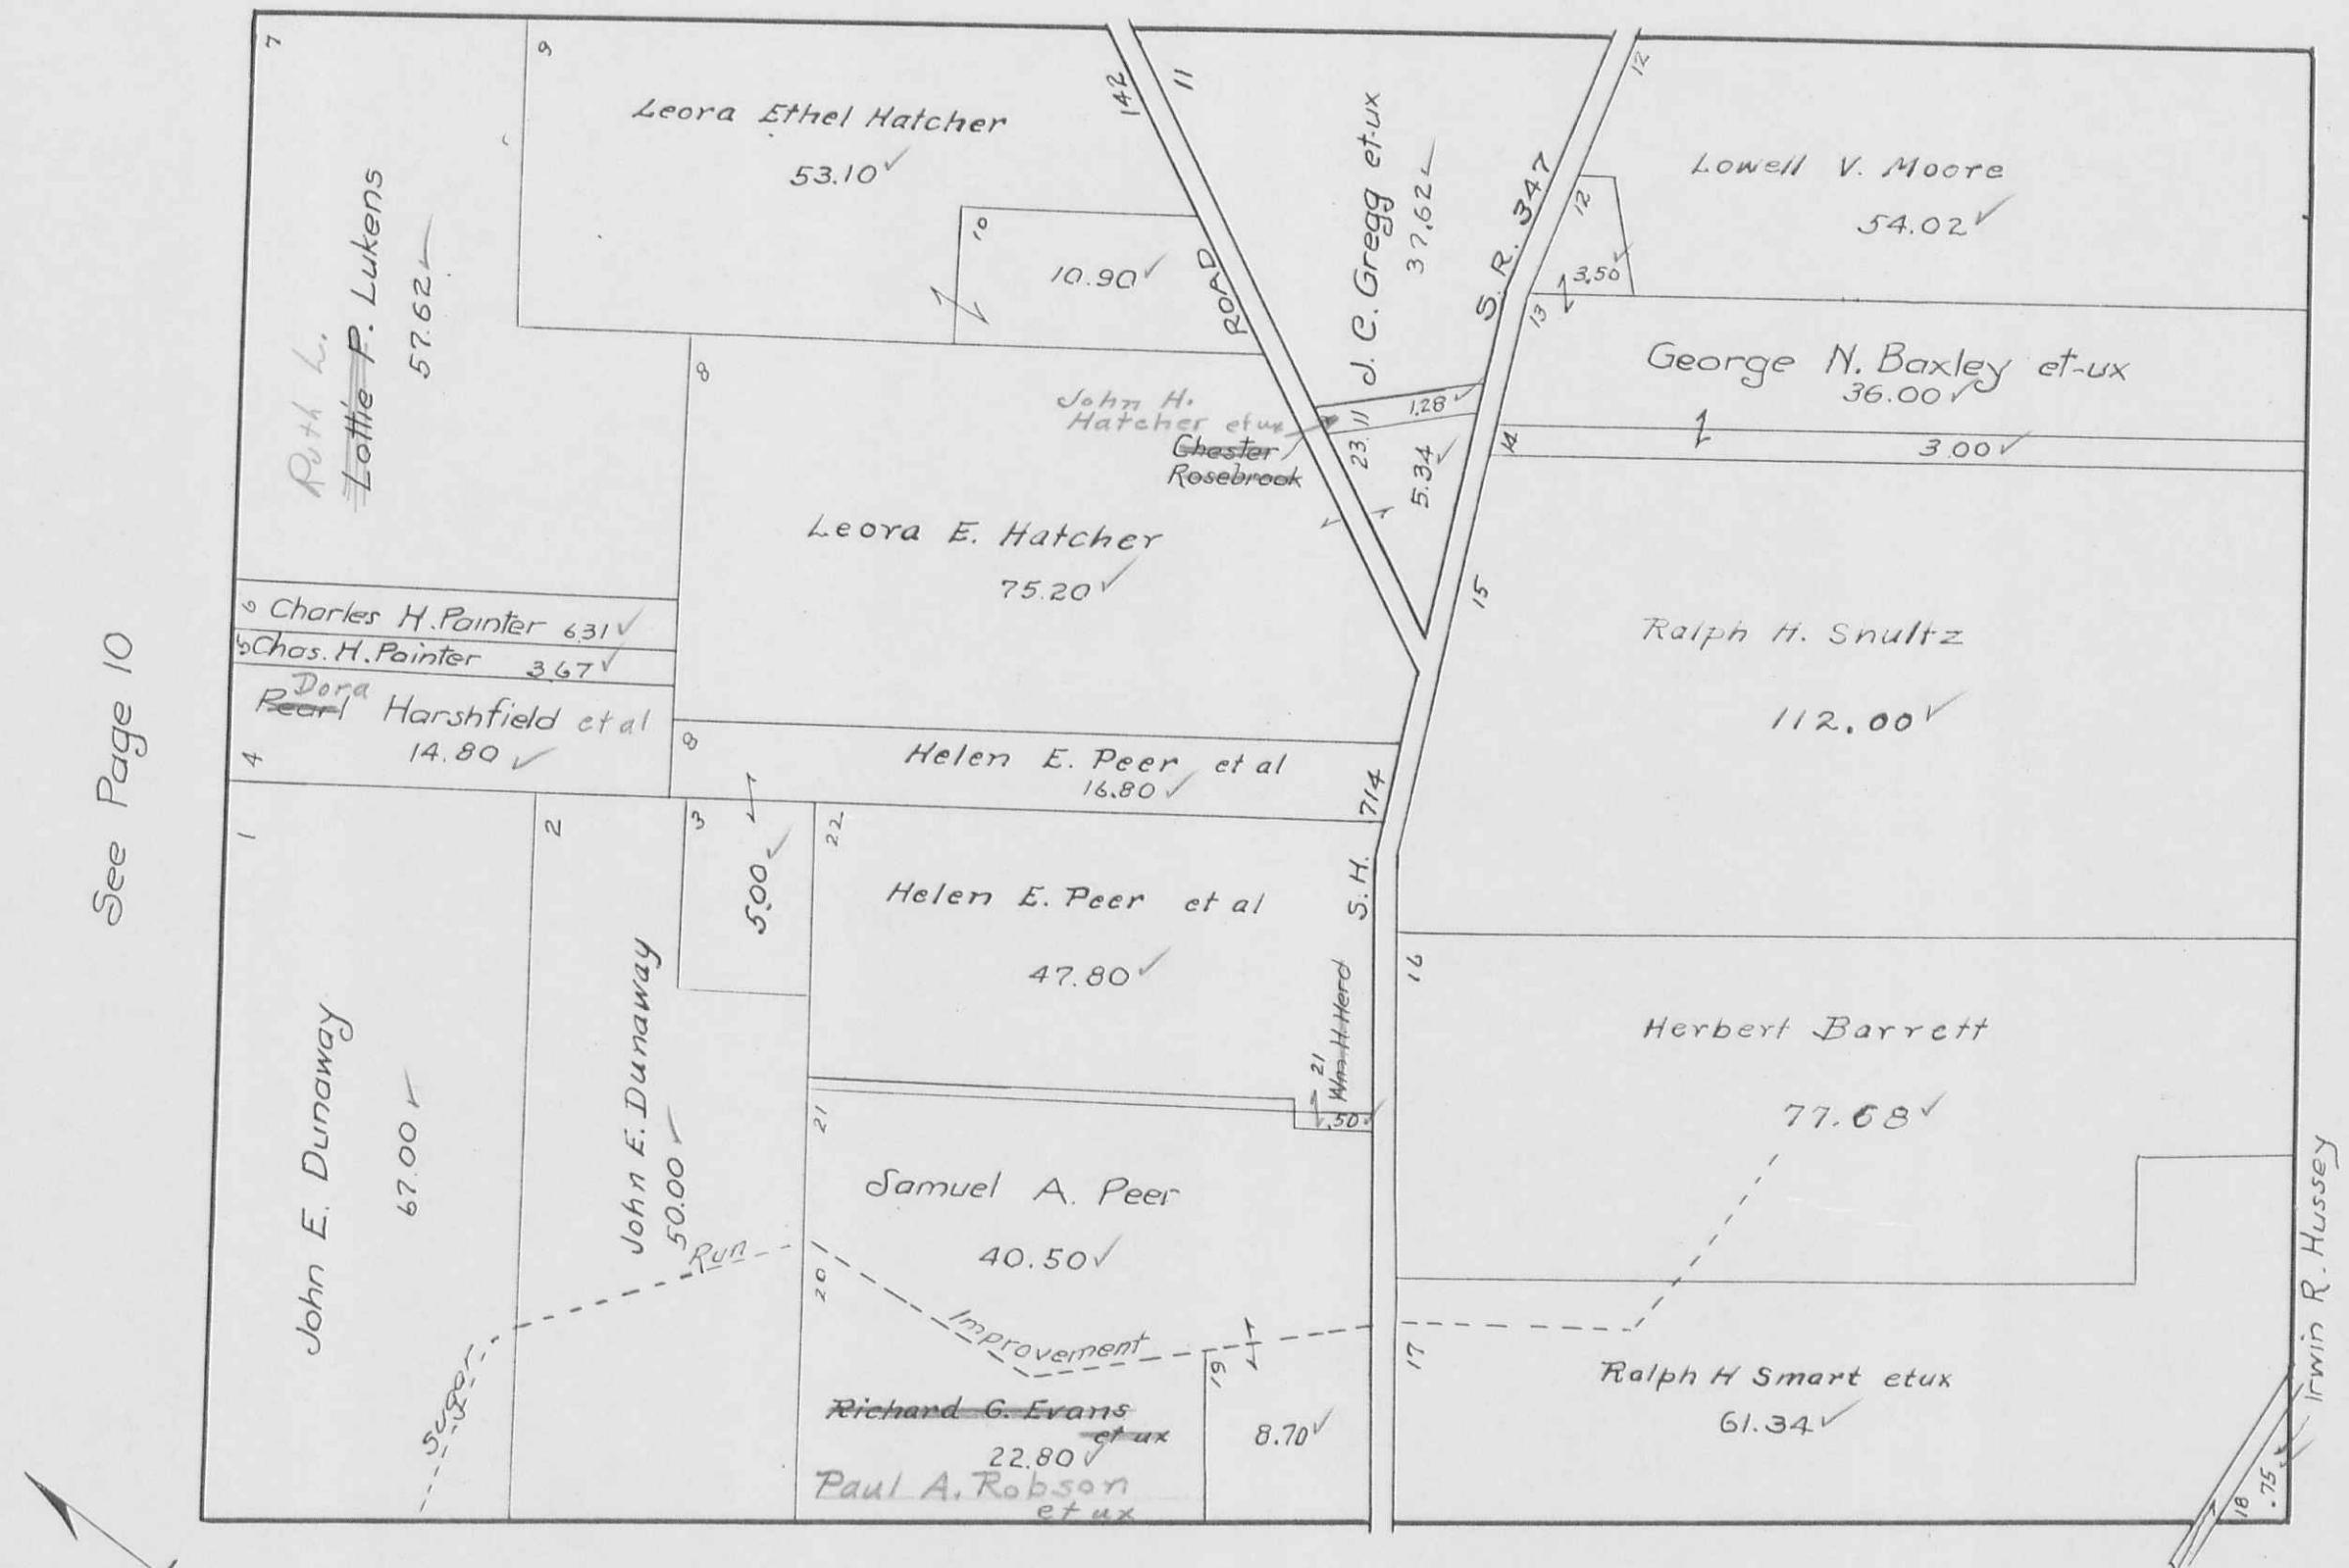

VIRGINIA MILITARY SURVEY 6232

SCALE 10 CHAINS TO THE INCH

See Page 10

See Page 11

UNION COUNTY



PERRY


TOWNSHIP

PAGE 20

VIRGINIA

MILITARY SURVEY 3154

SCALE 10 CHAINS TO THE INCH

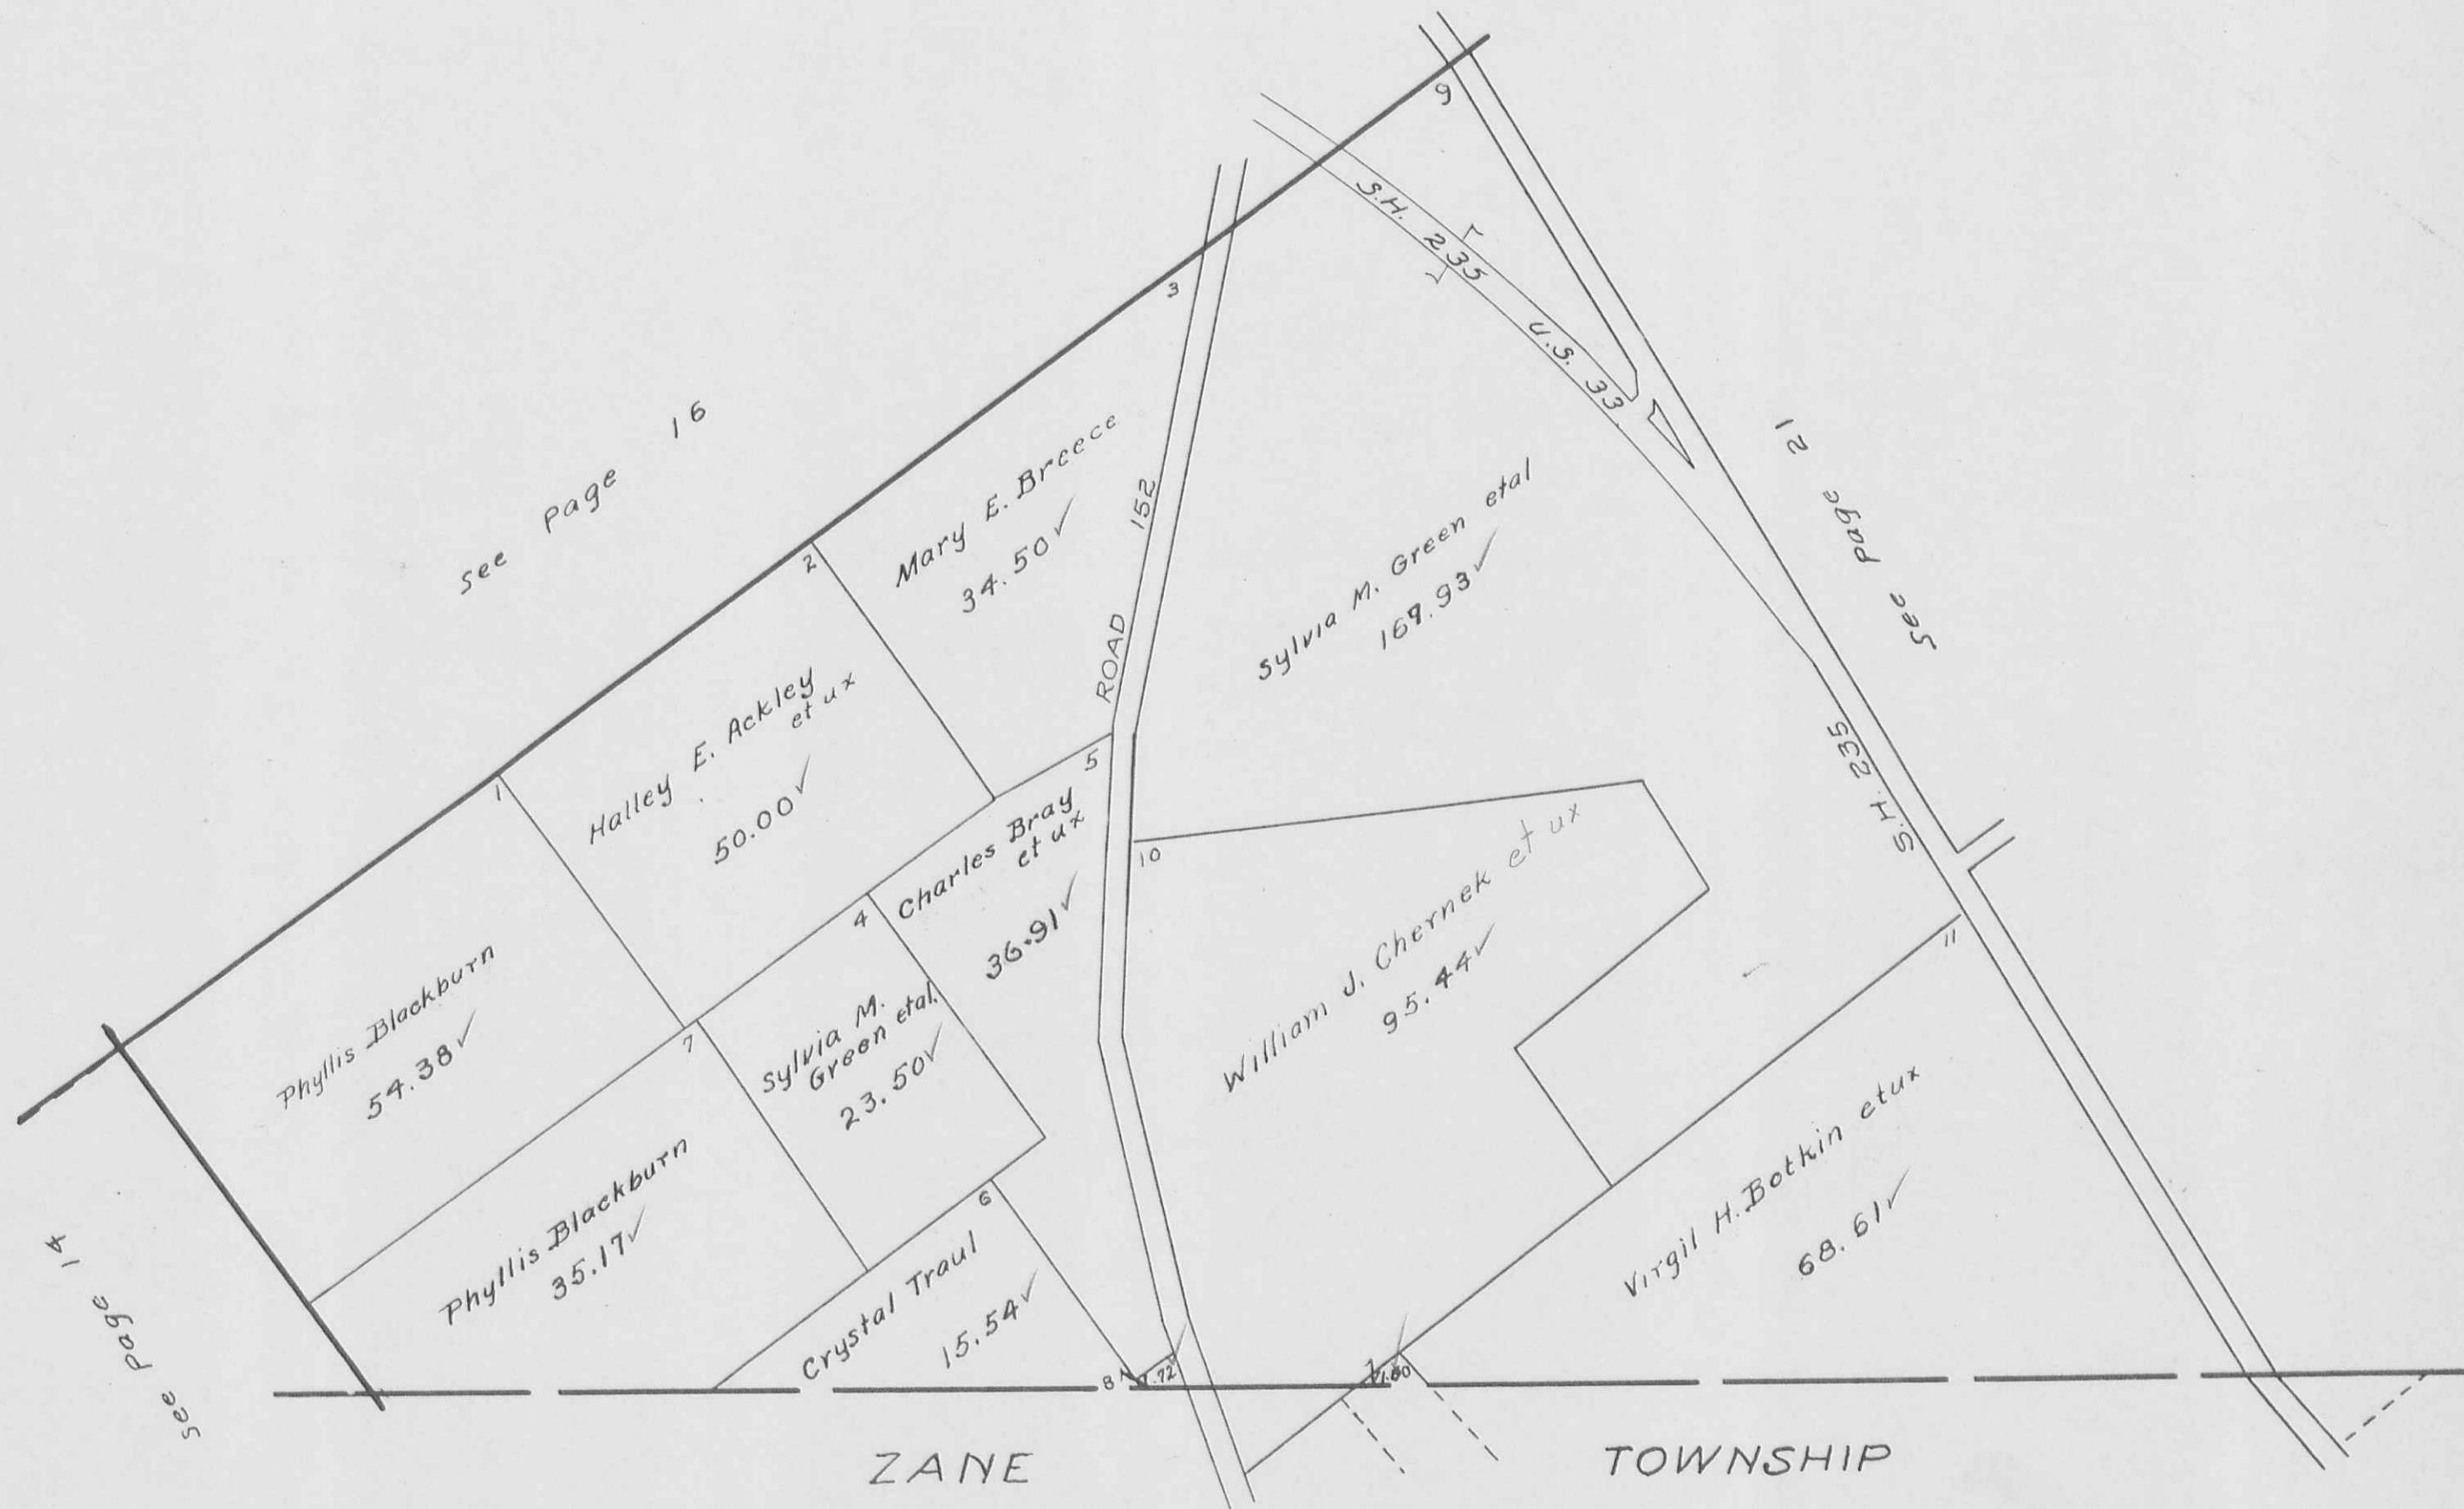

PERRY

TOWNSHIP


PAGE 21

VIRGINIA

MILITARY

SURVEY 4811


SCALE 10 CHAINS TO THE INCH

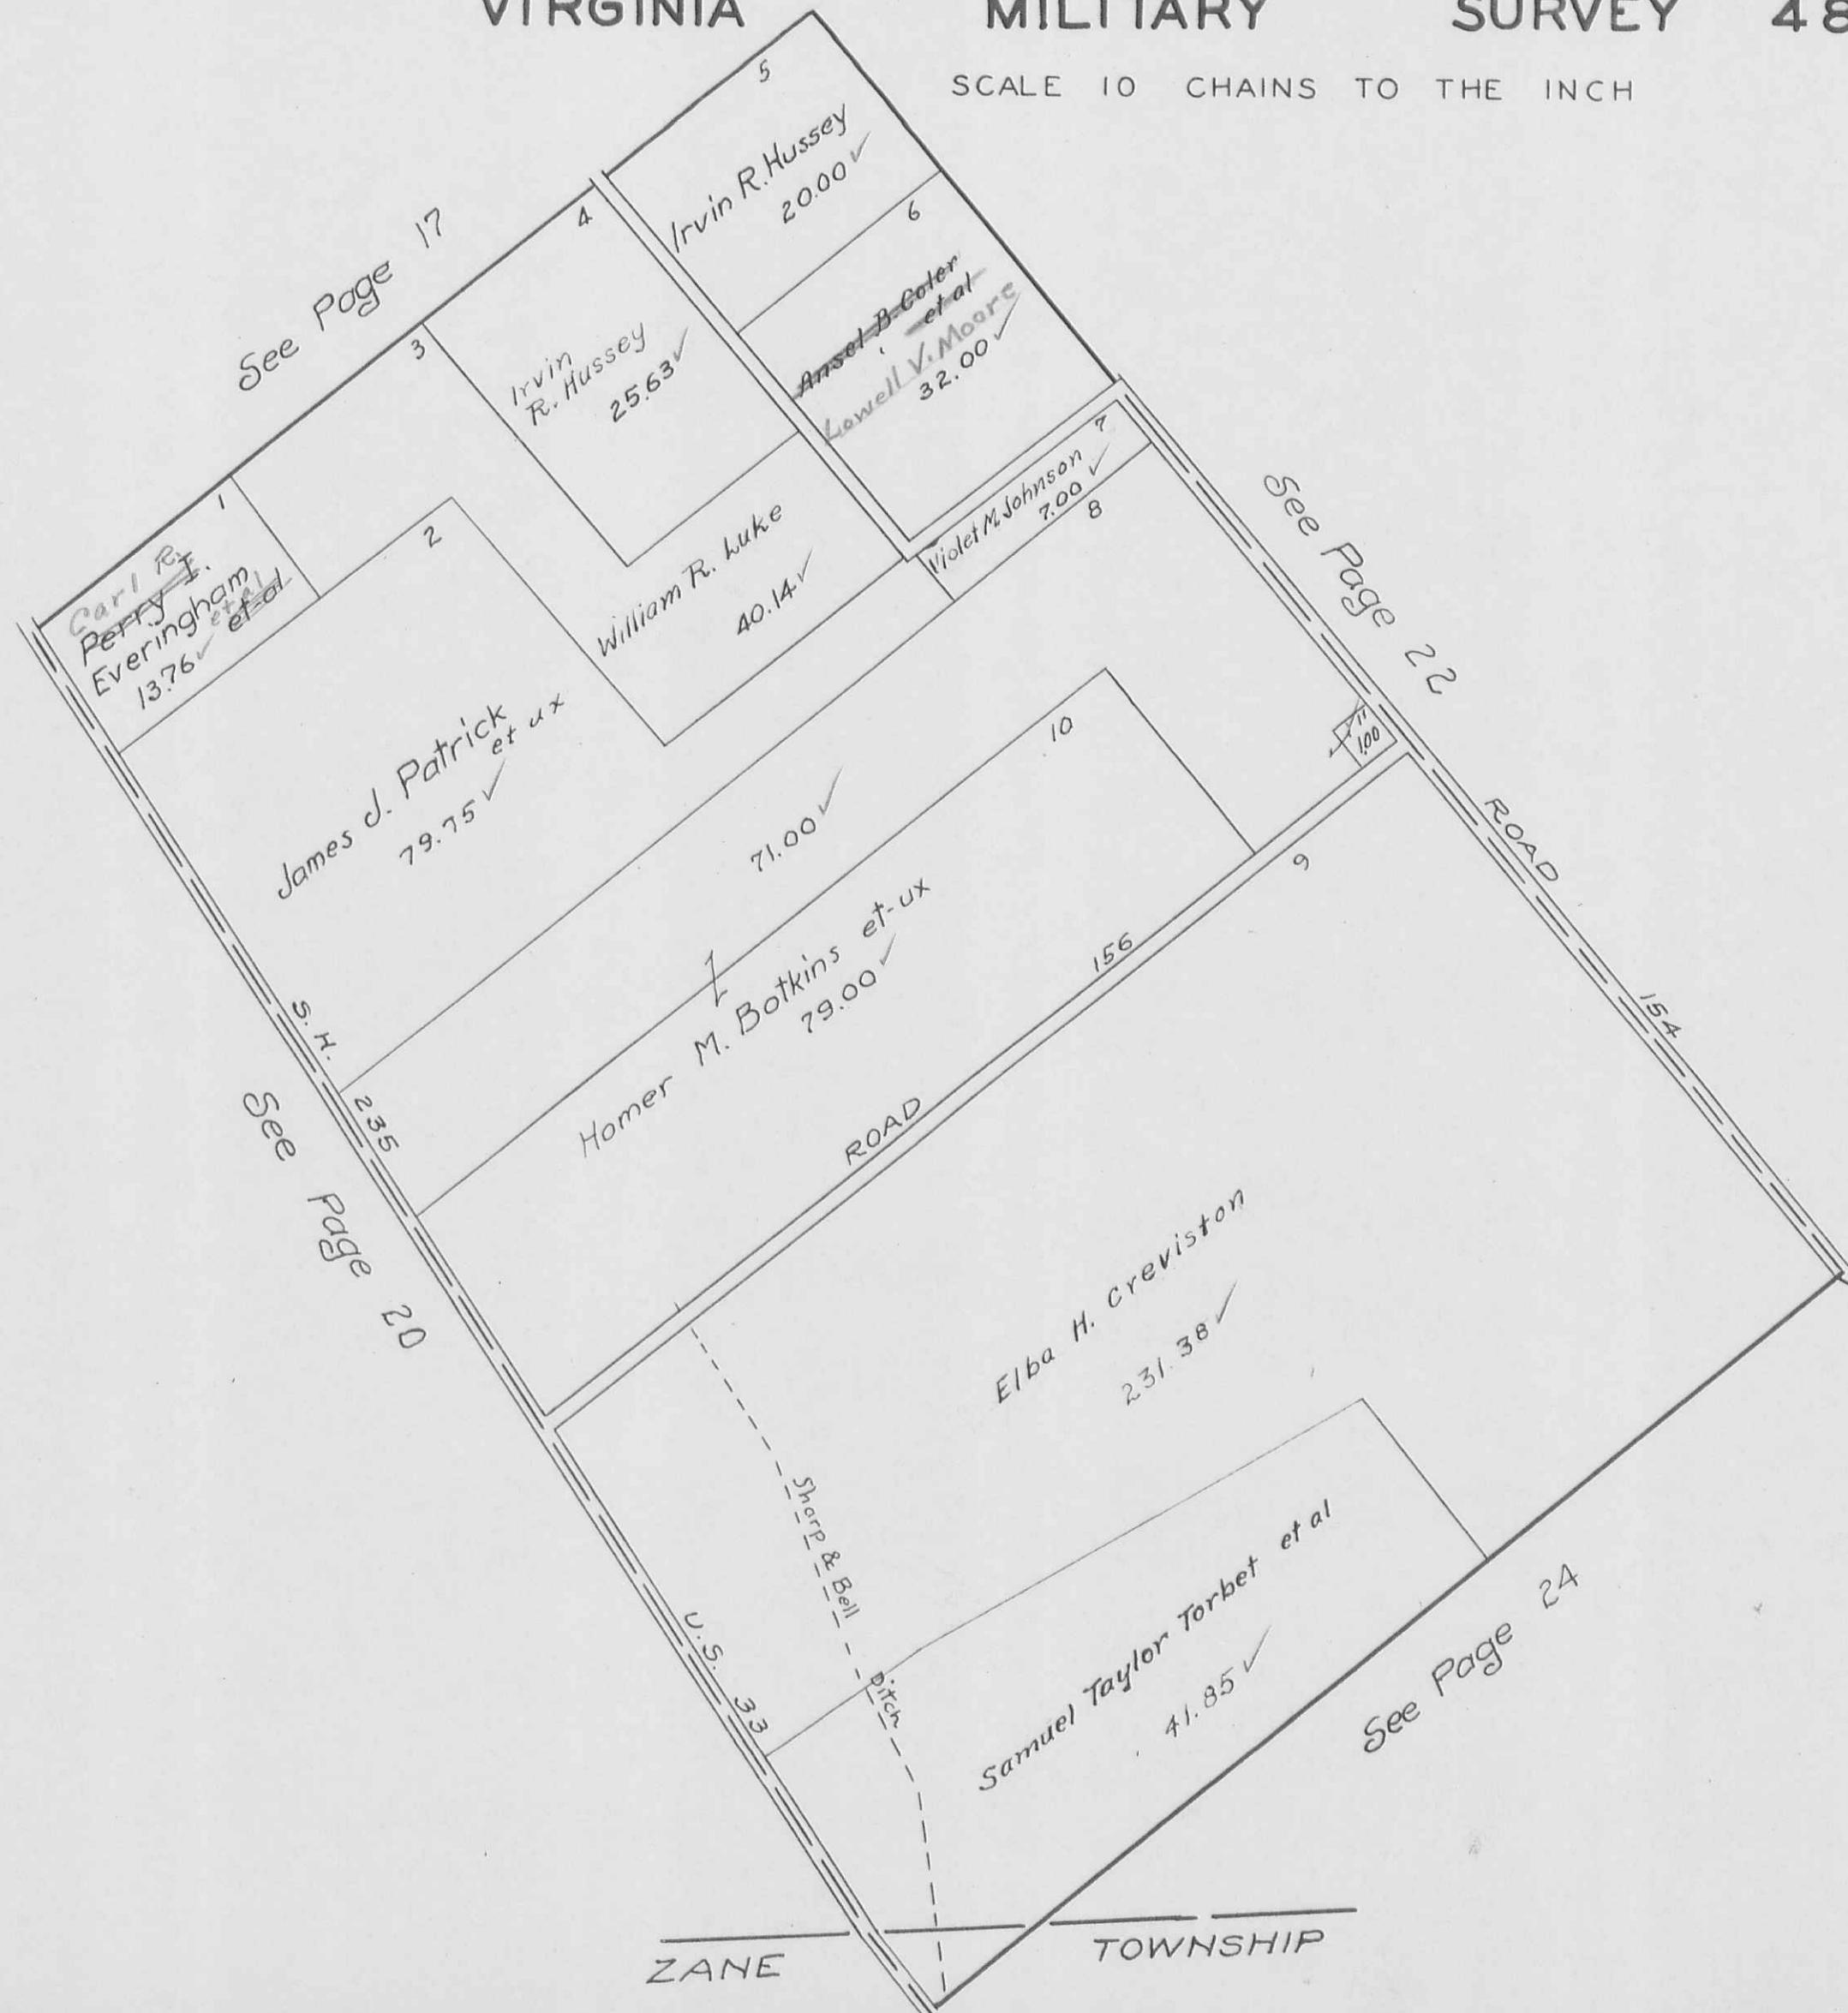

VIRGINIA



SCALE 10 CHAINS TO THE INCH

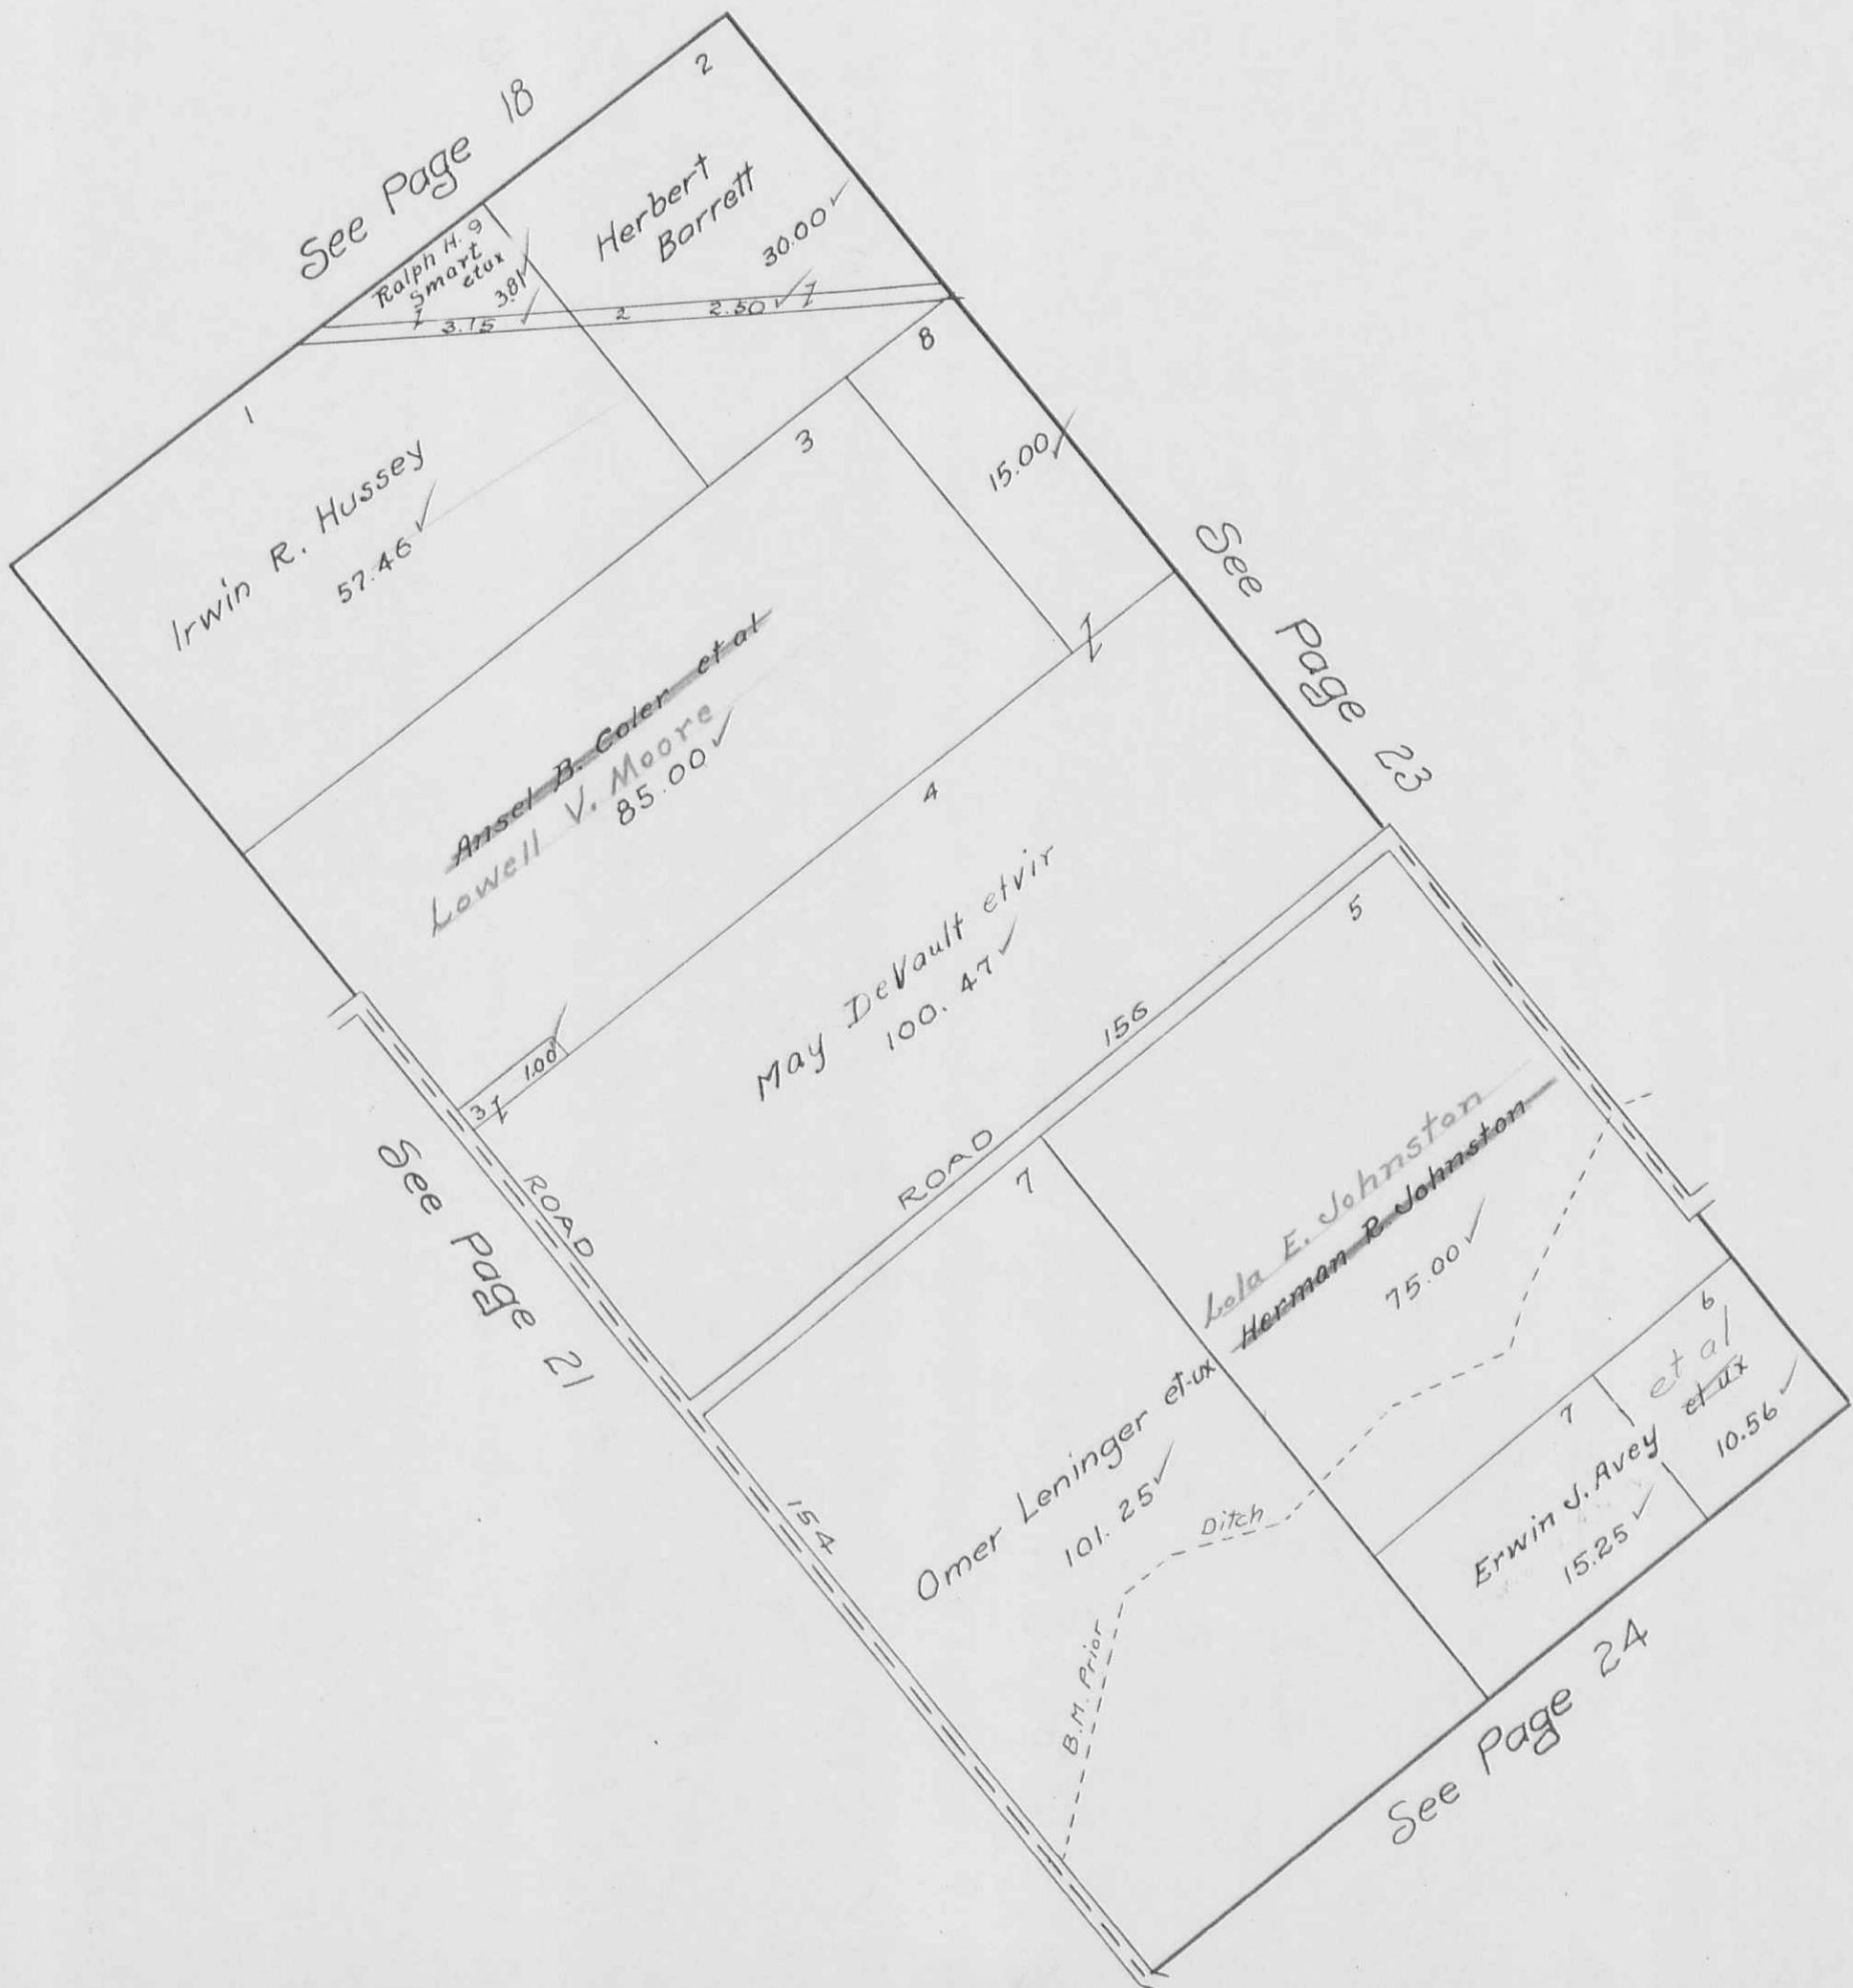

PERRY TOWNSHIP
VIRGINIA MILITARY SURVEYS 12283
14755
SCALE 10 CHAINS TO THE INCH

PAGE 23

SCALE 10 CHAINS TO THE INCH

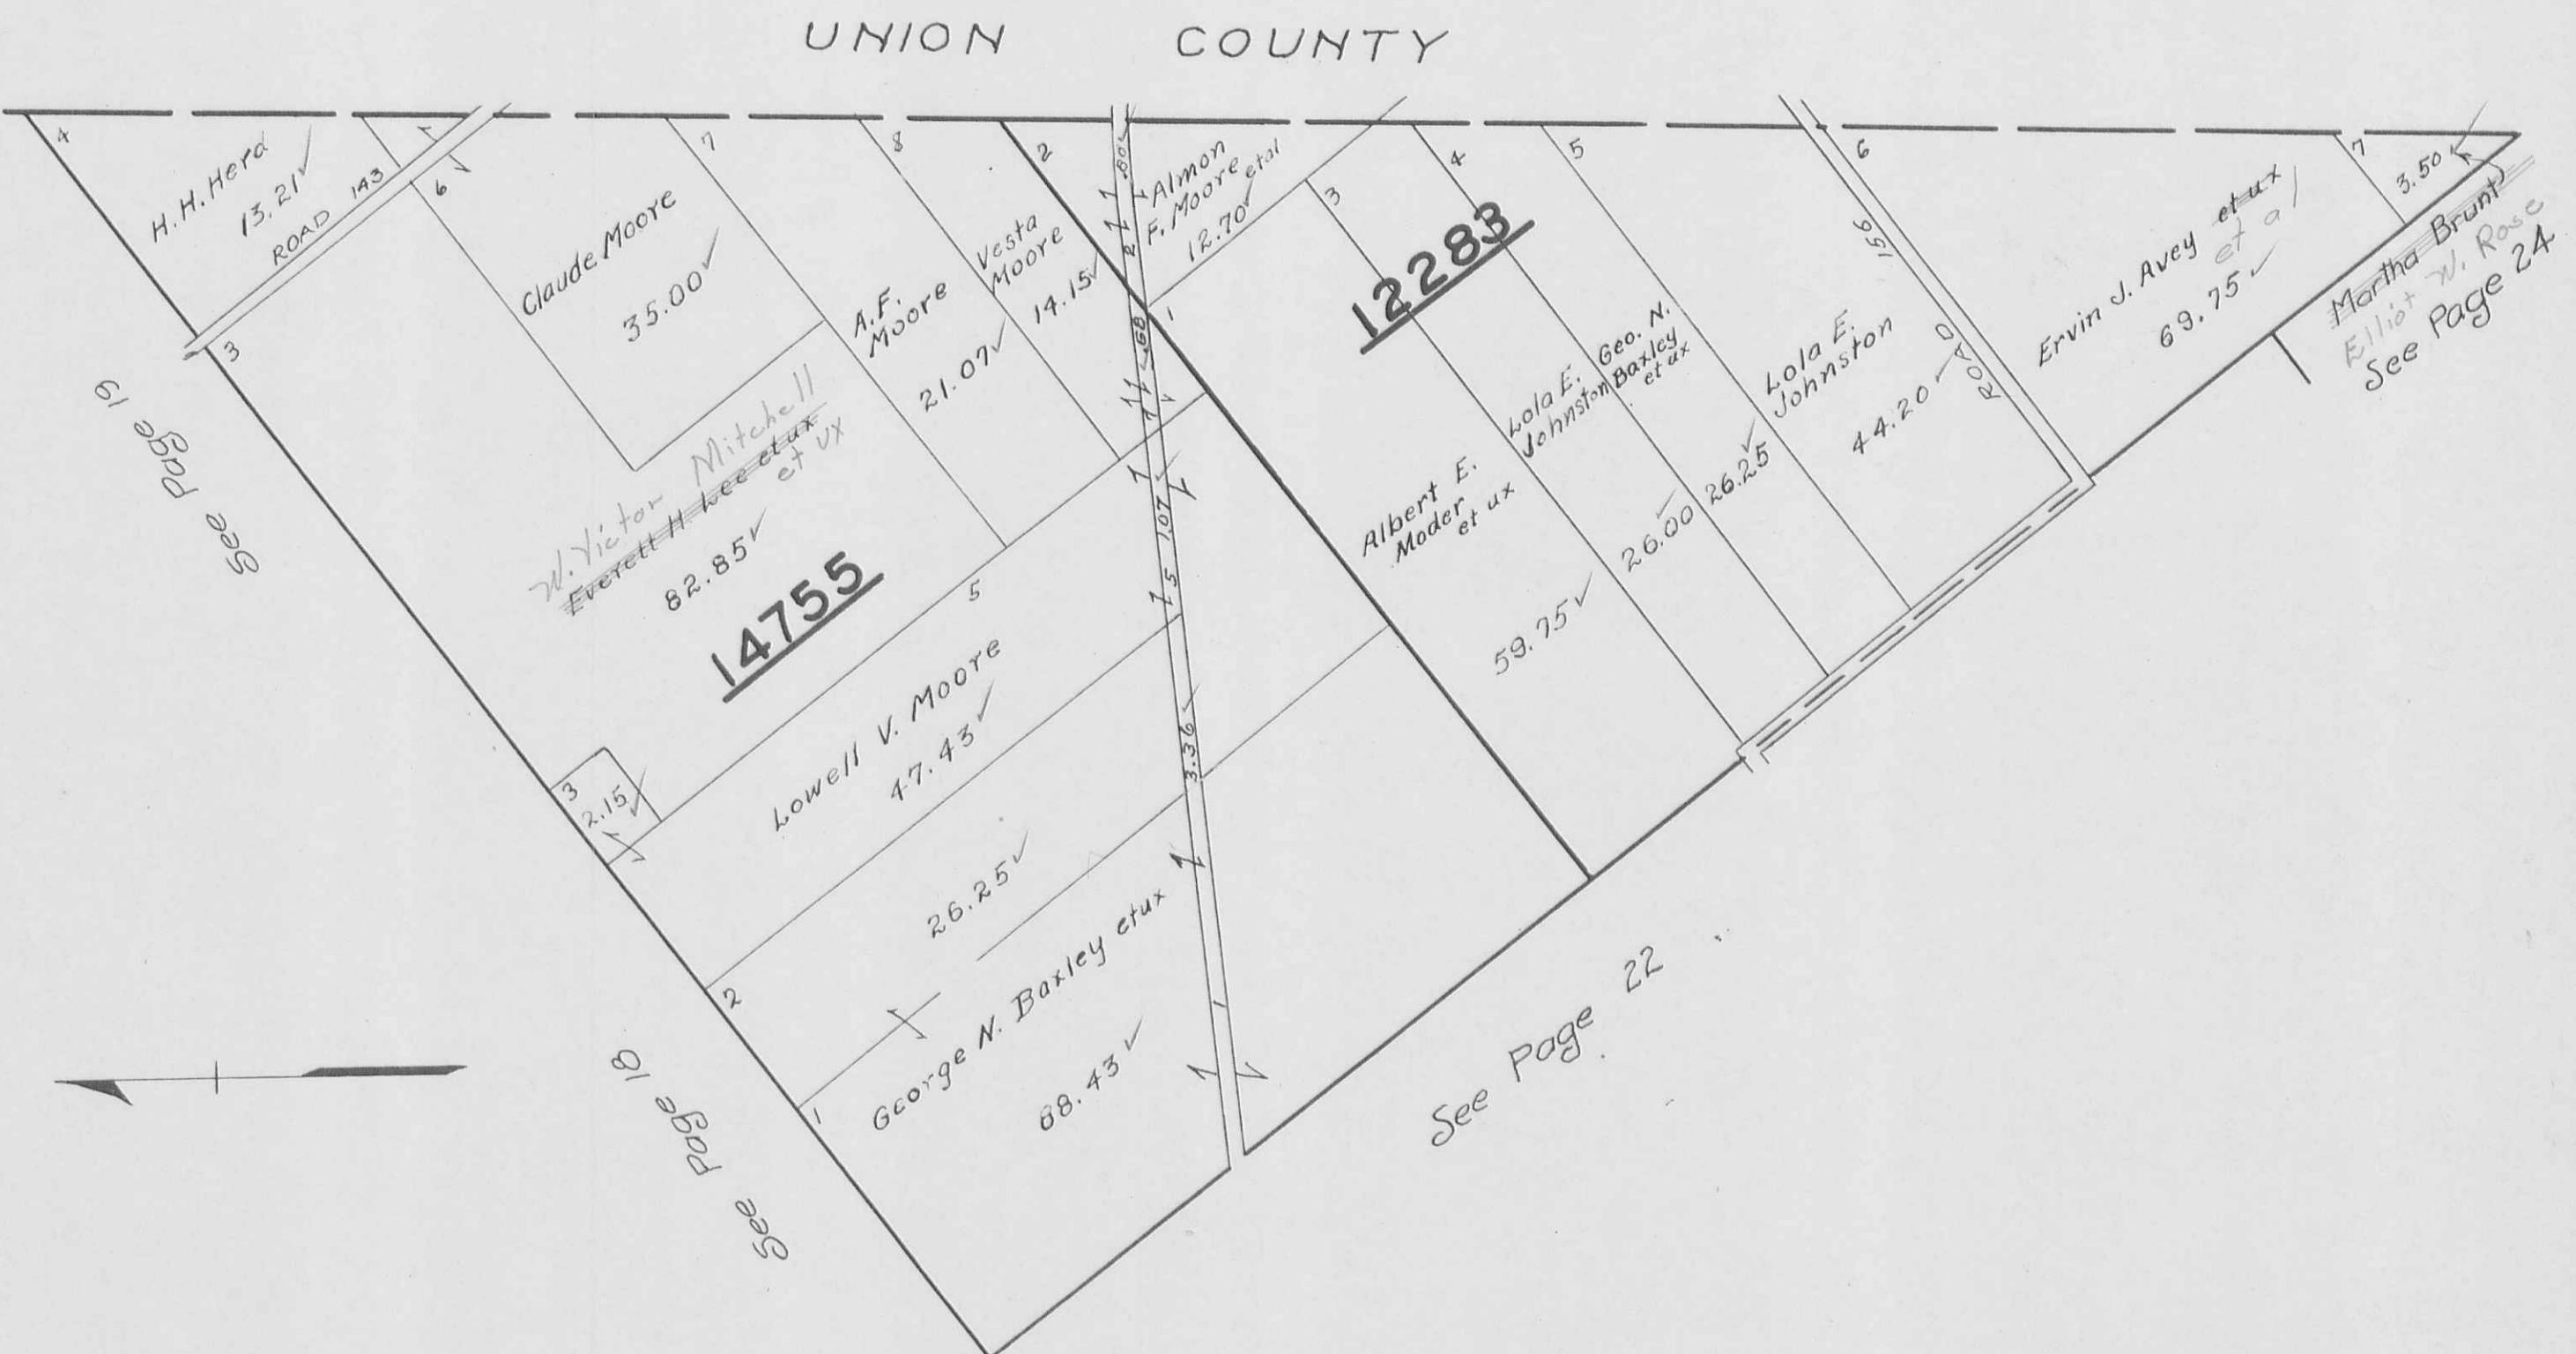


VIRGINIA

MILITARY SURVEYS


SCALE 10 CHAINS TO THE INCH

545
 12399
 12404
 12395
 12427
 12428

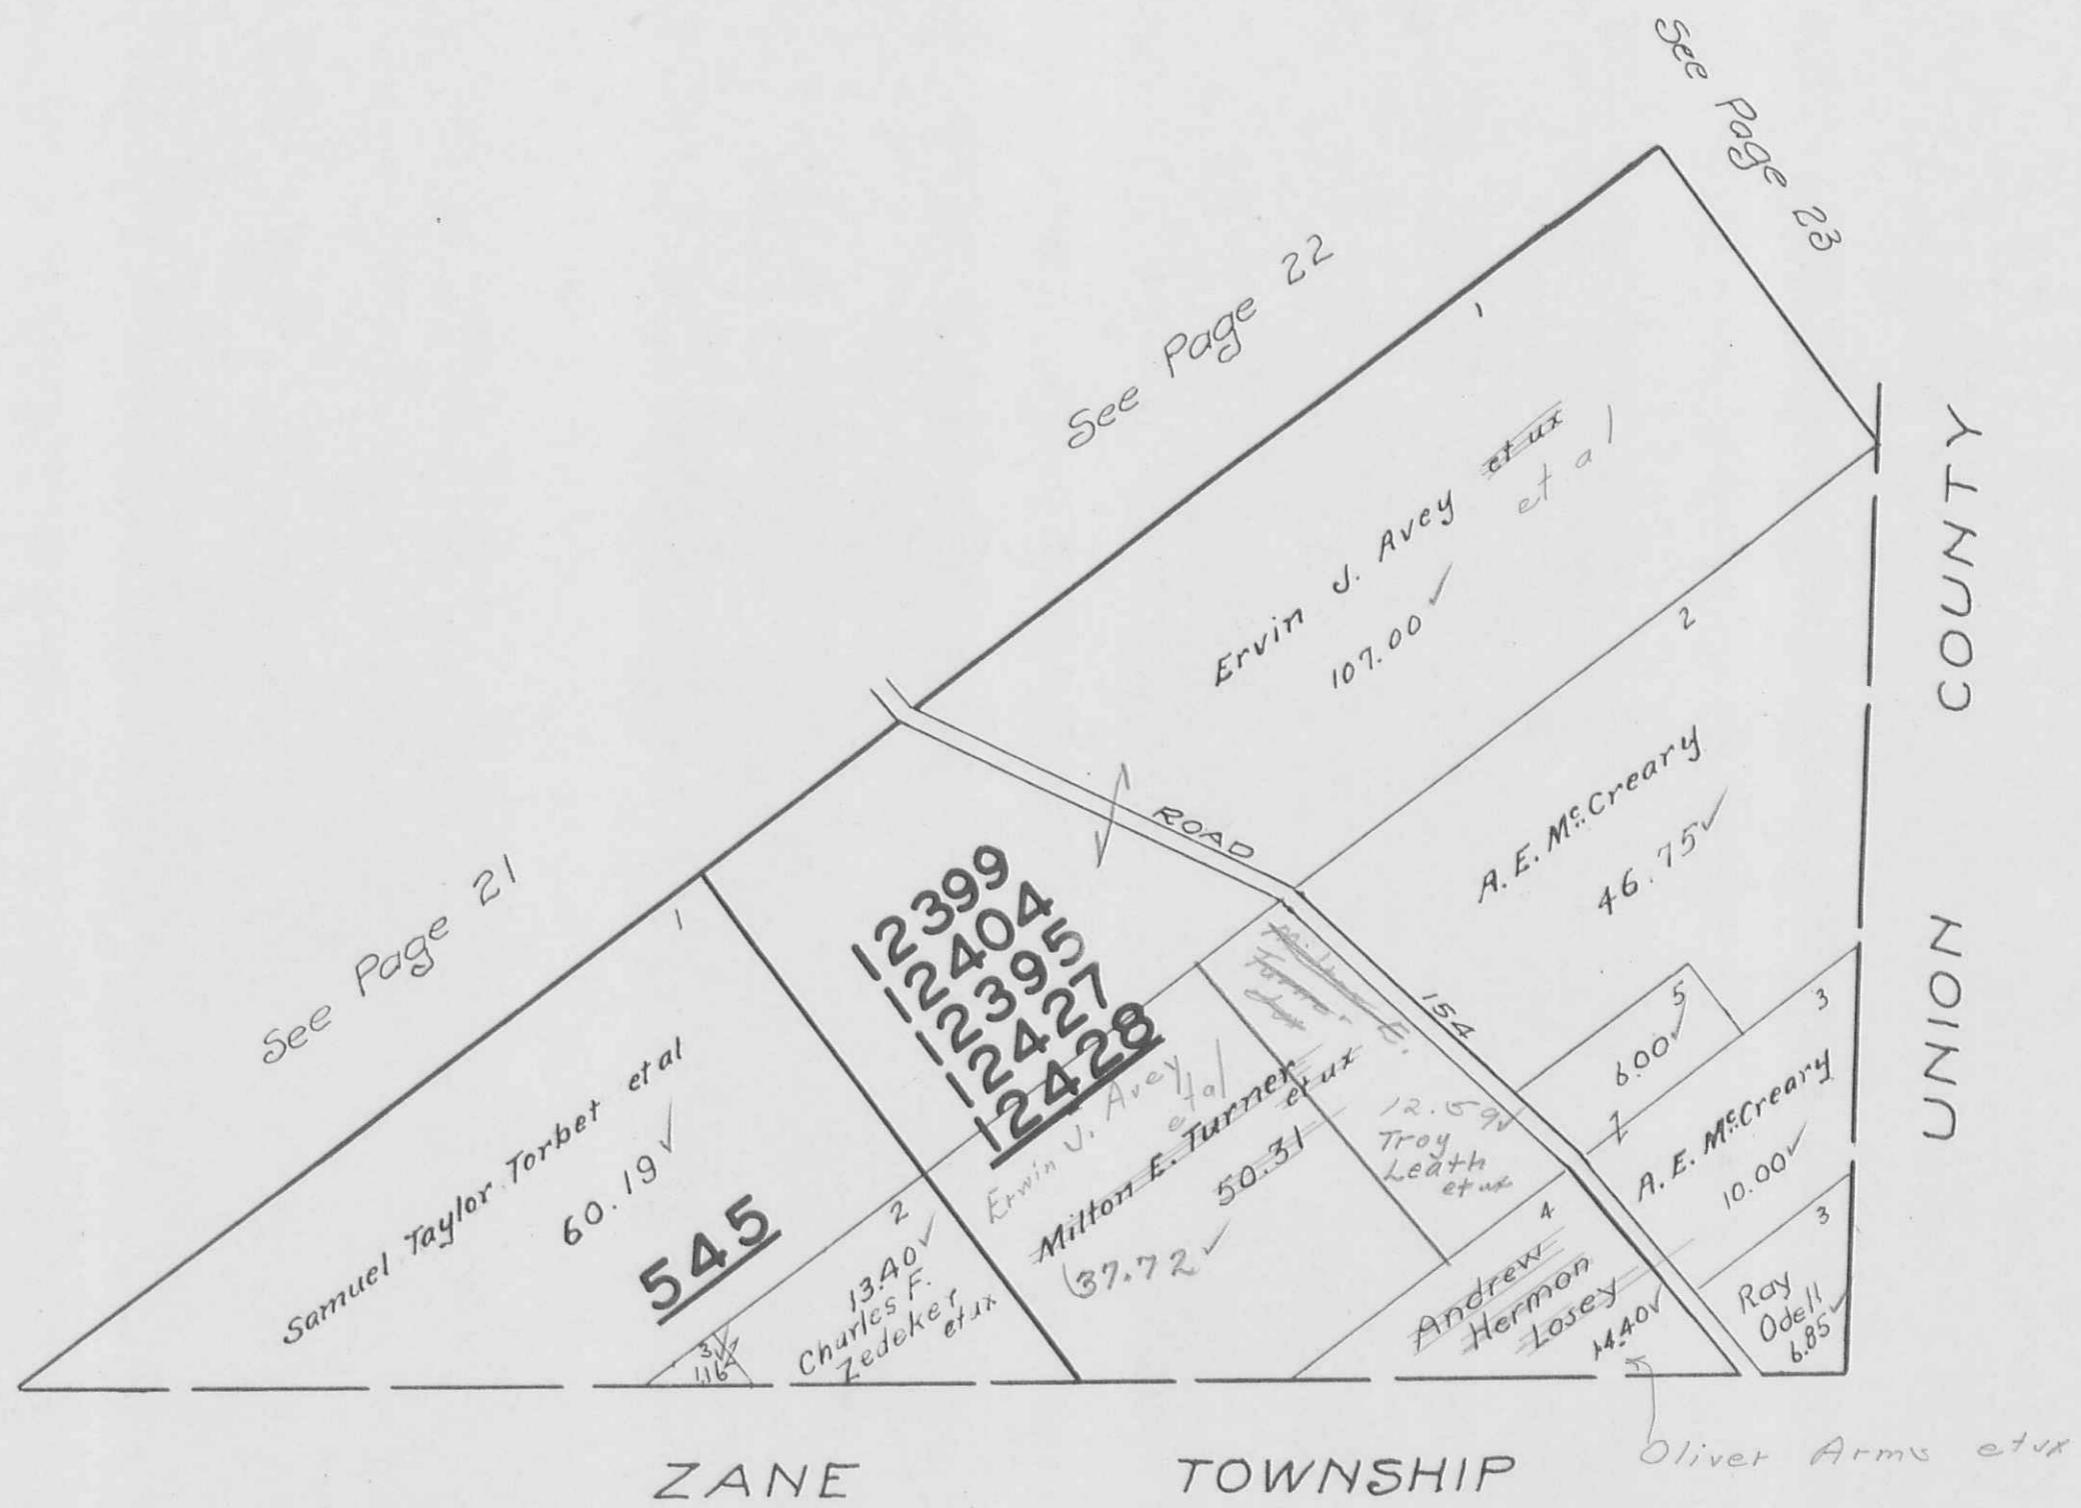

WEST MANSFIELD CORPORATION


SCALE 300 FEET TO THE INCH

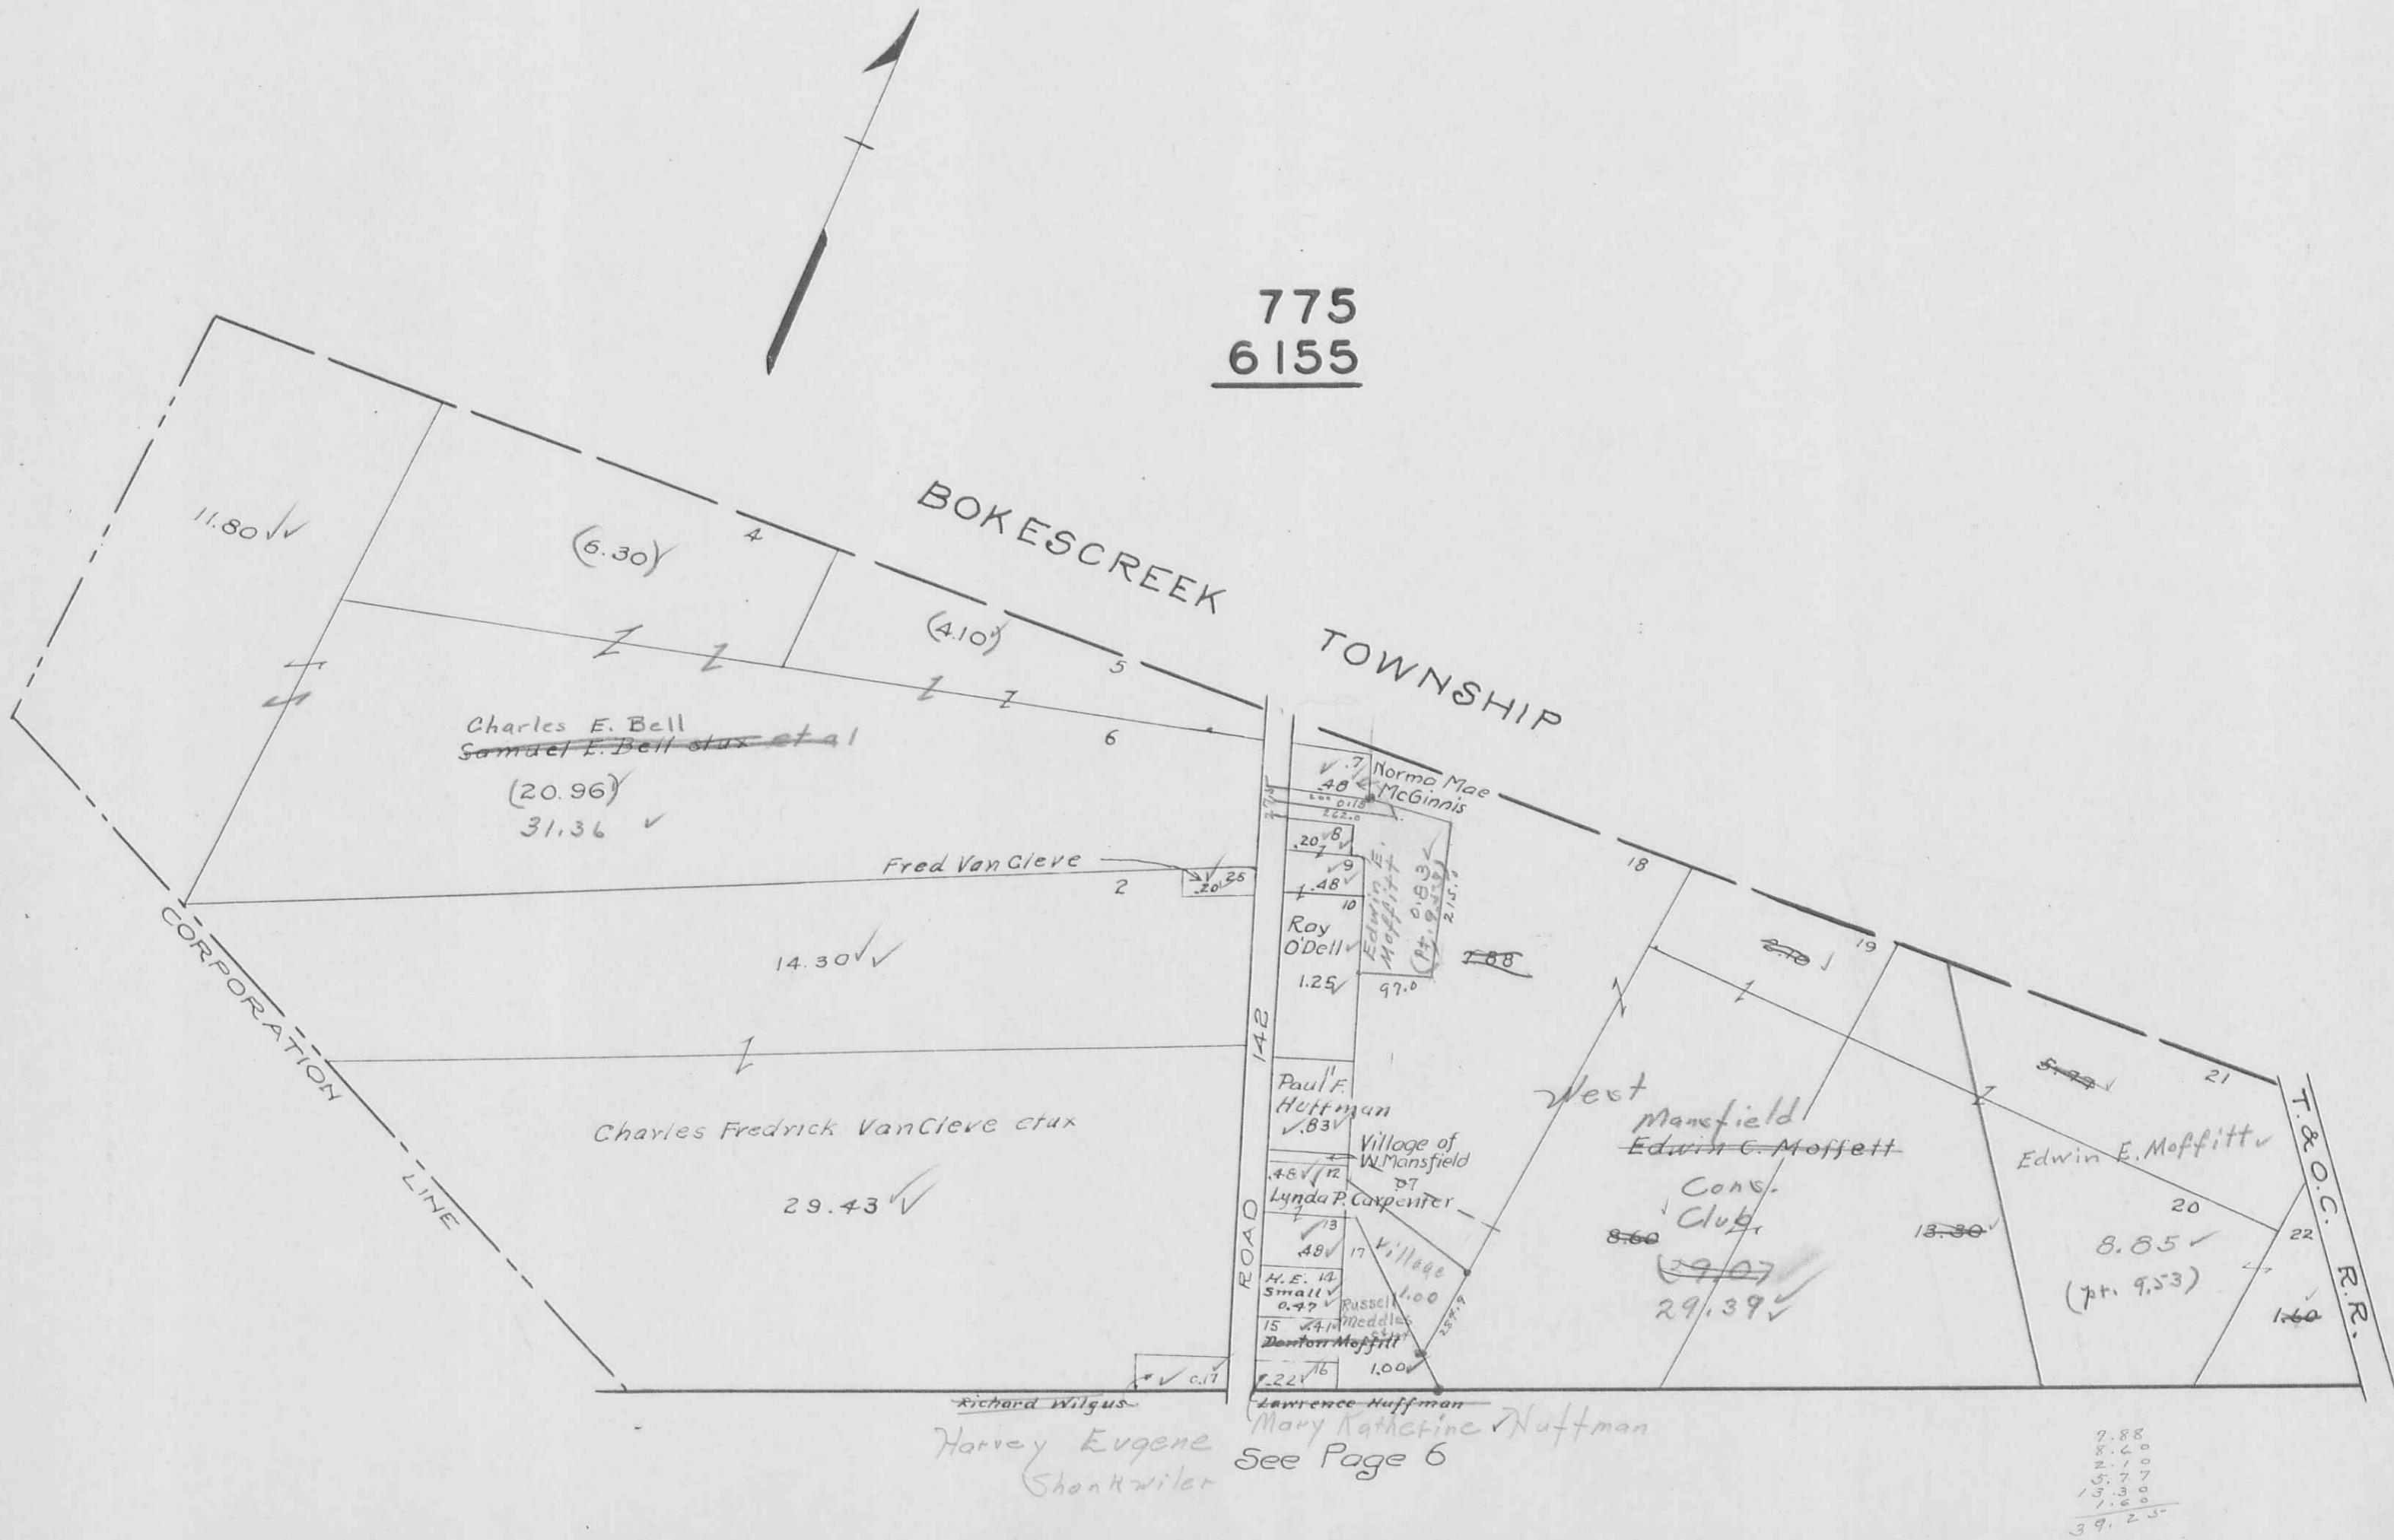

PERRY TOWNSHIP
NORTH EAST PART EAST LIBERTY

PAGE 26


SCALE 200 FEET TO THE INCH

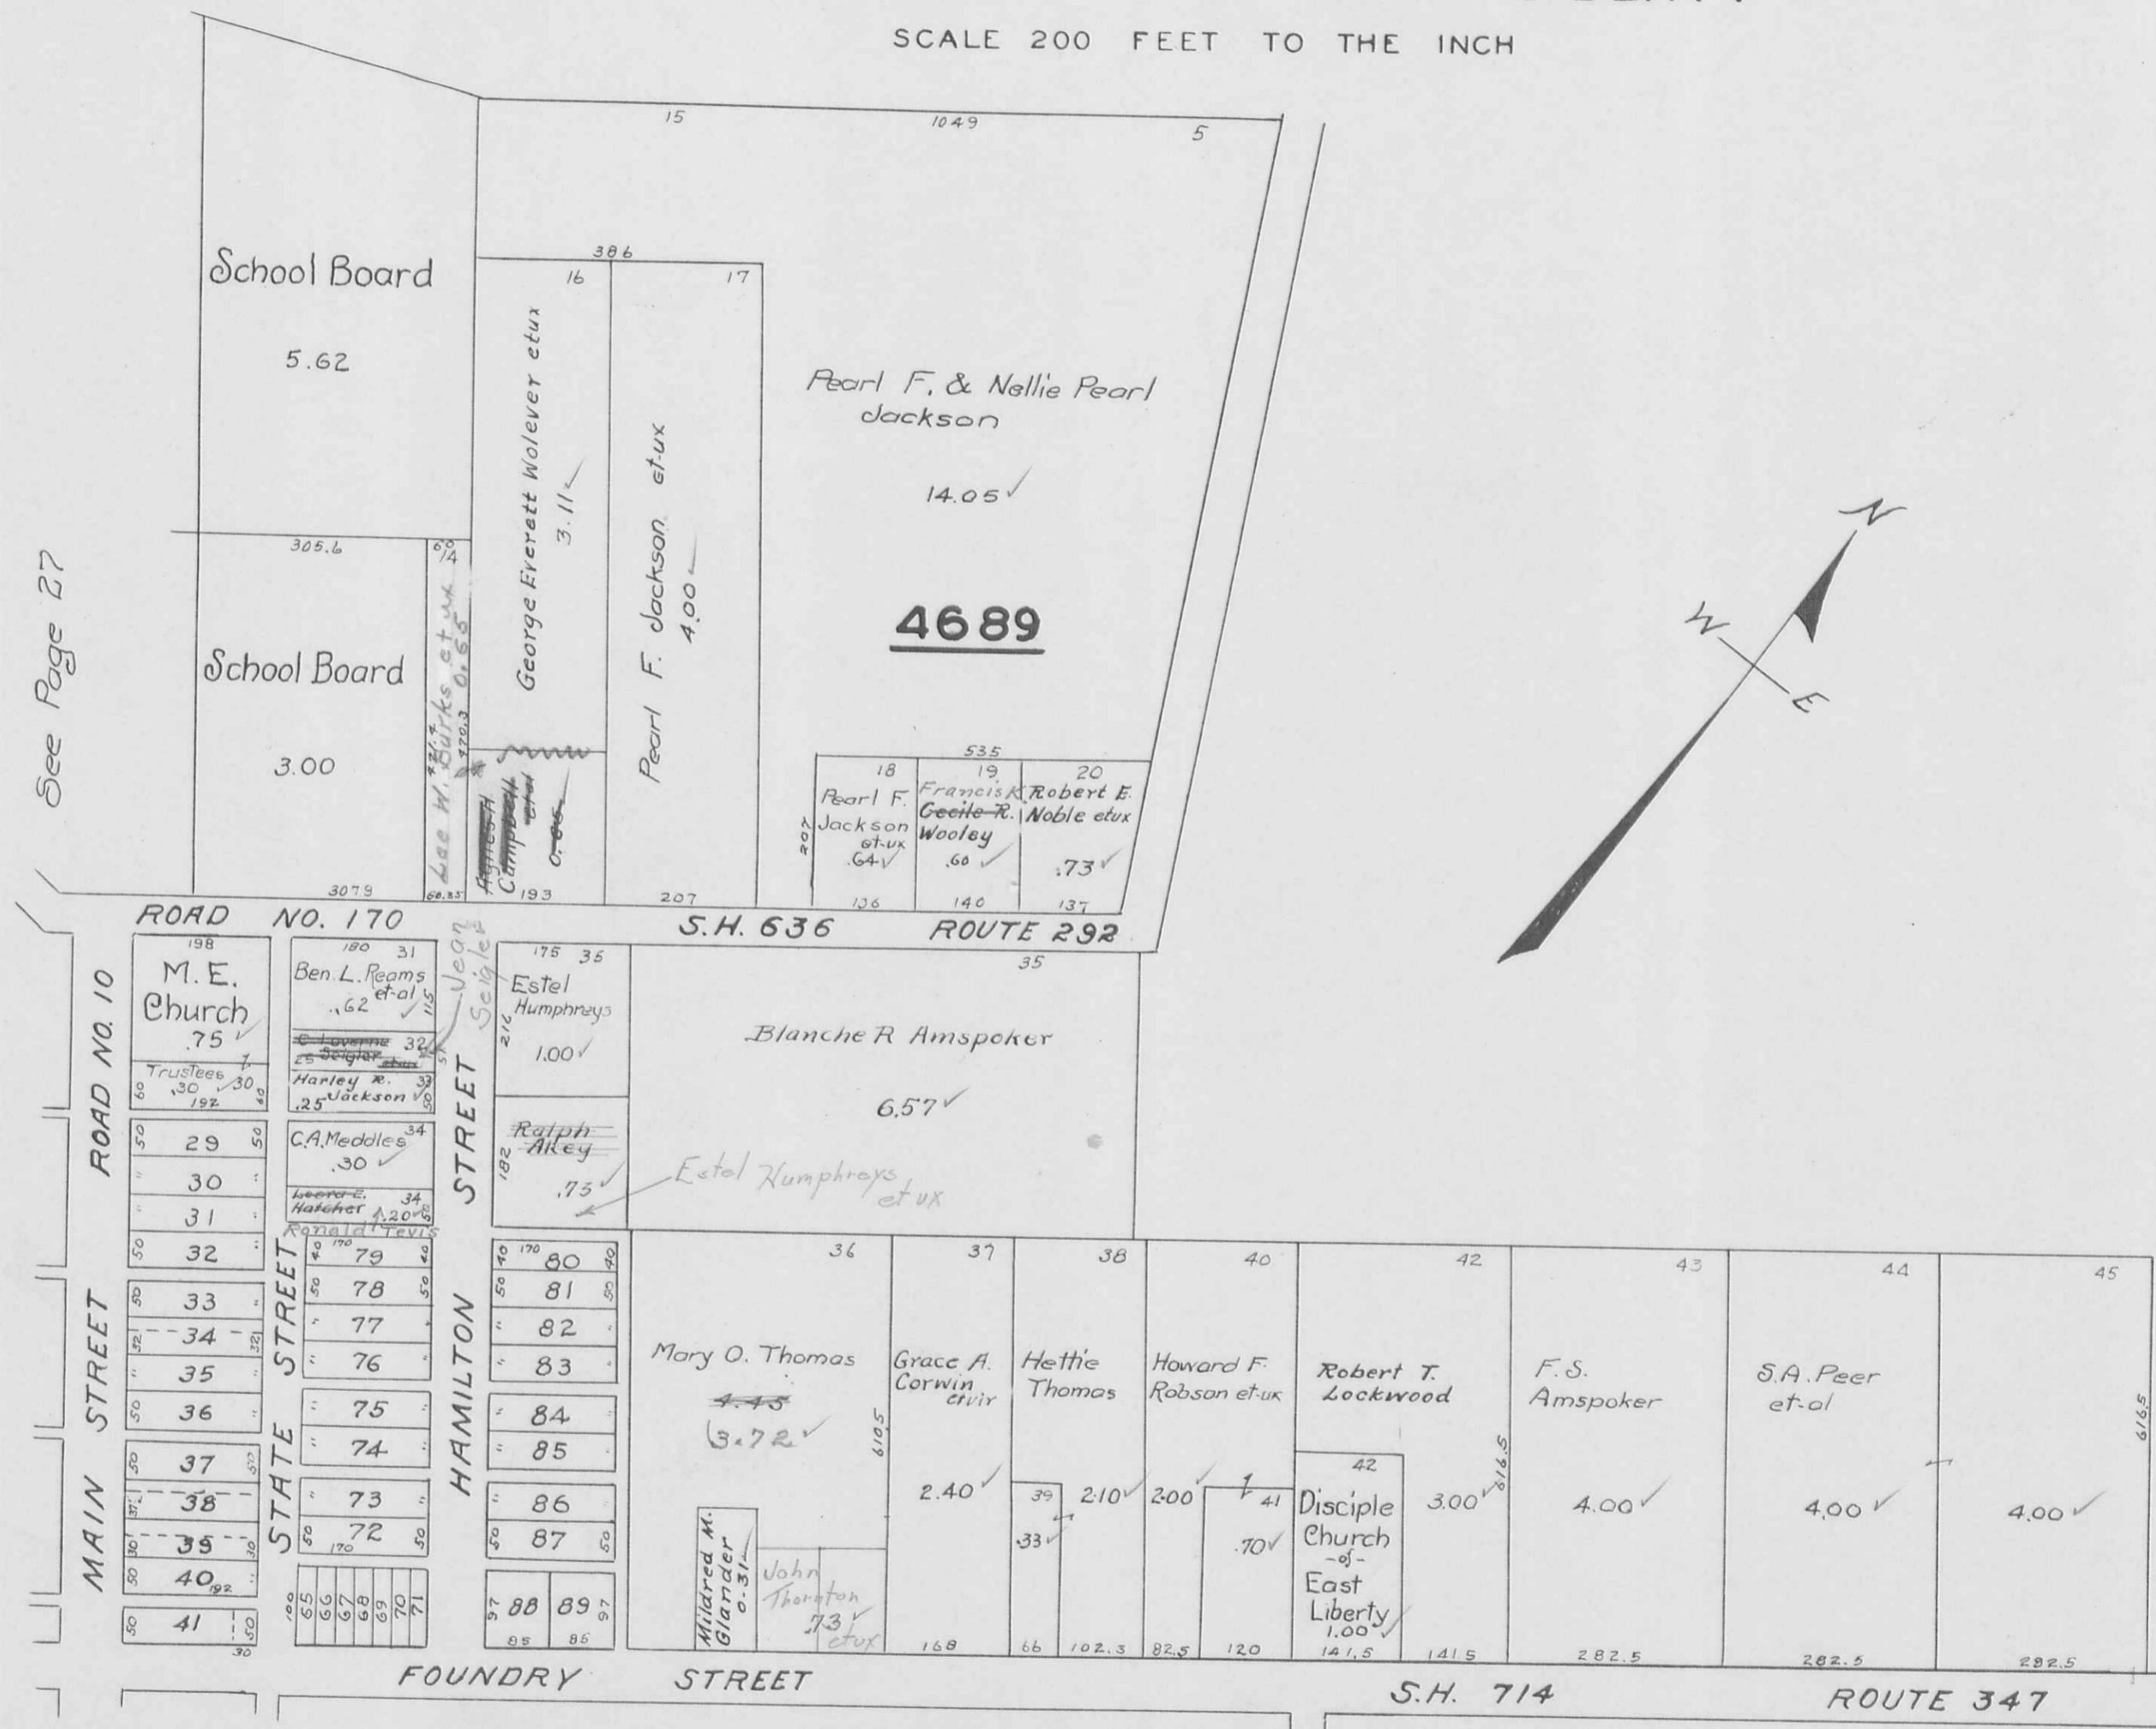

See Page 28

NORTH WEST PART EAST LIBERTY

SCALE 200 FEET TO THE INCH

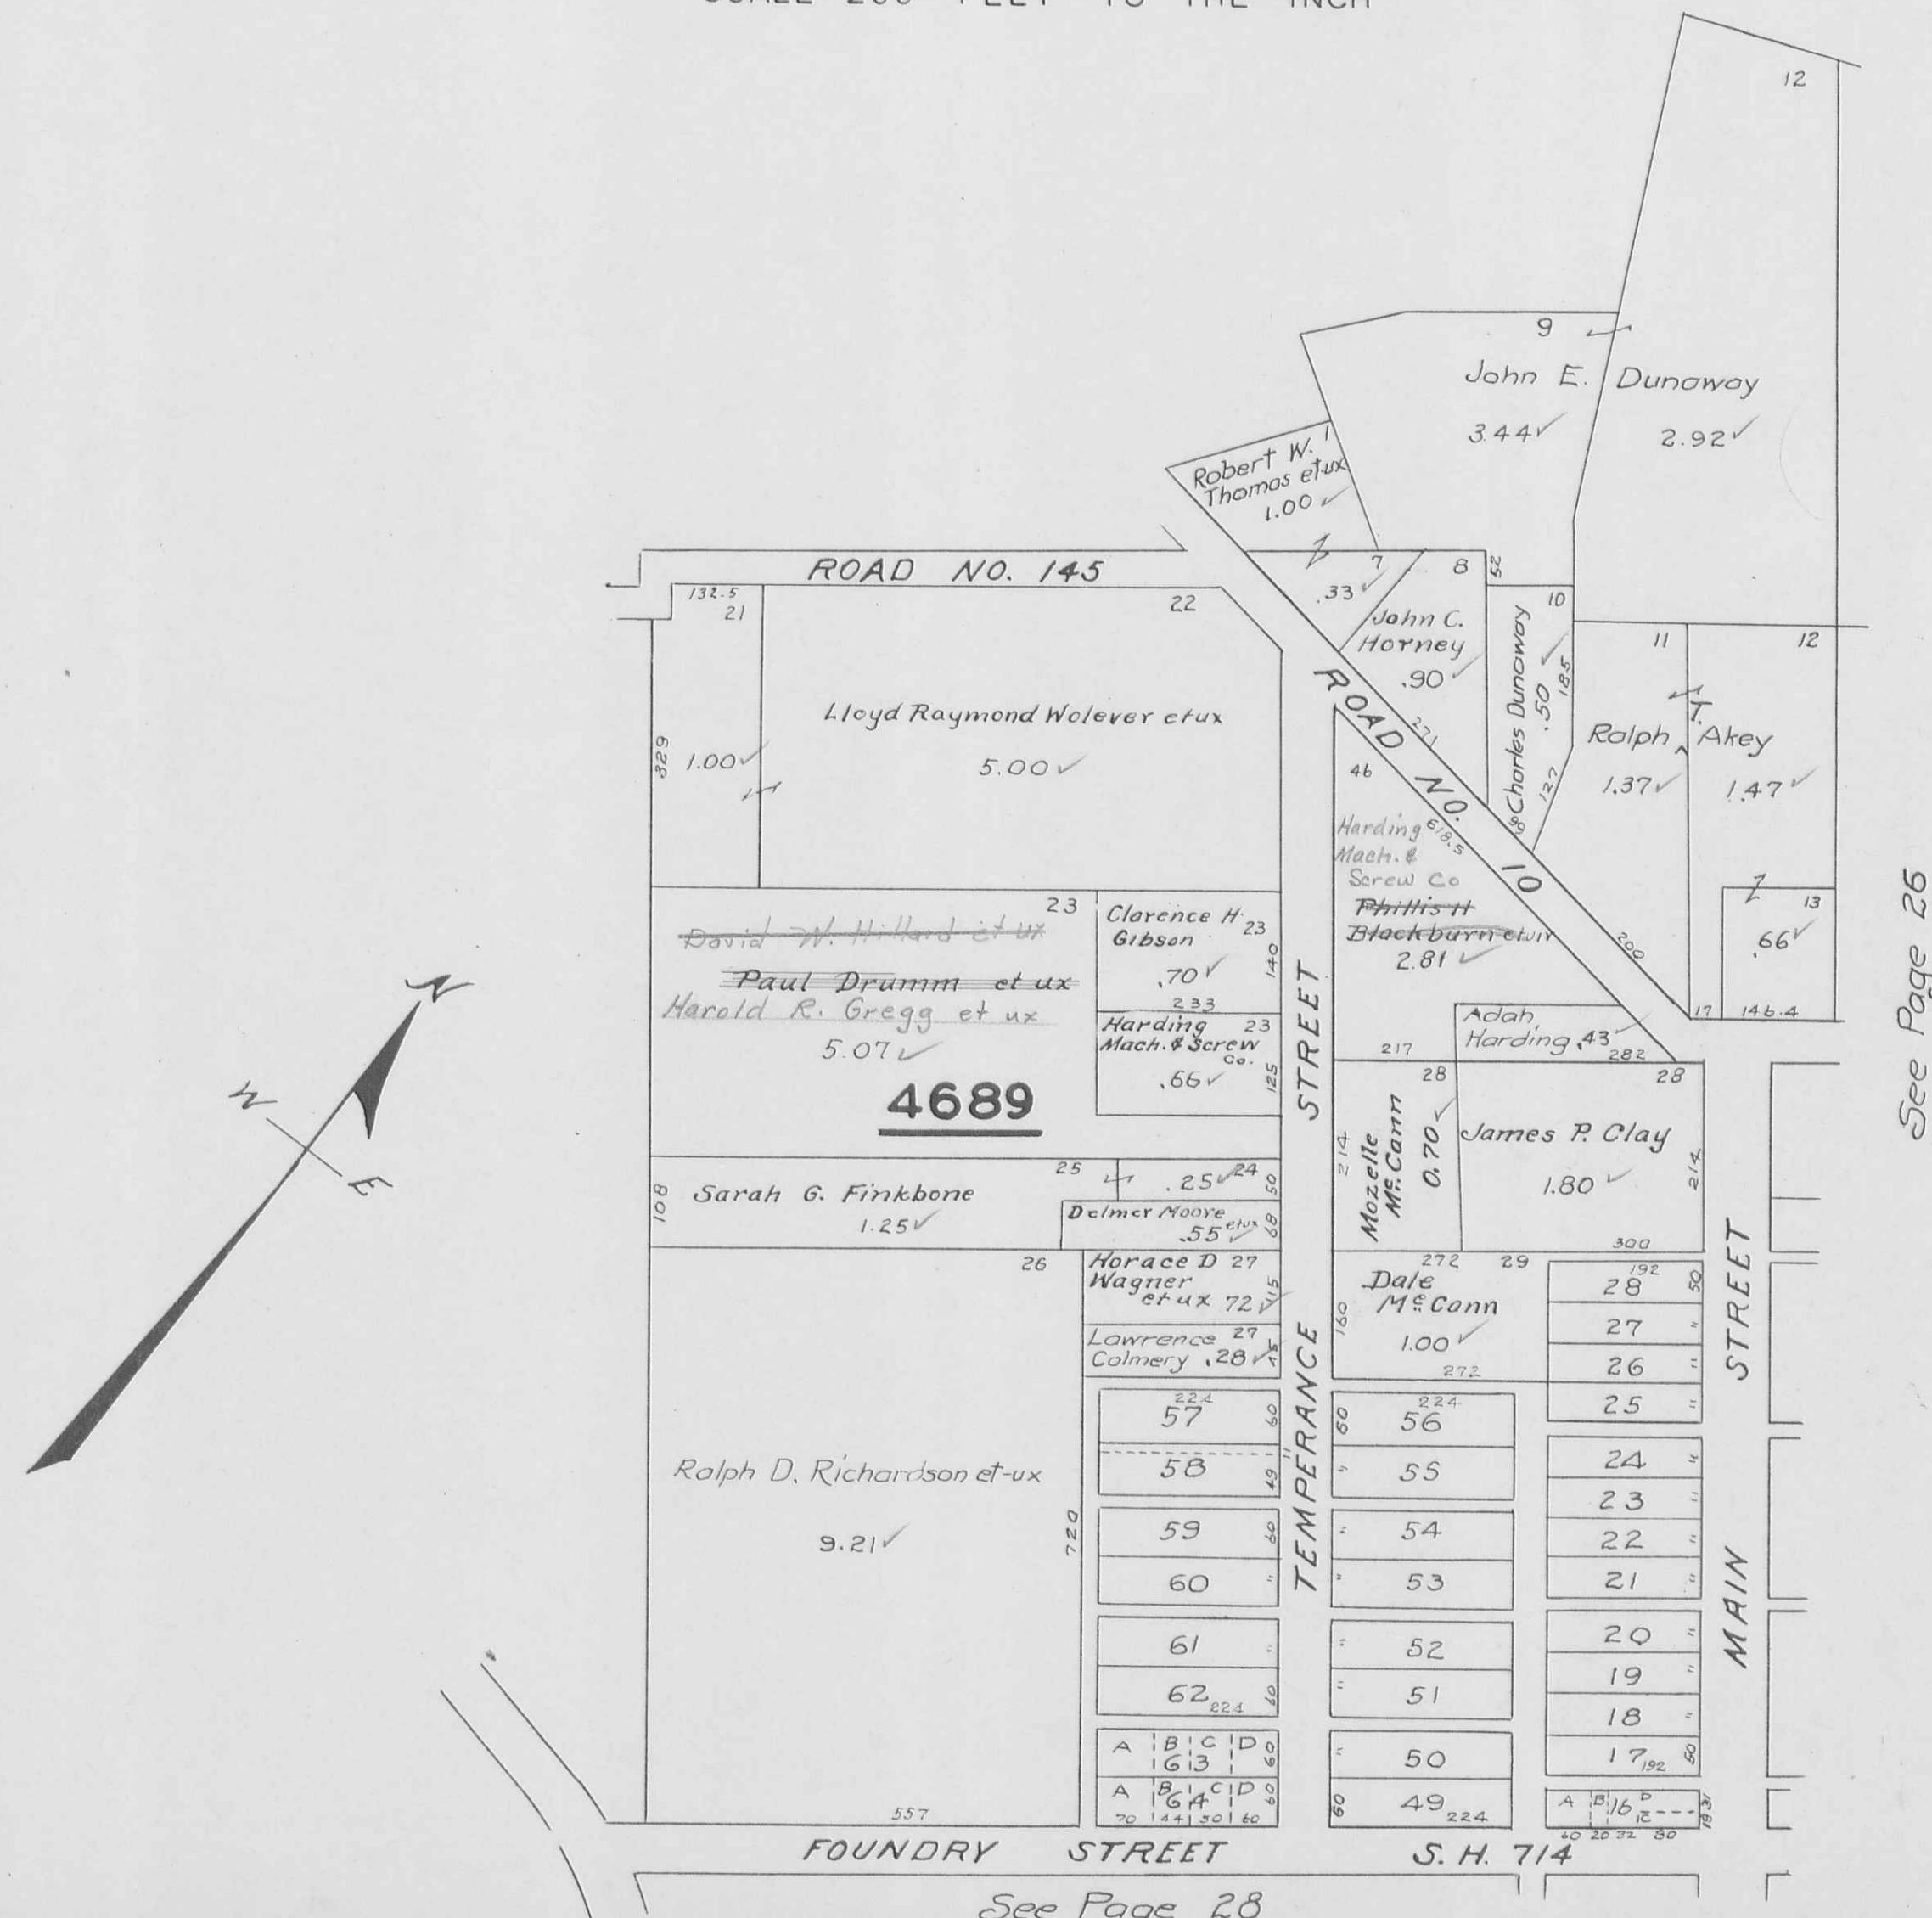

PERRY

TOWNSHIP

PAGE 29

VIRGINIA MILITARY SURVEY 4210
GREENFIELD


