

**MONROE**

**TOWNSHIP**

**1966**

## MONROE TOWNSHIP

## INDEX MAP

PAGE 0

CORRECTED TO

January 1, 1968

JANUARY 1, 1969



MONROE TOWNSHIP  
INDEX

PAGE A

VIRGINIA MILITARY SURVEYS

V.M.S.	PAGE	V.M.S.	PAGE
2220	15	4957	3
3138	8	5042	28
3159	12	5044	28
3221	11	5864	1
3222	10	6449	2
3223	17	6487	15
3224	16	6516	13
3225	22	6762	2
3226	23	7318	12
3227	24	8303	2
3228	25	8485	2
3229	26	9592	7
3230	27	9618	7
3242	7	9679	25
4479	14	9793	4
4492-West Part	20	9878	9
4492-East Part	21	10075	25
4493	5	10091	15
4497	8	10109	9
4525	5	10718	9
4570-North Part	18	10719	9
4570-South Part	19	10853	4
4676	12	12099	6

SECTION	TOWN	RANGE	PAGE
15	5	13	32
16	5	13	31
17	5	13	30
21	5	13	32
22	5	13	31
23	5	13	30
24	5	13	29
19	4	14	29

PICKRELLTOWN 33


MONROE

TOWNSHIP

PAGE

## VIRGINIA MILITARY SURVEY 5864


SCALE 10 CHAINS TO THE INCH

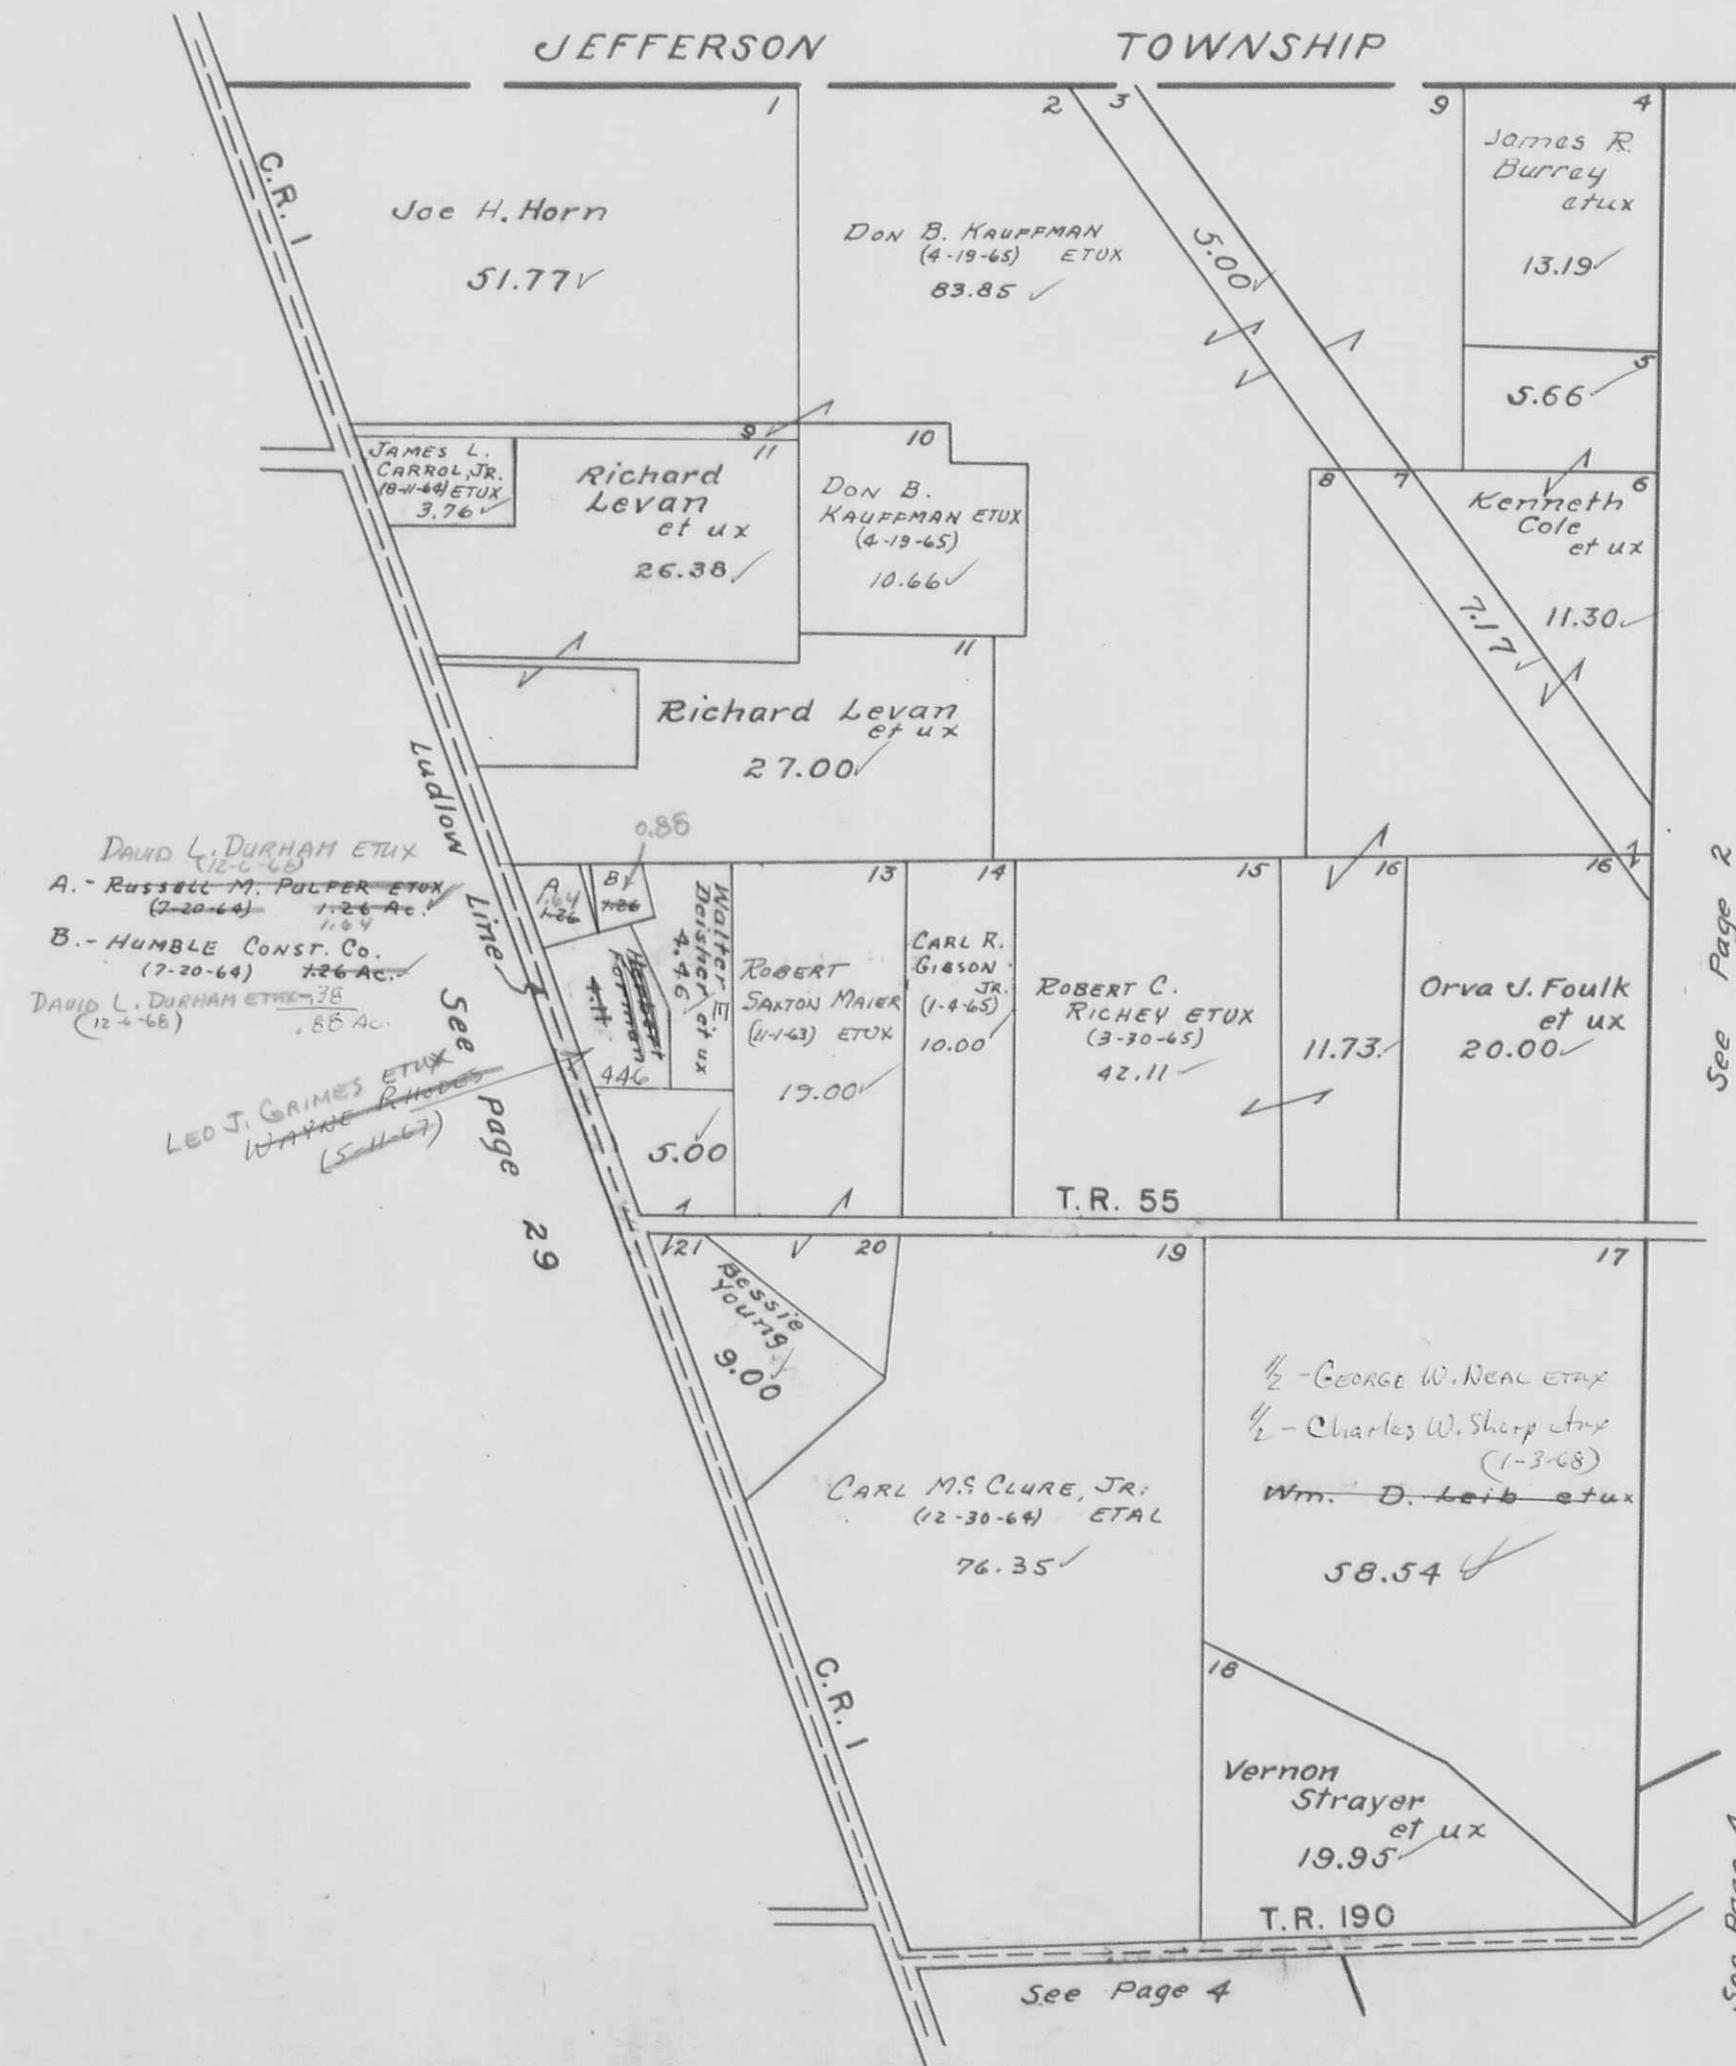

**MONROE TOWNSHIP**  
**VIRGINIA MILITARY SURVEYS**

PAGE


2

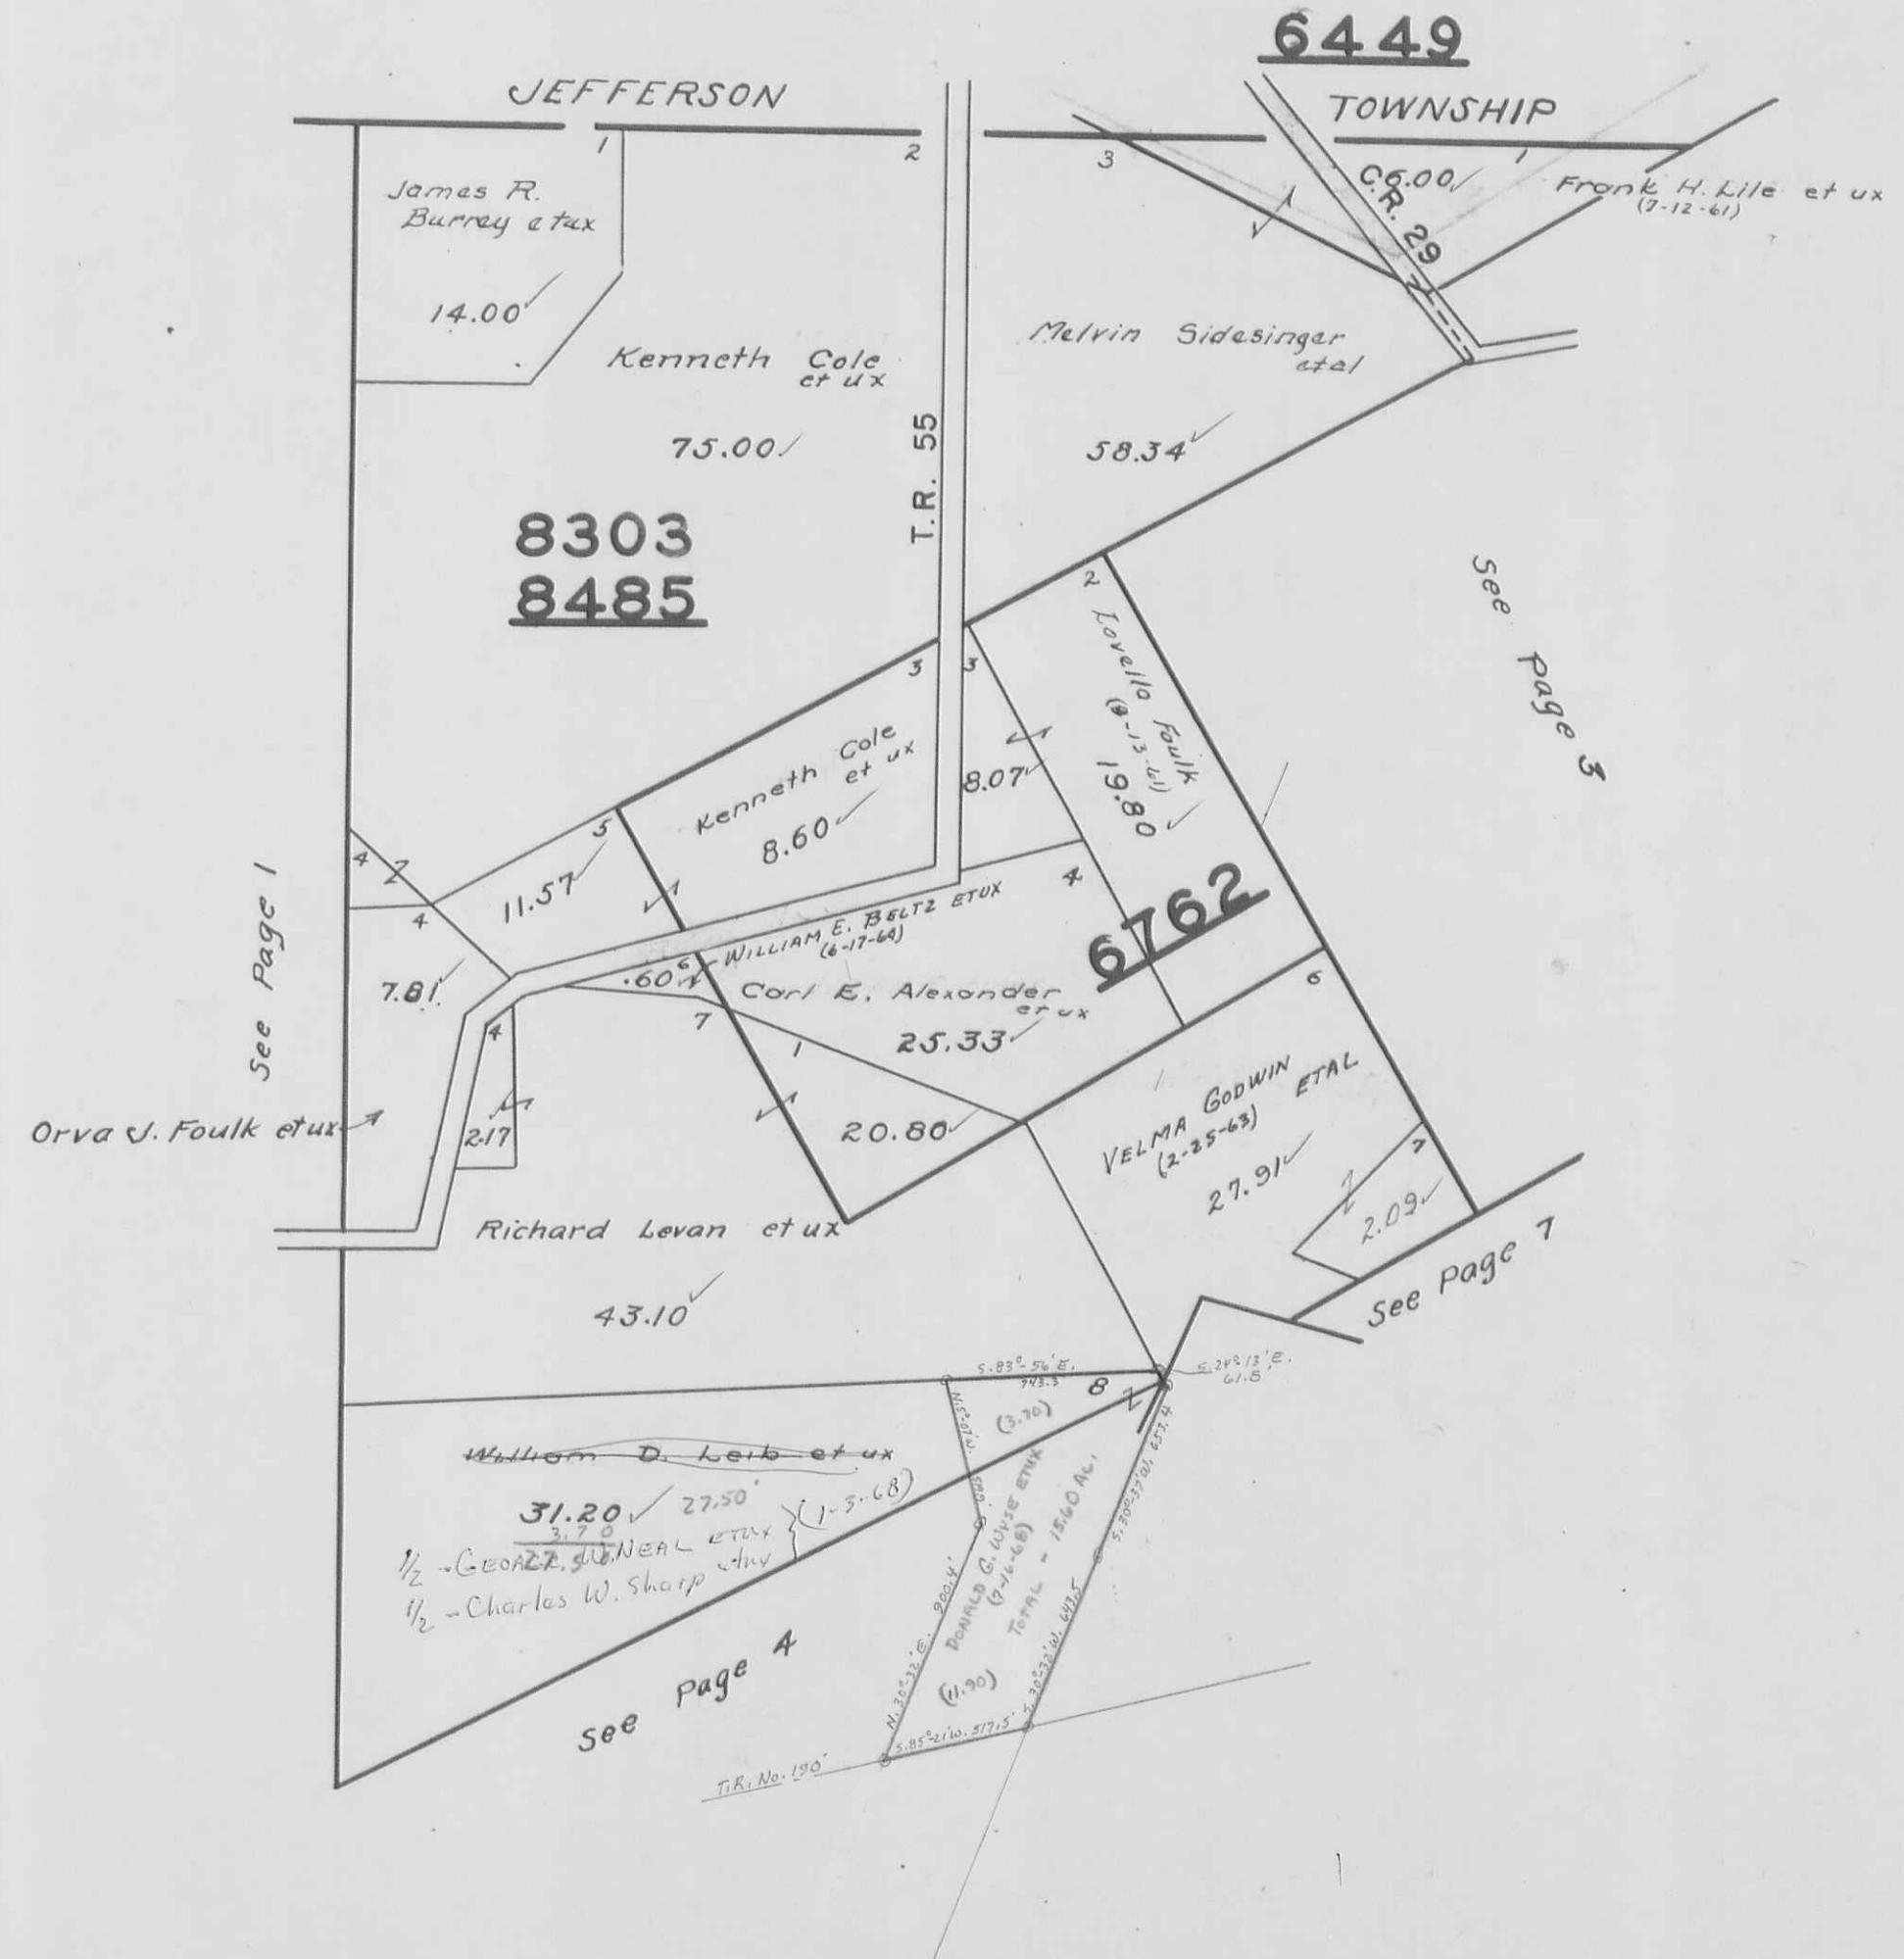

**MONROE TOWNSHIP**

3

SCALE: 1" = 10 CHAINS = 660'

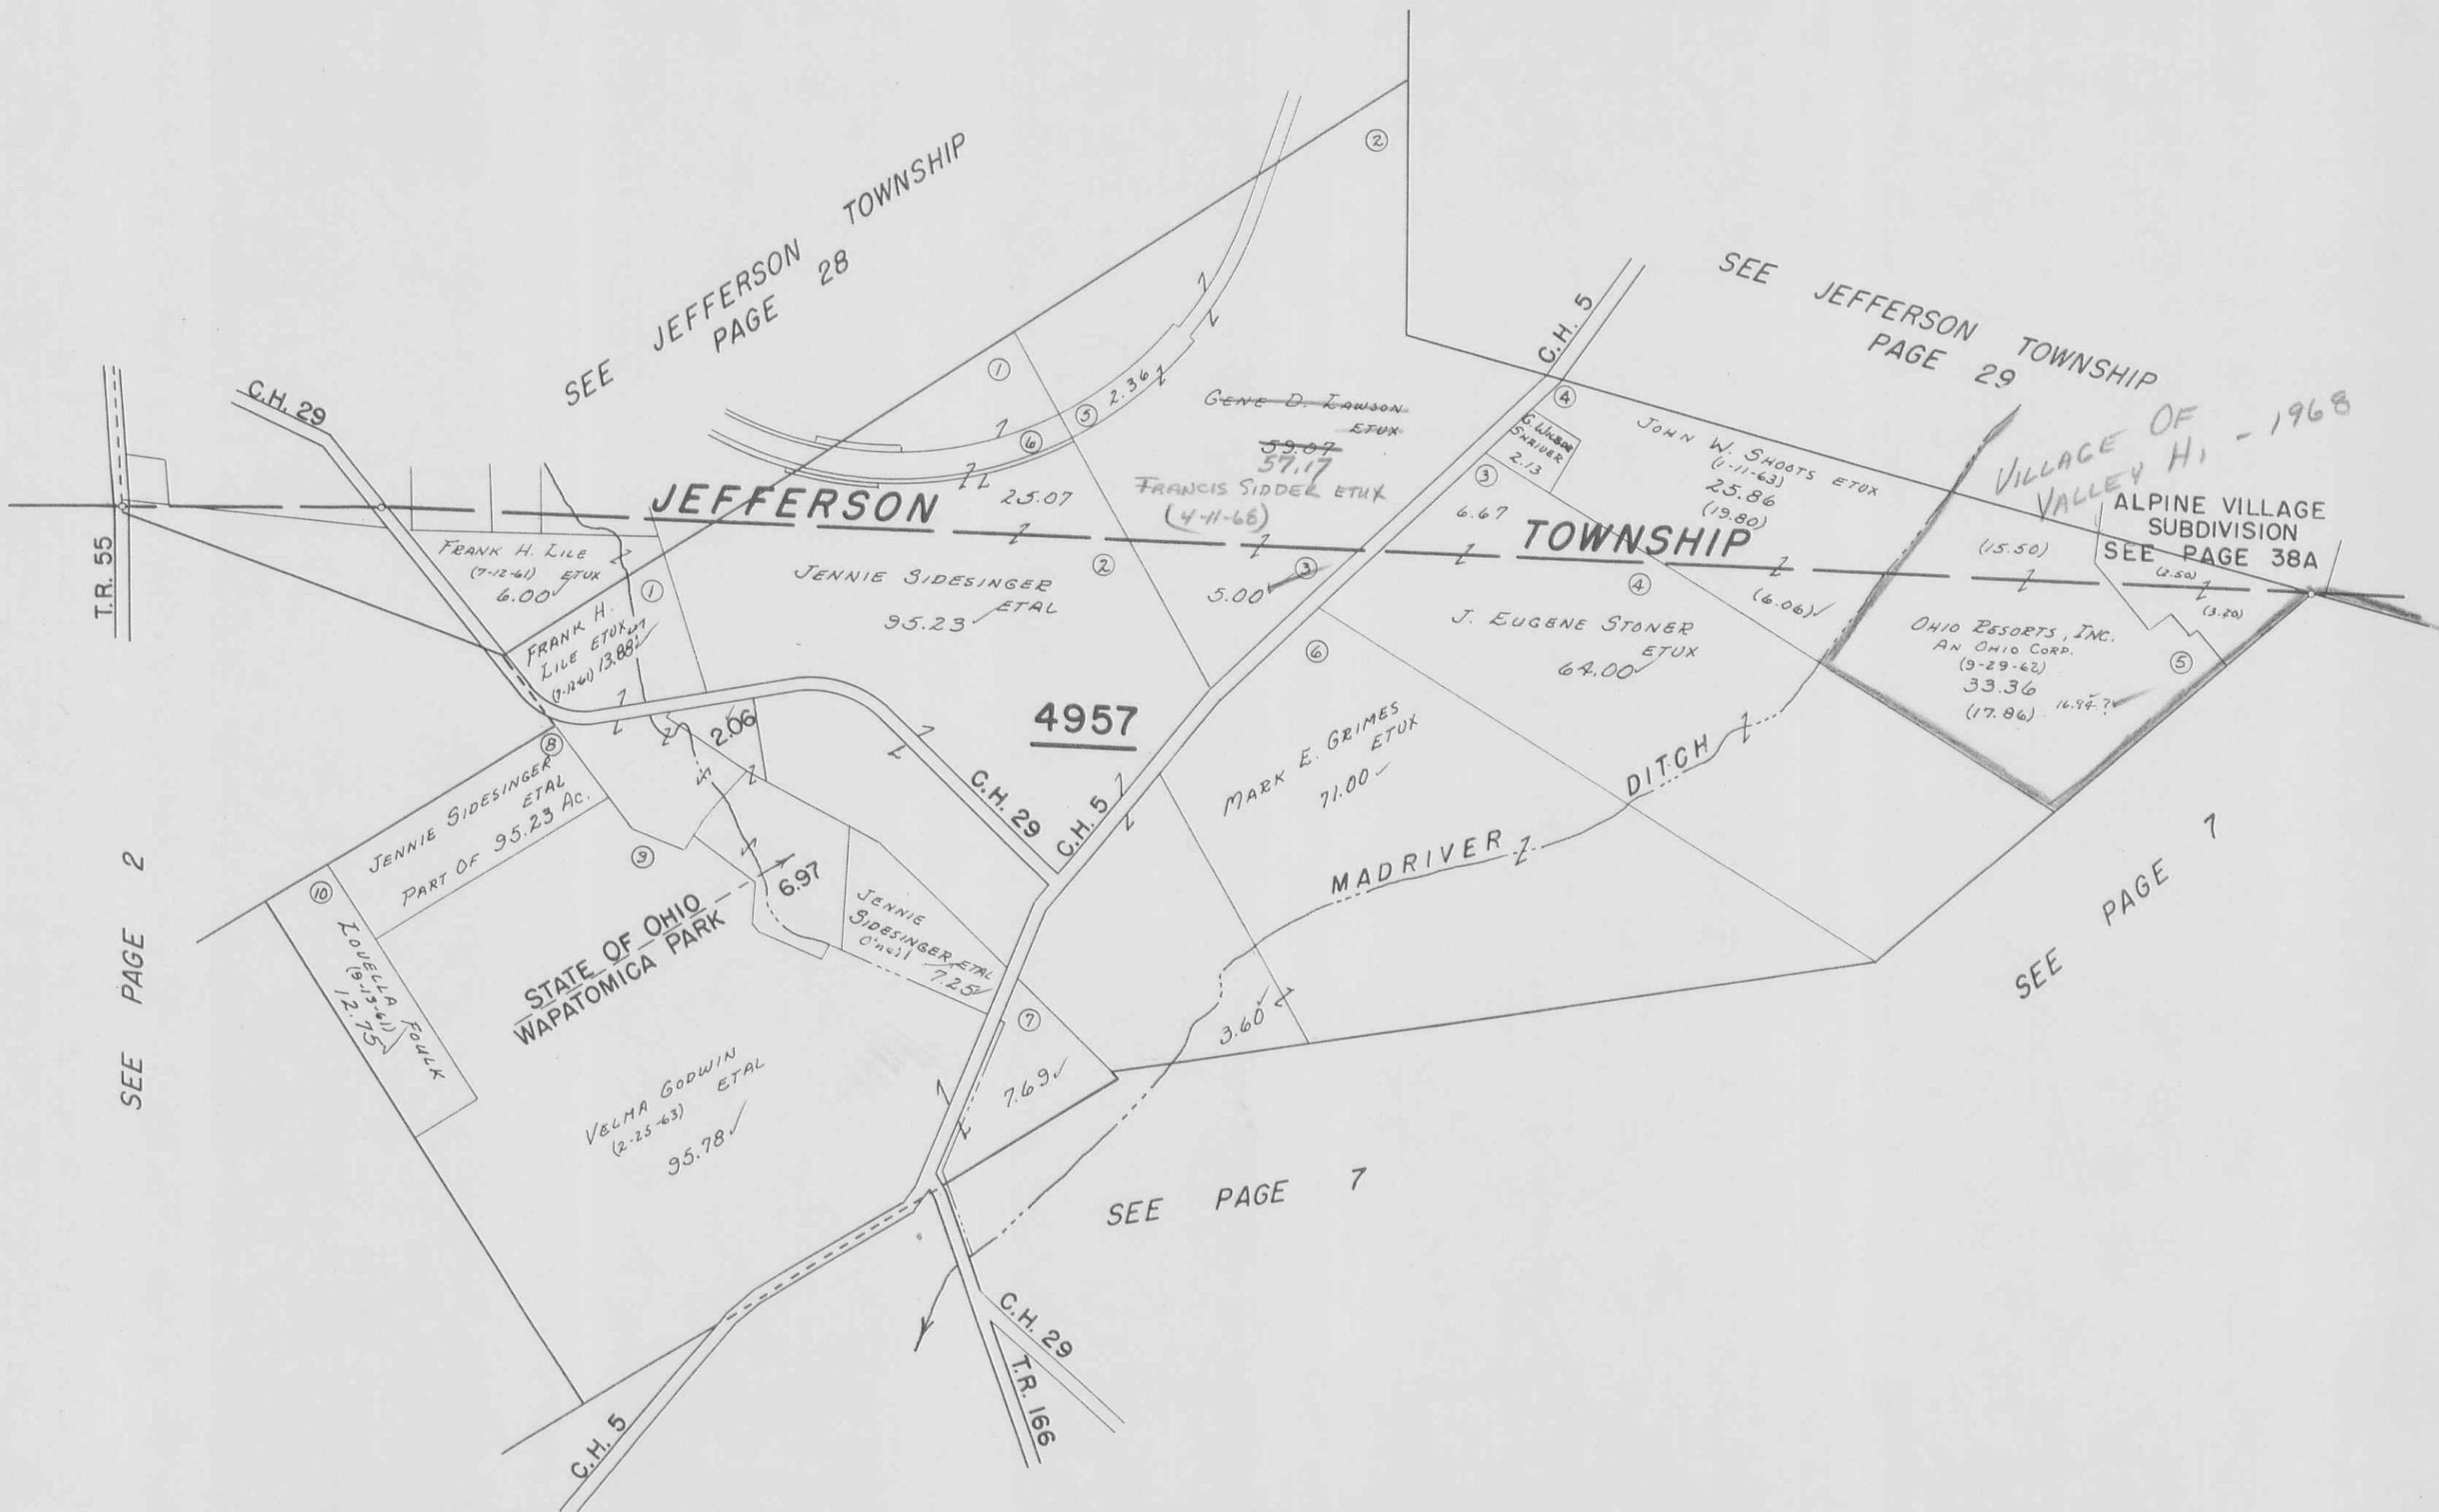

MONROE

TOWNSHIP

PAGE

4

VIRGINIA MILITARY SURVEYS 9793  
10853

SCALE 10 CHAINS TO THE INCH



MONROE TOWNSHIP  
VIRGINIA MILITARY SURVEYS {4493  
{4525

SCALE 10 CHAINS TO THE INCH


PAGE 5



MONROE TOWNSHIP  
VIRGINIA MILITARY SURVEY 12099

SCALE 10 CHAINS TO THE INCH

PAGE 6

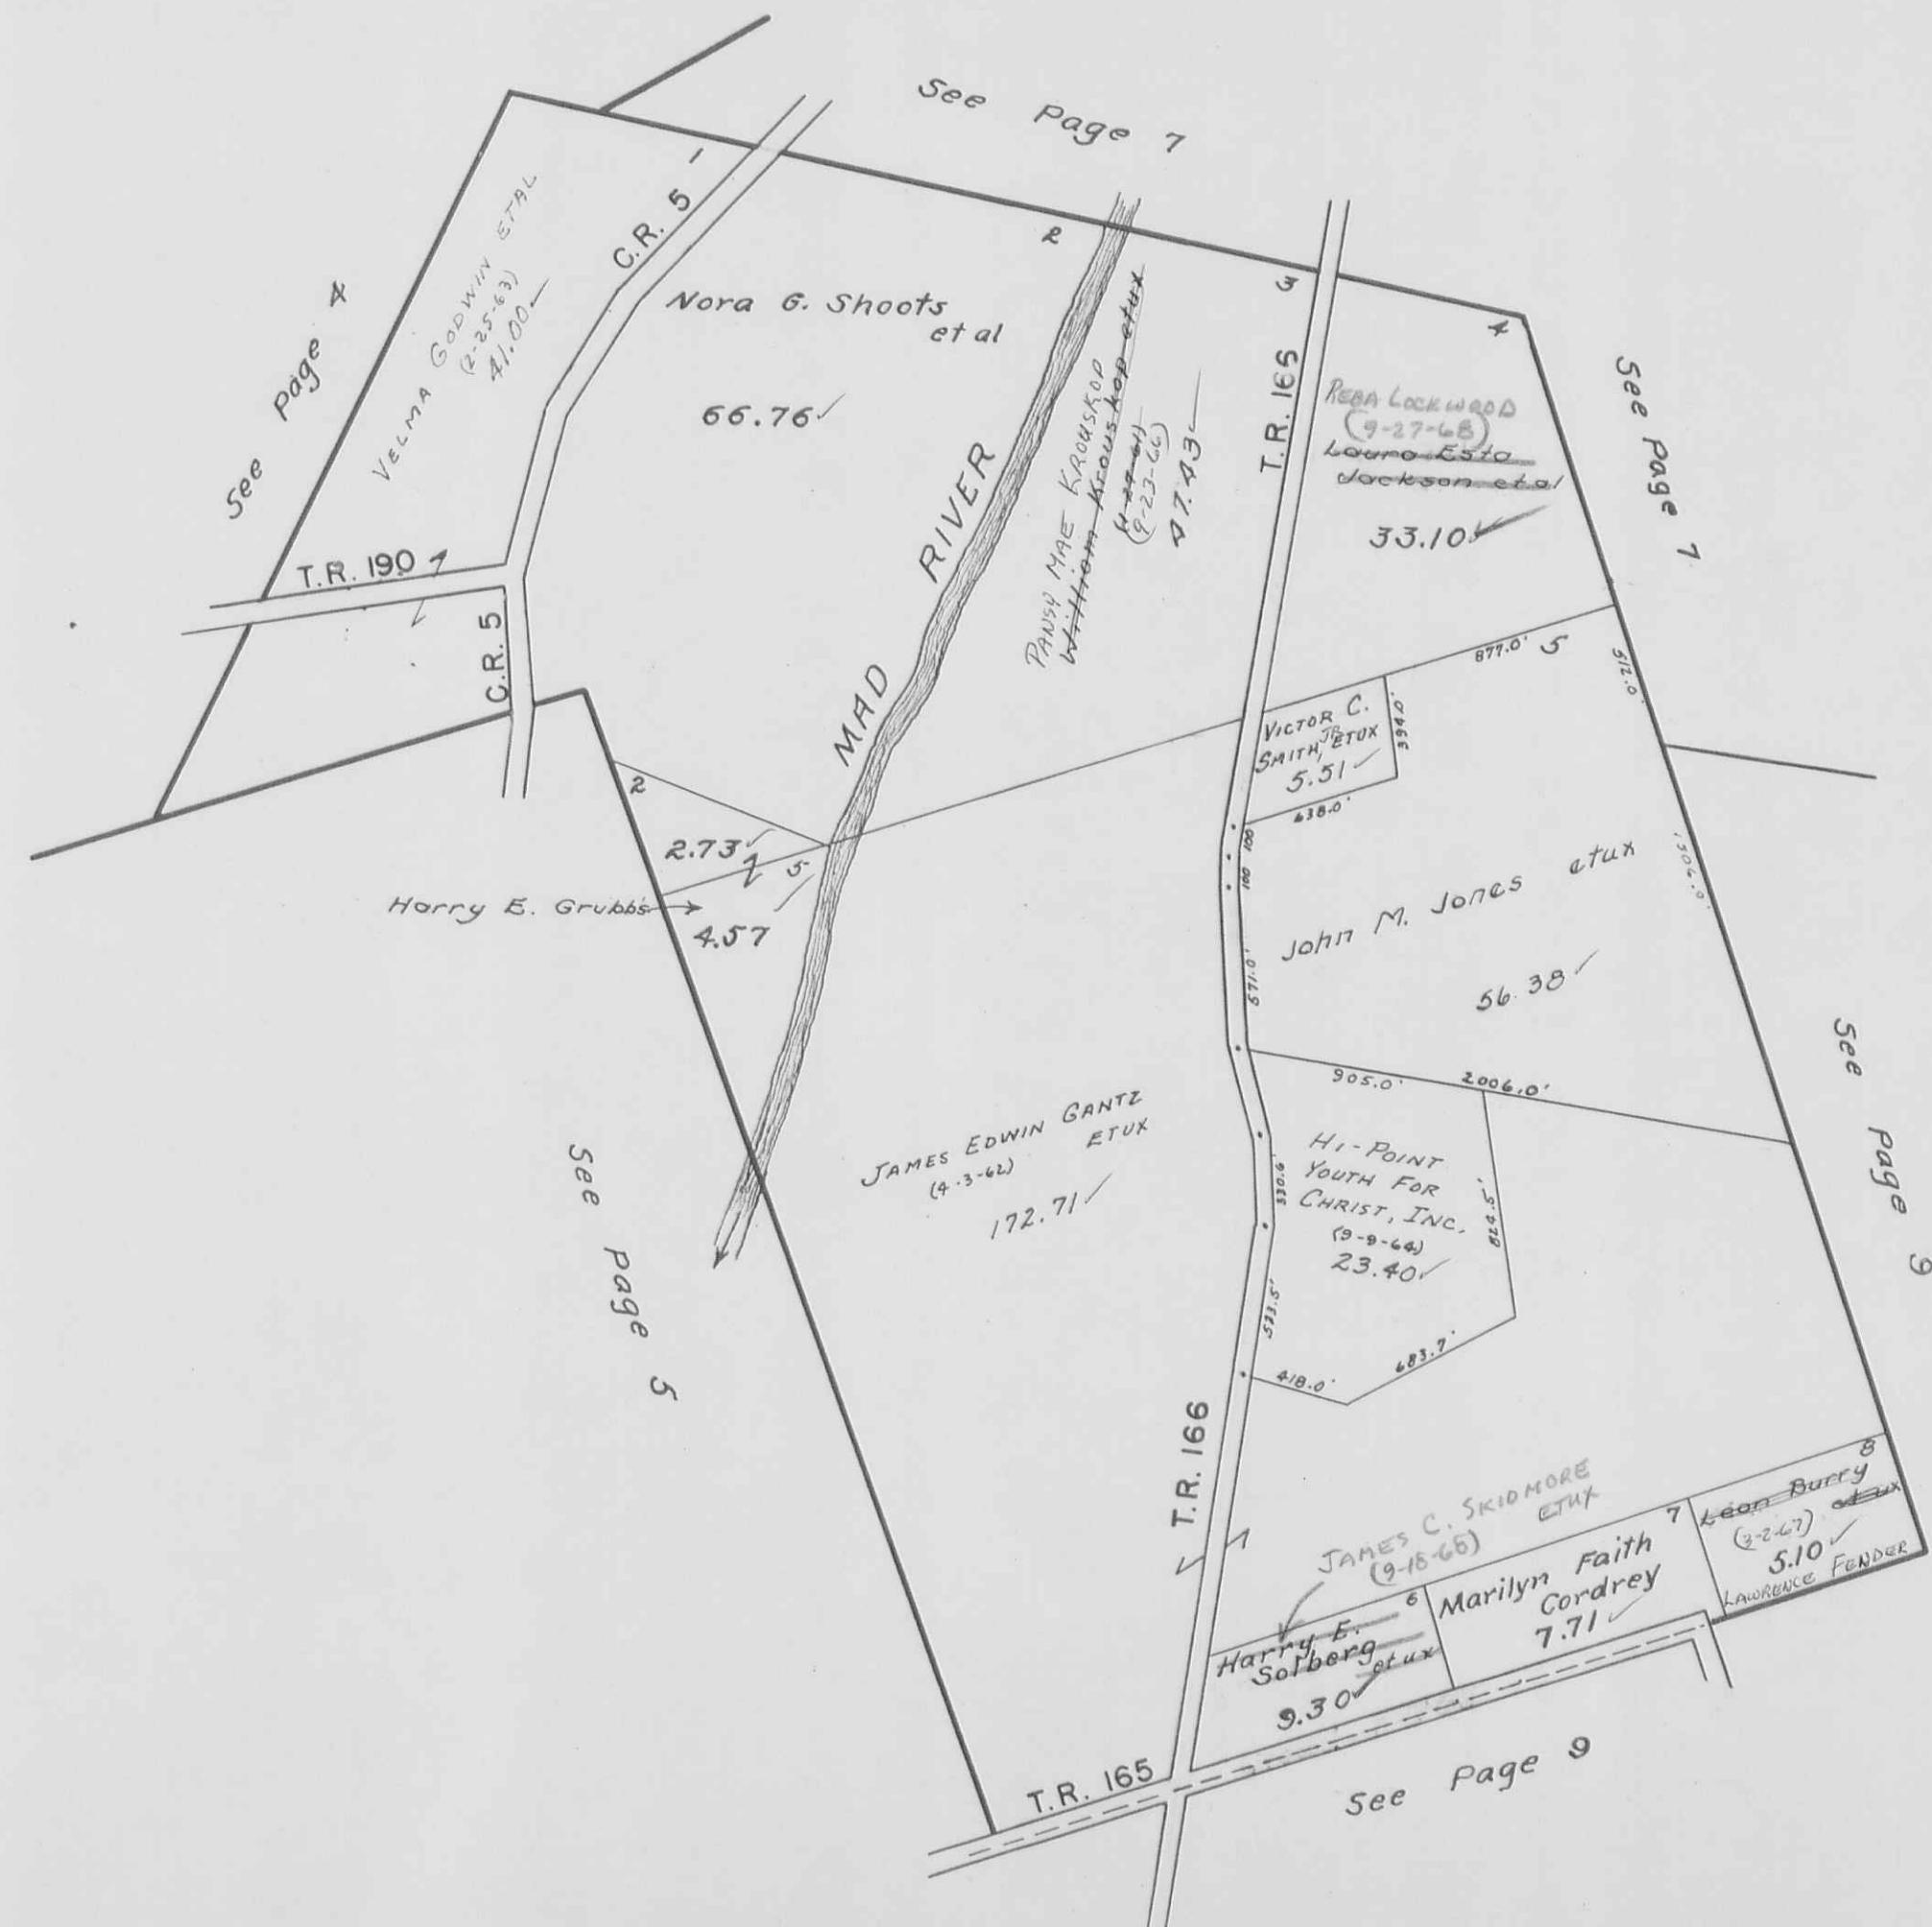

MONROE TOWNSHIP  
VIRGINIA MILITARY SURVEYS

SCALE 10 CHAINS TO THE INCH

PAGE

7


9592  
9618  
10075  
3242



MONROE TOWNSHIP  
VIRGINIA MILITARY SURVEYS 3138  
4497

SCALE 10 CHAINS TO THE INCH

PAGE 8

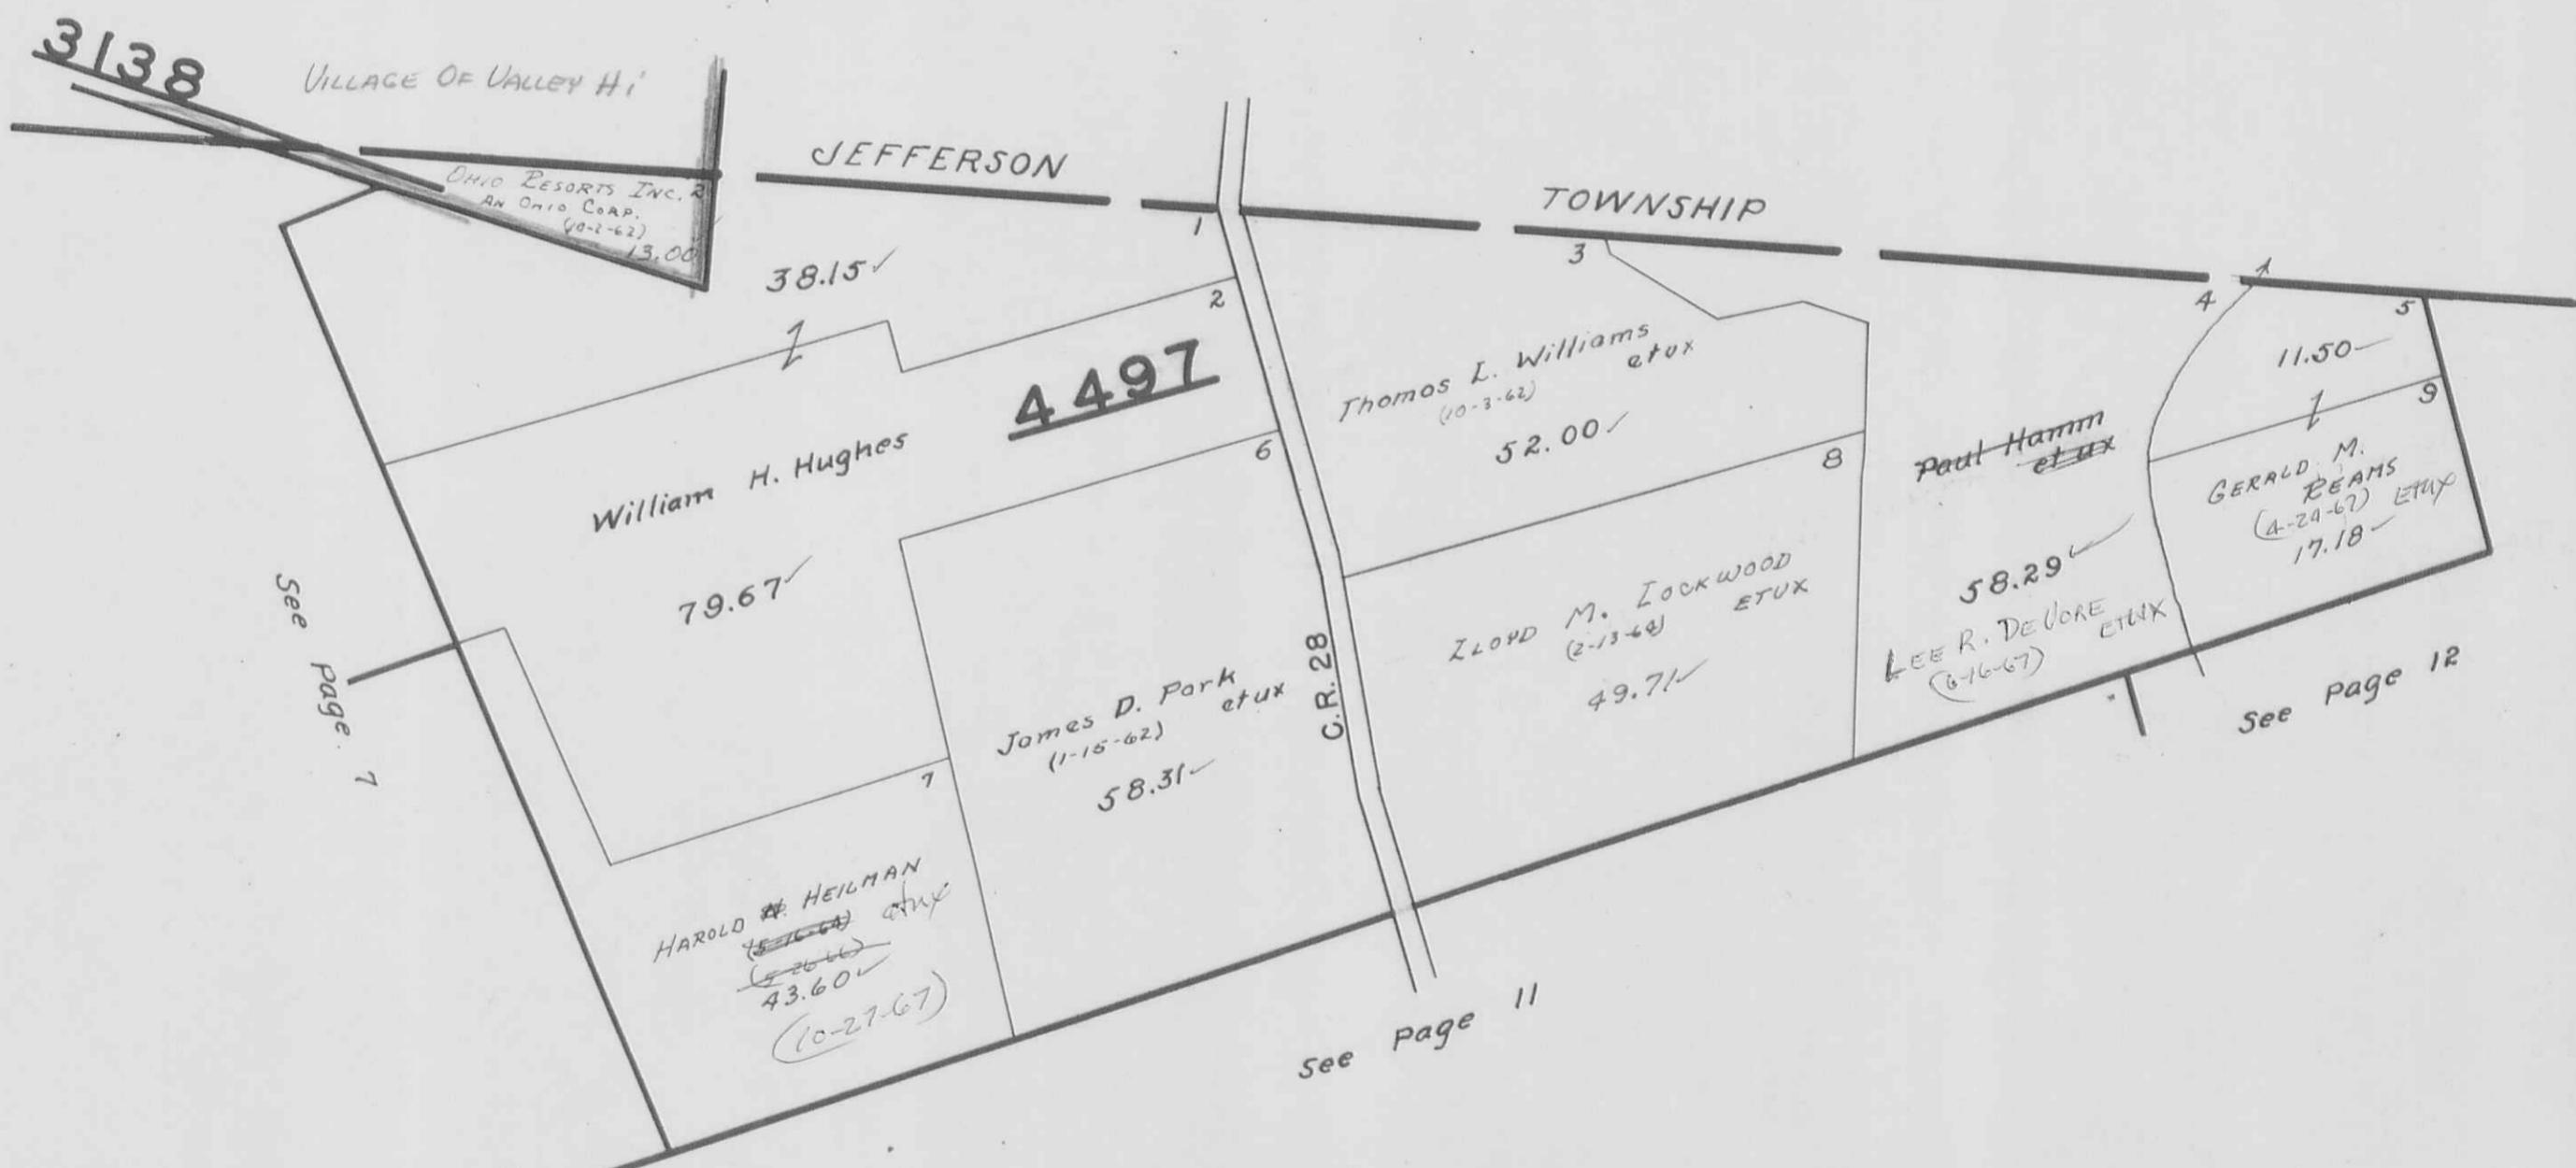

MONROE TOWNSHIP  
VIRGINIA MILITARY SURVEYS

PAGE 9

9878  
10109  
10718  
10719

SCALE 10 CHAINS TO THE INCH



MONROE TOWNSHIP  
VIRGINIA MILITARY SURVEY 3222

SCALE 10 CHAINS TO THE INCH




## MONROE TOWNSHIP

## VIRGINIA MILITARY SURVEY 3221

PAGE 11

SCALE 10 CHAINS TO THE INCH

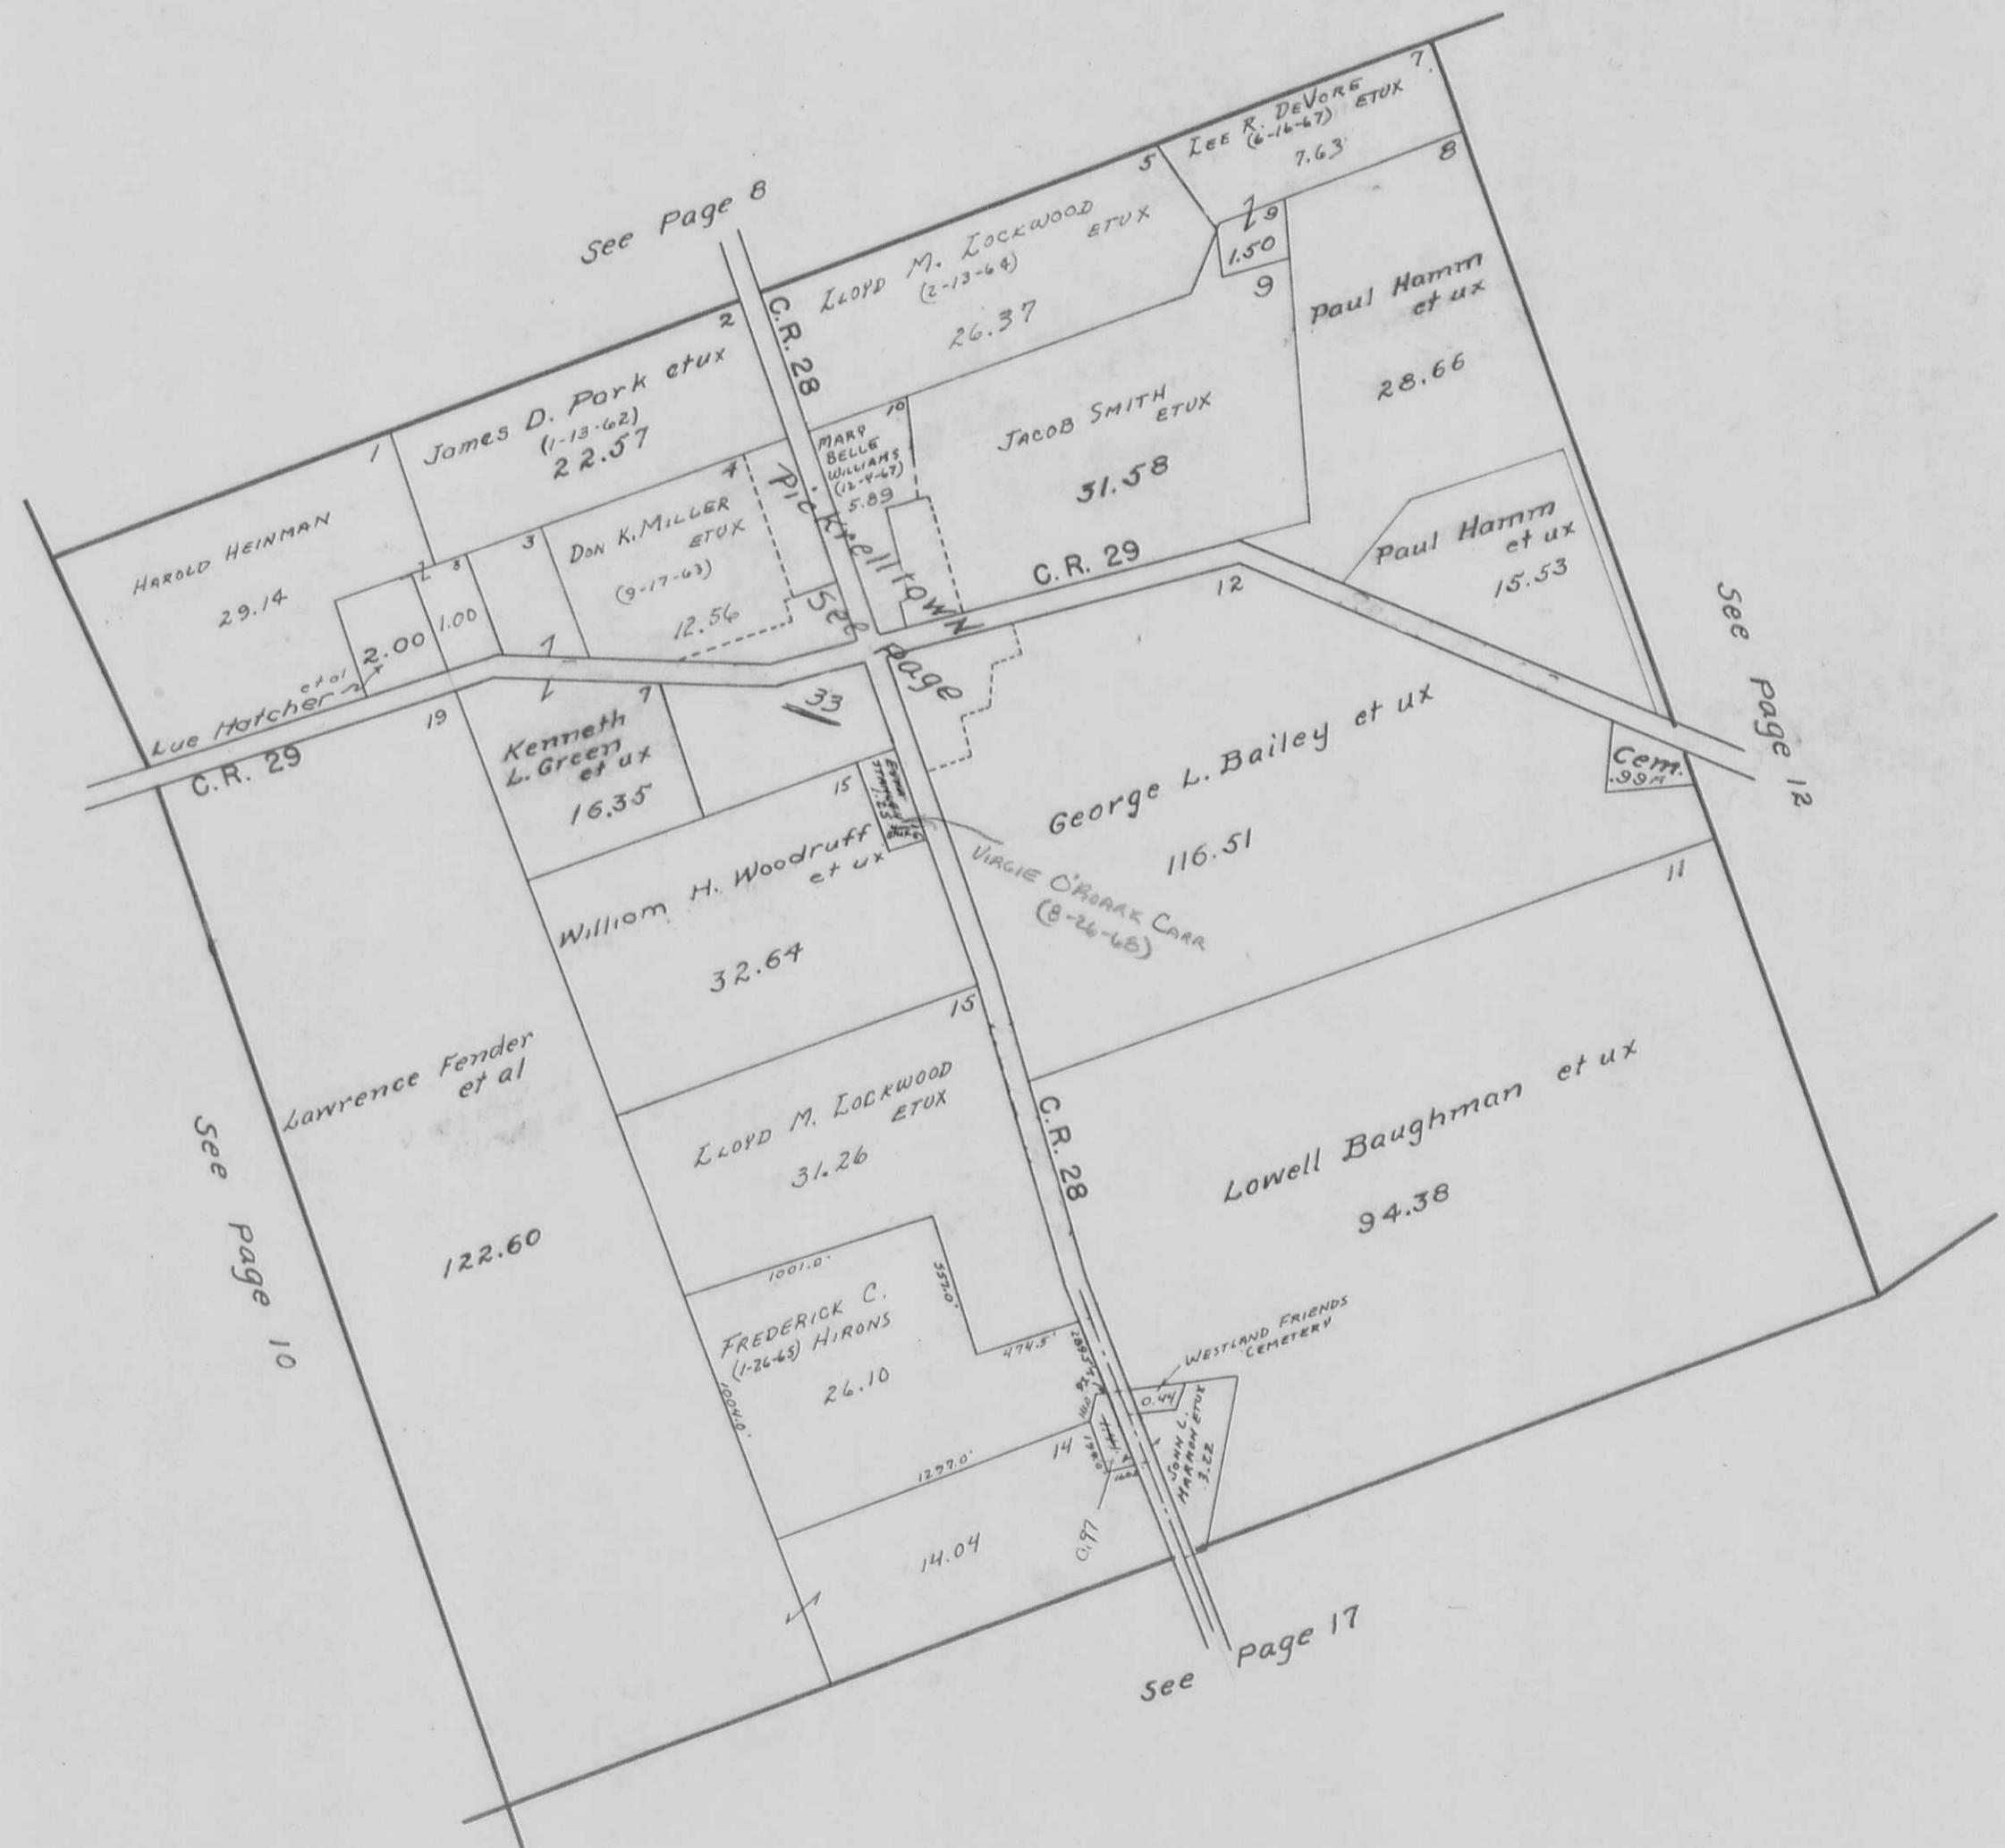

MONROE

TOWNSHIP

VIRGINIA

MILITARY SURVEYS


3159

4676

7318

PAGE 12


SCALE 10 CHAINS TO THE INCH

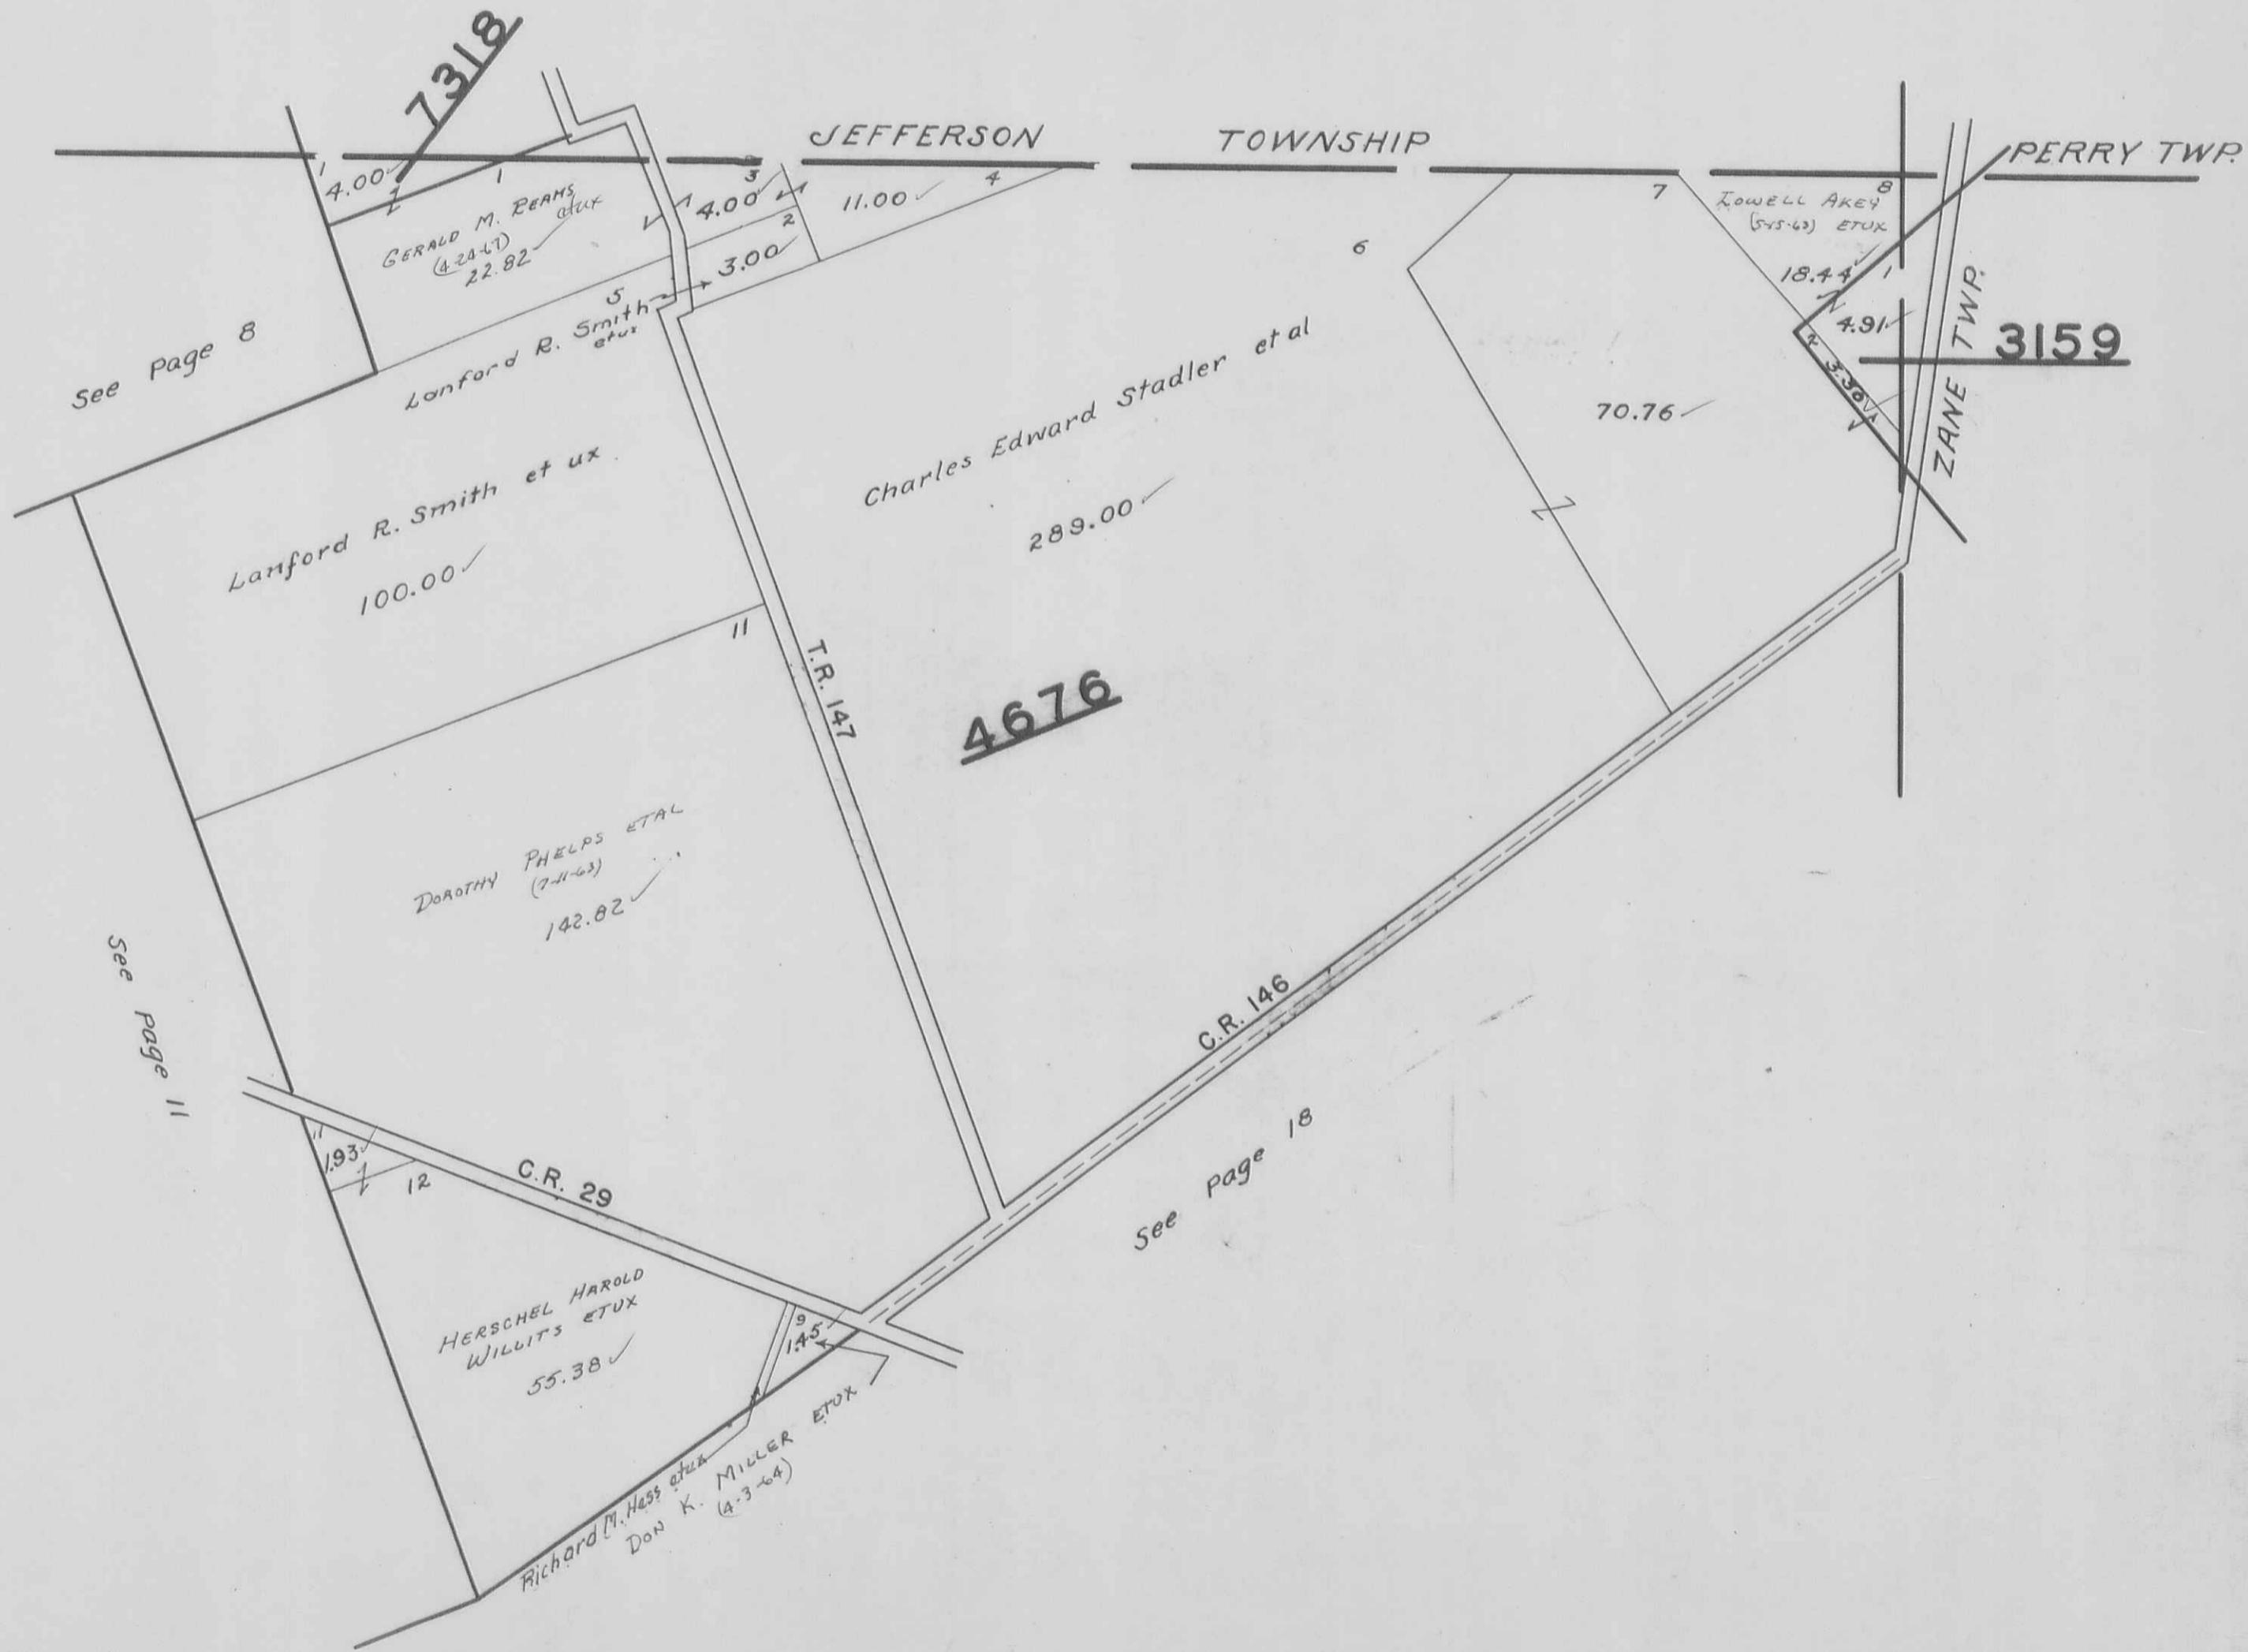

MONROE TOWNSHIP  
VIRGINIA MILITARY SURVEY 6516

SCALE 10 CHAINS TO THE INCH

PAGE 13

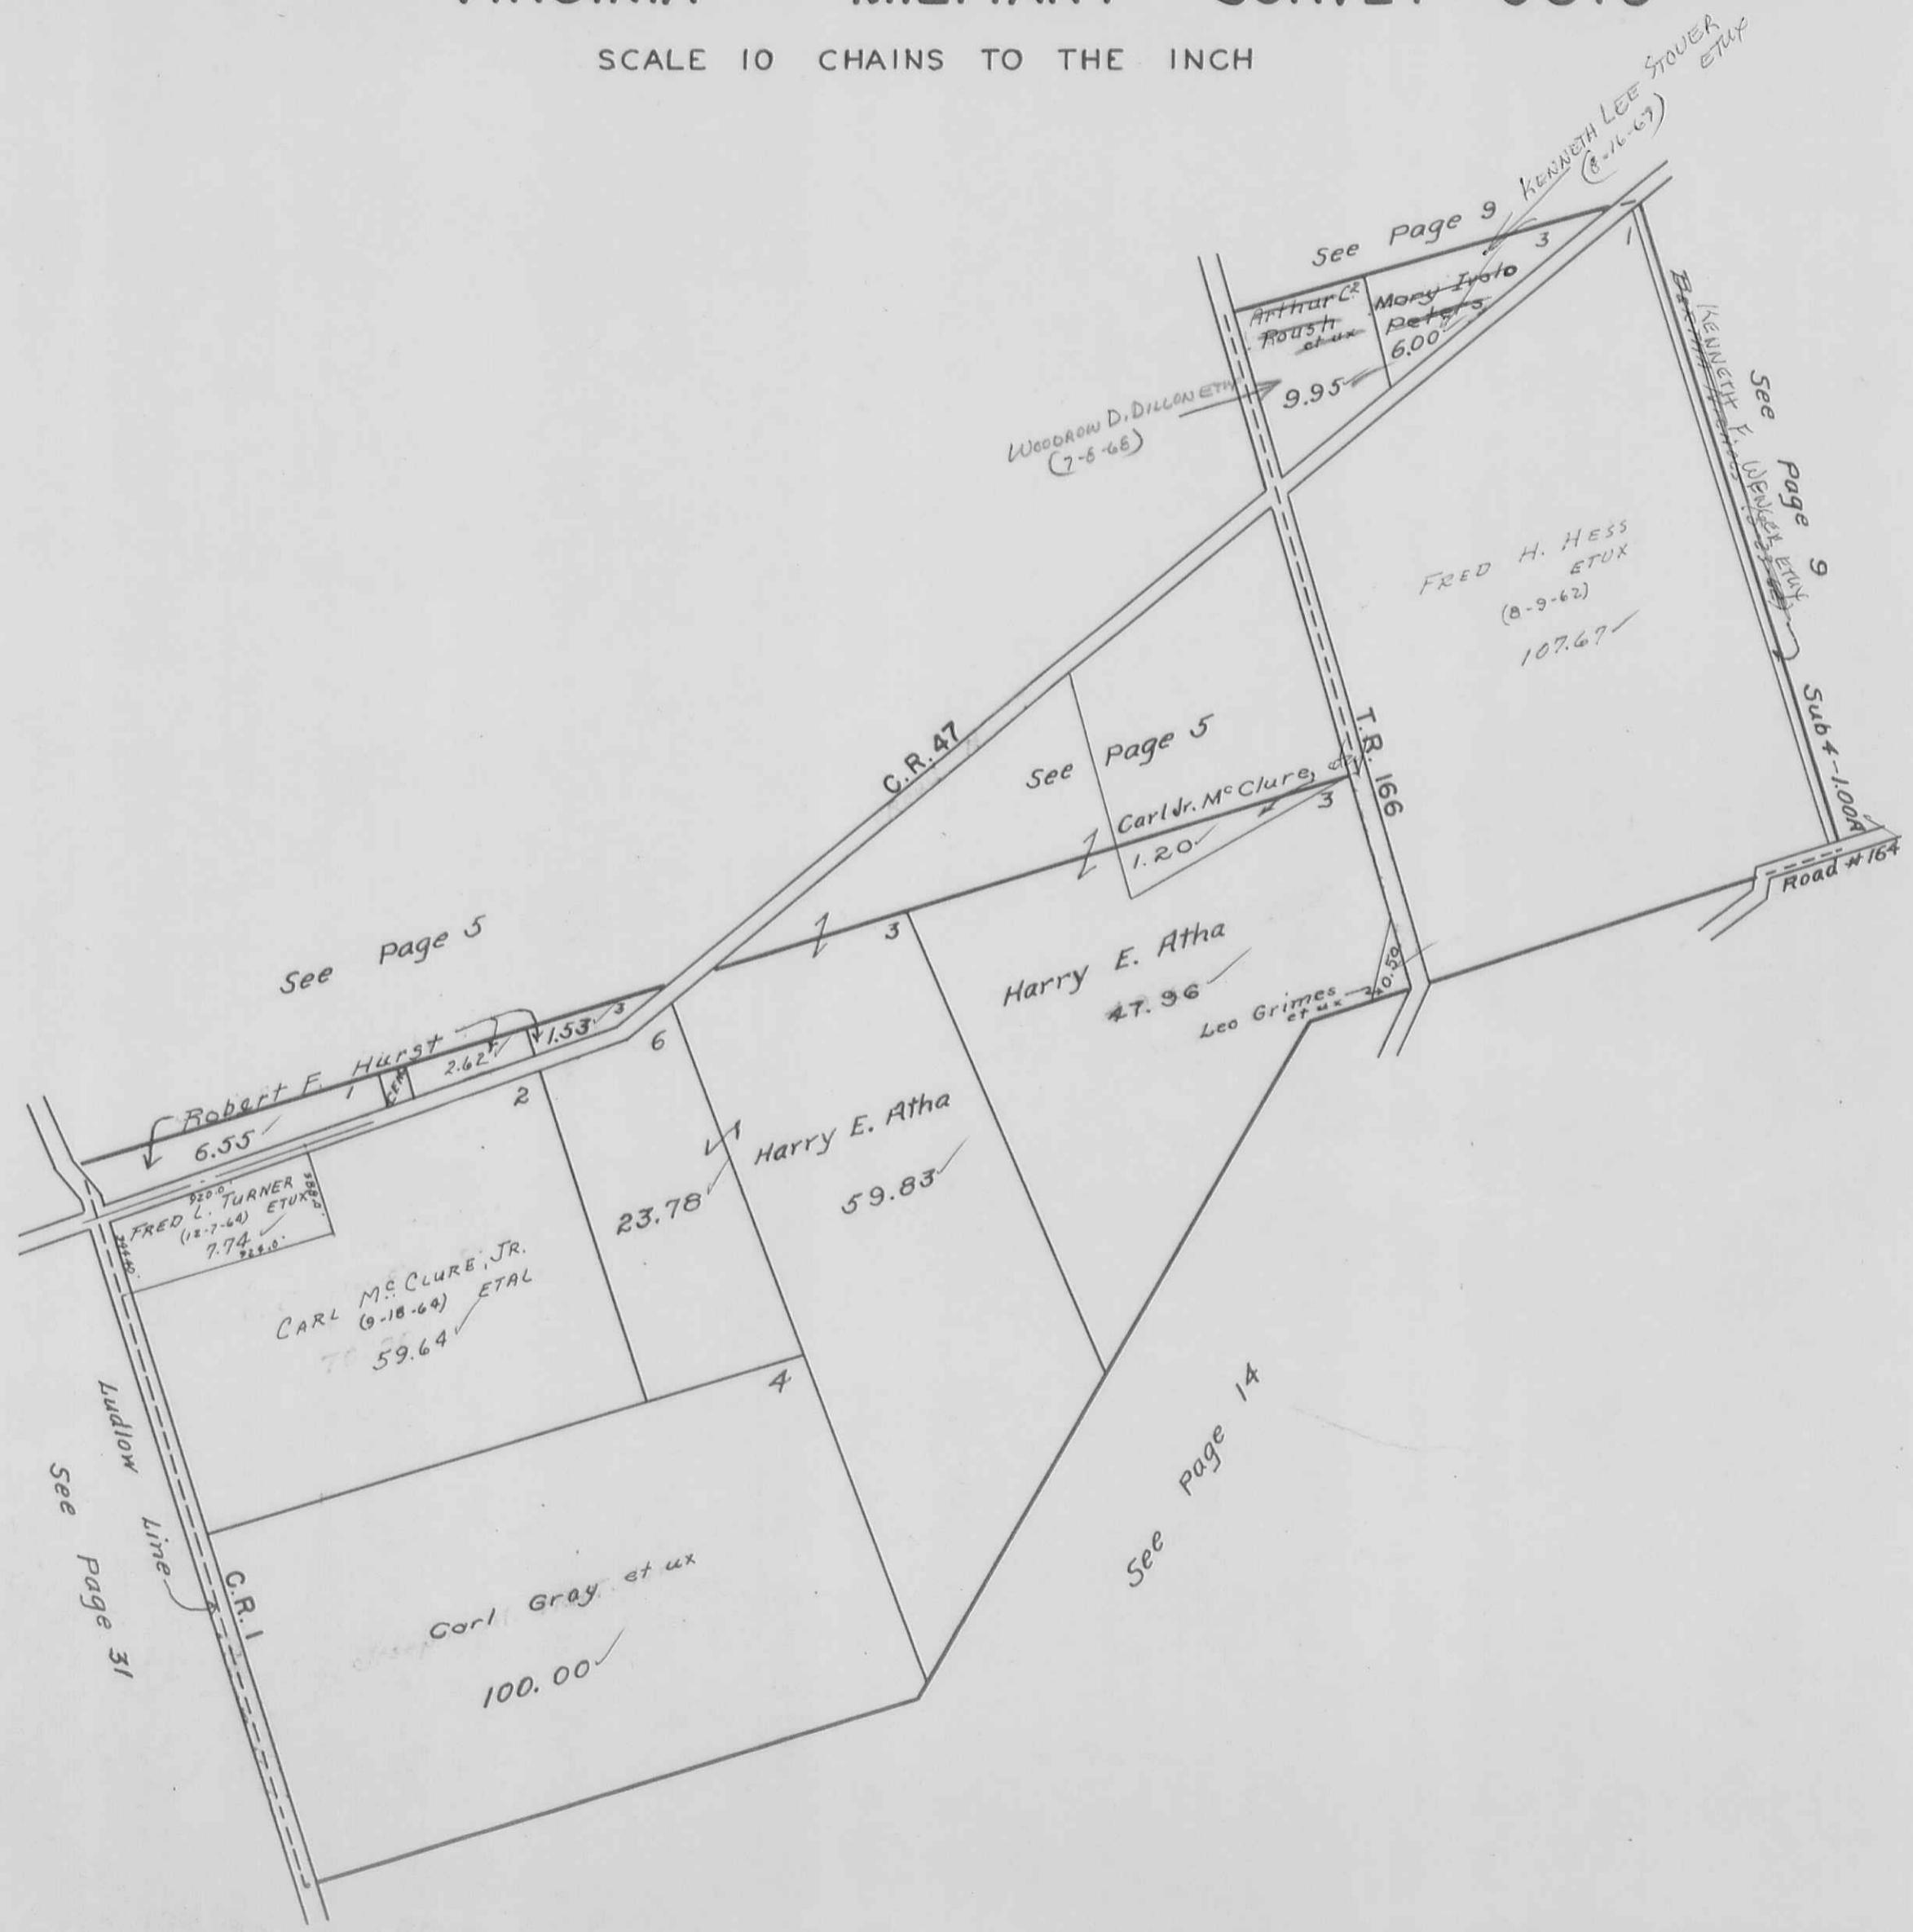

**MONROE TOWNSHIP**  
**VIRGINIA MILITARY SURVEY 4479**


PAGE 14

SCALE 10 CHAINS TO THE INCH



MONROE TOWNSHIP  
VIRGINIA MILITARY SURVEYS 10091  
SCALE 10 CHAINS TO THE INCH 6487  
2220


PAGE 15

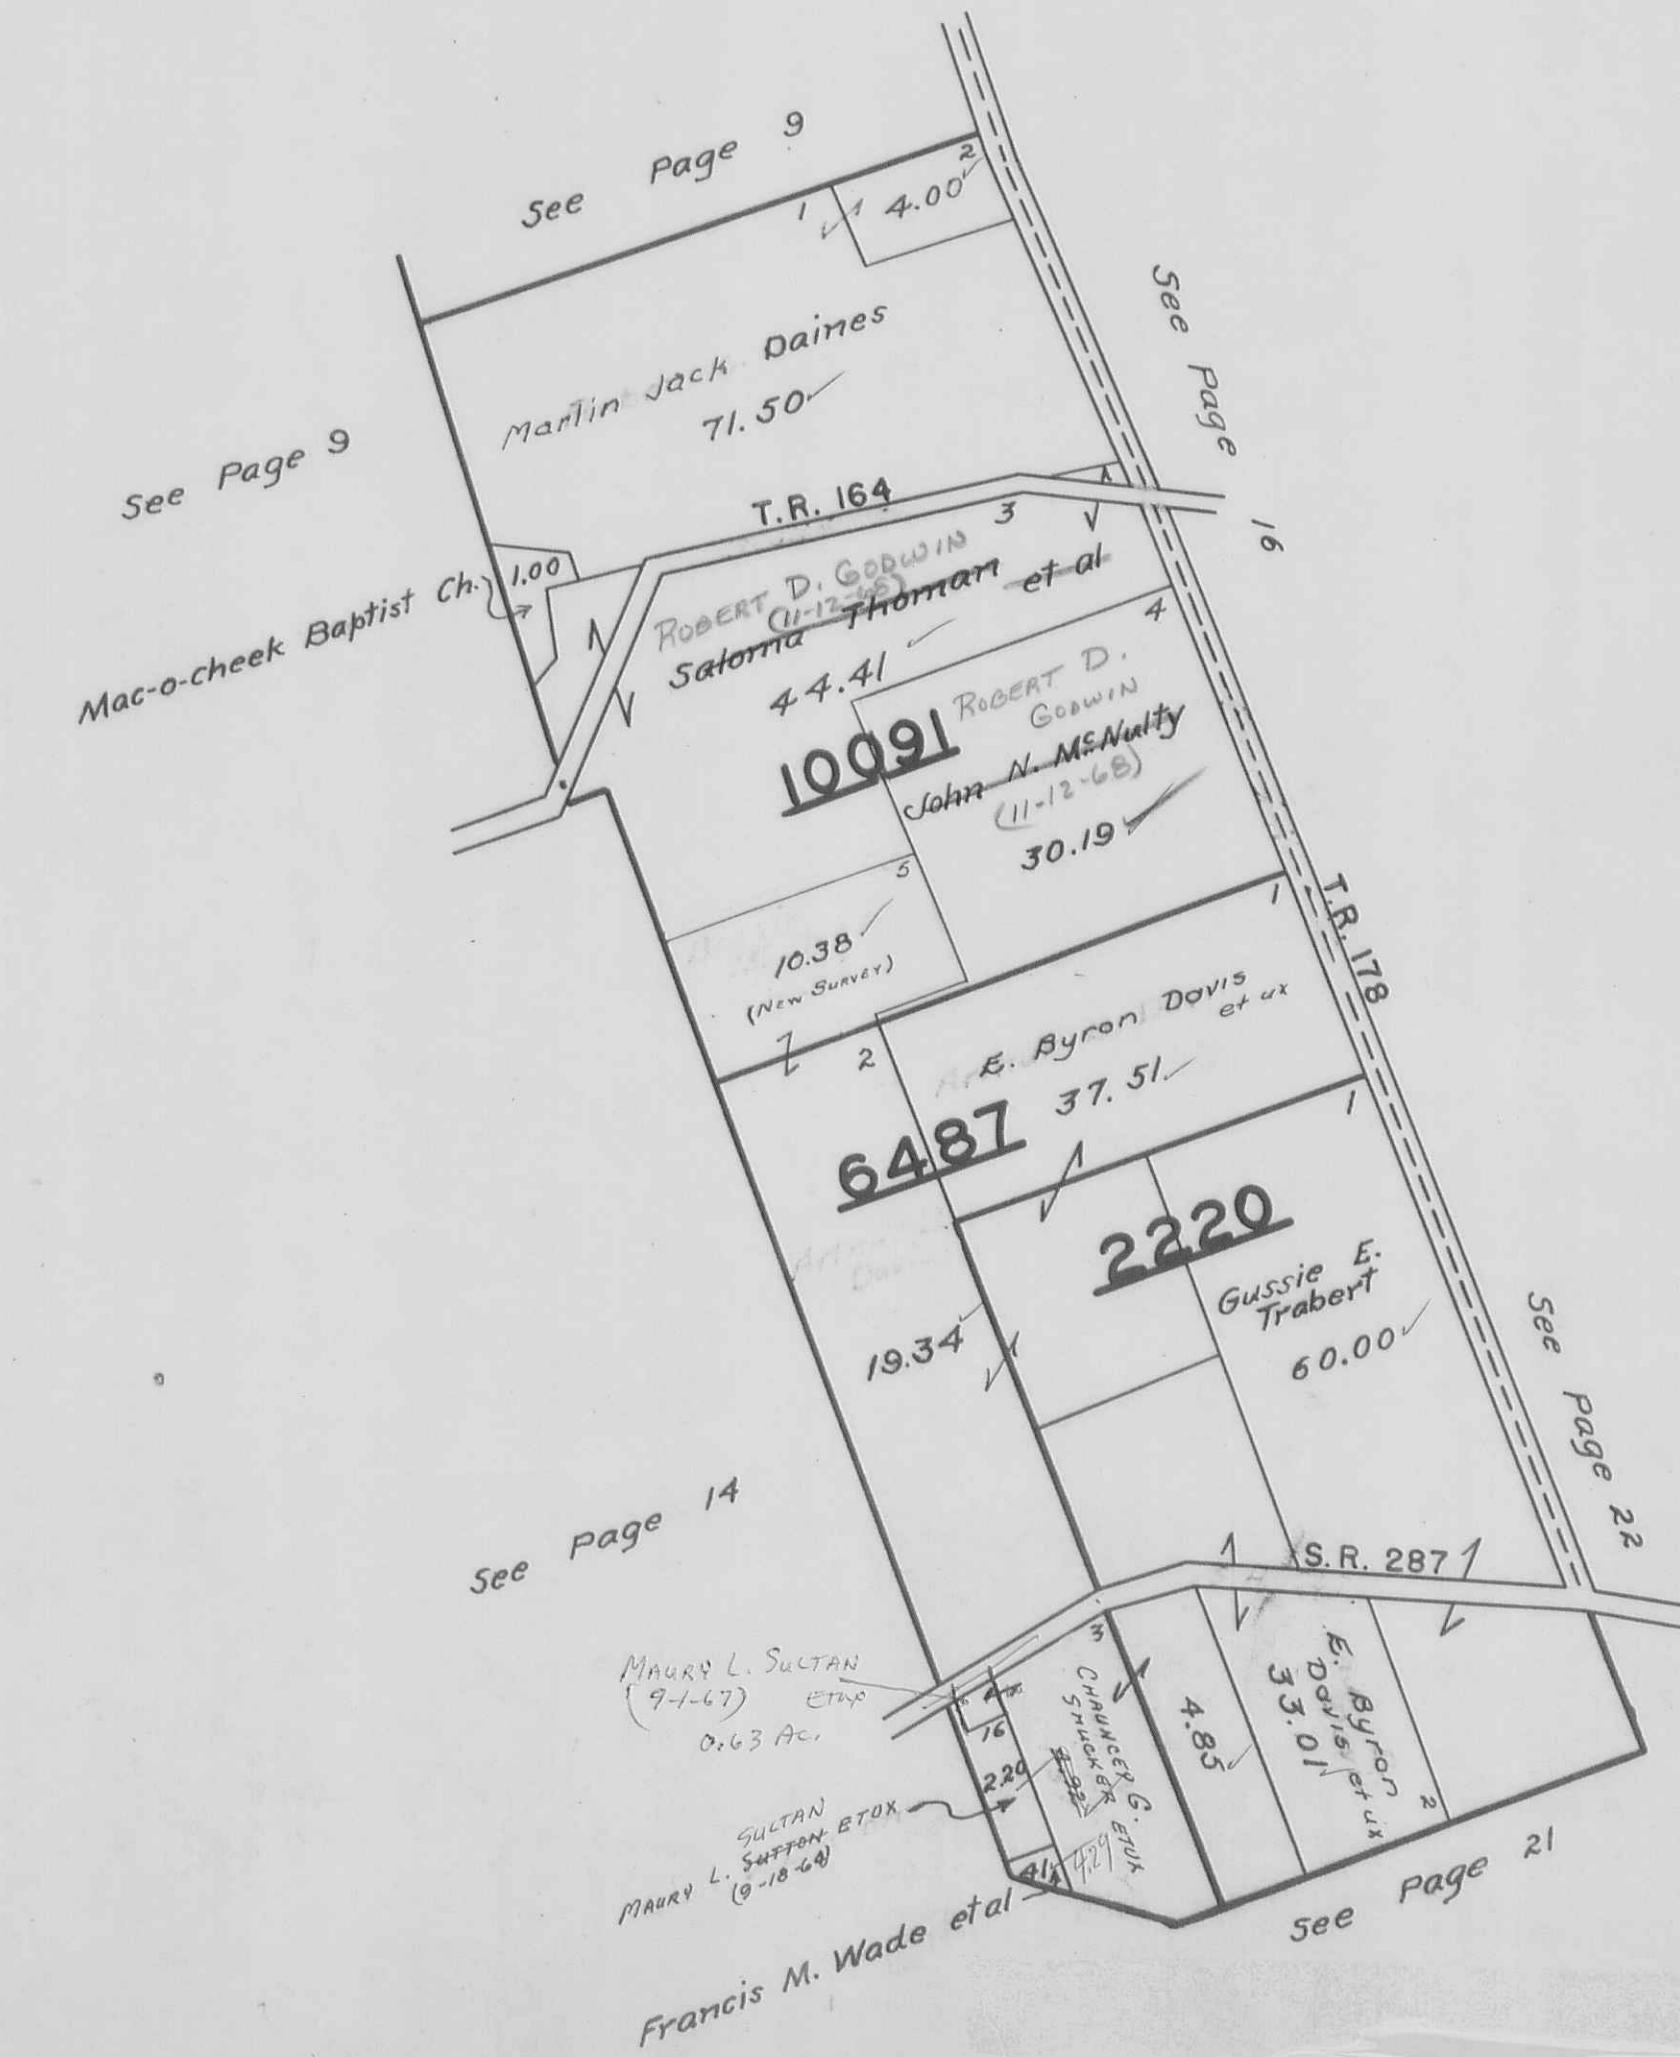

MONROE TOWNSHIP  
VIRGINIA MILITARY SURVEY 3224

SCALE 10 CHAINS TO THE INCH


PAGE 16

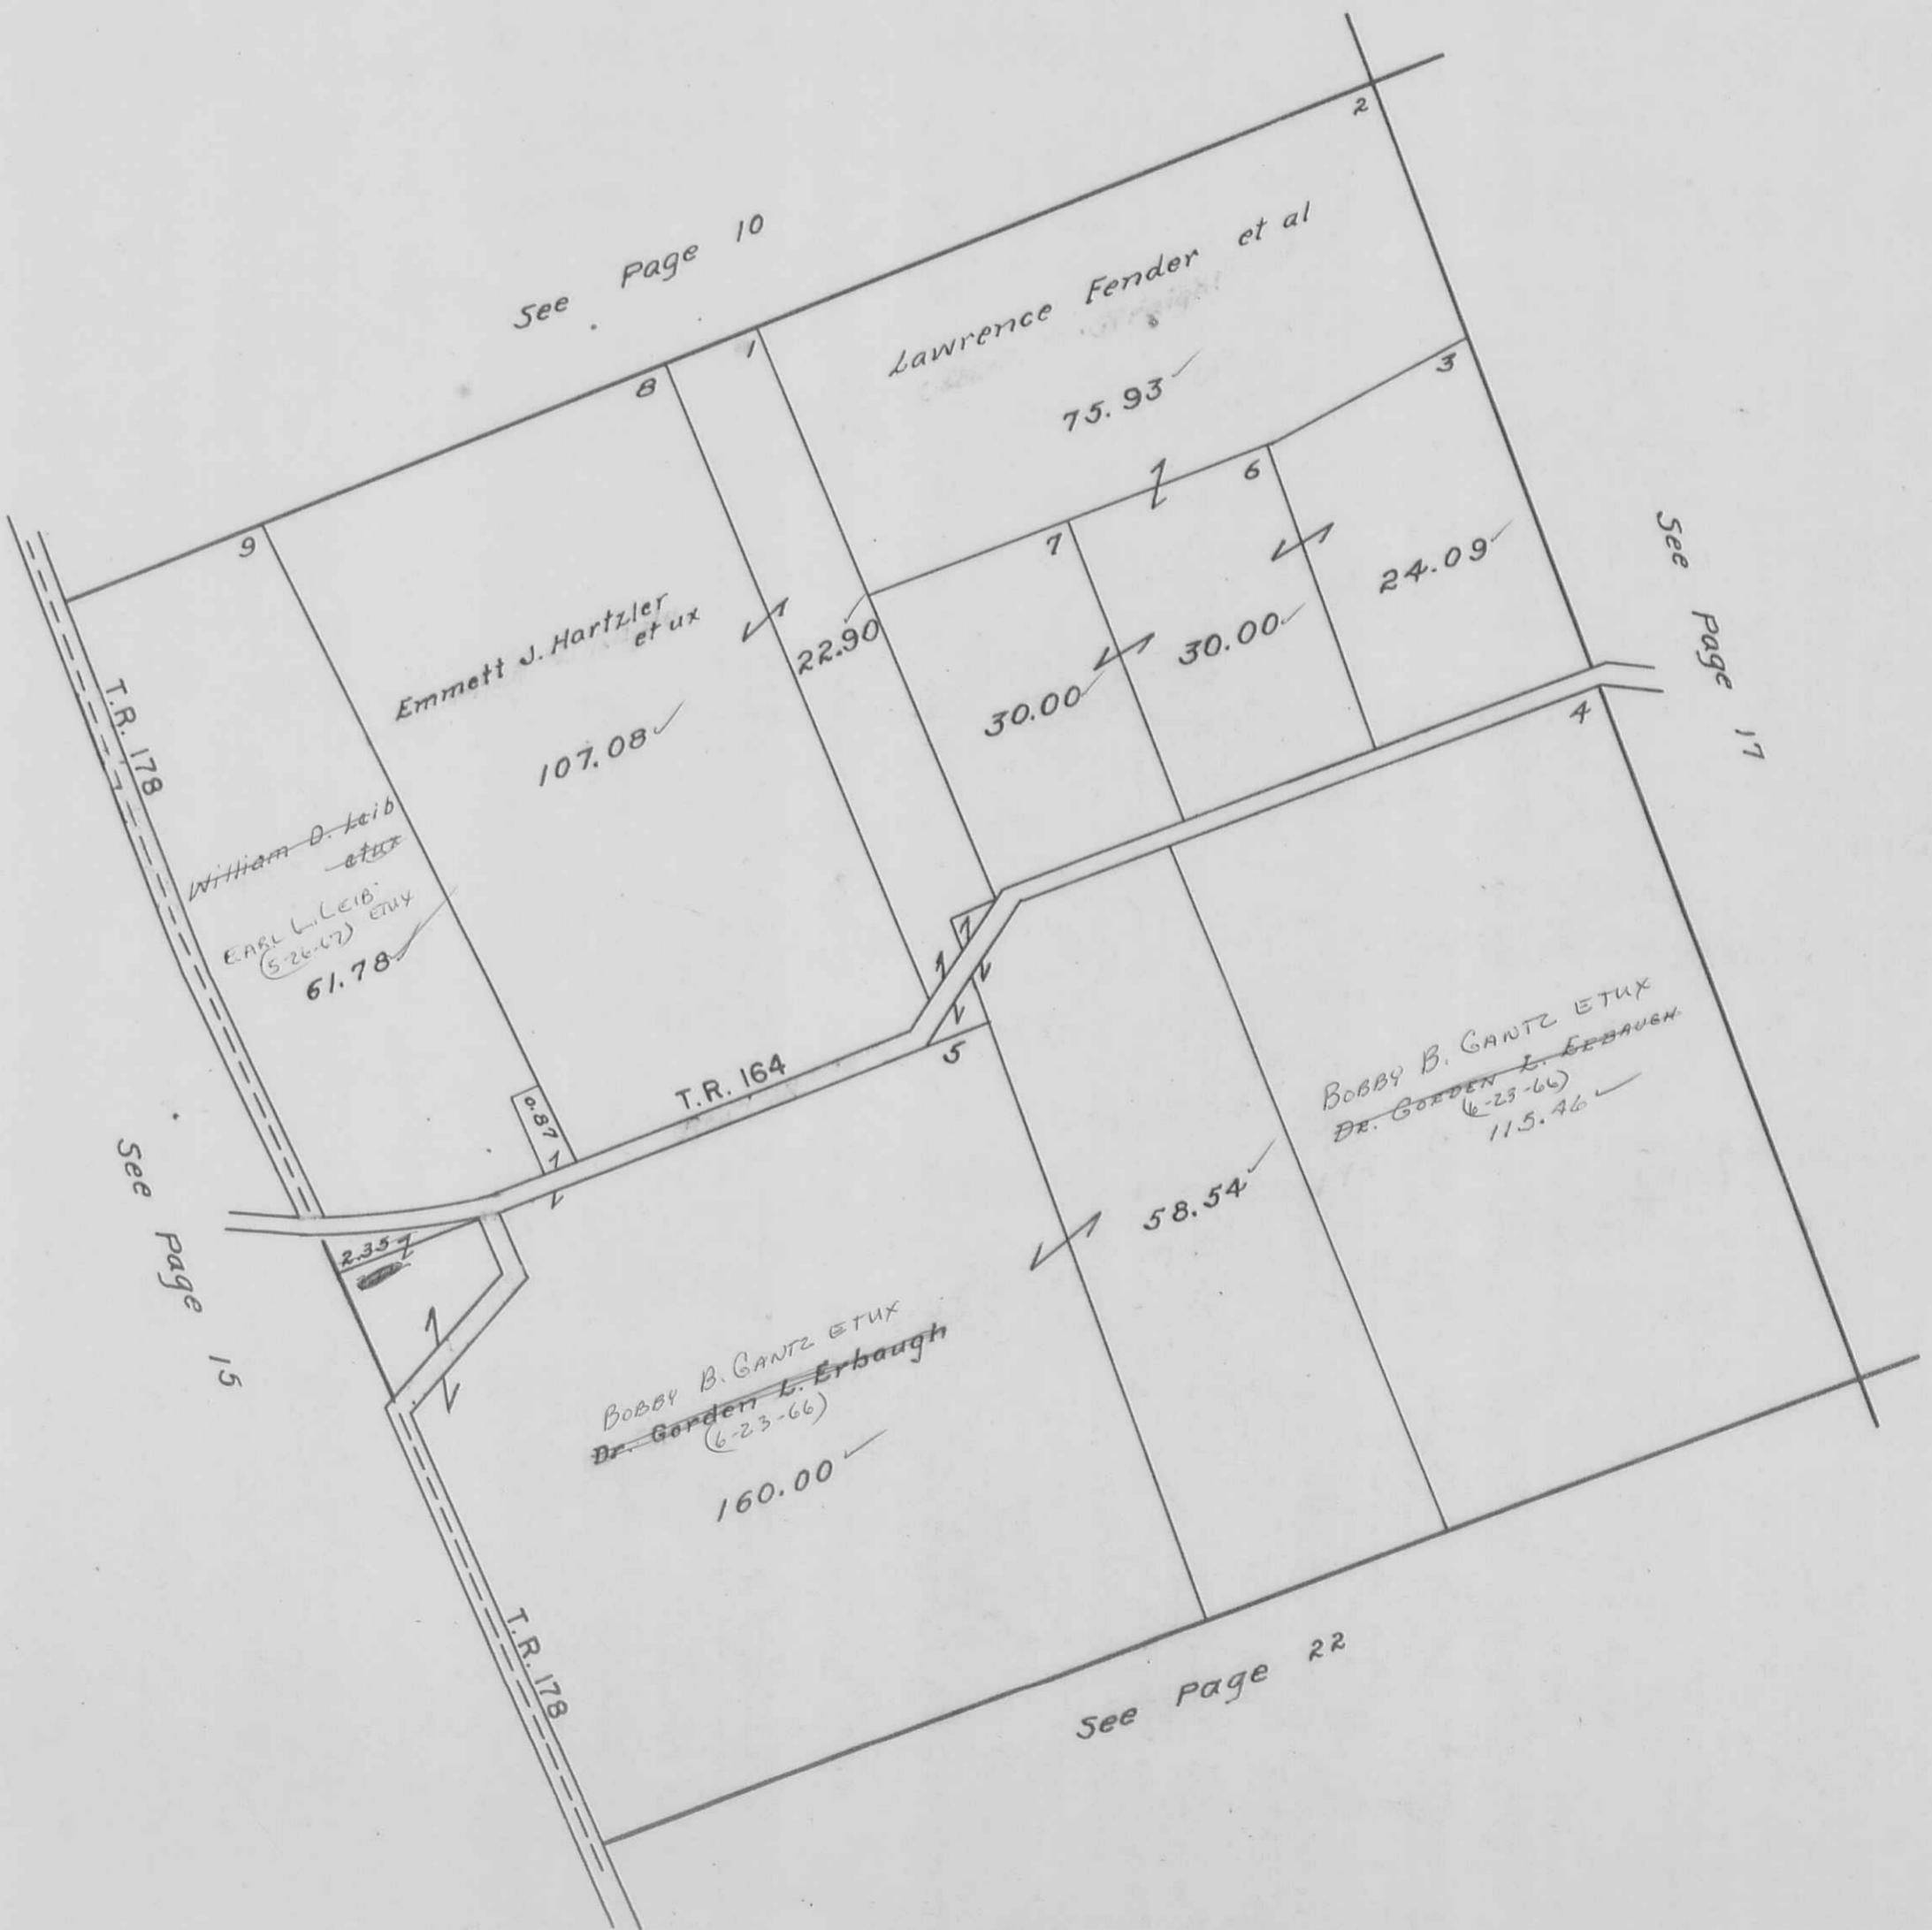

MONROE TOWNSHIP  
VIRGINIA MILITARY SURVEY 3223


SCALE 10 CHAINS TO THE INCH

PAGE 17

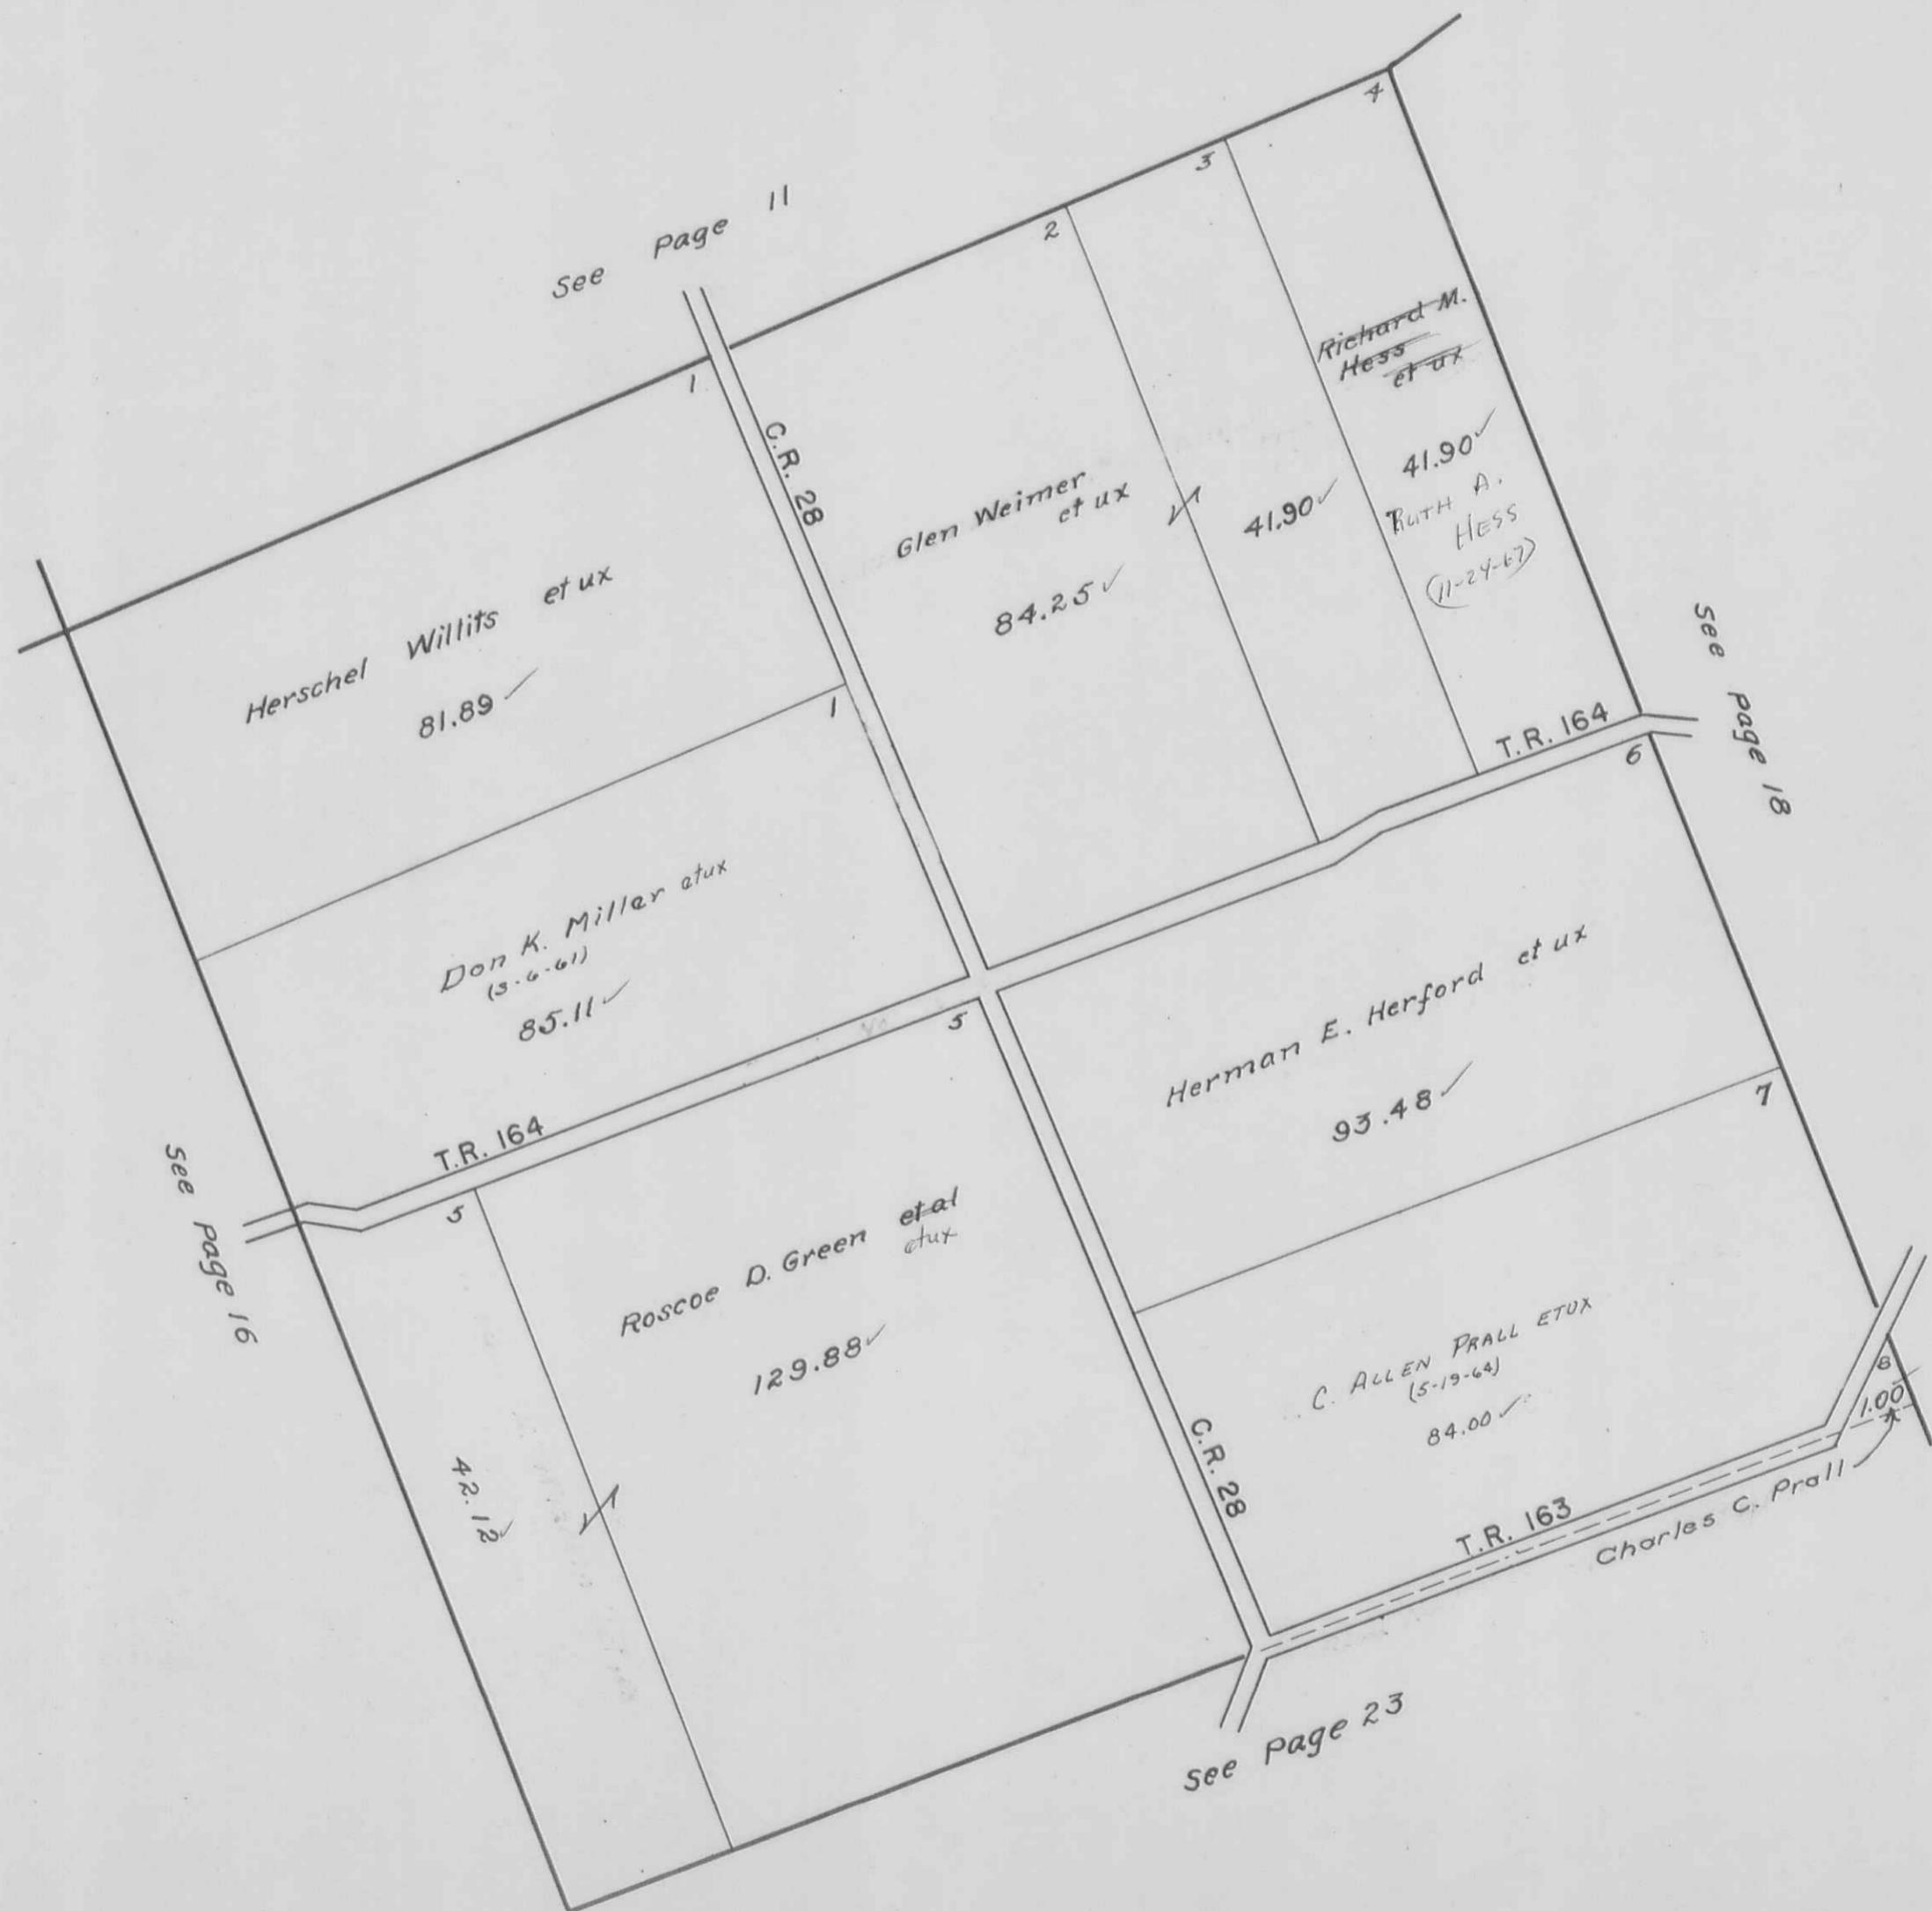

## VIRGINIA MILITARY SURVEY N.PART 4570

SCALE 10 CHAINS TO THE INCH

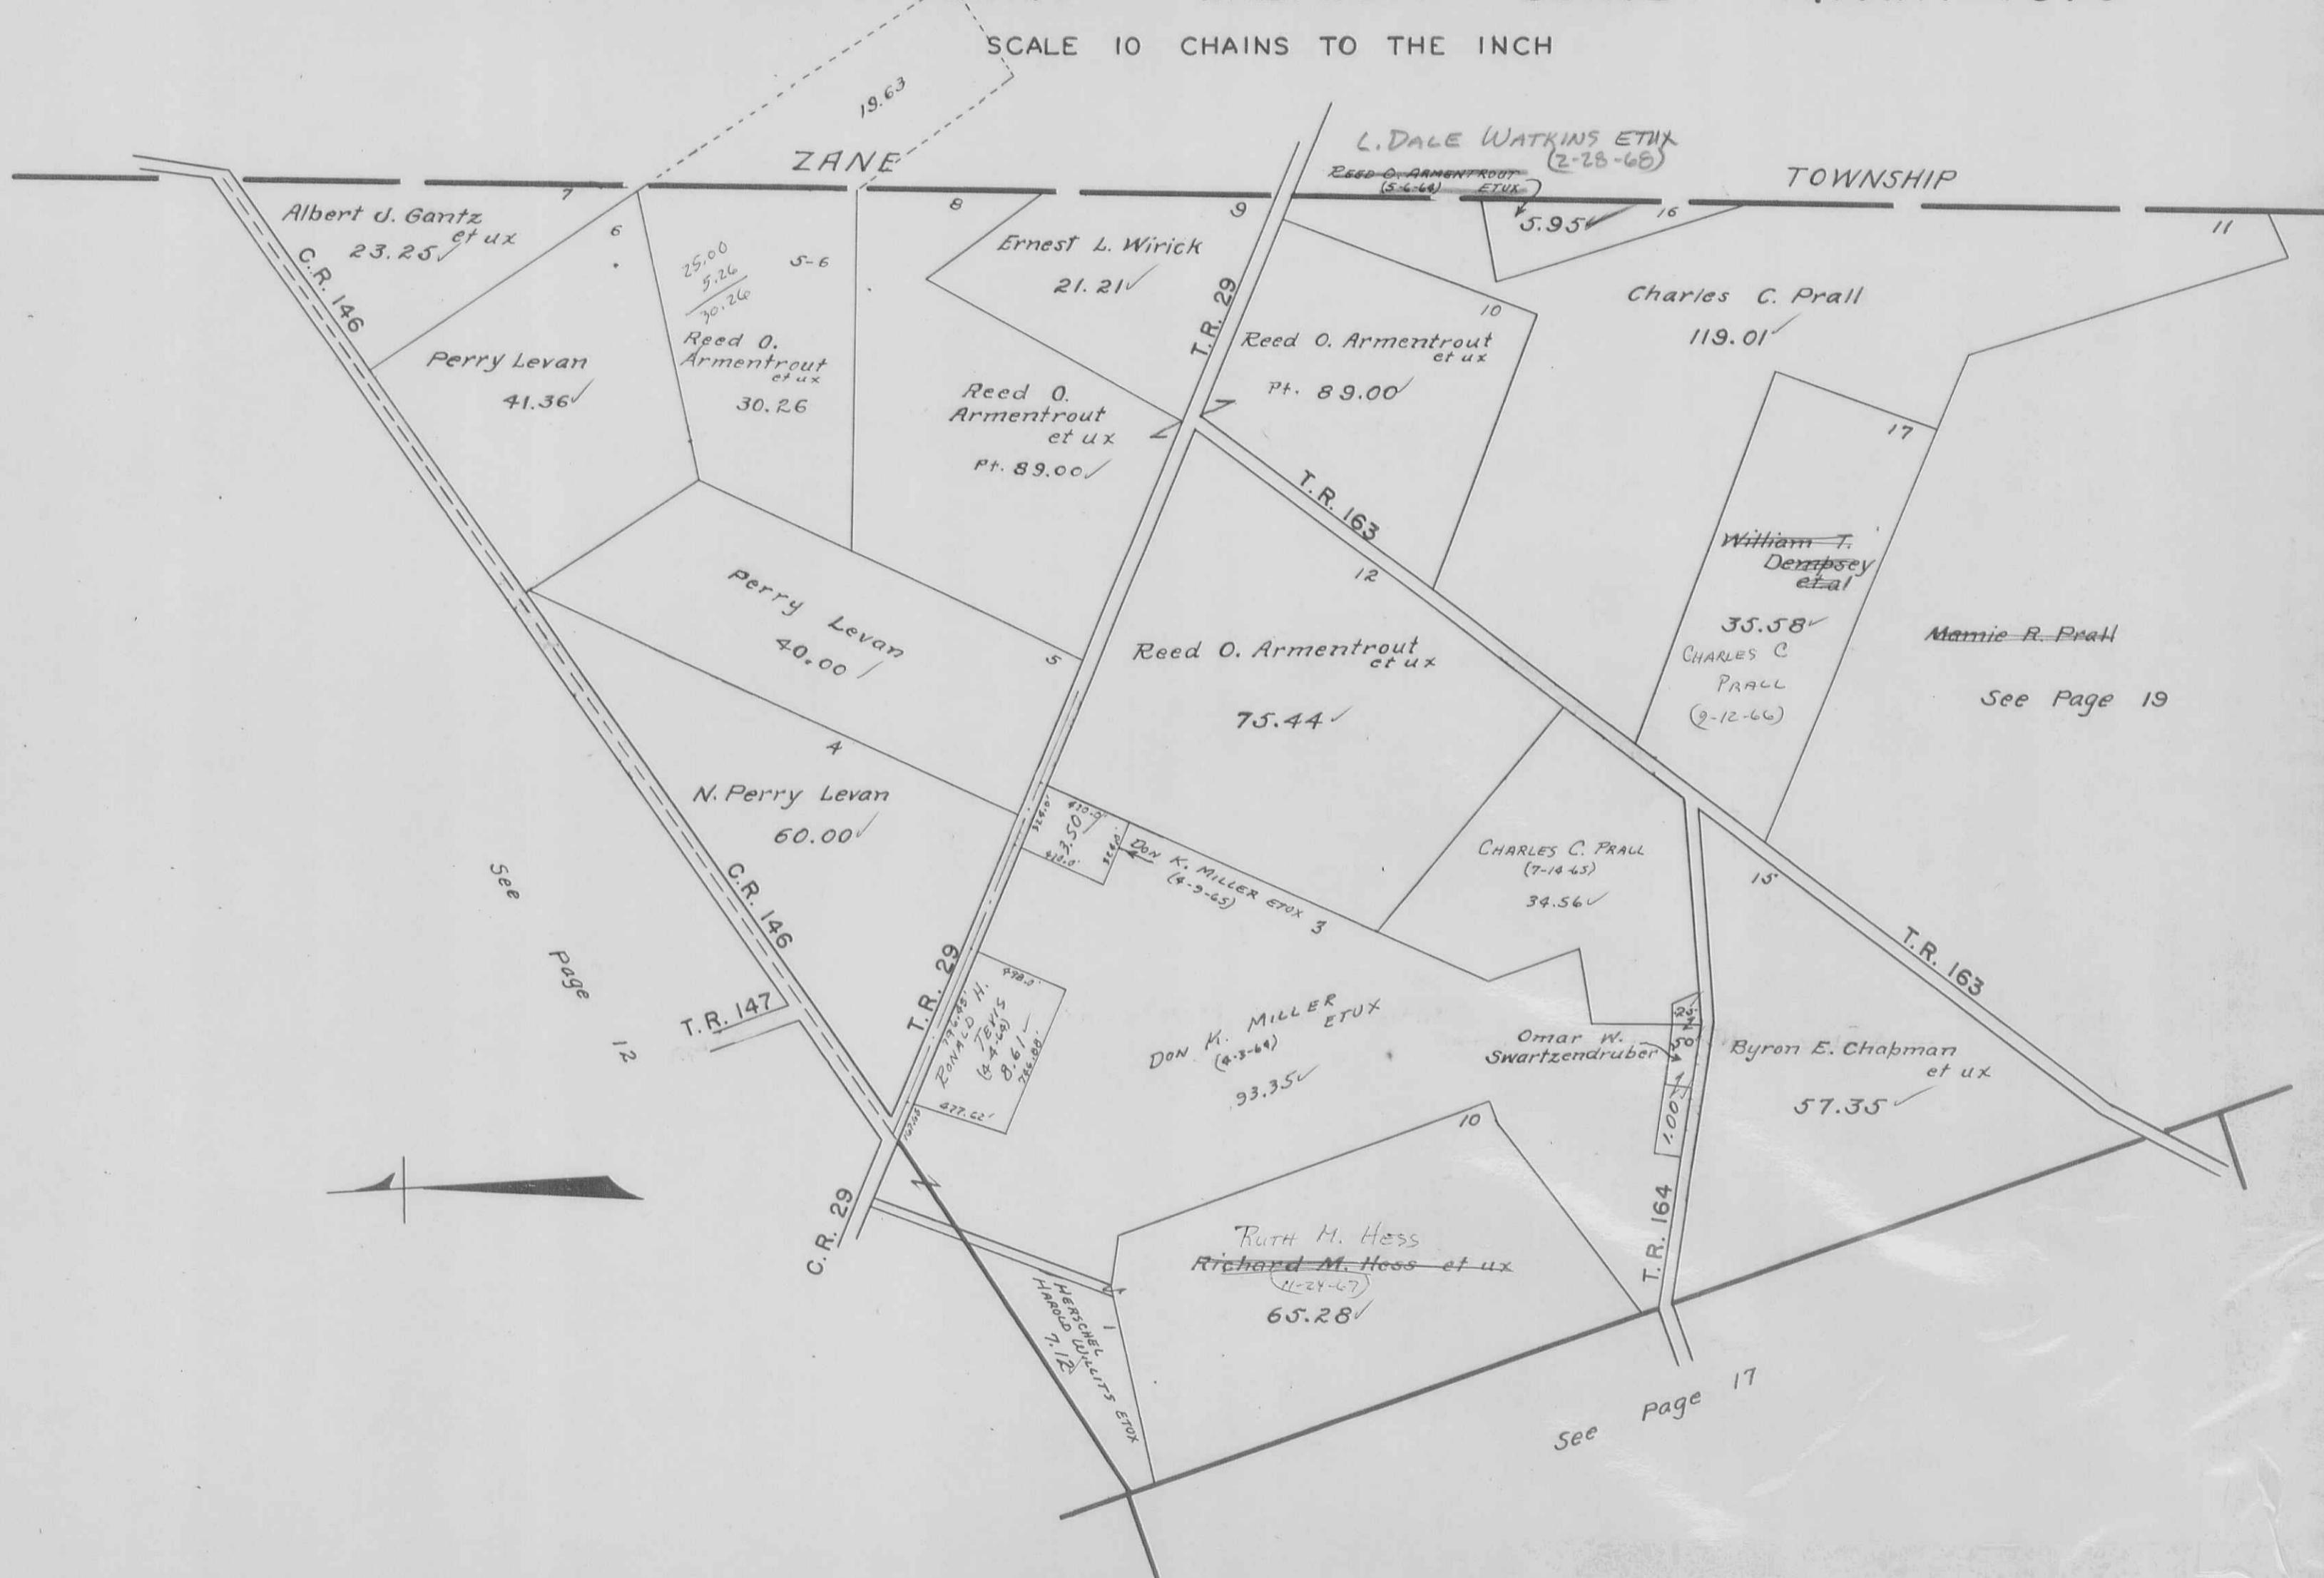

MONROE TOWNSHIP  
VIRGINIA MILITARY SURVEY S.PART 4570

SCALE 10 CHAINS TO THE INCH



MONROE TOWNSHIP PAGE 20  
VIRGINIA MILITARY SURVEY W. PART 4492

SCALE 10 CHAINS TO THE INCH





MONROE TOWNSHIP  
VIRGINIA MILITARY SURVEY 3225

SCALE 10 CHAINS TO THE INCH

PAGE 22



MON ROE TOWNSHIP  
VIRGINIA MILITARY SURVEY 3226

SCALE 10 CHAINS TO THE INCH

PAGE 23



MONROE TOWNSHIP  
VIRGINIA MILITARY SURVEY 3227

SCALE 10 CHAINS TO THE INCH



MONROE TOWNSHIP  
VIRGINIA MILITARY SURVEYS 3228  
SCALE 10 CHAINS TO THE INCH

PAGE 25

3228  
9679



## MONROE TOWNSHIP

V.M.S. 3229


SCALE: 1" = 10 CHAINS = 660'



MONROE TOWNSHIP  
VIRGINIA MILITARY SURVEY 3229

SCALE 10 CHAINS TO THE INCH

PAGE 26

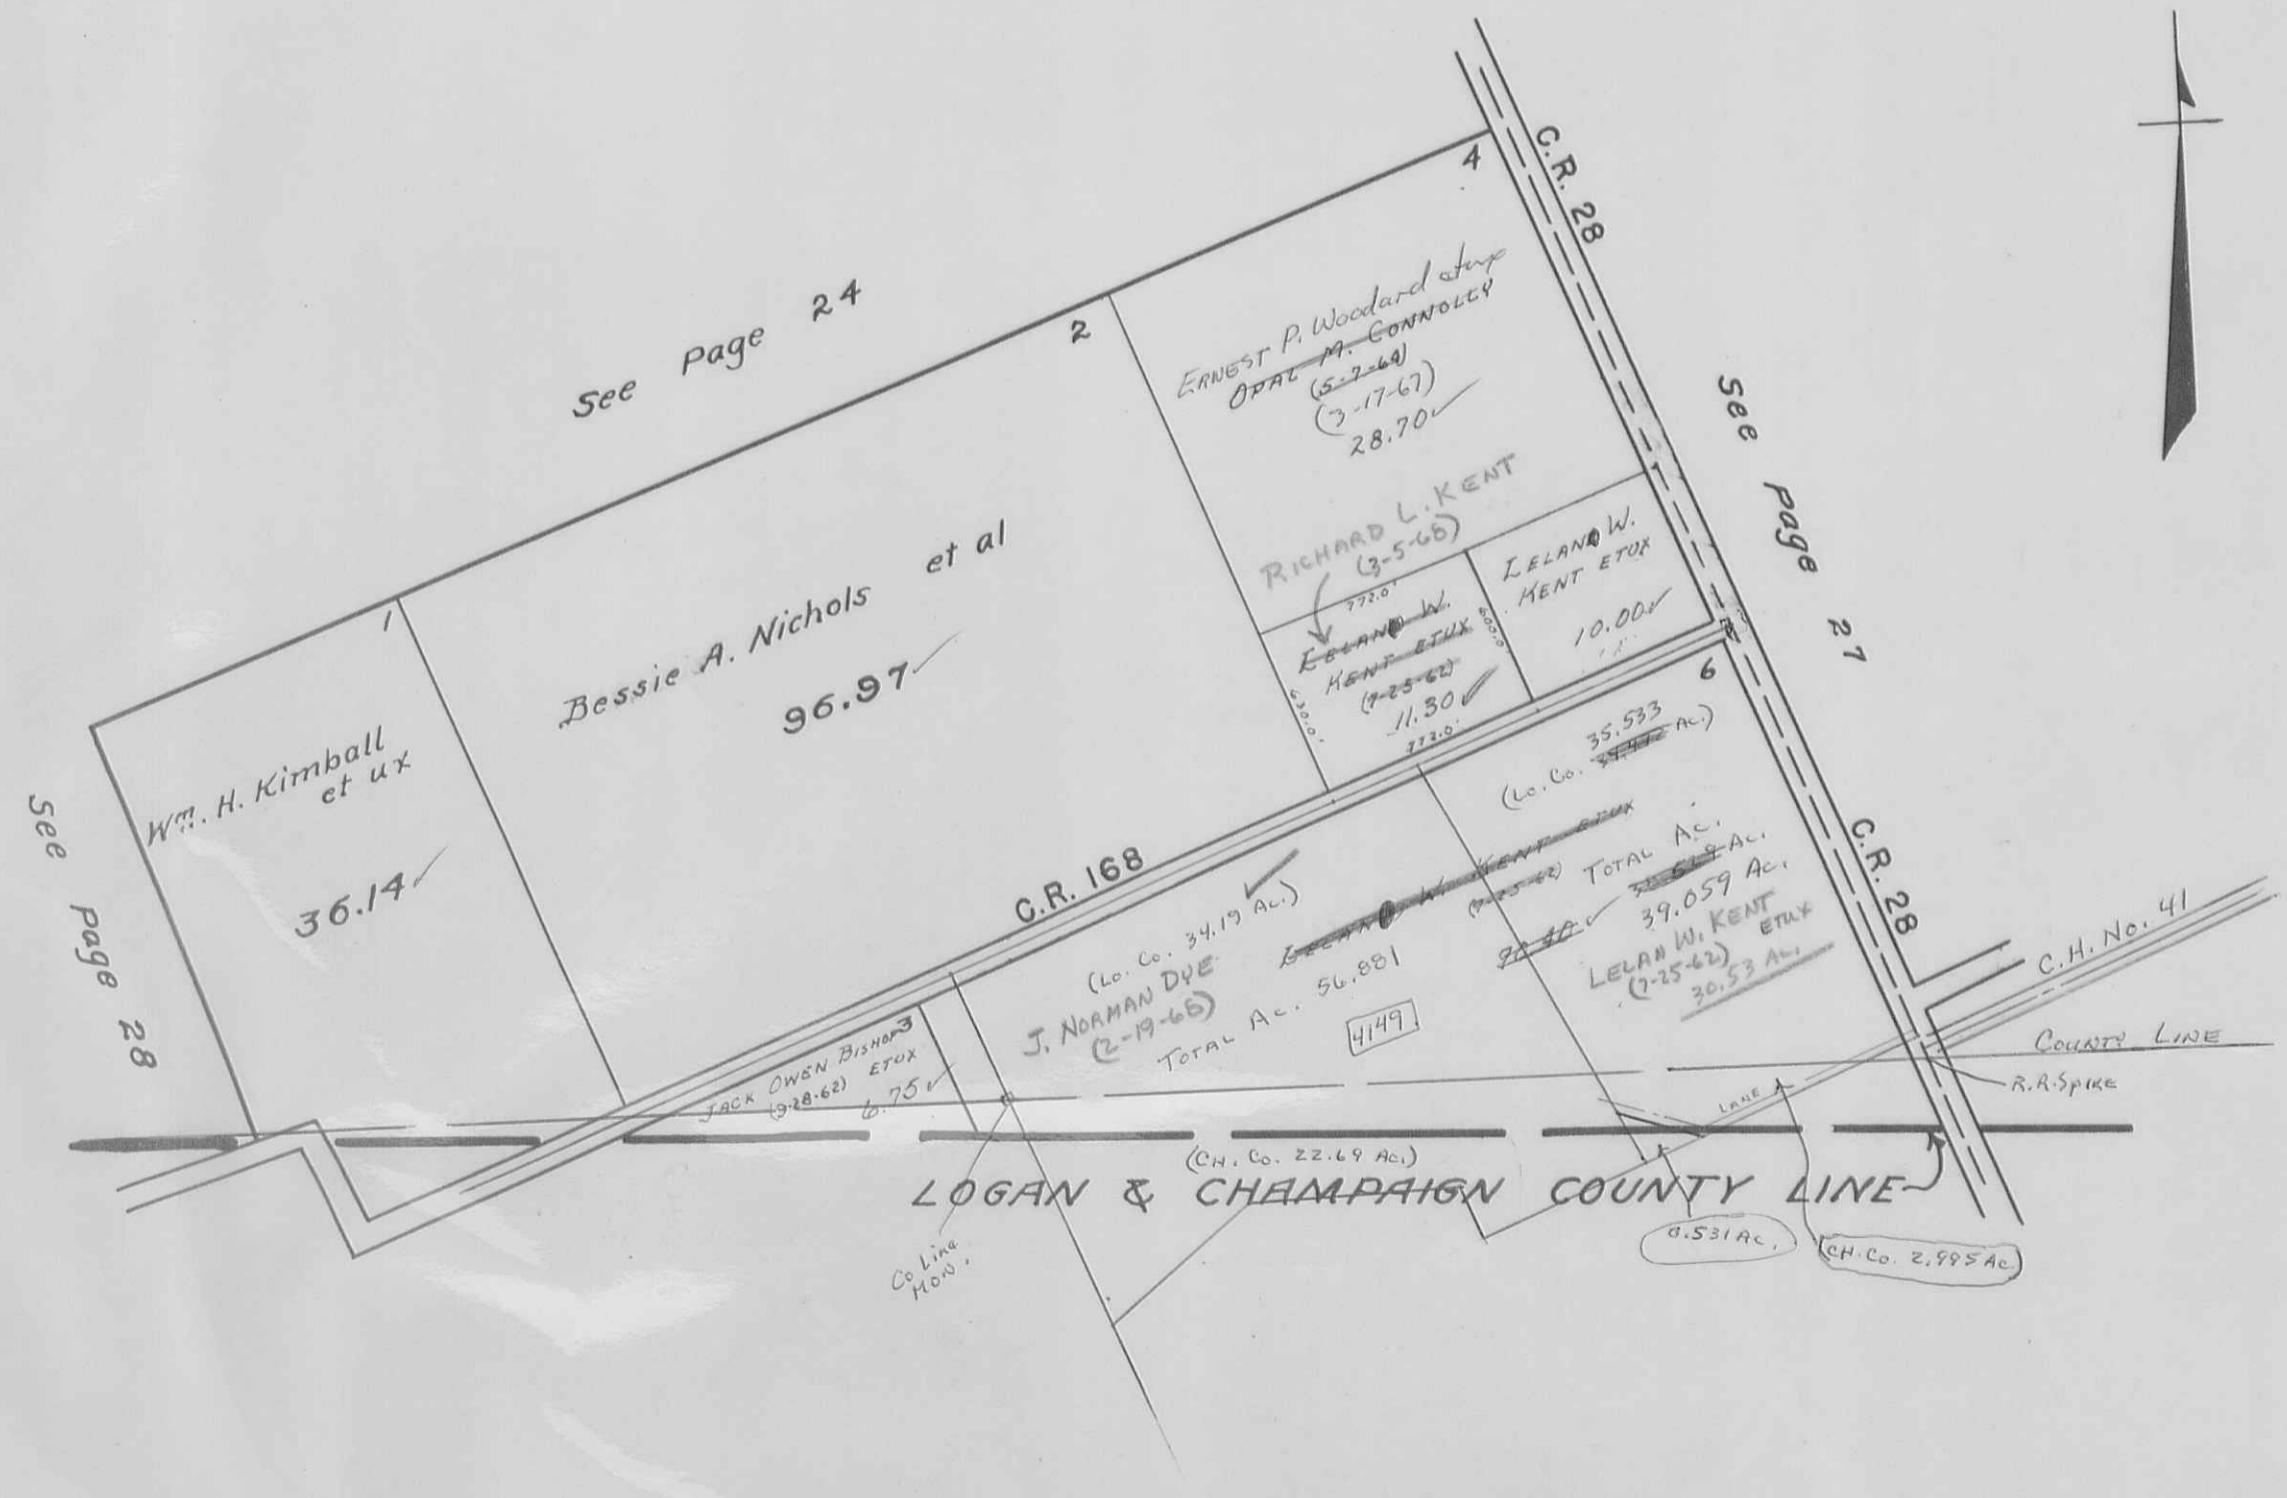

MONROE TOWNSHIP  
VIRGINIA MILITARY SURVEY 3230

SCALE 10 CHAINS TO THE INCH

PAGE 27




**MONROE TOWNSHIP  
VIRGINIA MILITARY SURVEYS  
SCALE 10 CHAINS TO THE INCH**

PAGE 28

5042  
5044

SCALE 10 CHAINS TO THE INCH

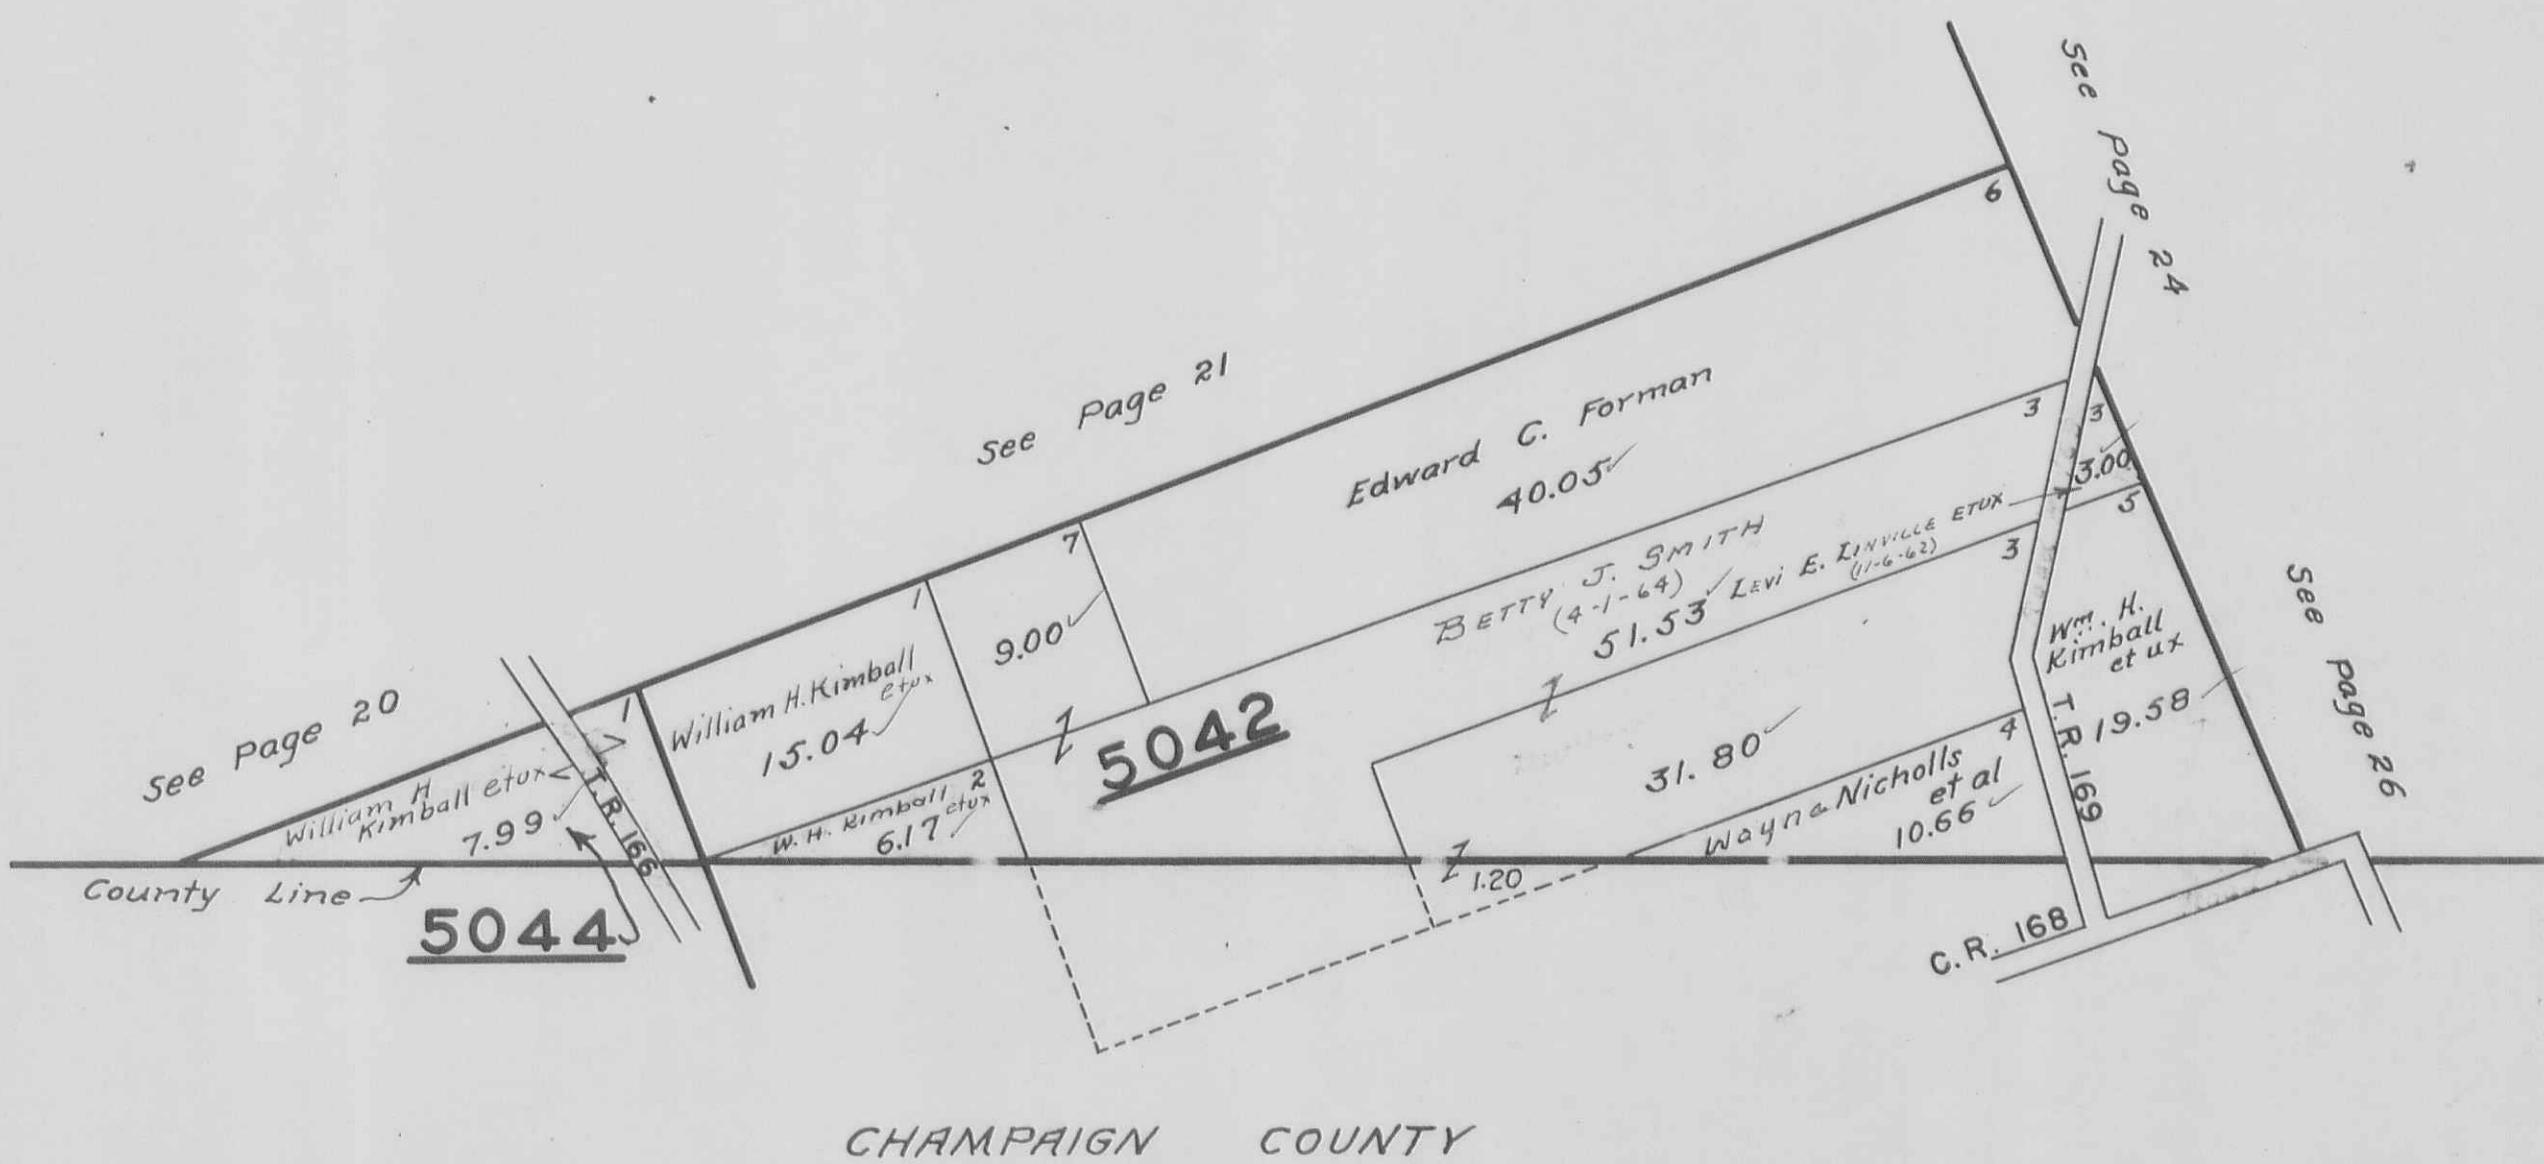



## MONROE

## TOWNSHIP

PAGE 29

SECTION 19 TOWN 4 RANGE 14  
 SECTION 24 TOWN 5 RANGE 13

SCALE 10 CHAINS TO THE INCH

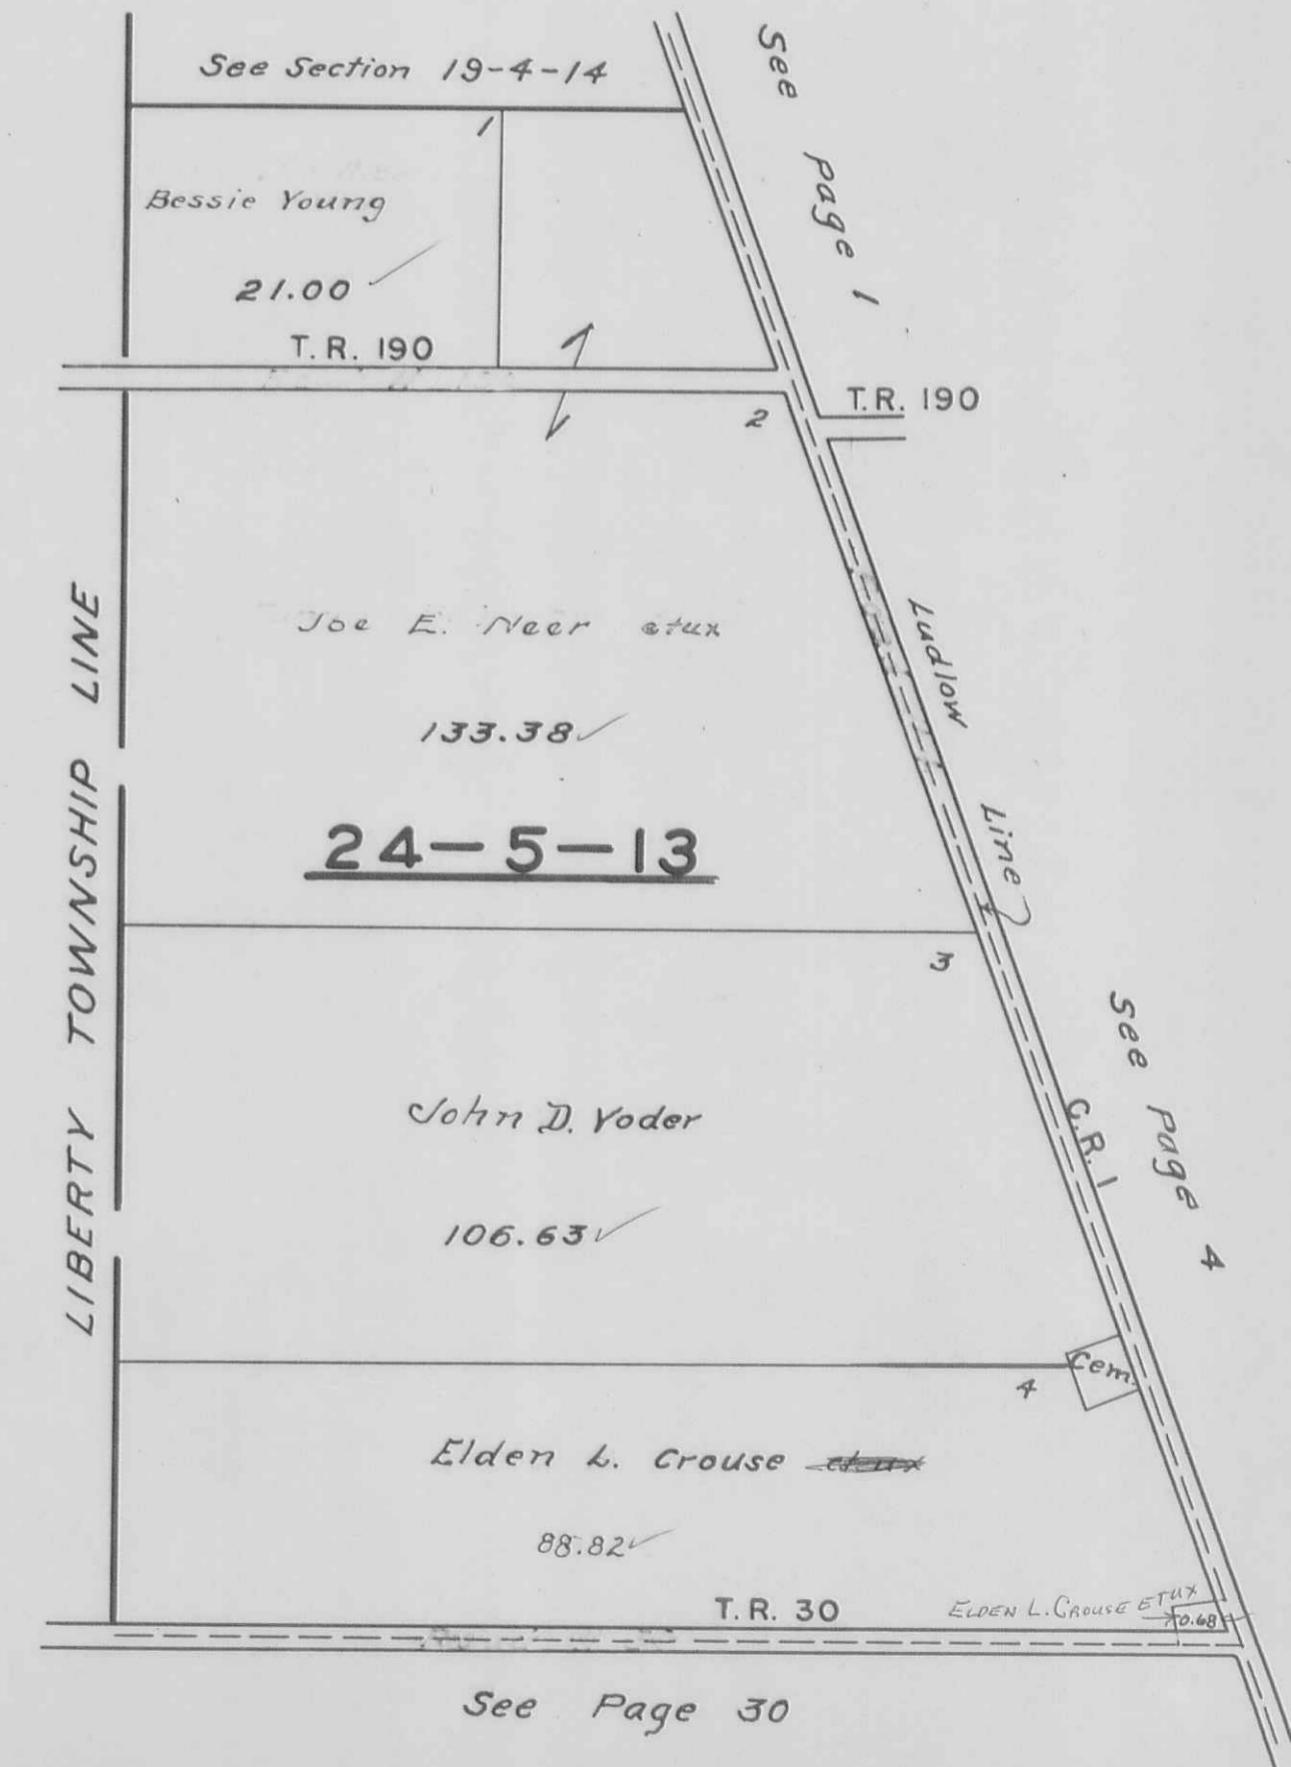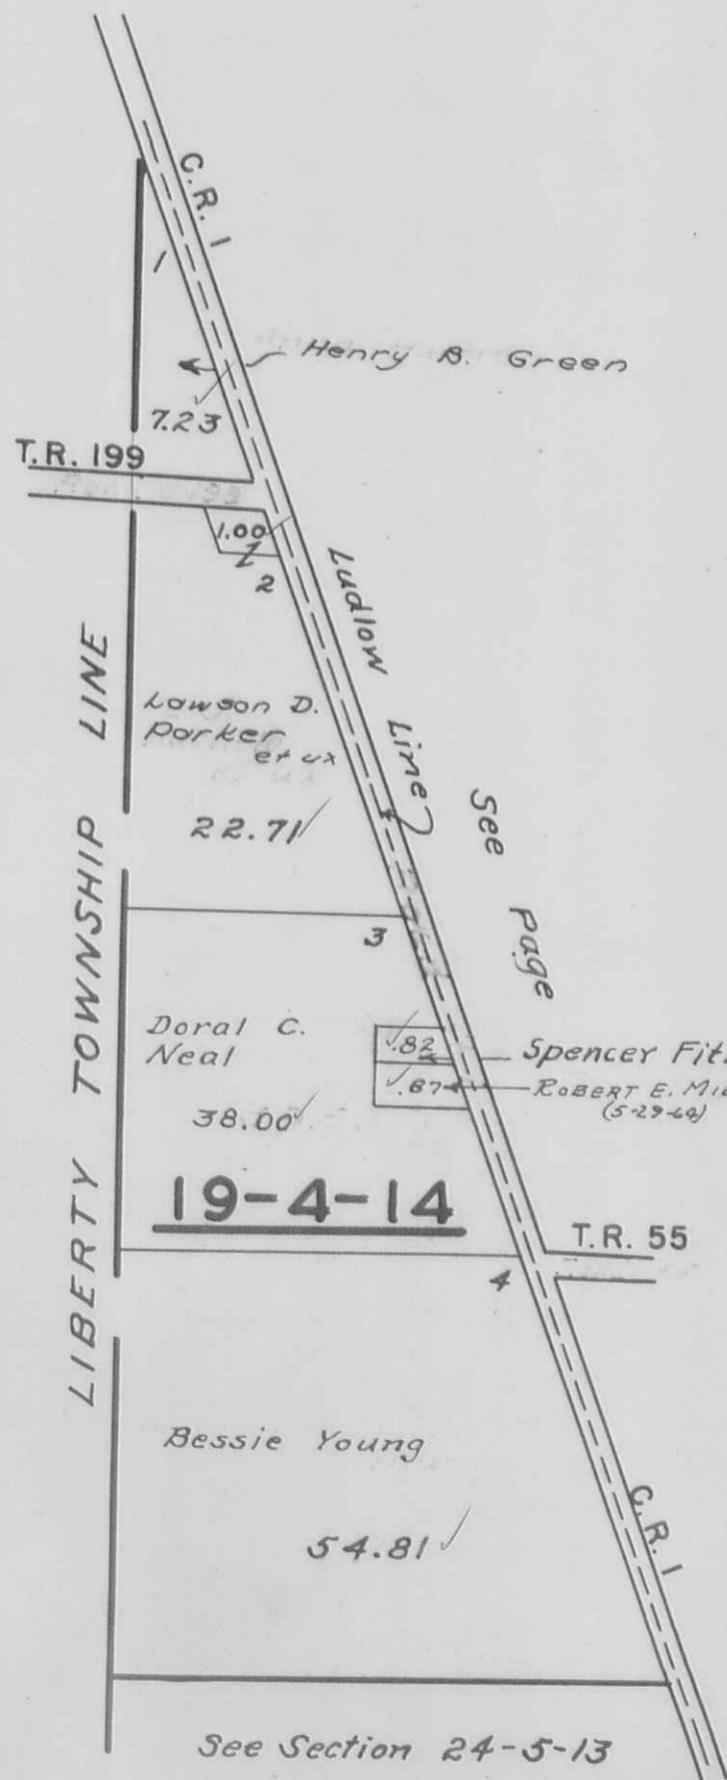


MONROE TOWNSHIP

PAGE 30

SECTION 17 TOWN 5 RANGE 13  
SECTION 23 TOWN 5 RANGE 13

SCALE 10 CHAINS TO THE INCH

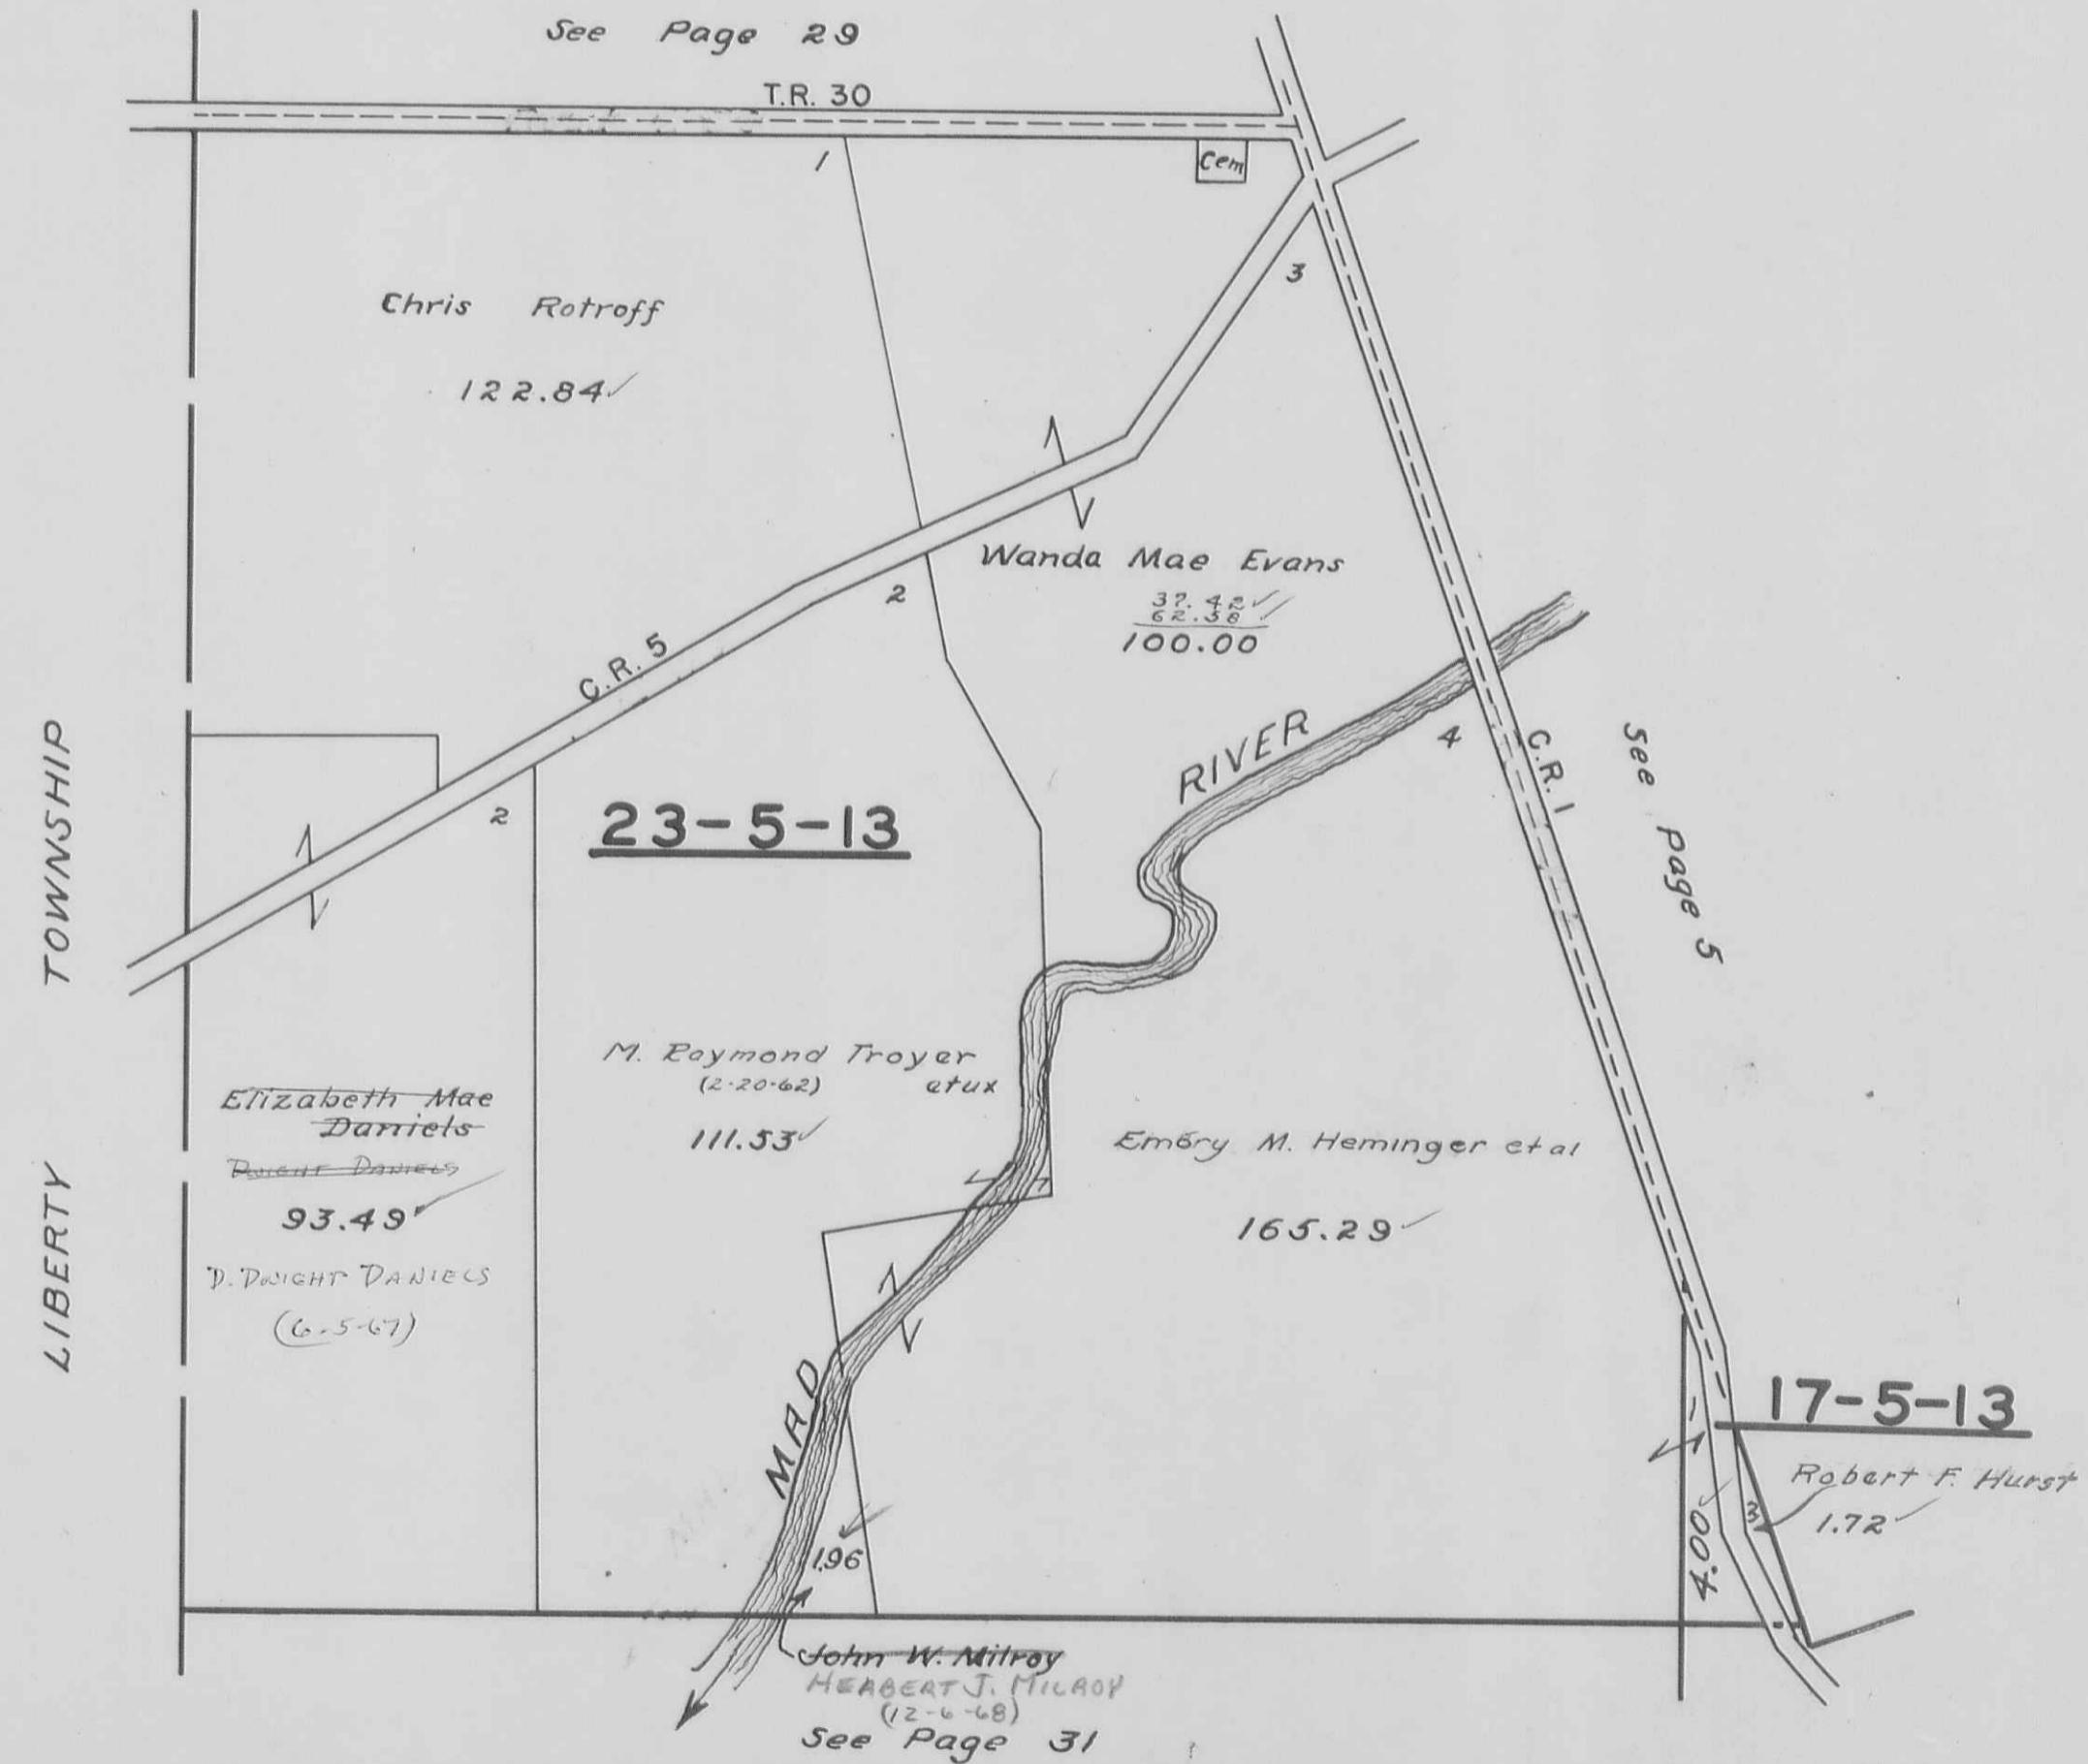


## MONROE TOWNSHIP

PAGE 31

SECTION 22 TOWN 5 RANGE 13  
SECTION 16 TOWN 5 RANGE 13

SCALE 10 CHAINS TO THE INCH


See Page 30

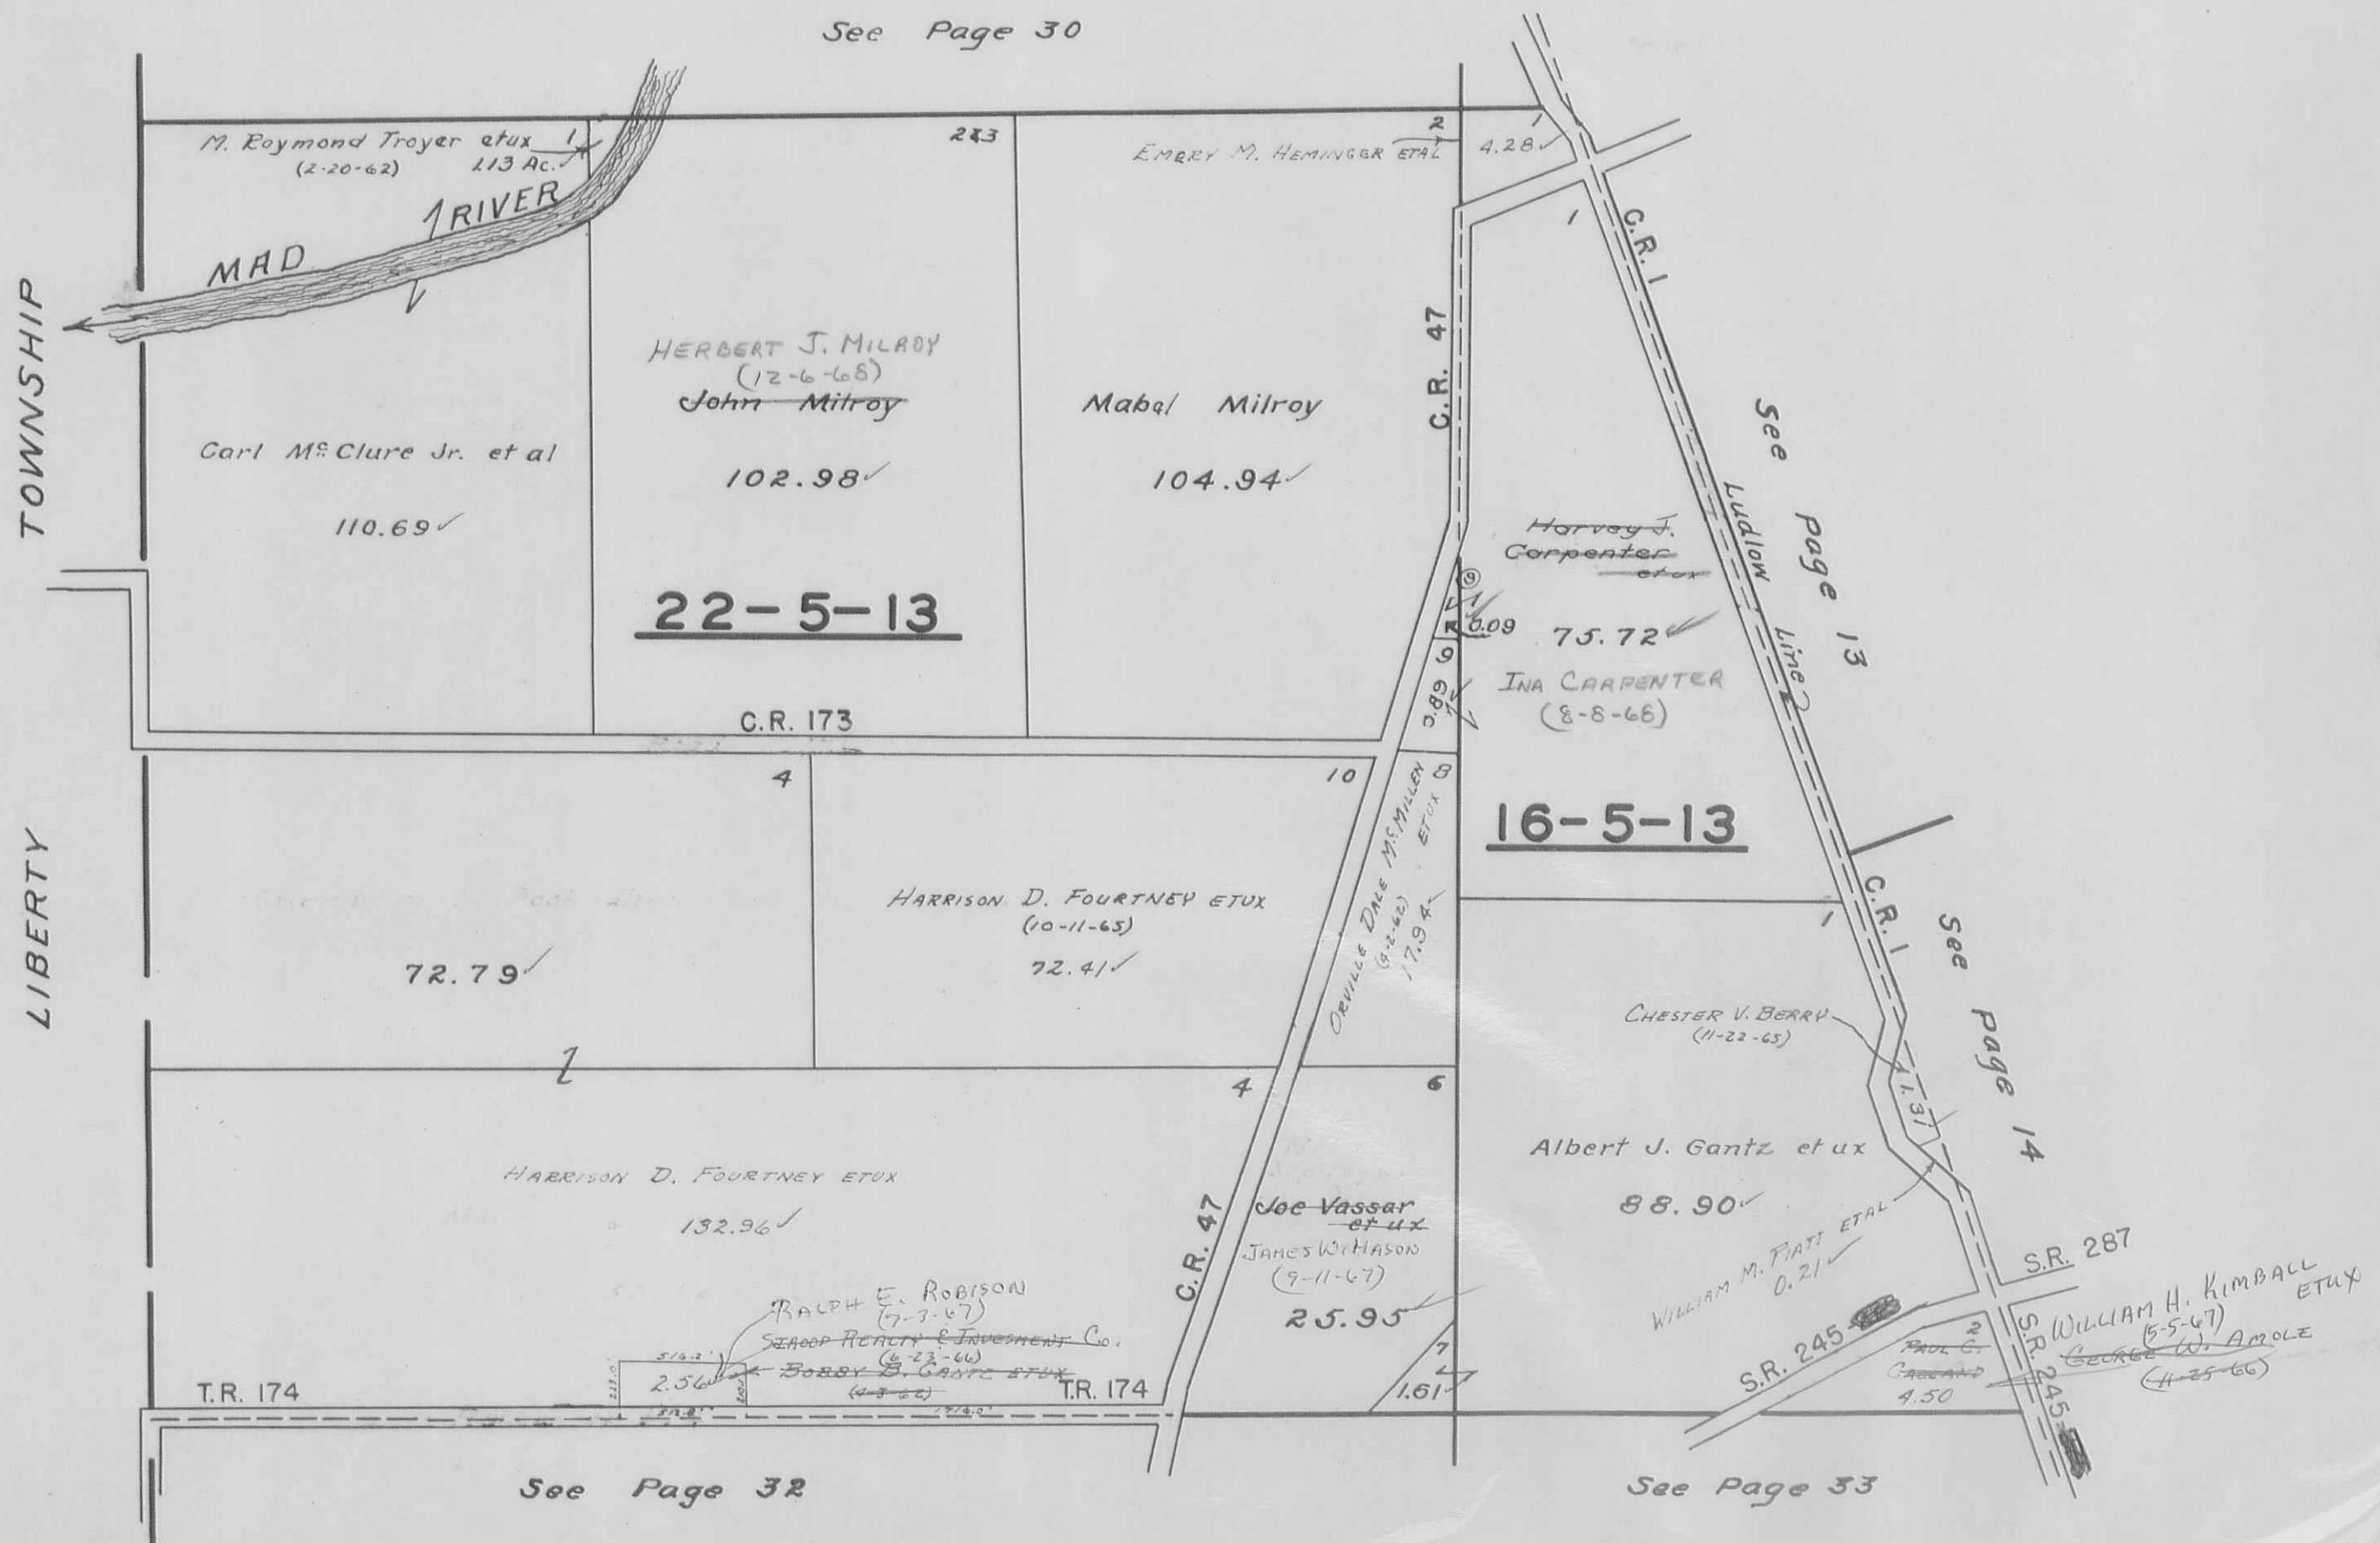

## MONROE TOWNSHIP

SEC. 15 &amp; 21 TOWN 5 RANGE 13

SCALE: 1" = 10 CHAINS = 660'

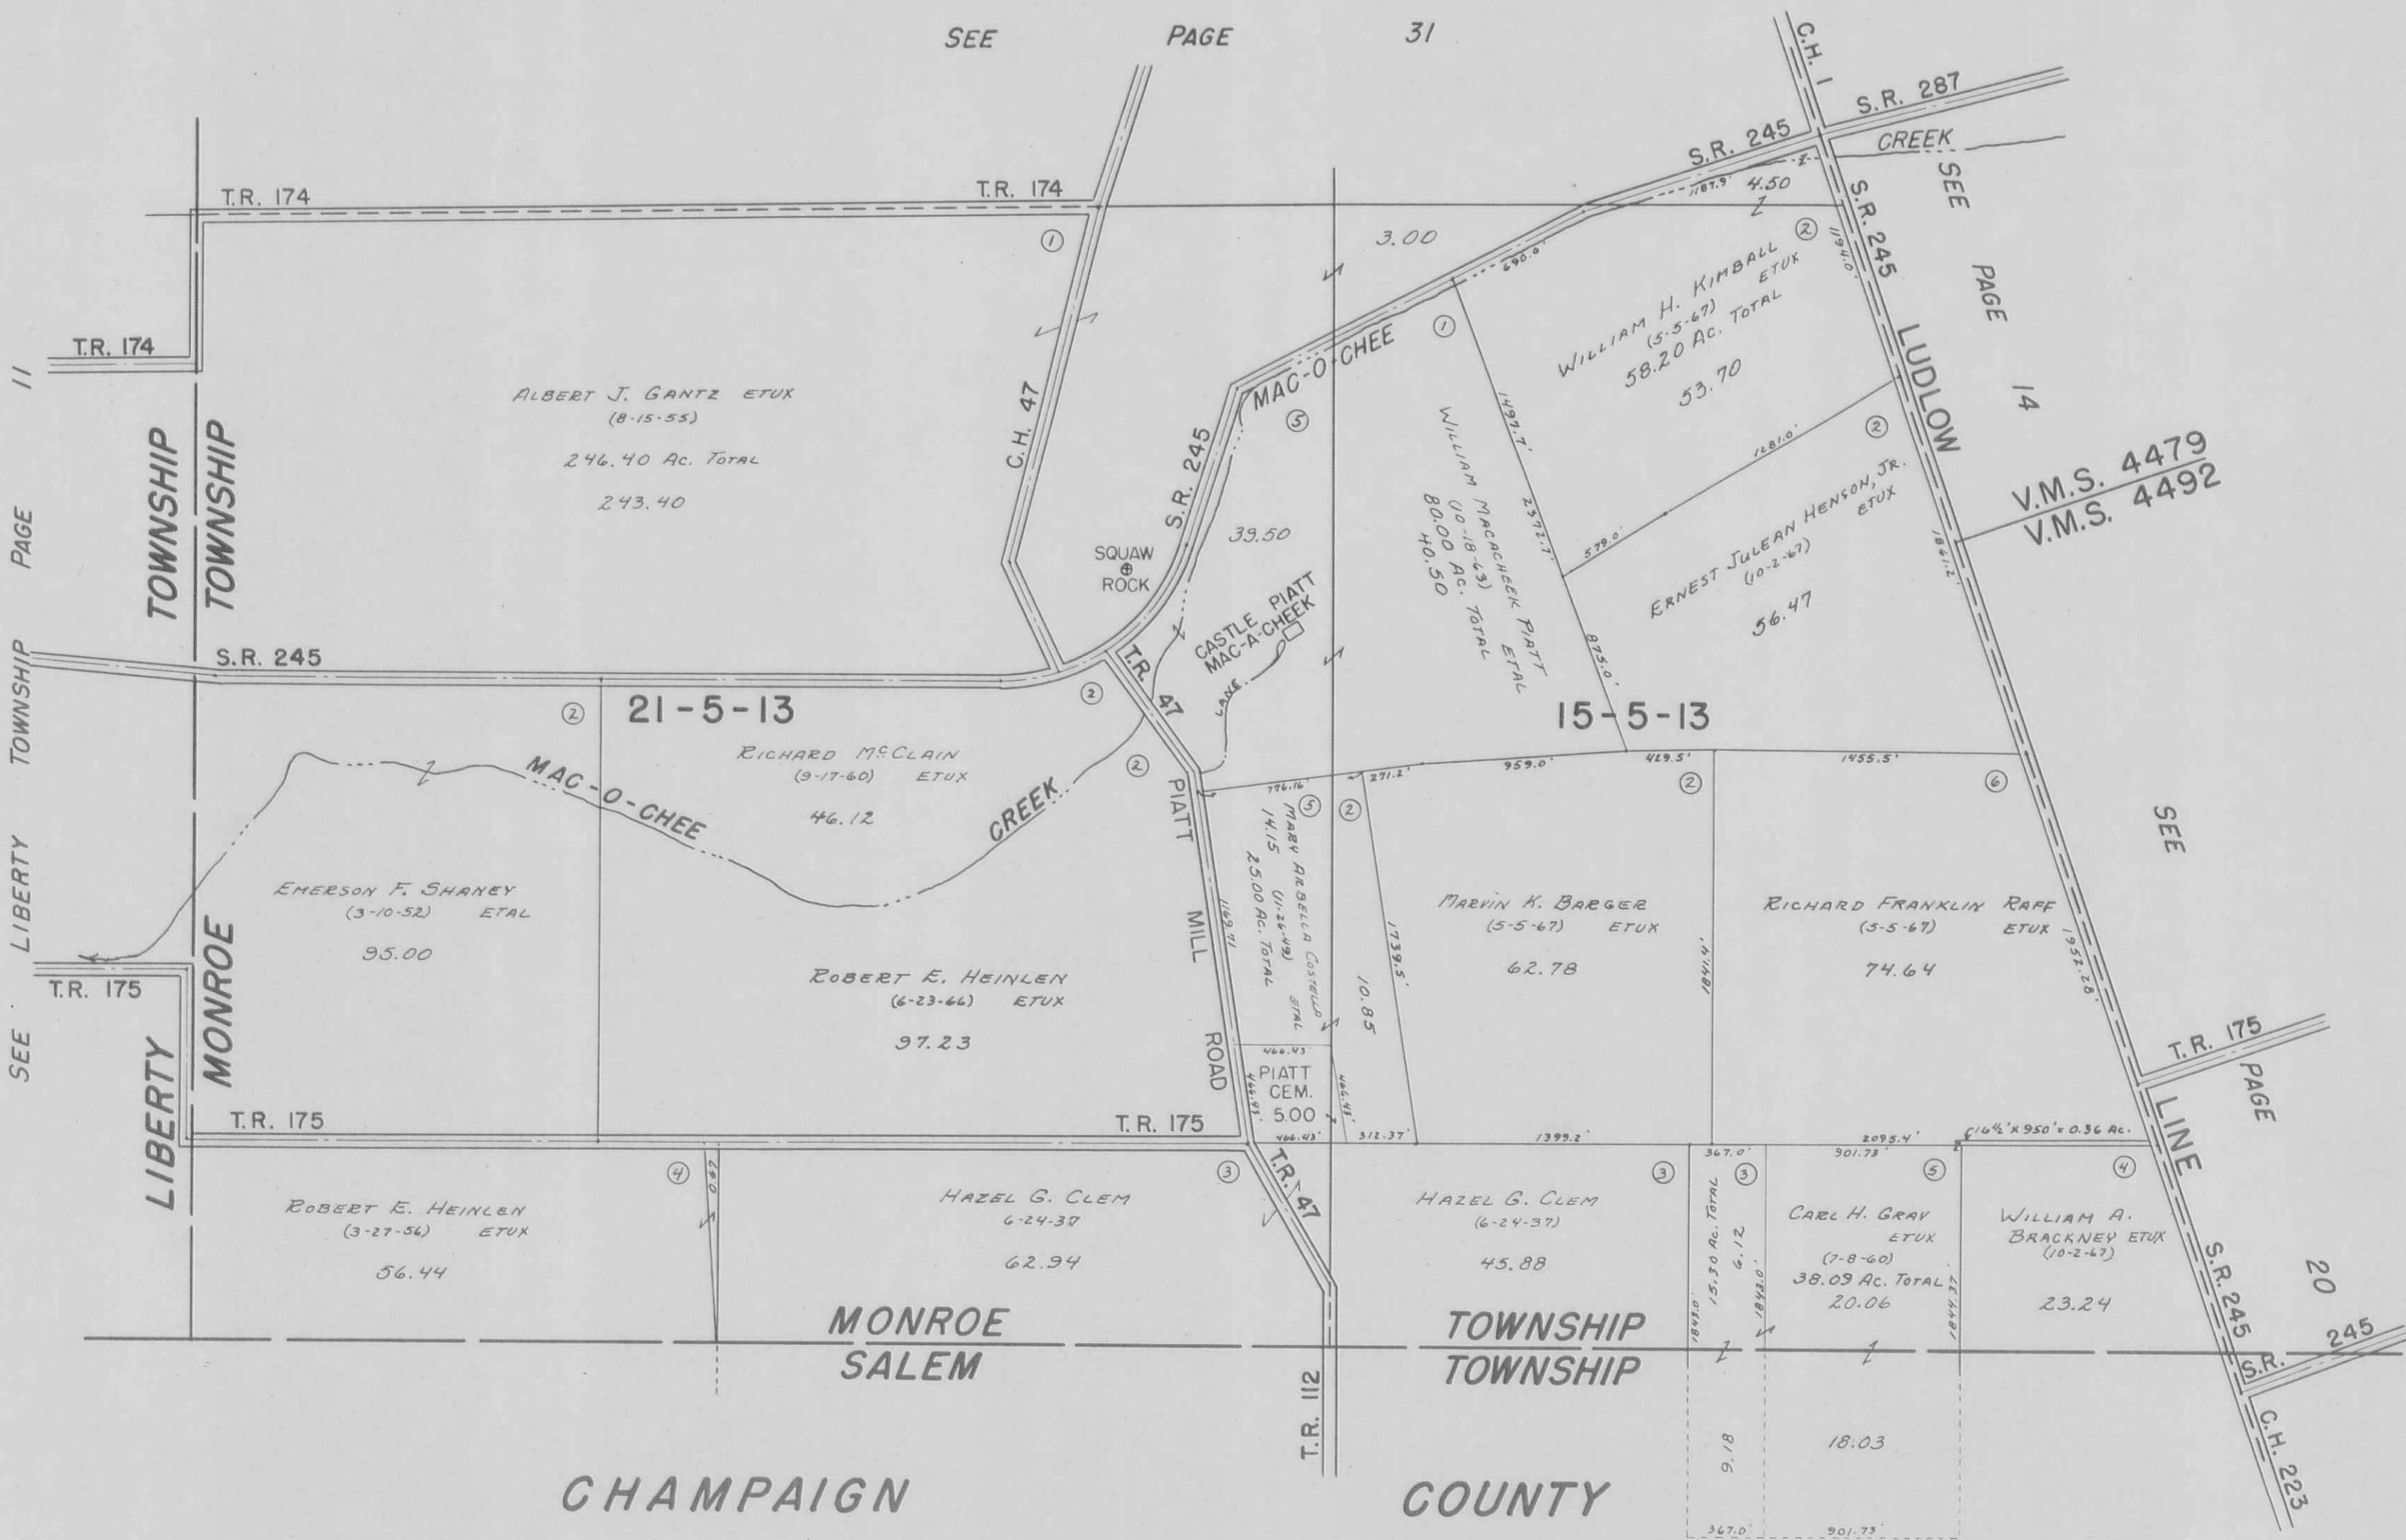


# MONROE TOWNSHIP PICKRELL TOWN

PAGE 33

SCALE 100 FEET TO THE INCH

322

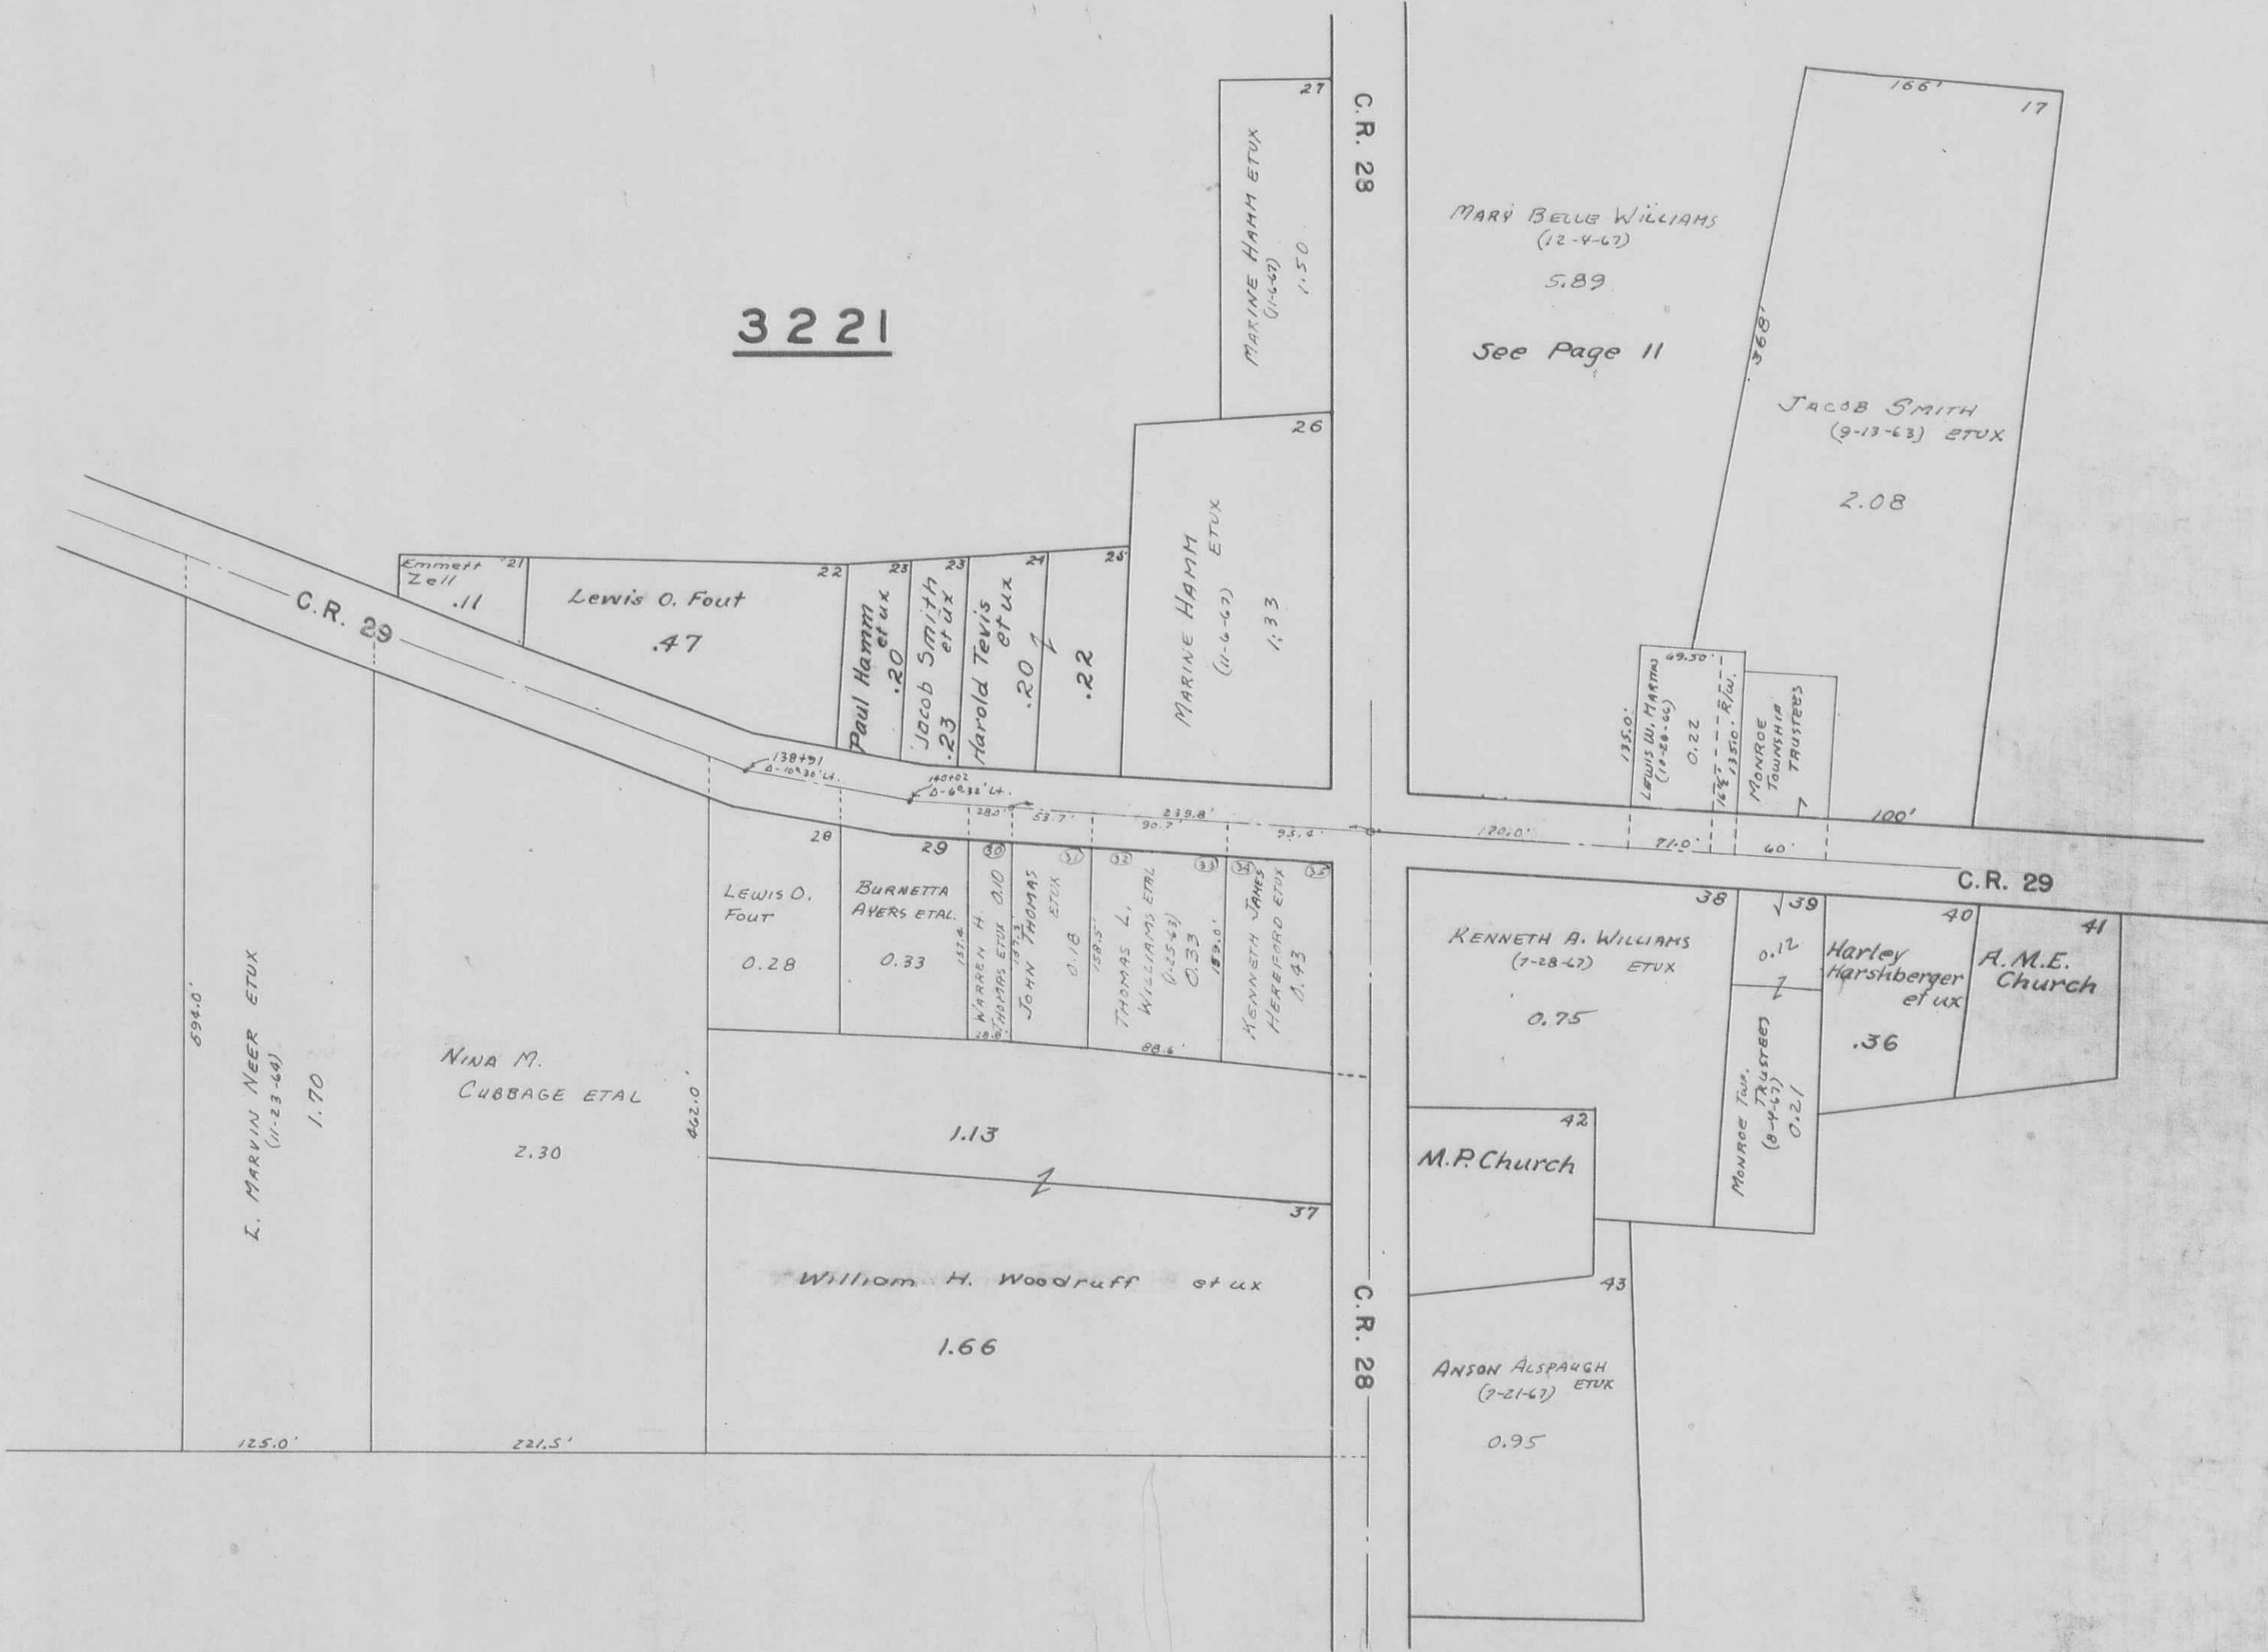

H.E.Dysert