

PERRY

TOWNSHIP

1988

PERRY TOWNSHIP

INDEX MAP

VIRGINIA MILITARY SURVEY

PAGE 0


CORRECTED TO

January 1, 1966

JANUARY 1, 1967

JANUARY 1, 1968

JANUARY 1, 1969

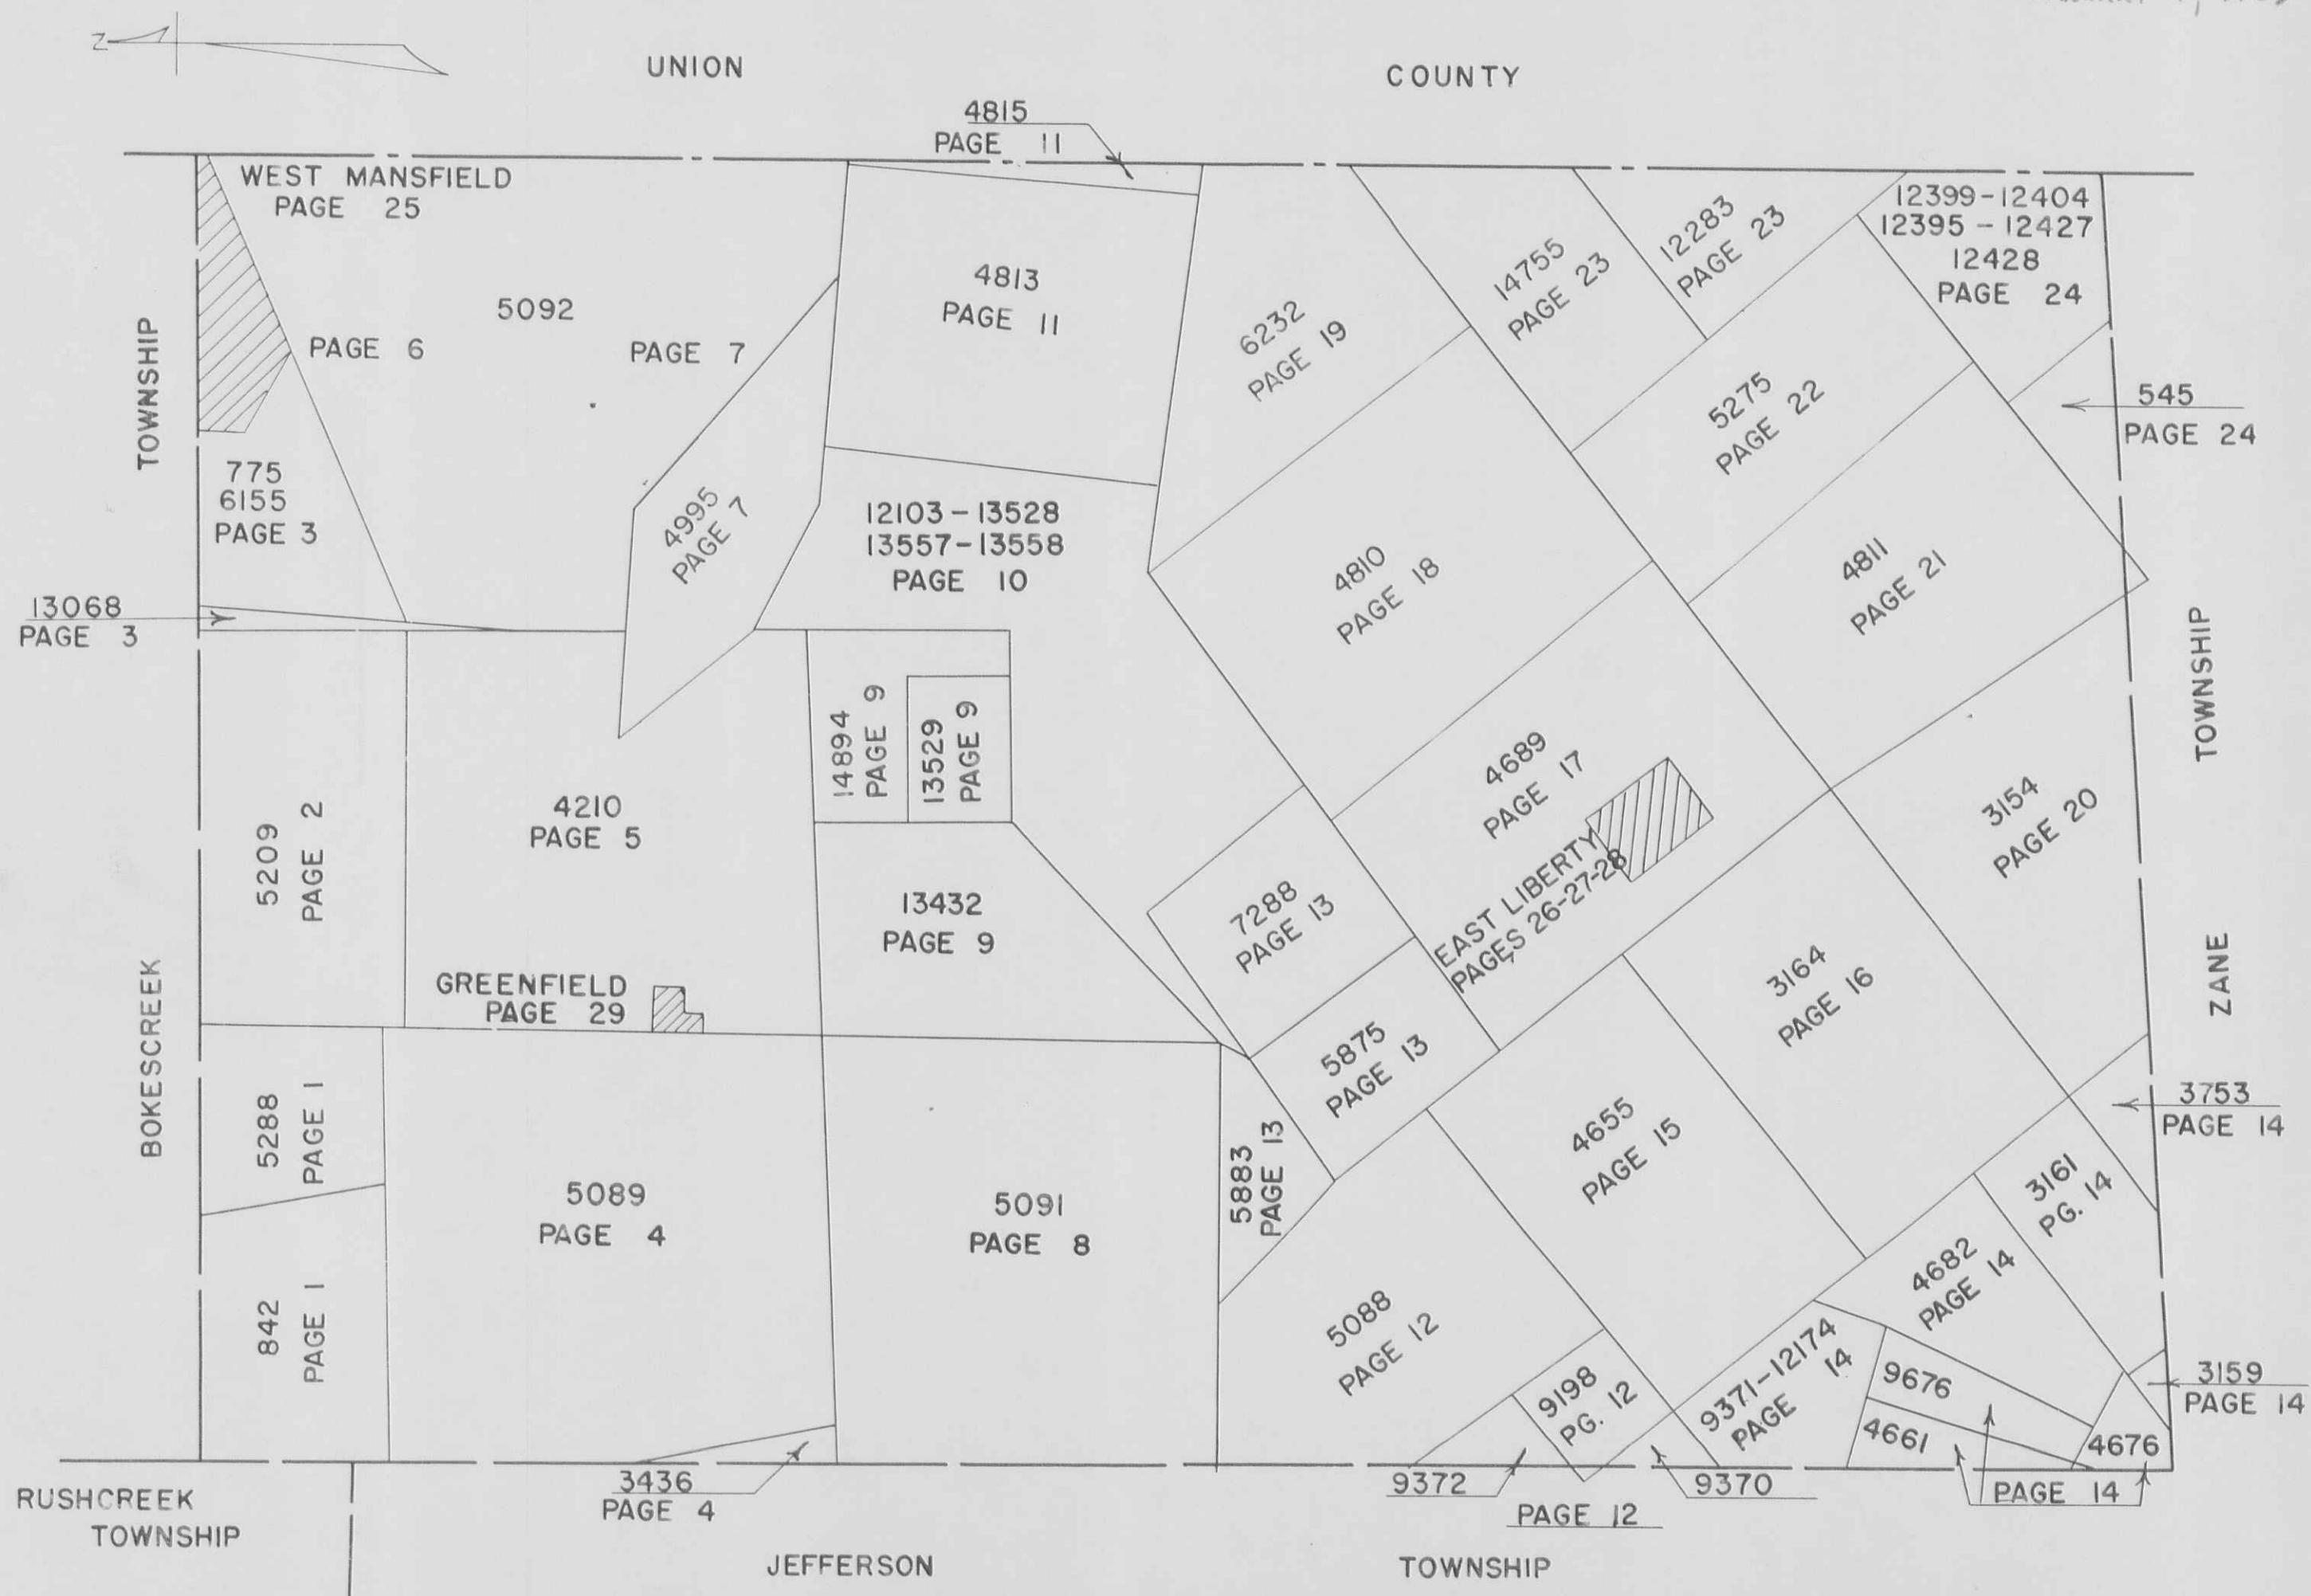

INDEX

VIRGINIA MILITARY SURVEYS

V.M.S.	PAGE	V.M.S.	PAGE	V.M.S.	PAGE
545	24	4815	11	9372	12
775	3	4995	7	9676	14
842	1	5088	12	12103	10
3154	20	5089	4	12174	14
3159	14	5091	8	12283	23
3161	14	5092 -North Part	6	12395	24
3164	16	5092 -South Part	7	12399	24
3436	4	5209	2	12404	24
3753	14	5275	22	12427	24
4210	5	5288	1	12428	24
4655	15	5875	13	13068	3
4661	14	5883	13	13432	9
4676	14	6155	3	13528	10
4682	14	6232	19	13529	9
4689	17	7288	13	13557	10
4810	18	9198	12	13558	10
4811	21	9370	12	14775	23
4813	11	9371	14	14894	9

VILLAGE OR TOWN PAGE

EAST LIBERTY-North East Part	26
EAST LIBERTY-North West Part	27
EAST LIBERTY-South Part	28
GREENFIELD LOTS	29
WEST MANSFIELD CORPORATION	25

PERRY

TOWNSHIP

PAGE 1


VIRGINIA

MILITARY SURVEYS

842
5288

SCALE 10 CHAINS TO THE INCH


BOKESCREEK TOWNSHIP

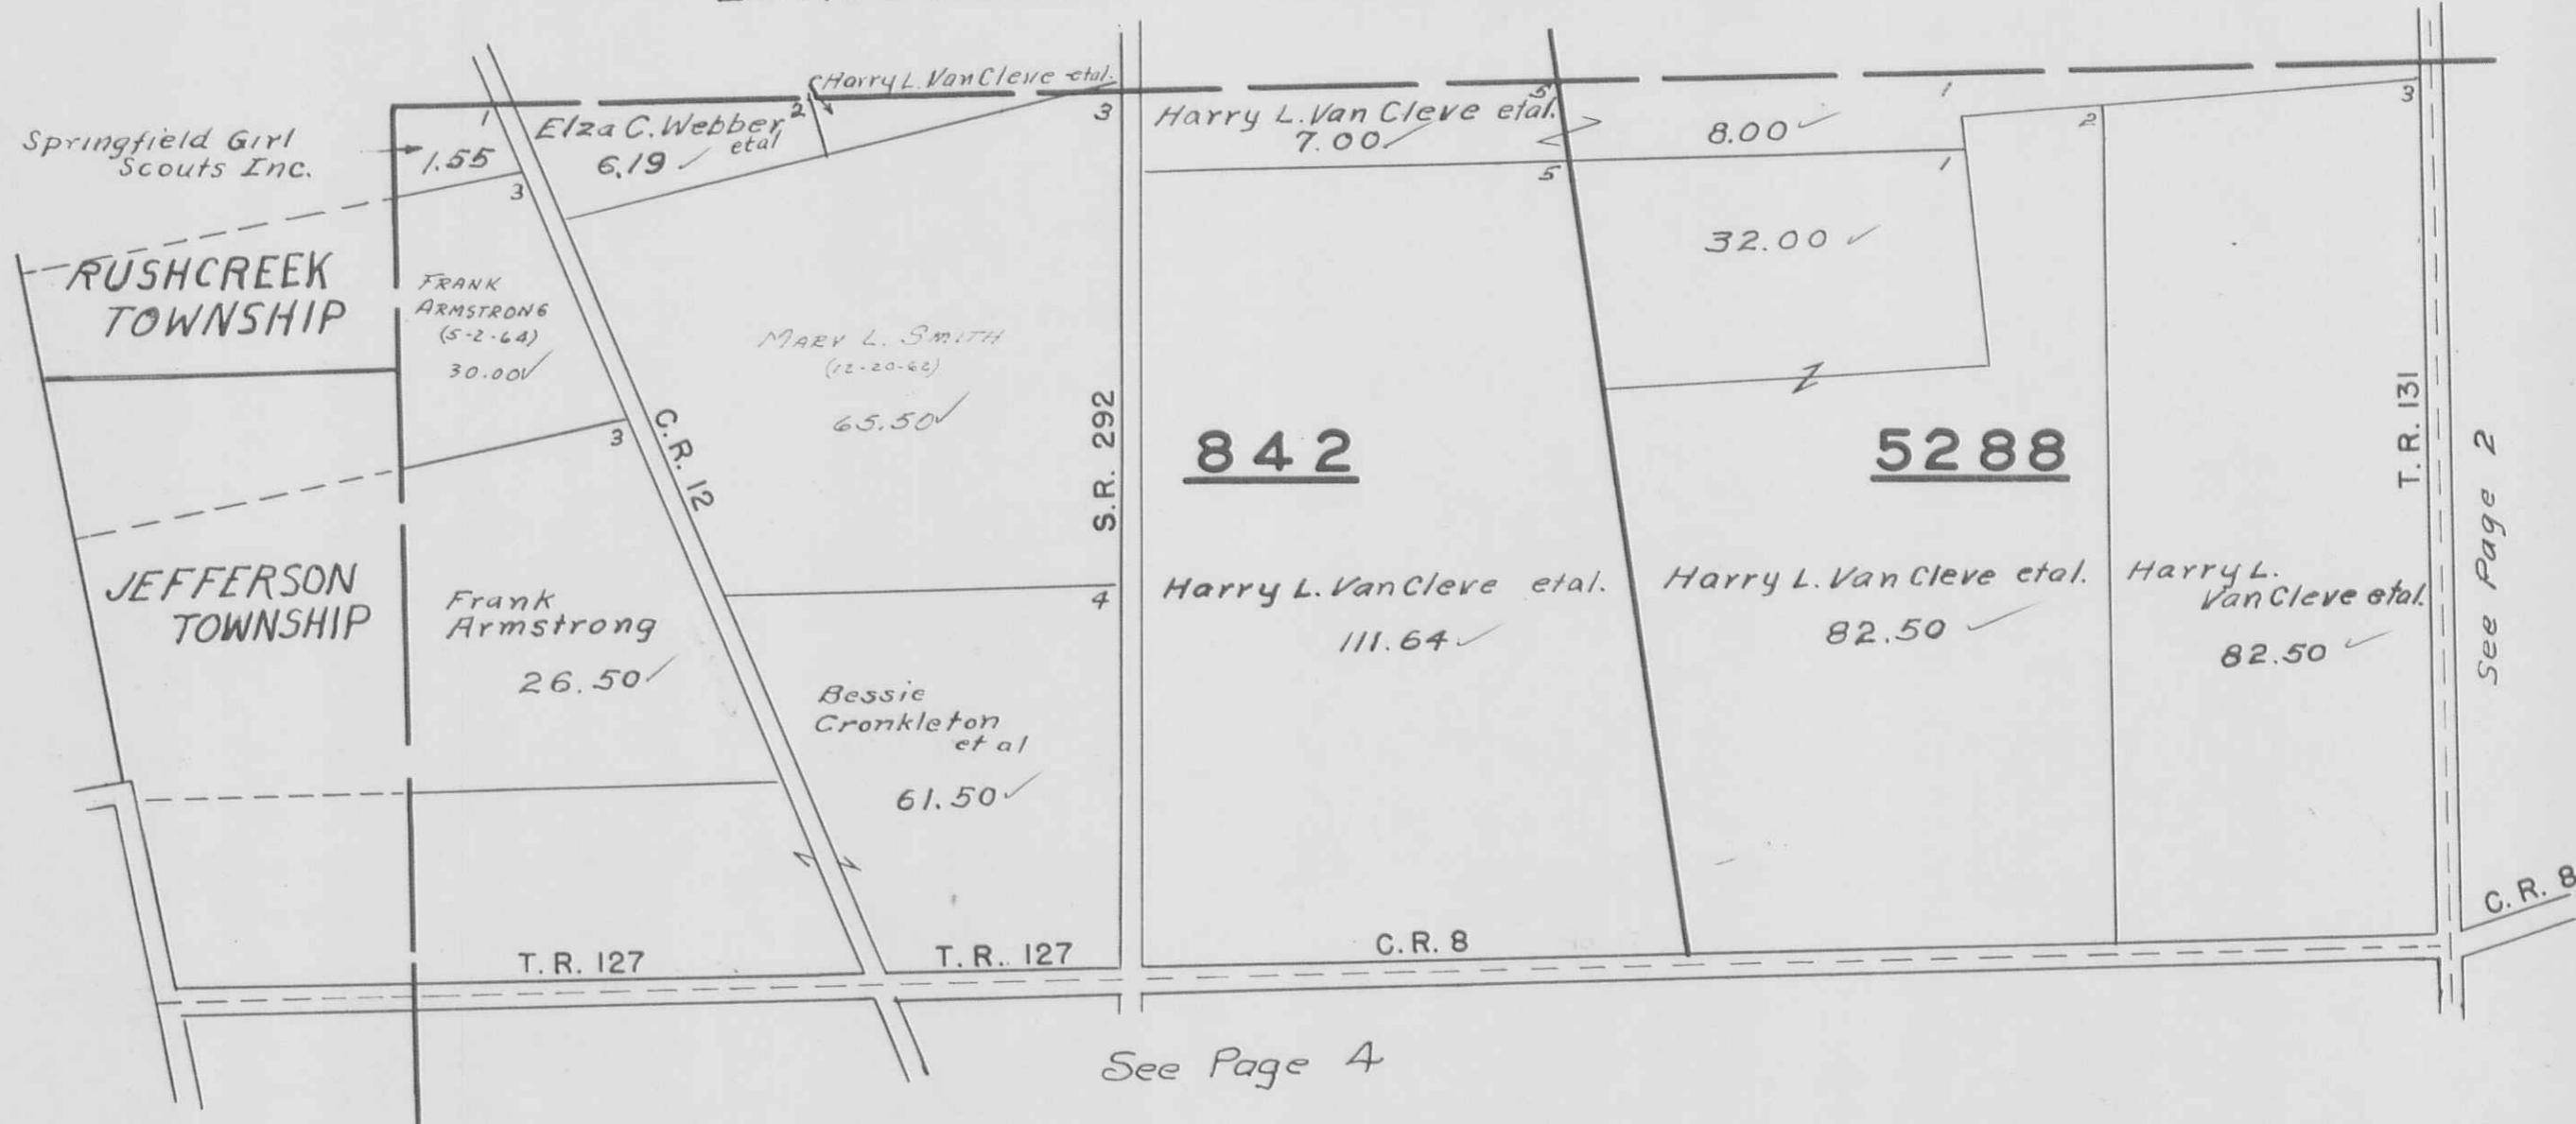

VIRGINIA MILITARY SURVEY 5209

SCALE 10 CHAINS TO THE INCH

BOKESCREEK TOWNSHIP

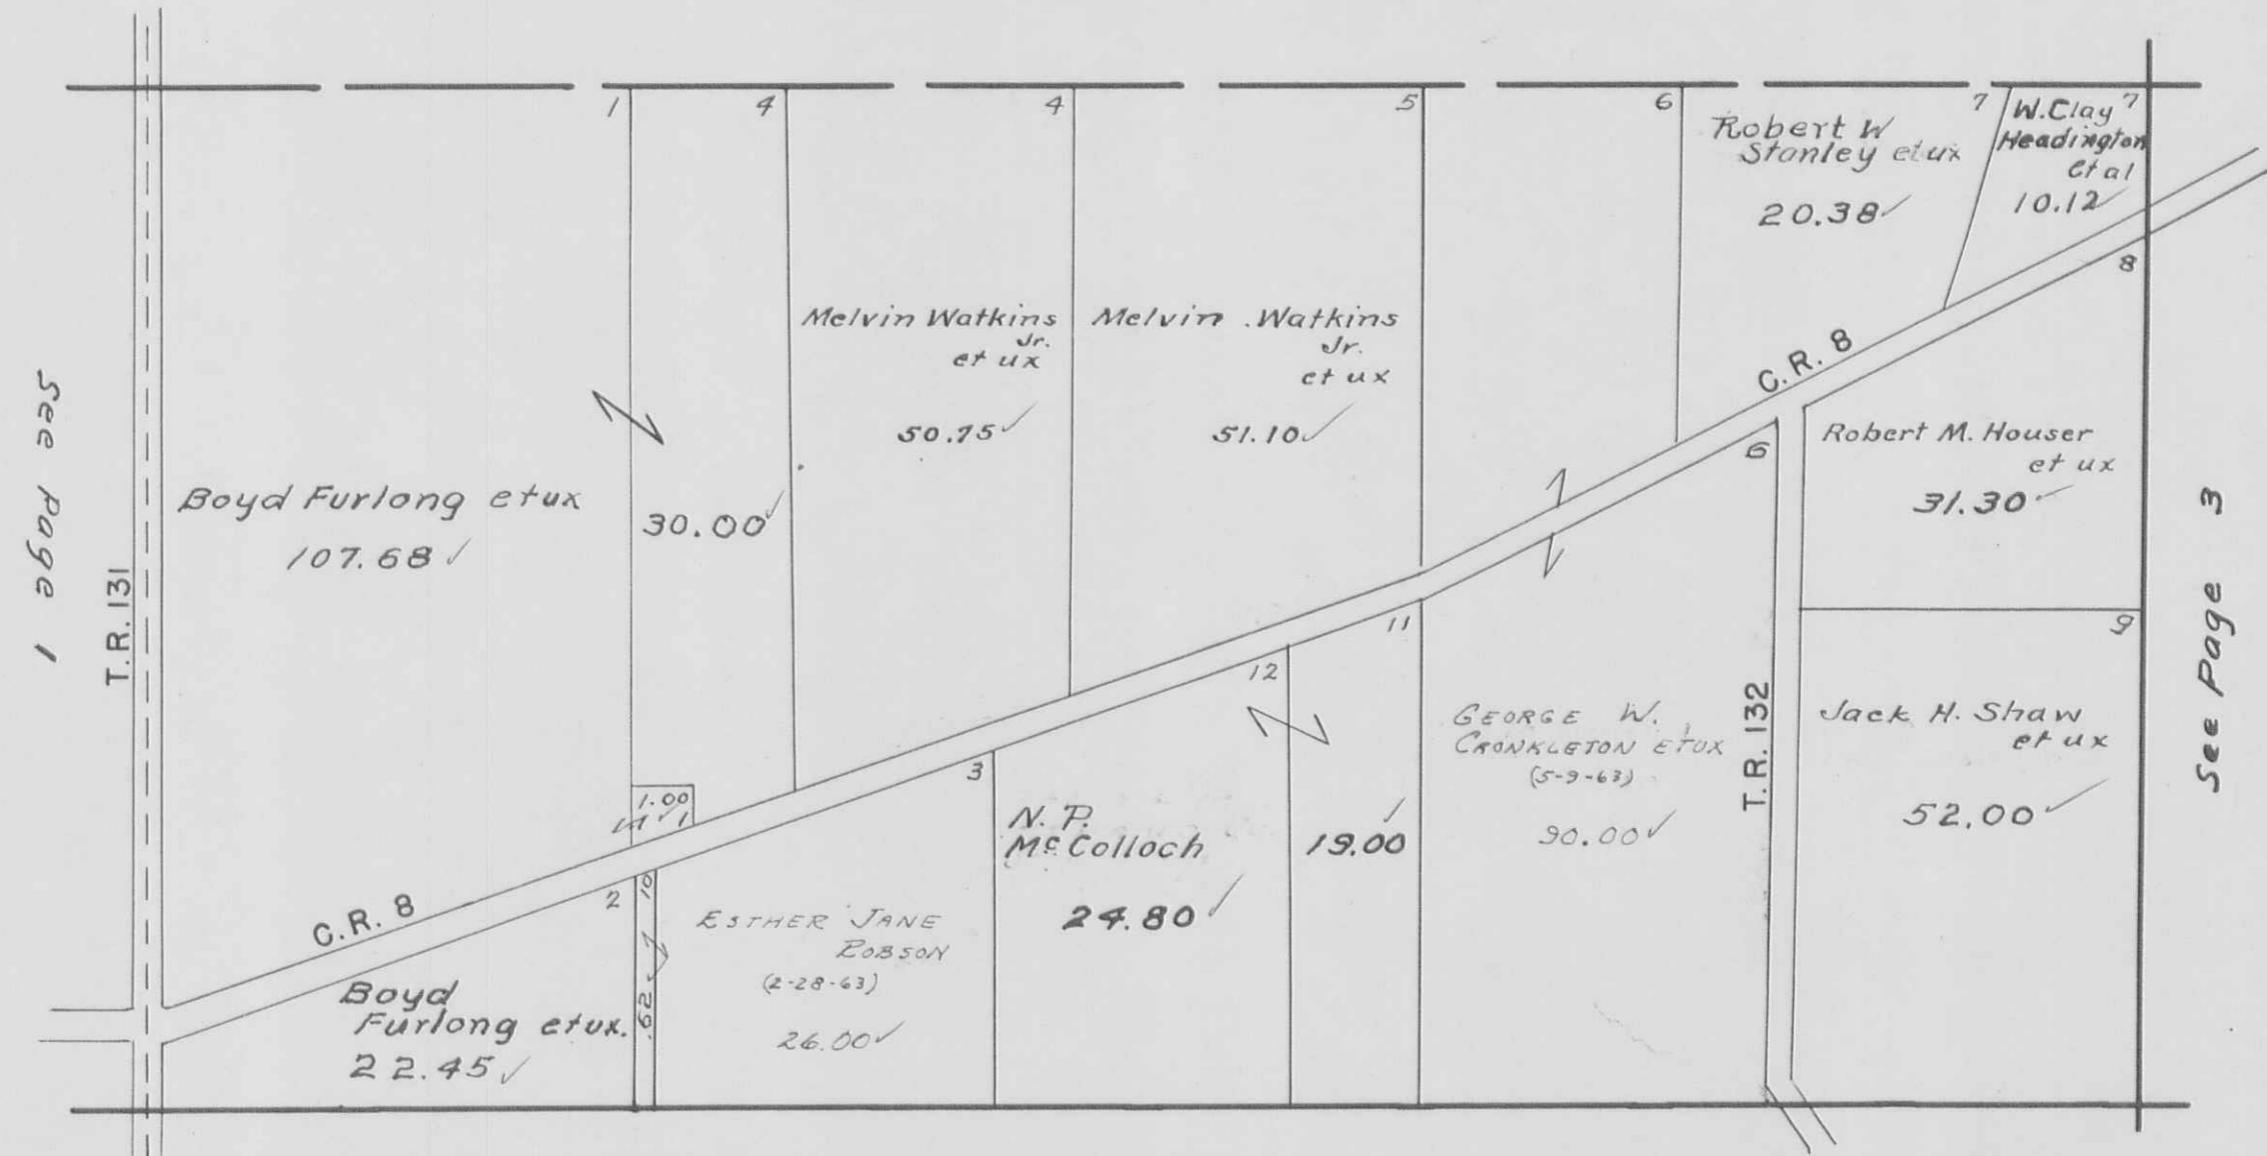

PERRY

TOWNSHIP

VIRGINIA

MILITARY SURVEYS


PAGE

3

{ 775
6155
13068

SCALE 10 CHAINS TO THE INCH

BOKESCREEK TOWNSHIP

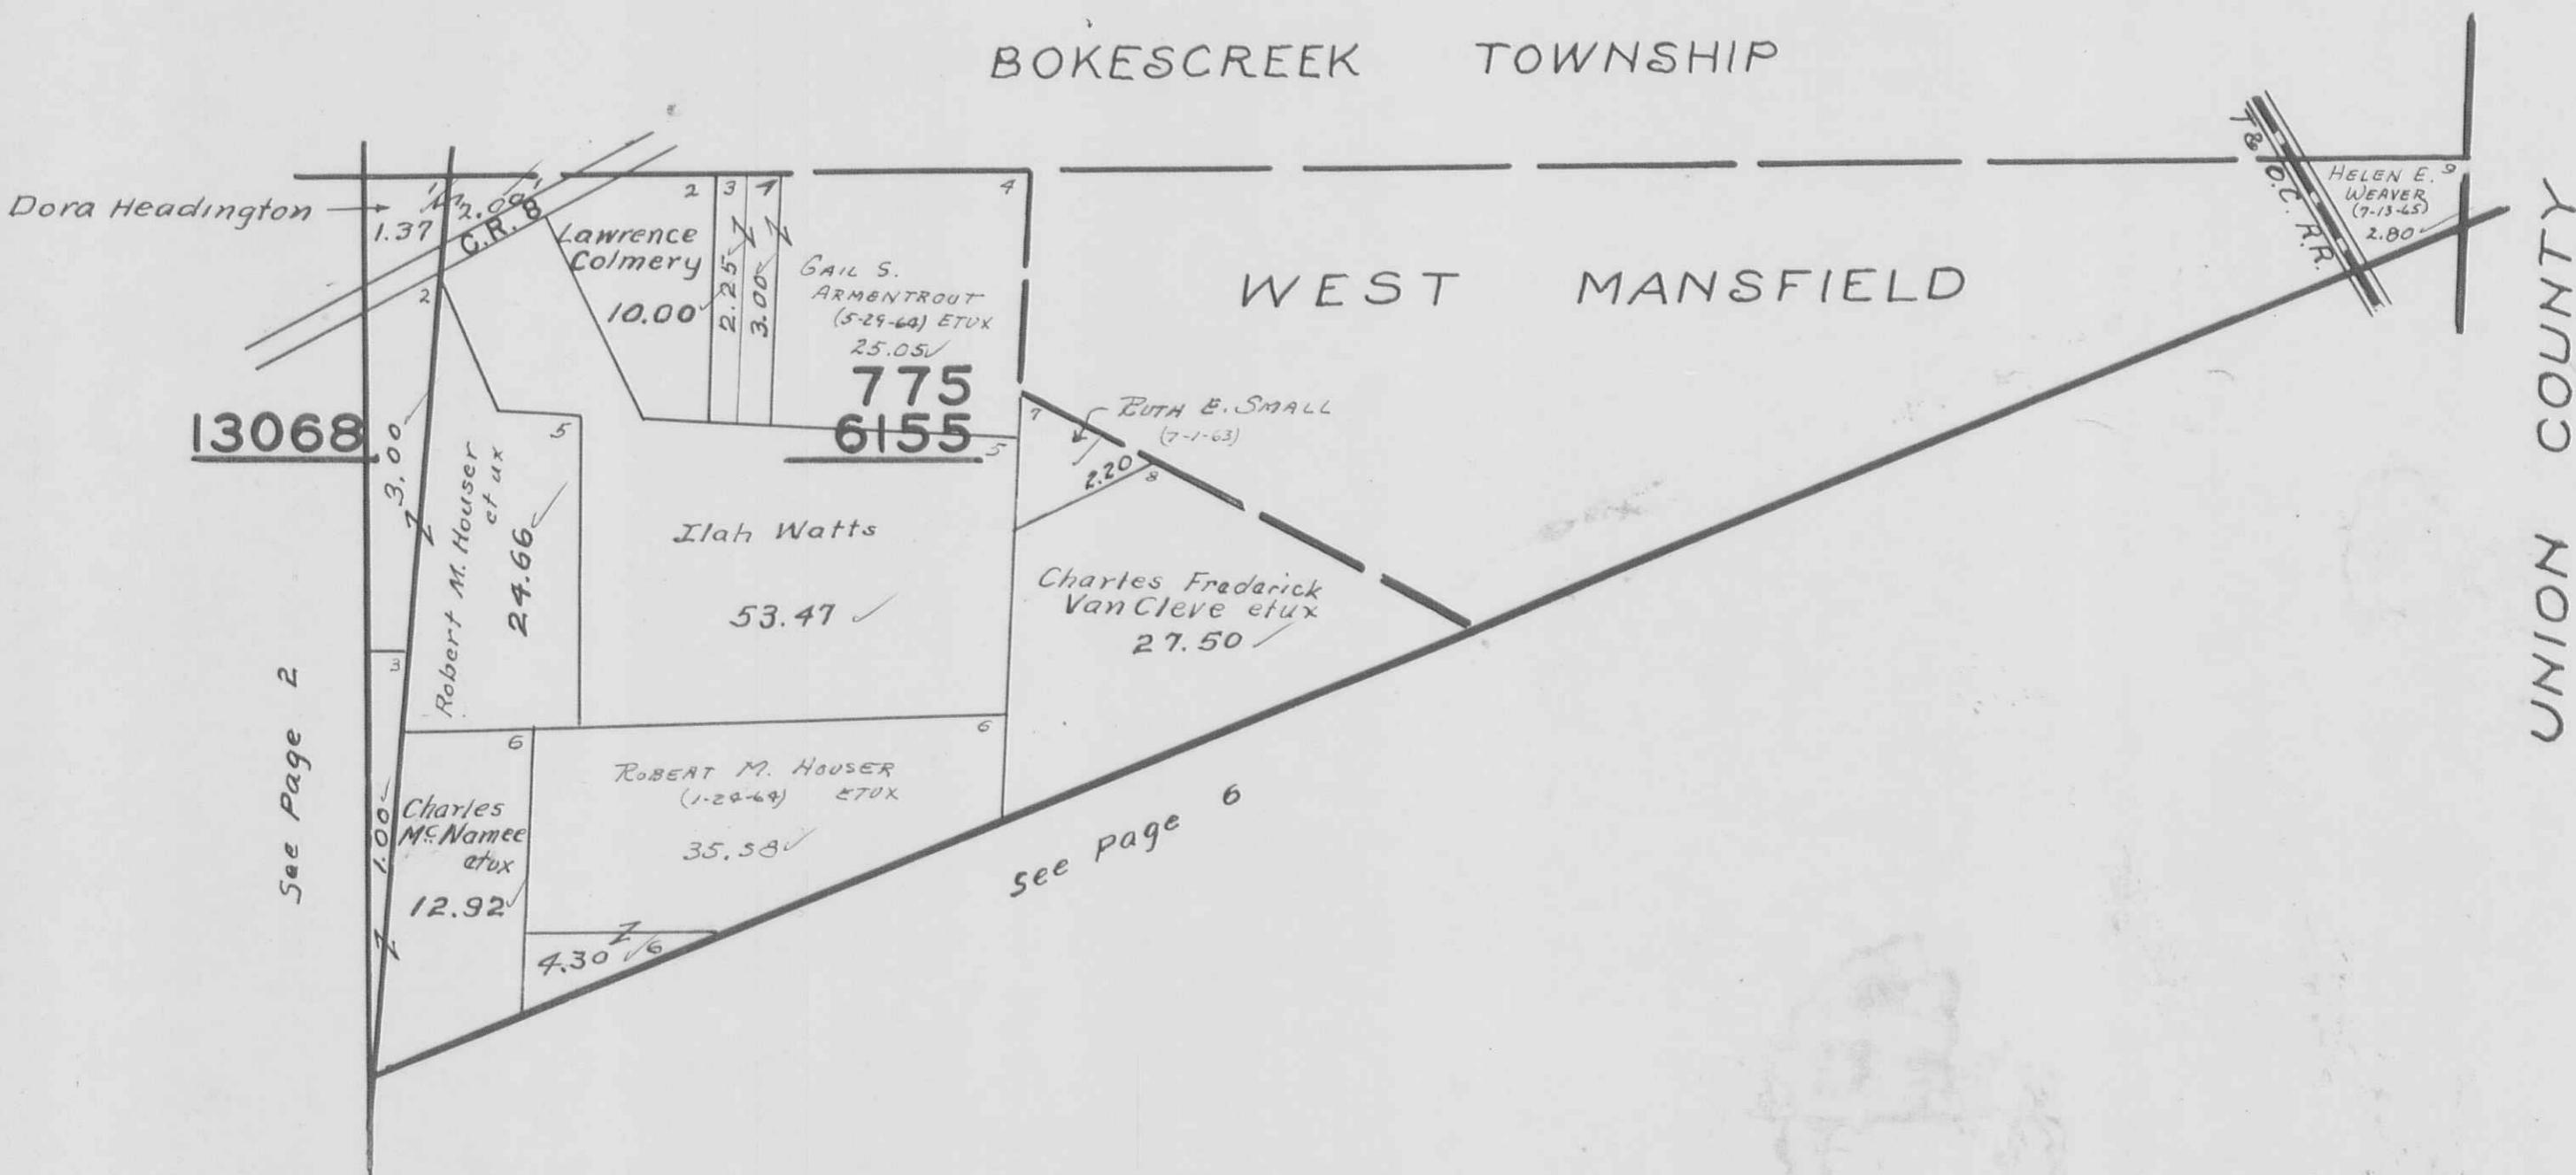

PERRY

TOWNSHIP

PAGE 4

VIRGINIA

MILITARY SURVEYS

3436.
5089

see

Page 1
T.R. 127

SCALE

10 CHAINS TO THE INCH

G.R. 8

T.R. 131



PERRY

TOWNSHIP

PAGE

5

VIRGINIA MILITARY SURVEYS 4210
4995

SCALE 10 CHAINS TO THE INCH

See Page 2



PERRY

TOWNSHIP

PAGE

6

VIRGINIA MILITARY SURVEY N.PART 5092

SCALE 10 CHAINS TO THE INCH



PERRY

TOWNSHIP

PAGE

7

VIRGINIA

MILITARY

SURVEYS

4995
S.PART 5092

SCALE 10 CHAINS TO THE INCH

UNION COUNTY



PERRY

TOWNSHIP


PAGE

8

VIRGINIA MILITARY SURVEY 5091

SCALE 10 CHAINS TO THE INCH

See Page 4

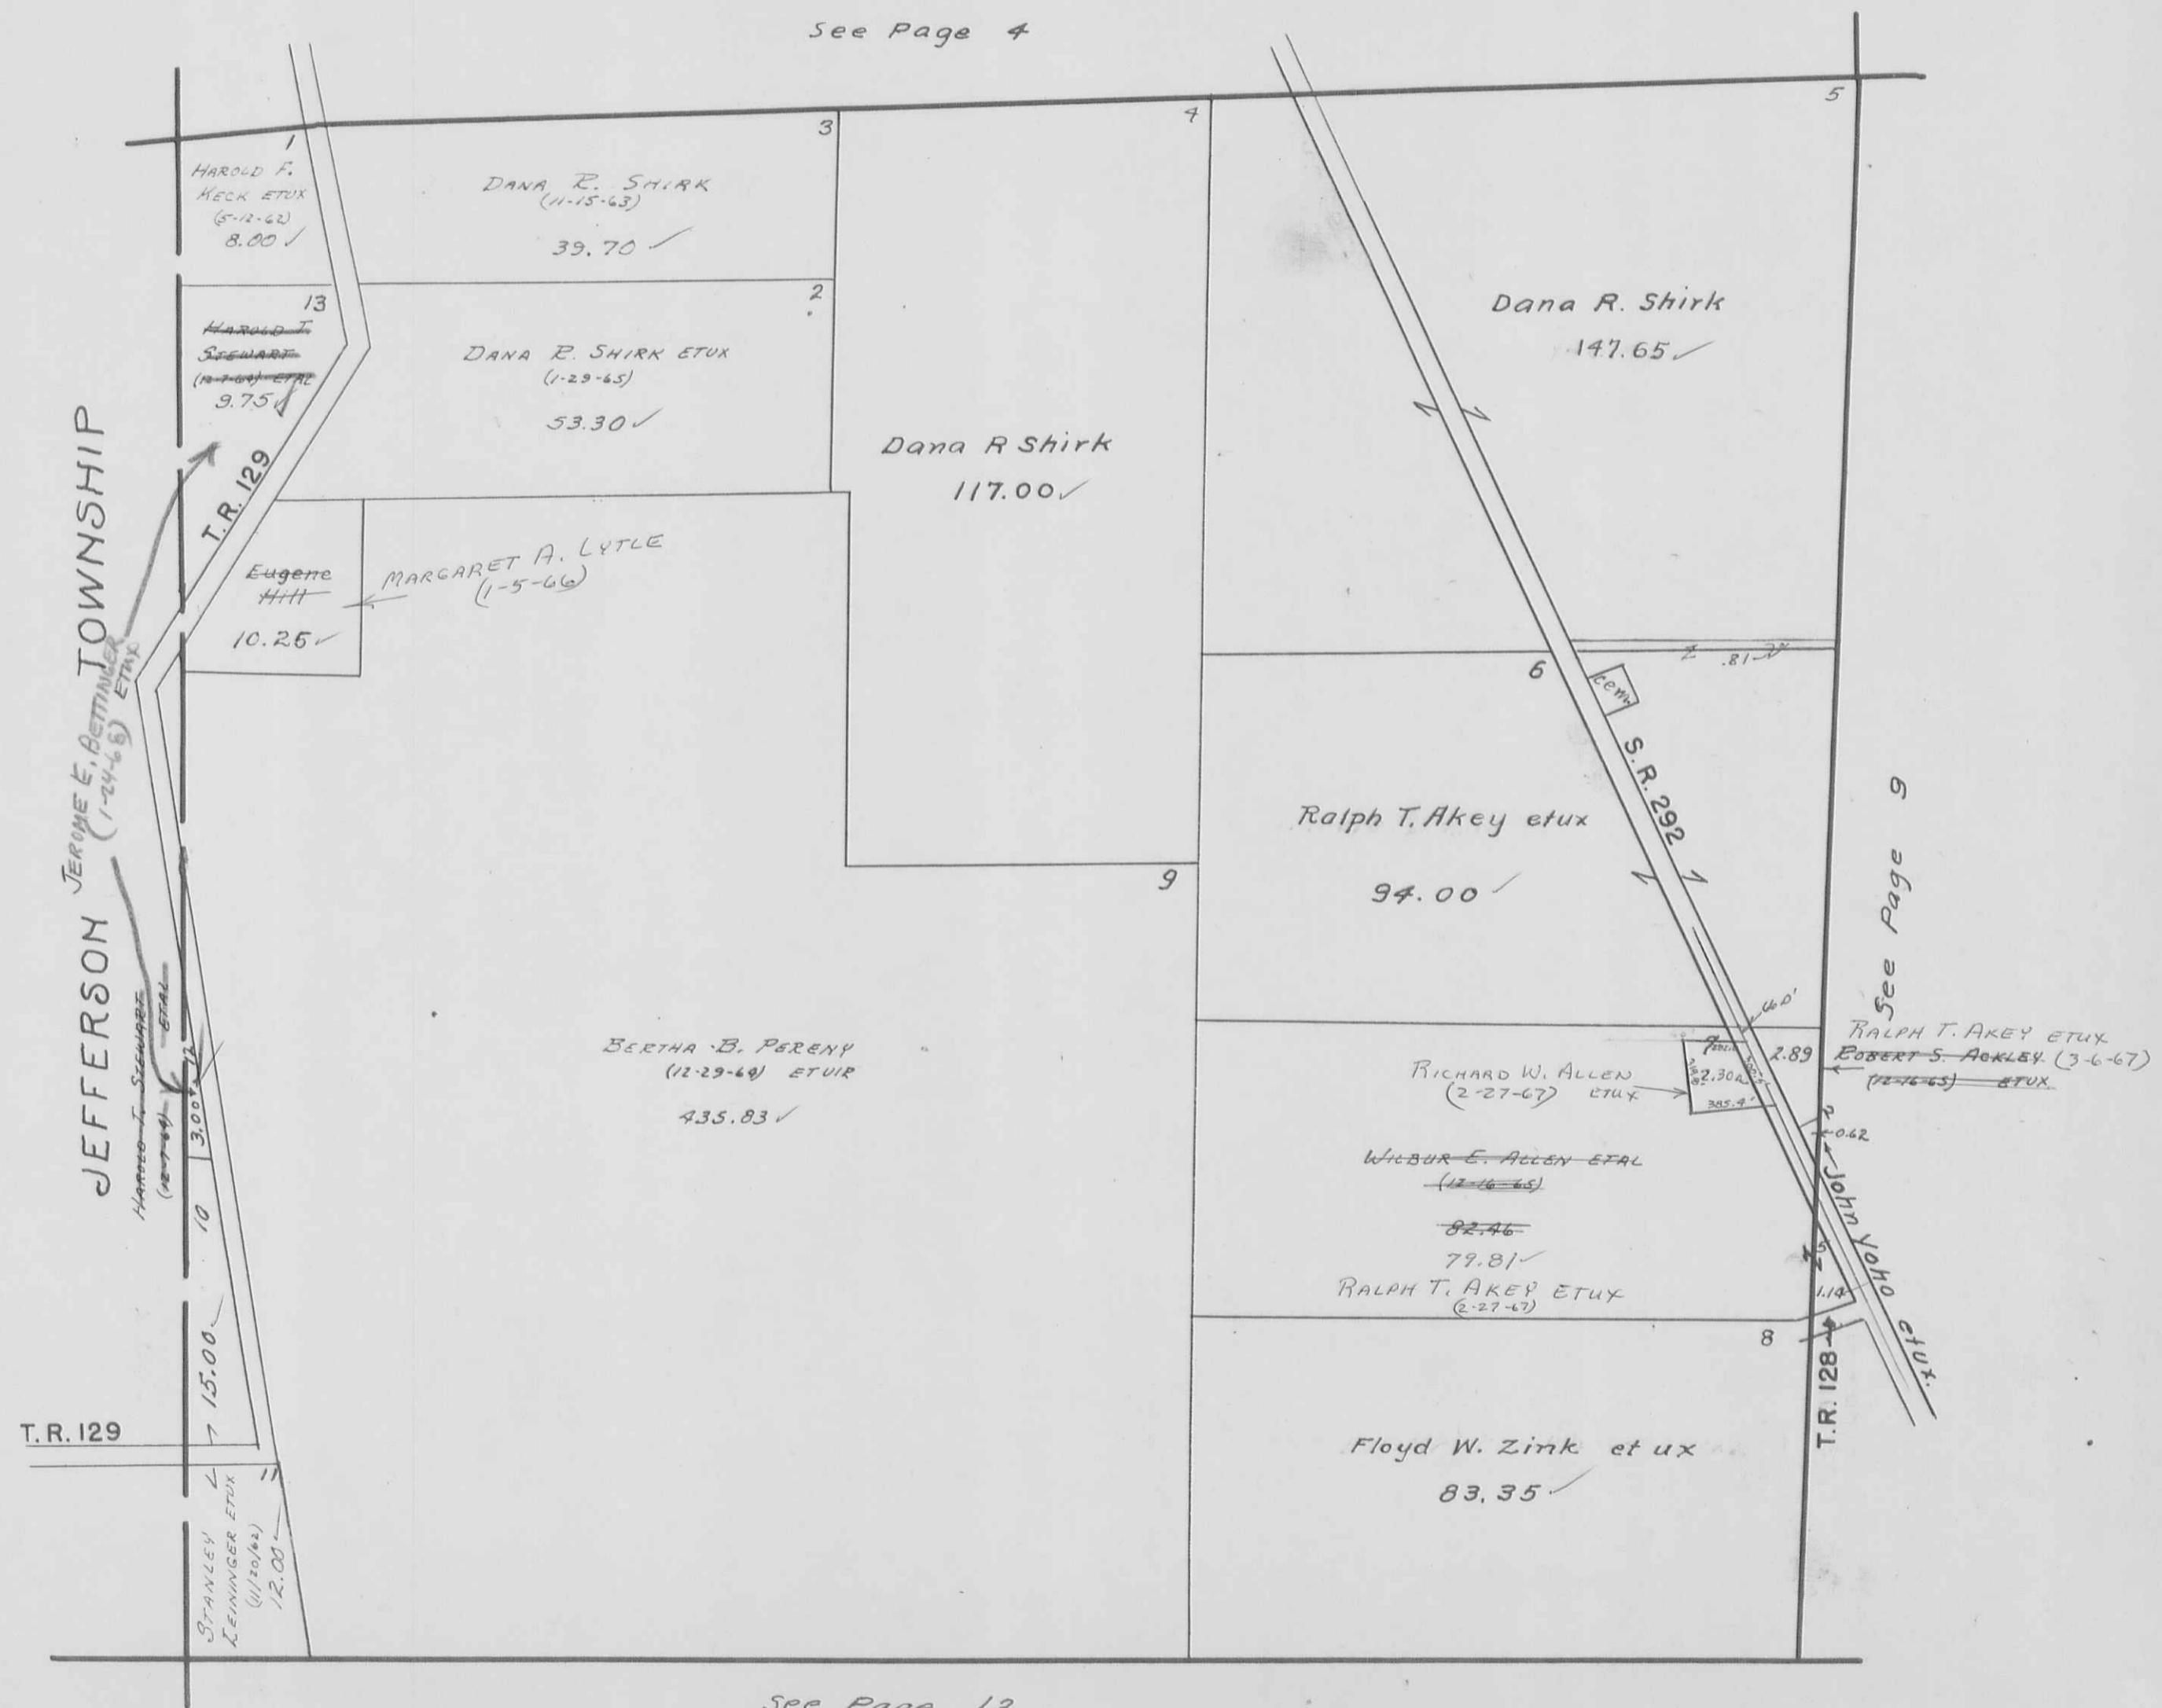

PERRY TOWNSHIP
VIRGINIA MILITARY SURVEYS
SCALE 10 CHAINS TO THE INCH

PAGE

9

13432
13529
14894

See Page 5

Ralph T. Akey etux
102.17 ✓

13432

Ralph T. Akey etux
102.17 ✓

14894

WILSON B. EVANS
(3-24-64) ETAL
73.00 ✓

33.20 ✓

Raymond L. Harris
35.15 ✓

13529


John Yoho etux.
57.50 ✓

EUG. BURTON
STANLEY ETUX
(6-2-64)

52.10 ✓ 22.17 ✓

See Page 8

See Page 10

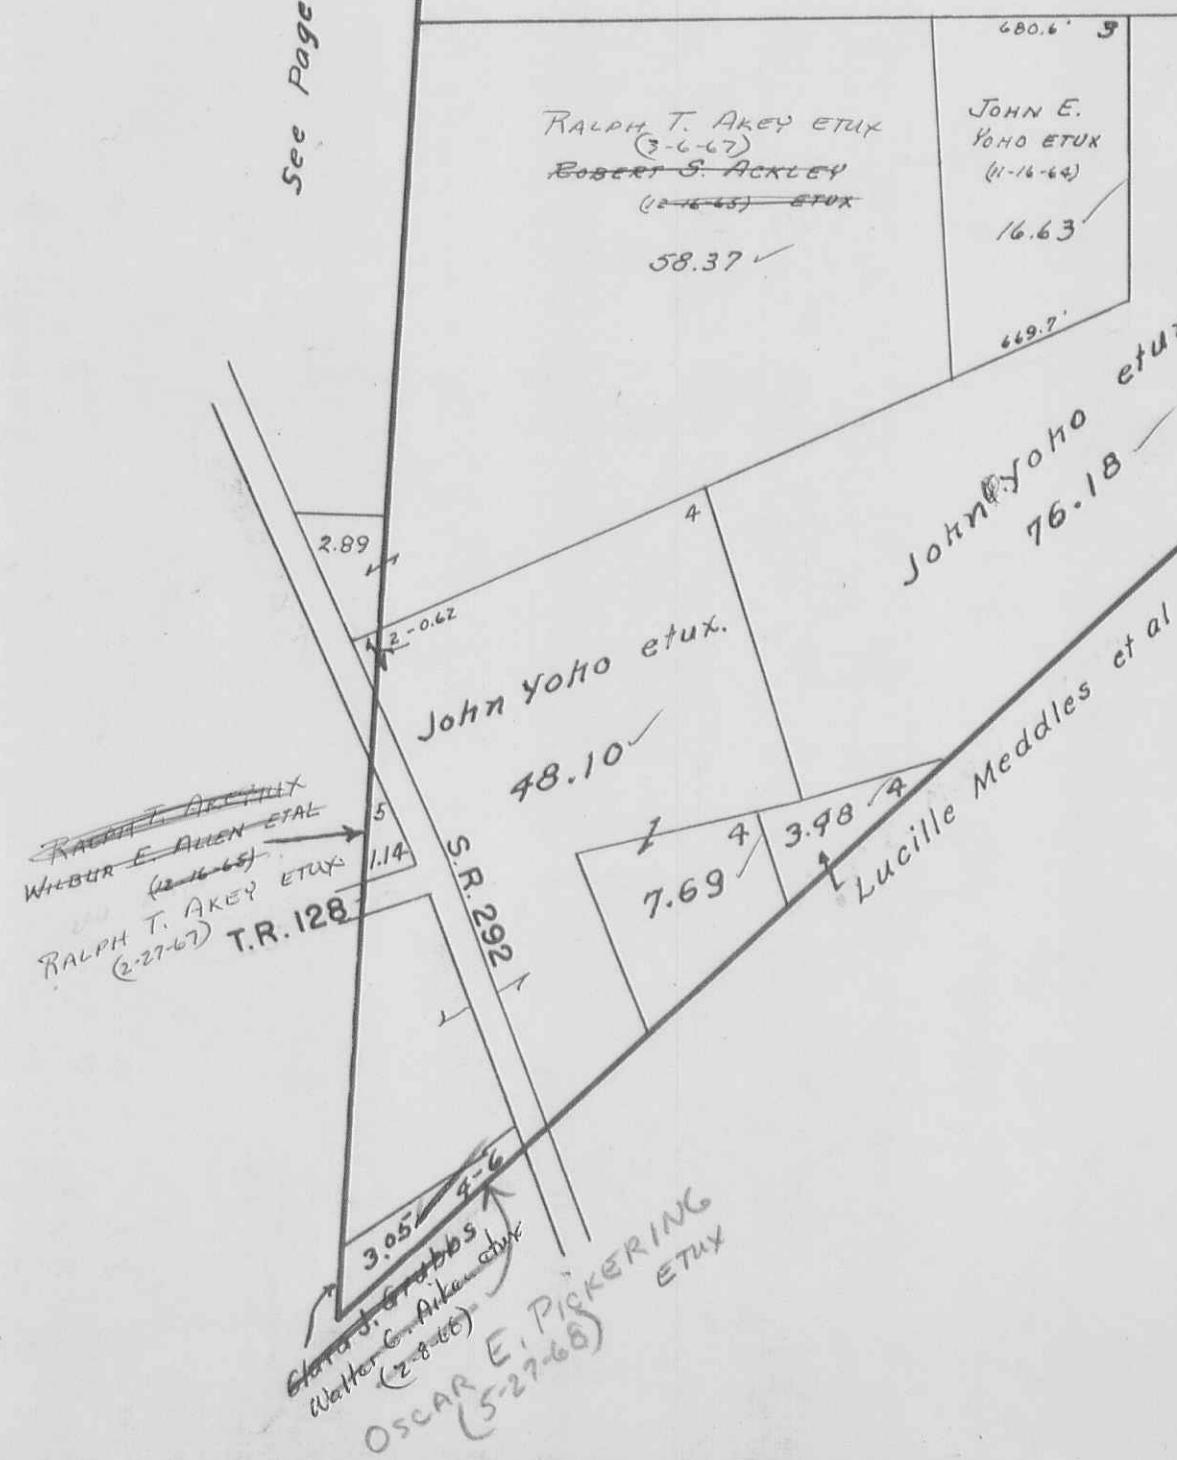

PERRY

TOWNSHIP

VIRGINIA

MILITARY SURVEYS

PAGE

10

SCALE 10 CHAINS TO THE INCH

12103
13528
13557
13558

See Page 13
Herman W. Lautenbach et ux
(6-19-68)
John Yoho et ux
4.71
2.70 ✓
S.R. 292

Lucille Meddles et al
26.00 ✓
16.75 ✓
24.00 ✓
ROBERT G.
PAULLEY ETUX
(3-29-62)
39.23 ✓
Lula Harshfield
19.35 ✓
Lula Harshfield
25.00 ✓
Lula Harshfield
xx. 30 ✓
See Page 16

Chas. H. Painter
96.14 ✓

Lucille Meddles et al
47.21 ✓
John Yoho et ux
19.41 ✓
William Riegel Shoemaker
(5-1-68)
Robert Bates et ux
44.30 ✓
36.00 ✓
T.R. 141
See Page 16

Lawrence V.
Abbott et ux
11

Roe Burton
Stanley ETUX
(6-2-68)
95.00 ✓

Ruth Inspree
25.50 ✓

See Page 9

Raymond L. Harris
89.01 ✓

RICHARD D. HARSHFIELD ETUX
Gecit W. Mortimer et ux
63.39 ✓

ESTHER GUTHERY SMART
(8-18-62)
100.00 ✓

See Page 11

See Page 7

PERRY TOWNSHIP
VIRGINIA MILITARY SURVEYS 4813
4815

SCALE 10 CHAINS TO THE INCH

PAGE 11

See Page 7

C.R. 2



See Page 10

See Page 19

PERRY

TOWNSHIP

PAGE

12

VIRGINIA

MILITARY SURVEYS

SCALE 10 CHAINS TO THE INCH

5088
9198
9370
9372



PERRY TOWNSHIP

V.M.S. 5088, 9198 & 9372

SCALE: 1" = 10 CHAINS = 660'



PERRY TOWNSHIP
 VIRGINIA MILITARY SURVEYS

SCALE 10 CHAINS TO THE INCH


5883
 5875
 7288

PAGE 13



PERRY TOWNSHIP
VIRGINIA MILITARY SURVEYS
SCALE 10 CHAINS TO THE INCH


PAGE	14	
3159	4661	9676
3161	4676	12174
3753	9371	4682

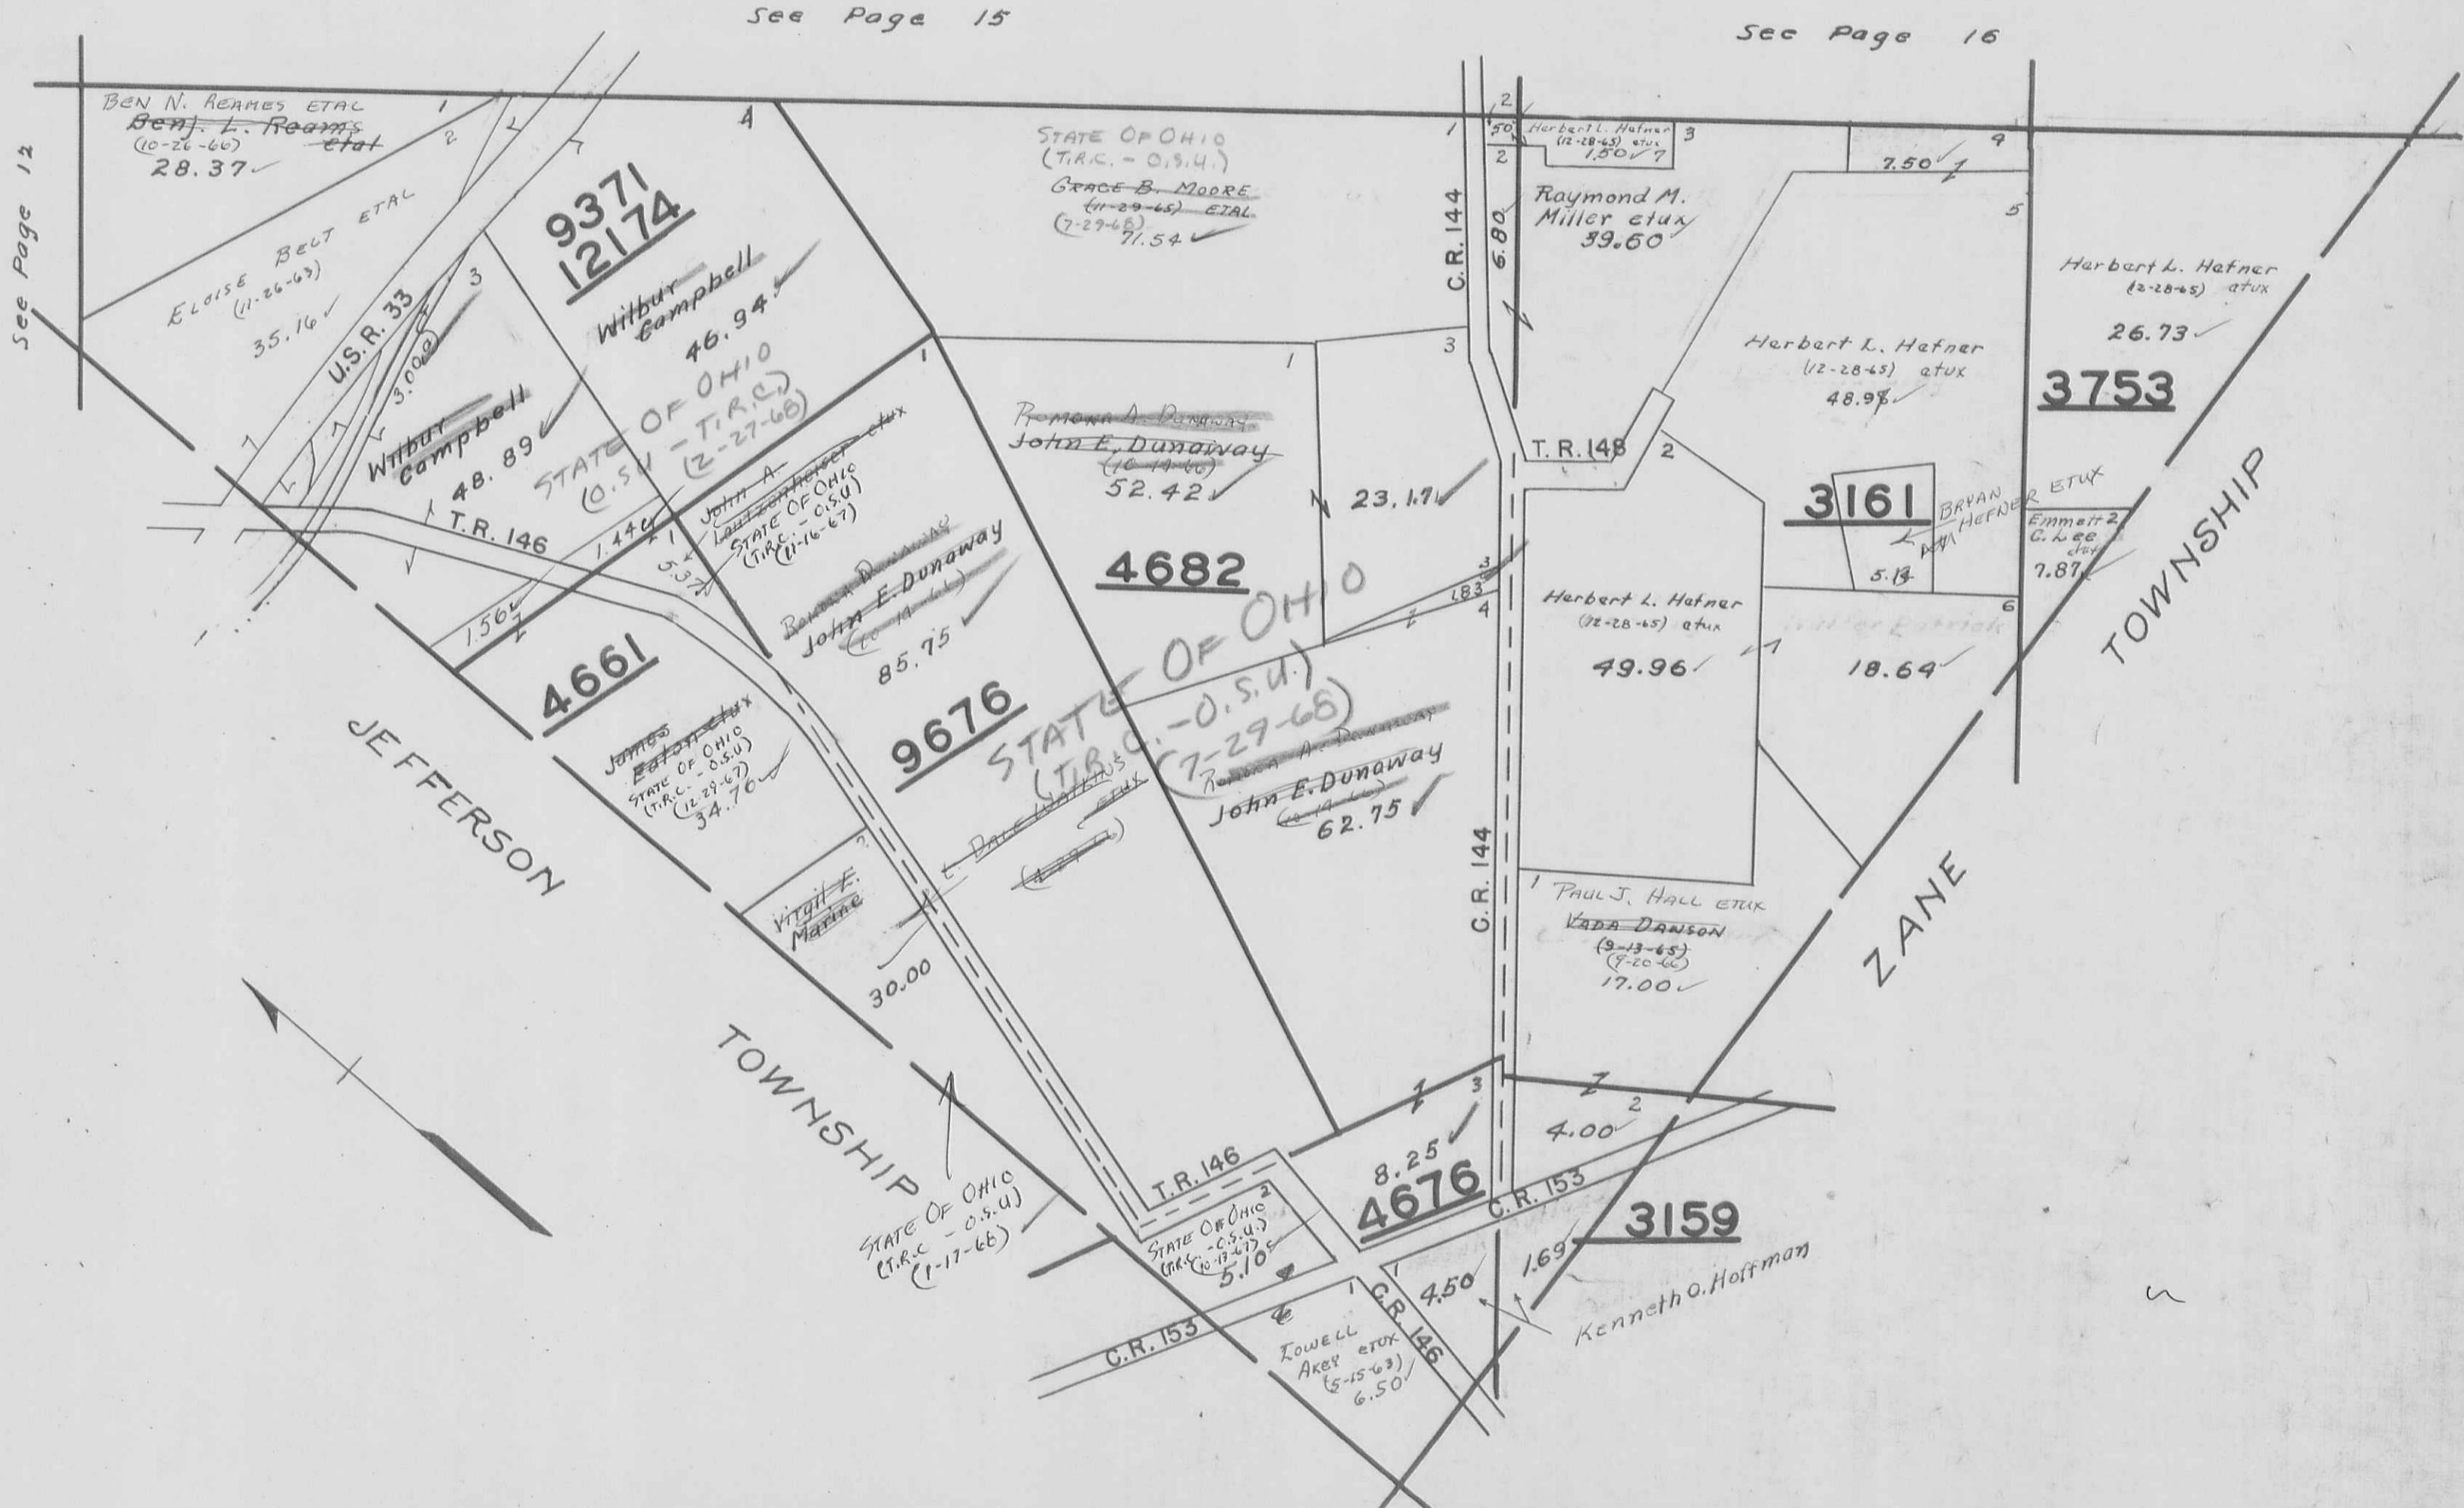

PERRY TOWNSHIP
VIRGINIA MILITARY SURVEY 4655

SCALE 10 CHAINS TO THE INCH


PAGE 15

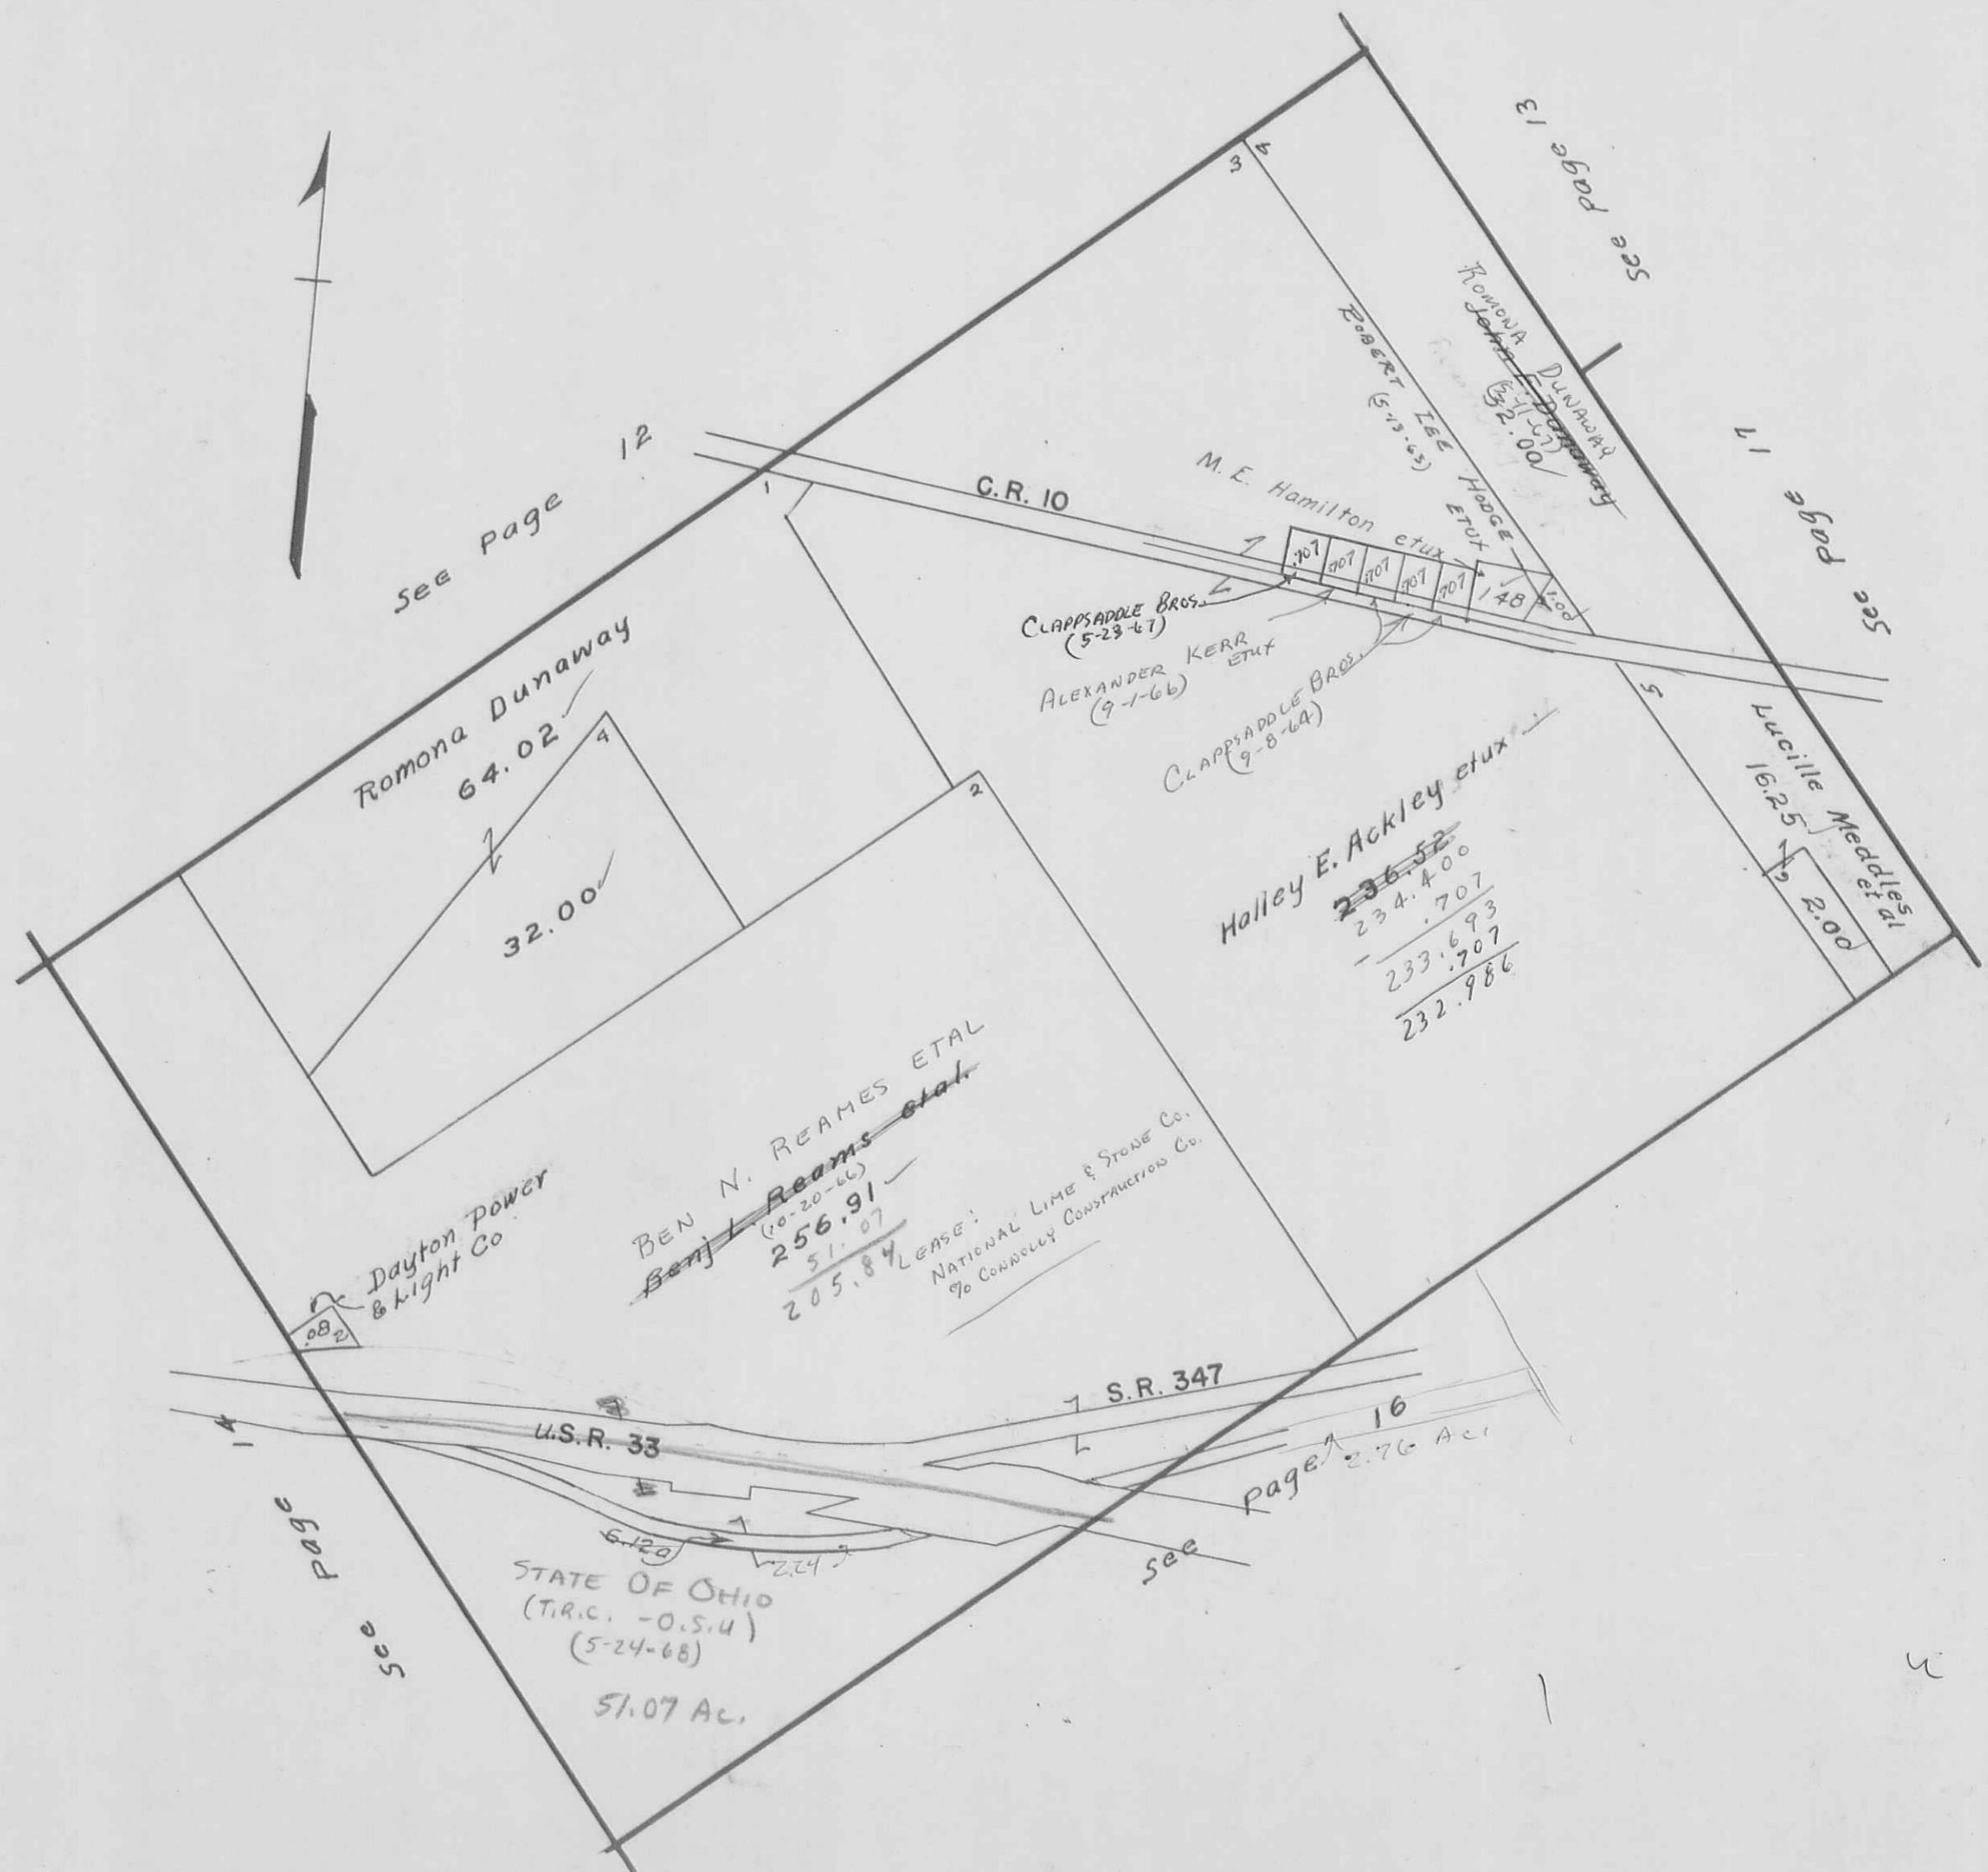

PERRY TOWNSHIP
VIRGINIA MILITARY SURVEY 3164

SCALE 10 CHAINS TO THE INCH

PAGE 16

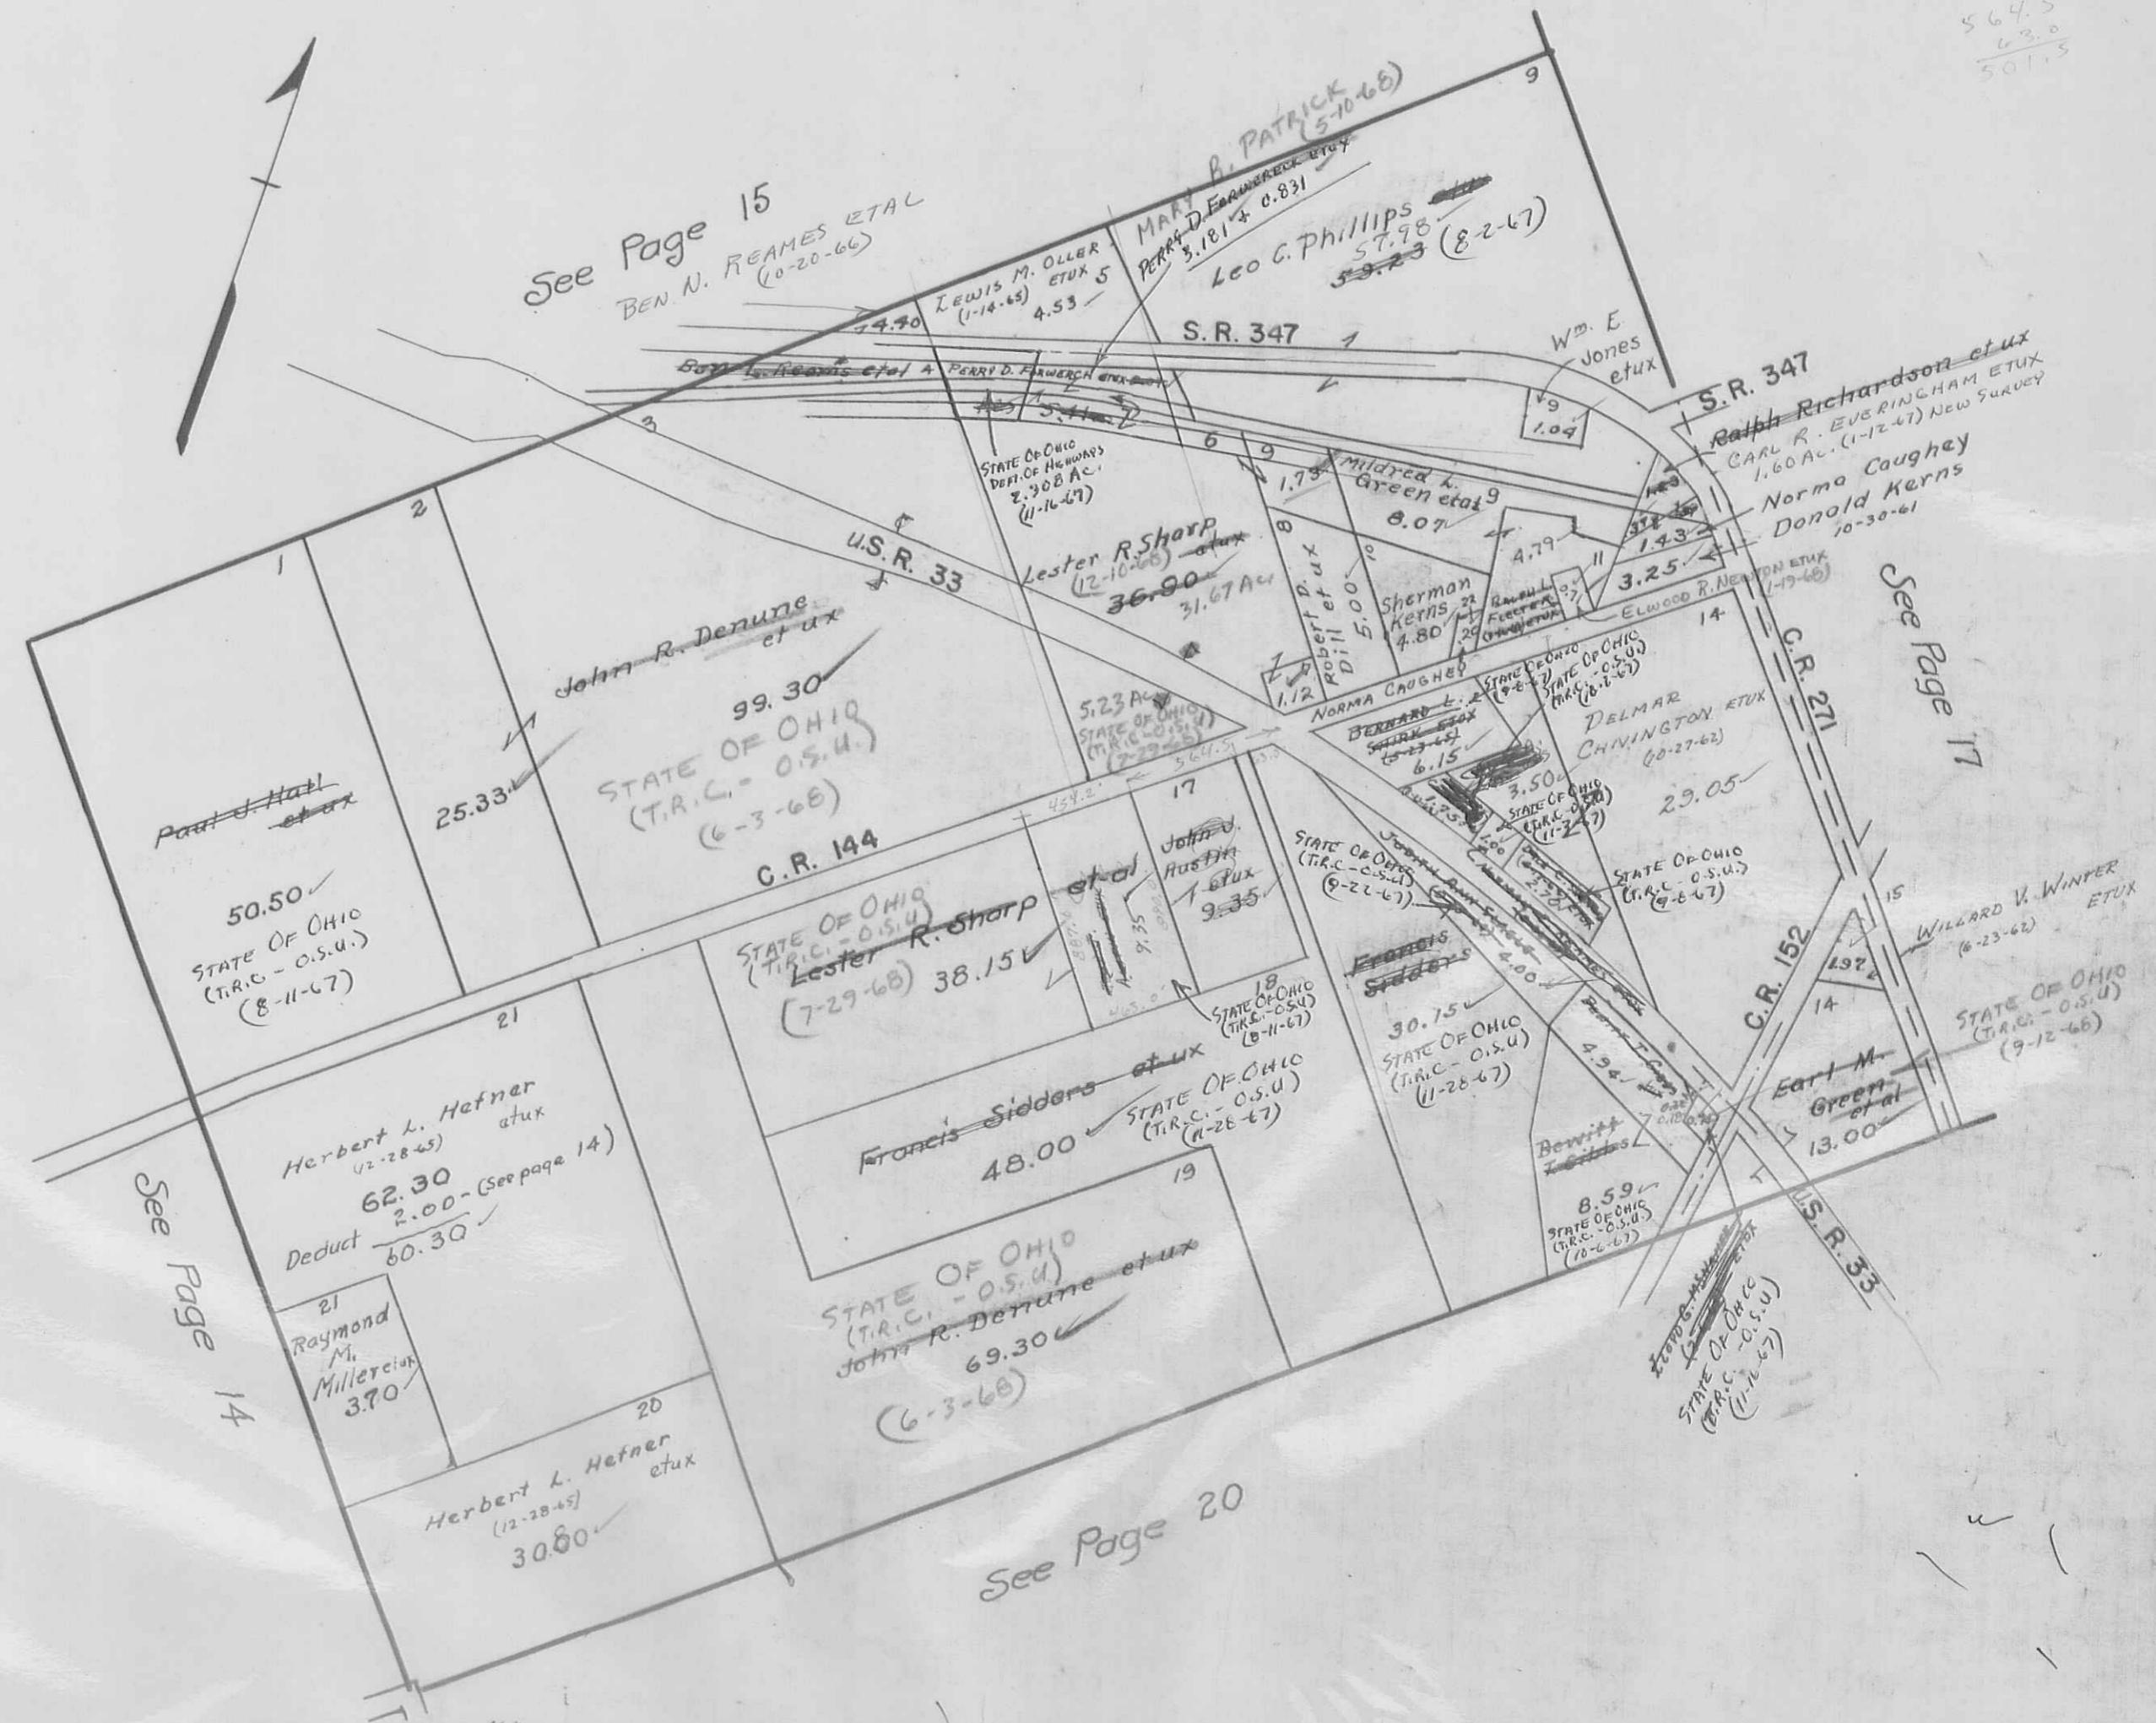


PERRY TOWNSHIP
VIRGINIA MILITARY SURVEY 4689

PAGE 17

SCALE 10 CHAINS TO THE INCH

See Page 15

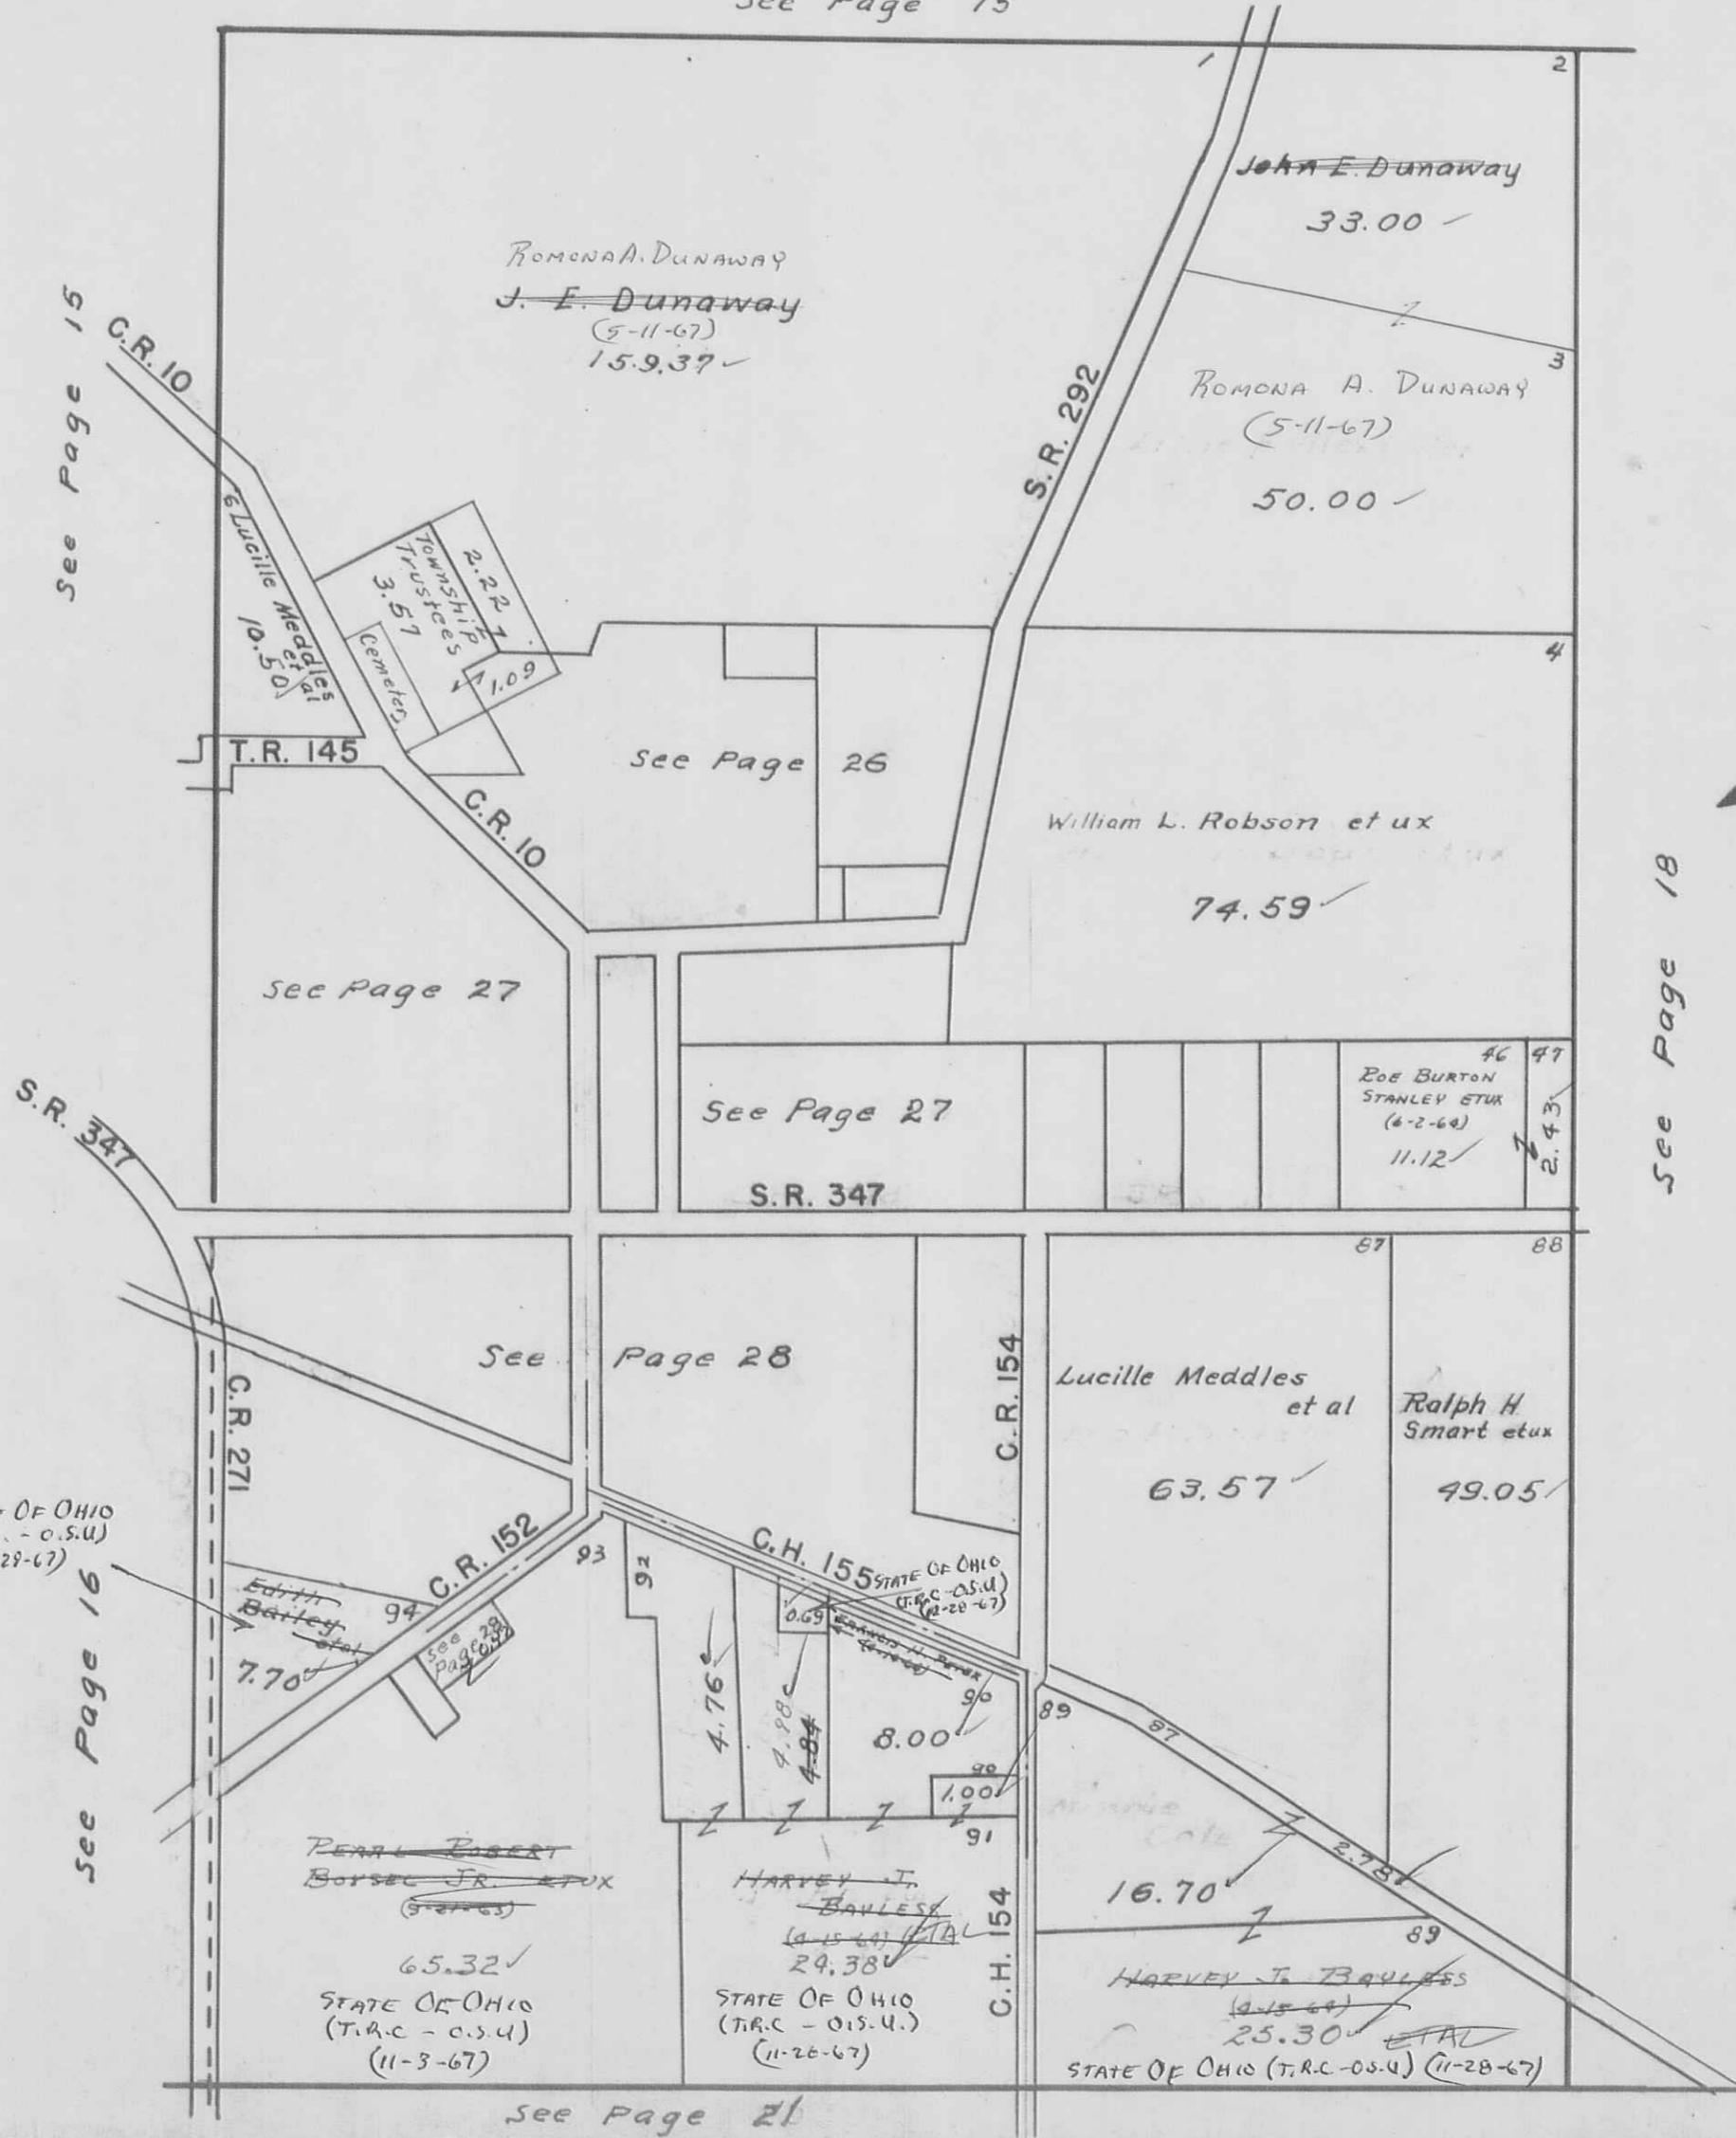

PERRY


TOWNSHIP

PAGE 18

VIRGINIA MILITARY SURVEY 4810

SCALE 10 CHAINS TO THE INCH

See Page 19

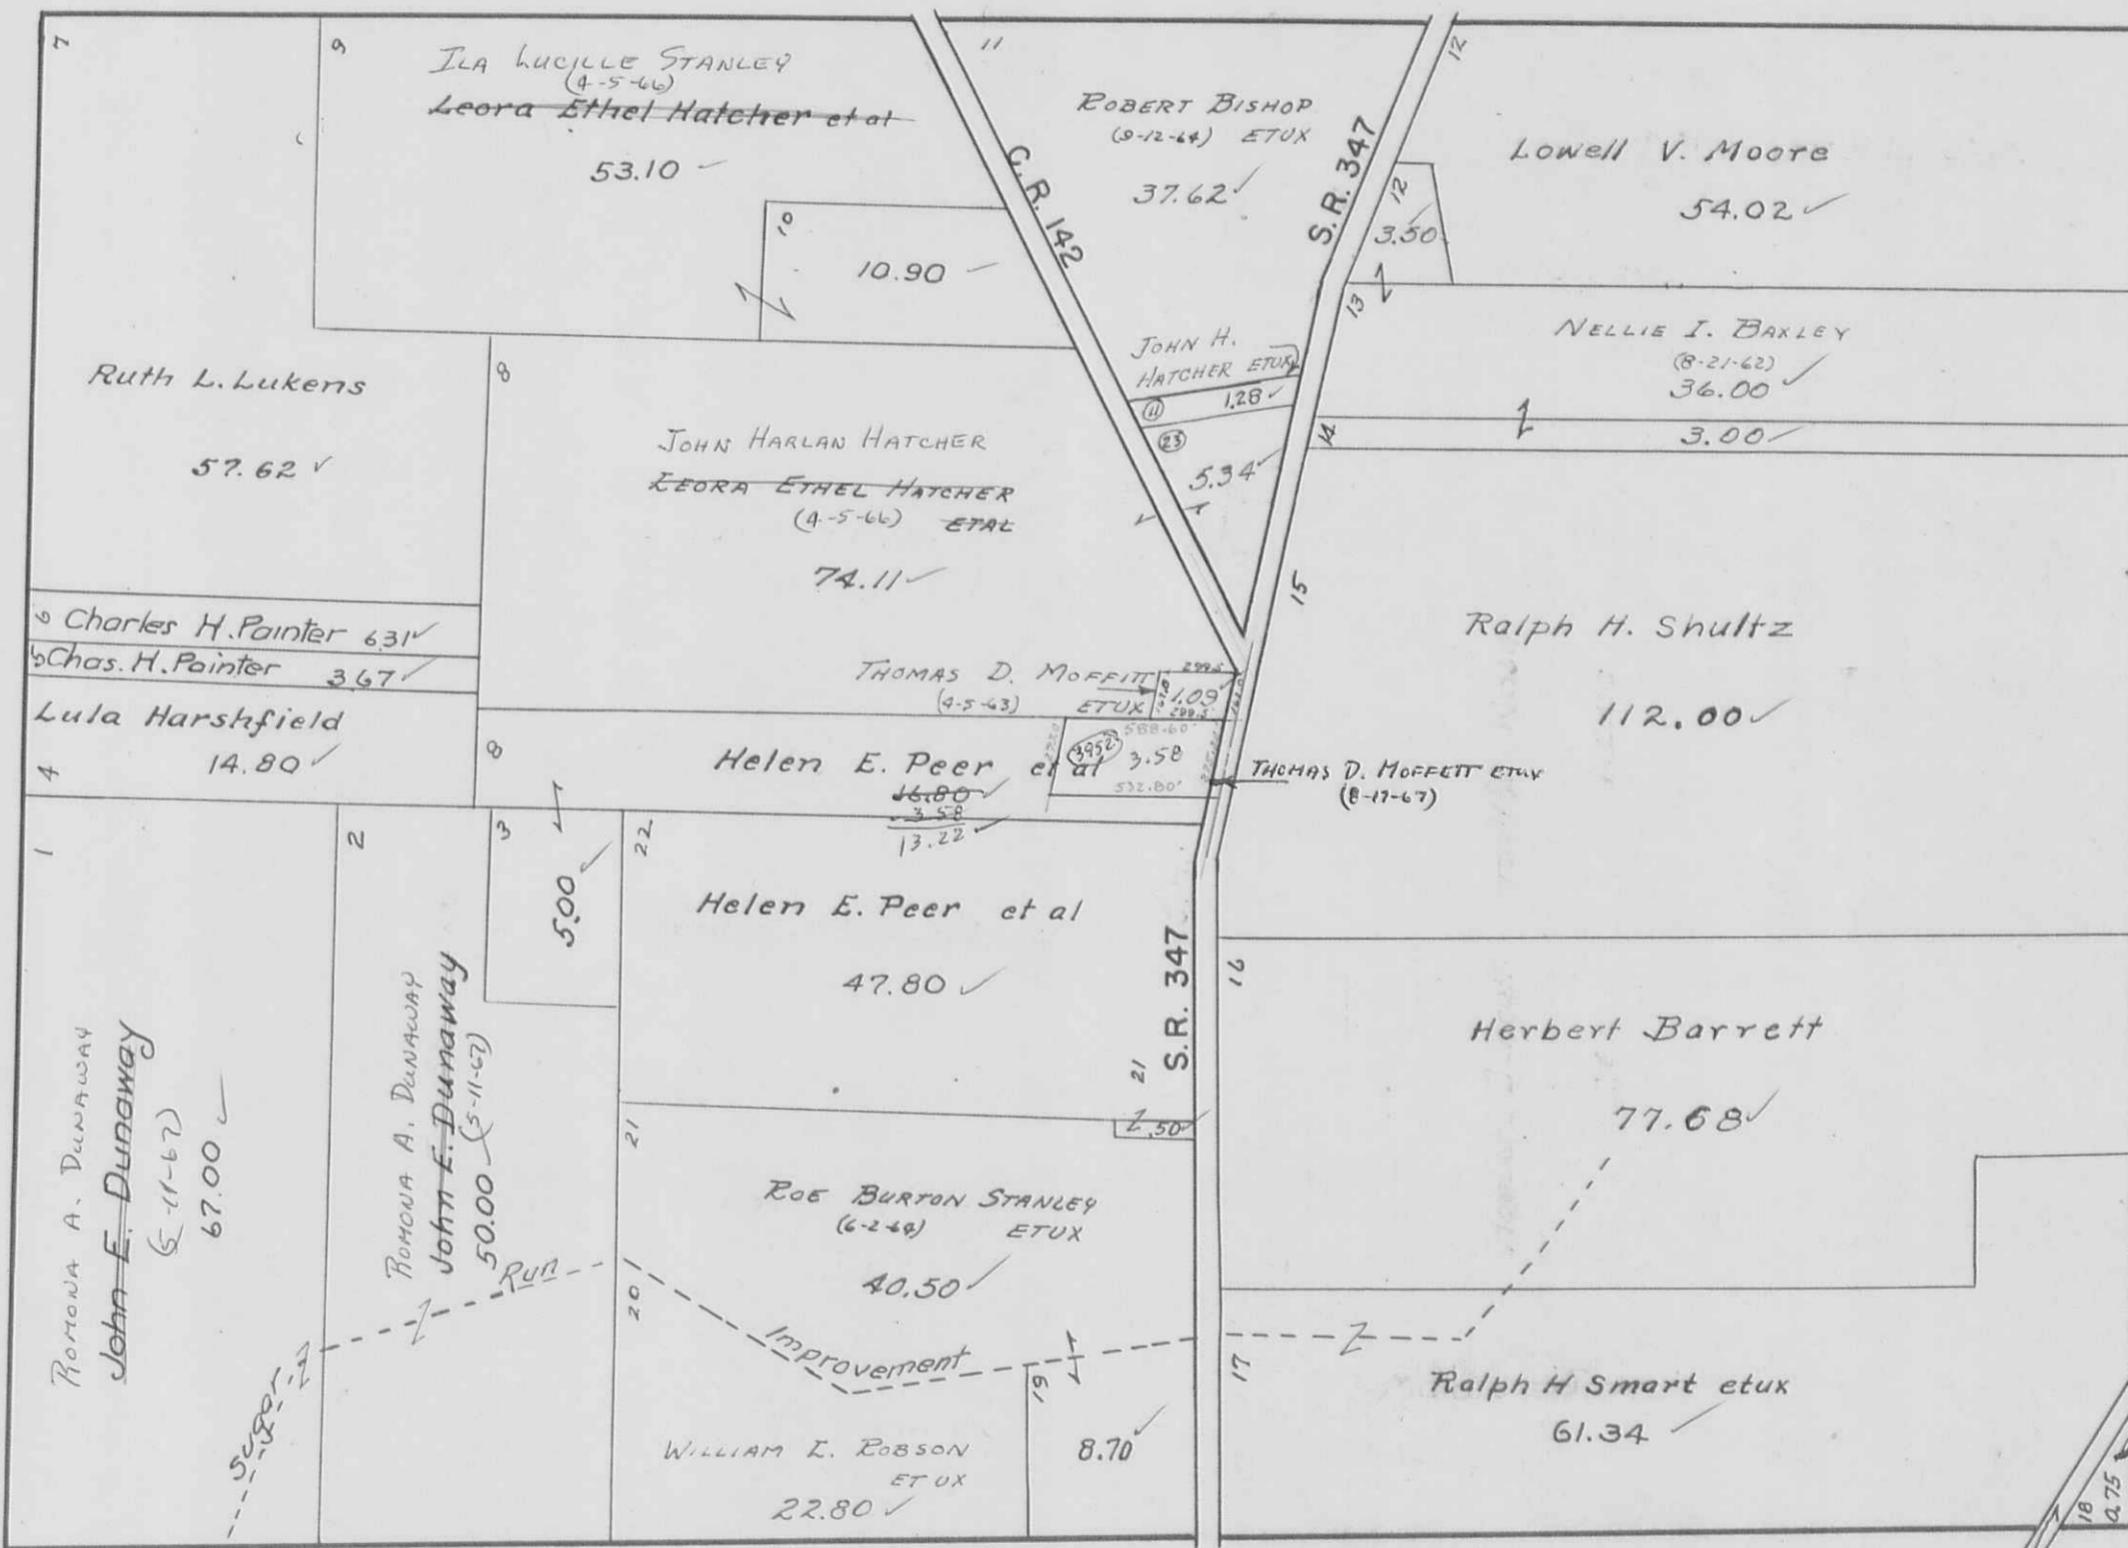

HAROLD J. BARNES
(1-13-44)
See Page 22

PERRY TOWNSHIP
VIRGINIA MILITARY SURVEY 6232

SCALE 10 CHAINS TO THE INCH

PAGE 19



PERRY TOWNSHIP
VIRGINIA MILITARY SURVEY 3154

SCALE 10 CHAINS TO THE INCH

PAGE 20



PERRY TOWNSHIP
VIRGINIA MILITARY SURVEY 4811


PAGE 21

SCALE 10 CHAINS TO THE INCH



PERRY TOWNSHIP
VIRGINIA MILITARY SURVEY 5275

SCALE 10 CHAINS TO THE INCH

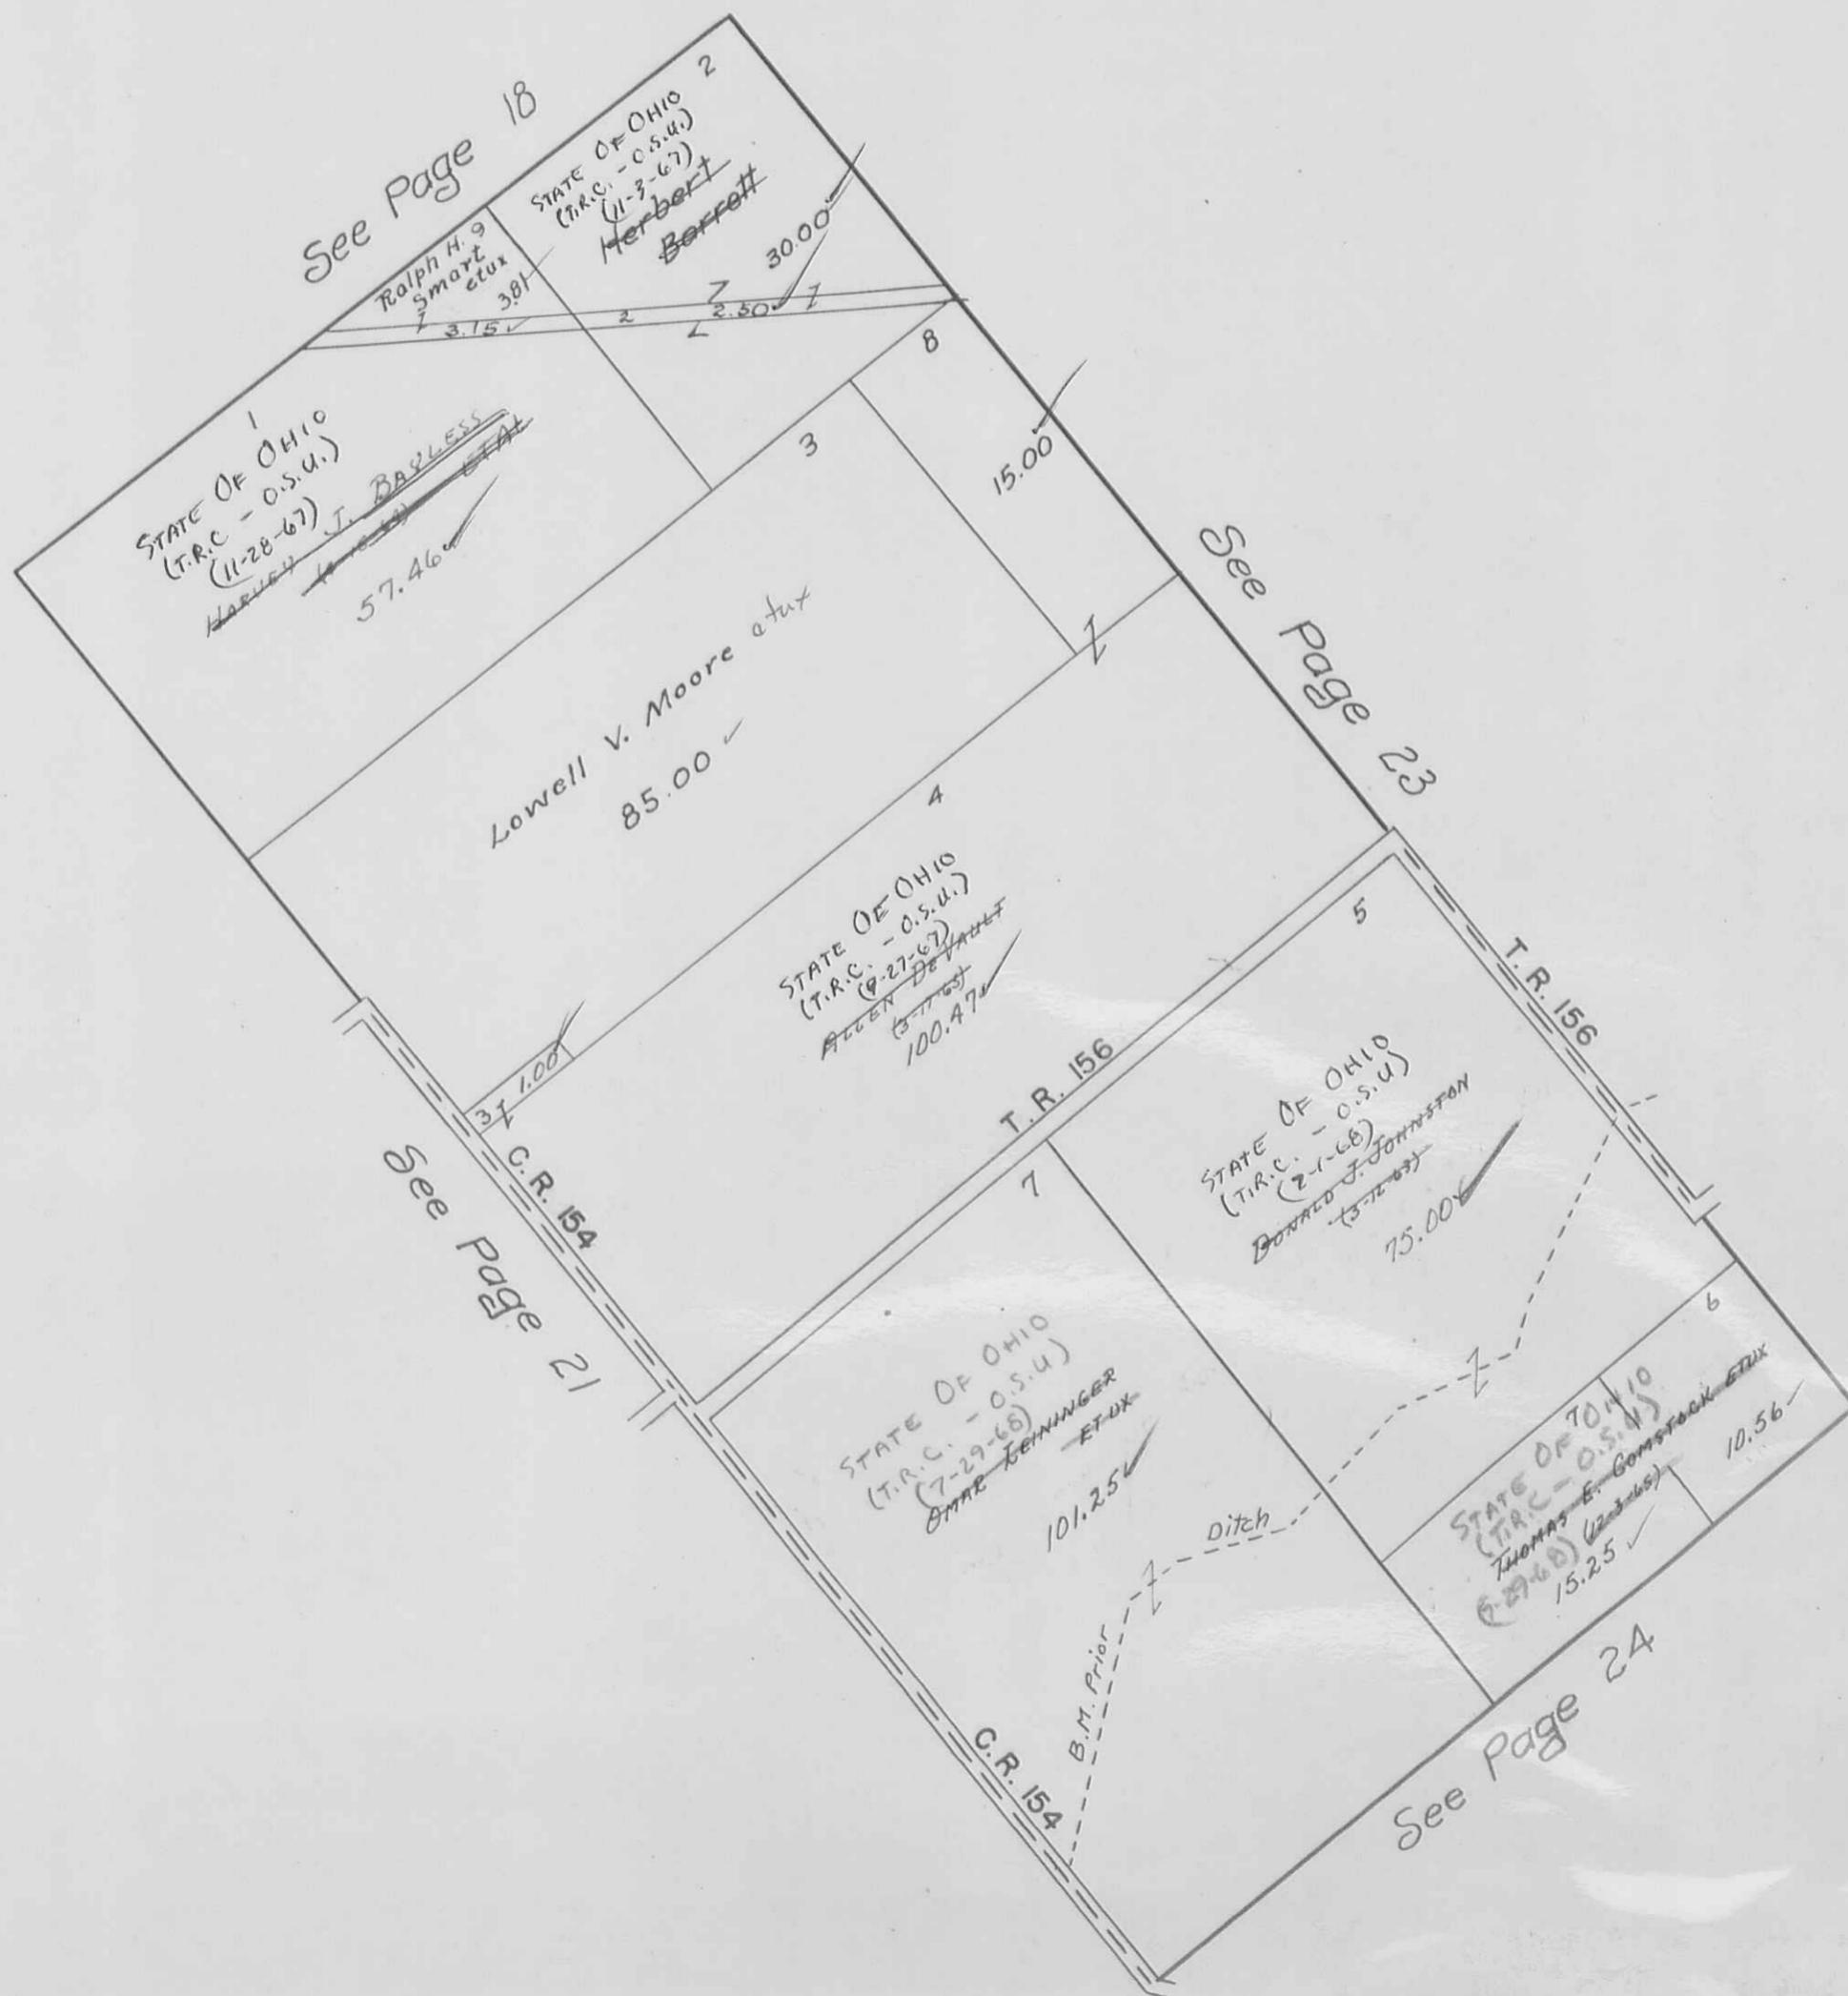

PERRY TOWNSHIP
VIRGINIA MILITARY SURVEYS

PAGE 23

SCALE 10 CHAINS TO THE INCH

12283
14755




PERRY TOWNSHIP
VIRGINIA MILITARY SURVEYS

SCALE 10 CHAINS TO THE INCH

PAGE 24


545
12399
12404
12395
12427
12428

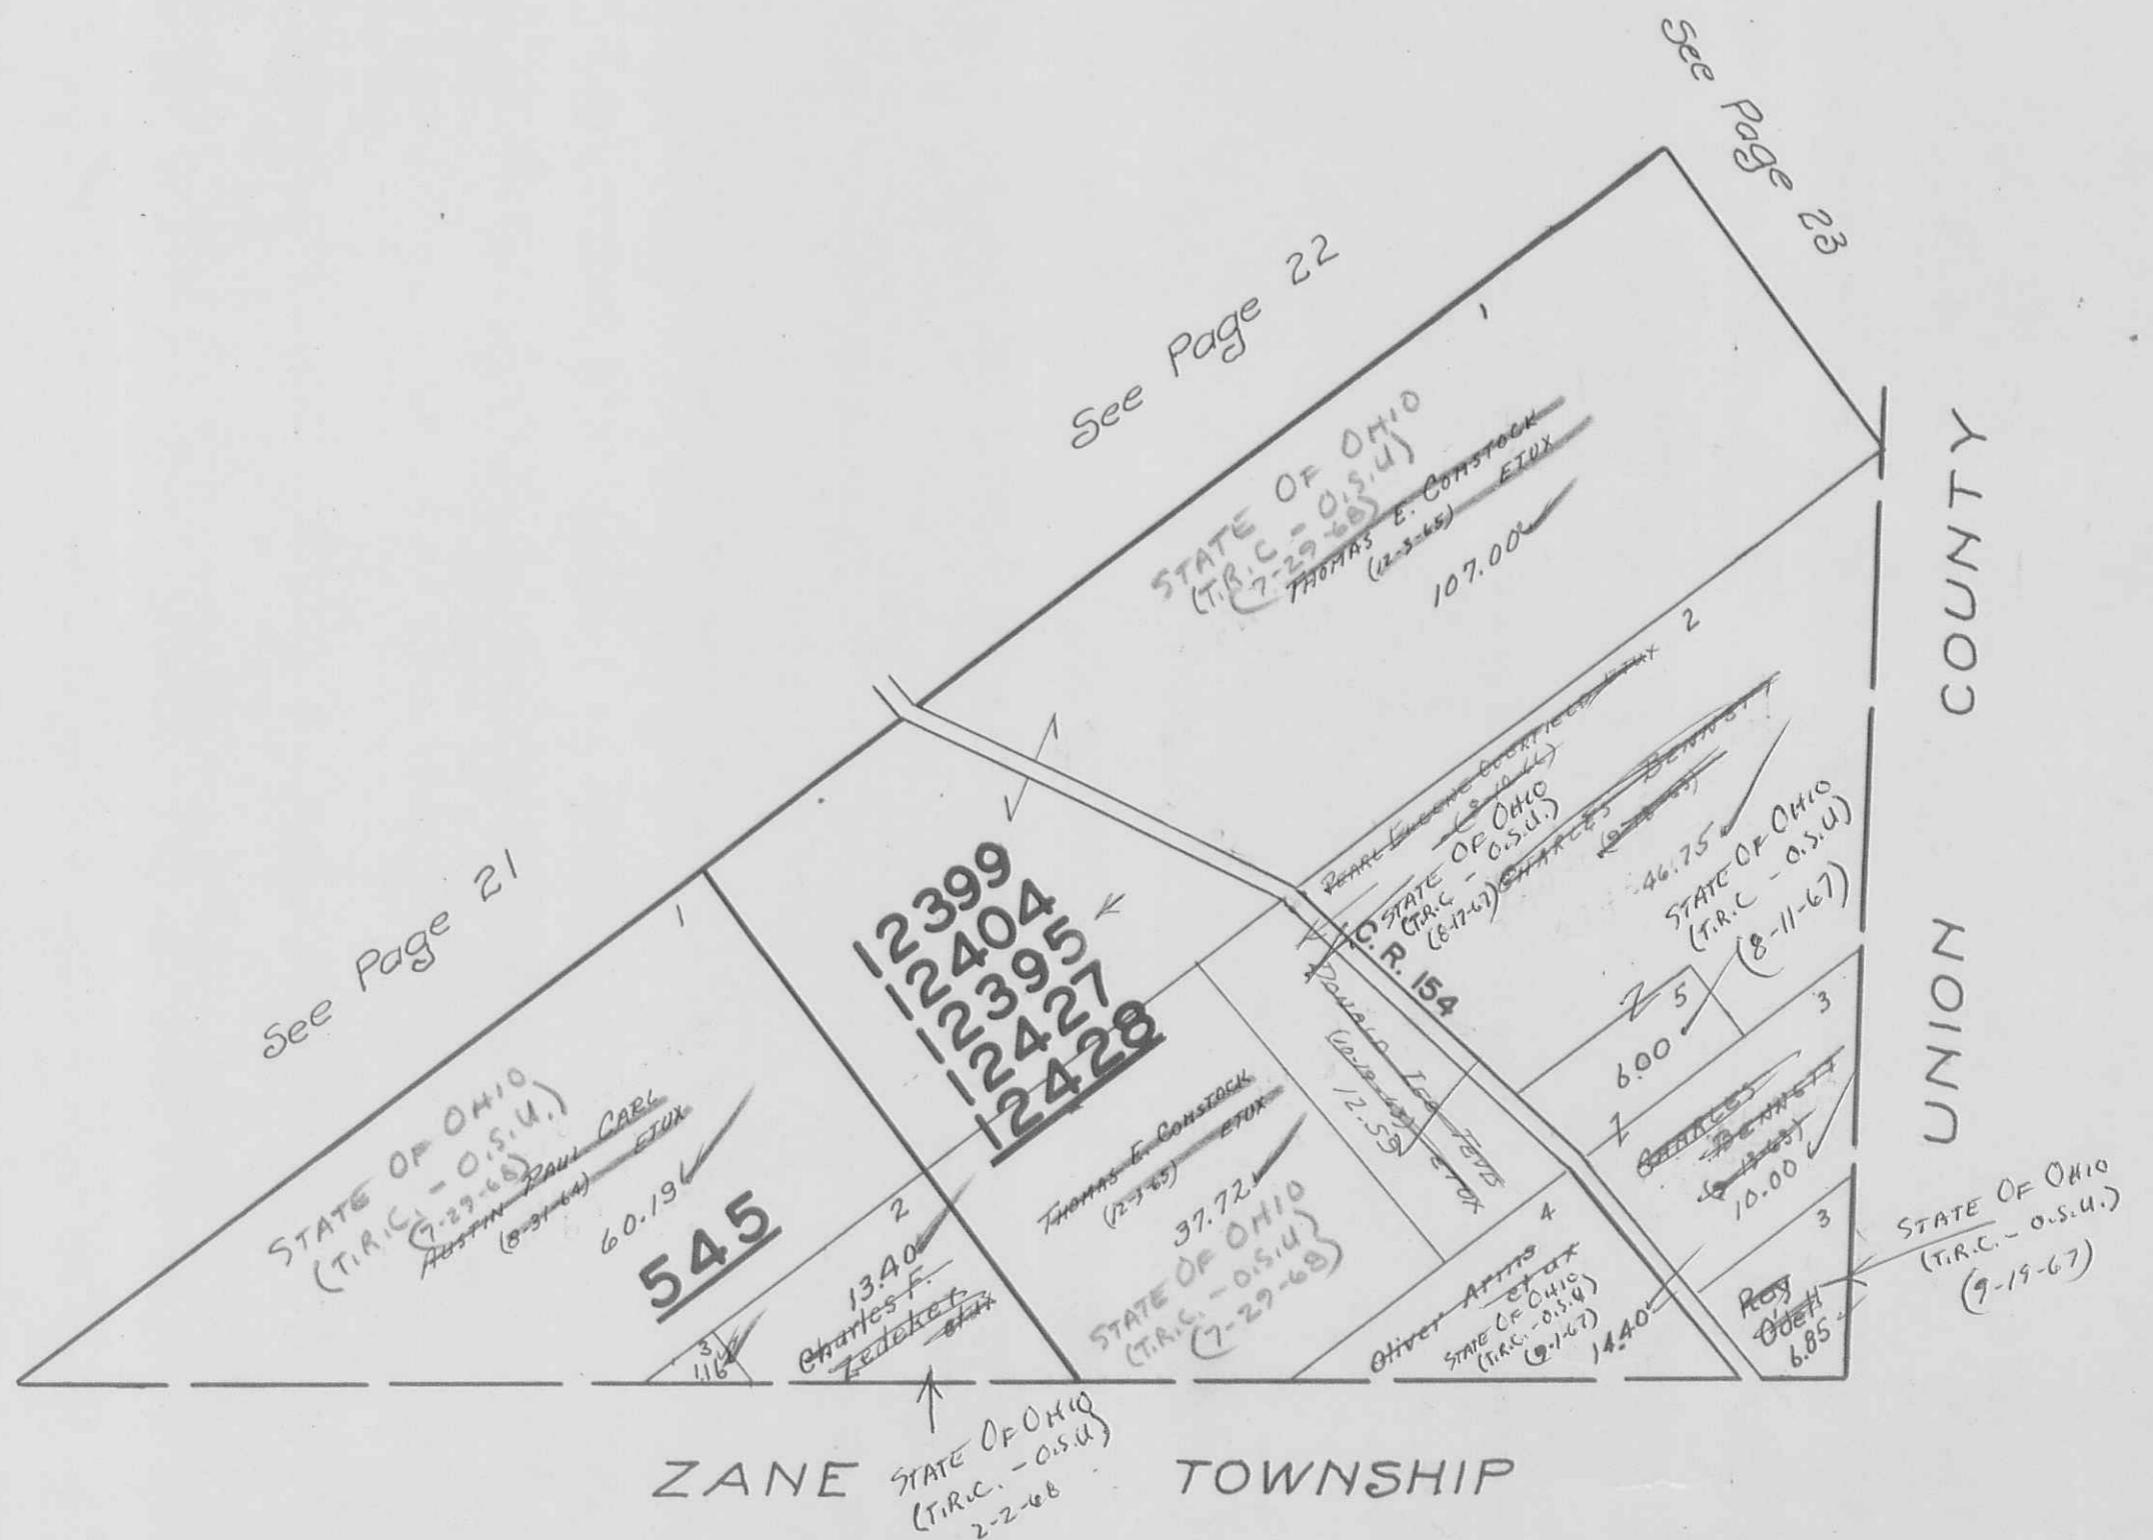

PERRY TOWNSHIP
WEST MANSFIELD CORPORATION

SCALE 300 FEET TO THE INCH

PAGE 25

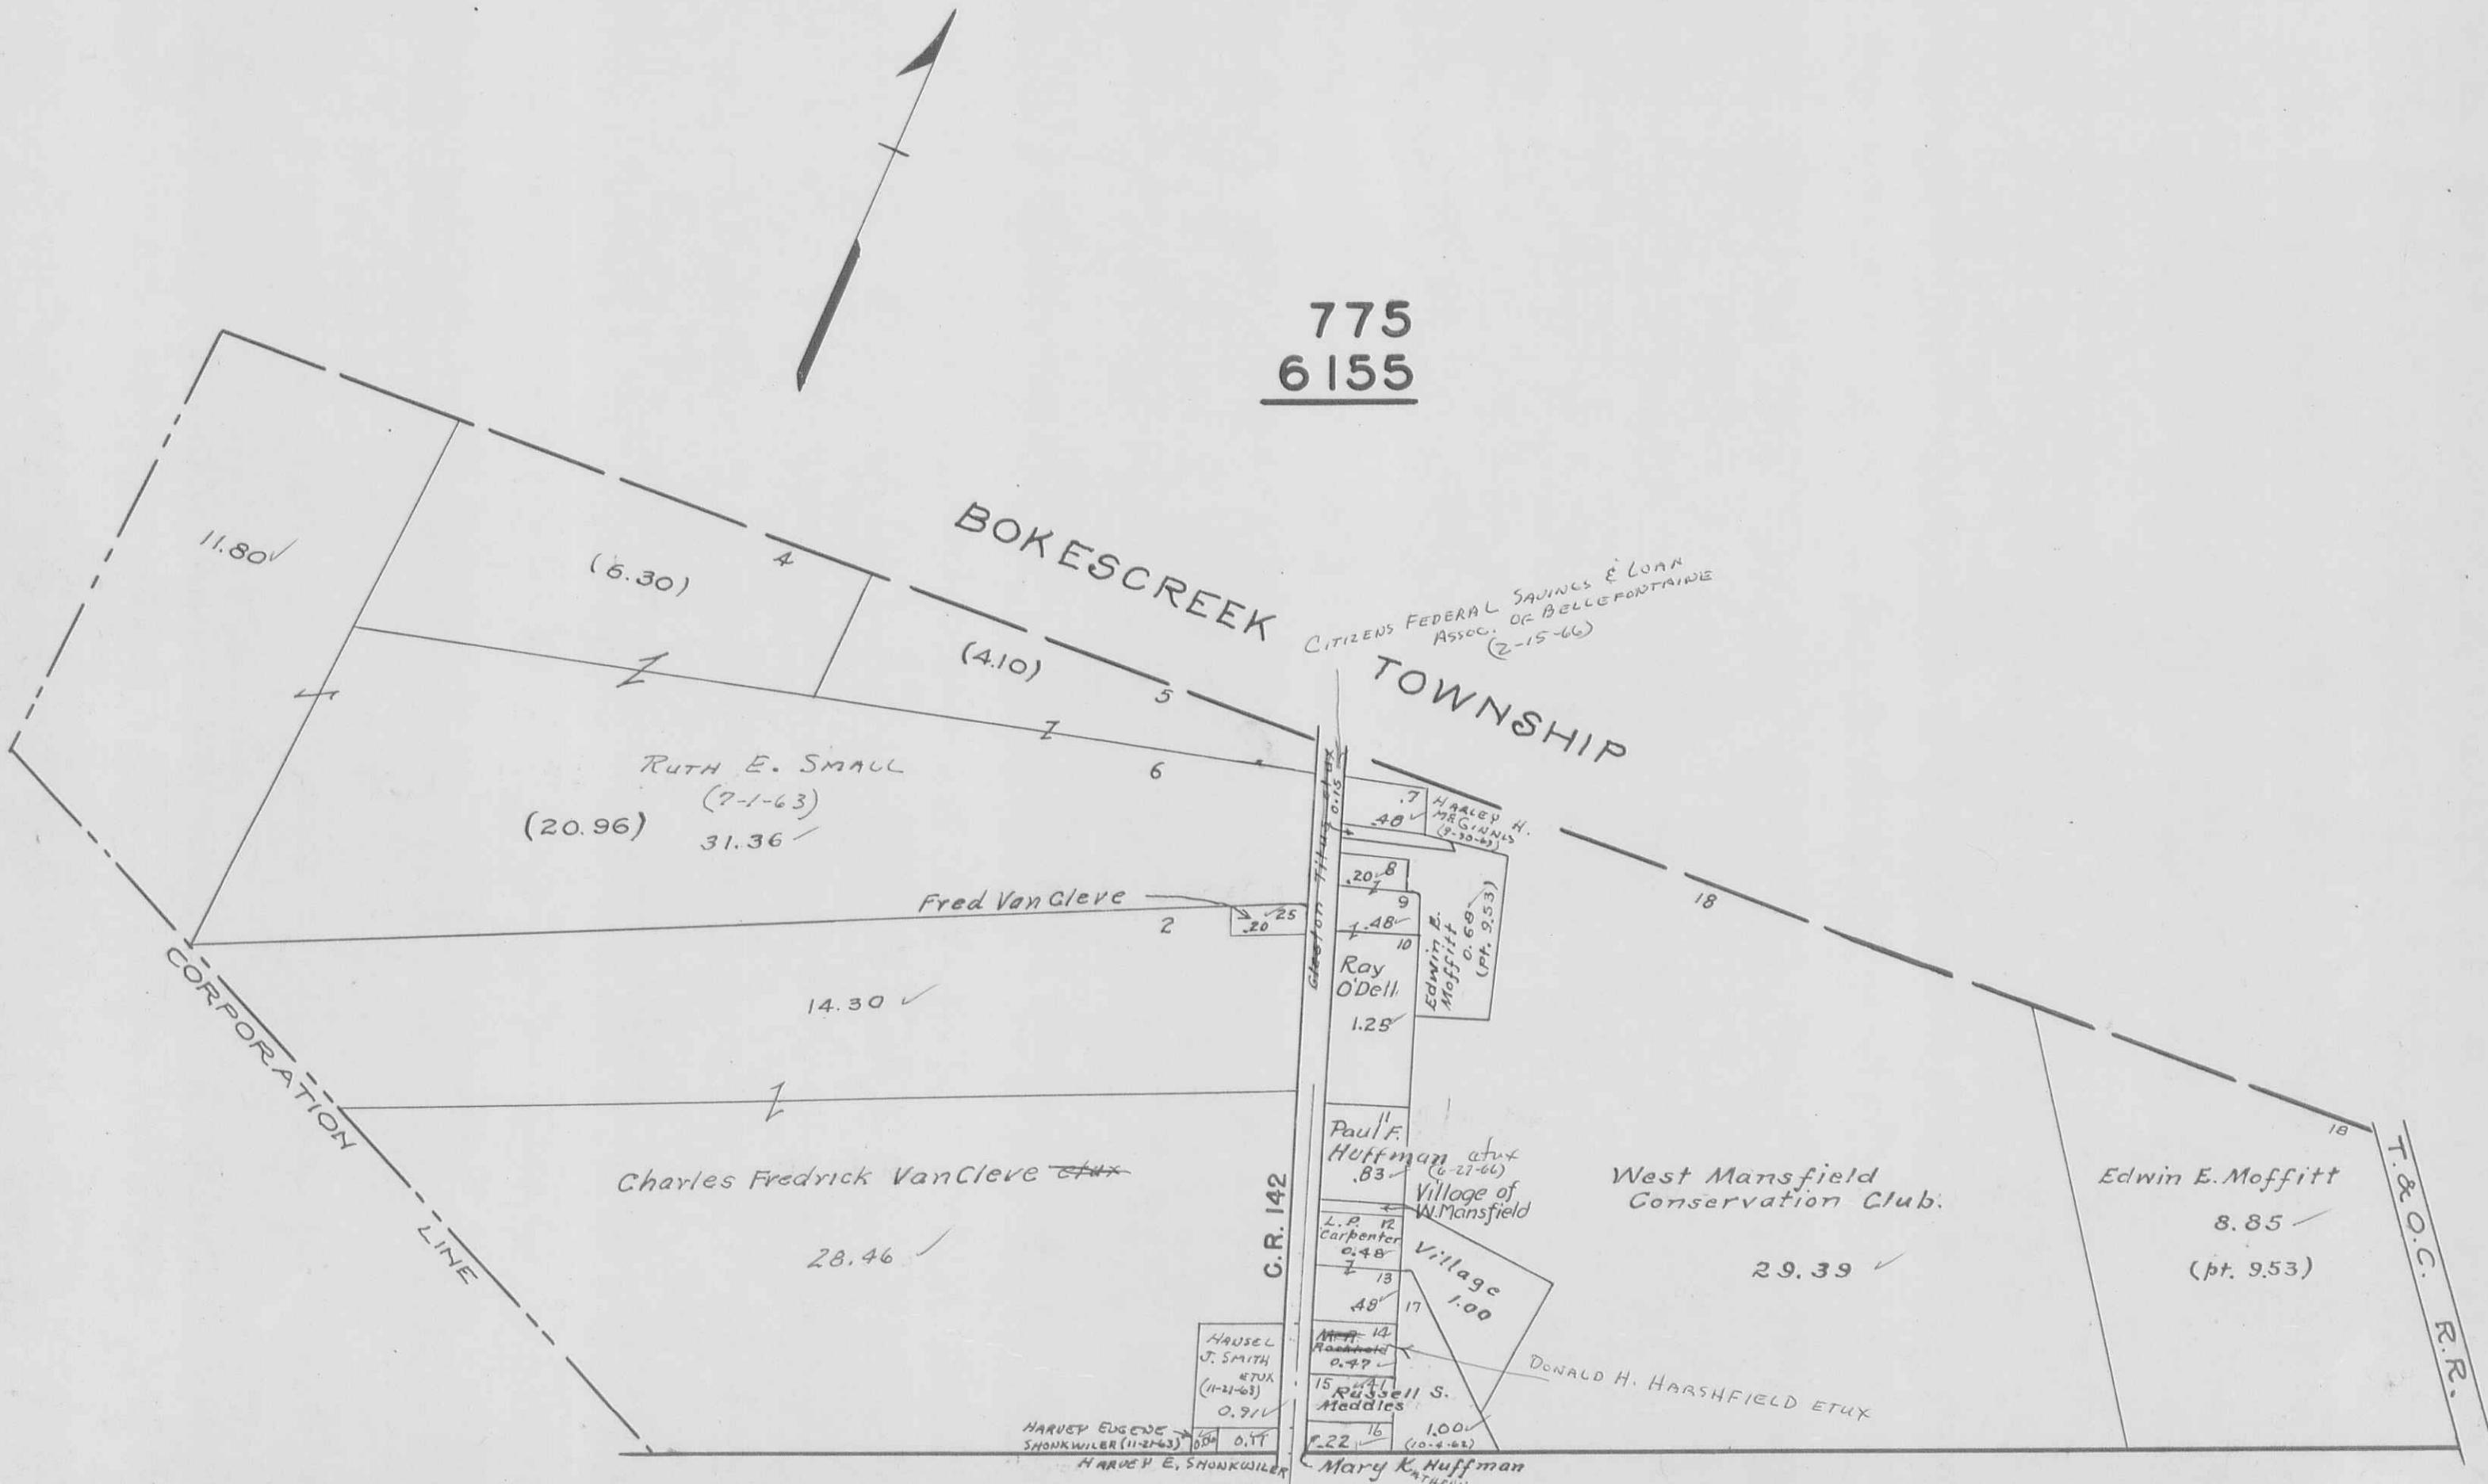


PERRY TOWNSHIP
NORTH EAST PART EAST LIBERTY

PAGE 26

SCALE 200 FEET TO THE INCH

See Page 27

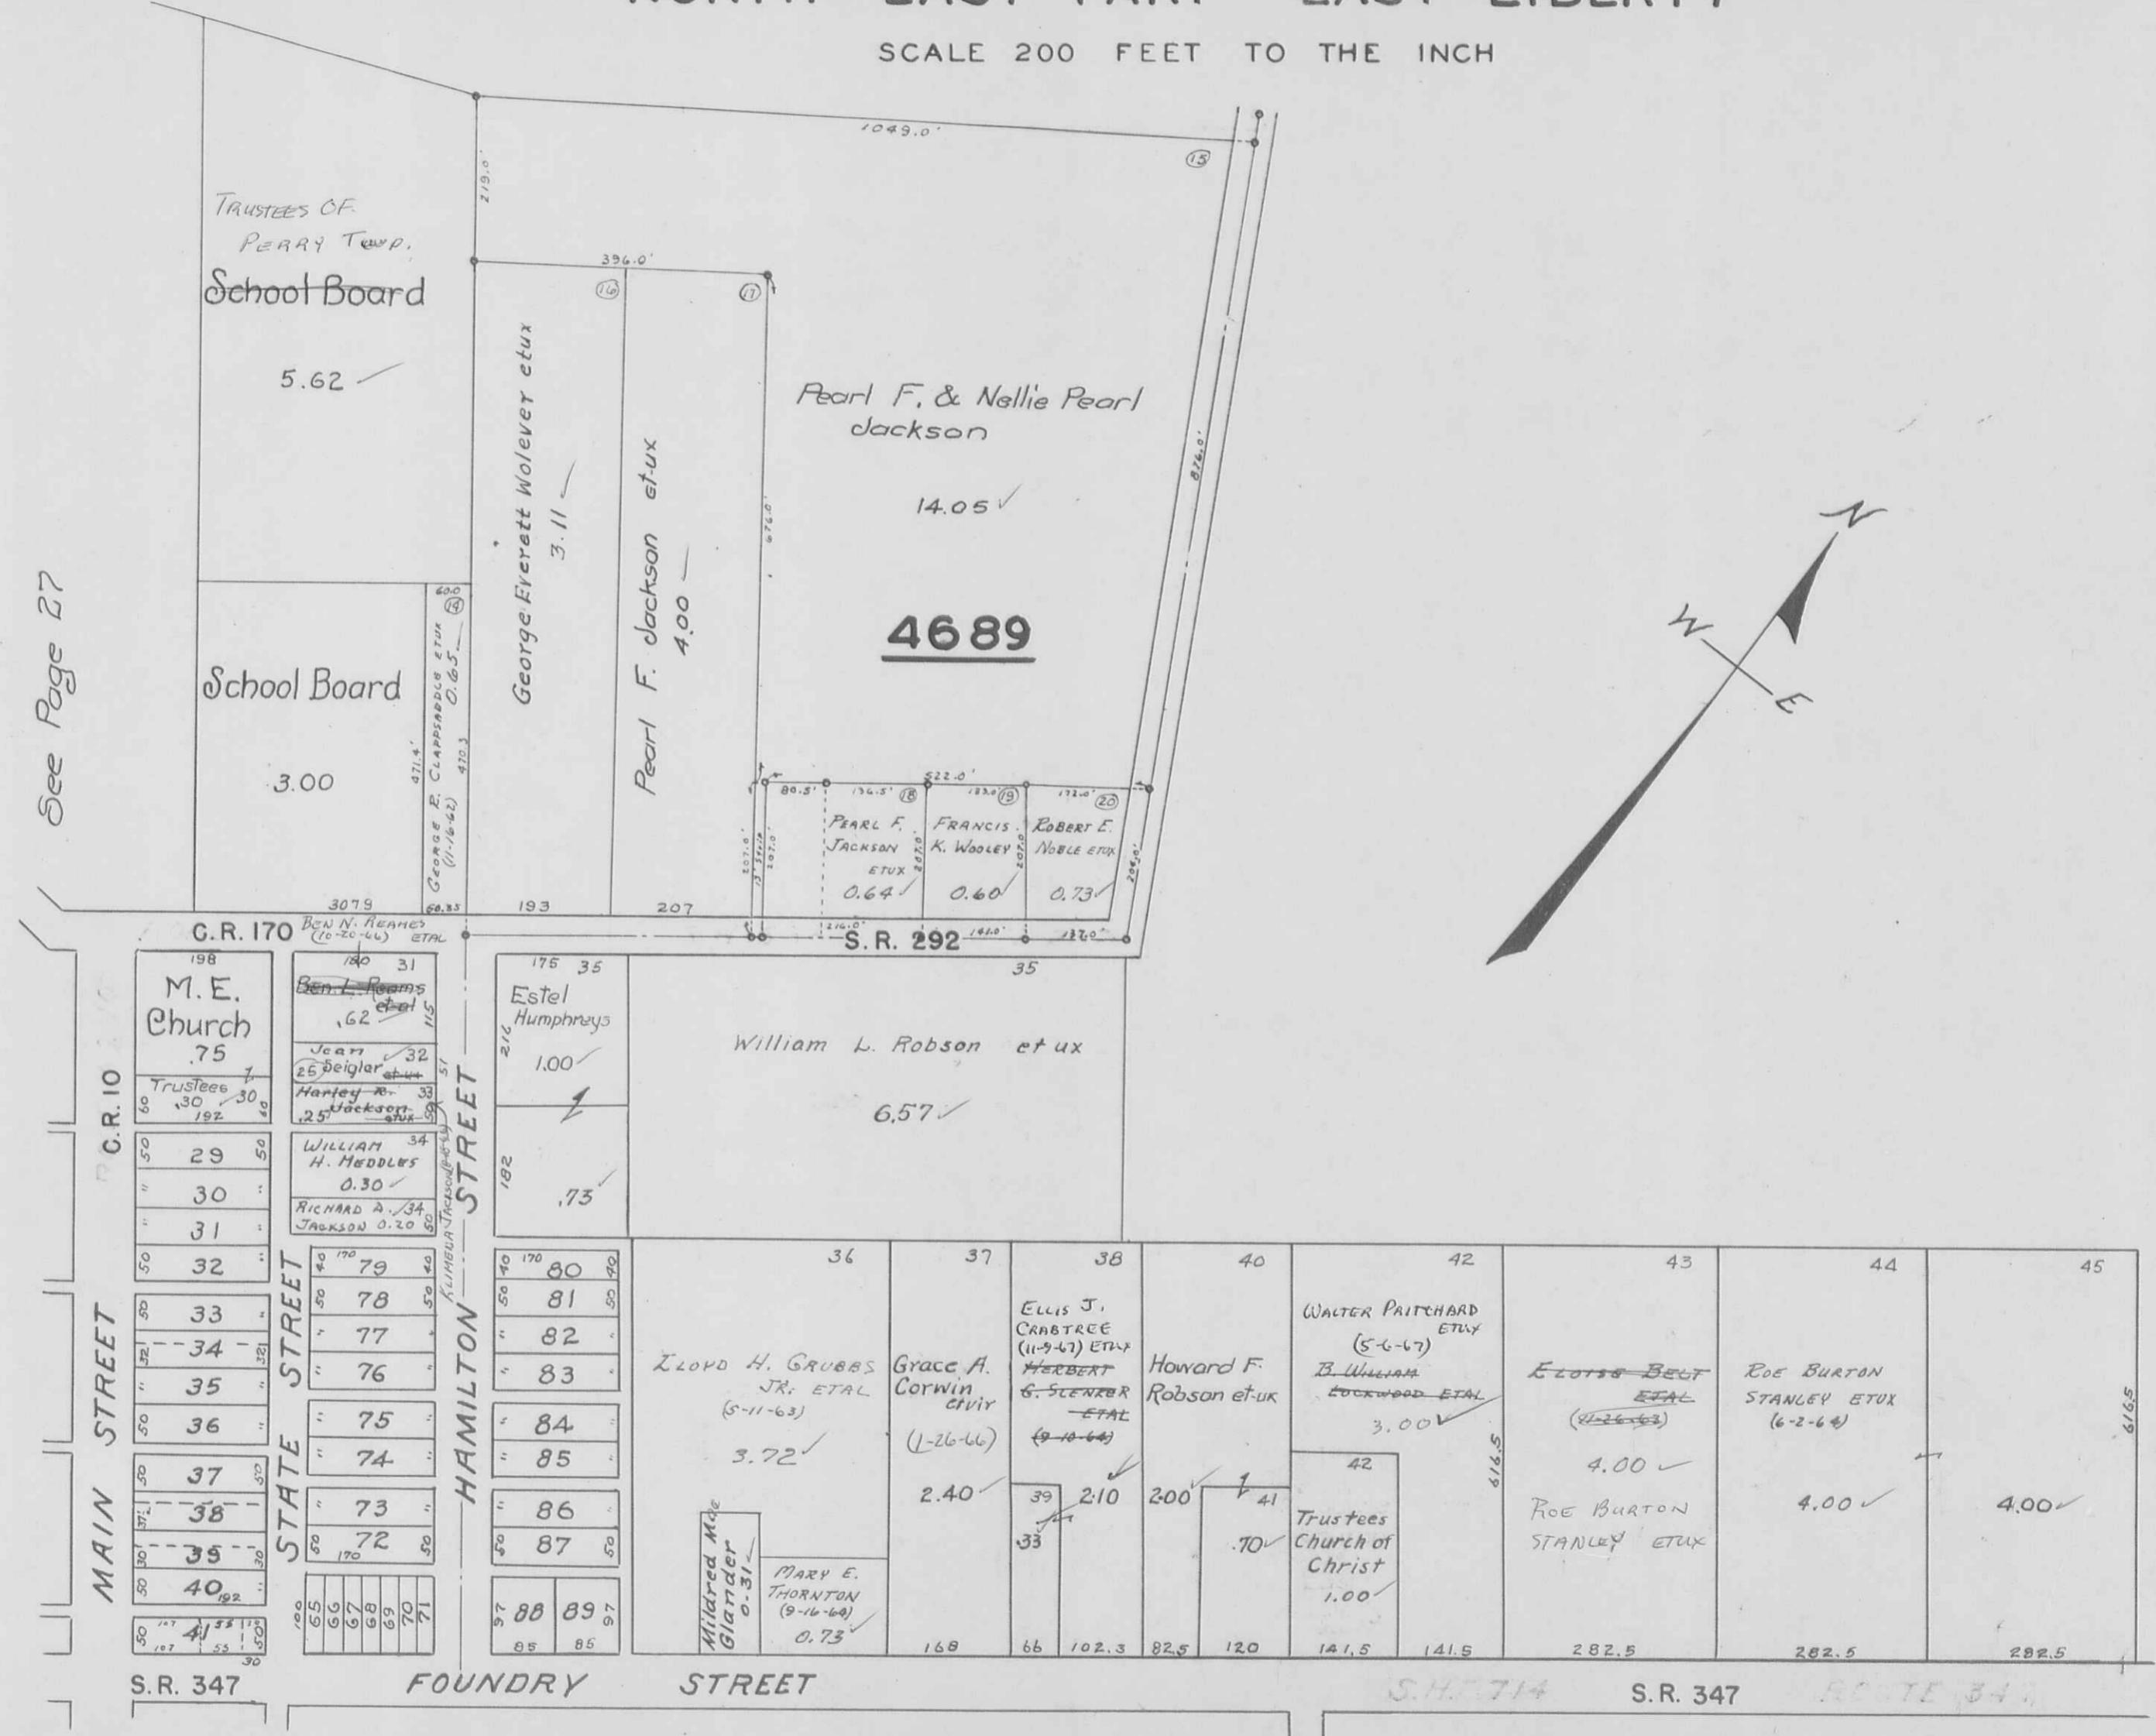

See Page 28


PERRY

TOWNSHIP

PAGE 27

NORTH WEST PART EAST LIBERTY

SCALE 200 FEET TO THE INCH

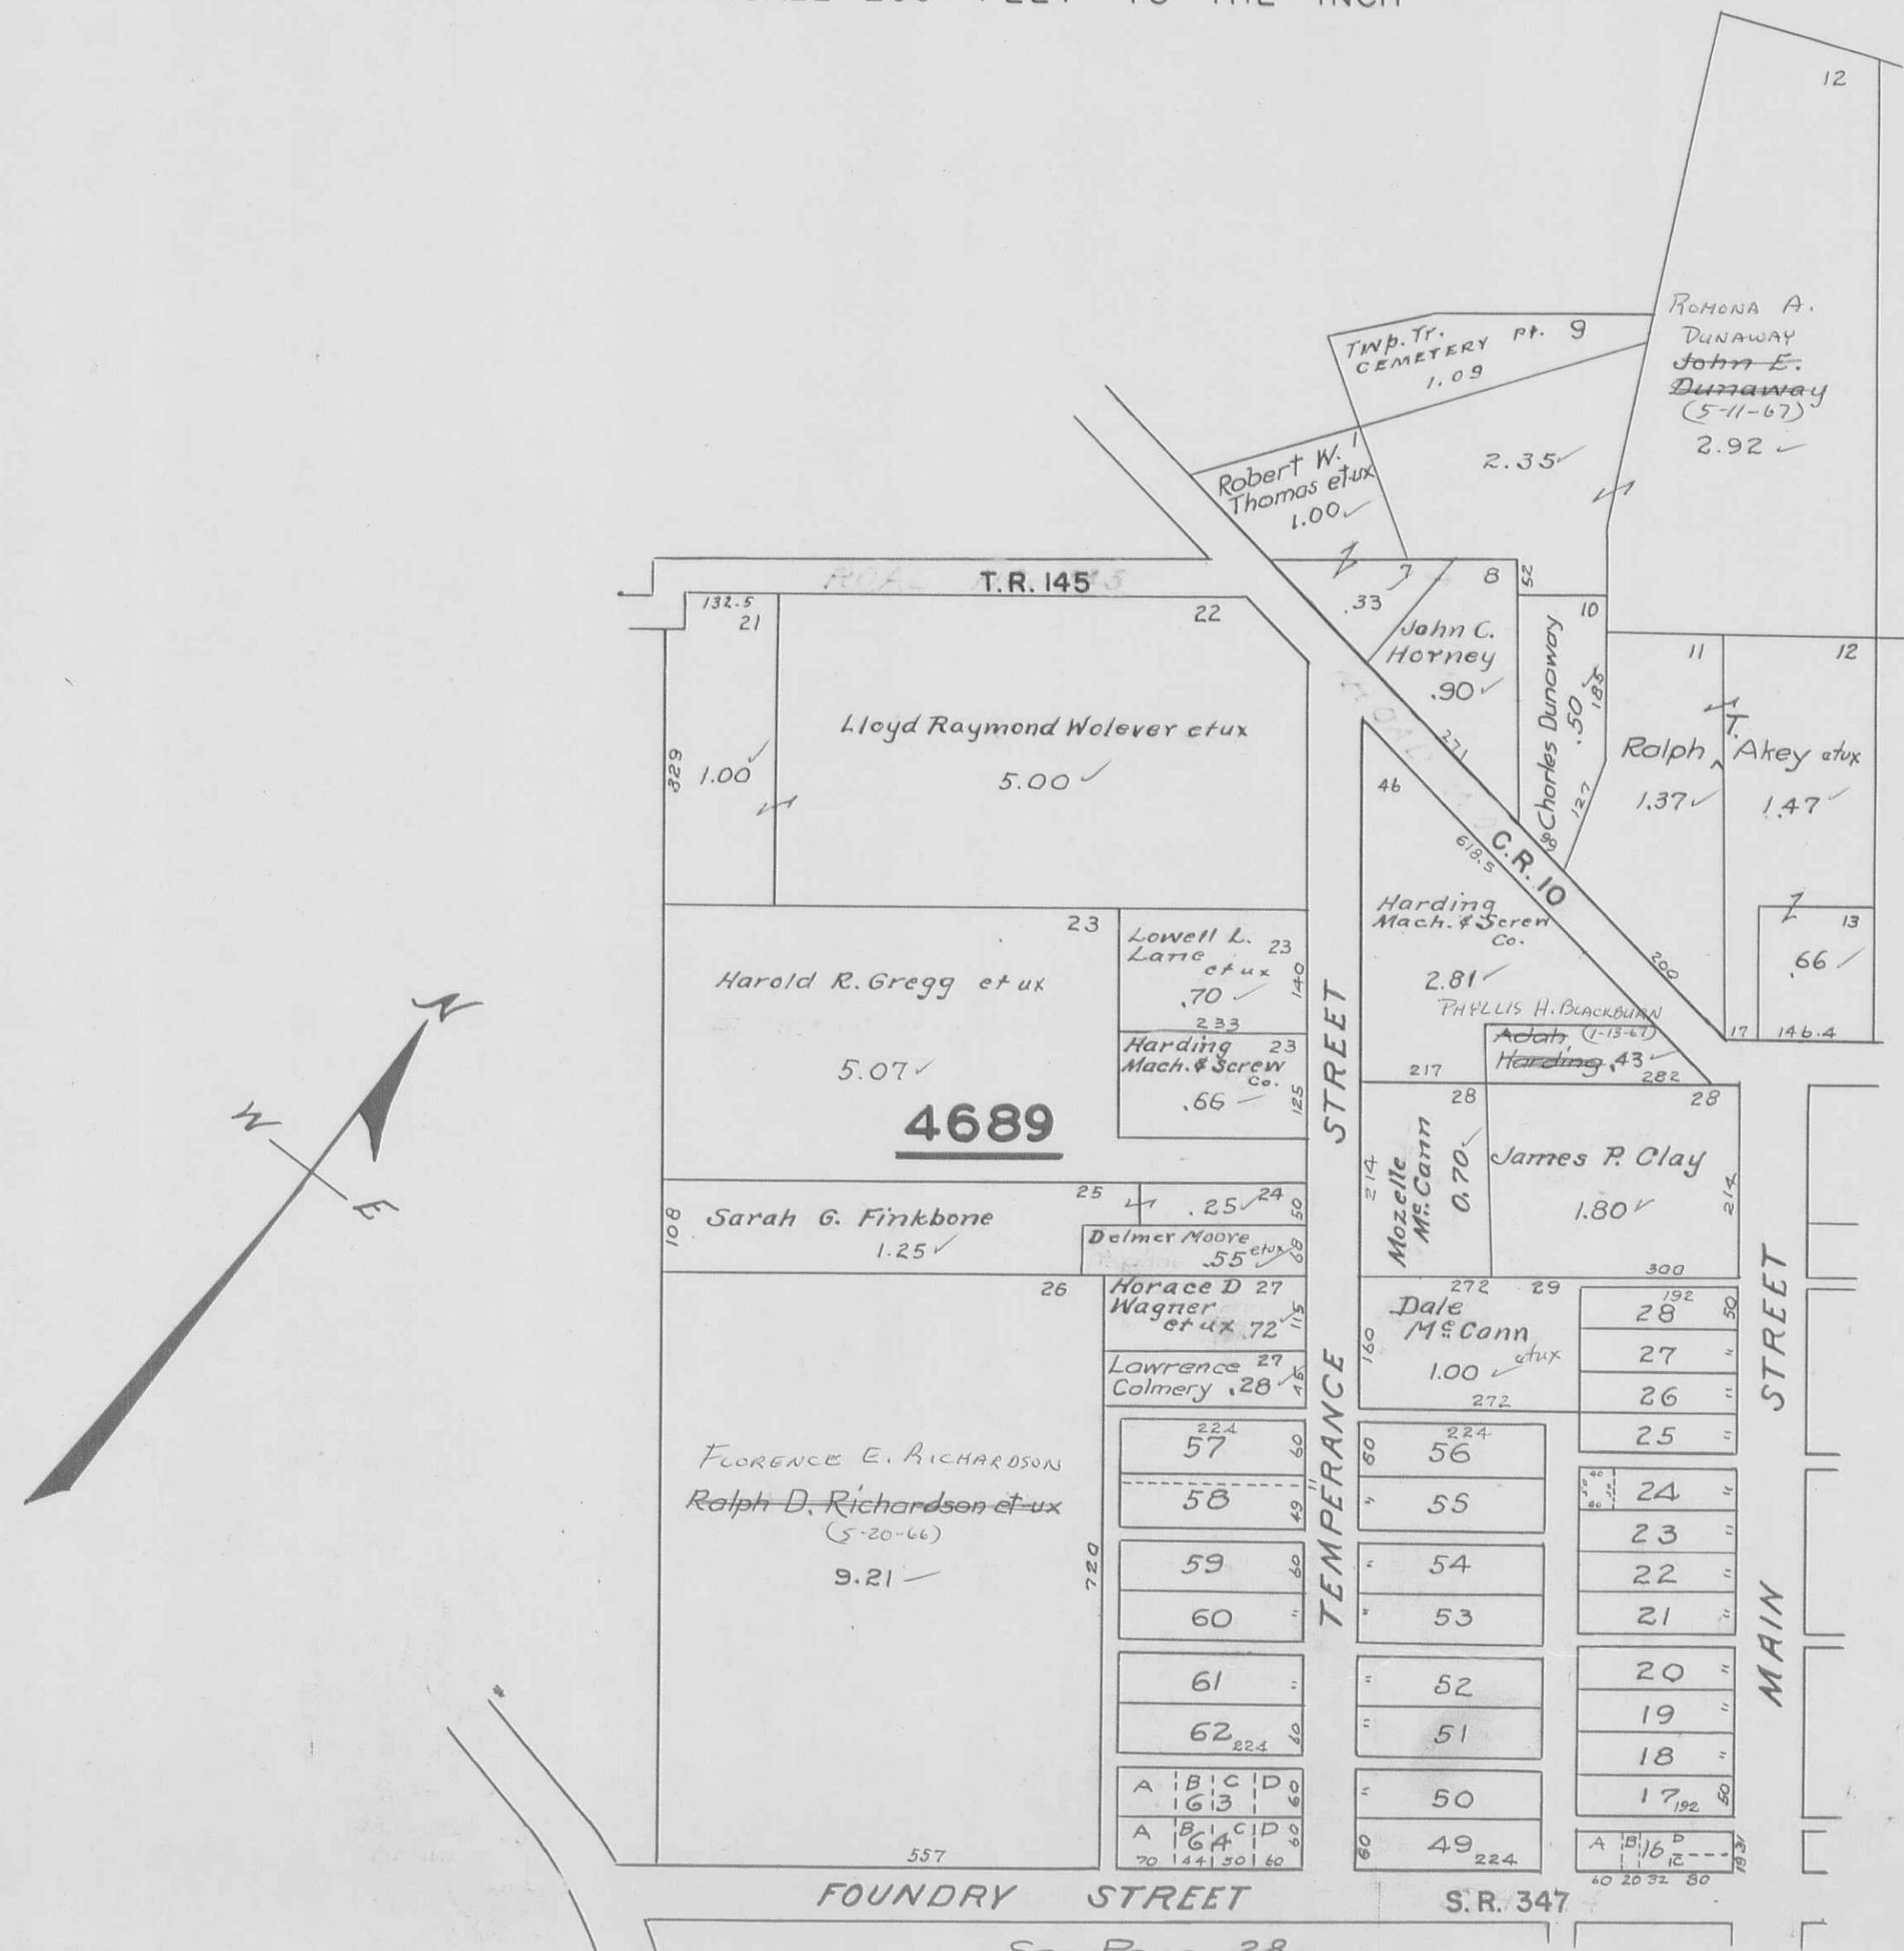

PERRY TOWNSHIP


SOUTH PART EAST LIBERTY

SCALE 200 FEET TO THE INCH

PAGE 28

See Page 26

RICHARD W. BEAGNOINE
ETUX
(9-2-66)

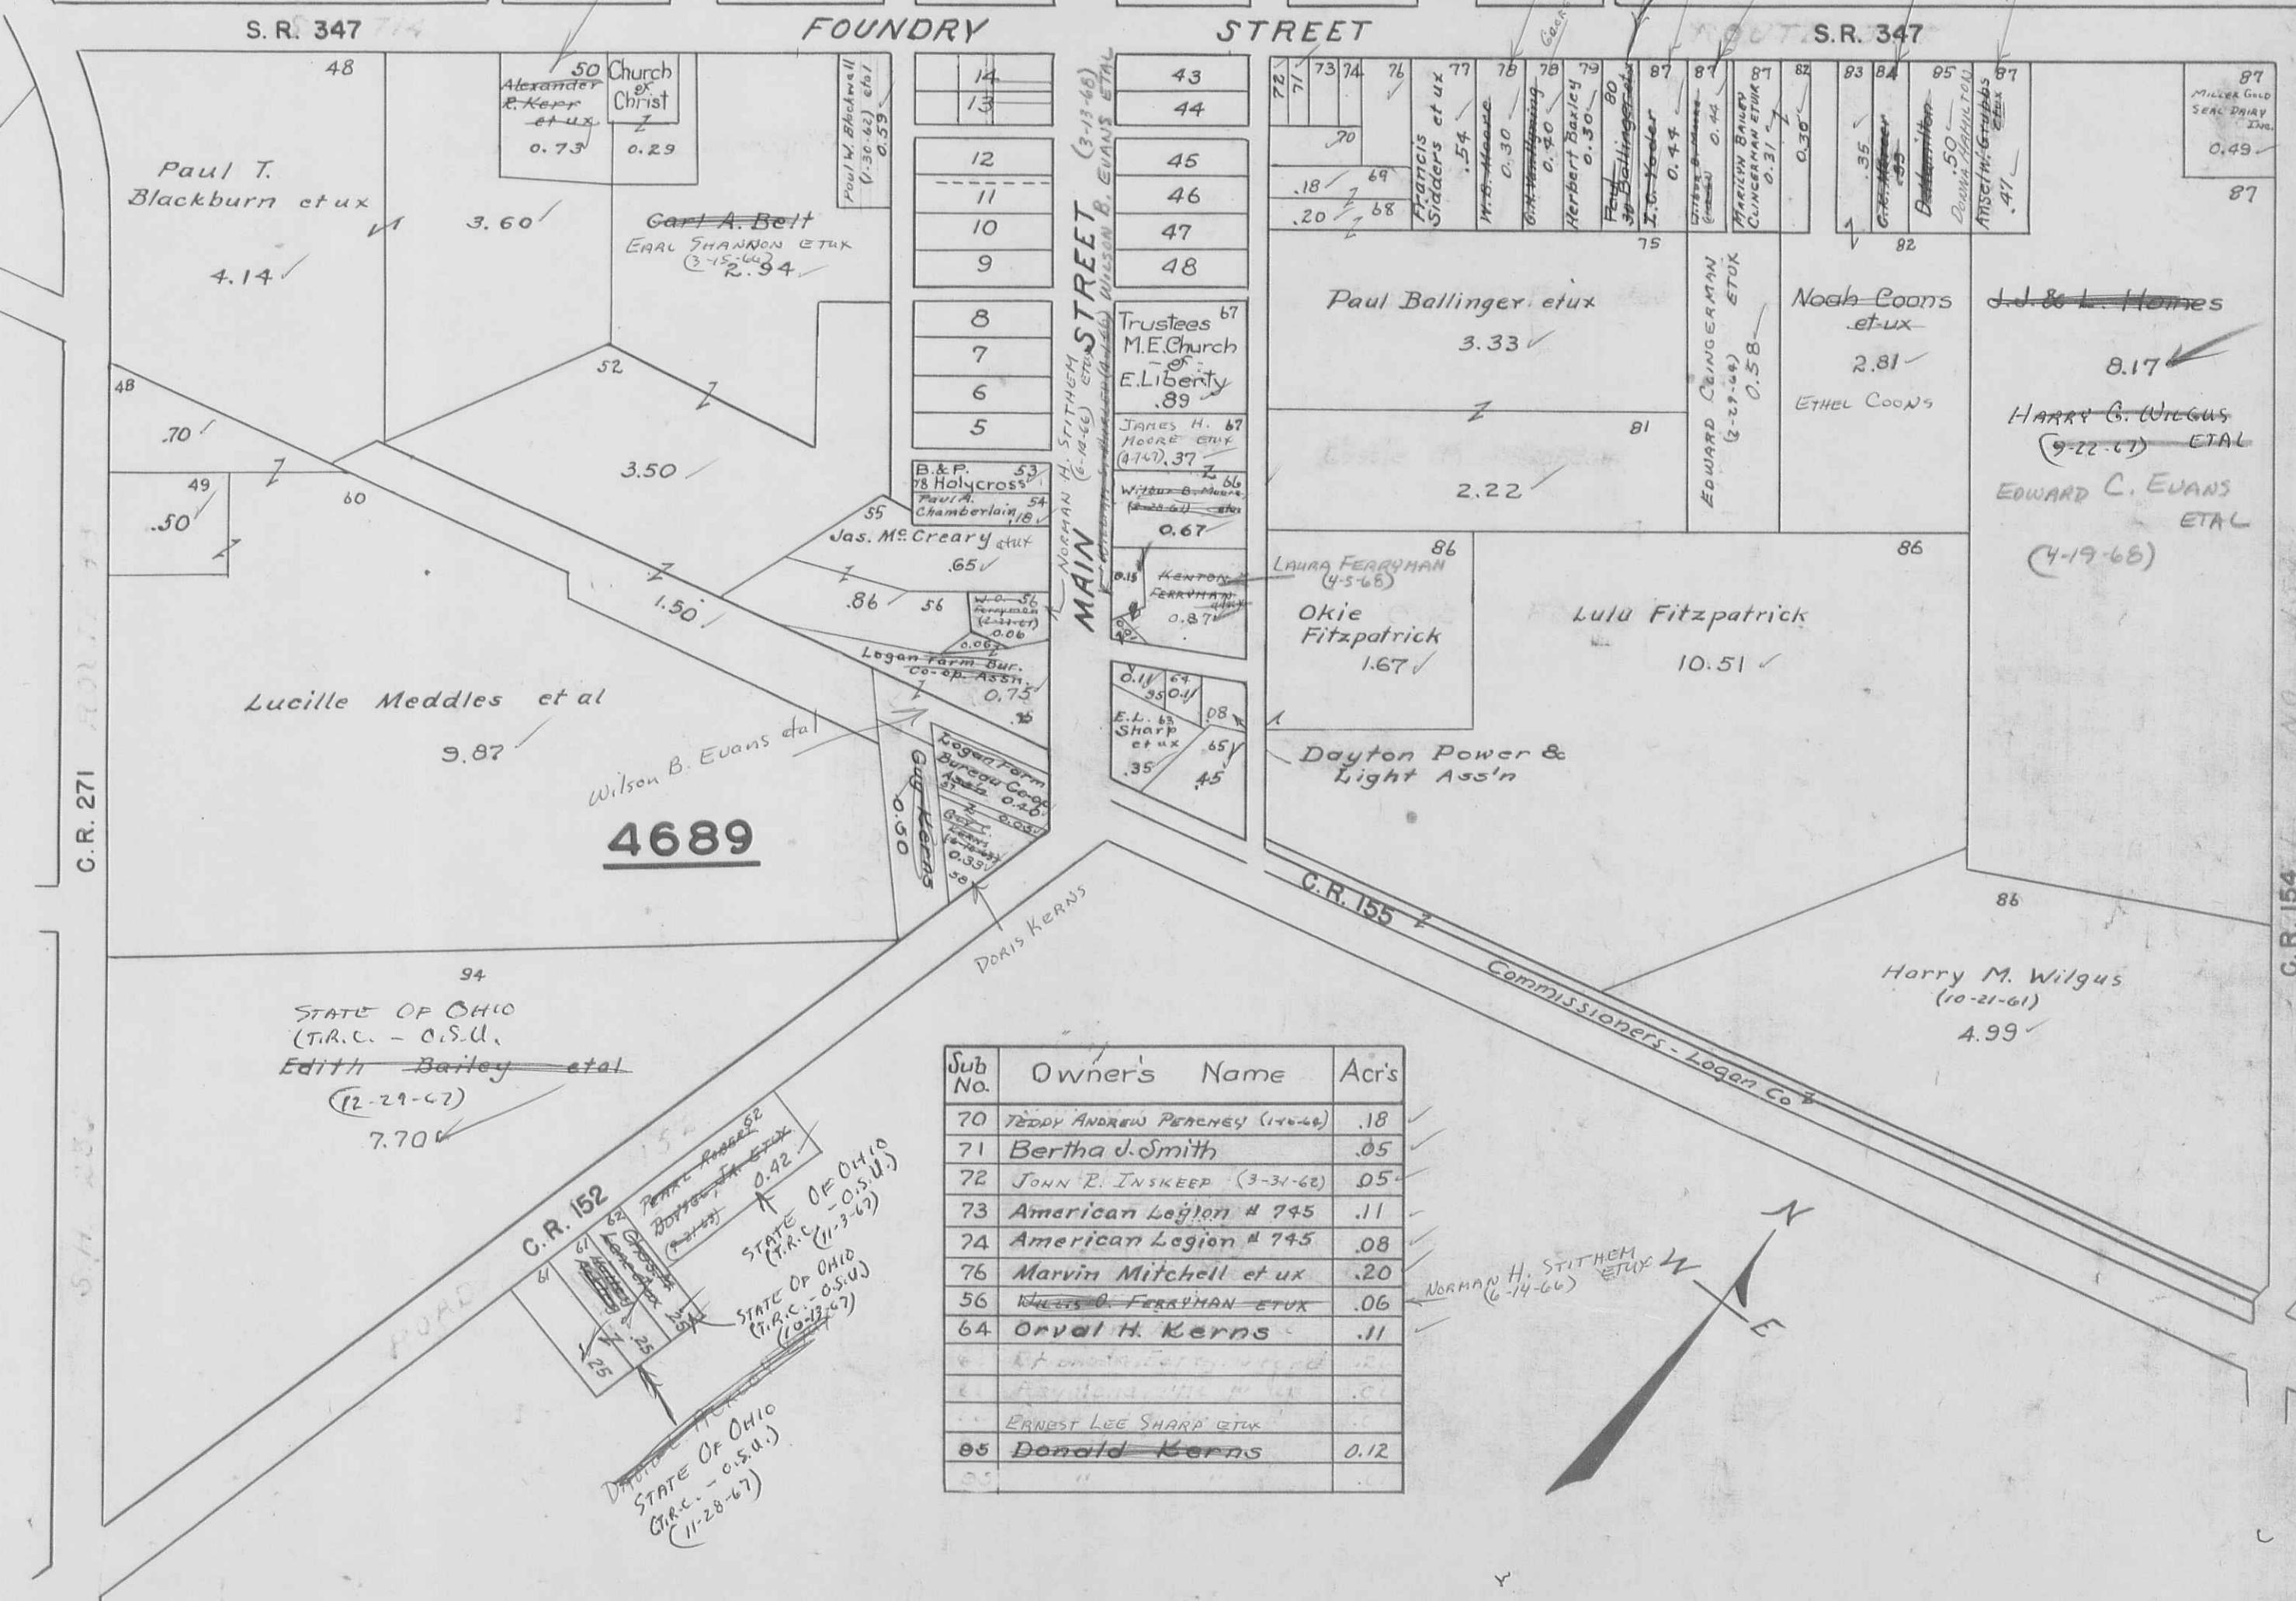

PERRY

TOWNSHIP

PAGE 29

VIRGINIA MILITARY SURVEY 4210
GREENFIELD

SCALE 150 FEET TO THE INCH

MAIN STREET								
T.R. 13								
1	2	3	4	5	6	7	8	9
45 10	65	"	"	"	"	"	"	55
C.R. 2								C.R. 2
55	"	"	"	"	"	"	"	55
18	17	16	15	14	13	12	11	10
55	55	19						
55	20	220						
1.16 a								
Charles E. Endsley								
145								

(Ralph T. Akey - (See Page 4))

Roy Clapsaddle 55
0.20