Smith Survey
Belle center

Elizabeth

55.9

150.15

2.05'

179-60
90-29
-31

90-29
89-23
90-44
89-24
358 12 0

Buckeye 60'

491.50'

BK 3
Pg 26

INDEXED ON MAP
3356

150.5'

2.0'

56.0'

150.5

Center

Dodson Detail 10/30/58

Chisel mark 2

St. 60'

5.60'

2.2'

150.15

2.2'

90-29½

127.5'

89-31

105.0

89-29

Bath

3.5'

1.6.11

12.2'

105.0

150.32
N. 40°E

Plat = 490.0'

491.50'

150.38

89-23

20'

30

1.05
490

=,00210'

150.75'

Tomahawk St.

60'

190.77'

Chisel mark

150.5

1.85

1.45

30

30

60'

56.3'

5.7.1

80-58
87-57
89-24
101-42
357-181

179-60
78-18
101-42

60.00
55.65
4.35

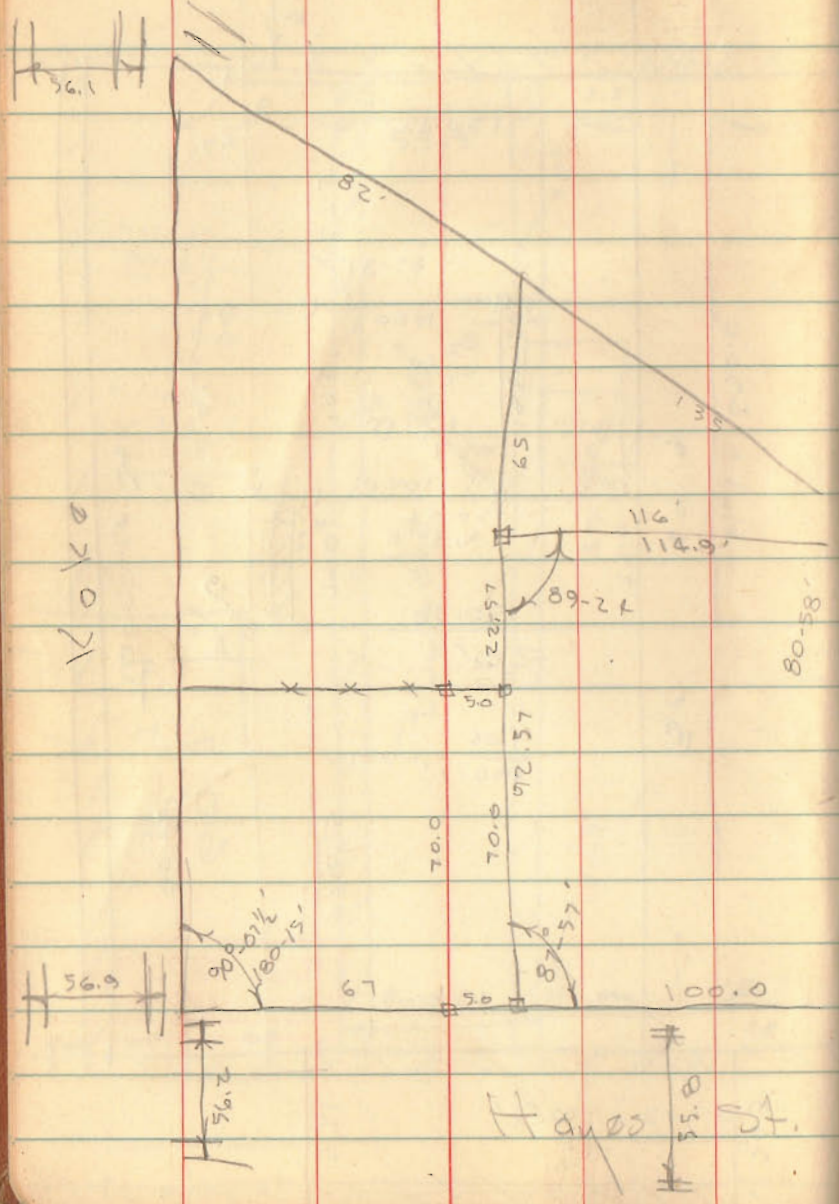

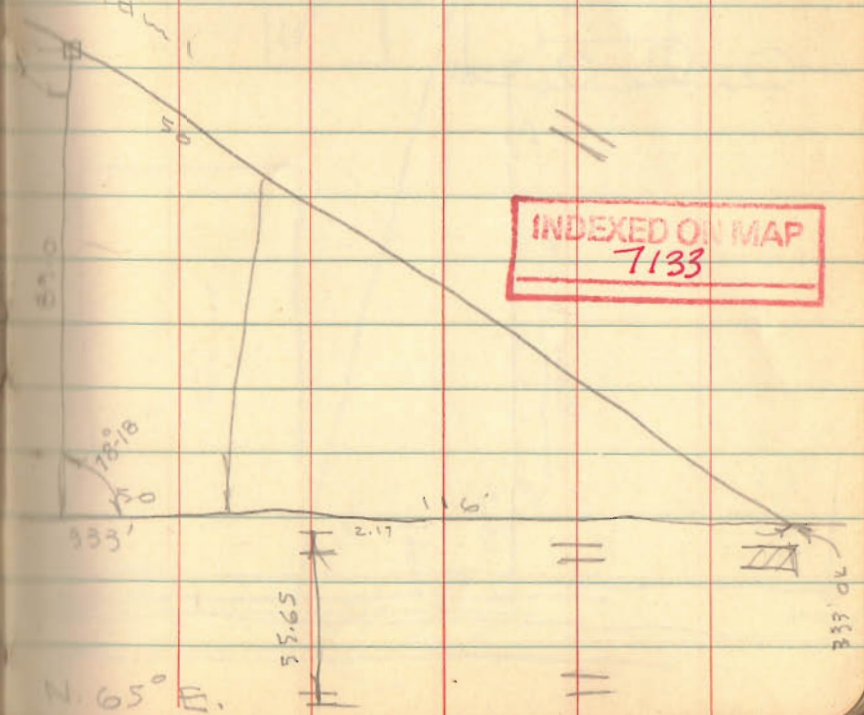

INDEXED ON MAP
7133

Carpenter Stokes | Survey Twp

See Co. Eng. F.B. # 589 pg. 32

INDEXED ON MAP
3158

Dodson Gaslin | Feb. 7, 1959 | 30° | 6

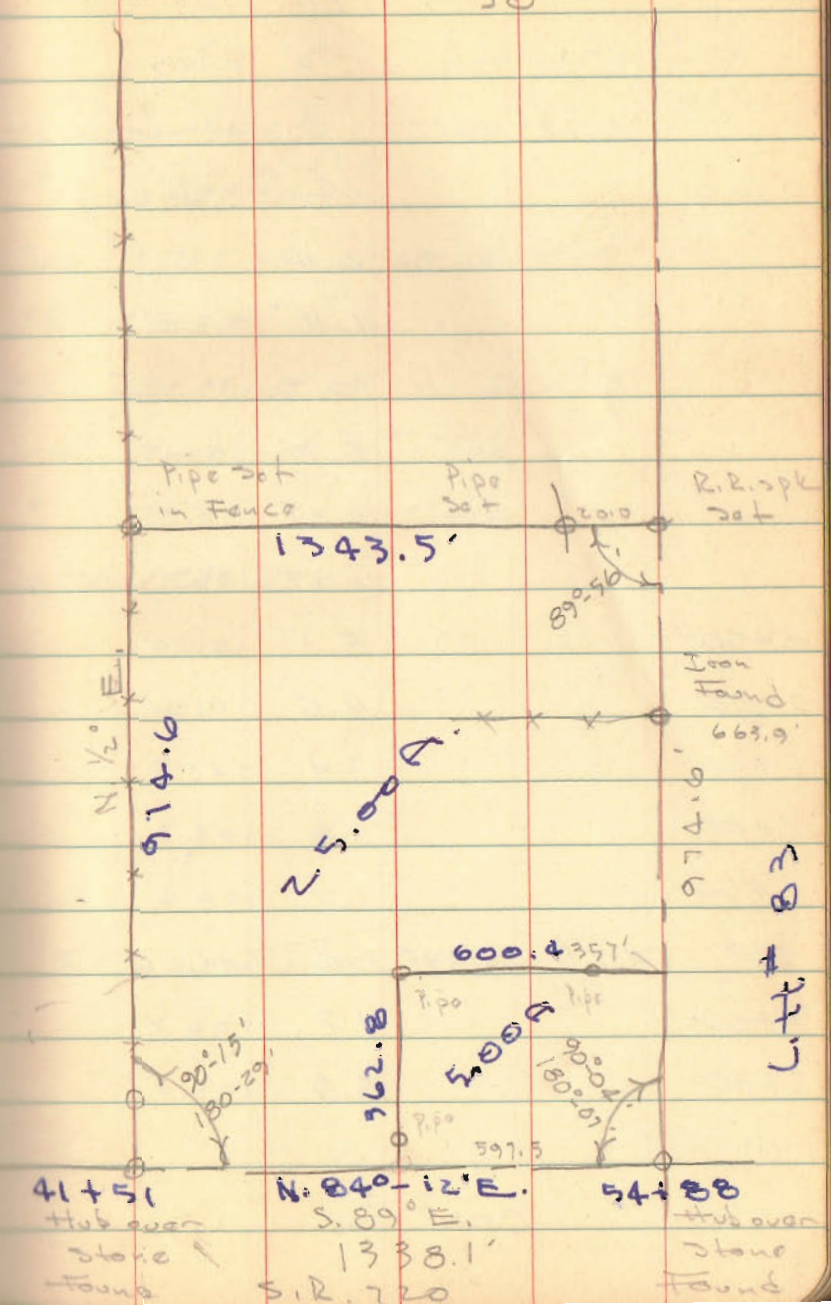

Campbell Survey
Main St.
Belle Center

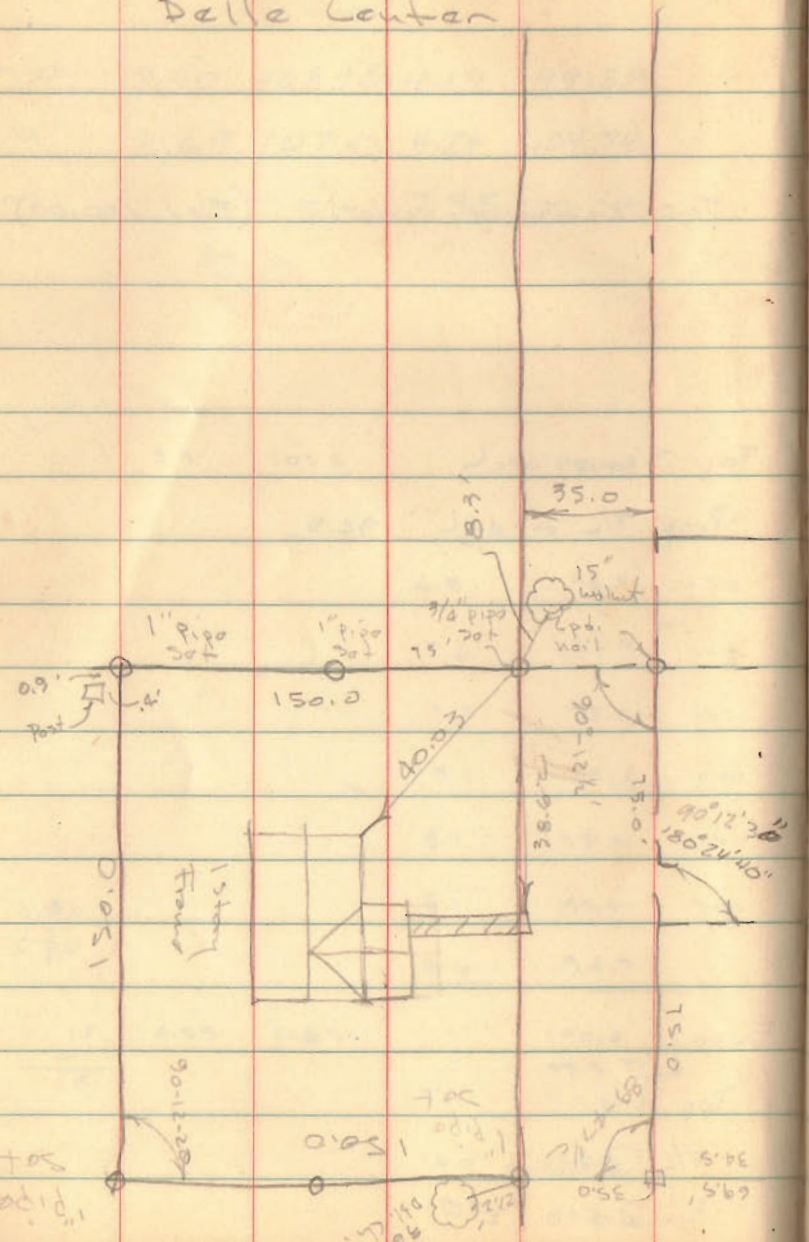

Dodson
Goodlin

40

179-60
90-12½
89-47½

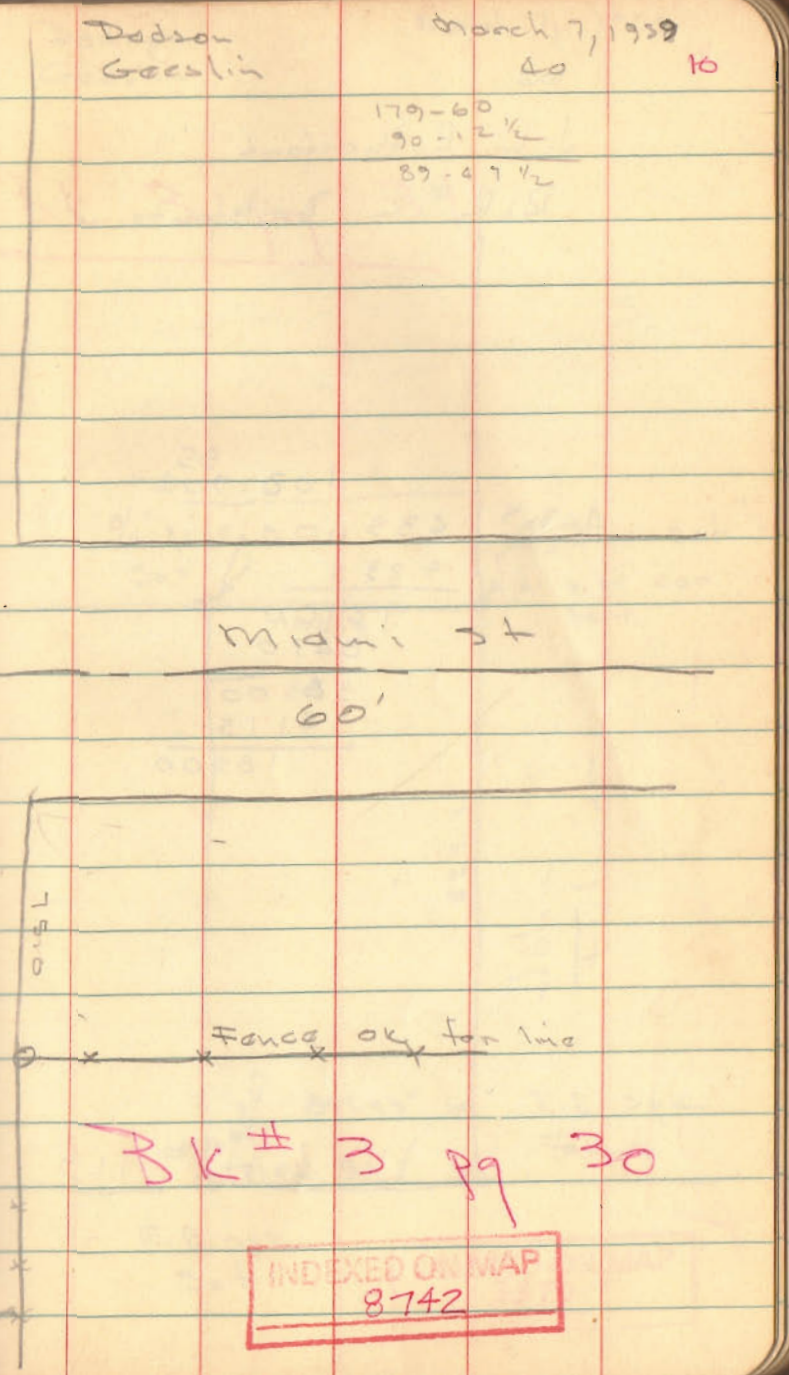

BK # 3 Pg 30

INDEXED ON MAP
8742

J. L. Rutherford

R. R ± 2 Bellefountaine

102.85

423.5 | 43560.00

4235

12100

8470

38300

38115

18500

L. H. # 113

Dodson
Geeslin

March 7, 1959

40°

Bk 3 pg 31

3/4" pipe set

3/4" pipe set
W. side cor.
post

102.9

423.5

60 ft. to
center of
road

90°-07'

89°-53'

102.93'

R.R. spk
found

R.R. spk
set

INDEXED ON MAP
3370

Steinmetz Survey

U.M.S. 12168

McArthur Twp.

L.H.# 95 R/W 80' FB# 572/61

Mons - 1+00 6+00 30+00 -25+00

19+00 -13+90

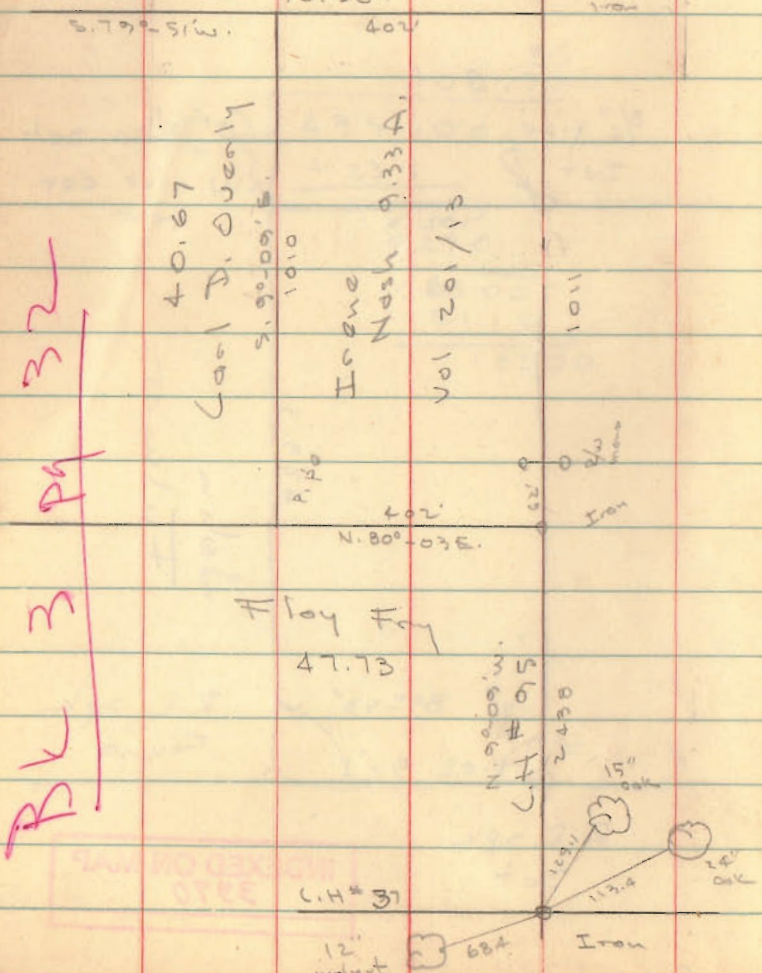

Dodson
Geelin

March 14, 1959
50°
nice day

12

Iron evidently set on Fence line

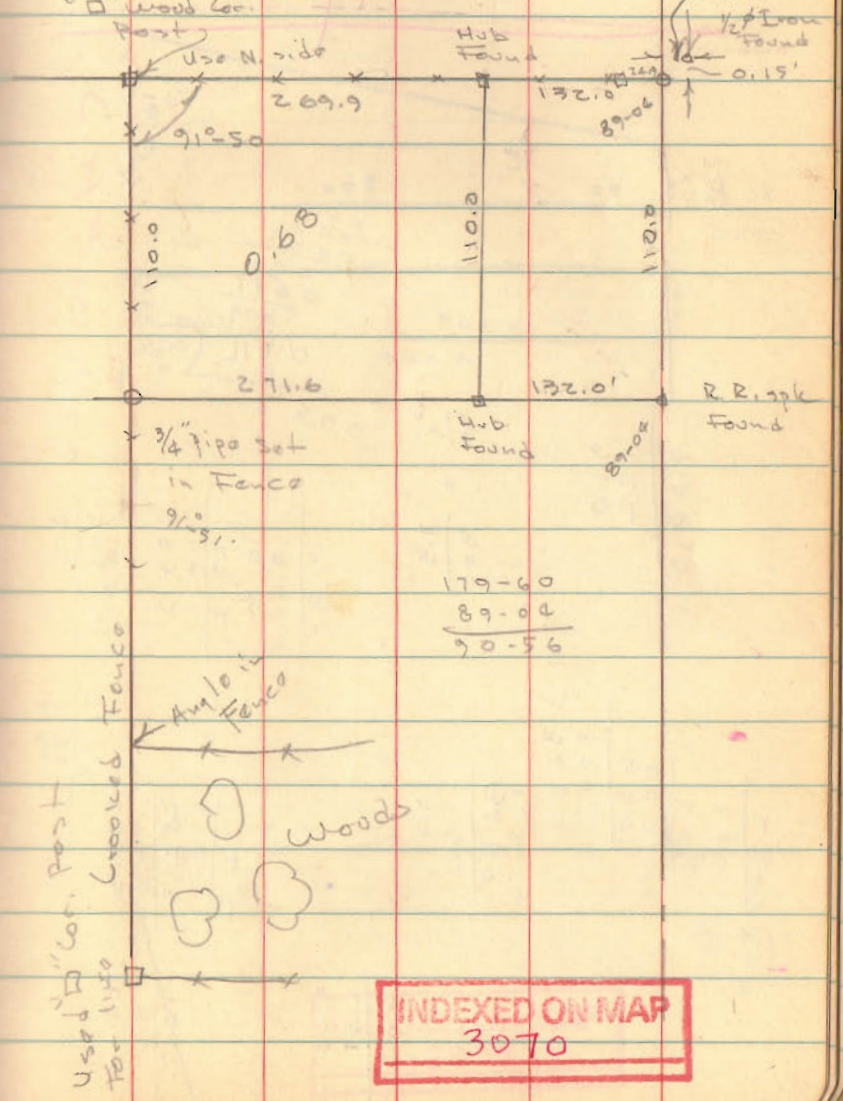

INDEXED ON MAP
3070

BK 3 Pg 50

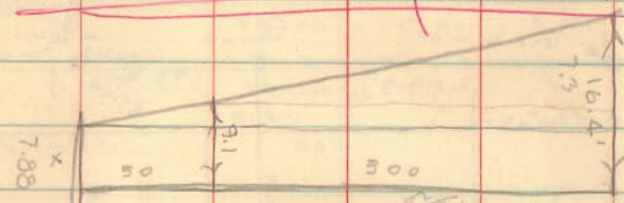

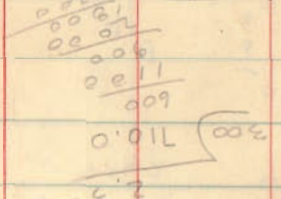

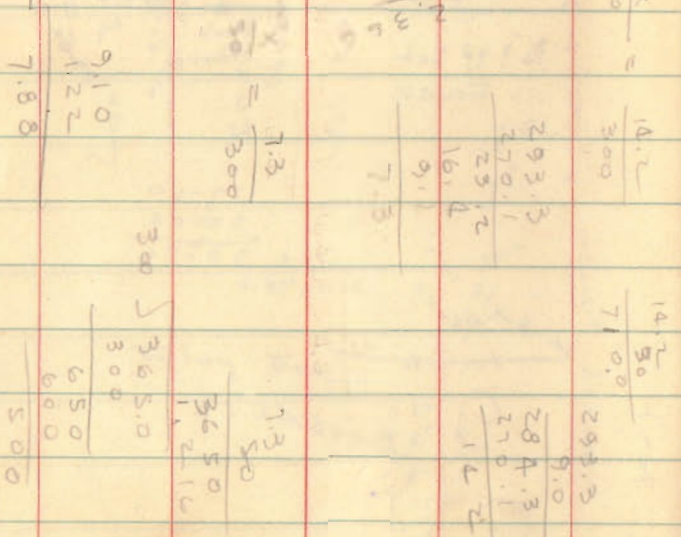

RANNO DEED

Hostetler Survey

April 18, 1958

Dodge - Geesli

C.I. # 6

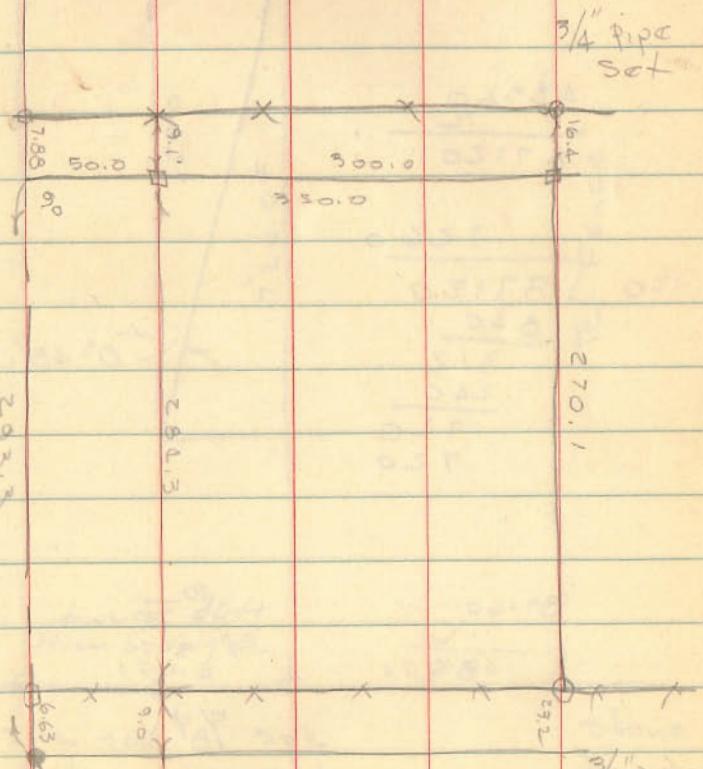

INDEXED ON MAP
2854

W. R. Lyons
920 N. Main

X = Sec. 48½' × 726

1.0001
726
60006
20002
70007

7 | 26.07 | 26

43560 / 2 / 87120

726.0
120) 87120
840
312
240
720
720

726.0

0°-48½'

89-60
11½
48½

Hub Found
Replaced with
5/8" bar.

179-60
89-11½
90-48½

INDEXED ON MAP
3050

April 25, 1959
Dodson - Geeslin

14

R Fence

77.5'
79.0

5/8" ϕ bar Set

90-48½

5/8" ϕ bar Set

726.07

Fence

R

89°-11½'
179-23
120.0

120.0

spk Set

spk Set

stone found

S. R. 274

Lot 41

Seminole Isl

Bk 3 pg 53

INDEXED ON MAP
6397

May 8, 58

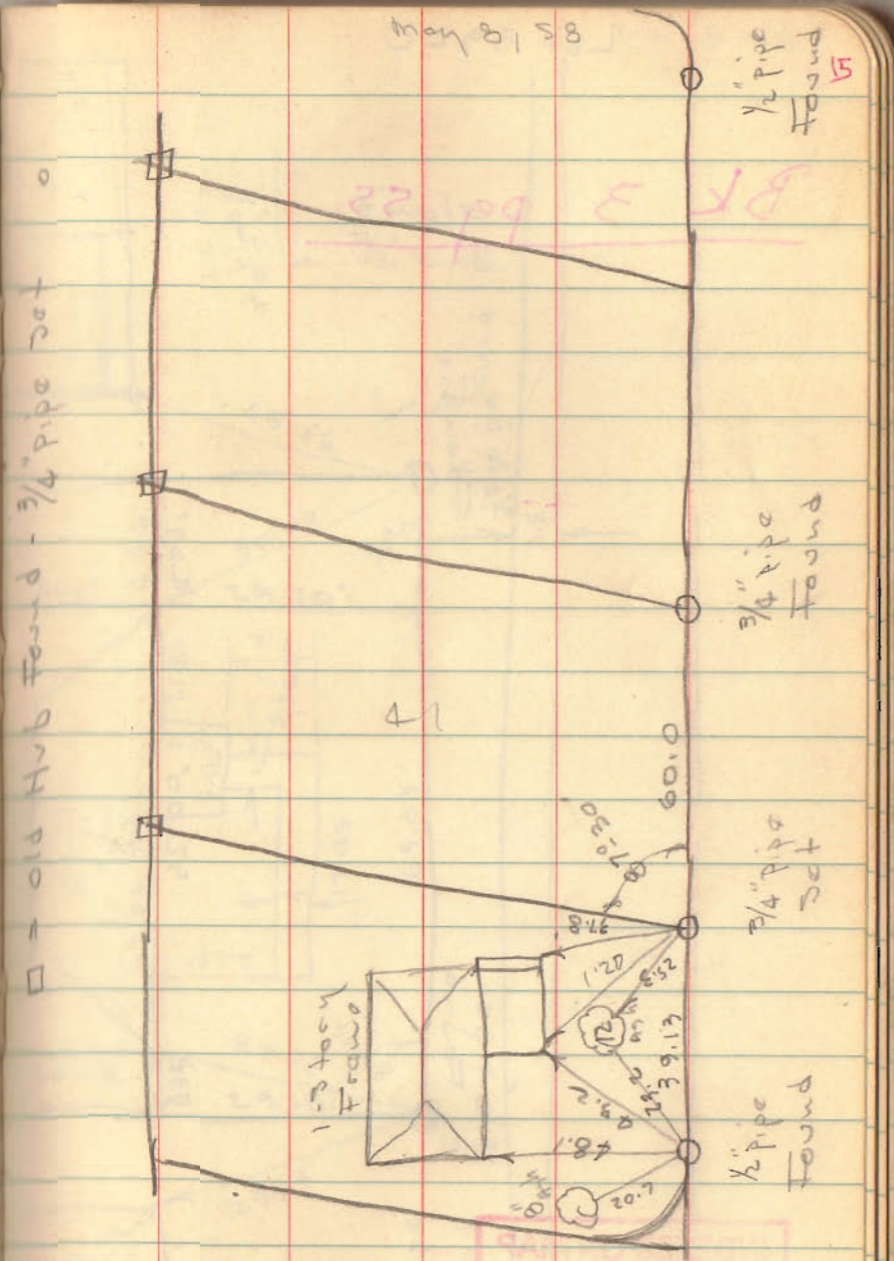

Lot 3920

May 18, 58

16

Bk 3 pg 55

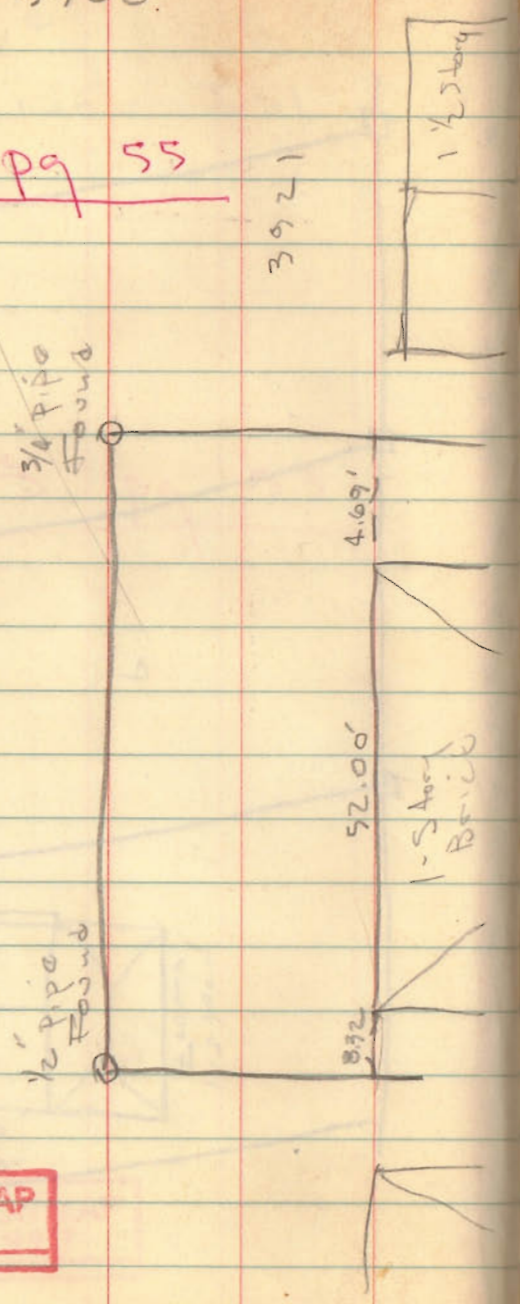

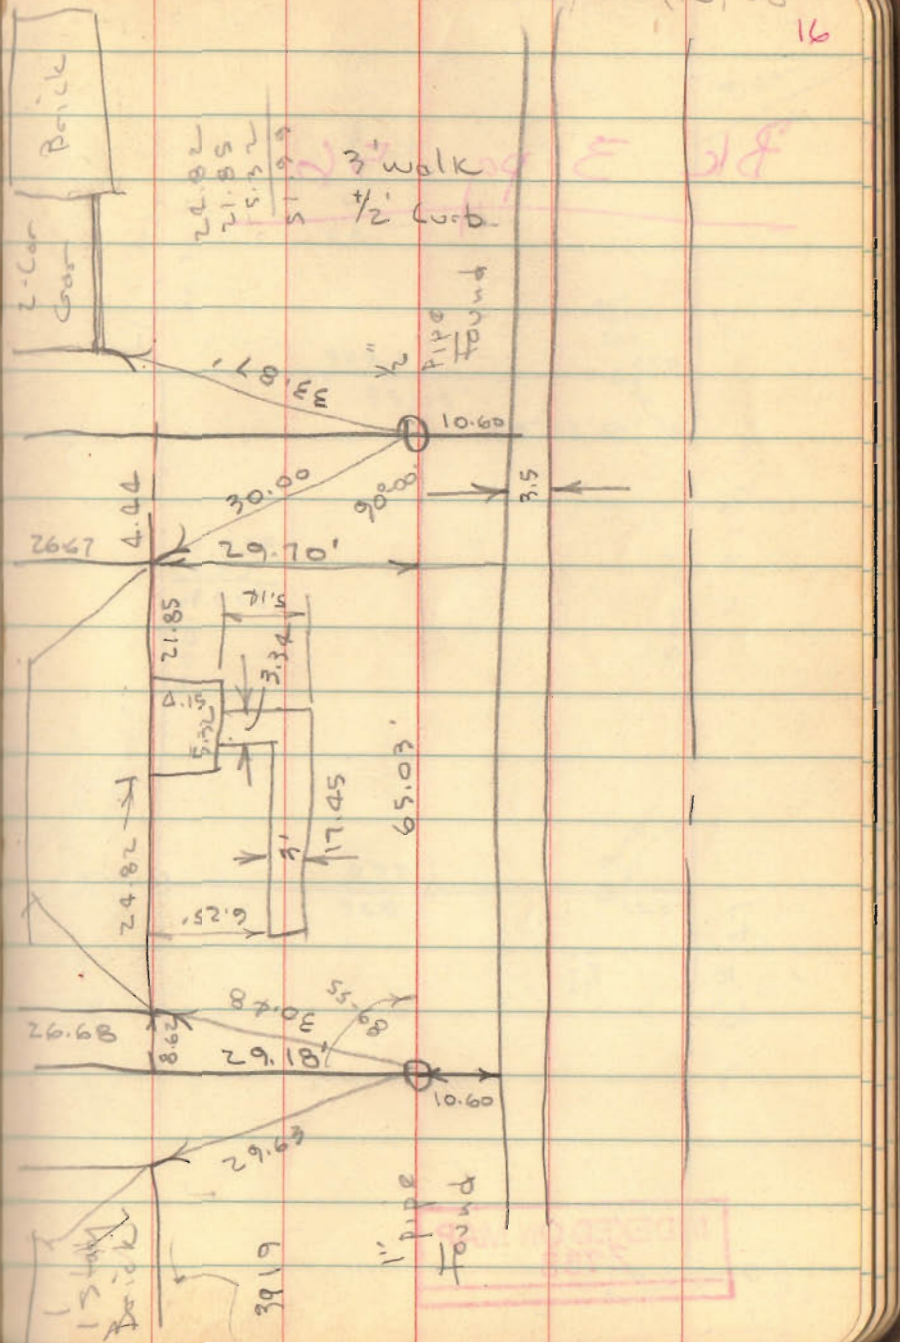

INDEXED ON MAP
2580

Bk 3 pg 56

328.3
25.0
353.3

INDEXED ON MAP
2788

May 16, 1959

17

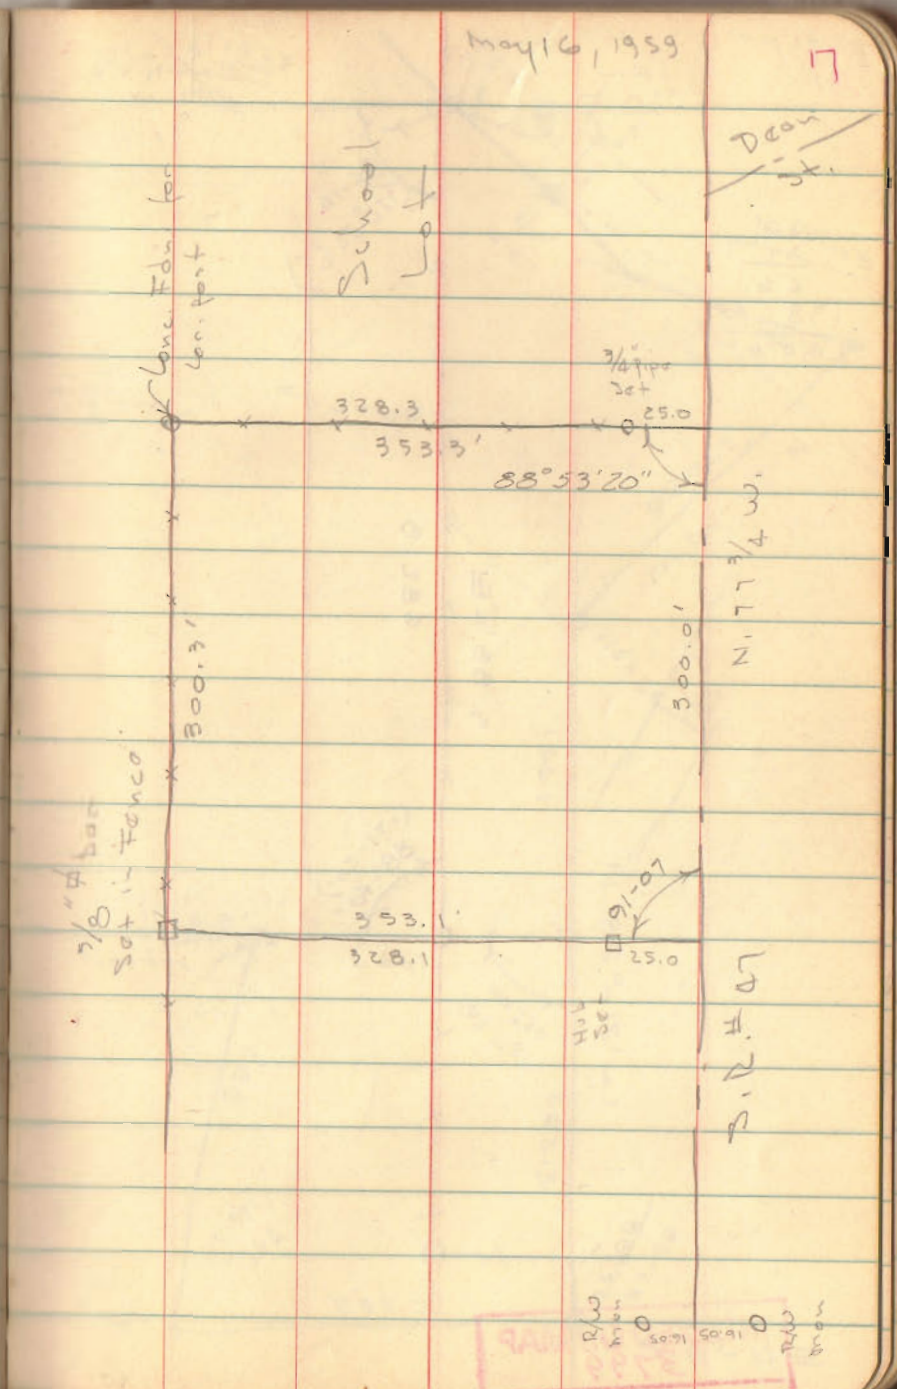

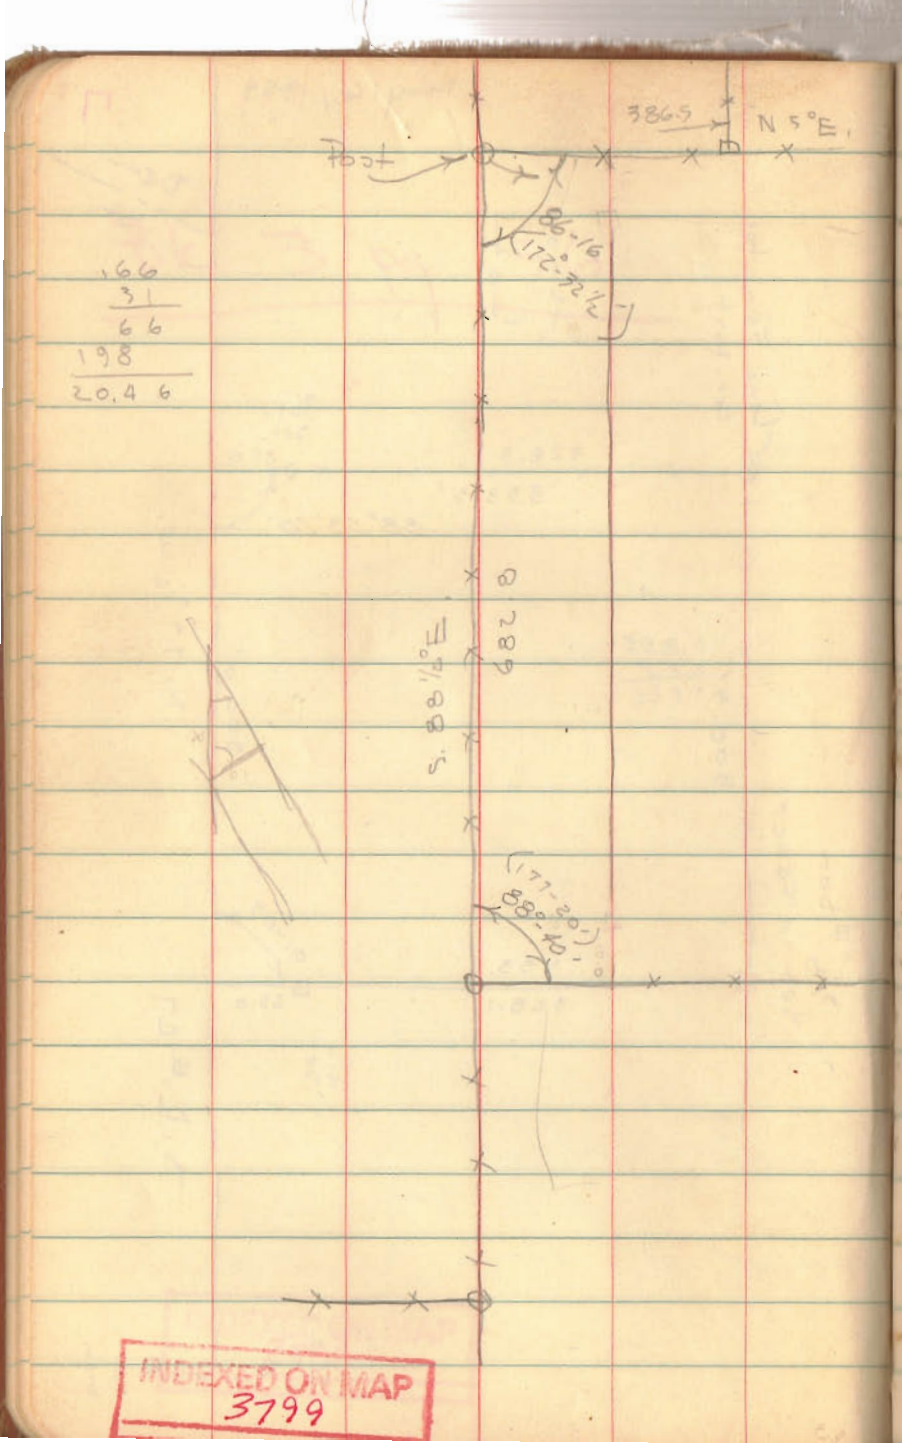

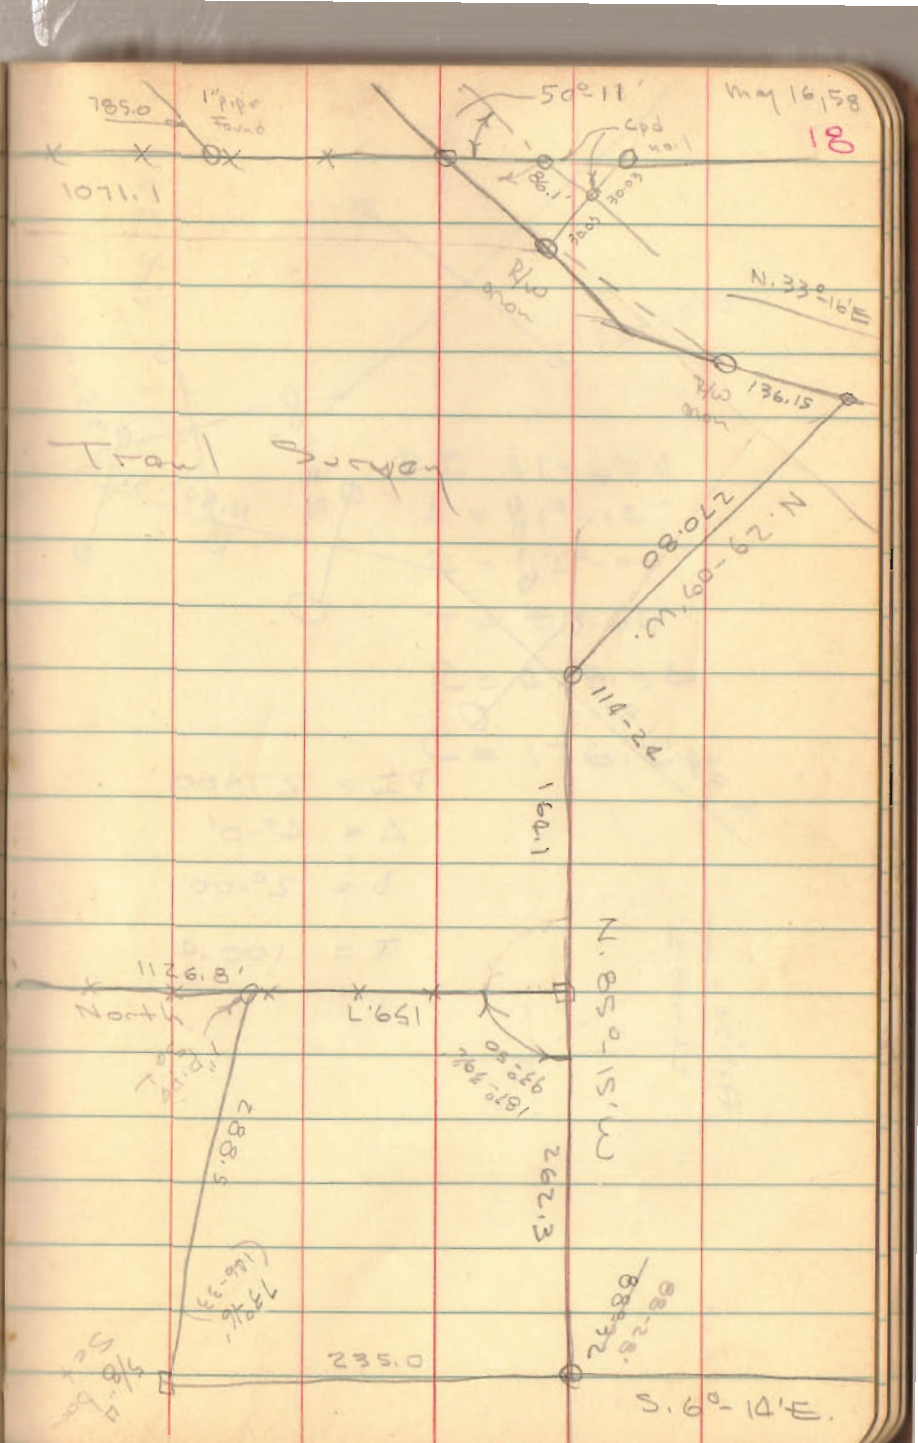

INDEXED ON MAP
3799

Bk 3 Pg 51

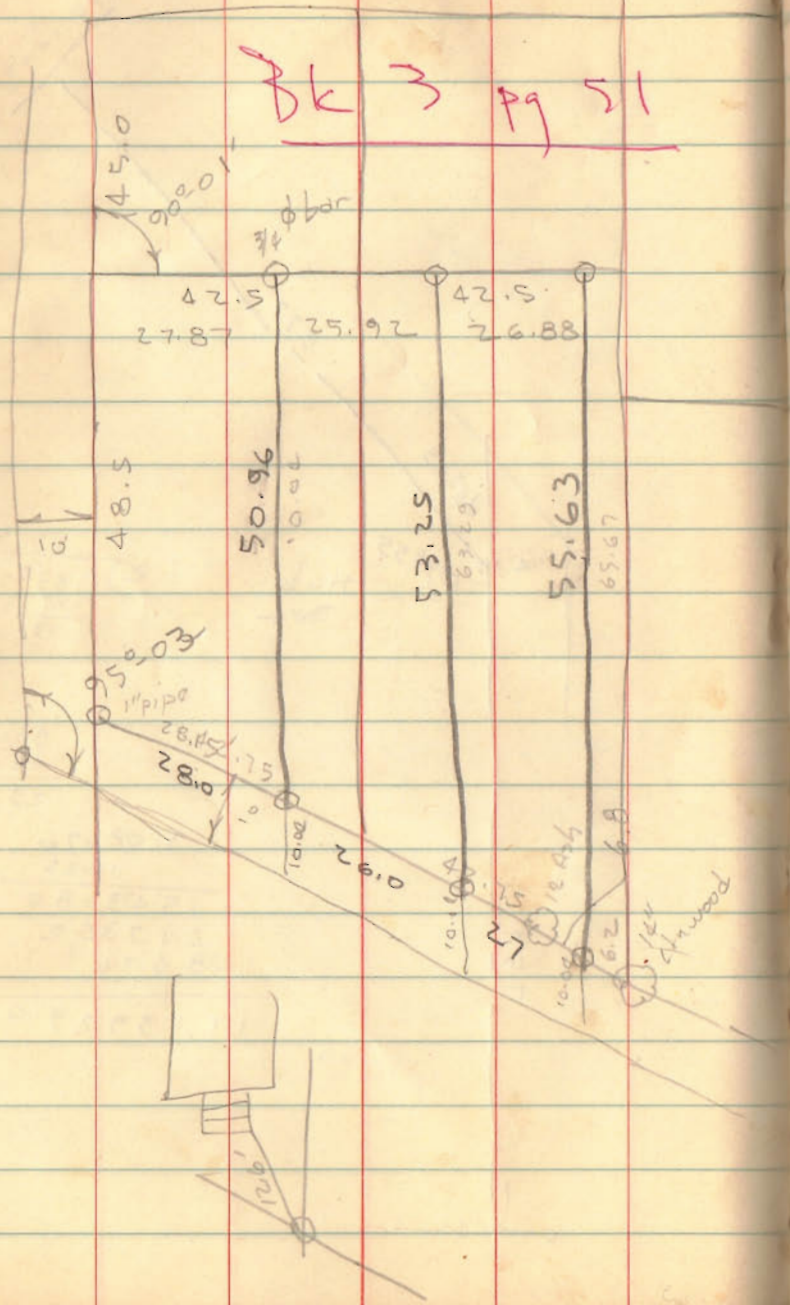

53.75
10.94
64.69
93.5
45.0
48.5

28
26
54

81
54
27

42.75
85.50
54.00
31.50

221
27.87
25.92
26.88
80.67
50.0

47-31.5
95.03
8 61
15
42-28.5

89-60
47-31.5
42-28.5

179-60
95-03
84-57
6-03

INDEXED ON MAP
3250

Mc Coy
Russells Pt

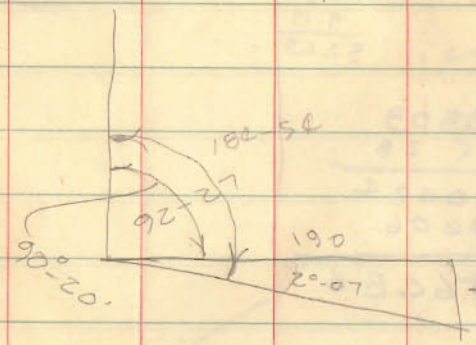

.03684
190) 7.00000
570
1300
1140
1600
1520
800
760

INDEXED ON MAP
9617

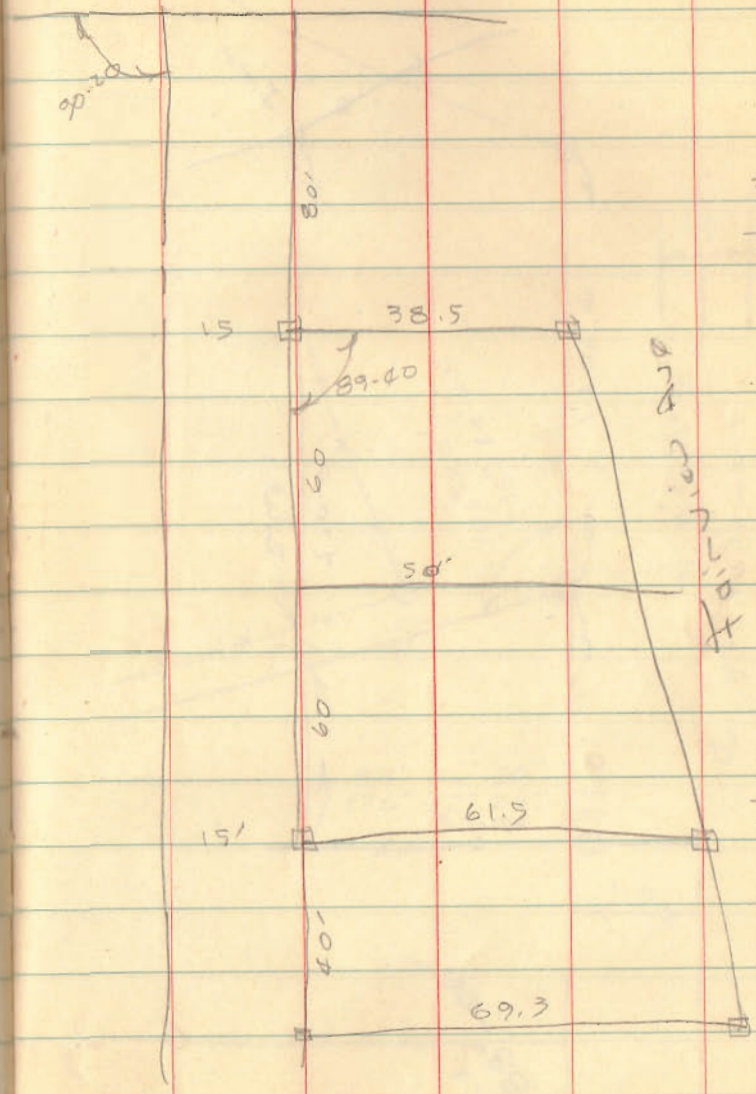

Geo. Sowell

13.19.8
1250
69.8

82.5
11
93.5

82.5
19.0
63.5

300.0
93.5
206.5

89-60
59.08½
30-51½

Sec. 1,164805
101
Sec. 30-51½ = 1,164905

1,164905
300
349,471500

34.95
12.81
22.14

1.164905
11
1,164905
11 64905
12,813955

179-60
59-08½
120-51½ 349.47
34.95
314.52

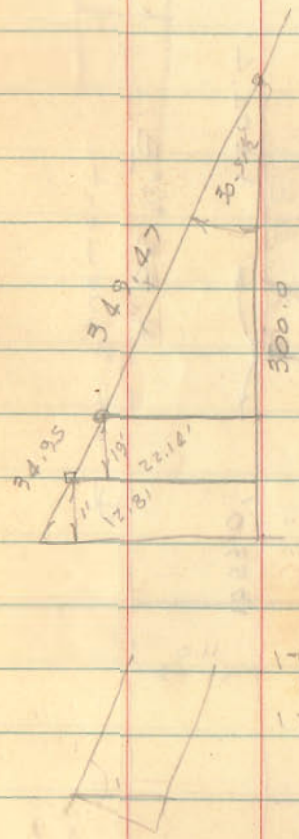

INDEXED ON MAP
3400

June 13, 1959

25

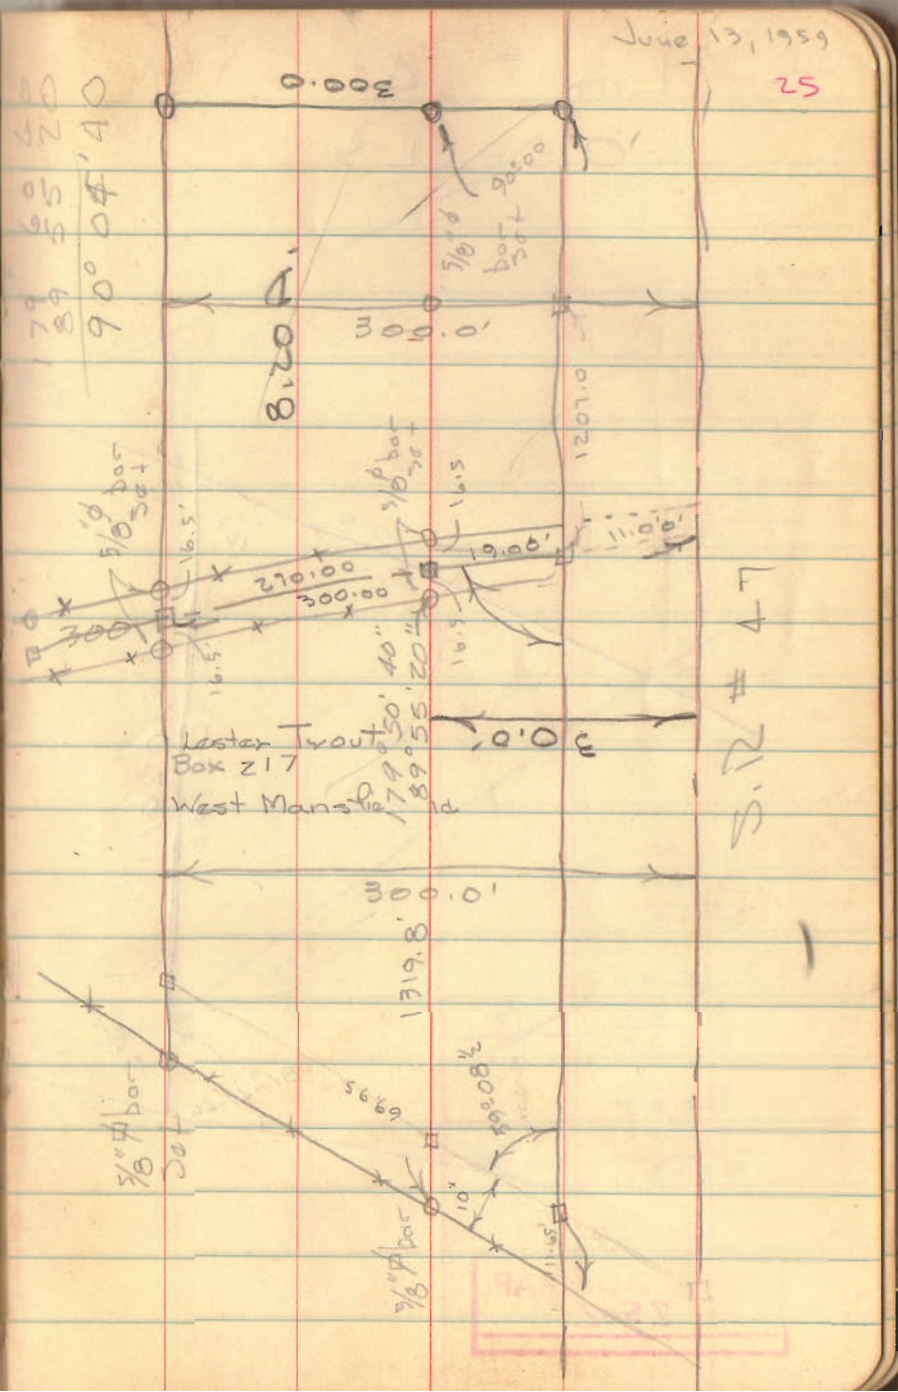

25

Lot # 4

O'DELLS

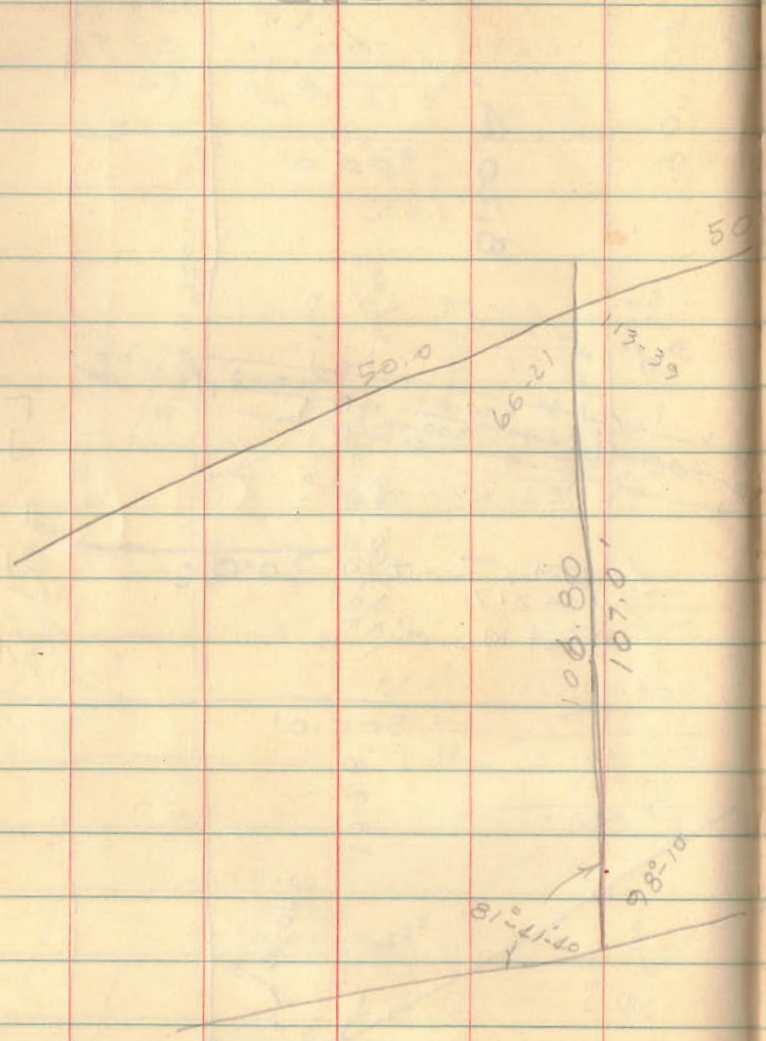

INDEXED ON MAP
2502

26

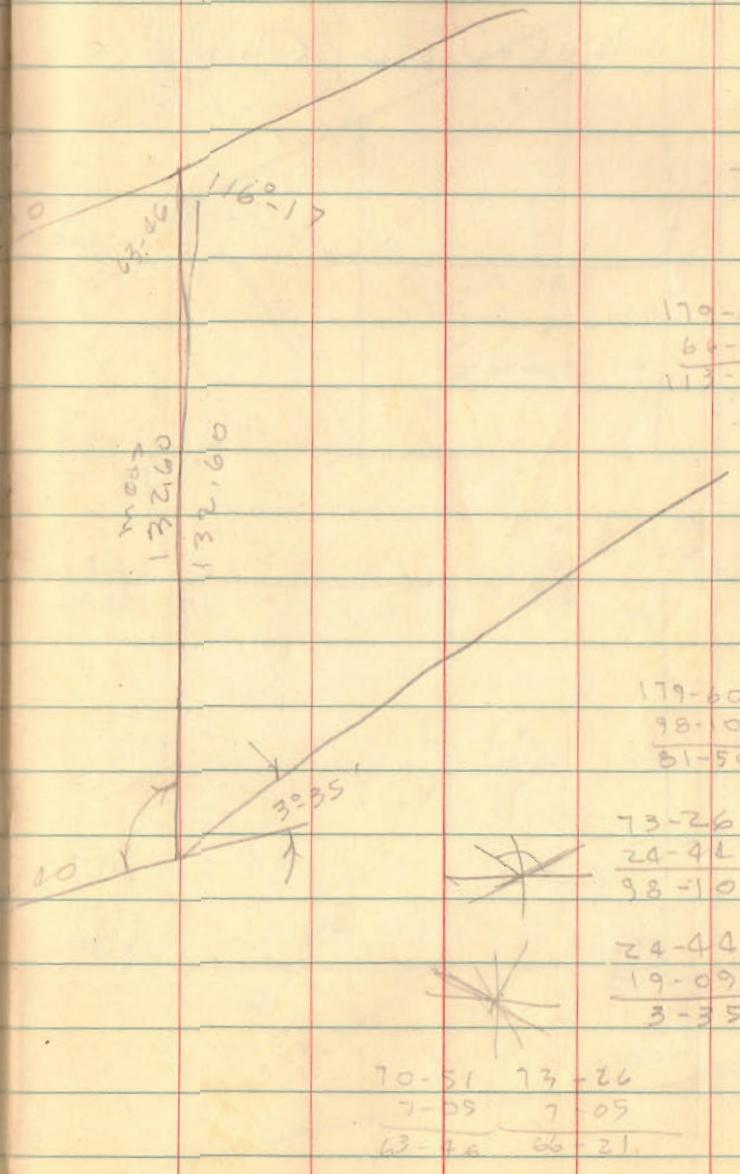

179-60
63-46
116-14

179-60
66-21
113-39

179-60
98-10
81-50

73-26
24-44
98-10

24-44
19-09
3-35

70-51
7-05
63-46

73-26
7-05
66-21

Thomas Survey

Sec. 7, T-2, R-1E

Thomas Deed

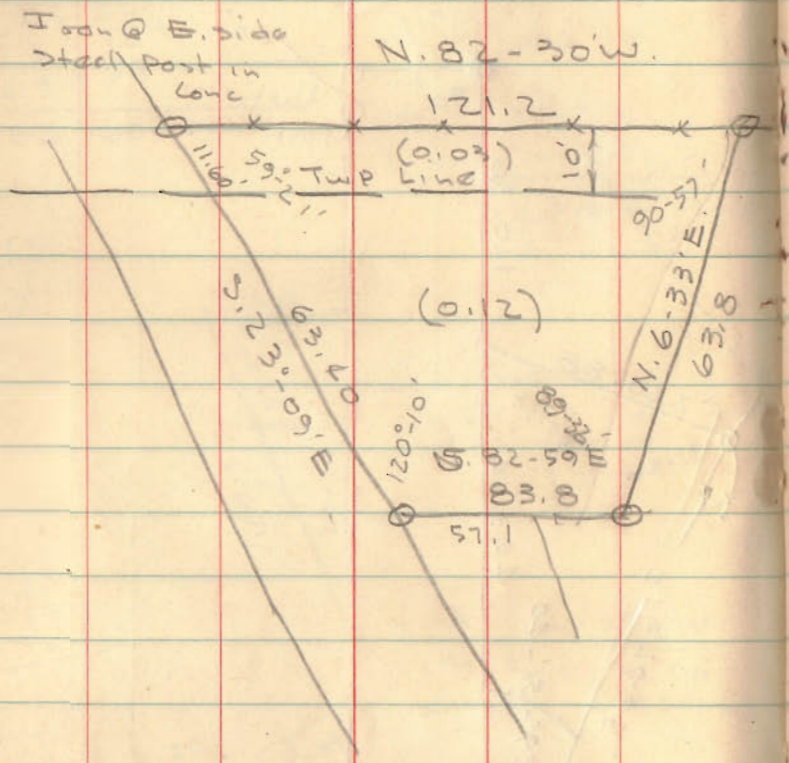

See Inskeep Bk 12 pg 63

Bk 3 pg 61

Dodson
Geeslin

July 7, 1959

29

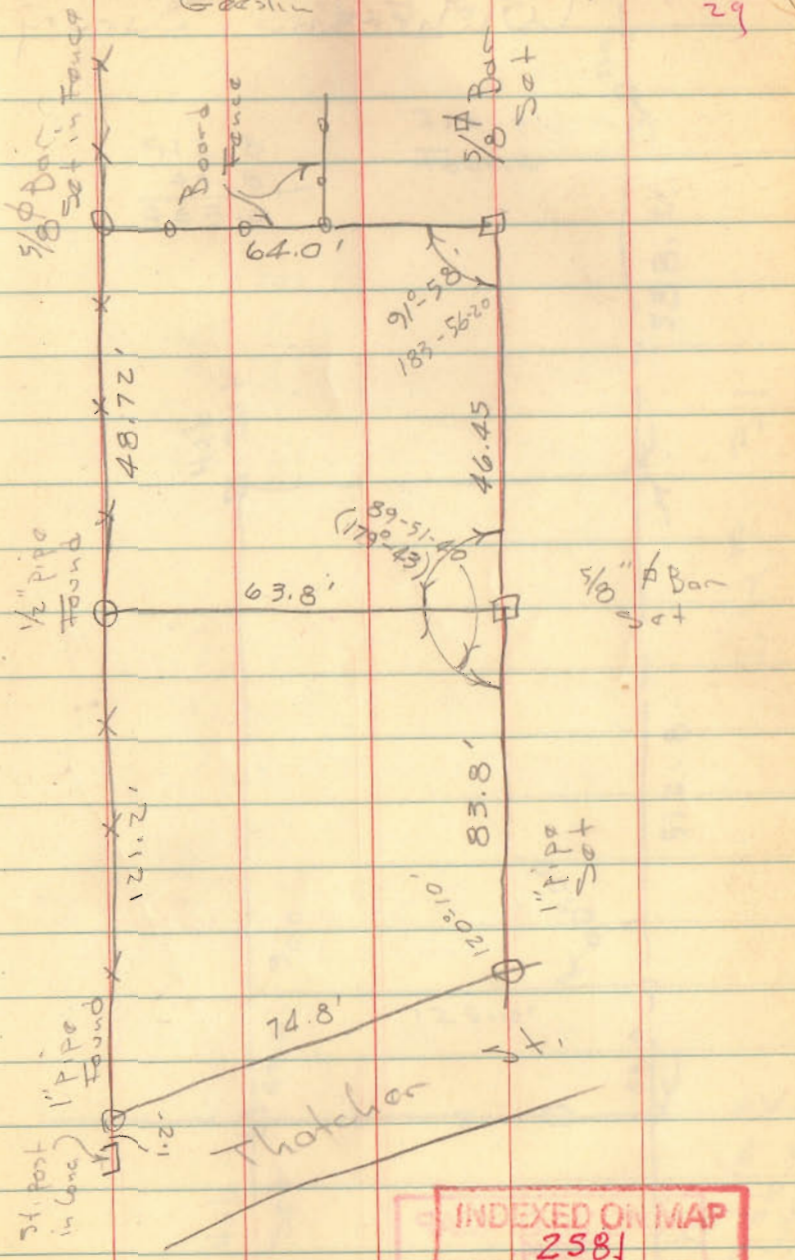

INDEXED ON MAP
2581

Wichenson Survey

INDEXED ON MAP
3214

Lot #45

512.8
49.8
463.0

Iron pin found

33.0

588.2'

Hub 58

Lot #31

512.8

90°00'

125.0'

49.9

48.9

Hub 58

Dog leg Sec. line to wire fence

Fort Survey

Rush Creek Twp.

1.007 51
25
503755
201502
25187 75

1.000 21
25
500120
20 0048

Bk 3 pg 62

INDEXED ON MAP
3372

July 10, 59
31

Dodson
Geolin
Fort

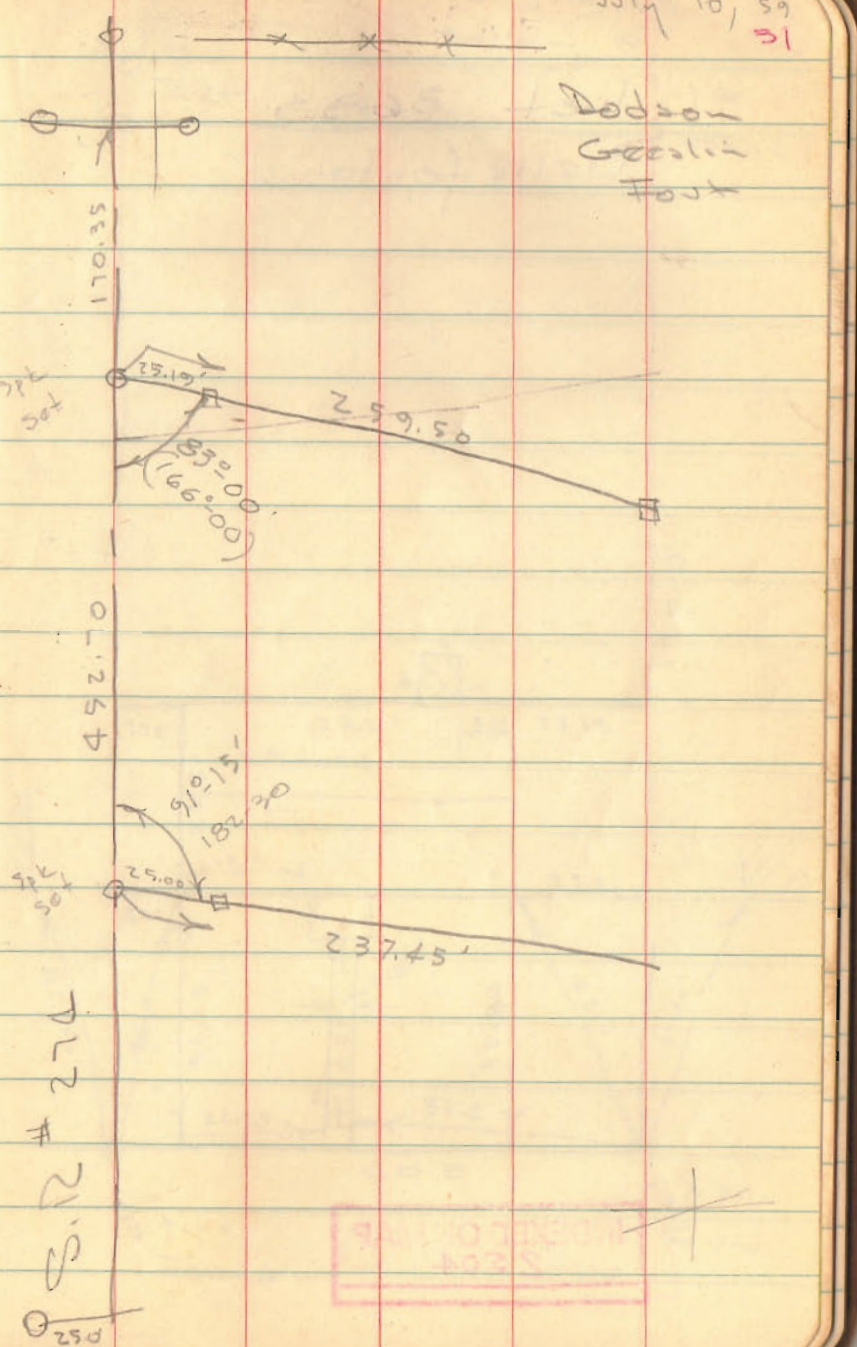

Lot 3633
Belle fontaine

INDEXED ON MAP
2504

July 15, 59
Dodson 80°
Gilbert

32

5/8 Bar Set

3/4" pipe Found

59.8

60.0

4'

28.5'

7.72

8.63

29.78

24.5'

1 story Frame

12.3'

23.21

8.28

4'

4'

2.80

35.15

28.85

35.80

22.25

35.2'

42.7'

36.4'

3/4" Pipe Found

Coulter Ave

3/4" Pipe Found

Survey of lot # 189
Orchard Isl

Dodson - Goodin
July 18, 1959

See Co. Eng. Bk # 5090 pg. 36

For Andrew F. Woerl
Box 101
Russells Point

INDEXED ON MAP
1649

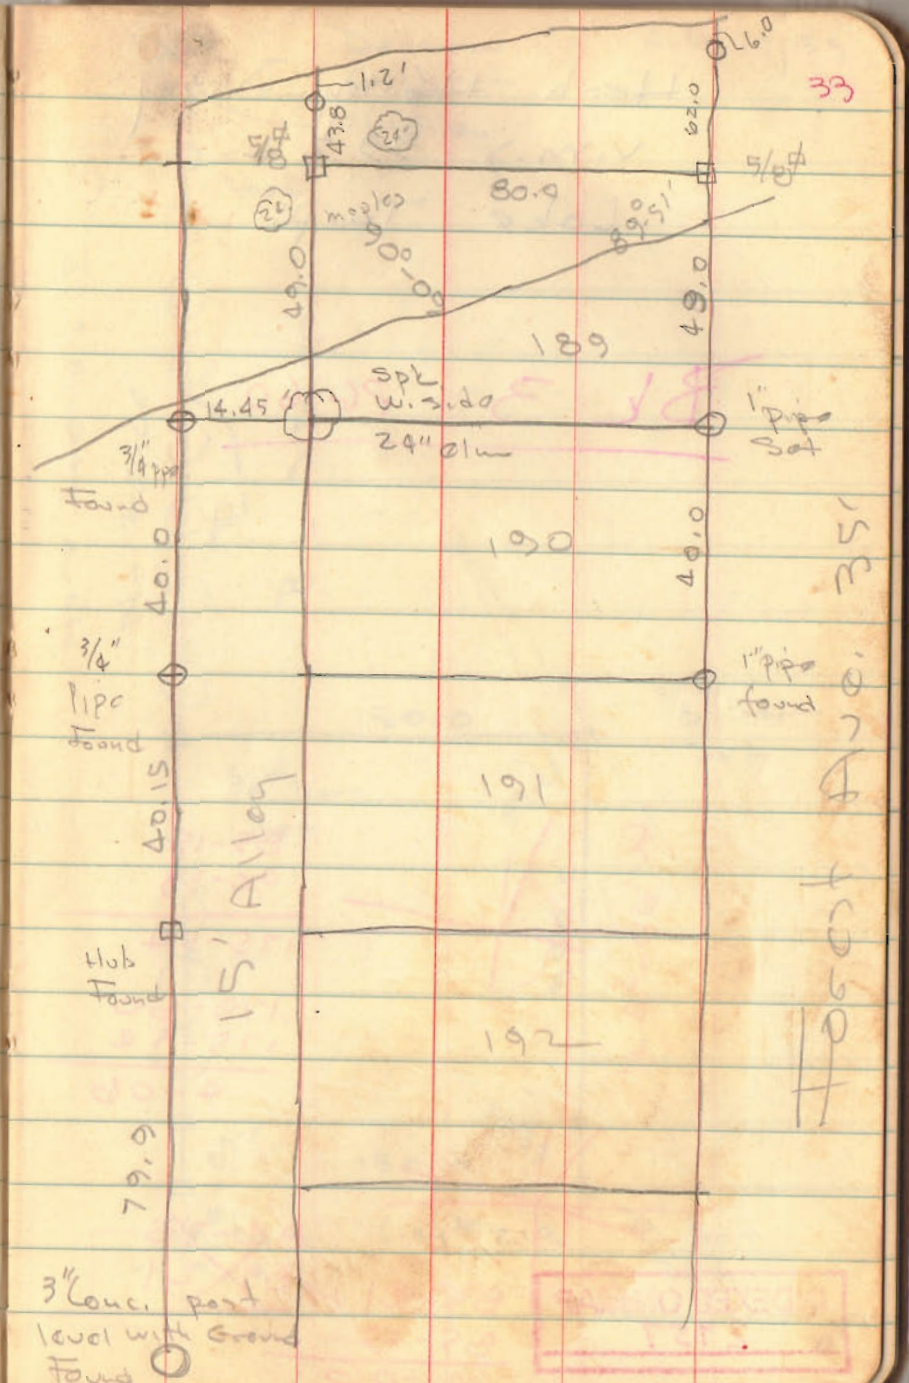

Herb Holley Survey

V.M.S 3322

Lake Twp.

Bk 3 PG 60

85-15
90-39
175-54

179-60
175-54
4-06

84-75
89-21

89-21
85-15
4-06

INDEXED ON MAP
2957

Dodson
Gilbert
Holley

July 17, 59

34

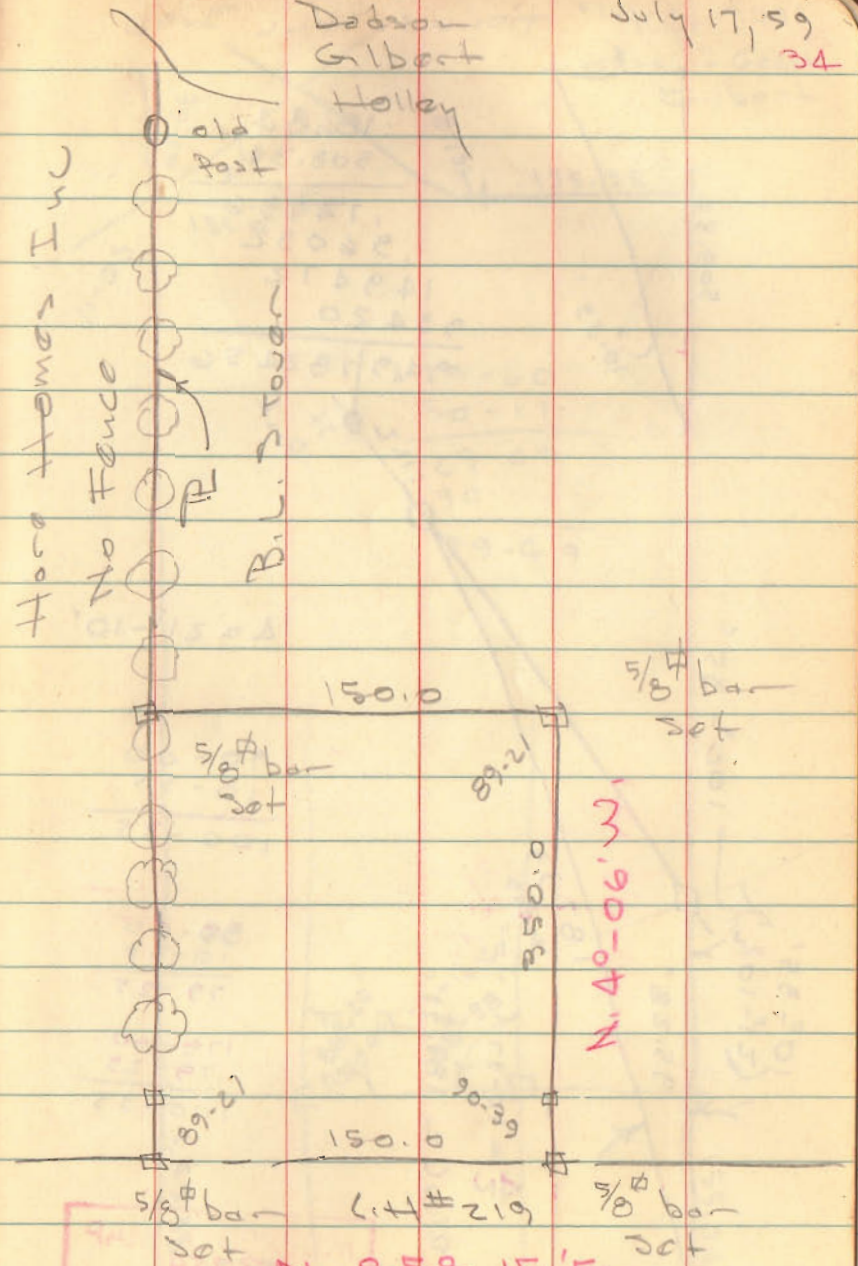

Holly Hill Sub D

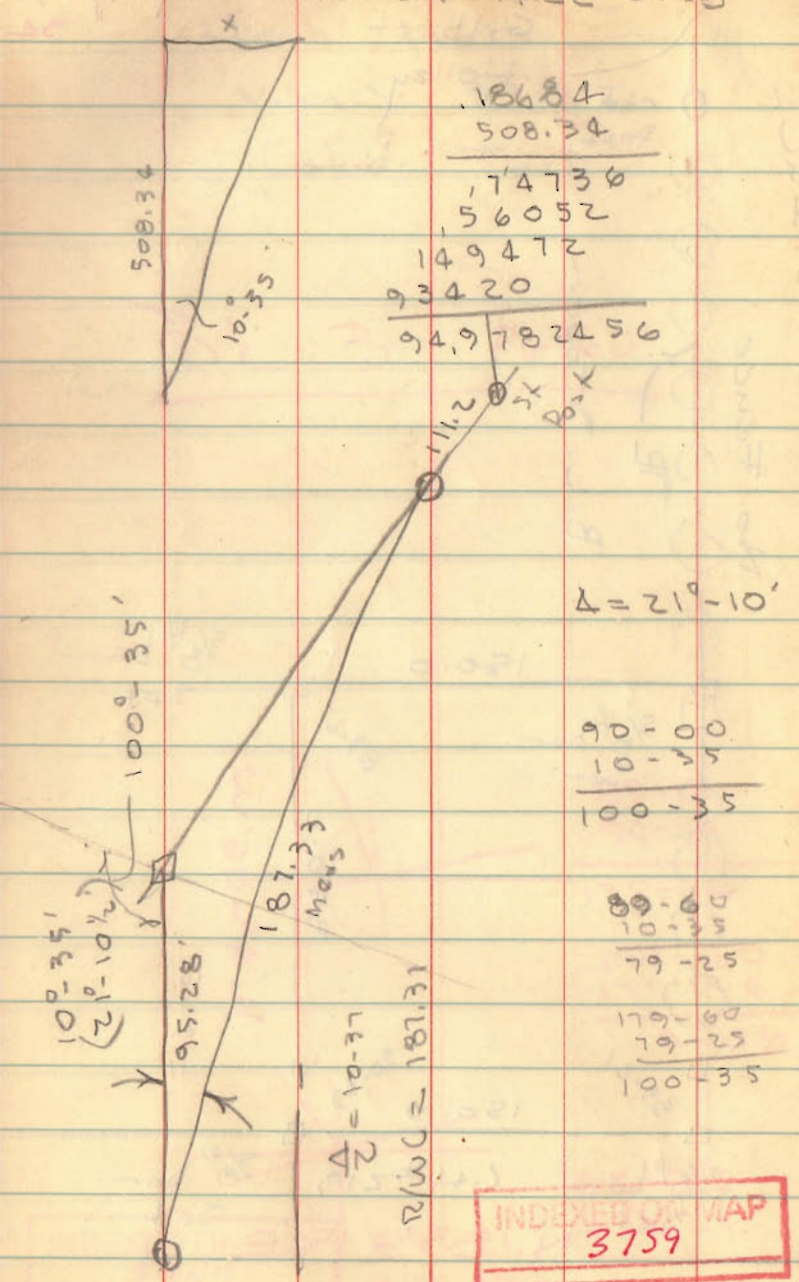

18684
508.34
74736
56052
14947 2
93420
94.9 | 78245 6

Δ = 21°-10'

90-00
10-35
100-35

89-60
10-35
79-25

179-60
79-25
100-35

INDEXED ON MAP
3759

Aug. 1, 1959
Dodson - Geesli
Gilbert

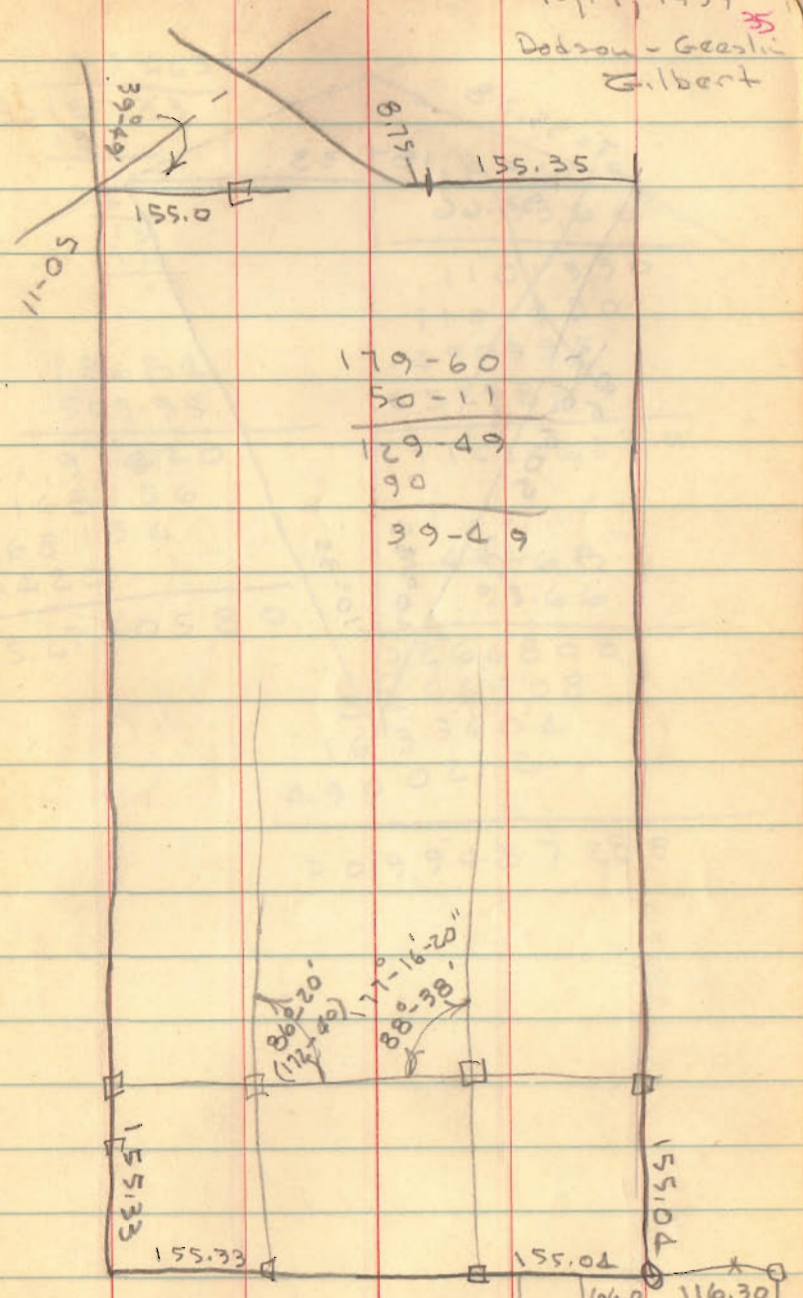

179-60
50-11
129-49
90
39-49

Holly Hill
Street Centres

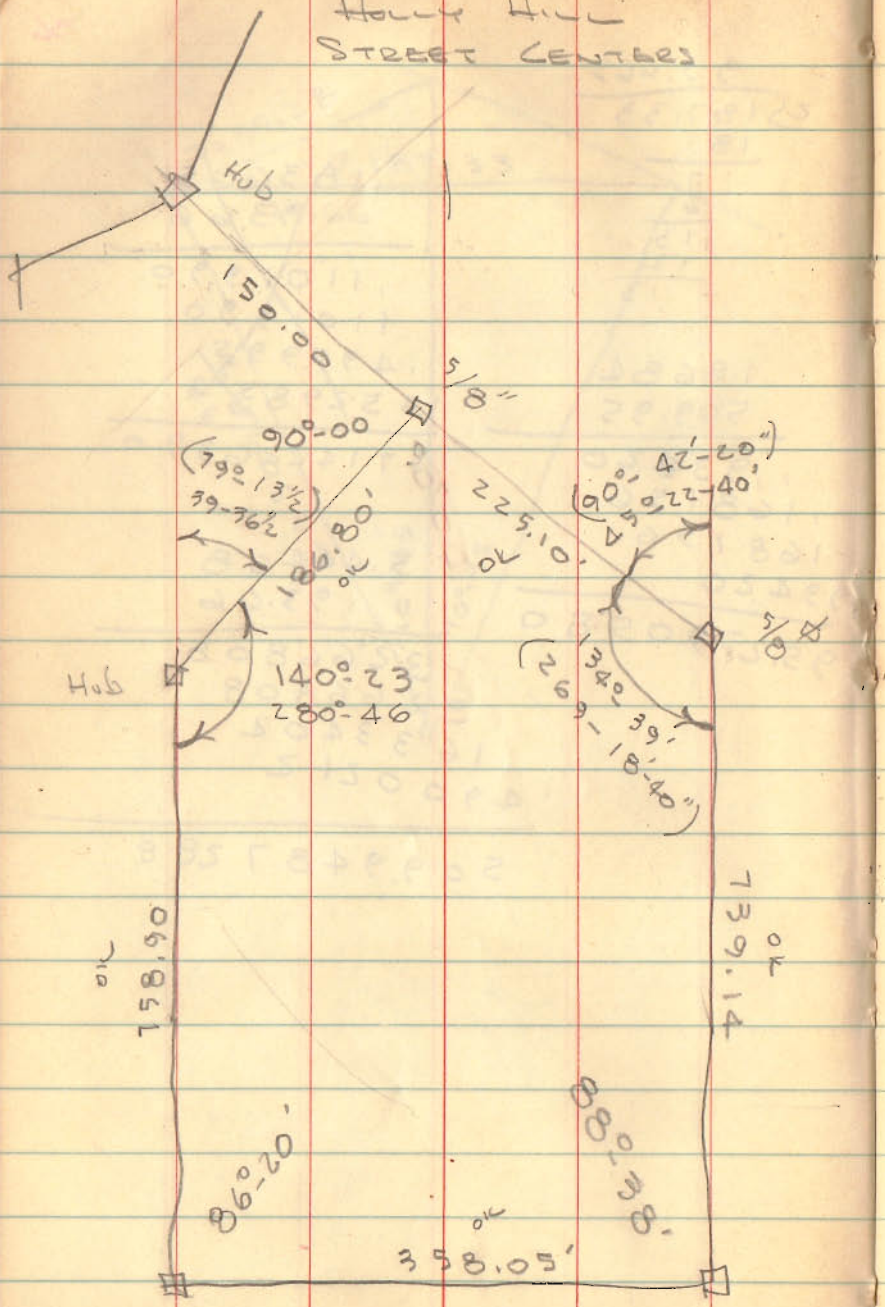

179-60
134-39
45-21

180°-3
54-0

3 2
140-23
90-00
134-39
88-38
86-20
538-120-0K

INDEXED ON MAP
3759

Geo. Sewell Survey

125 / 1000

58.19
1124.62
33.57

1124.62

.1001 4
270
00980
00280
.3780
x
0.38

125.00
30
4.62

x

00.02 7

.5977
270
418390
11954
161.3790

1319.95
161.76
1158.19

89-60
59-08
30-52

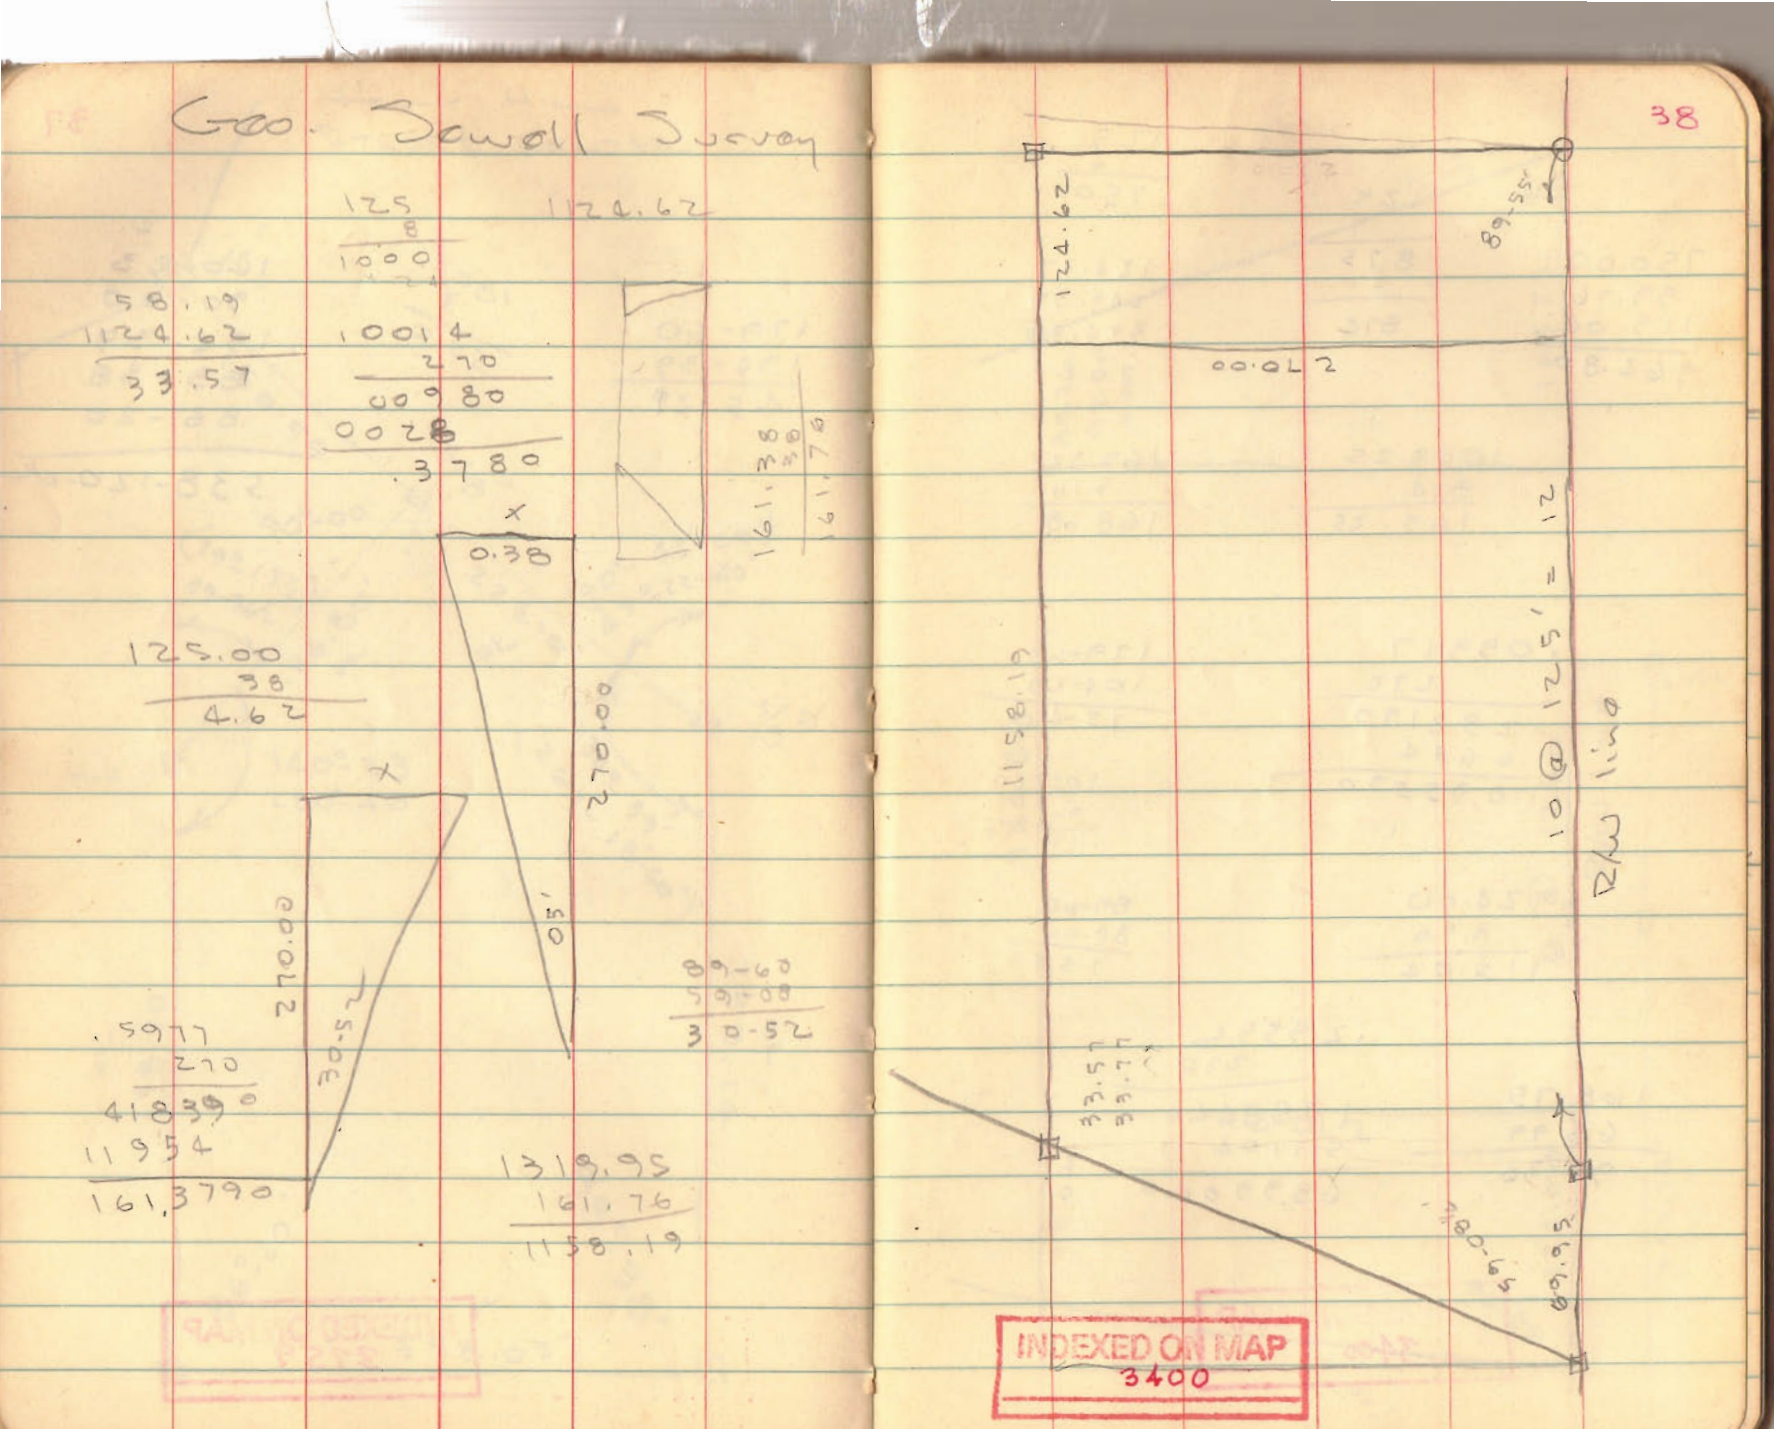

INDEXED ON MAP
3400

125
6
750

125
7
875
-1
874

750.00
99.76
115.04
964.80

124.37
249.37
374.37

1043.25
874
169.25

163.52
5.16
168.68

.03317
270
232190
6634
8.95590

179-60
104-20
75-40

104-20
90
14-20

124.00
8.96
115.04

89-60
88-04
1-54

.25552
270
1788640
51104
68.99040

168.75
68.99
99.76

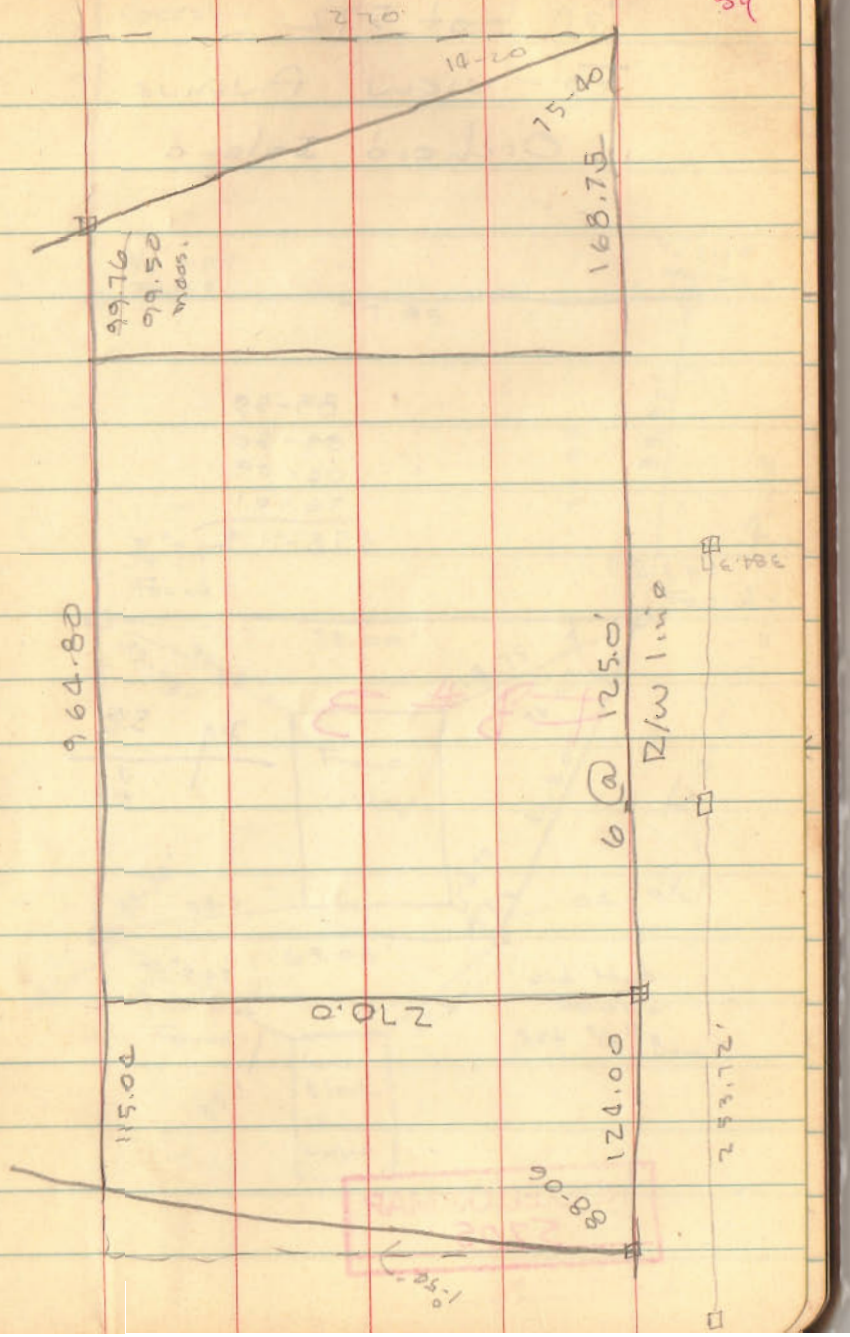

MAP
3400

Lot 572

Fair-view Avenue

Orchard Island

89-59
89-50
08-09
76-01
358-119

FB # 3

Pg 59

INDEXED ON MAP
5705

Dodson
Geesli-

Sept. 5, 1959
70°

40

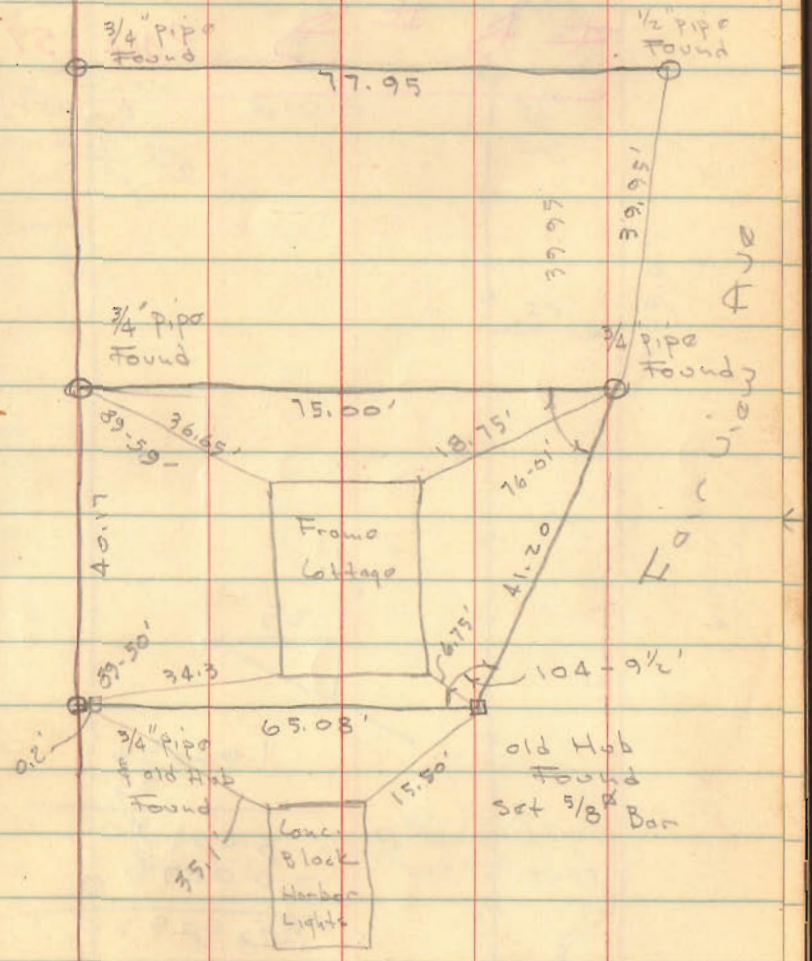

Riddle Survey

#B# PAGE 57

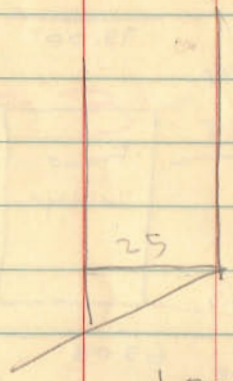

1.000038
25
5 00190
2 00076
25.00950

INDEXED ON MAP
2910

Dodson
Geesling

Sept. 5, 1959

41

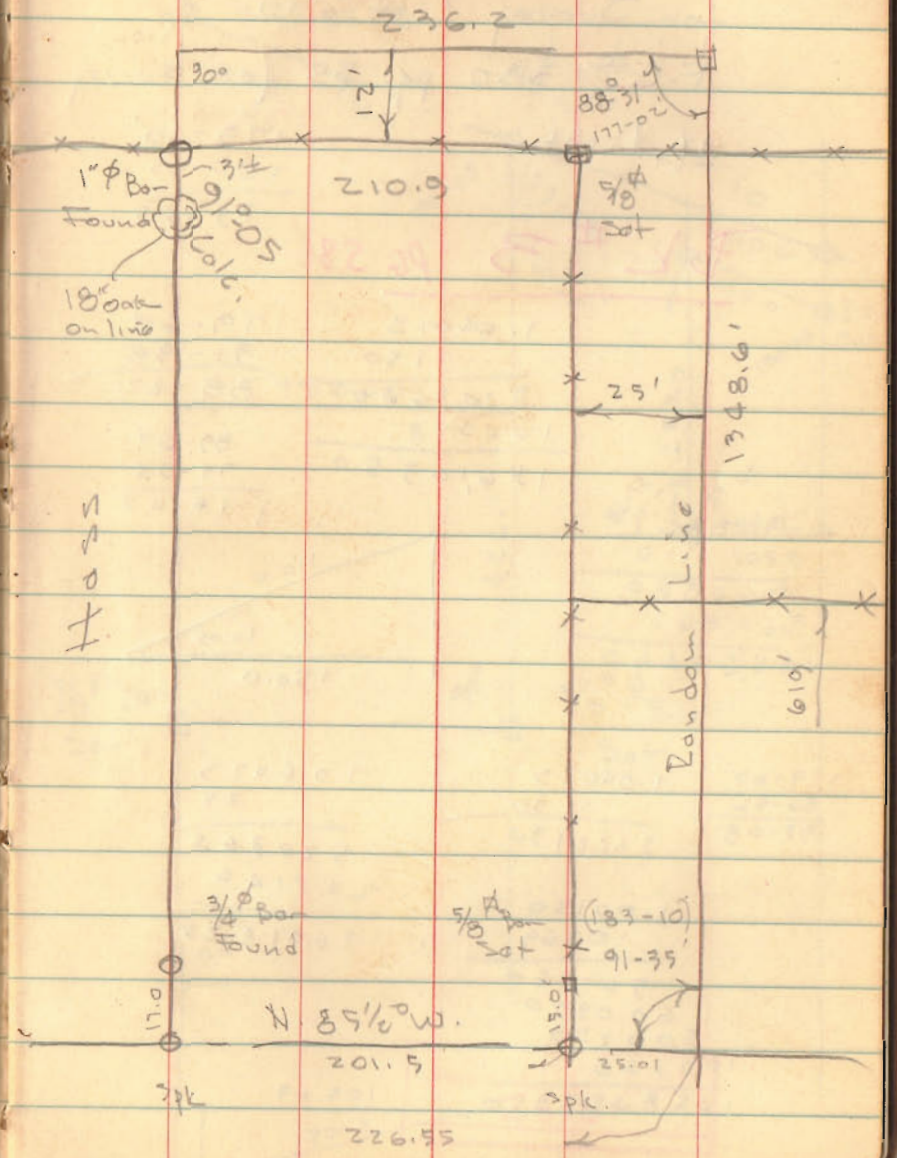

Baxley Survey
U.M.S. 3220
See Co. Eng. F.B # 614, pg 15 & 16
for Survey C.H # 10 &
F.B # 390 pg. 55 for Survey
of tract

BK # 3 PG 58

179-60
106-05
73-55

1.04073
150
5203650
1040-3
156,1095 0

179-60
91-38
88-22

89-60
73-55
1 16-05

.96086
110
960860
96086
105.694660

110.0
16.05
150.0

179-60
86-52
93-08

1.04073
30
31.22190

1.00150
105.69
9013.50
60 0900
500750
100150
105.8485350

1.04073
25
5203 65
20814 6
26.018 25

105.69
3-08

Dodge-
Geeslin

Sept. 11, 1959
42

Iron Found
Sta. 85+16
13-55
156.11
5/8" Bar Set
106.05
273-55
C.H # 10
110.0
110.0
106.05
Hub Set
150.00
283.0
424.1
86-52
93-08
105.9
5/8" Bar Set
90°
5/8" Bar Set
38-22

INDEXED ON MAP
2861

Spain Survey

C.H # 153

Zone Twp.

BK 3 / 63

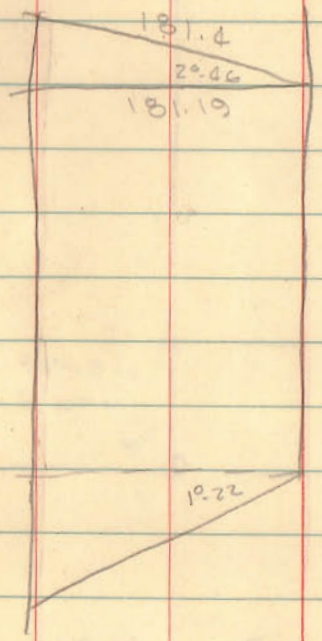

.99883
181.4
39952
399883
79964
99883
1.00028 181.18776
20056 0

Cos A = x / 181.4

x =

1.00028
181.19
900252
100028
100028
800224
100028
181.24073 32

179°-60
91-22
88-38

Dodson
Louis
Gilbert

10/1/59

44

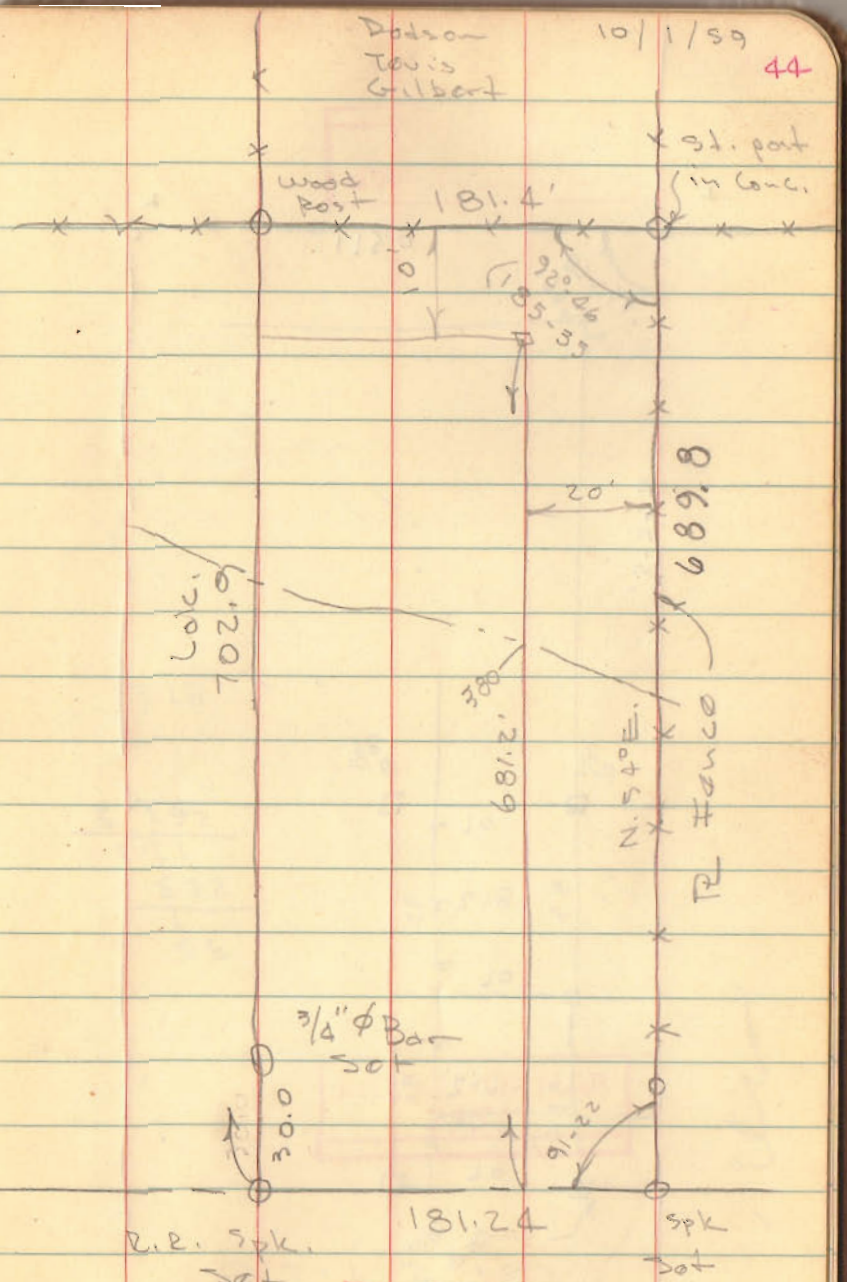

INDEXED ON MAP
3296

Chippewa Park

Lot 217-218

1 car

INDEXED ON MAP 7751

35
7
245
17.5
262.5

81½'

INDEXED ON MAP

SD

Dodson
Geslin

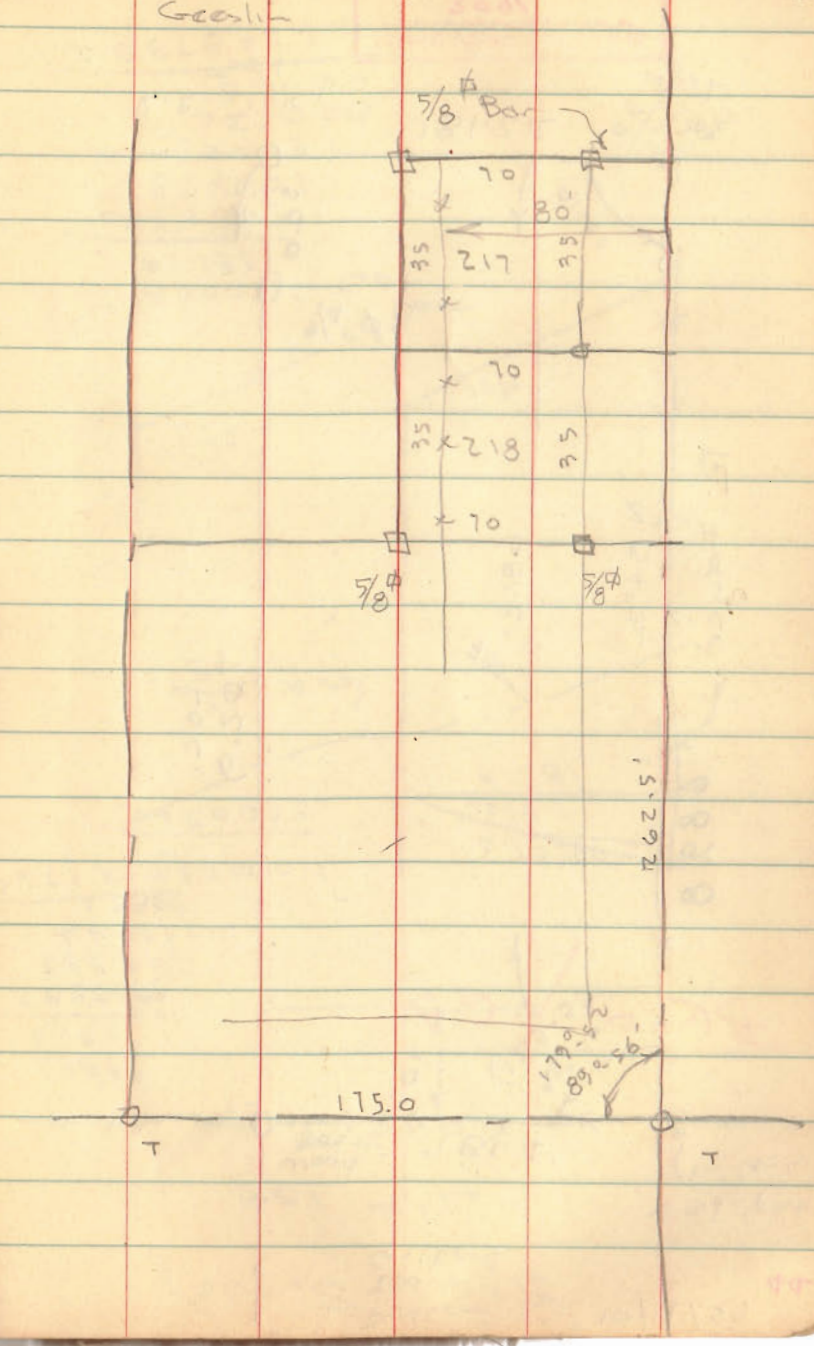

Lot #22

Huntsville

Mirror tracing

66.09
29.87
36.13
8.25
44.38
8.25
52.63

29.87

INDEXED ON MAP
7895

Dotson
Geodimeter

10/24/59

46

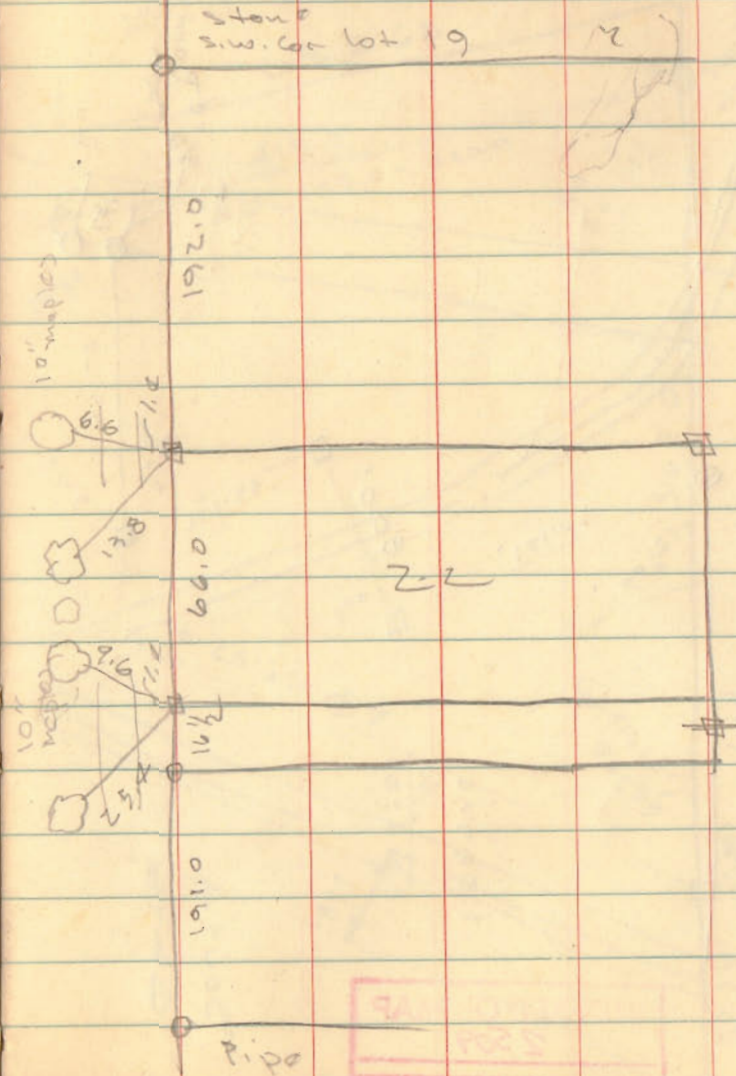

HARE SURVEY
LIBERTY TWP

Dodson
Geodimeter

Nov. 7, 1959
250

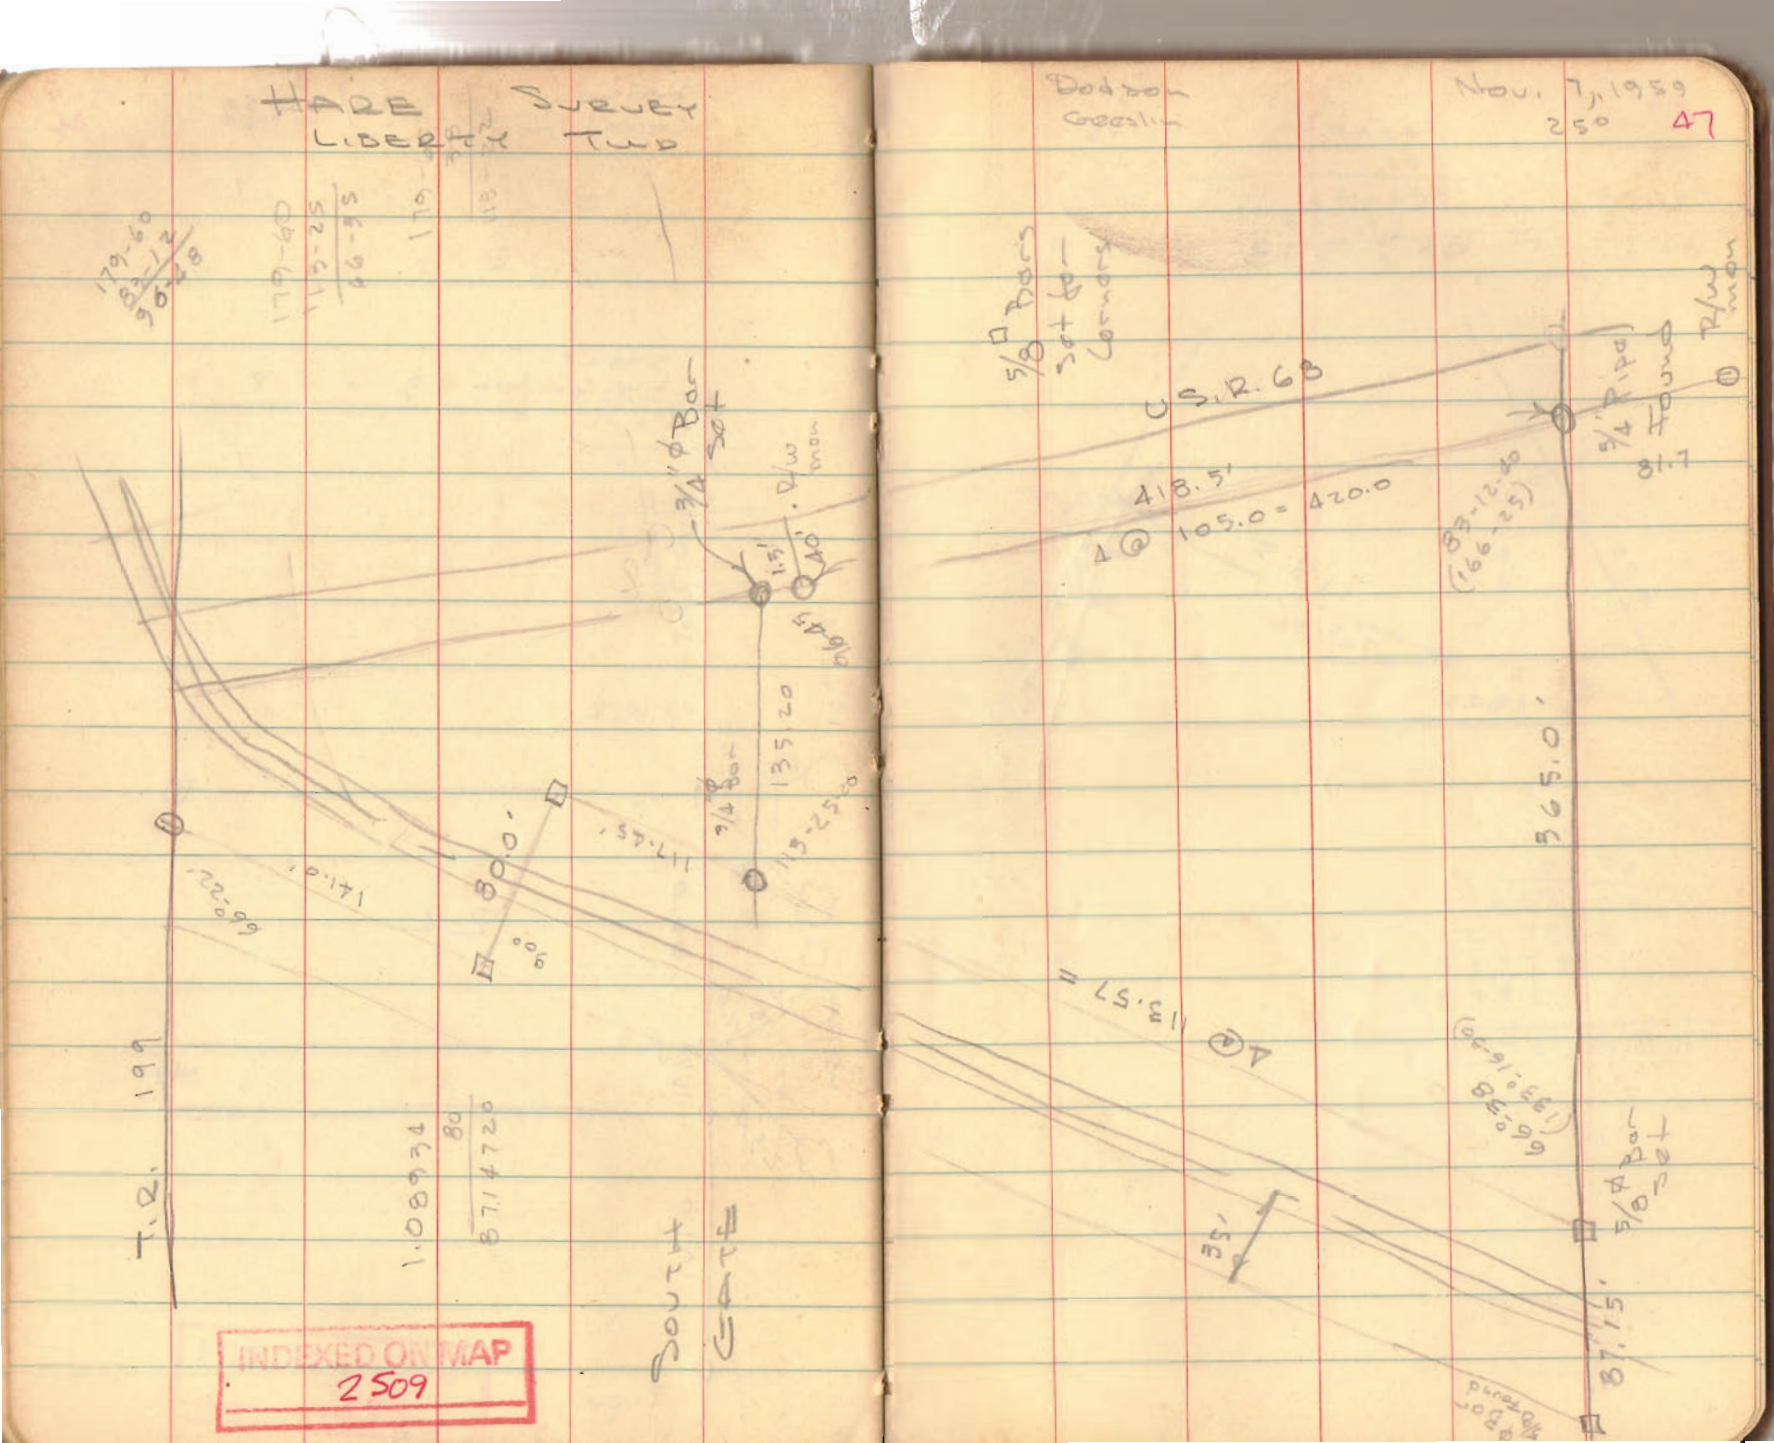

Kindall Survey

U.M.S. 3220

Jefferson Twp

217.8
20
197.8 200

217.8
35560
400
356
200
1560
1400
1600
16

Bk 3 Pg 67

613.35
166.6
779.95
780.0

89-60
6-02
S 83-58 E

INDEXED ON MAP
Z862

Pedro-
Geesler

11/14/59
30° 49

R.R. Spk
20.0
217.8
5/8 ⌀
S. 83-58 E. 90°
35.5
90°
15" Maple
200.0
90°
5/8 ⌀
217.8
5/8 ⌀
20.0
84.1
780.0
84.1
864.1
Tr. R. Spk Found
N. 90° E. 200.0
N. 6-02 E. 199.6
780.0
L.H. #10
53+58.15
217.8
20
197.8

Troyer Survey

McARTHUR TWP.

179-60
89-39
90-21

195
180
100
475

$\frac{475 \times 235}{43560} = \frac{111,625}{43560}$

$= 2.56$ A.

Dodson

Goeslin

11/21/59

50

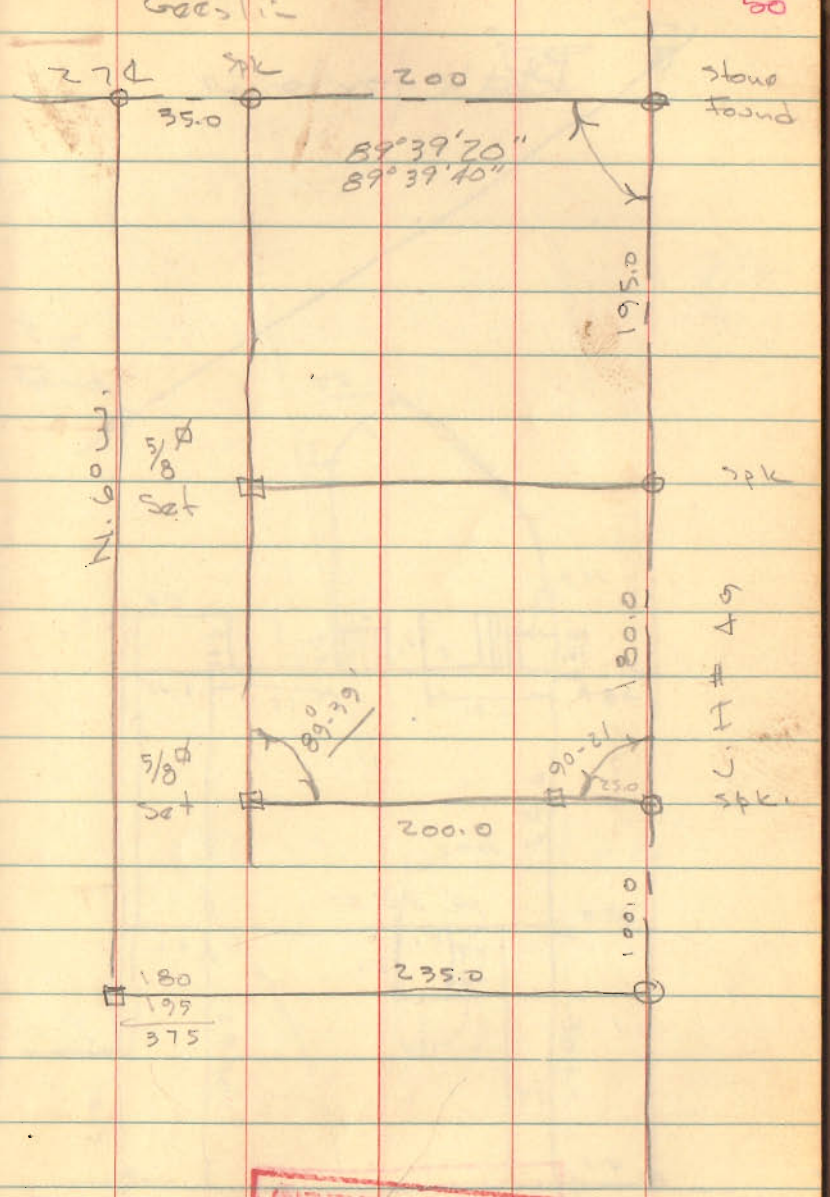

INDEXED ON MAP
3063

Lot 3013

Bellefontaine

INDEXED ON MAP
2583

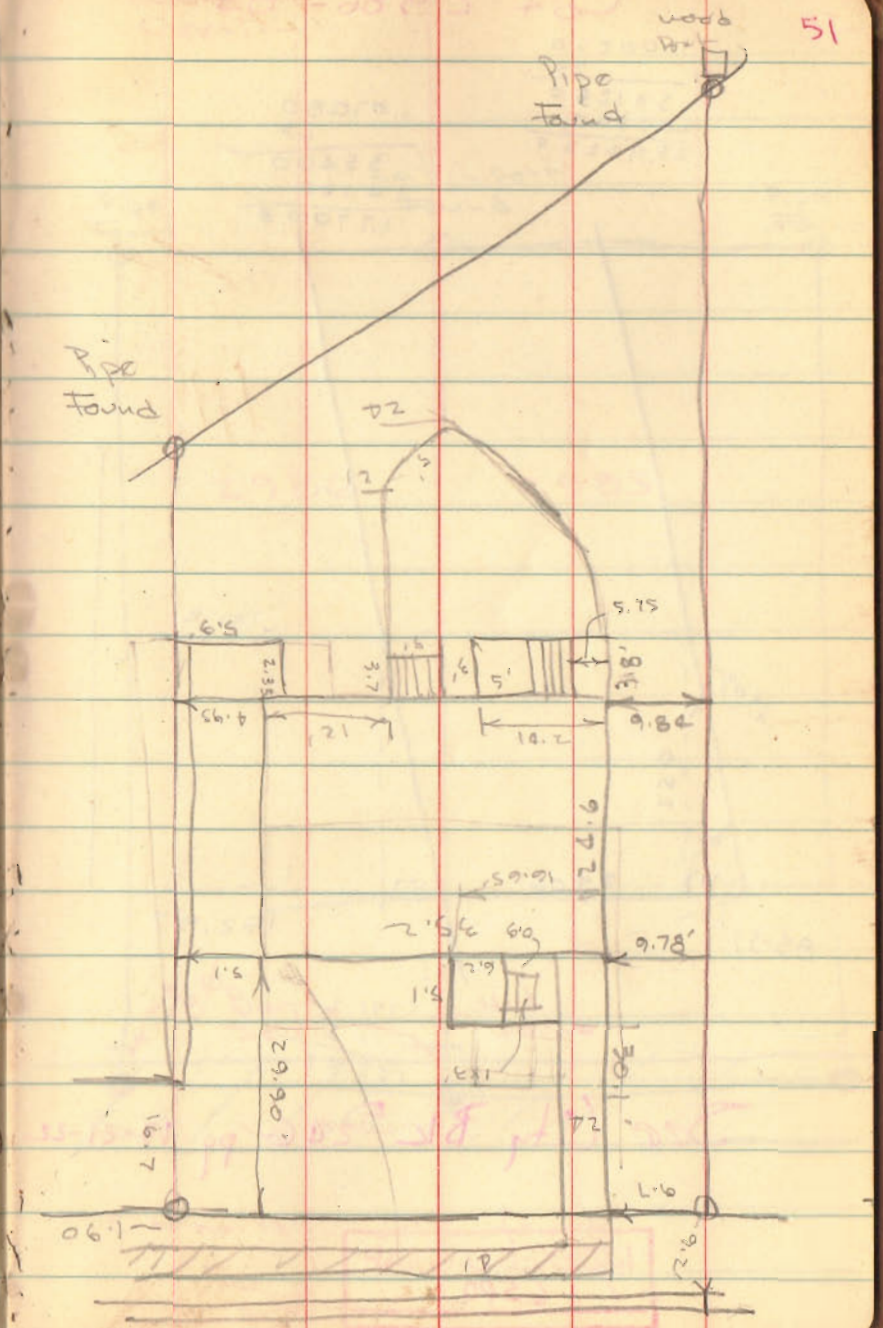

Lot 2986-85

1.00250
25
501250
200500
25.06250

.07080
25
35400
14160
1.77000

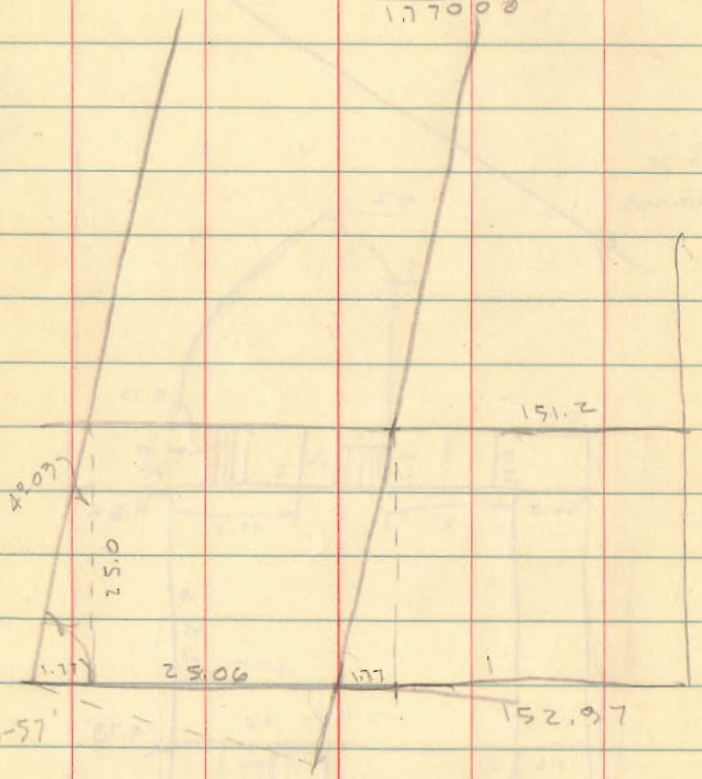

85-57

151.2
1.77
152.97

See City Bk # 246 pg 13-21-22

INDEXED ON MAP
6500

Dodson
Geeslin

12-19-59

52

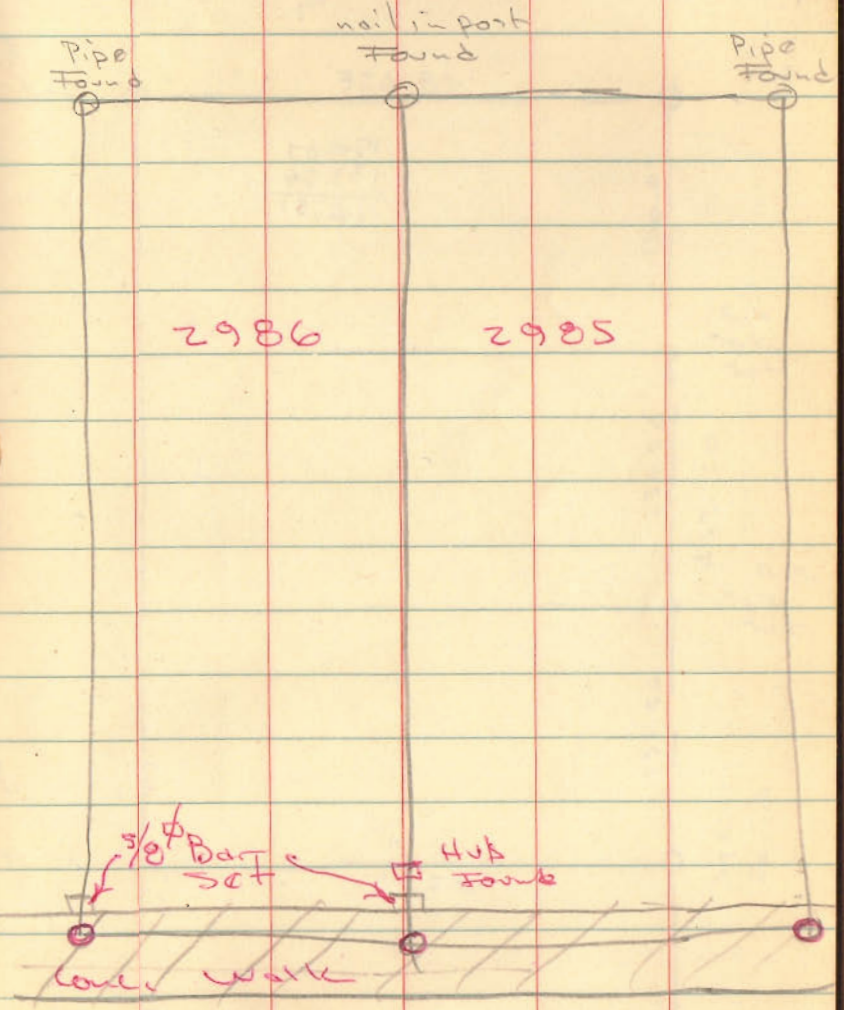

O = nails in walk found

Seminole Rd

Mar 19, 1960 Dodson Geesling

Rich Survey

Sec. 34-63-8E

Stokes Twp

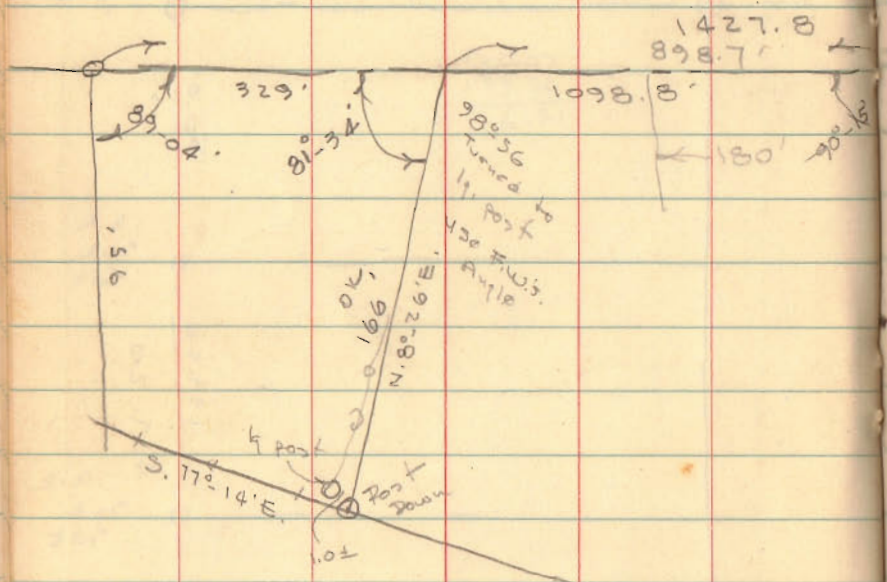

BK 3 Pg 66

54

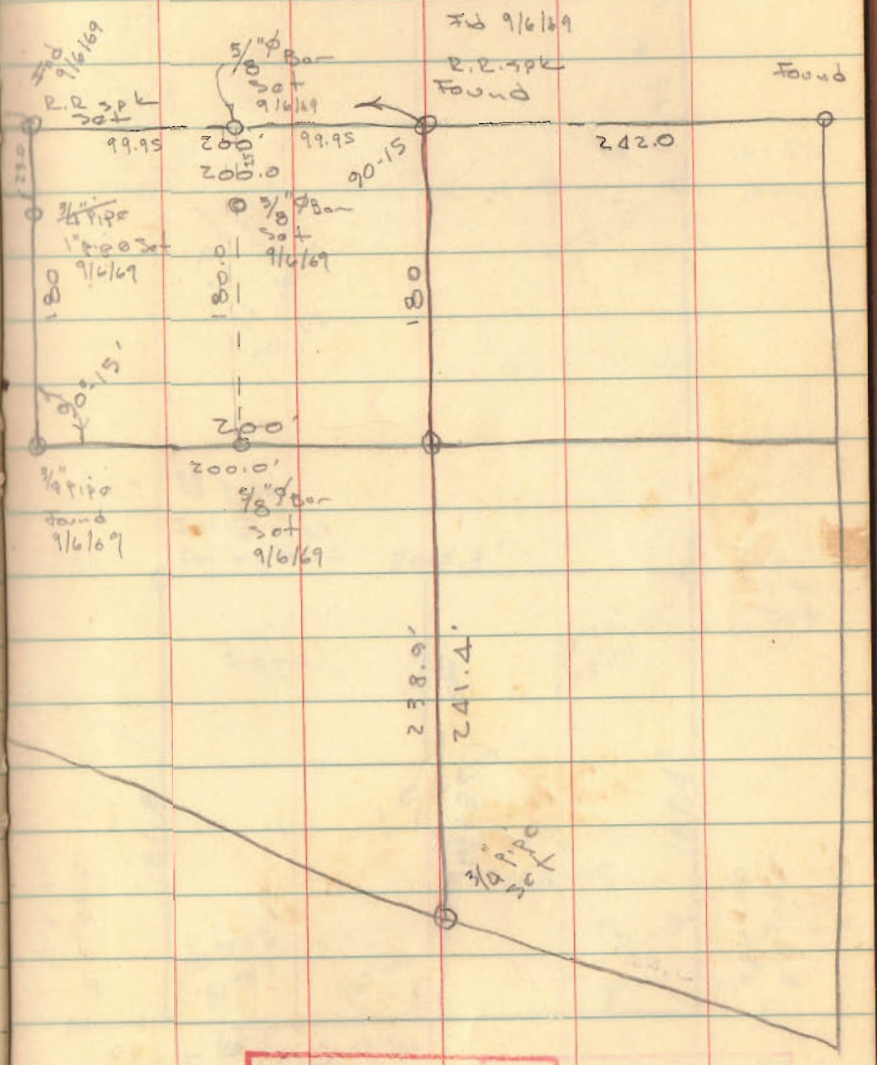

INDEXED ON MAP
3163

Bates Survey
U.M.S. 9891
Bokes Creek Twp.

C.H.# 26 - FB# 701/44

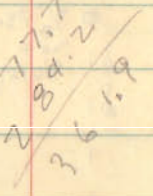

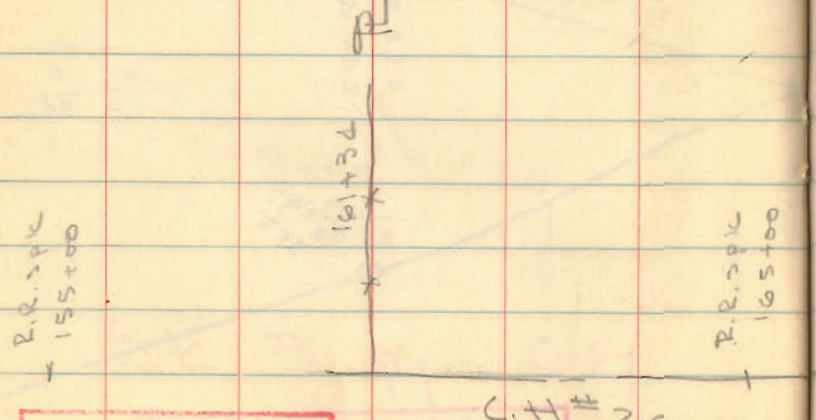

INDEXED ON MAP
2599

3/30/60

55

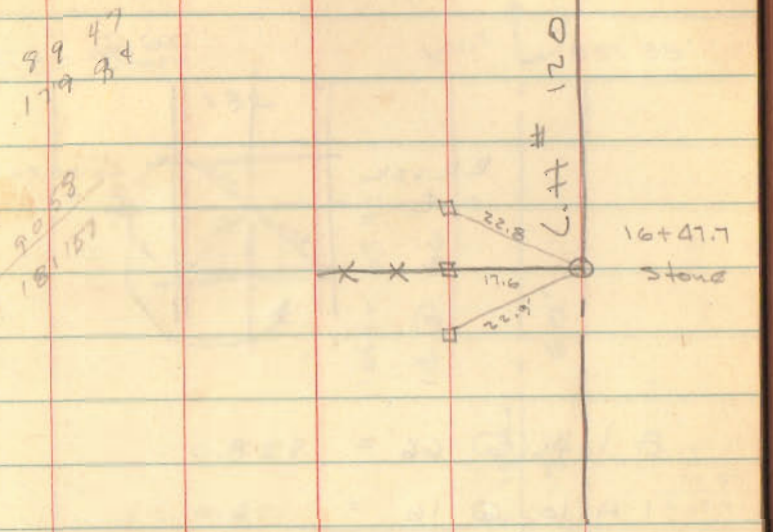

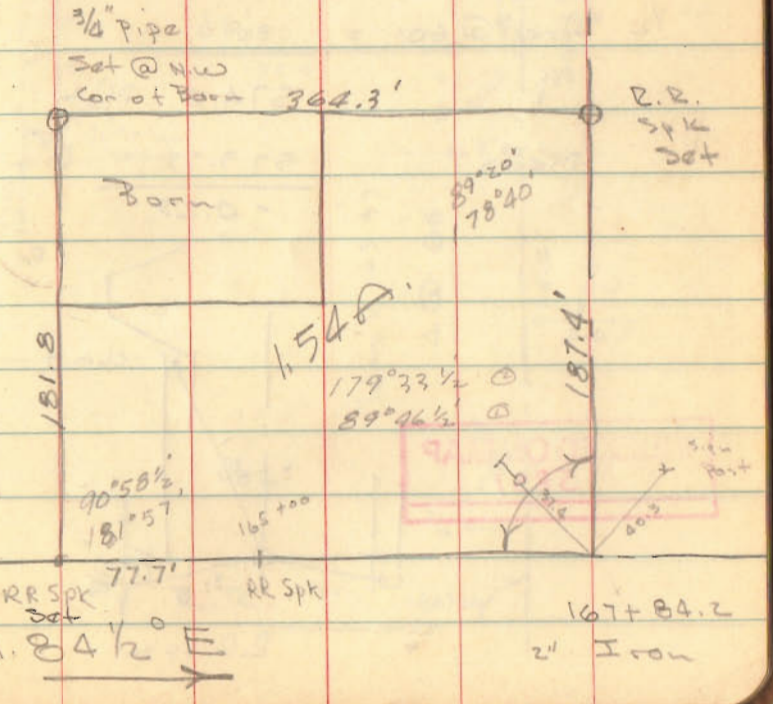

lots 53 - 54 - 55 - 56 pt

DeGroff, Ohio

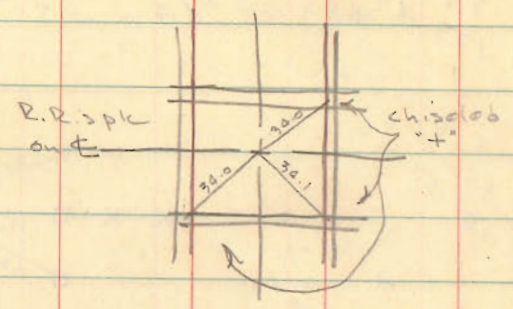

8 lots @ 66' = 528.0

1 Alley @ 16 = 16.0

1/2 Street @ 60 = 30.0

574.0 Plat

Meas 573.75

-0.25

66
9
264

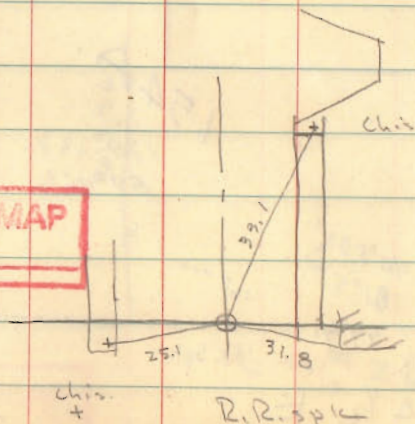

INDEXED ON MAP
5851

56

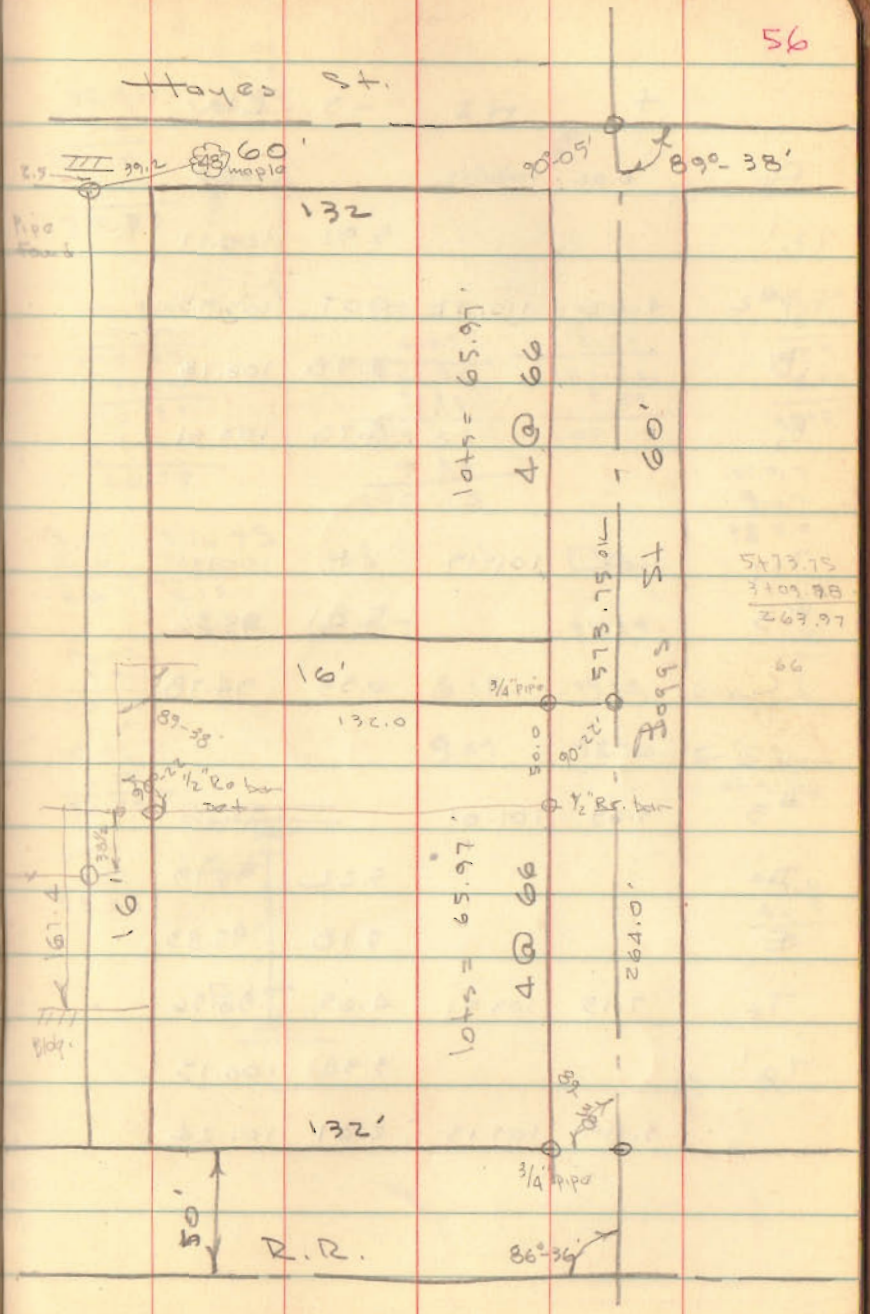

Hare Homes
Huntsville

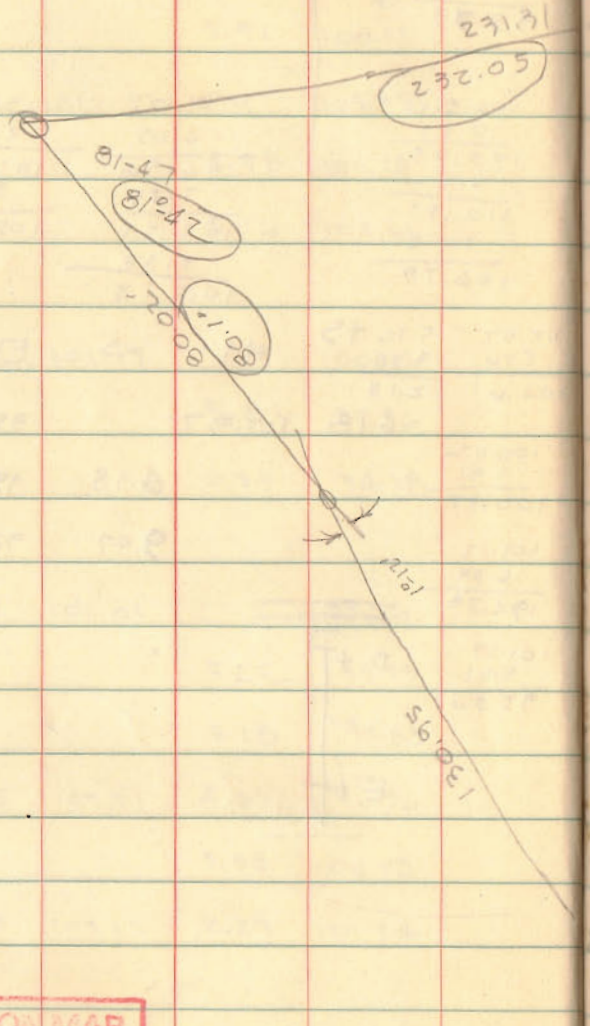

INDEXED ON MAP
2614

Dodson
Geesling

April 2, 60

58

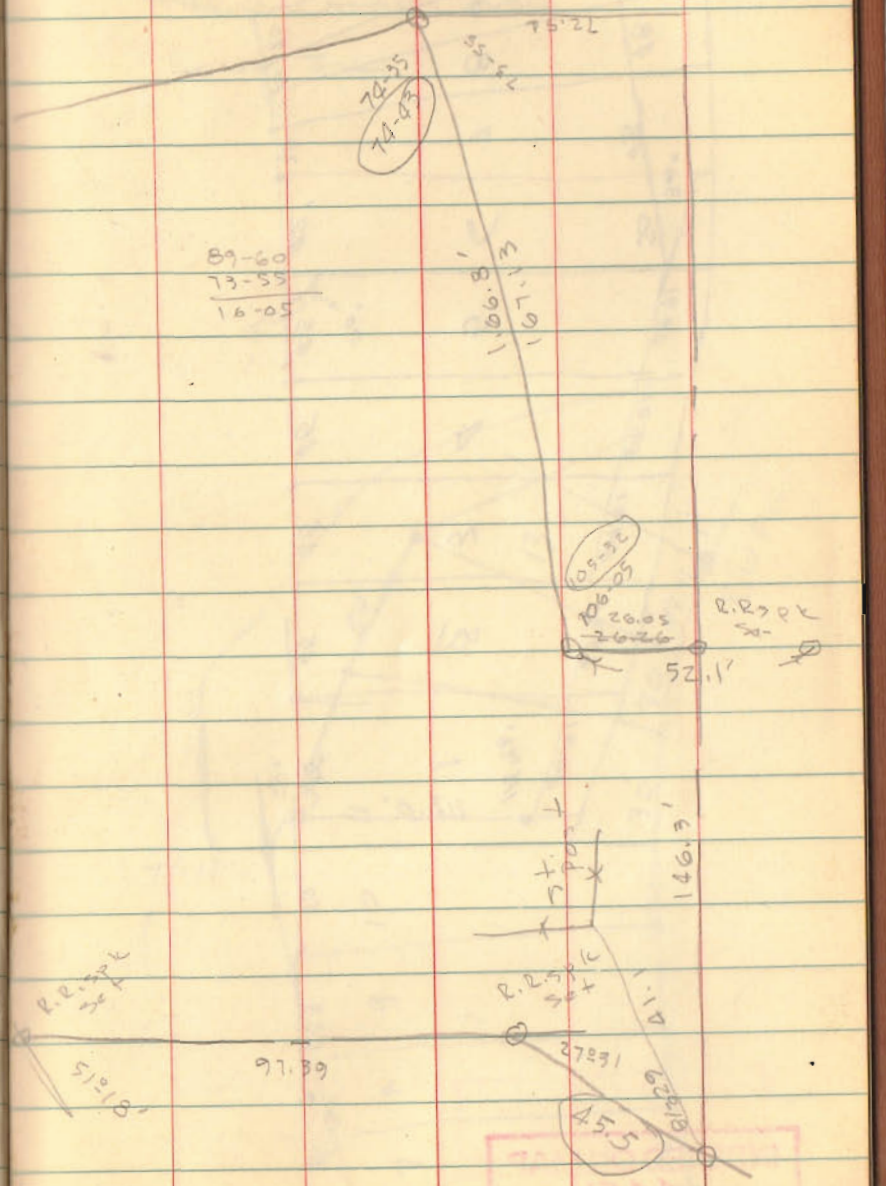

FERNWOOD SUBD

LONG I. L.

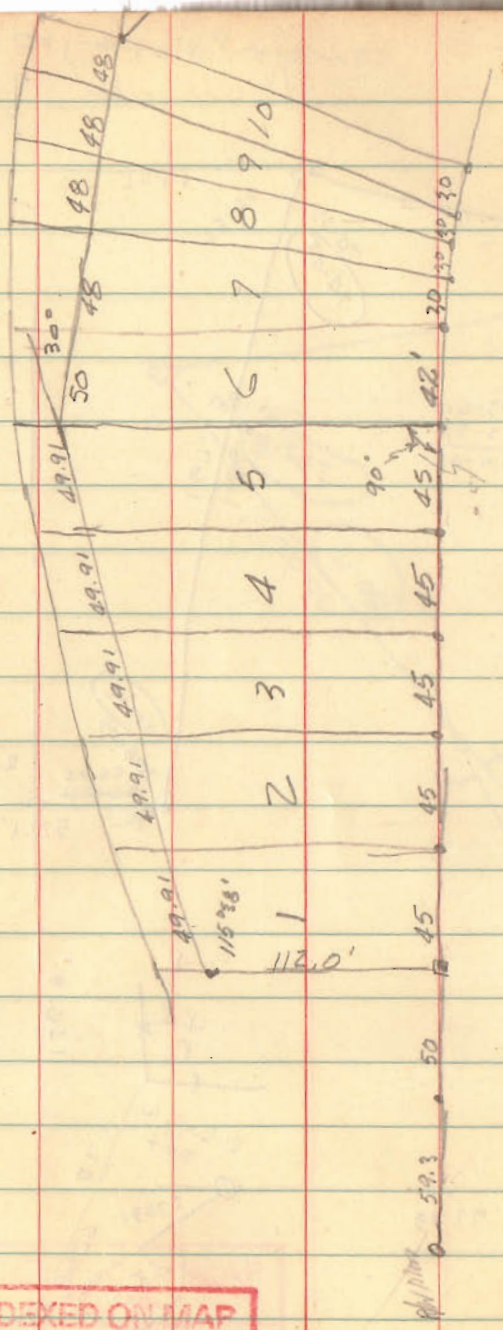

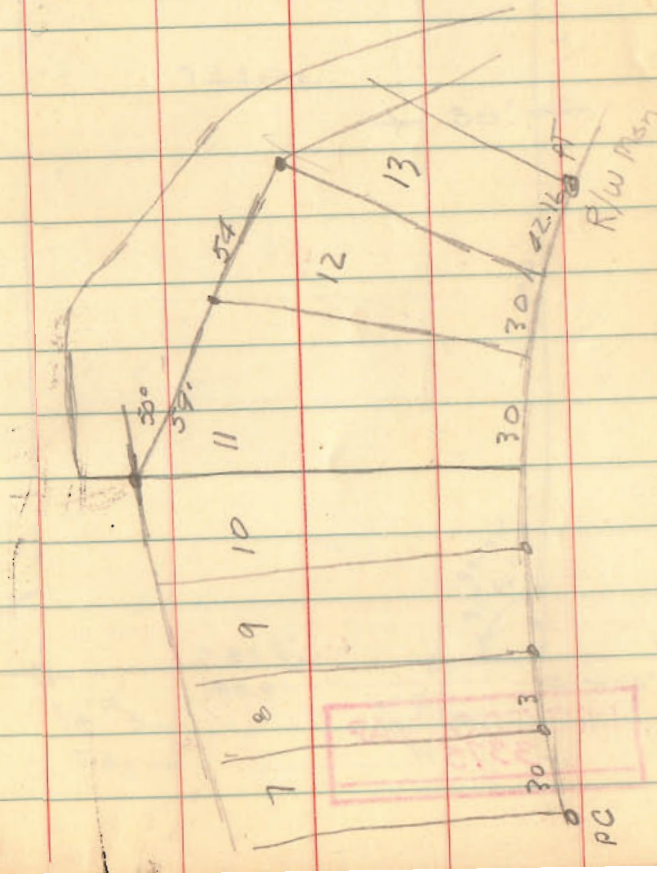

INDEXED ON MAP
4451

MATHEWS SURVEY

V.M.S 9907

Dushcreek Twp.

INDEXED ON MAP
3375


4-16-60

75°

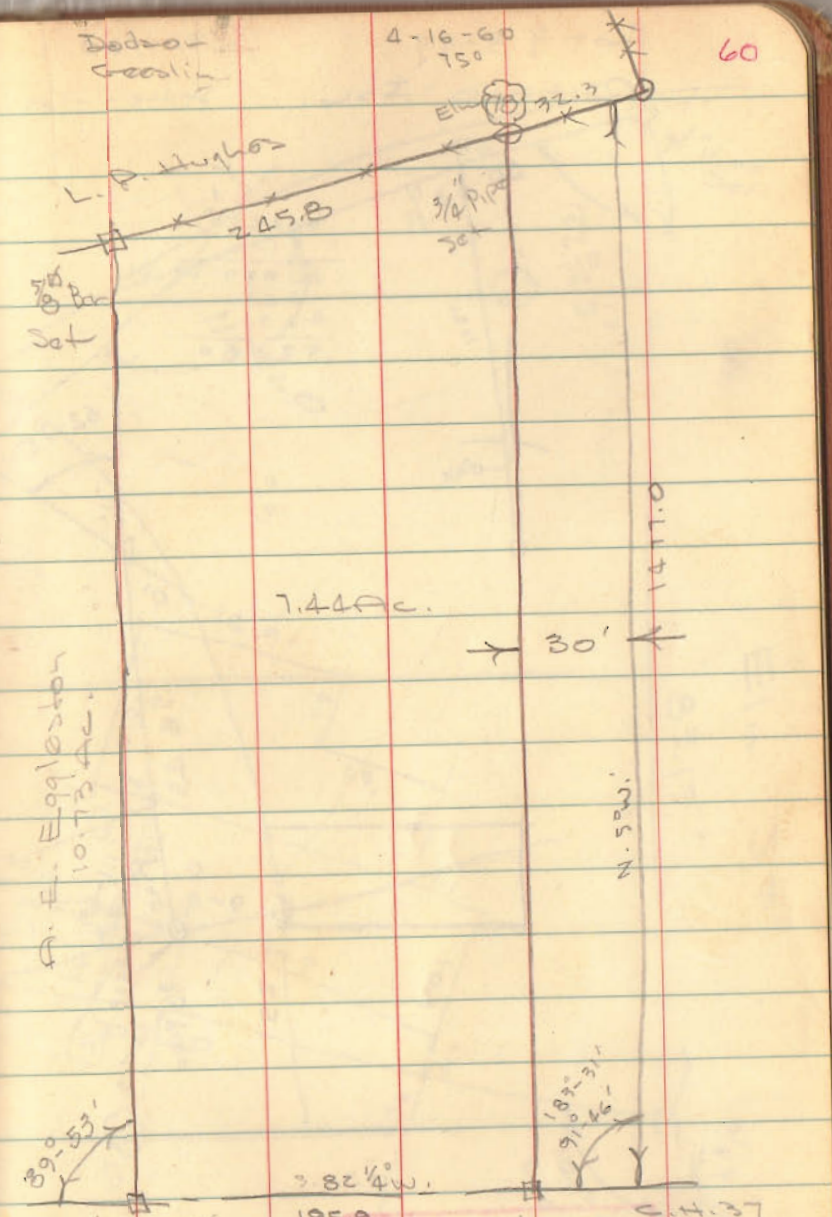

LOT 98-99
ORCHARD I.S.L.

5/7/60

Dodge - Geesl

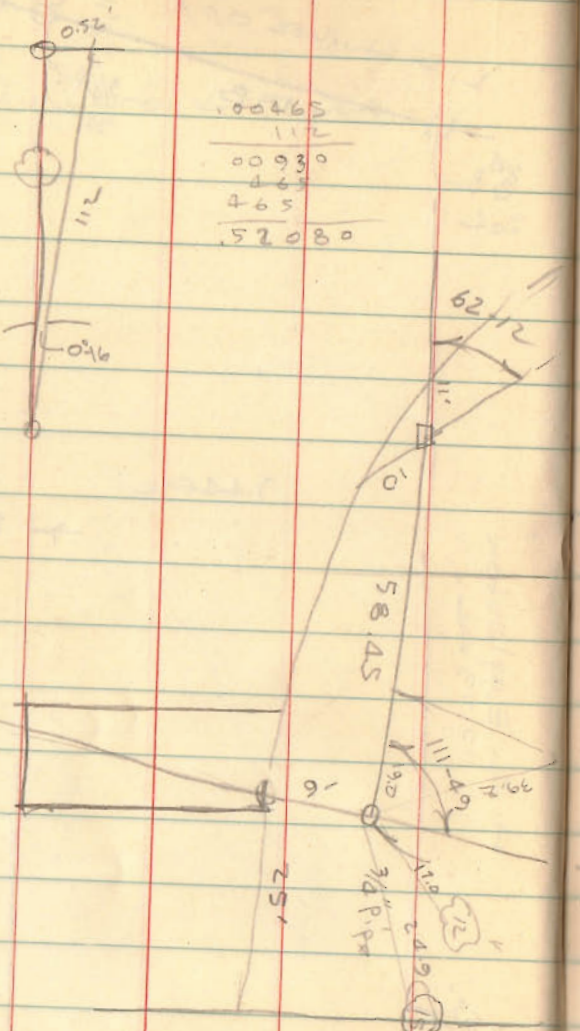

INDEXED ON MAP
2582

61

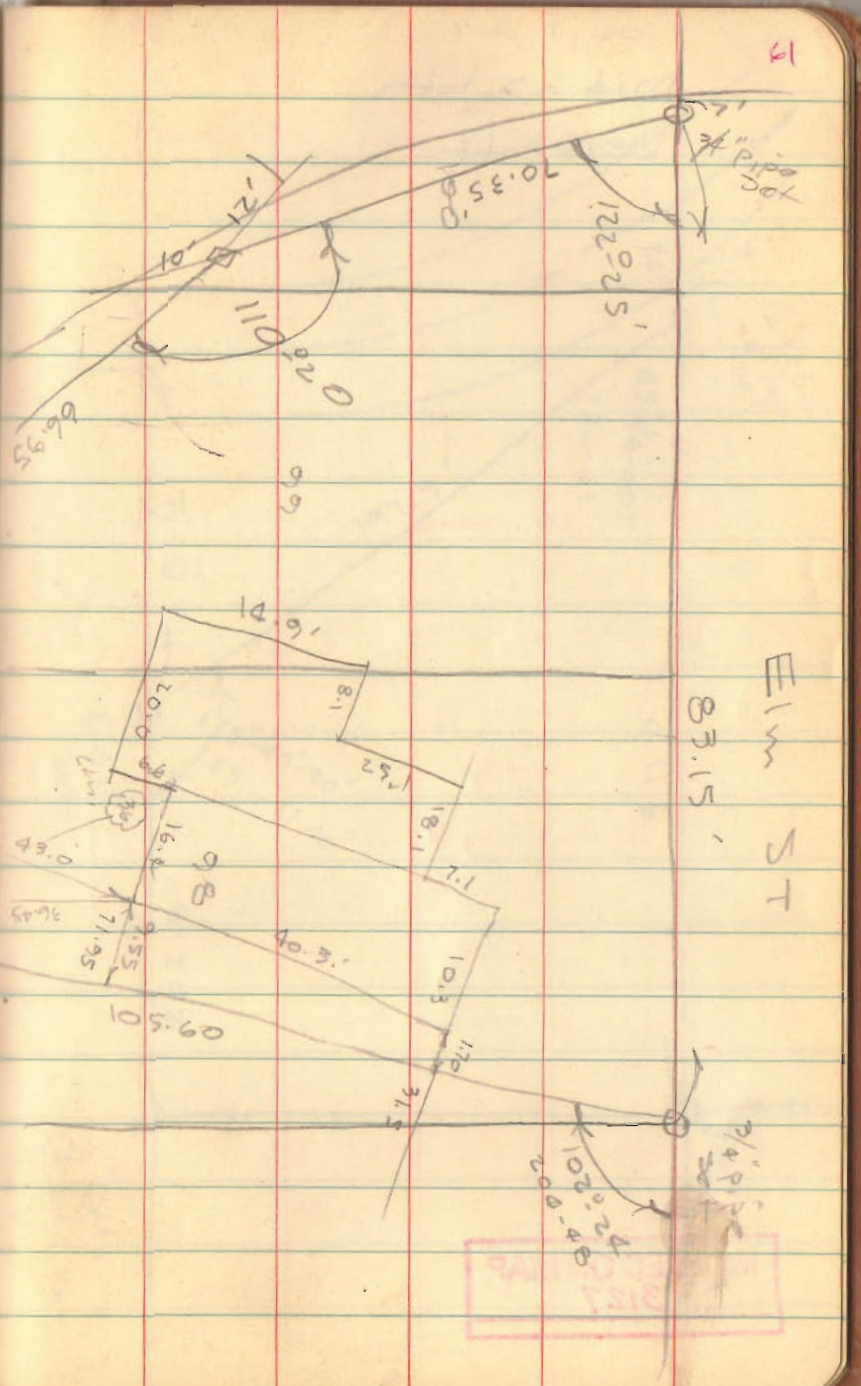

Mid - 3 totes

DeGroff

INDEXED ON MAP
3127

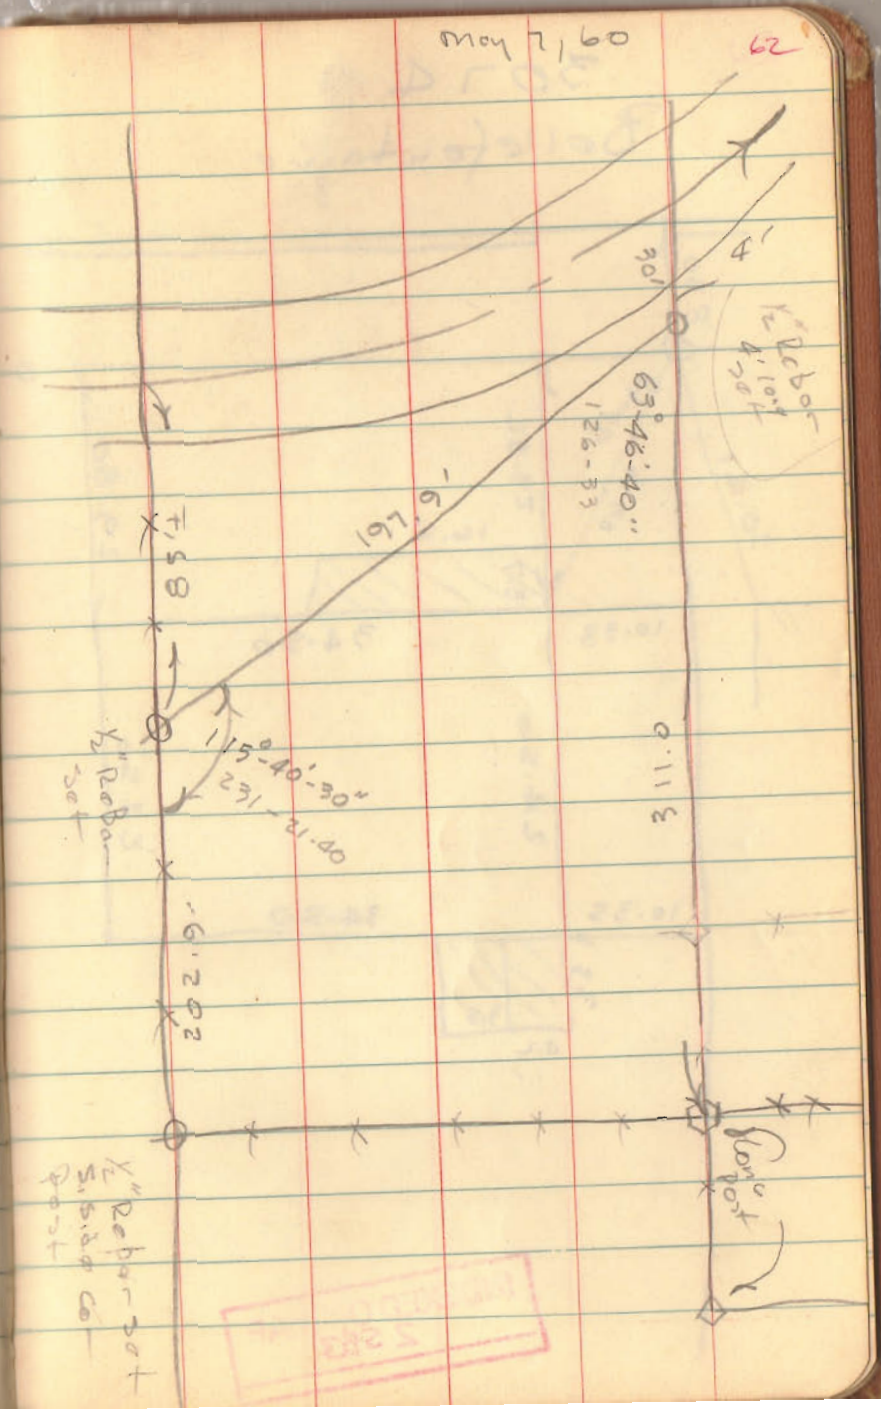

3074

Bellefontaine

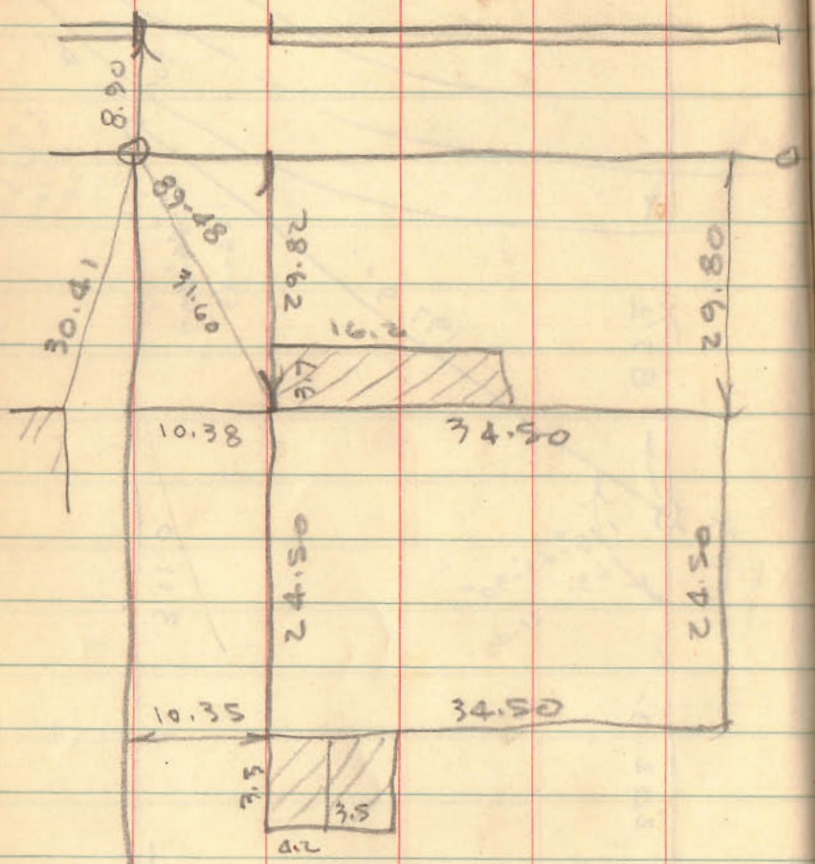

INDEXED ON MAP
2583

Rosa Survey

Walnut St. 82½'

Alleys 16½

89-60
51-55
38-05

1.27046
12.5
635230
254092
127046
15.880750

1.25'
44.10
48.1
1.25
x
51-37

1.27572
1.25
D

.79212
1.25
396060
158424
79212
.9901500

20.0
20.6
89°-55'
179-20

Dedrick Geasler

May 28, 60
70°
65.

40'
½ Pipe found
16½'
North line of alley
90°
Hub Set
40
41.25
½" Pipe Found
16½'
2744.8
½" Pipe Found
Hub Set
51.0'
(128°-29')
3/4" Pipe Set
442.1
51°-37'
(103°-51')

1080.6
51°-55'
103.51
15.88
12.5
380.9'
Hub Set on E. of Pavement

INDEXED ON MAP
1204

Hook School House

75.00
64.43
139.43

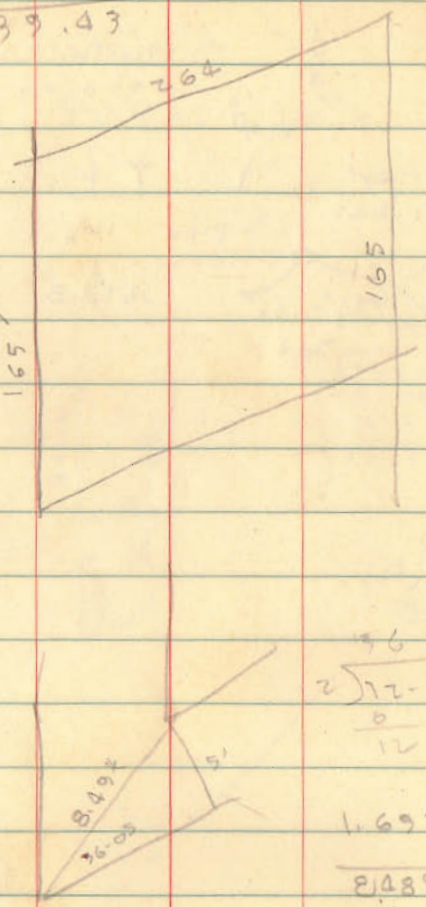

16.5
16
990
165
264.0

6
2 | 12.10
0
12

1.69 90
5
8.48950

Dodge-
Geol.

6/4/60

66

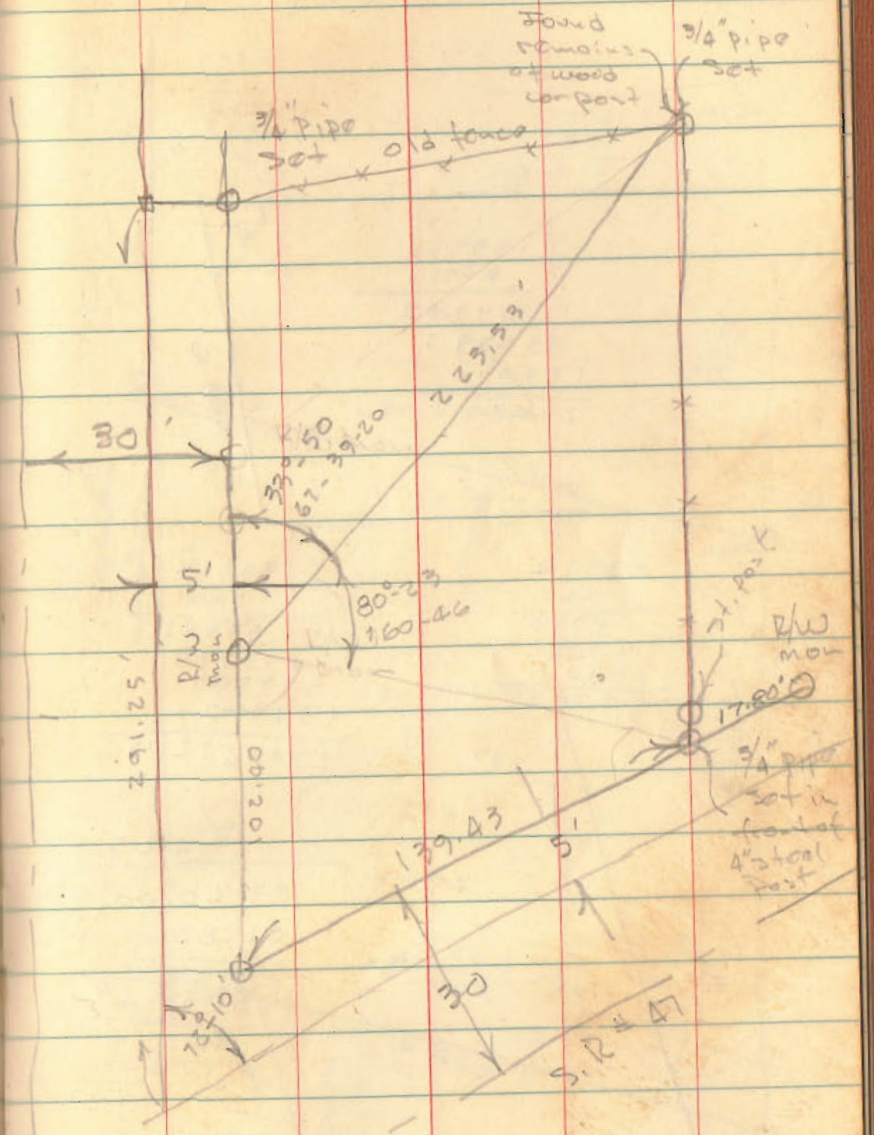

INDEXED ON MAP
6047

Godwin Survey
Lake Twp.

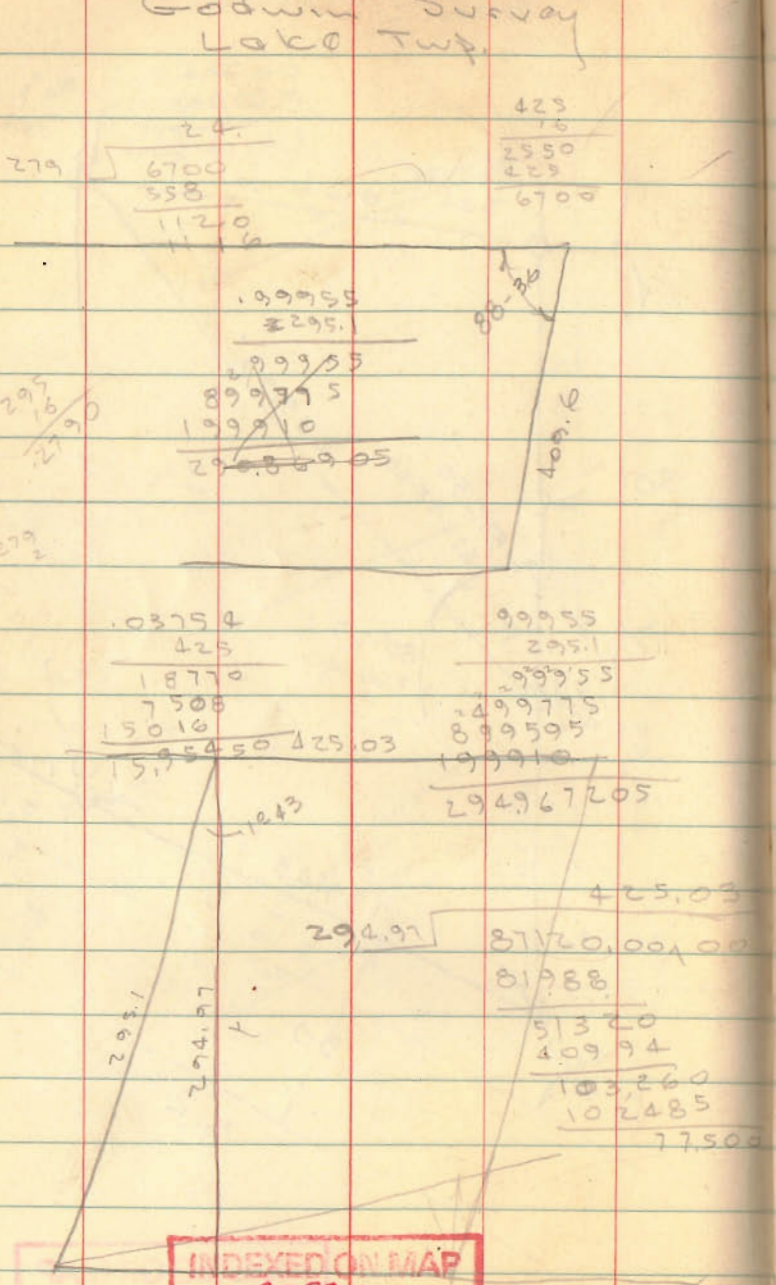

INDEXED ON MAP
2958

Dodson
Tevis

6/11/60
67

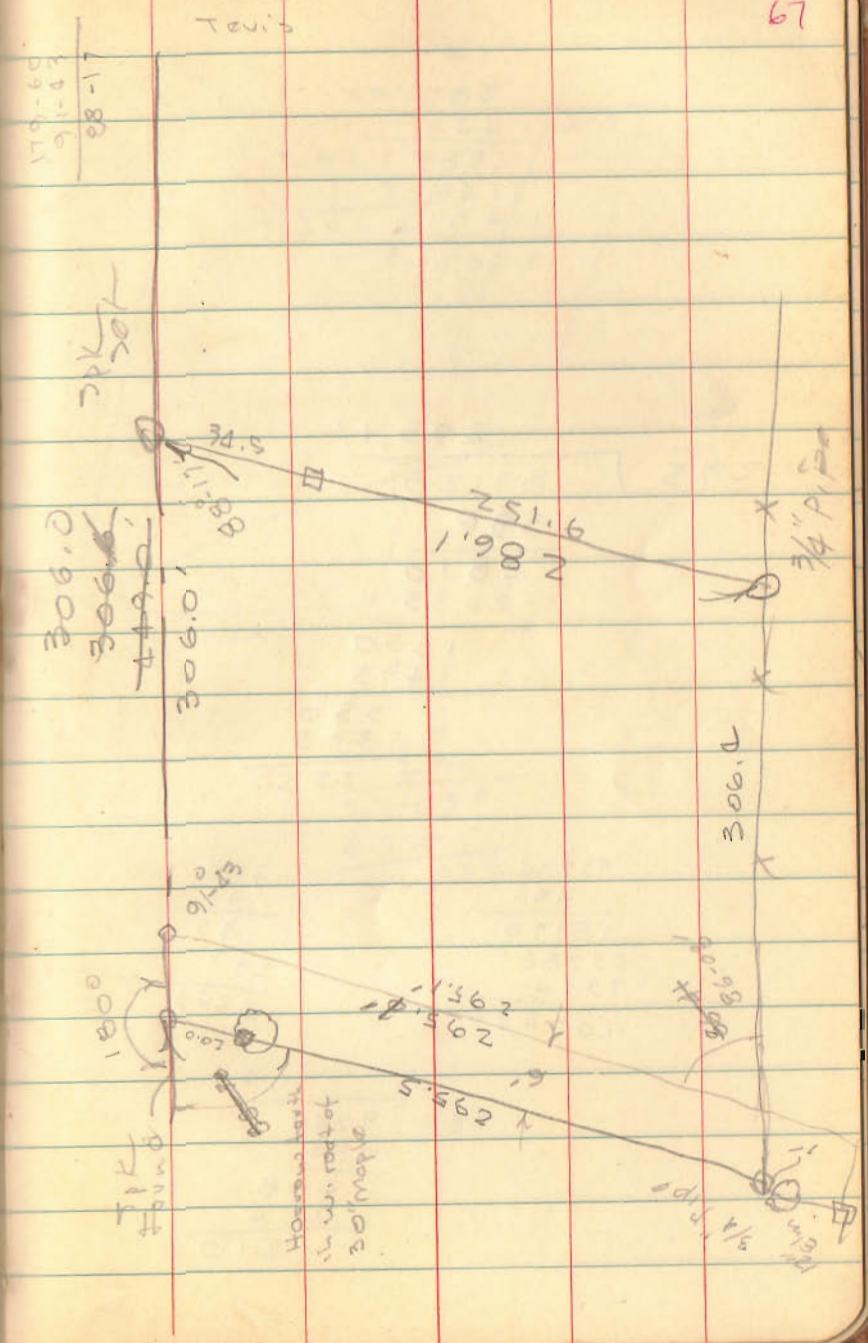

BOWSER SURVEY

SEC. 12 T-2 R-12 WASHINGTON TWP.

208.7103

435560.0000000

4

408 | 3560
8 | 3264

4167 | 29600
7 | 29169

41744 | 43100
1 | 41741

417420 | 1359000

208.71
1.5
104355
20871
313.065 Frontage

278.276

313.07 | 87120.00

62614
245060
219149
259110
250456
86540
62614
239260
219149
20111 0

6/15/60
Dedson
Gilbert
69

3/4" Pipe set

278.3

89-53

0°-07'

2.00 Ac.

313.1'

90°-07'
(180°-14')

C. L. A. W.

Stone
Sta. 334+93

INDEXED ON MAP
3224

Bellefountaine Dev. Co.
Main St. Lokaview

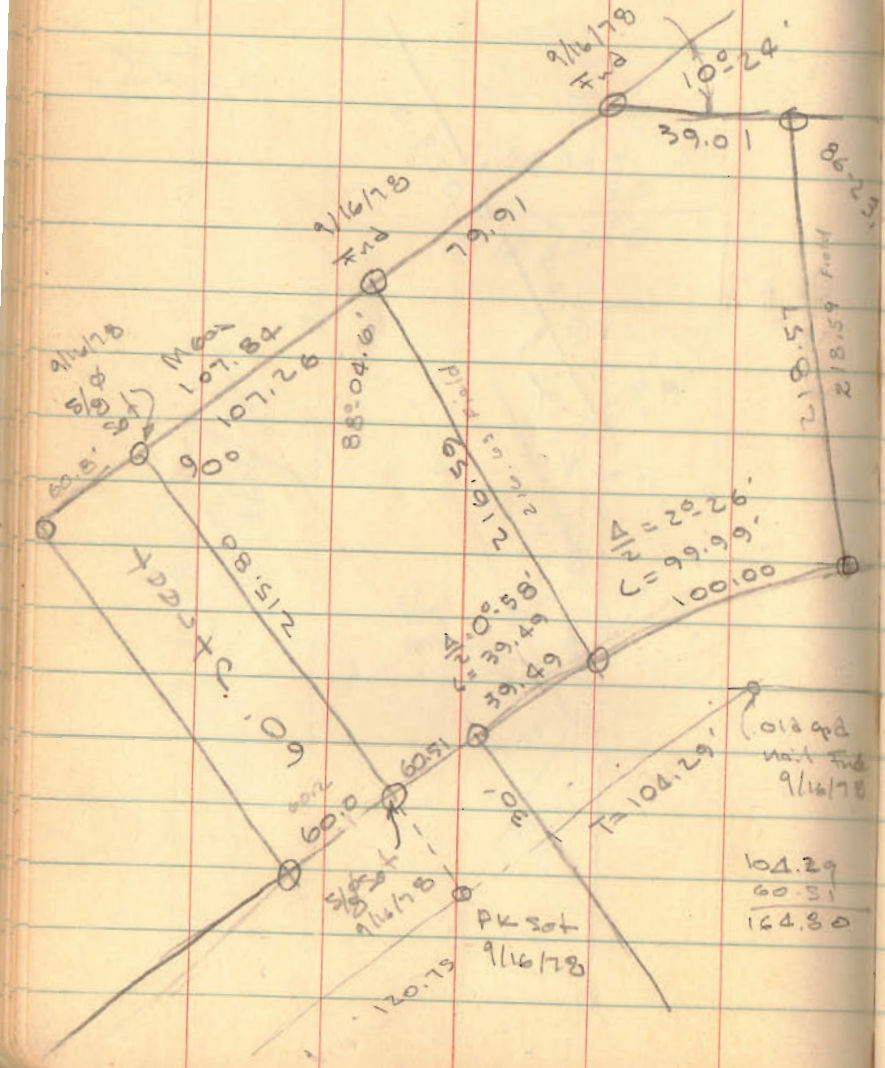

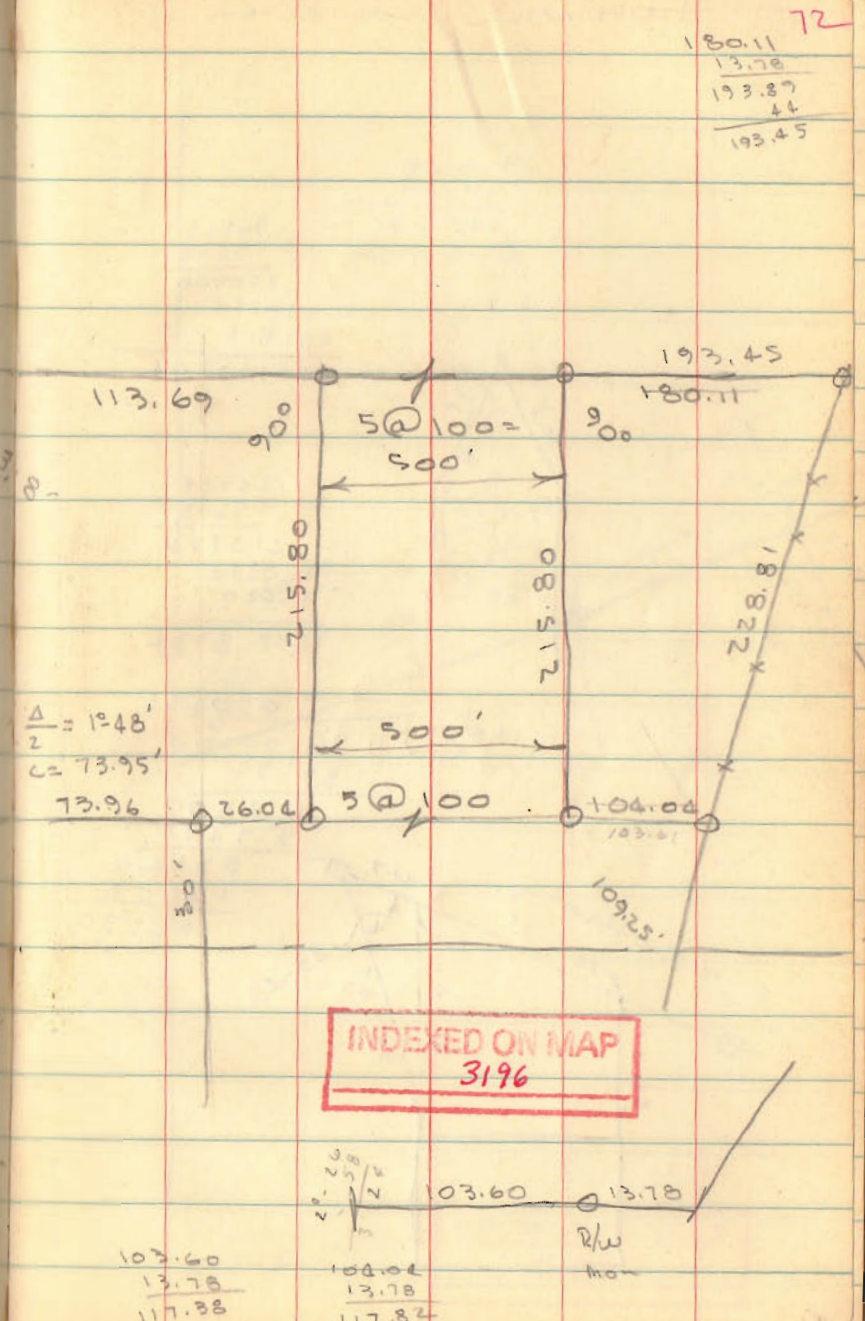

HOPEWELL CHURCH

163.68
14.99
148.69

.96363
56.08
770904
5'2 578178
481815
54.04037 04

126724
56.08
213792
160344
133620
14986192

.0804.36
148.69 ⌋ 11.96.00000
1189 52
64.800
59476
53240
44607
8633 0

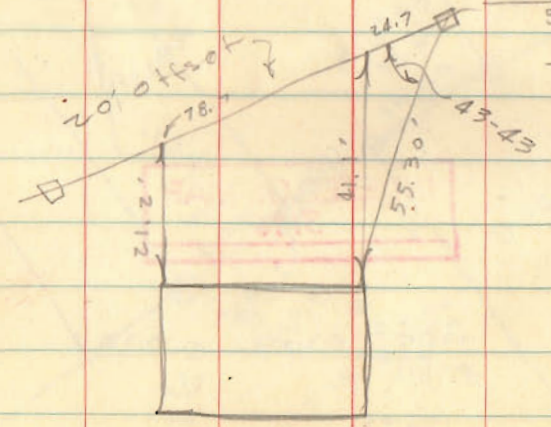

73

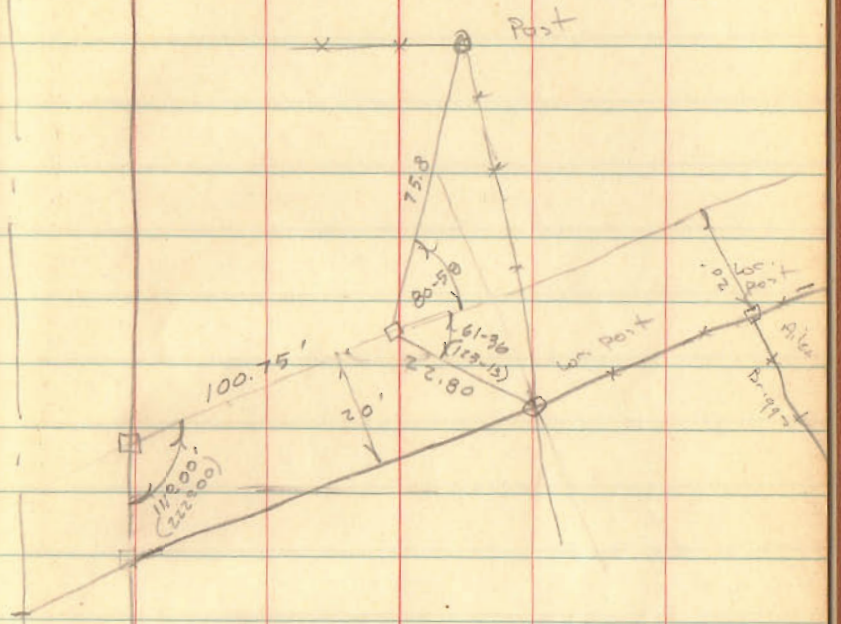

INDEXED ON MAP
2587

11/3/65
76

Wolf Island

J. Timmermeister

R/W mons. Set @ R Corners = 0

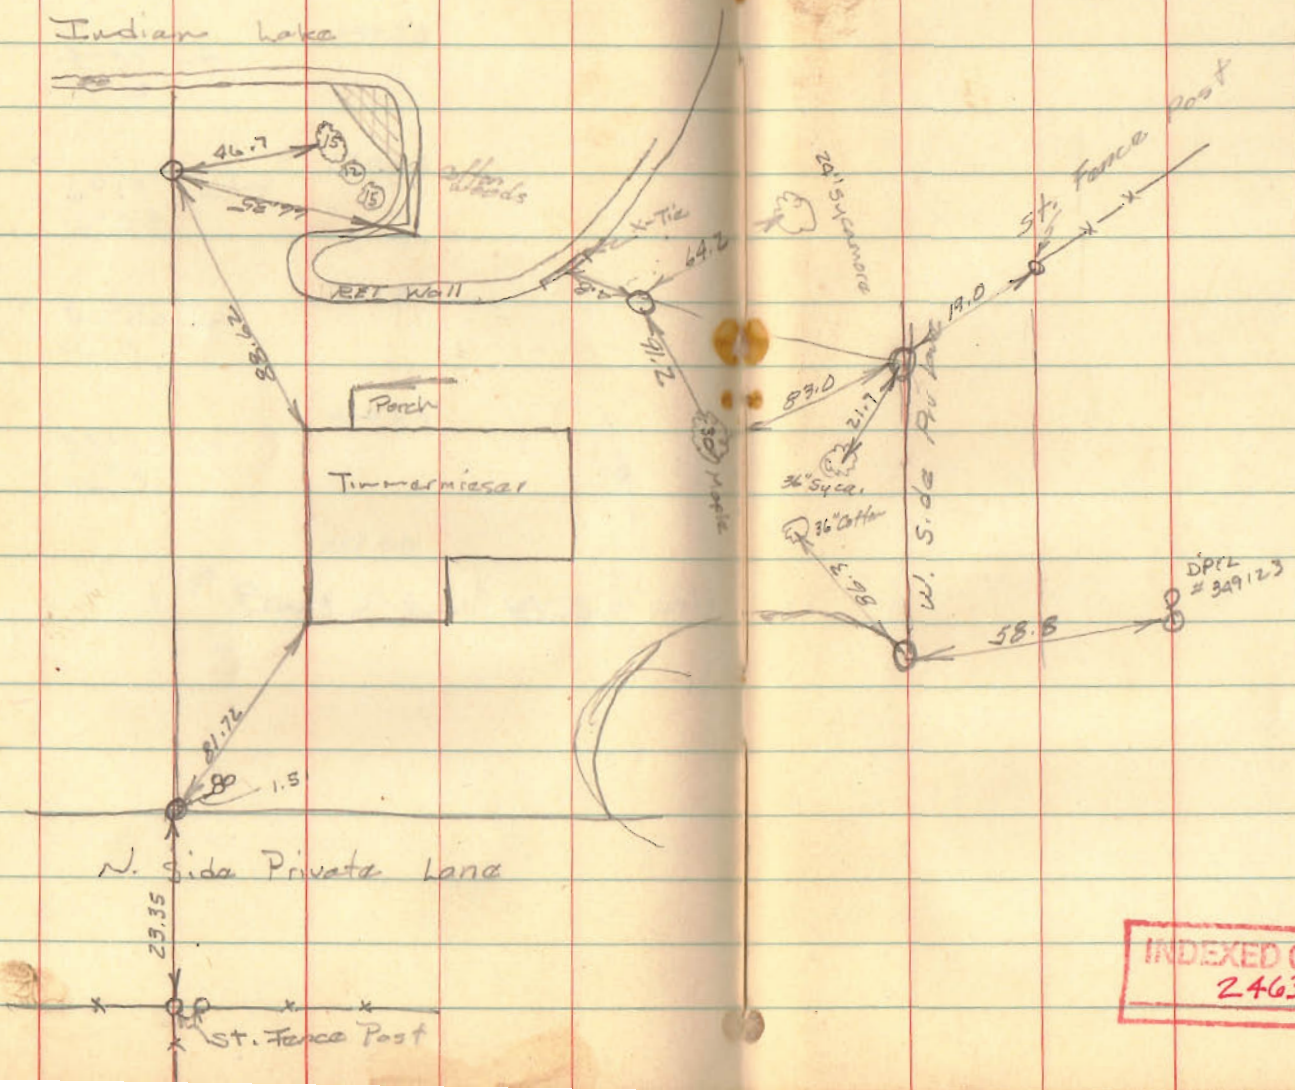

INDEXED ON MAP
2463