Index

1
2
3
4
5
6
7
8
9
10
Time for 226 Monuments 11
226 Sec A 5+00 to 8+00 12
" " 10 to 17 13
" " 19 to 32 14
" " 37 to 51 15
" " 52 to 66 16
" " 67 to 75 17
" " 81 to 86 18
" " 87 to 94 19
" " 95 to 97 20
20
" " 97 to End 21

INDEX

21
22
23 235 Sec A. Monuments
24 Time
25 St. 0 to 12+26.8
26 15+02 to 27+84
27 32+00 " 33+55.9 39+08
28 45+00 " 52+00
29 59+00 " 65+00
30 70+00 " 85+00
31 91+00 " 96+44
32 102+00 " 112+00
33 117+00 " 135+00
34 135+89 " 147+07
35 147+42 " 151+52.6
36
37
38
39
40

INDEX

41
42
43
44
45
46
47
48
49
50
51
52
53
54
55
56
57
58
59
60

735 Sec B.

Monuments 317+36 to 324+89
330 — 336
340 353+06
335-90 366+55
370+45 378
383 — 395+96
401 — 428
433 — 453
458 — 475+71
480+87 — 490
494 — 505

INDEX

510+91 — 518+05

518+65 — 527+68 61

530+92 — 535+26 62

542+00 — 559+00 63

564+00 587+89 64

596+00 — 605+00 65

66

Road. 88 Stokes Twp. 67

" " " " 68

" " " " 69

" " " " 70

" " " " 71

Road No. 219 Lake Twp. Survey 72

" " " " " " 73

" " " " " " 74

" " " " " " 75

" " " " " " 76

Bridge Orchard Island Road North. 77

" " " " " 78

" " " " " 79

80

I.C.H 226

Nov 1930 Sat.	Grid		
3	2		
1	1		E.K. Bridge
1½	1		Hugh Baier
1½	1		Richard Shultz
1½	1		Dwight Gossard
1	1		B.O. Downing
1	1		Chas. Downing
1	1		Ross Antrim
1	1		Irvin Wickersham
			John. McFarran
			Lunch
			Paid By
45	45		Livery McKinahan States
		Nancements 226 Sec B 226 " B	Work.

226

Monument 8+00

Monument St 3+00

May - 2 - 1930

E.K. Bridge
Hugh Baier
Richard Shultz
Dwight Gossard

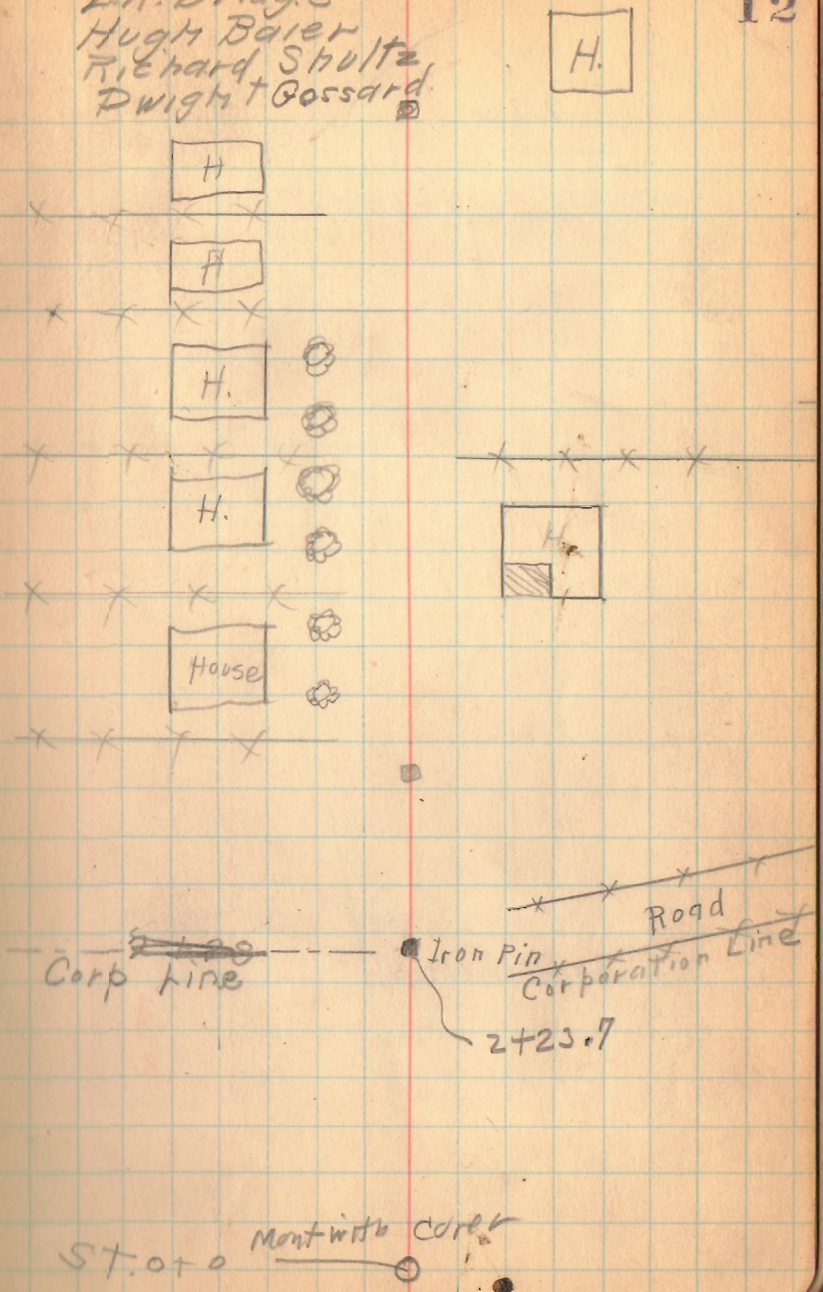

226

Monument 17+00

Monument 11+00

5-2-30

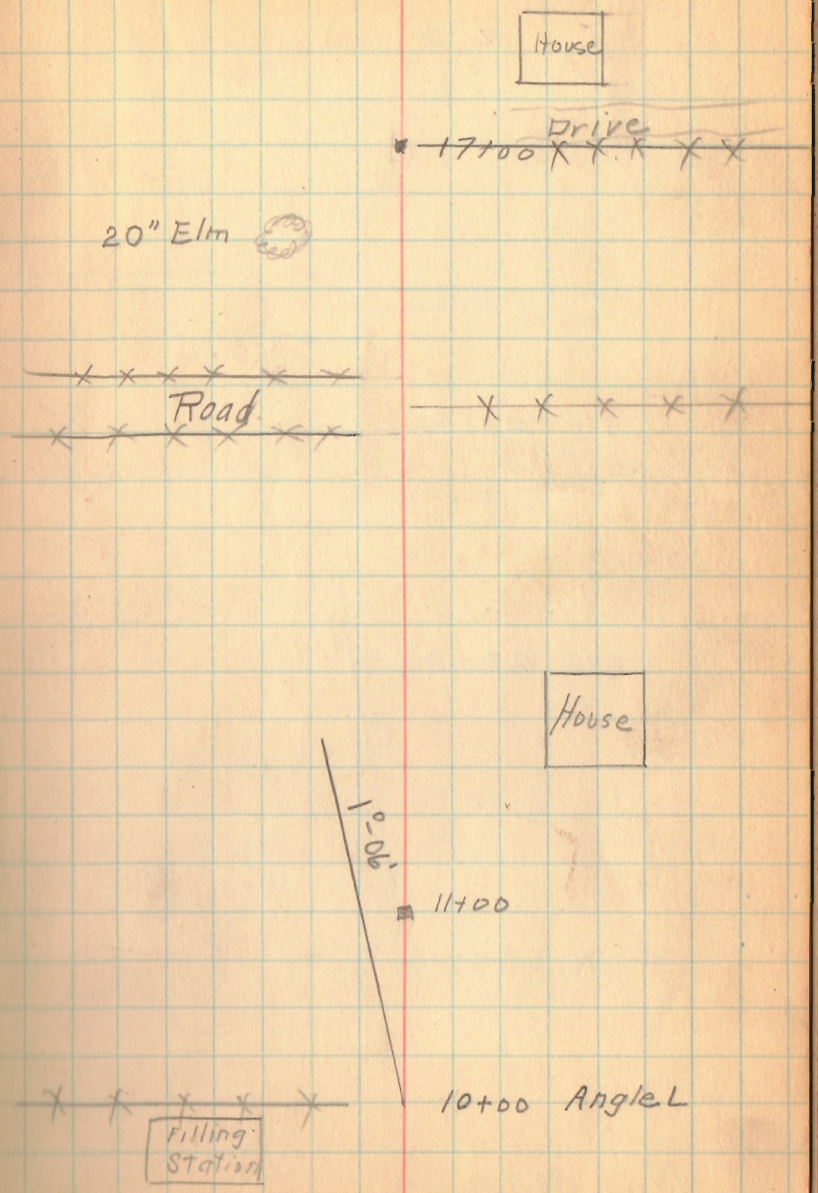

29.95 Lt
29.92 Rt
Capped Nail

226

Mon 32+00

Mon 27+00

29.90' Rt
RR Spkg Set

Mon. 22+00

Mon. 19+00

5-2-30

LANE

32+00

Dwight Stewart

Isaac Sours

Slab Top Culvert

27+00

L.H. Poulson

C.B. Sparks

Barn

22+00

0°-35'

Drive

House

3' Maple

20+00 Angle L

19+00

226

Set Copperweld

Mon 51+00

Set RR spike 29.98'

Mon. 46+00

Mon 41+00

Mon. 37+00

5/2/30

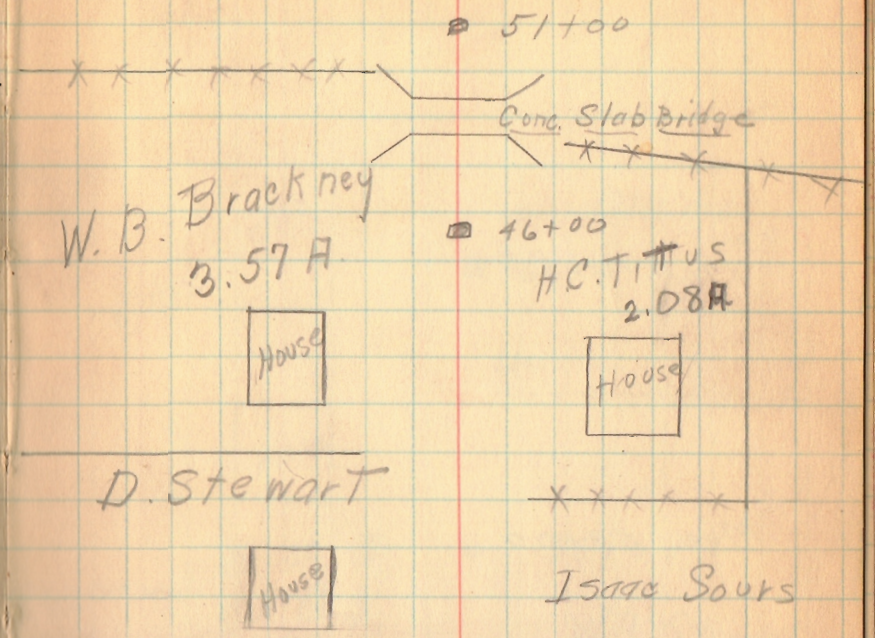

E.K. Bridge
D. Bossard.
H. Baier
R. Shultz

726

Mon. 75+00 Both sides

~~Mon. 73+00 Left only~~

Mon 72+50 45' Left. 30' Right

Mon 69+00 45 feet Left 30 feet Right

Mon. 68+00 Both sides

5/3/30

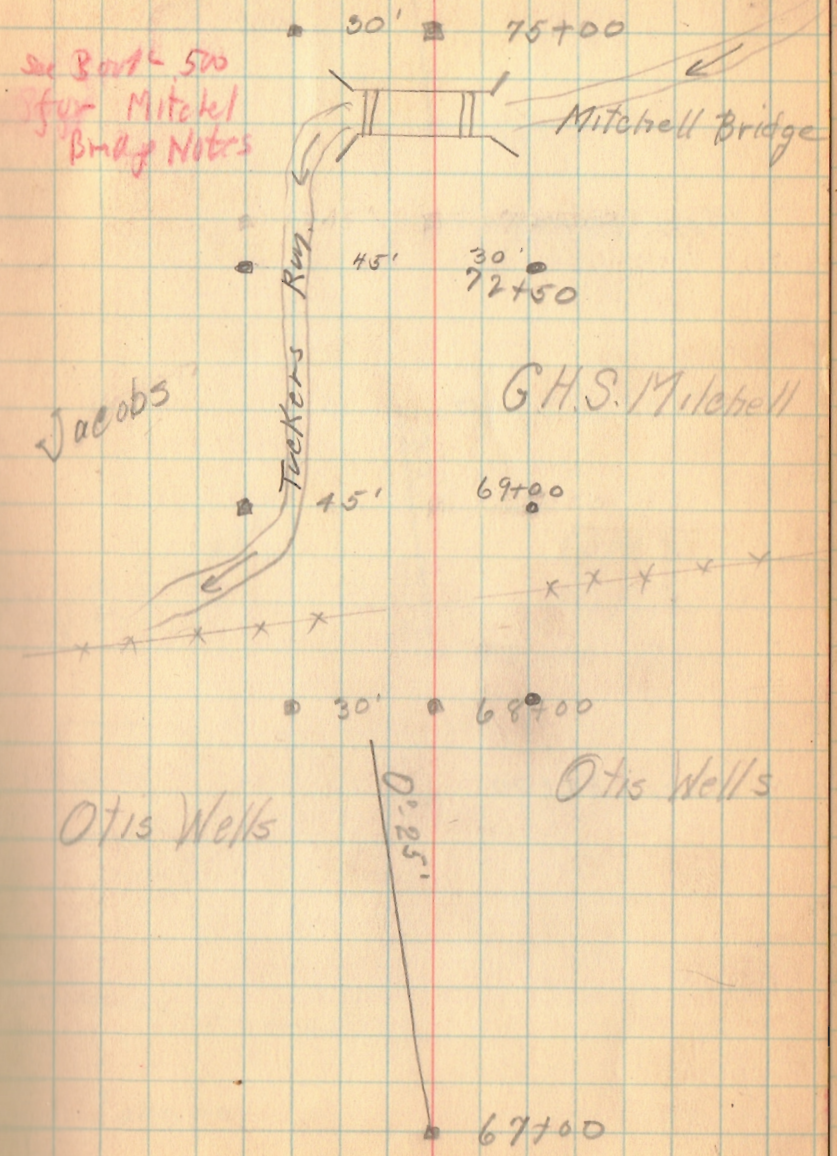

Mon. 85+00

Mon. 83+00

Mon. 81+00

5/3/30

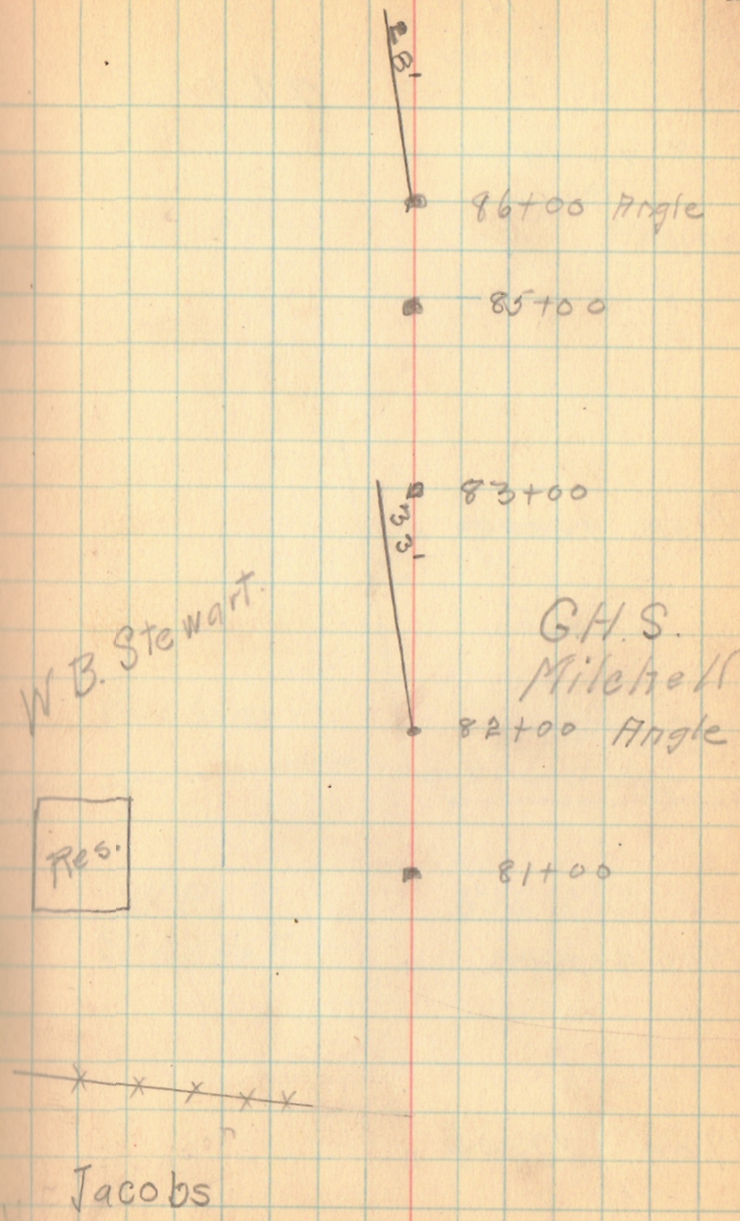

E.K. Bridge
John McKarian
D. Gossard
H. Baier
R. Smoltz

226

Mon. 94+00

Mon. 90+00

Mon 88+00

Mon. 87+00

5/5/30

94+00

L.M. Stereson

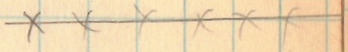

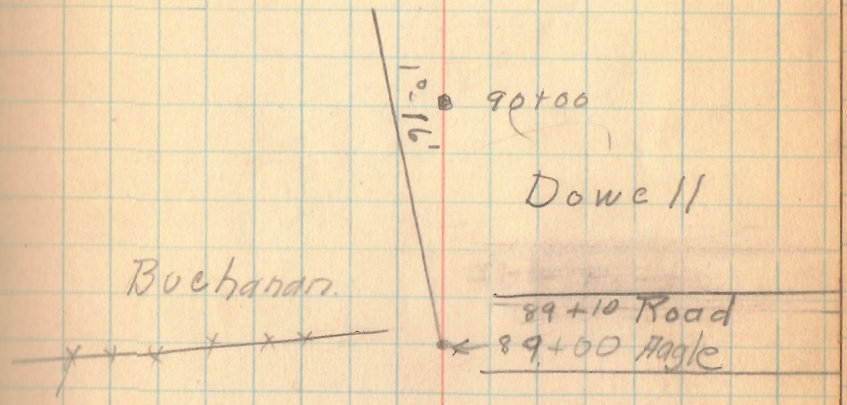

5/5/30

276

Mon 97+00

R.R property

Milton Shick.

C.C.C. & St. L. R.R.

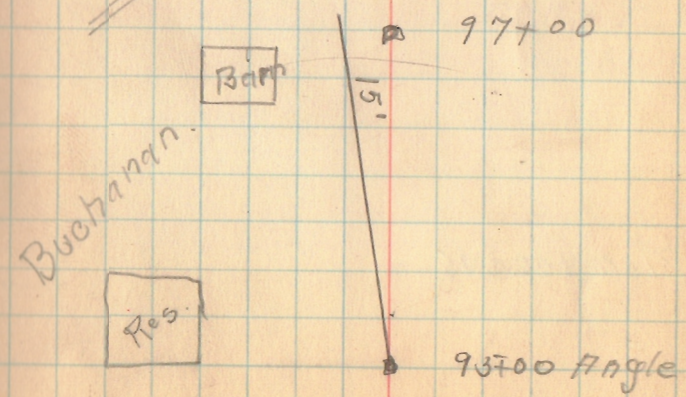

226

Mon. 102+95

(Continued in Book 404 Page 1)

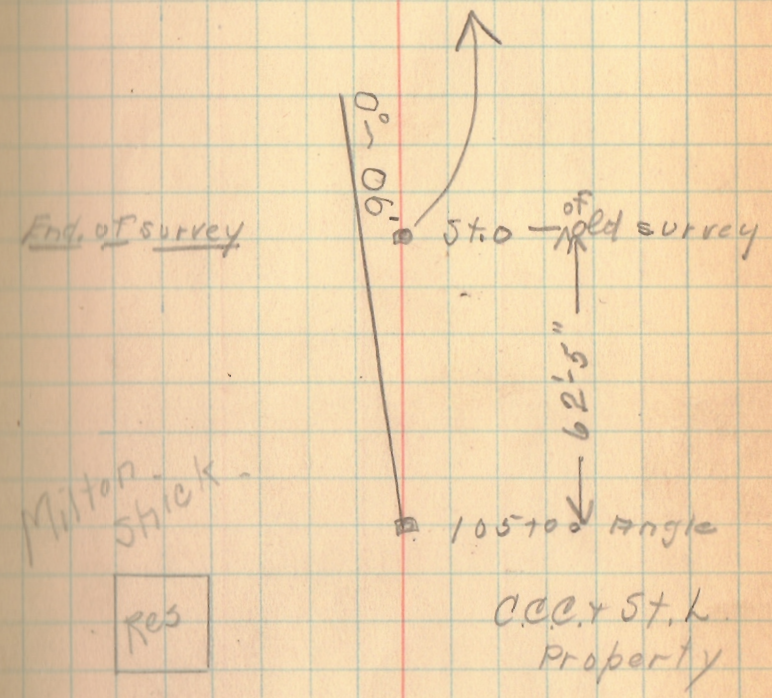

May	1930	E.K. Bridge	D. Gossard	H. Baier	A. Shultz	B.O. Downing	Chas. Downing	Iran Wickersham	Ross Antrim	Lunch	Paid By	Livery McKinnahan	Work. Monuments
Tues.	6	1	1	1	1			1	1			35 sec A	Sec A.
Wed.	7	1	1	1	1	1	1	1	1	sec A		40 sec A	" A
Thurs	8	1	1	1	1	1	1	1	1	50	Bridge	45 sec B	" B
Frid	9	1	1	1	1	1	1	1	1	55	"	30 sec B	" B
Sat	10	1	1		1	1	1	1	1	55	"	30 sec B	" B
Mon.	12					1	1	1	1				" B
Tue.	13					1	1	1	1				" B.
Wed.	14					1	1	1	1				" B
Thur.	15					1	1	1	1				" B

235 Sec A

Mon P.T. 12+26.5

Mon. P.C. 10+51.8

Mon 5+00

Mon. 3+00

Mon 0+00

See Book 433 for original notes

E.K. Bridge
H. Baier
R. Shultz
D Gassard
I. Wickersham
R. Antrim

Alice Reams.

5/6/30

25

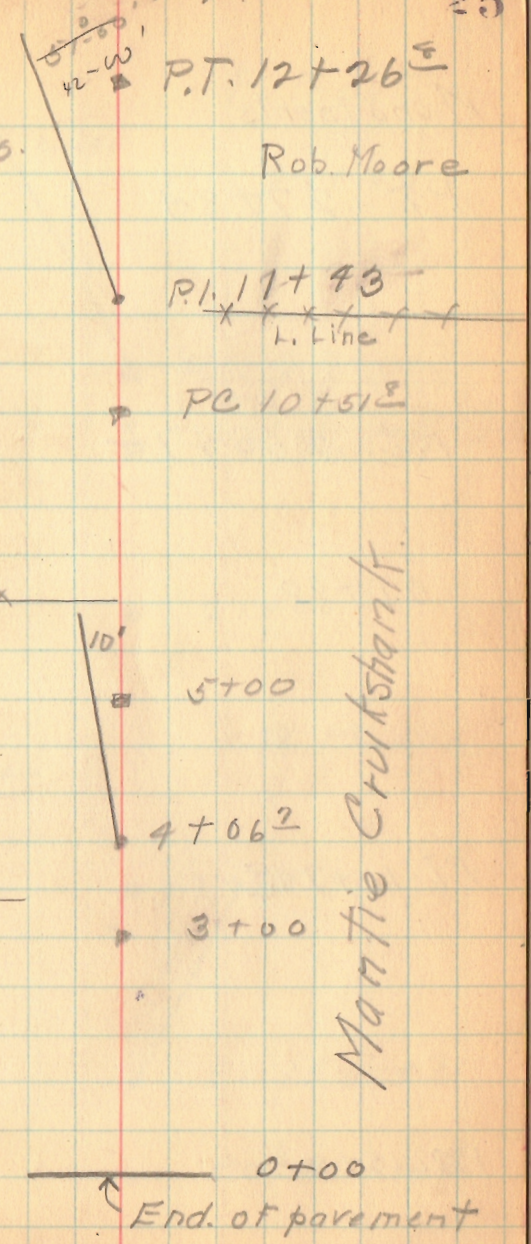

235 Sec A

Monuments

P.T. 27+84.

*
T.81

P.C. 26+27 2

21+00

P.T. 16+74 5

P.C. 15+02 2

5/6/30

F. Beatty

37°40'

P.T. 27+84

P.L. 27+99 2
W.L. Daniels
P.C. 26+27 5

P.E. Beatty

21+00

R. Moore

t. Line

51°09' P.T. 16+74.5

Reams

P.I. 15+95 3

P.C. 15+02 5

235

Monuments

P.T. 39+08 ℄

P.C. 37+55 ℄

32+00

5/6/30

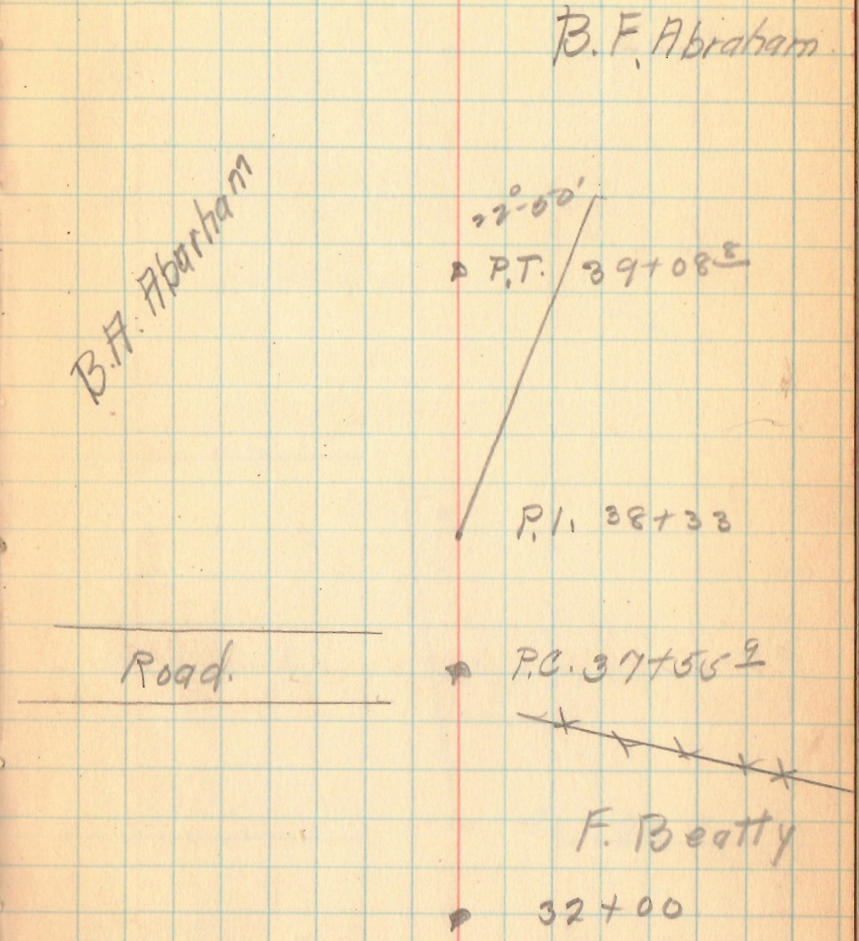

235 F.K. Bridge
H Baret
D. Bossard
R. Stullz
I. Wickersham
R. Antrim

Monuments

52+00

47+00

45+00

5/7/30

28

W.A. Wallace

52+00

Lena Easton

C.D. Campbell

1°00'

Ottie Sutton

47+00

46+08 Angle

B.F. Abraham

45+00

Monuments

65+00

63+00

62+00

59+00

MR. Allen

Campbell

65+00

1° 15'

63+85 Angle

63+00

62+00

15'

60+78 Angle

59+00

Wallace

Campbell

Monuments

85+00

81+00

79+00

75+00

70+00

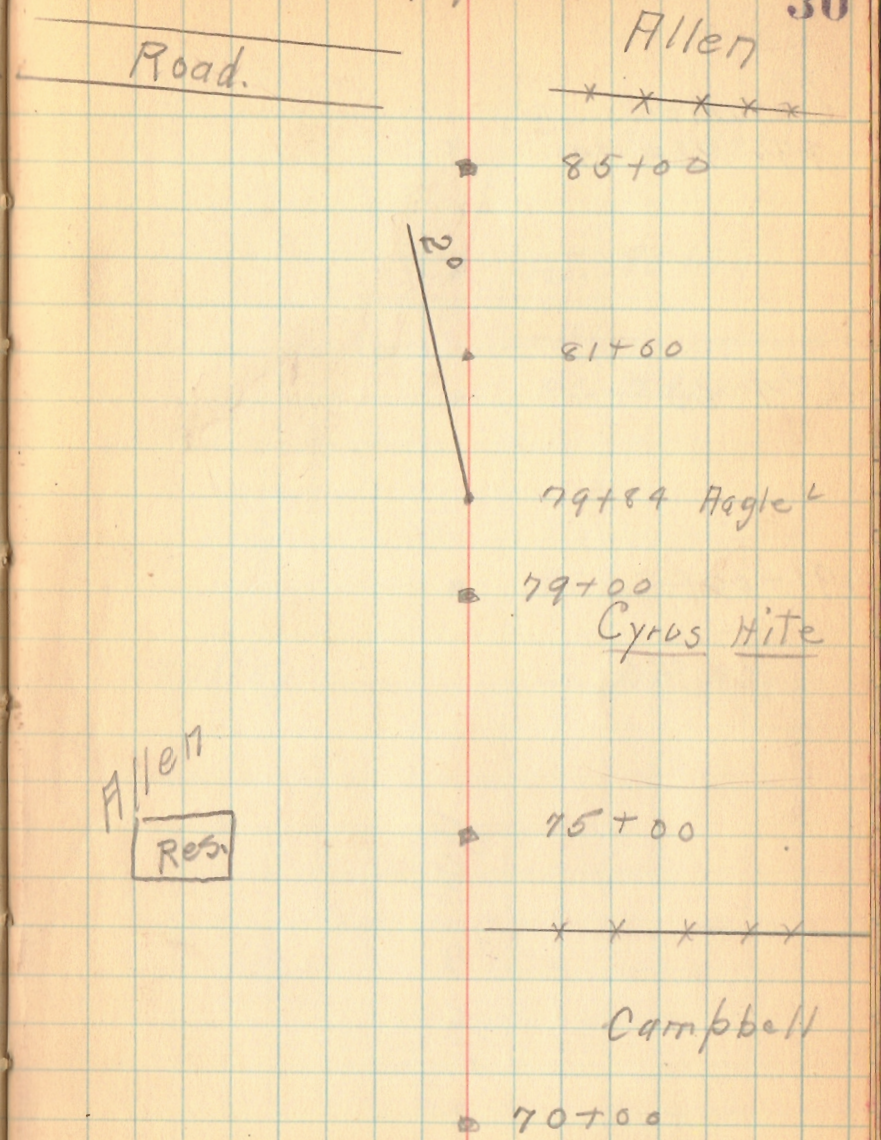

235

Monoments
P.T. 96+44

PC 94+60 ±

91+00

5/7/30

Jamison

P.T. 96+44

P.I. 95+53

PC 94+60 ±

91+00

Wolfey

M.R. Allen

Angle Not on plans or Notes

235

Monuments

112+00

110+00

109+00

107+00

102+00

5/7/30

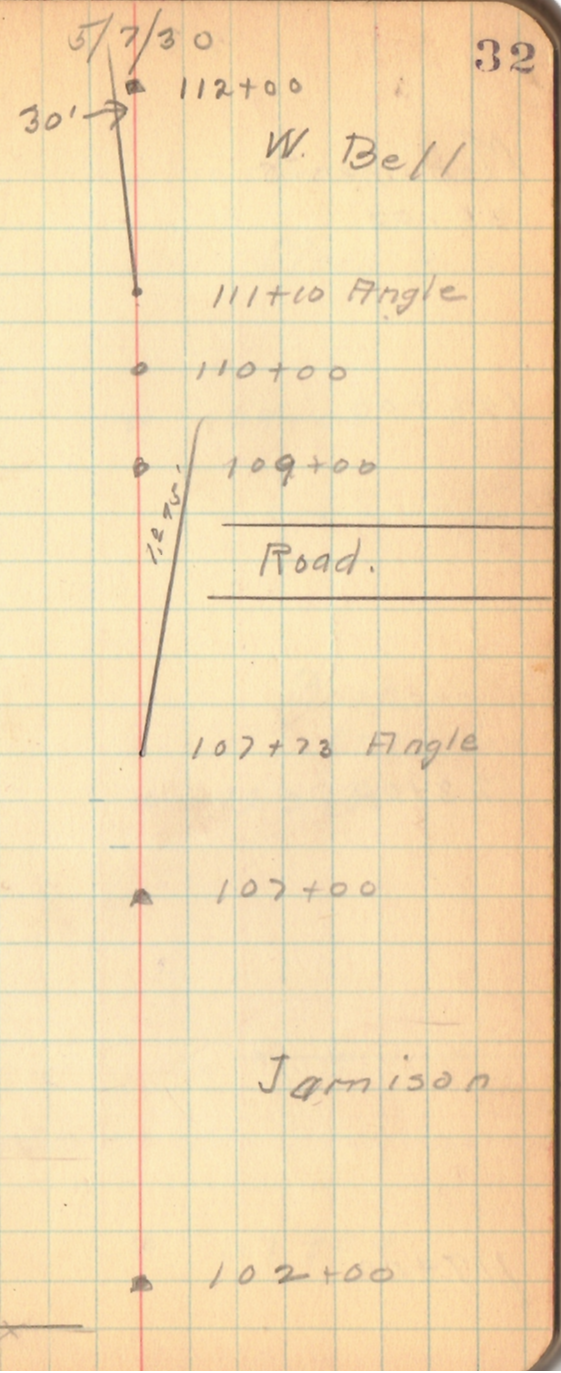

W. Bell

Monuments

135+00

129+00

123+00

117+00

135+00

Mary Baker

129+00

W. L. Bell

Barbara Sherman

123+00

117+00

235

Monuments
P.T. 147+07.3

P.C. 146+07.3

142+00

137+00

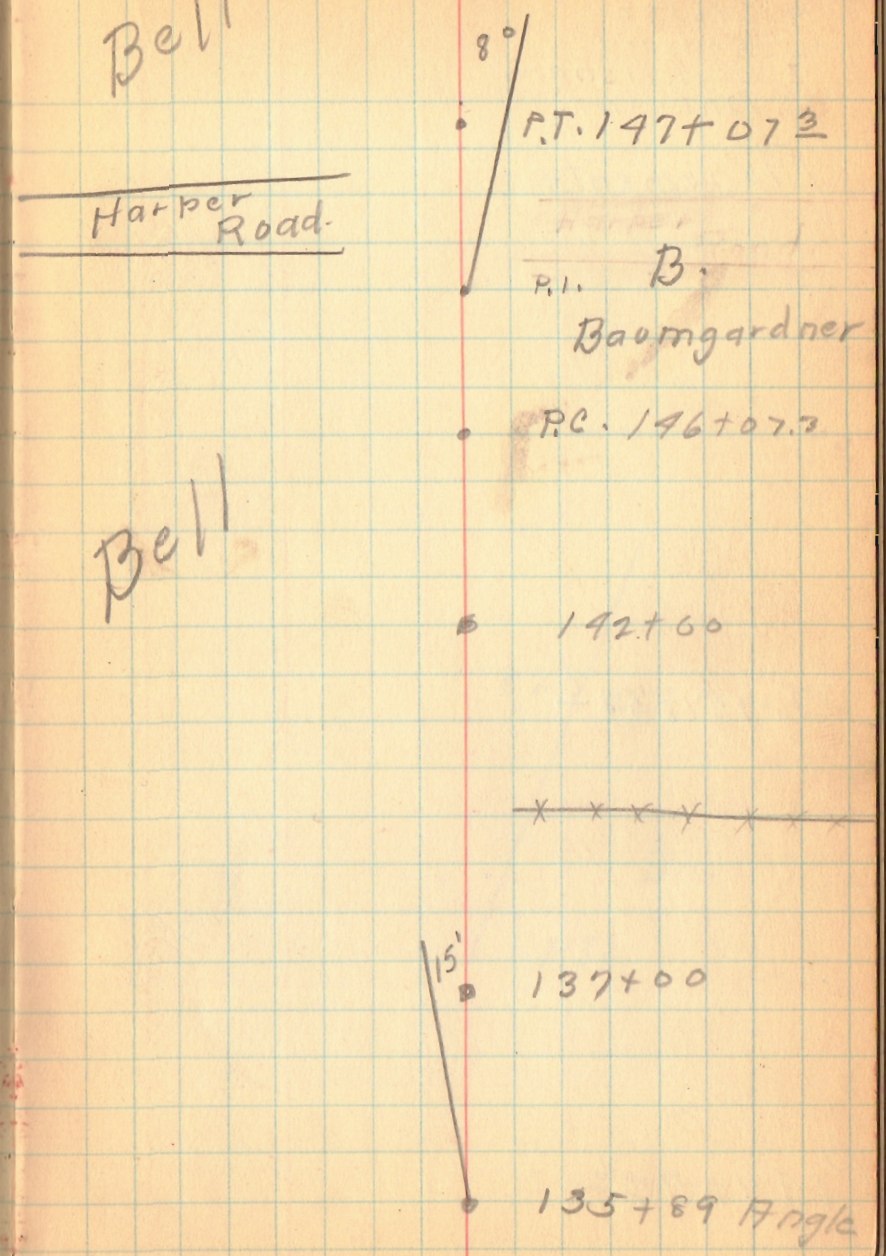

E. Bridge
H. Baier
R. Stultz
D. Possard.
I. Wickersham
R. Antrim

Monuments

PT. 151+52 ℄

PC. 147+42 ℄

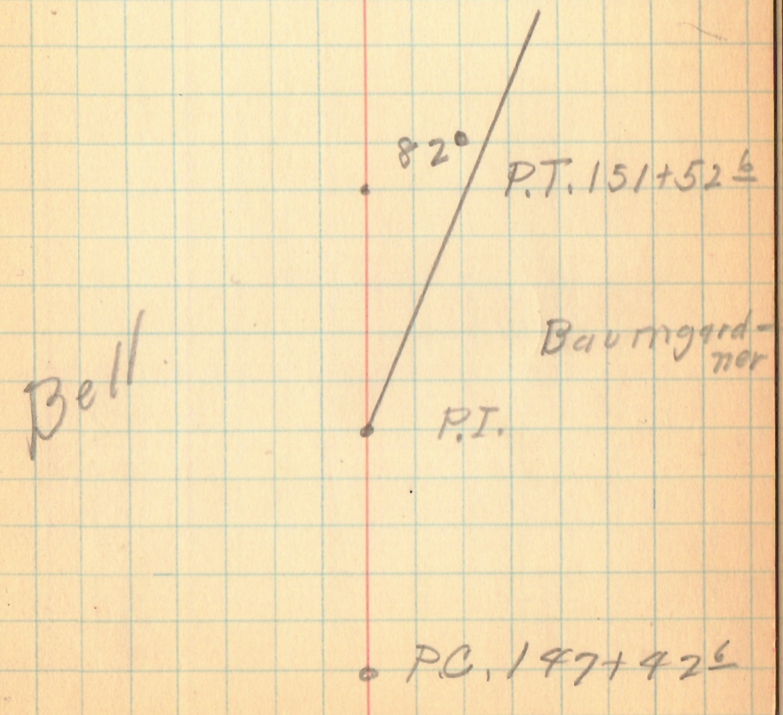

235 Sec B

Monuments

327+42.1 P.T

324+89 P.C

322+00

319+00

312+36

5/8/30

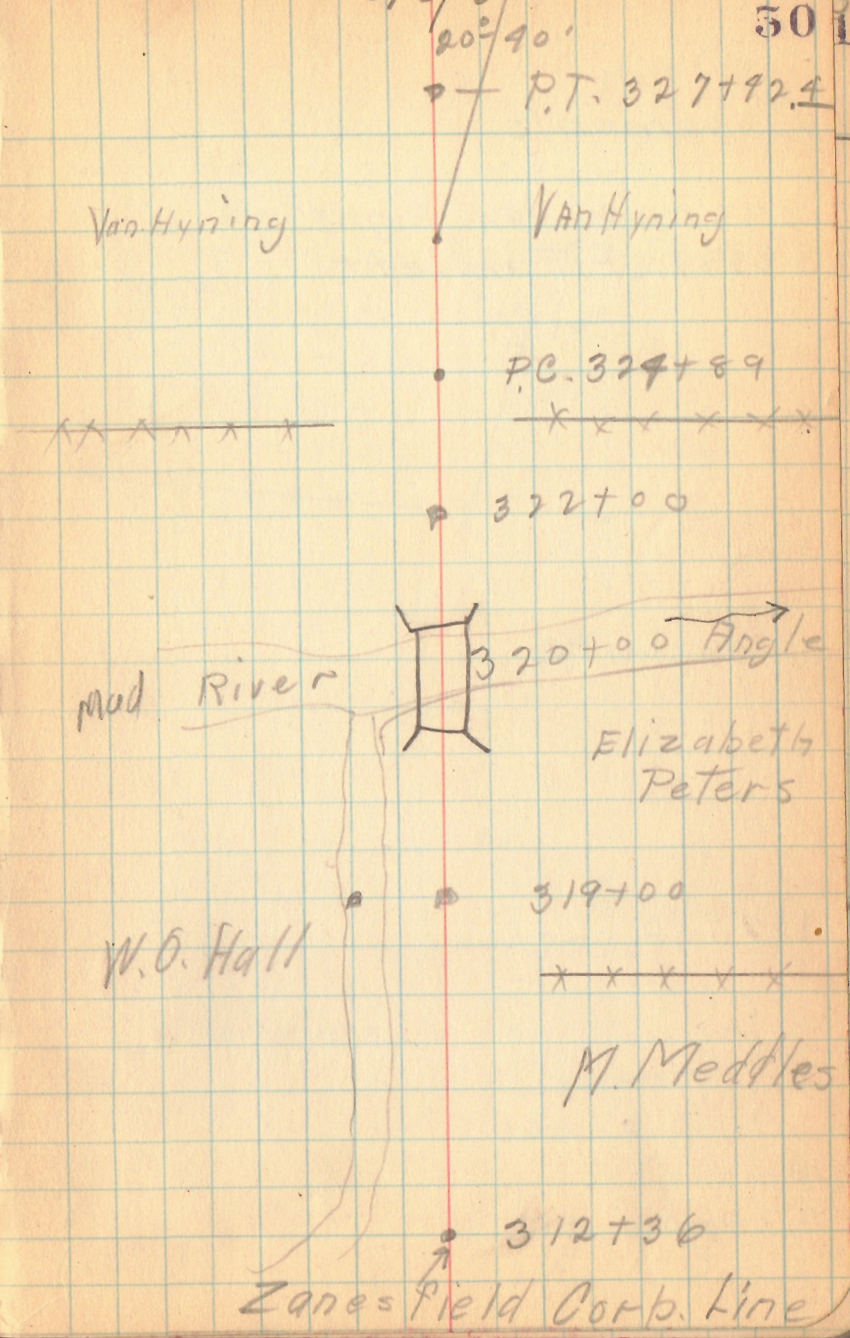

235 Sec B

Monuments

336+00 on Right
335+91 P.T. on Left

333+66 PC

332+50

330+00

3/8/30

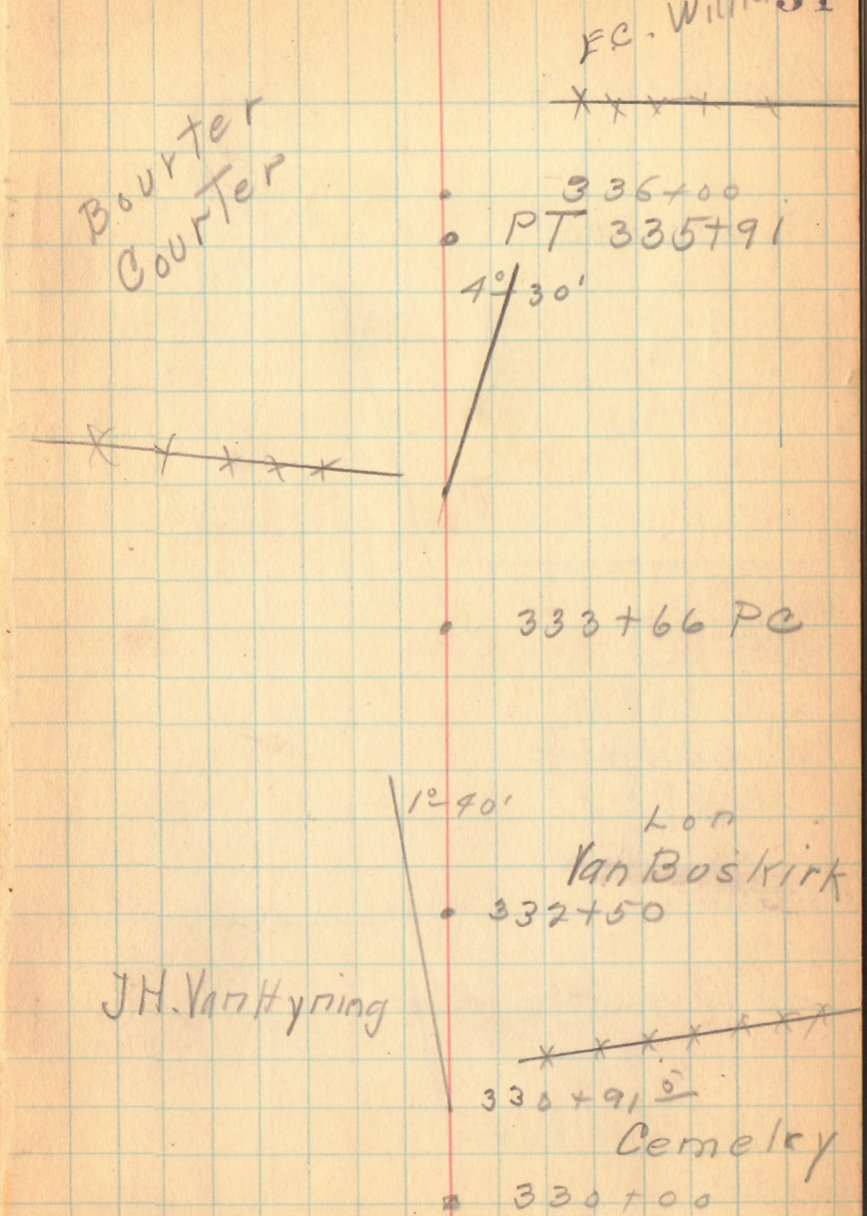

Monuments

P.T. 353+06 ℓ

P.C. 350+45 ℓ

343+00

340+00

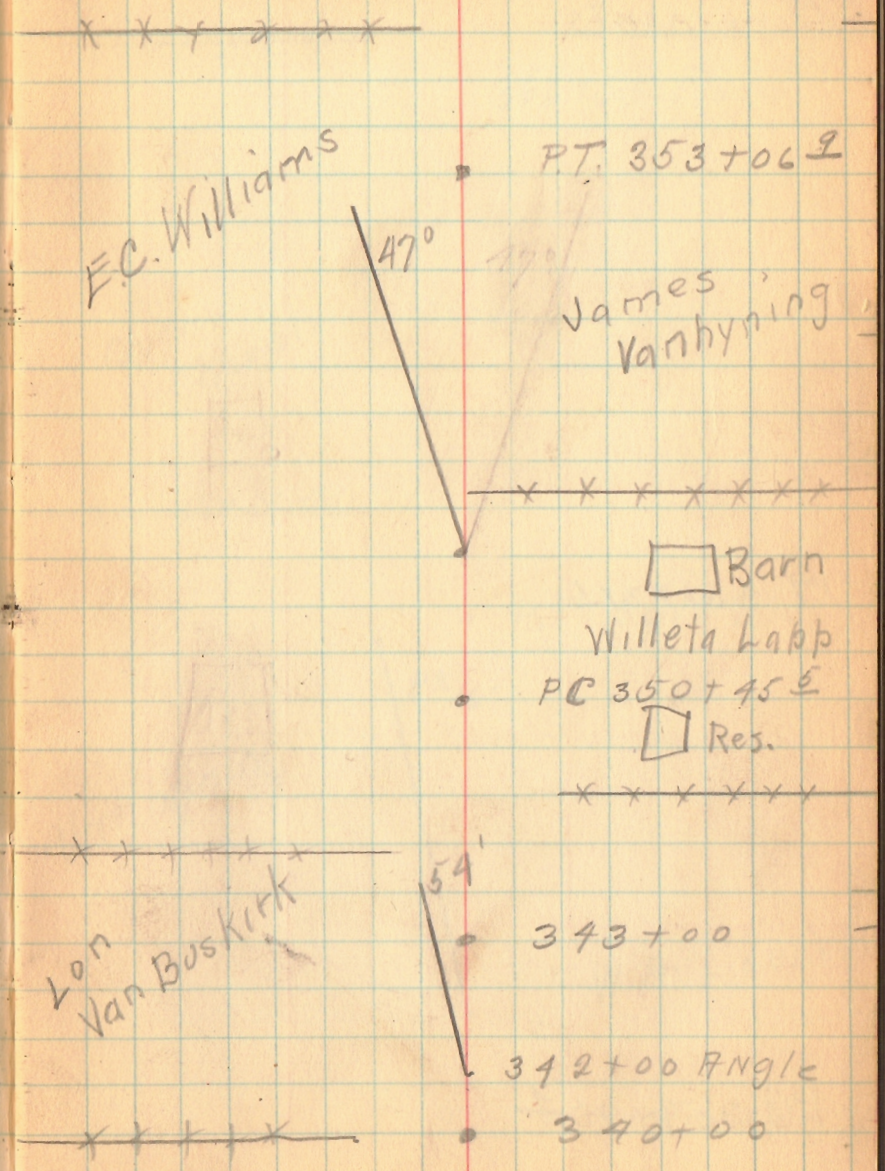

235 Sec B

Monuments

P.T. 361+31.1

P.C. 359+90.1

E H Thompson 5/8/30

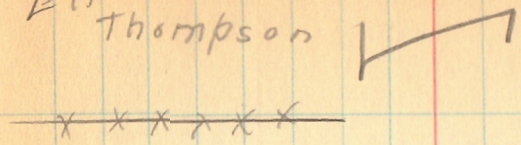

366+55 Road

Quaker Church.

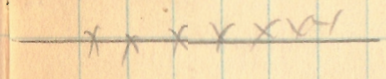

P.T. 361+31.1

11°16'

Vantuyning

W A Louden

P.C. 359+90.1

235 Sec A

5/8/30

Monuments

378+00 ~~Right only~~ 50' on Left

P.T. 372+49

P.C. 371+22

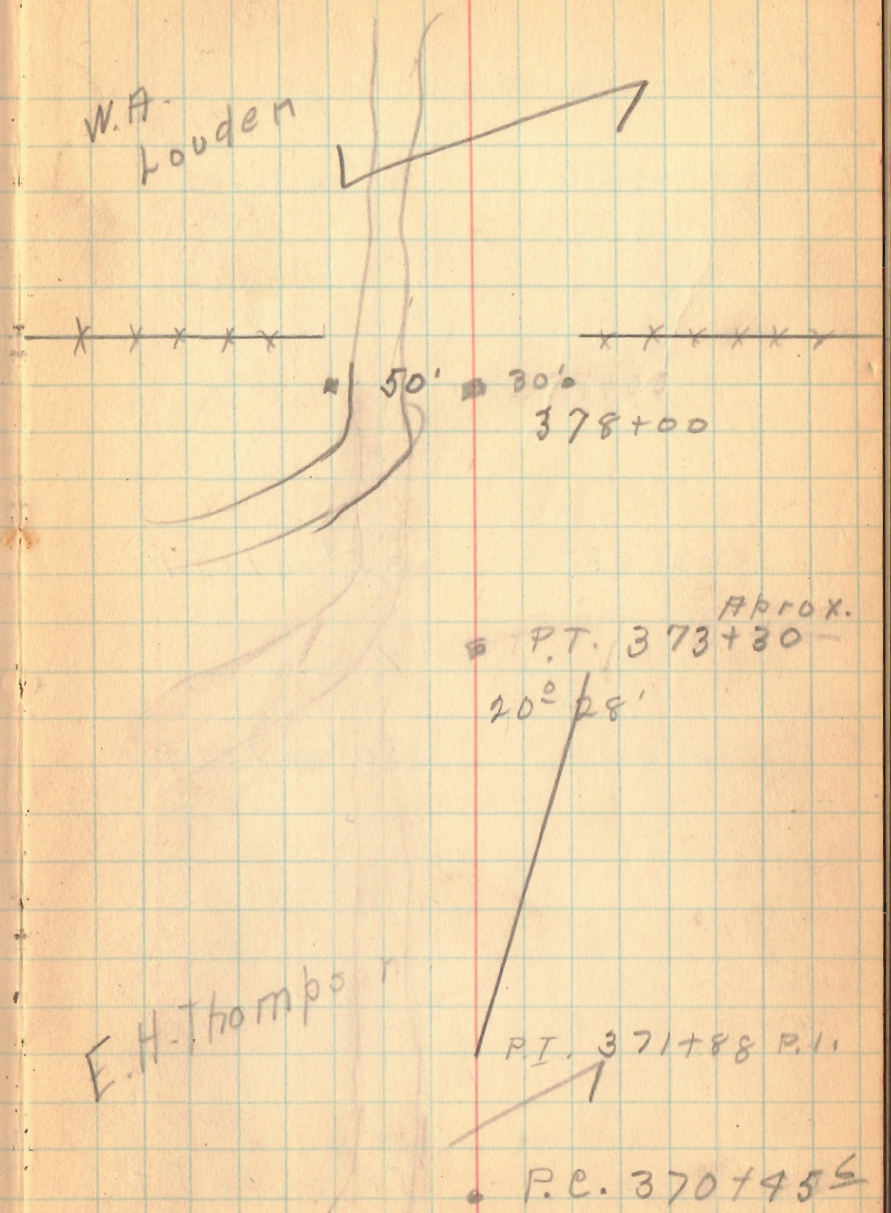

Z 35 Sec A

5/8/30

Mon

P.T. 395+96	40' on Right
P.C. 393+02.8	35' on Left
388+00	50' on Left
383+00	50' on Left

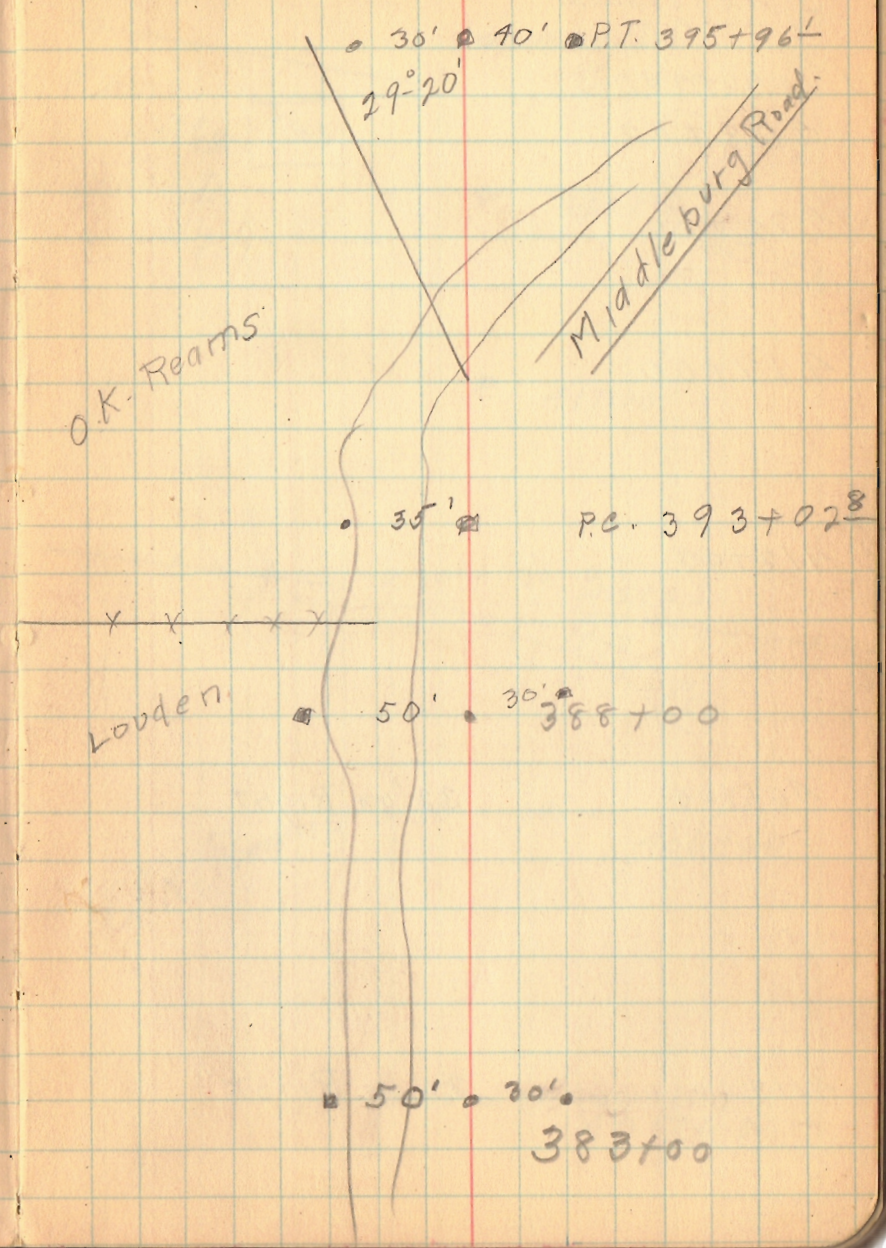

E.K. Bridge
H. Baer
M. Stutie
D. Gossard
I. Wickersham
R. Antrim

235 Sec B

Monuments

428+00

422+00

417+00

412+00

406+00 32' on Right

401+00 32' on Right

5/9/30

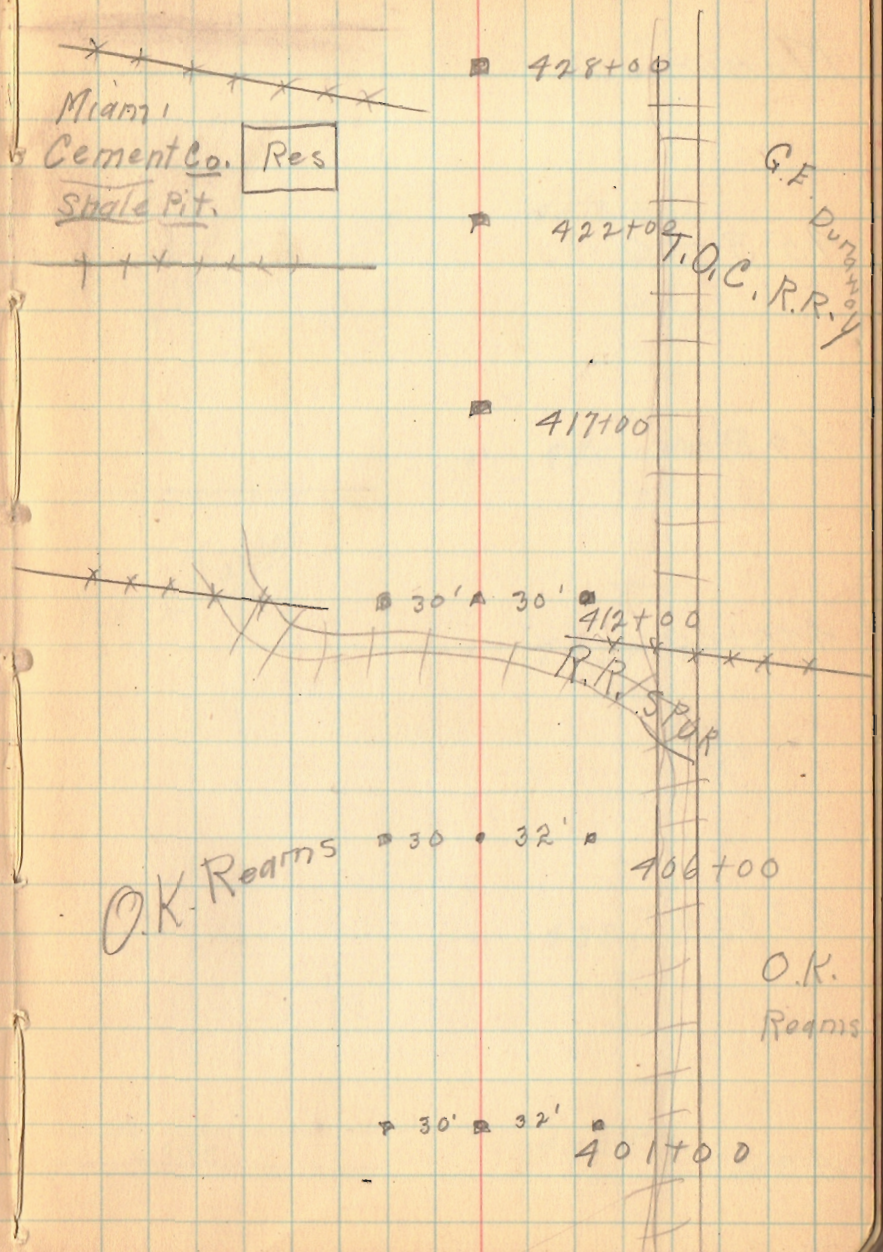

235 Sec B

Monuments

453+00

448+00

443+00

438+00

433+00

5/9/30

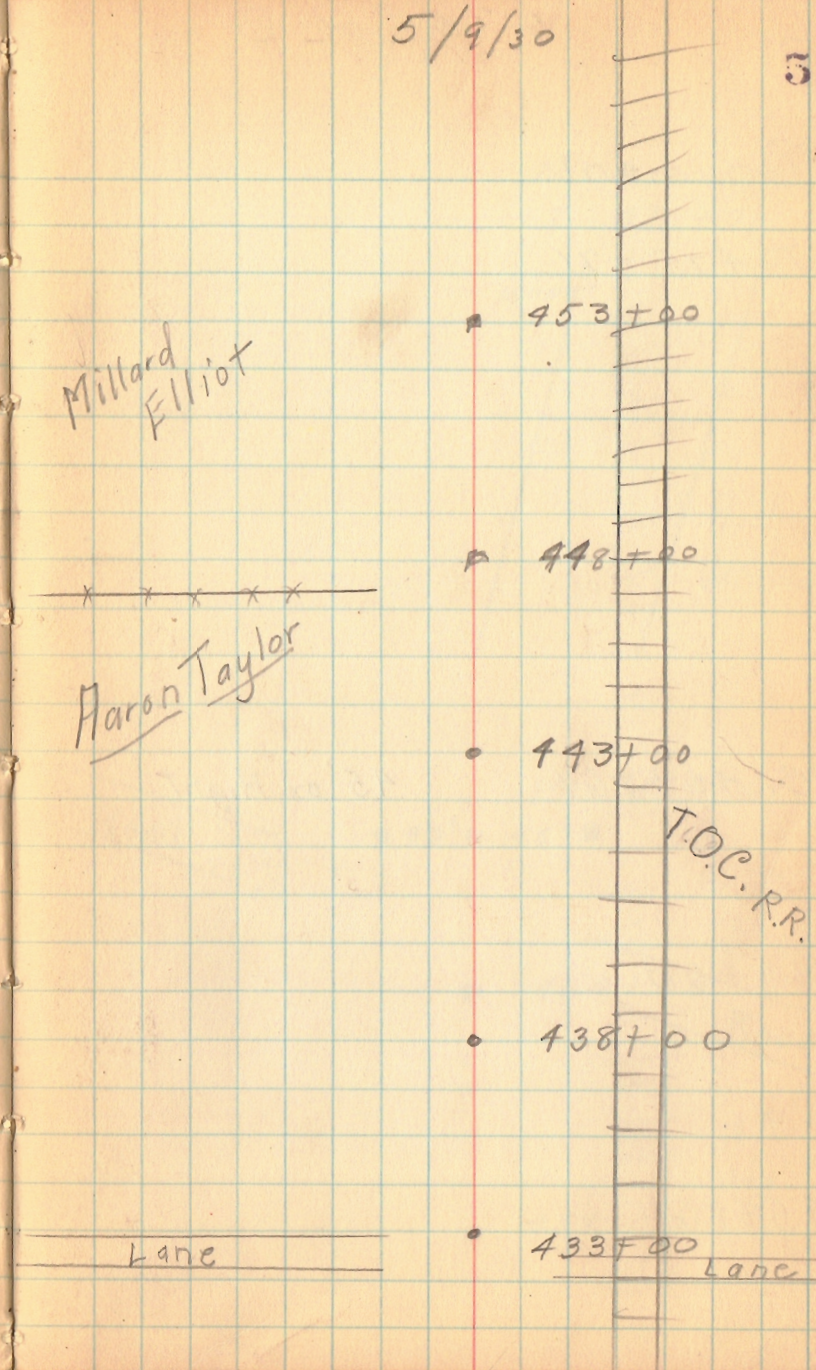

Monuments

P.T. 475+71

P.C. 469+61 45' on Right

464+00

458+00

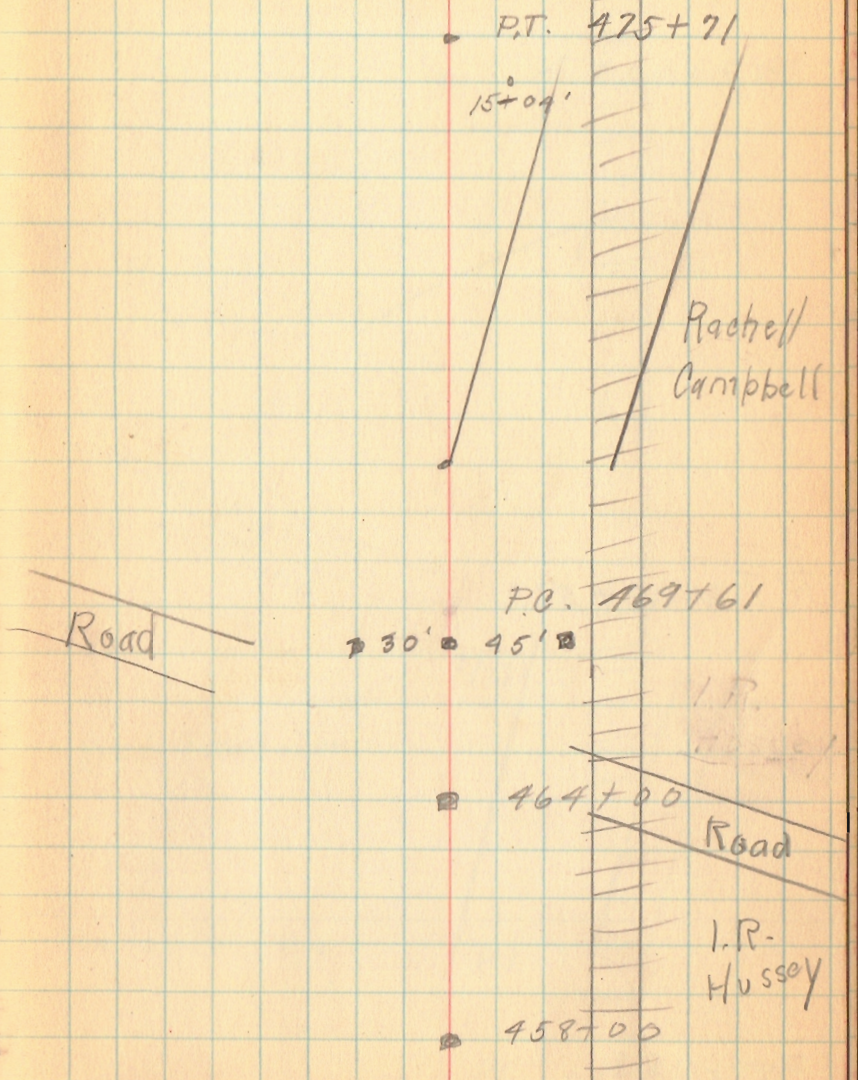

235 Sec B

Monuments

490+00

P.T. 485+21

P.C. 480+87

5/9/30

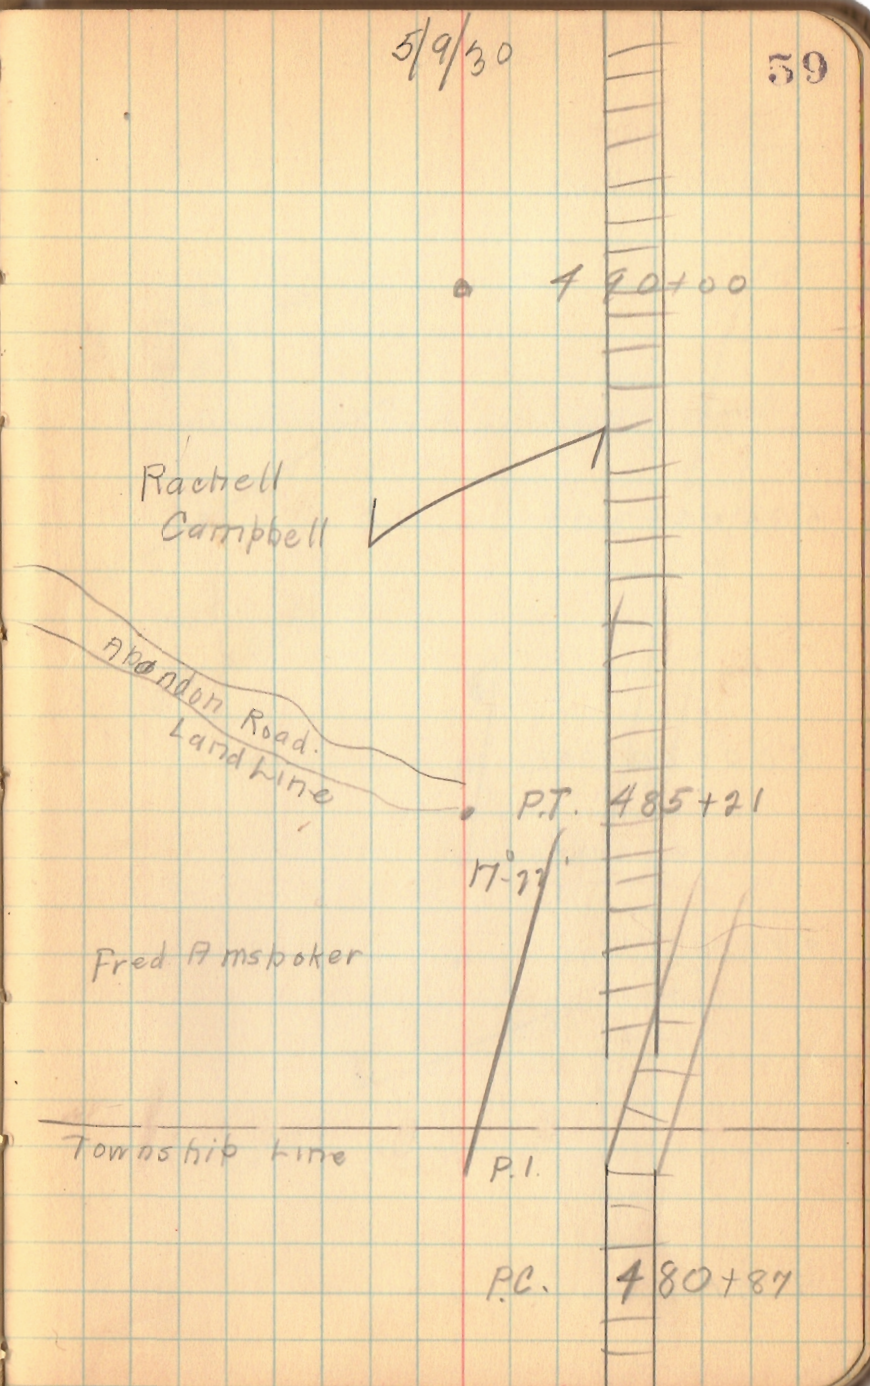

235 Sec B

Monuments

505+00

500+00

498+00

494+00

5/9/30

Ben. D. Reams

Rachel Campbell

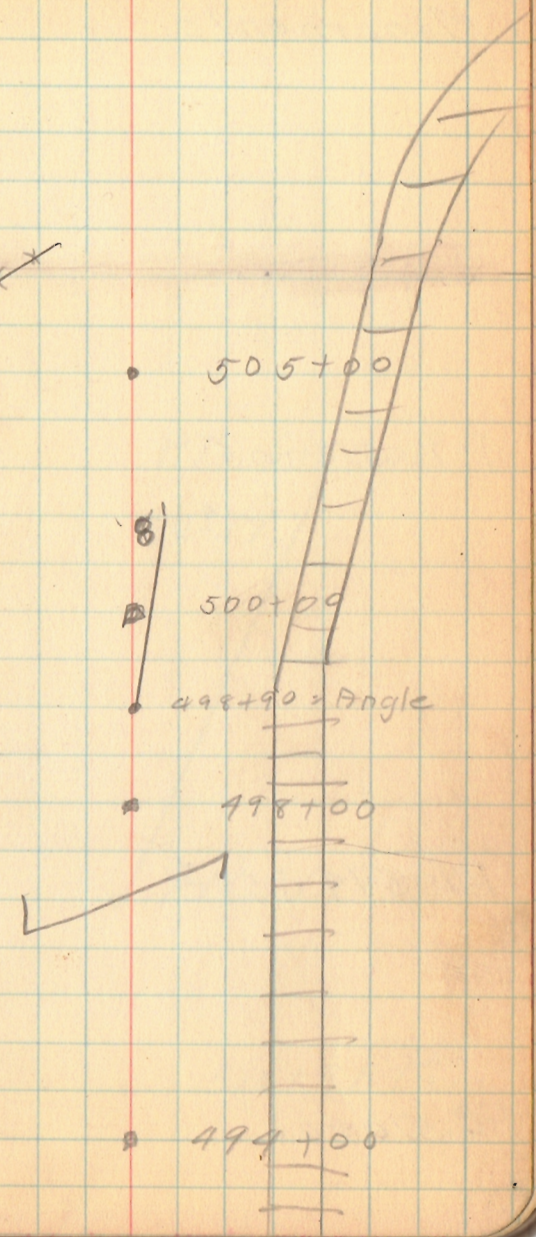

235+Sec B

Monuments

P.T. 518+05

P.I. 514+59.1

P.C. 510+00

5/9/30

P.T. 518+05

32°-17'

Ben Reams

P.I. 514+59.1

510+91 P.C.

235 Sec. B
E. Bridge
R. Stoltz
D. Gossard
I. Wickersham
R. Antrim

Monuments

PT 527+86 L

P.C. 522+95 R

P.T. 520+36 L

P.C. 518+65

5/10/30

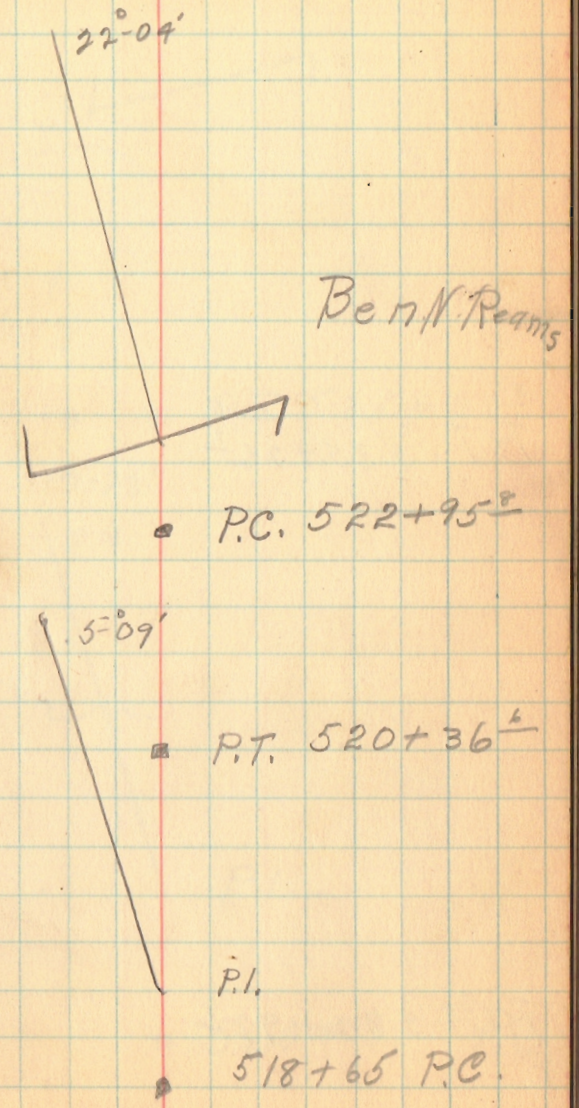

235 Sec B

Monuments

P.T. 535+26.2

P.C. 530+92.2

5/10/30

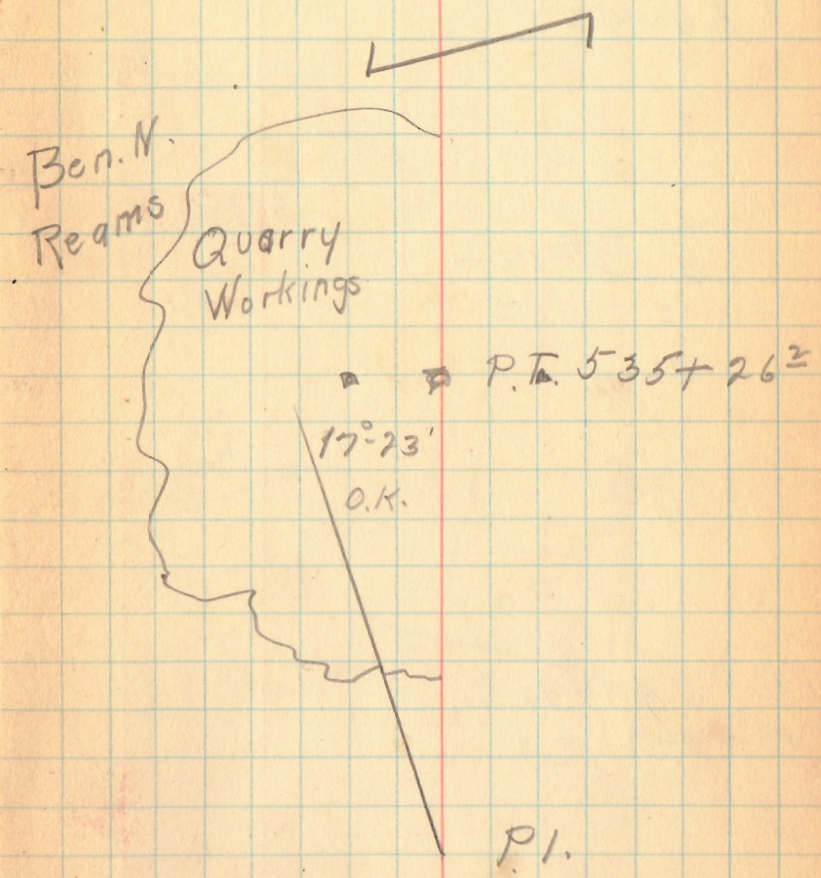

P 35 Sec B.

Monoments

559+00

P.T. 552+19.2

P.C. 549+42.2

542+00

5/10/30

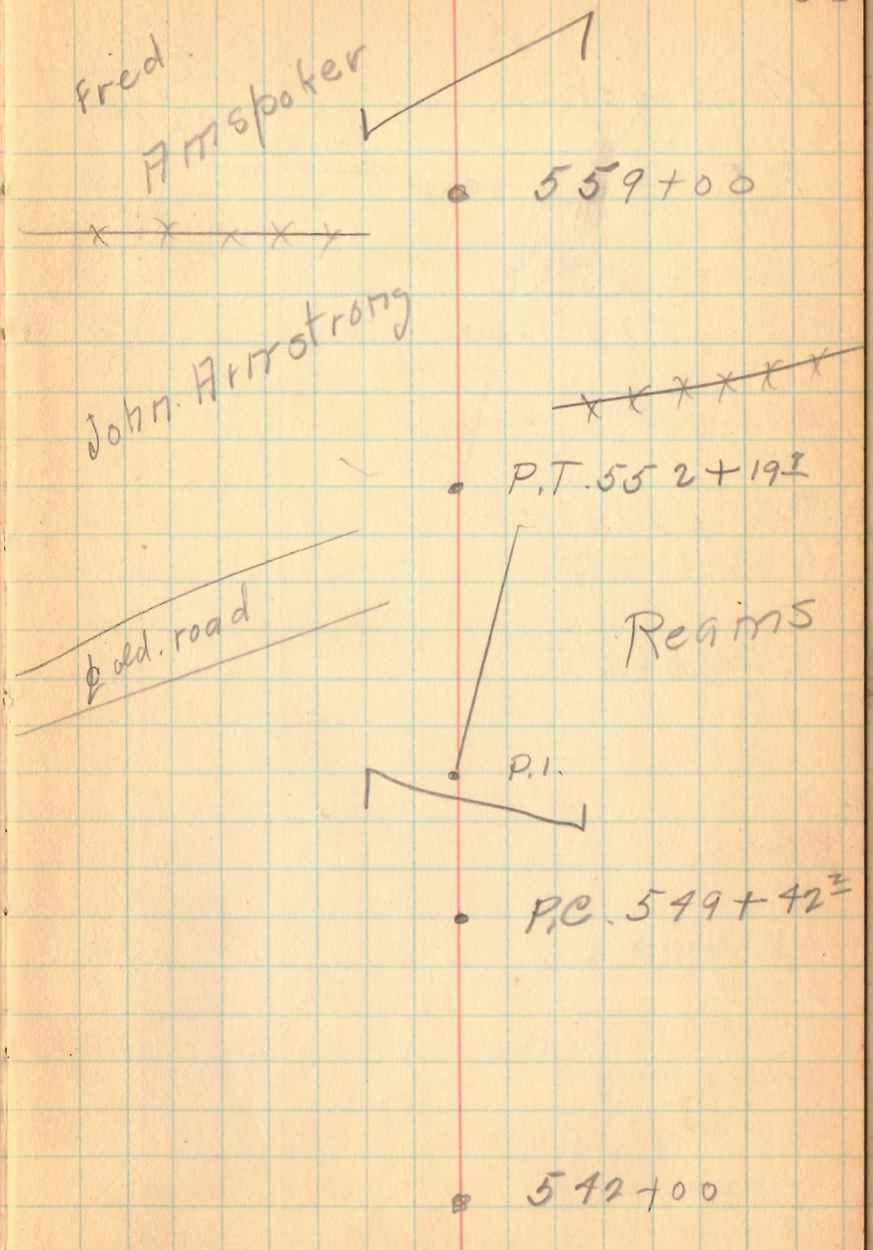

235 Sec B.

Monuments

P.T. 587+89

P.C.C. 583+64.2

P.C. 577+64.2

574+00

569+00

564+00

5/10/30

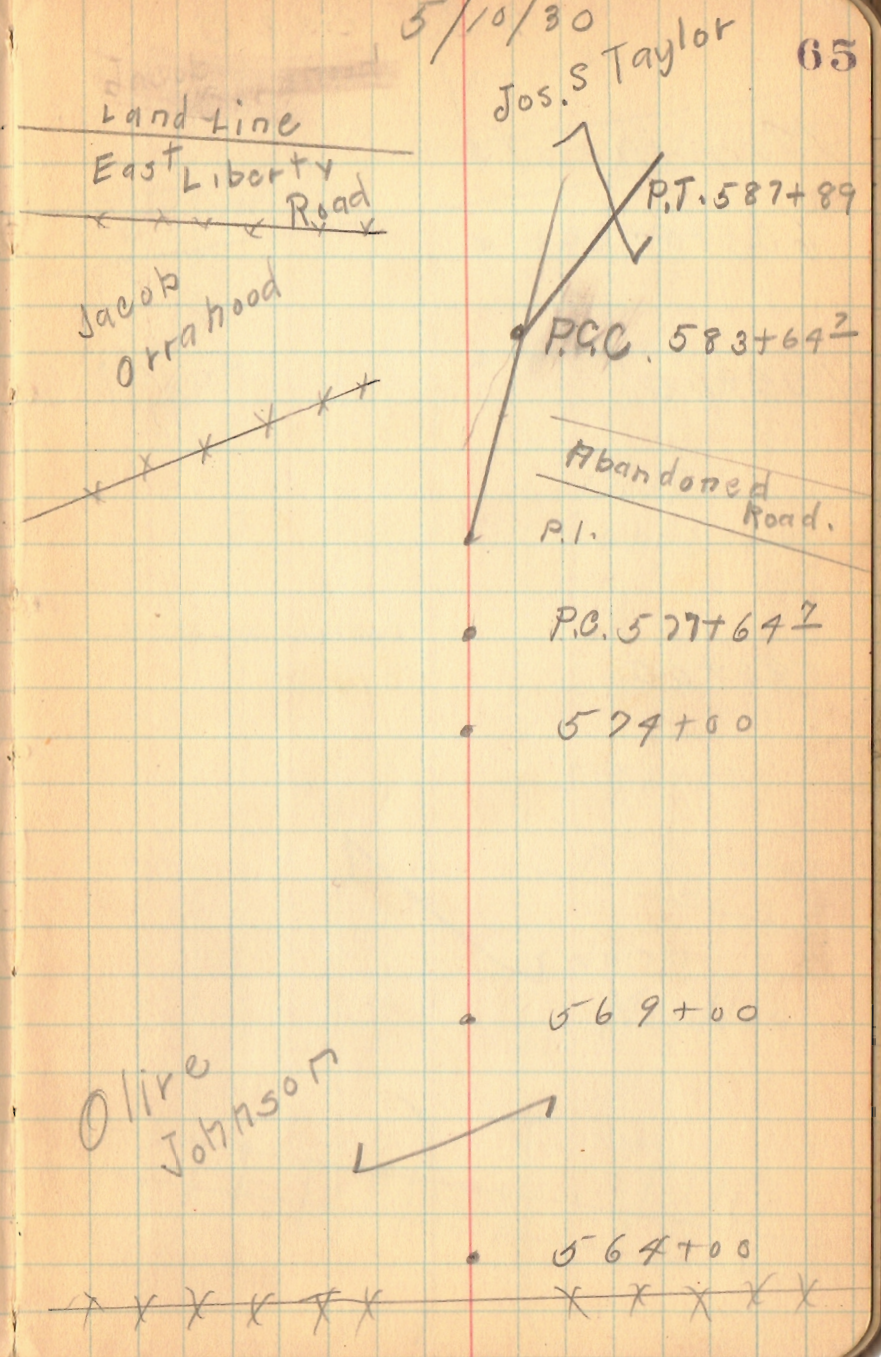

235 Sec B

Monuments

605+00

602+00

596+00
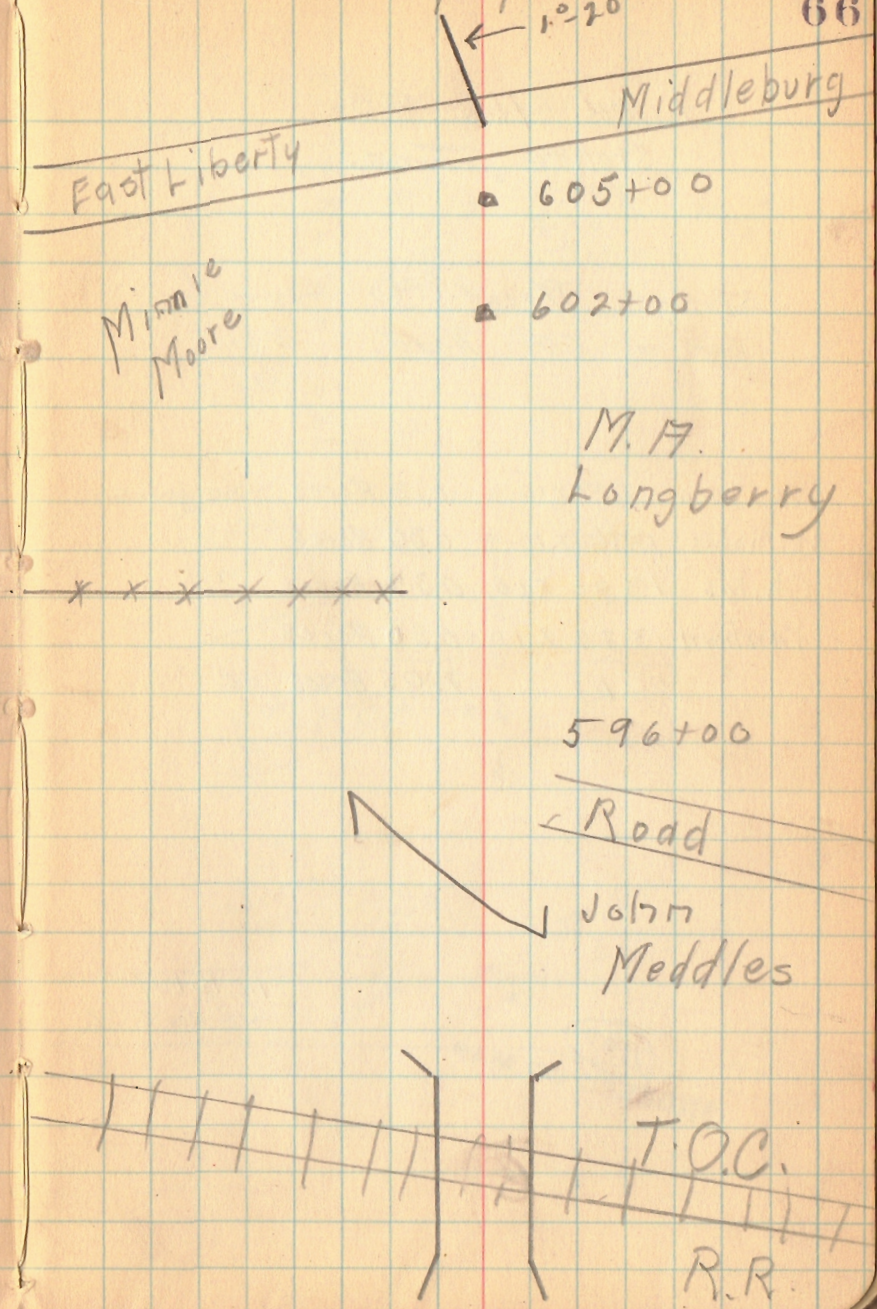
5/10/30