(16+91.5)

Road No. 23
Bloomfield Twp.

40' Sta. 0+00 To 43+48 Road Record
No. 2 Page 25

60' Sta. 43+48 To 96+63
Comm. Journal Vol. 2 Page 139

Stakes 20' from ℄ for 40' Road 0+00
To 96+63

See Book C Page 160

(16+91.5)

(12+00)

(8+00)

(2+86)

(1+00)

Set R/W Posts
Aug. 22-1935
F. Wright
E. Moore
L. Whitlow
Mr. Graham
Mr. Neff

(1663)

INDEXED ON MAP

June-24-1935
Clear
F. Wright
E. Moore
Mr. Graham
Mr. Neff

Sec. 30 T 7 R 8

Sec. 25 T.7 R.7

Sec. 36 T.7 R.7

Sec. 31 T.7 R.8

(16+91.5)

4" Elm
30.2
N 41° W
16.9
Stone
0.3 E
5.4 W
10.2 S
4" Hickory
16+87
Cement Block Post

Sec. 31 T.7 R.8

Found Hub, Set 3/4" Bar
9/23/67
L. Whitlow

Ft. Cole

10+26

Raymond Miller

Cement Block Post

19+11
R+70

Z

Sec. 31 T.7 R.8

91° 30'

Windy Line

Sec. 36 T.7 R.7
Greenville

Sta. 2+91
Book C Page 160

Sec. 21 - T.7 - R.8

2+91

Stone

2+86

G.F. Shaver

Raymond Miller

N 1° 15' E

Cement Block Post

Iron

150.0

Road 59

Boundary Pine

39.0

12" Walnut

Raymond Miller

Rush Strayer

Sec. 27 T.2 - R.8

Road. 23

43 +00

38 +00

33 +00

28 +00

25+00

20+00

1663

INDEXED ON MAP

6-24-35

7

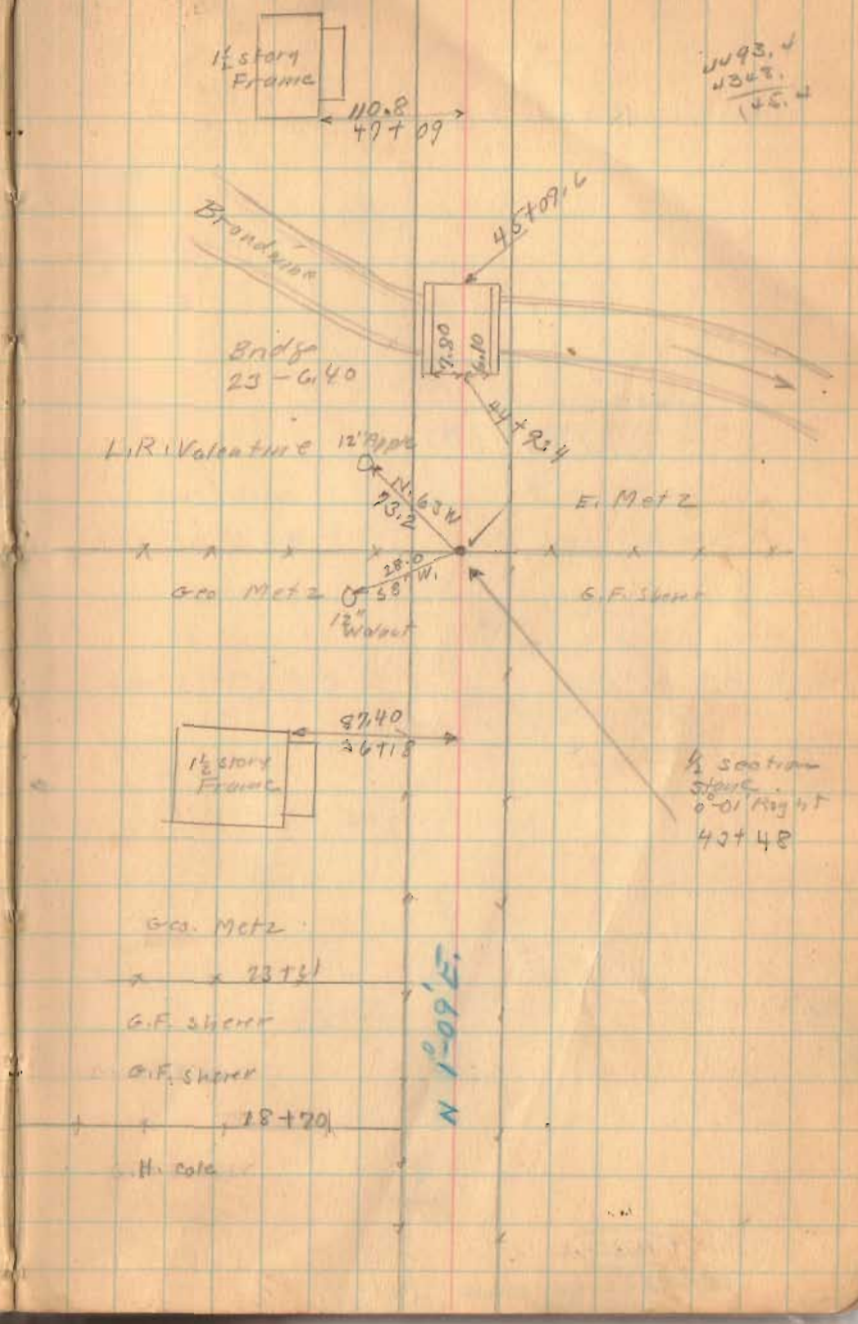

Road 23

(1663)

INDEXED ON MAP

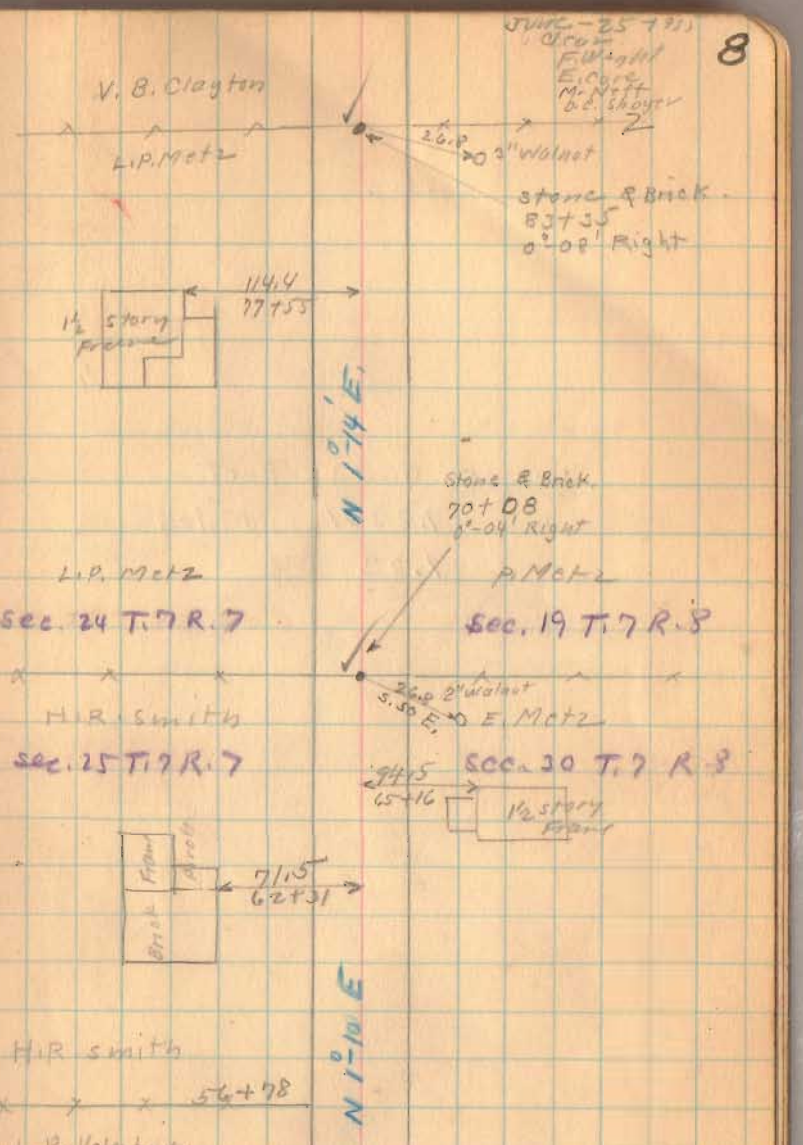

Road. 23

Length. 9663 Feet
" 1.8301 Miles
1.83

(1663)
INDEXED ON MAP

4-26-35

9

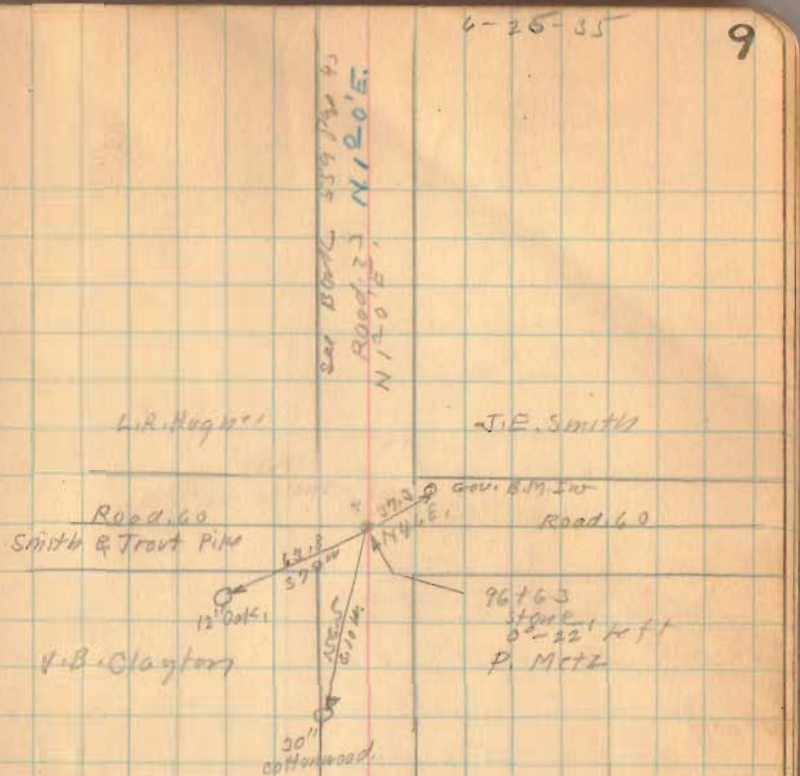

July - 25 - 1935
Clear
F. Wray HT
E. Cole
Mr. Neff
D.C. Shafer

Road No. 34
Bloomfield Twp

Sta. 0+00 To 16+63
No. stakes Placed.

Sta. 16+63 To
Stakes 20' from ℄
for 40' Road.

No. road record found.
old fences would
indicate 33' road.

1664
INDEXED ON MAP

Road No. 27

2+91
3
2+86

Boundry Pike

Iron

180°

Rush Strayer

Cement Block Post

12.5

17.5

Concrete Block post

Greenville Twp Ty Line

5+18

1½ story frame

30.0

4+26

2+53

Shed

Barn

Concrete Block Wall

N & W Head ↑

17.8

1757

Geo. F. Shafer

Sec. 21 T. 7 R. 8

RUM CREEK

Concrete posts

20.05

Iron stake

338.0

Road No. 59

Rush Strayer
Sec. 27 T. 2 R. 8

Rum Creek M.E. Church

Road No. 74

Road No. 34

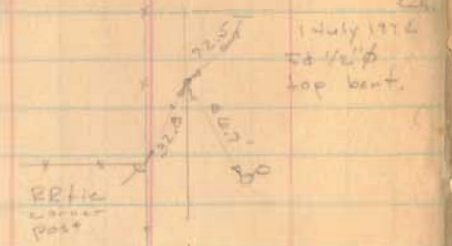

(1664)

INDEXED ON MAP

6-25-35

11

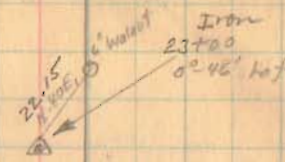

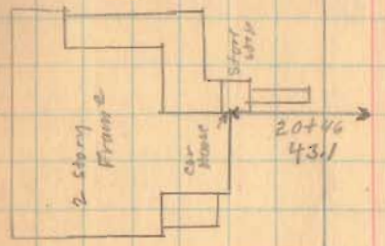

Sec. 30. T. 7 R. 8

Sec 31 T. 7 R 8.

Road No. 34

(1664)
INDEXED ON MAP

6-25-35 12

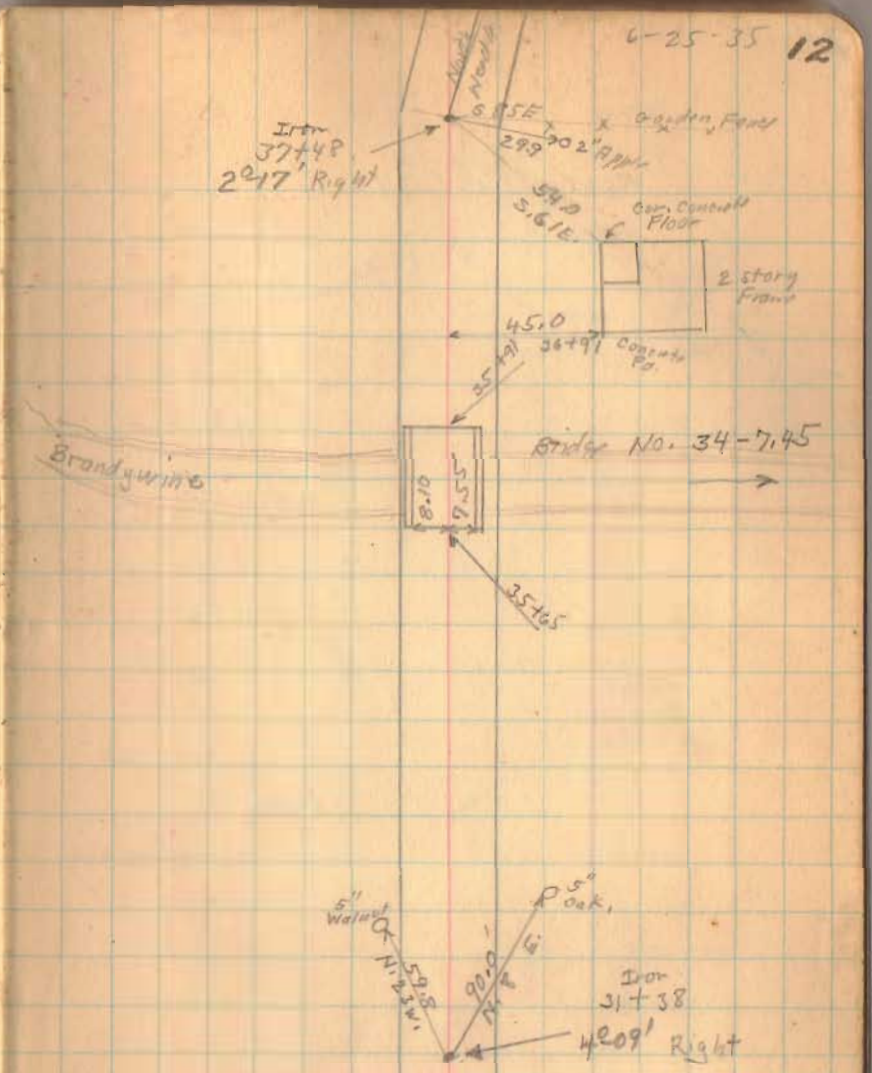

Road. No. 34

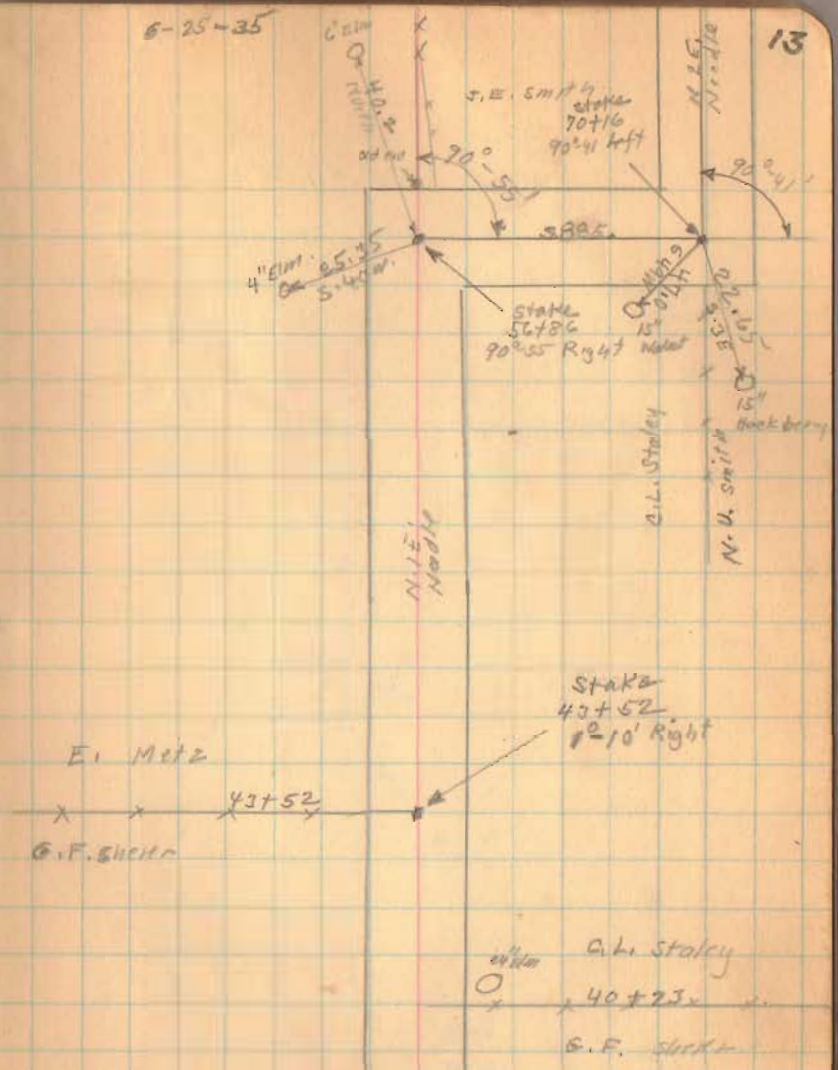

1664
INDEXED ON MAP

Road. No. 34

(1664)
INDEXED ON MAP

June-27-1935
Cloudy
F. Wright.
E. Card

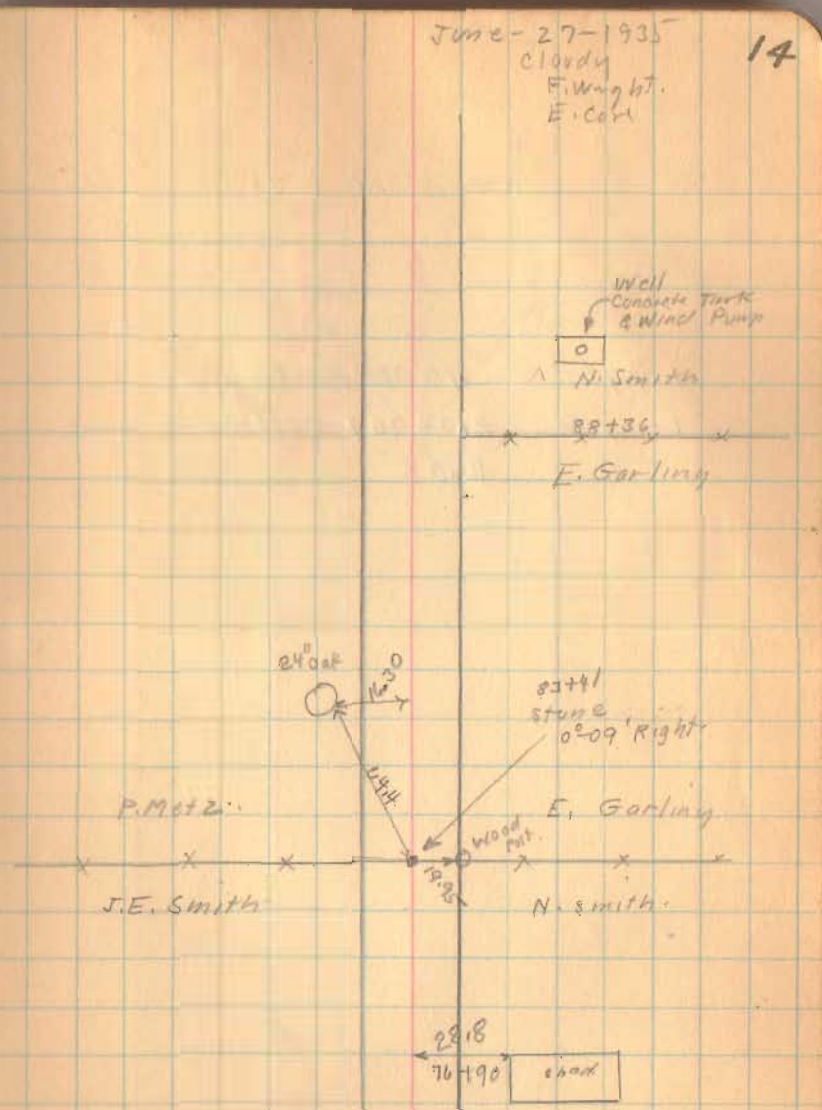

Road No. 34

Length 11002 Feet
Length 2.08367 Miles
2.08

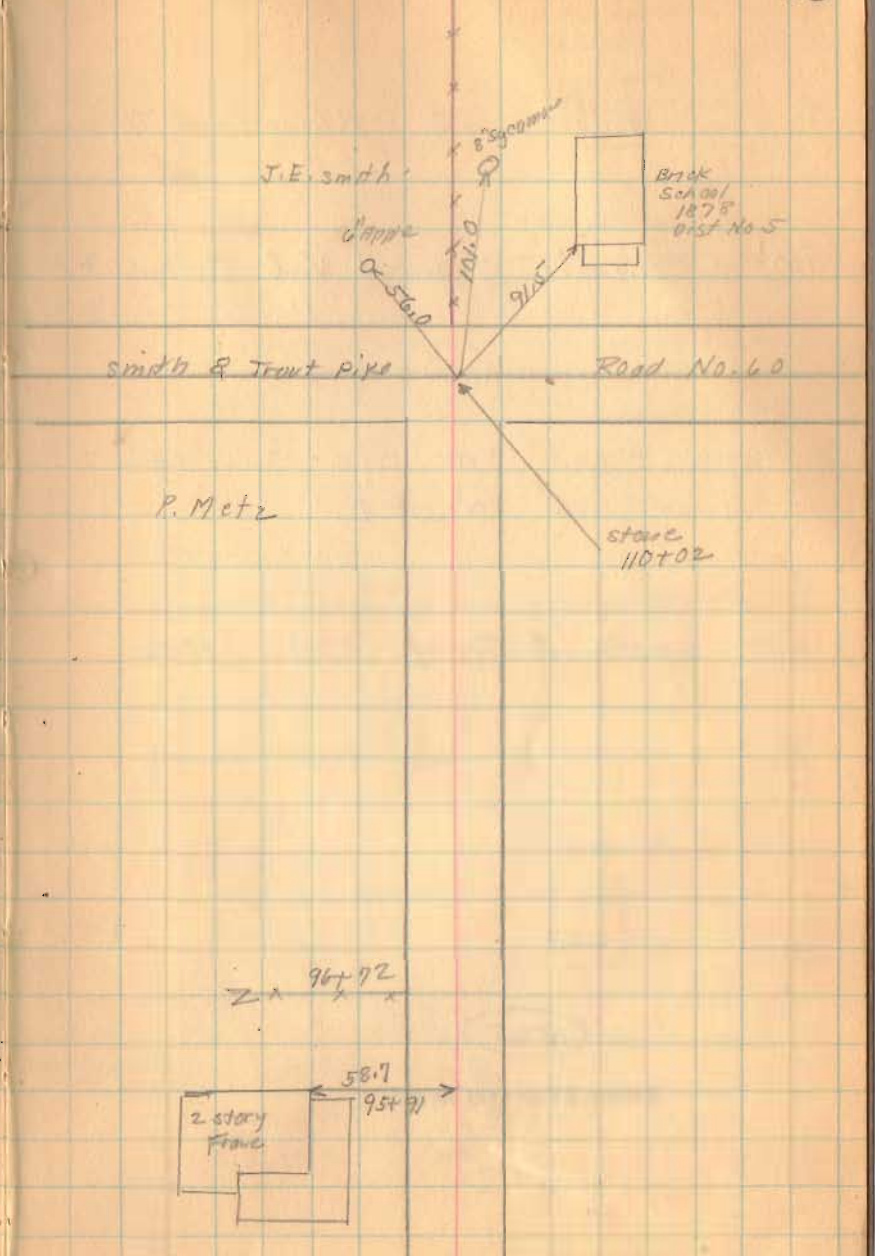

1664
INDEXED ON MAP

Road 60 Bloomfield Twp.

60' - Commis Journal Vol. 5 Page 97
" 5 " 183

Stakes Plavid on Life Ins Co.
Land. 25' N. of ℄.

45' Smith & Trout Pike. 1876

1565

INDEXED ON MAP

July 1-1915
Cloudy
F. Wright
E. Corry.

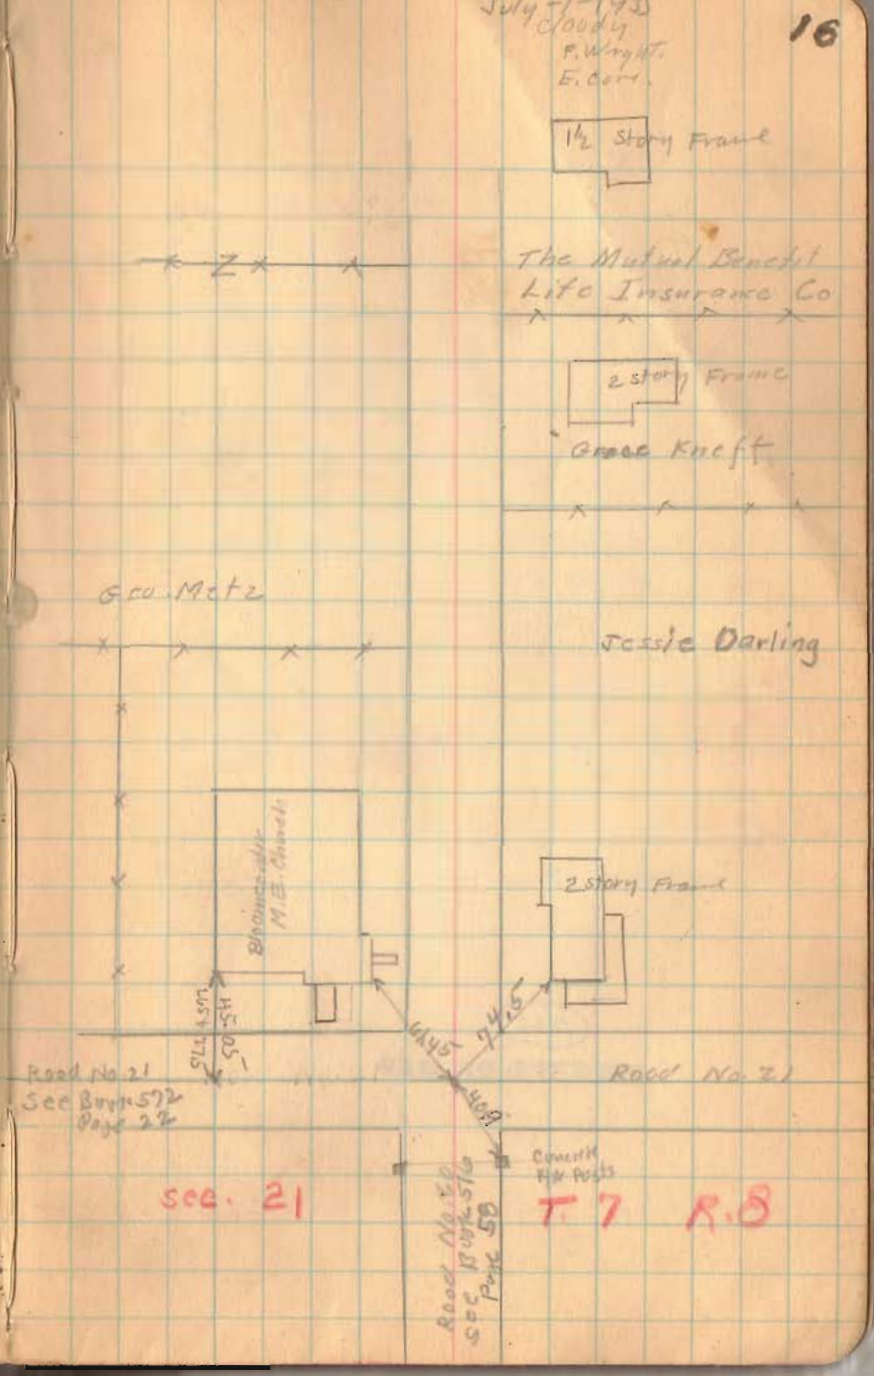

Rood. 60

(1665)

INDEXED ON MAP

The Mutual Benefit
Life Insurance Co.

old church
Lot

M. Wobler

The Mutual Benefit
Life Insurance Co.

Rood. 60

(1665)

INDEXED ON MAP

71-35 18

Sec. 20 T. 7 R. 6

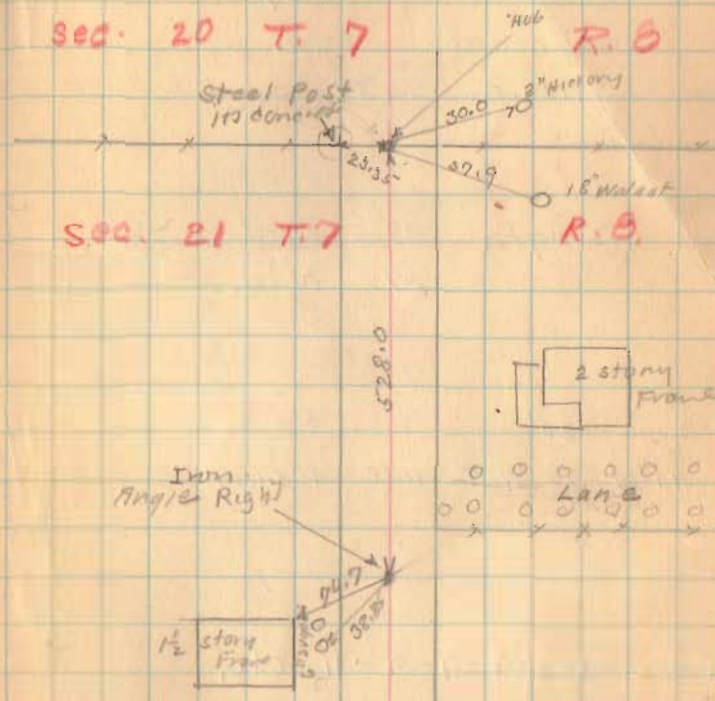

Road No. 267

King Road (No 267)

Bakerscreek Twp.

V.M.S. 9937

Length 3955 Feet

.75 Mile.

Old Lane 20'

10' Added To West side as shown

Stakes 1-3-5-7-9-11 etc.

INDEXED ON MAP

(1671)

Rushcreek Twp.

Bakerscreek Twp.

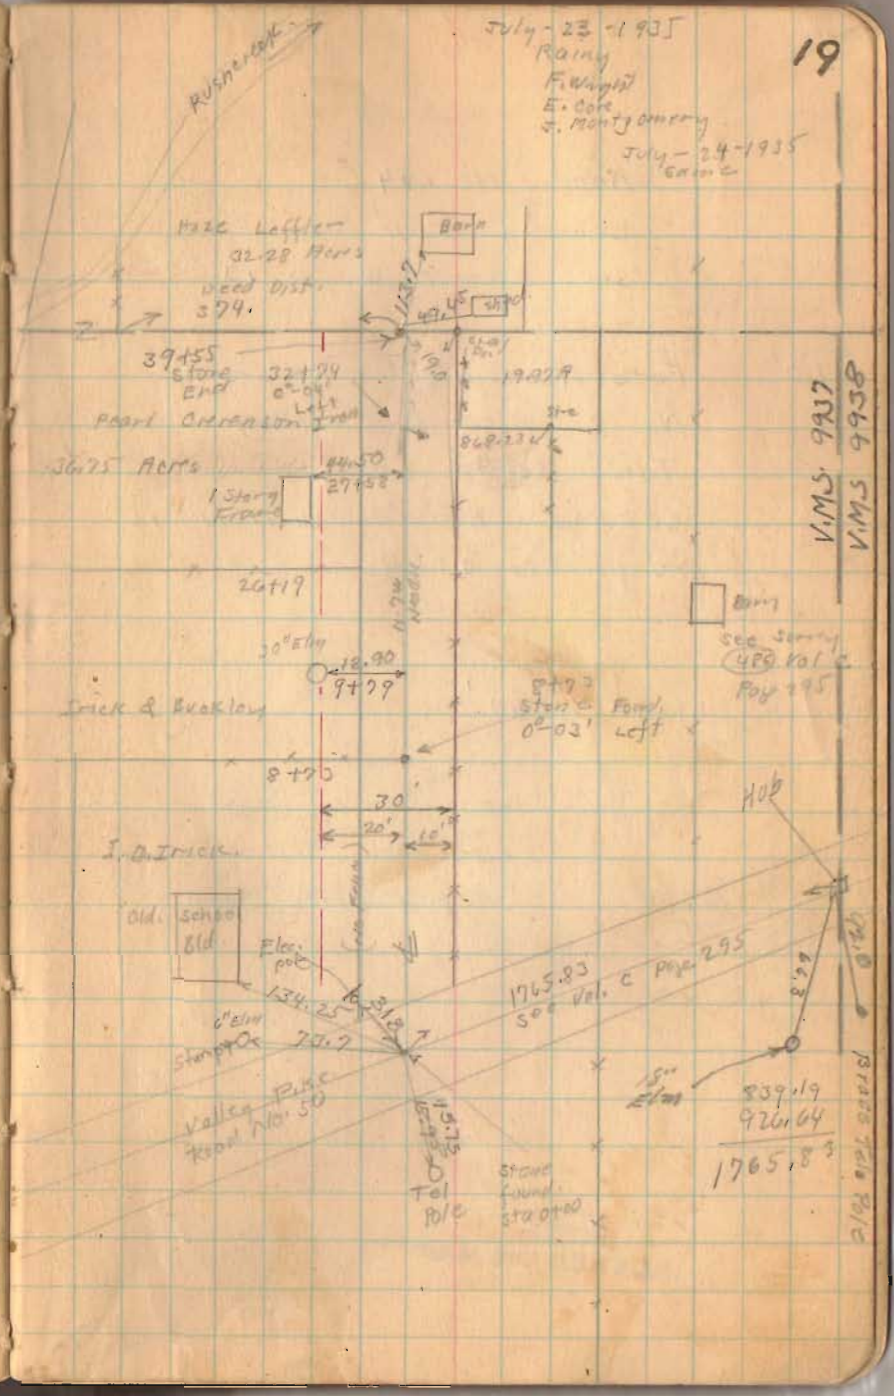

Road No. 184
Liberty Twp
Sec. 33 - T 5 R 13

60' Free Turnpike Record
No. 2 Page 6 - 1869
This Record 60' from
second Bend which is
1774 Sta. 0+00

Staked 60'

Sec Survey (1227)
Liberty Twp.
Big 4 R/W. Map.

5+00

1+00

Longitudinal Sec. Staked by J. Montgomery 1935

See Page 38

(1674)
INDEXED ON MAP

July - 26 - 1935
F. Wright
E. Cole
J. Montgomery
July - 27 - 35 cont'd

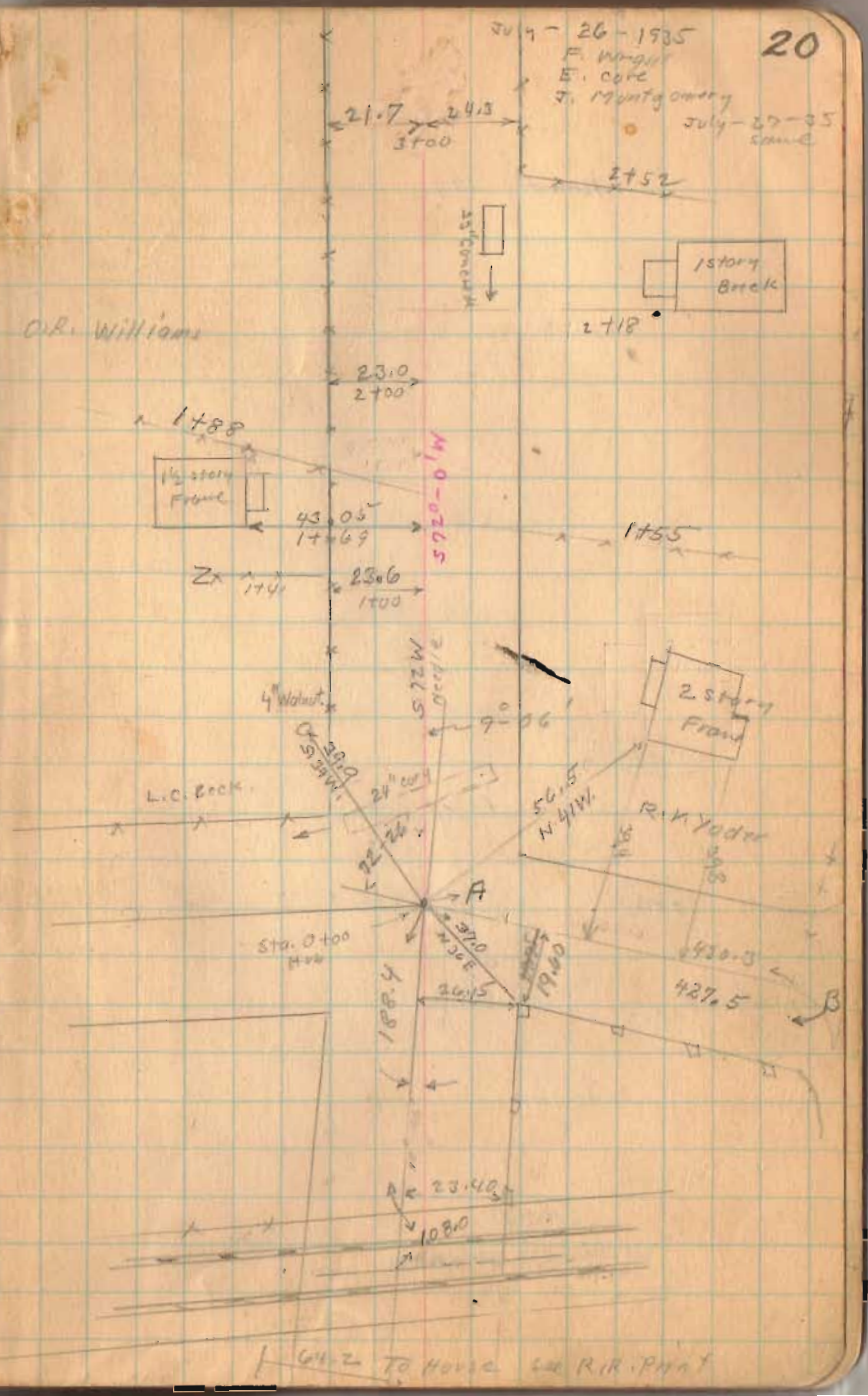

7-26-35
7-27-35

21

Road 194

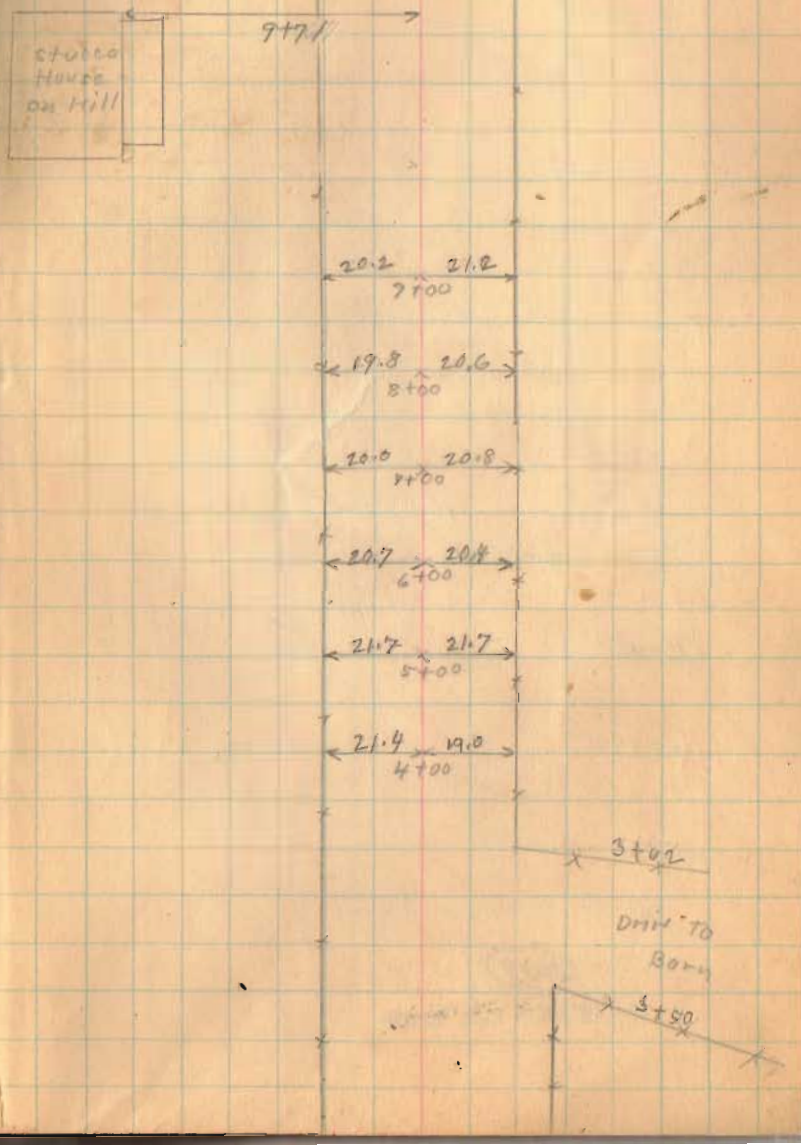

12+00

9+00

1674

INDEXED ON MAP

Road. 194

16+40

15+40 Left only

14+40

13+40

(1674)

INDEXED ON MAP

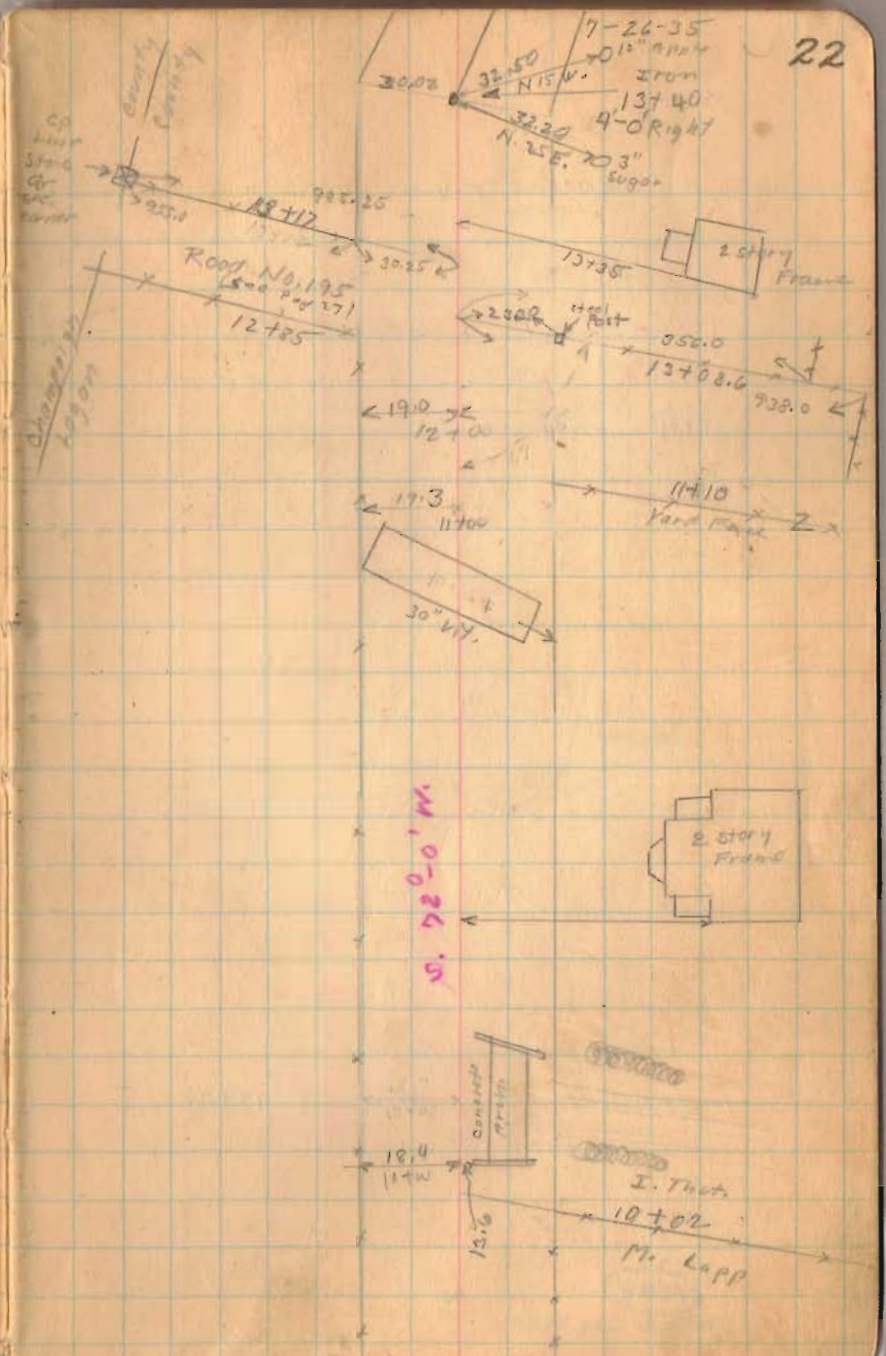

Road. 194

(17+40)

Distances To Fences
not noted West of 13+00

(1674)
INDEXED ON MAP

7-27-35

July-29-1935
F.W. Wright
E. Corr.

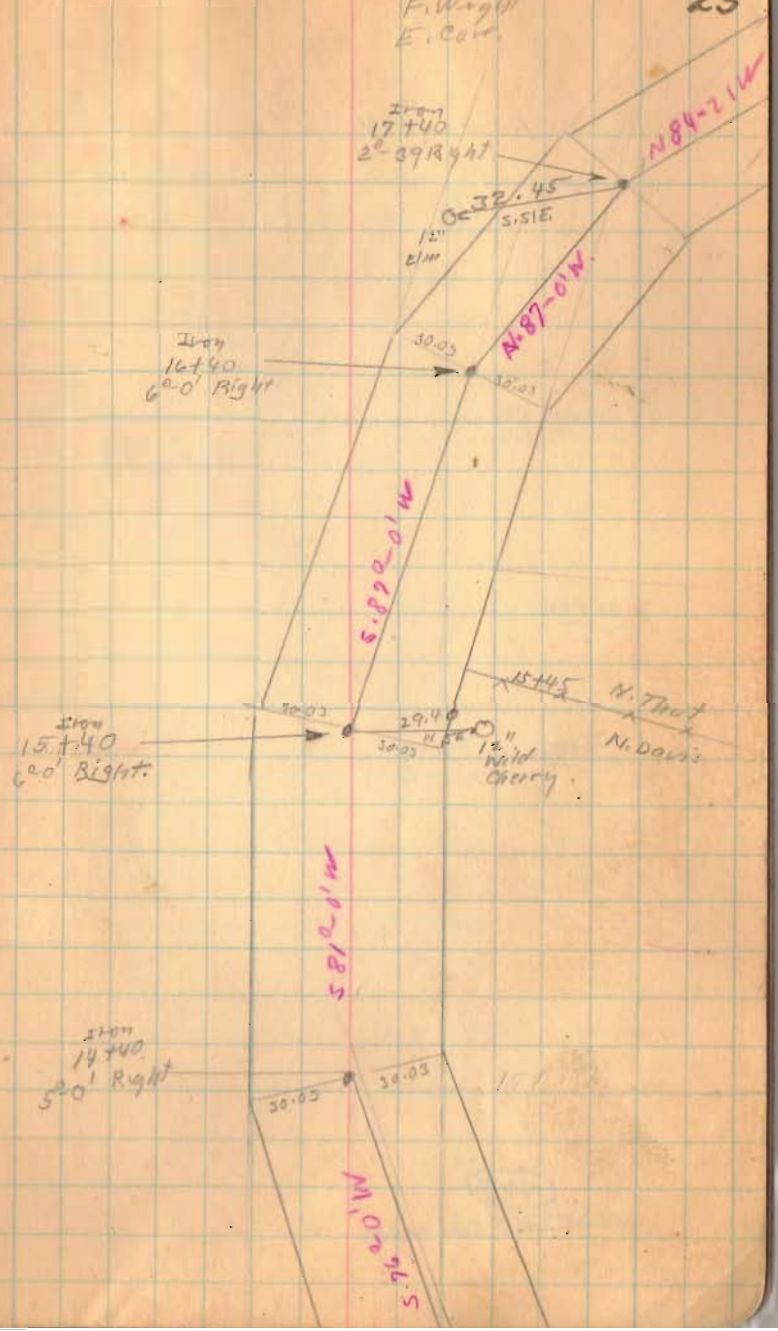

Road. 194

29+00

25+00

20+00

(1674)
INDEXED ON MAP

7-29-35

24

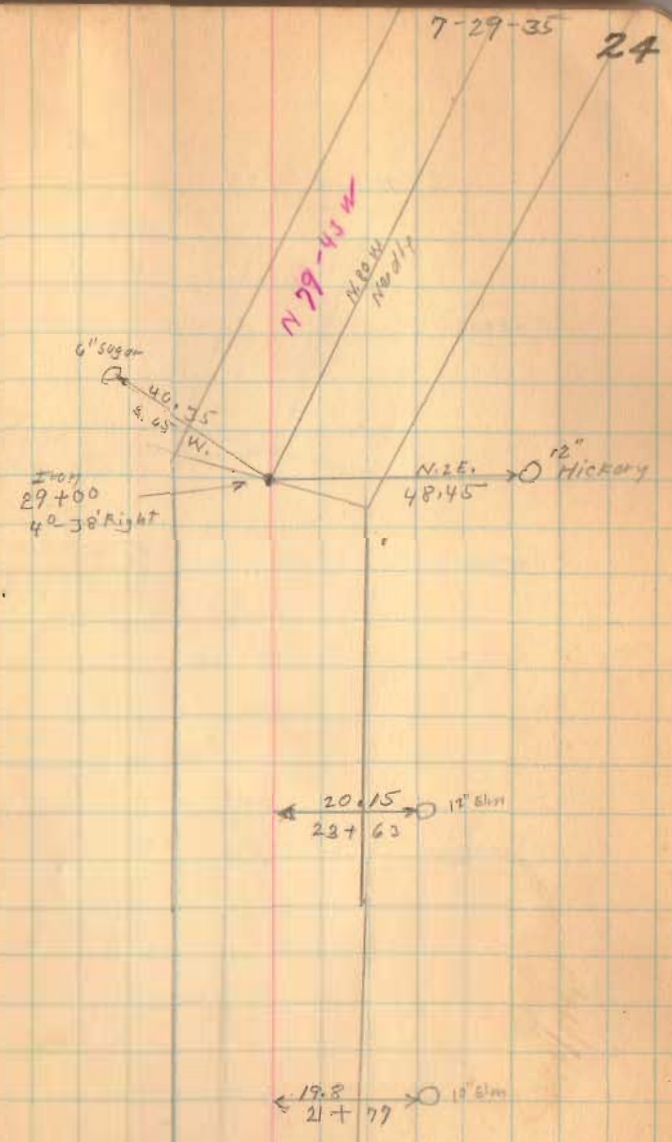

Road. 194

38+00

35+00

31+00

(1678)

INDEXED ON MAP

7-29-35

25

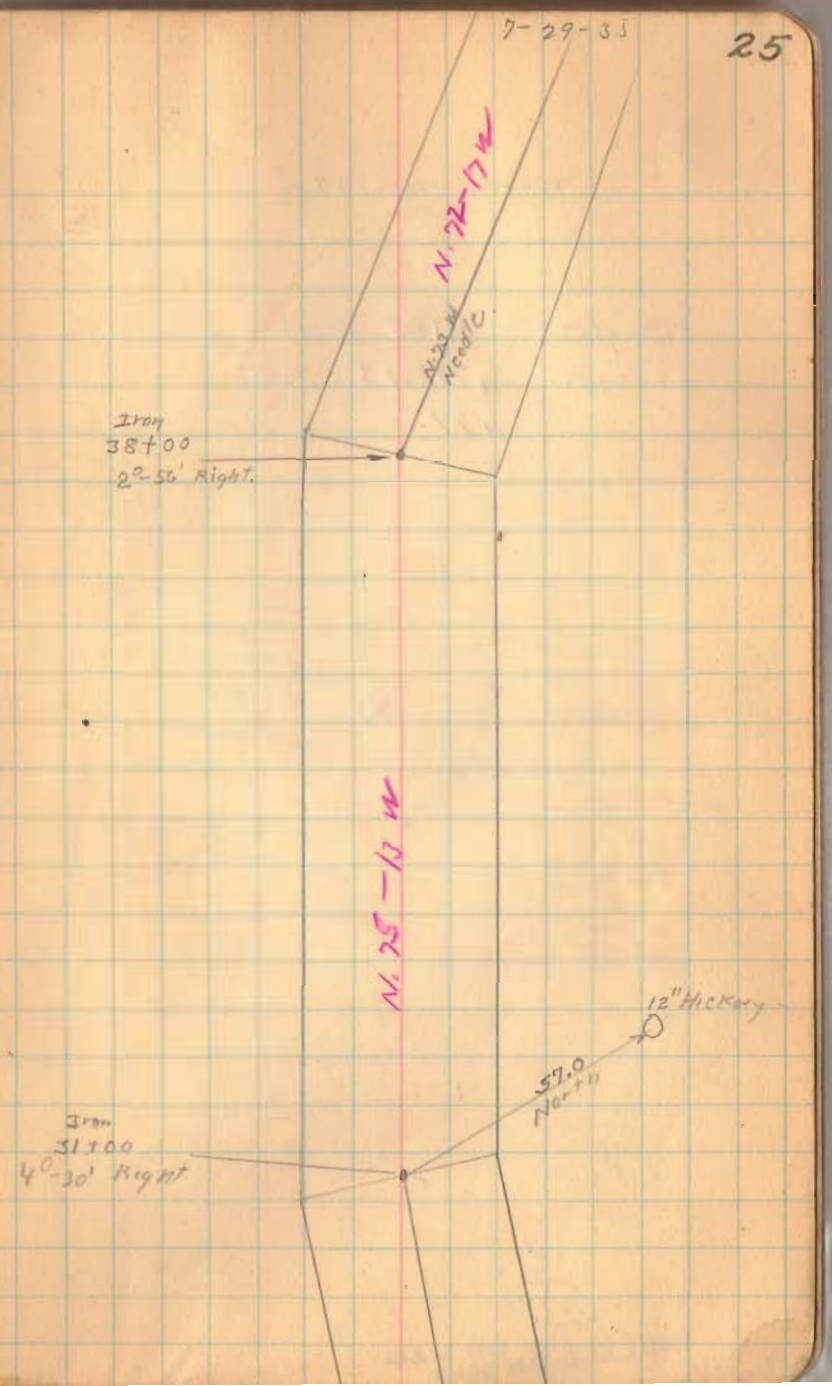

Road. No. 194

Length 4185 Feet
Length .792613 Miles
.79

41+00

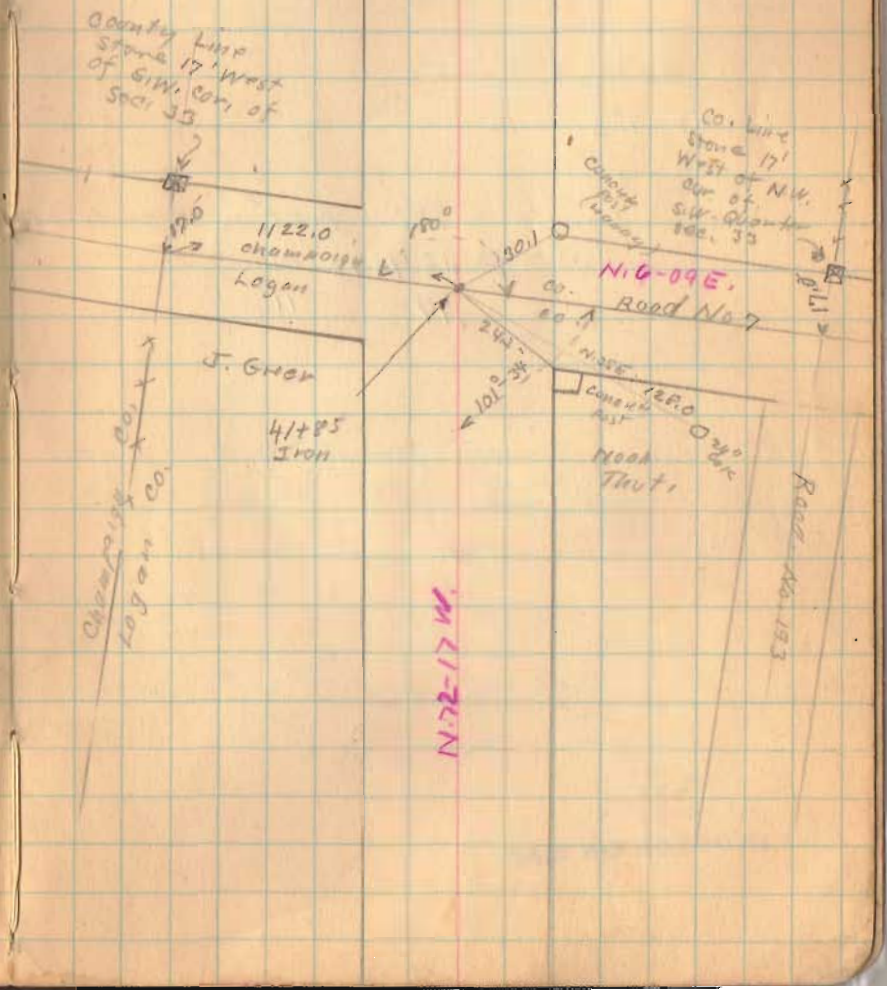

1674

INDEXED ON MAP

Road No. 195

9+00
6+00
1+00

Road 194

Sec. 33 T. 3 R. 13

Sta. 13+40
see Page 22

Length 992 Feet
" .187878 Miles
" .19 "

40' Commissioners Journal No. 9 Pg. 290
" " " 10 " 50

1851.

Logan Co.
Champaign Co.

1675

INDEXED ON MAP

July 30-1913
Clear - Nice day

27

F. W. Wright
E. Cd.

2 Story Frame

32.6

℄ Road Produced

3" Sugar

75'

Sta. 13+92 Road 194
From Sta. 7+92 Road 195

S. 77-0 W.

29.5

39.4

1800

112.54

O. R. Williams

J. Greer

W. E.

West side of road on Quarter Section Line

N 4-54 E.

6+00 R/W Posts

Measured 1157.00
Dead 1122.66
34.34

20' 20'

1157'

Co. Line Stone
S. E. Cor. of
S. W. Quarter

170.5

7.200

10'

Road

Line

O. R. Williams

J. H. Musser

(over)

Road. 195

sec. 33 T.5 R.13

Red. line represents E. line of S.W. Quarter sec. 33 T.5 R.13 Line was ran from Post near road. 193 To Co. Line Store, West side of road 195 is on E. Line of S.W. Quarter

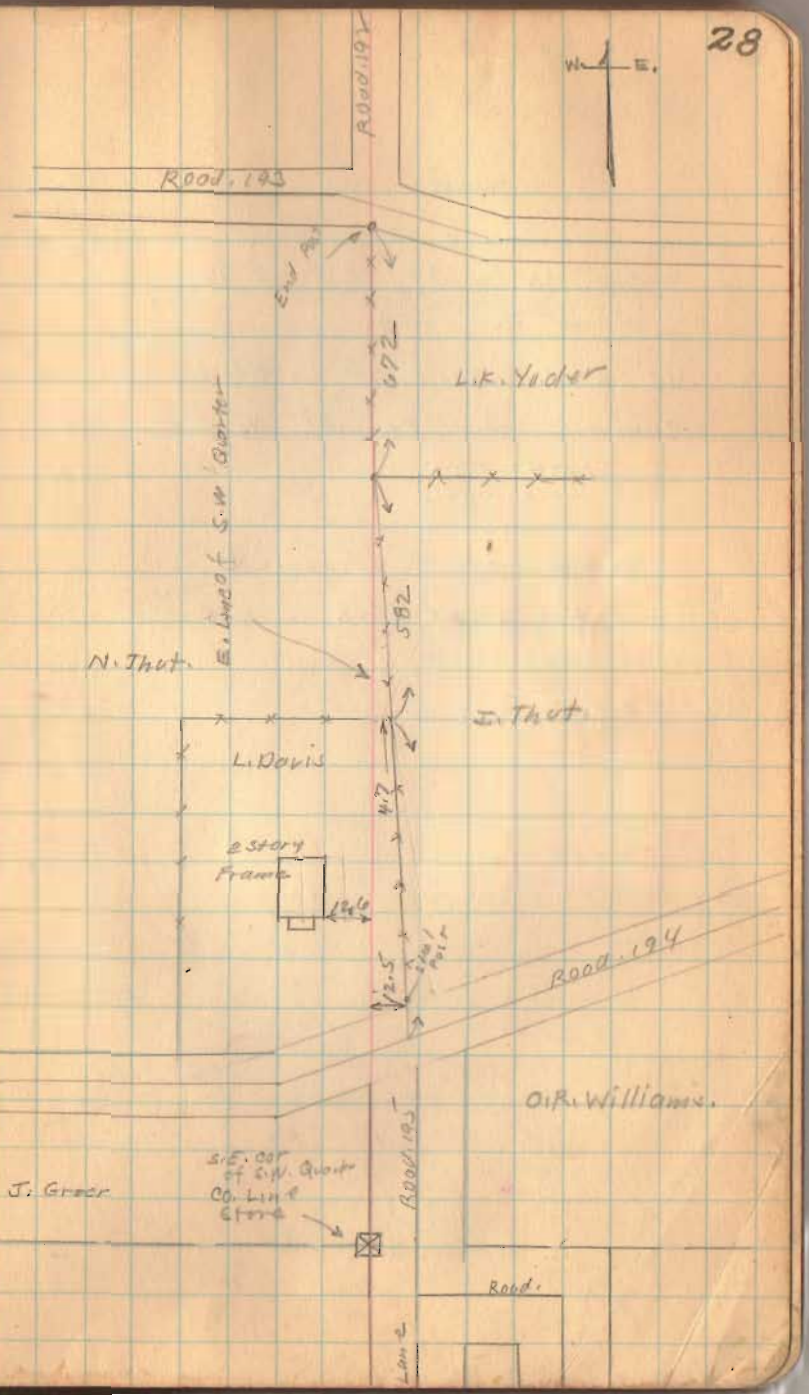

(1675)

INDEXED ON MAP

Road. 192

Liberty Township

sec. 33 and 34 T.5 R.13

40' Road. Sta. 0+30 To 9+74

Commissioners Journal No. 10 Page 185

1854

Stakes placed 20' from ℄

for a 40' Road.

7+00

3+00

1+00

Mon. For Monuments Set Dec. 1935

0+00
Stone found
20 1"ϕ Bar
over Ends

Power Pole

22.7

58.7

24.5

Power Pole

Con Post

1698

INDEXED ON MAP

Dec. 9, 1935
F Wright
E Carter
G. Weiger
not very cold.

29

5472

2 story Frame

26.8

5433

N 4° 51' E

3449
stone found

85.0

1.4

cc cramsor

Catalpa

double catalpa

0+31
Stone found
center of
Sec. 33 T 5 R 13

Road 193

sta 0+00 Begin Mon.

End Post

Road 193

10 pine 10 yard

Mon. Taft

K. Yoder

Road. 192

13+00

12-9-35

30

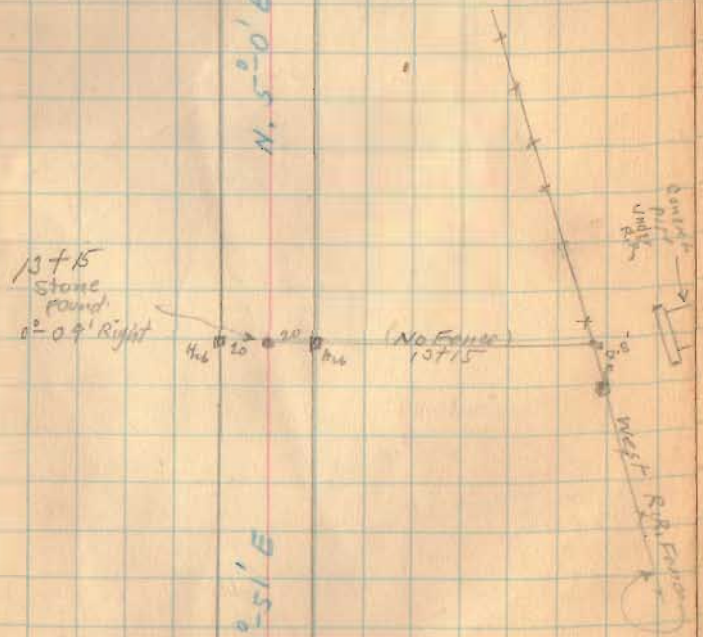

(1698)

INDEXED ON MAP

Road 1.92

21+00 East only

17+00

1698

INDEXED ON MAP

12-9-33

31

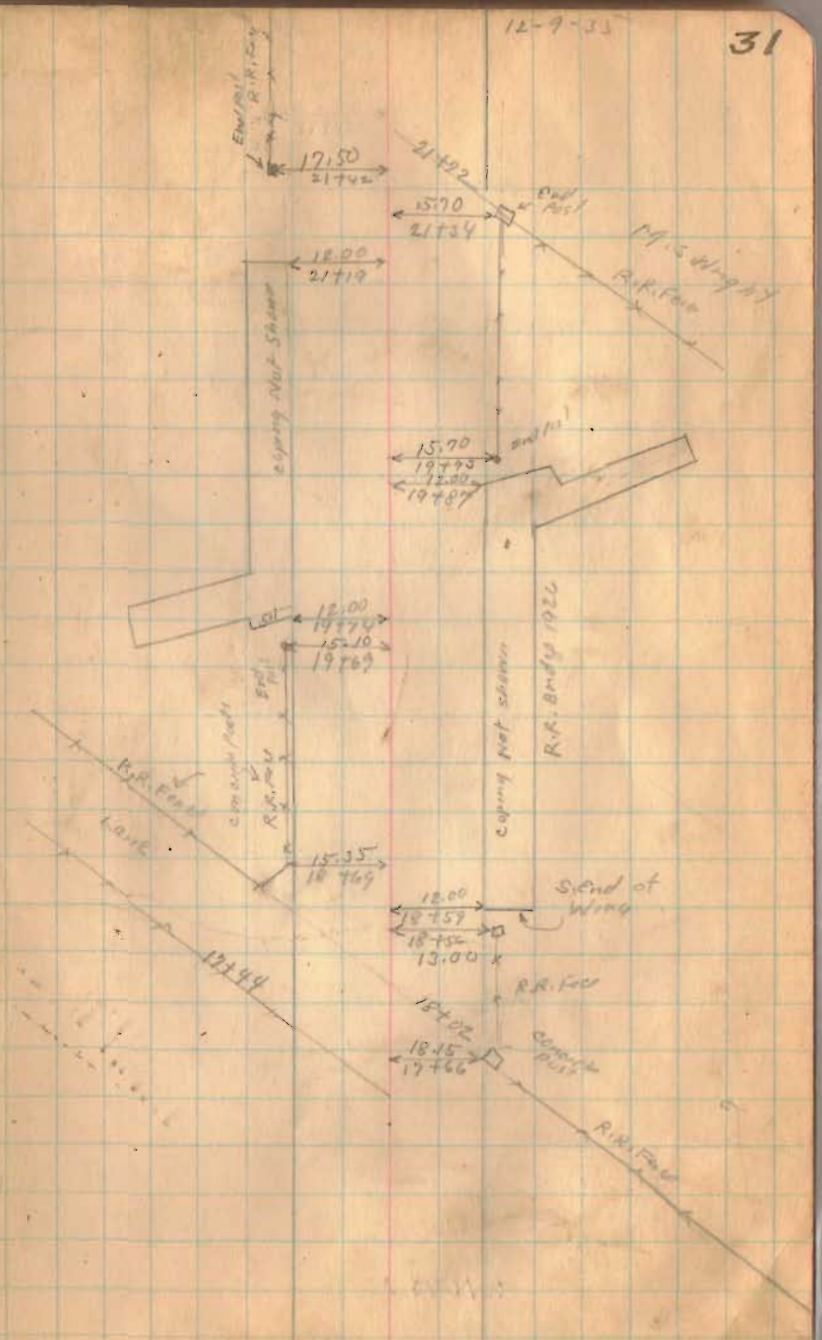

Road 192

27+00

1698

INDEXED ON MAP

12-9-33

32

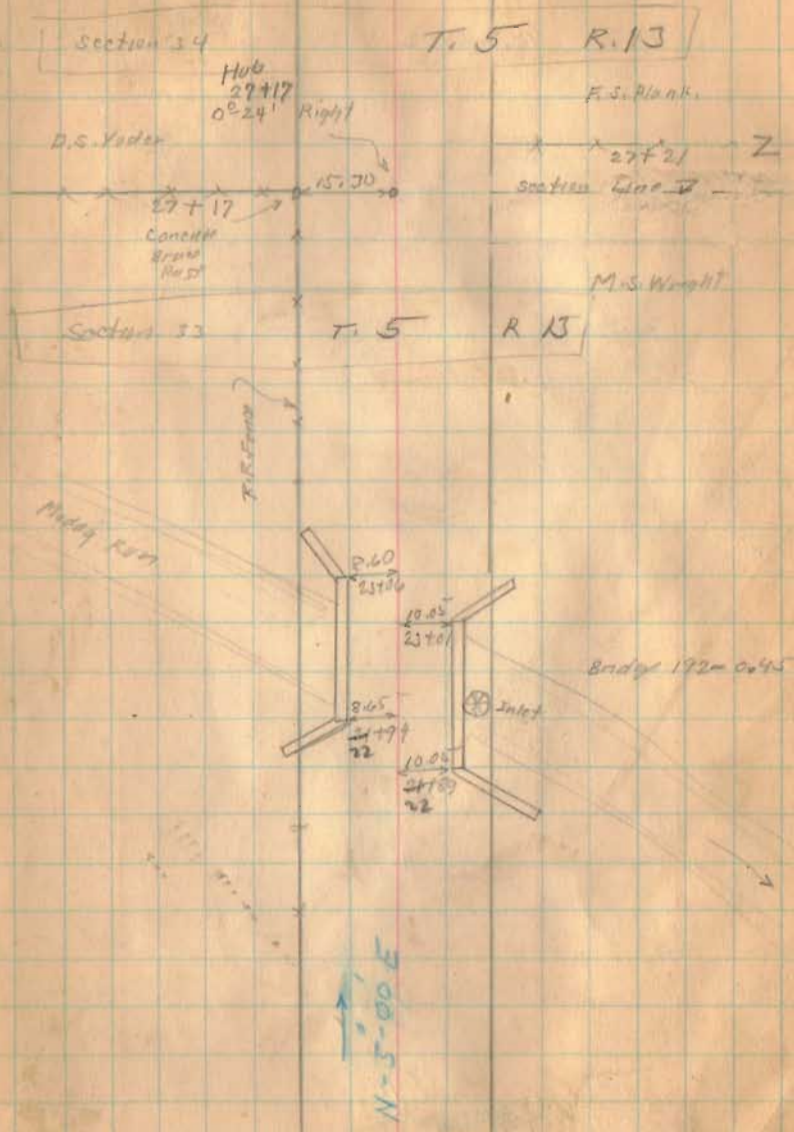

Road 192

35+00

29+00

27+

(1698)
INDEXED ON MAP

Dec. 10, 1933
Rain—Snow
F. Wright
E. Cole
G. Wilgus

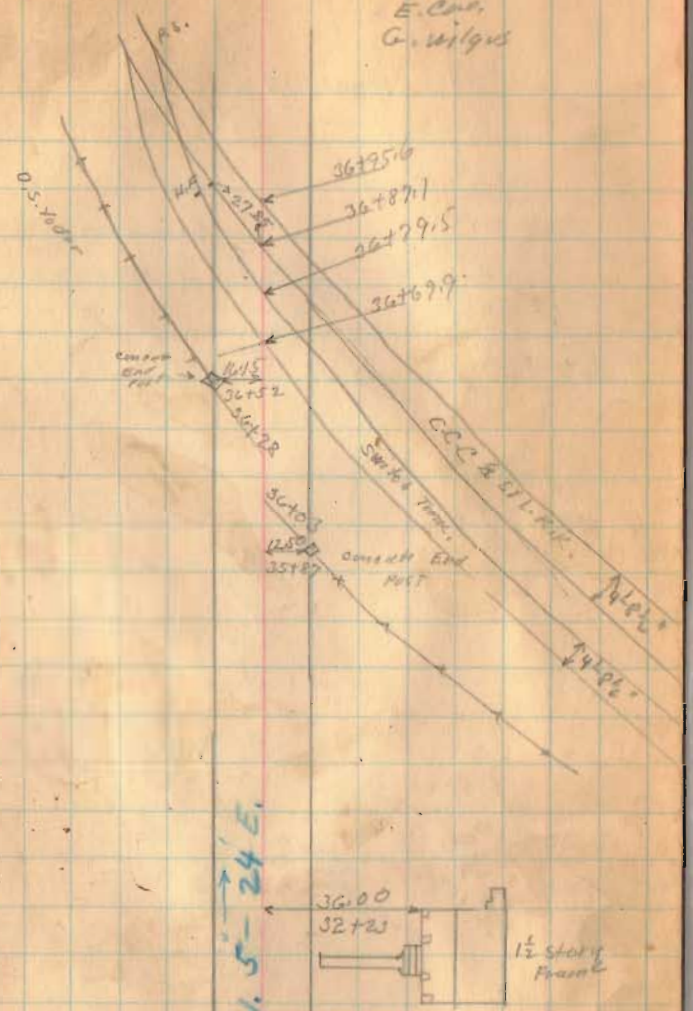

Road 192

53+00

47+00

41+00

1698
INDEXED ON MAP

Dec. 11, 1935
Clear - Cold.
F. W. 907
E. Cort
G. Miles

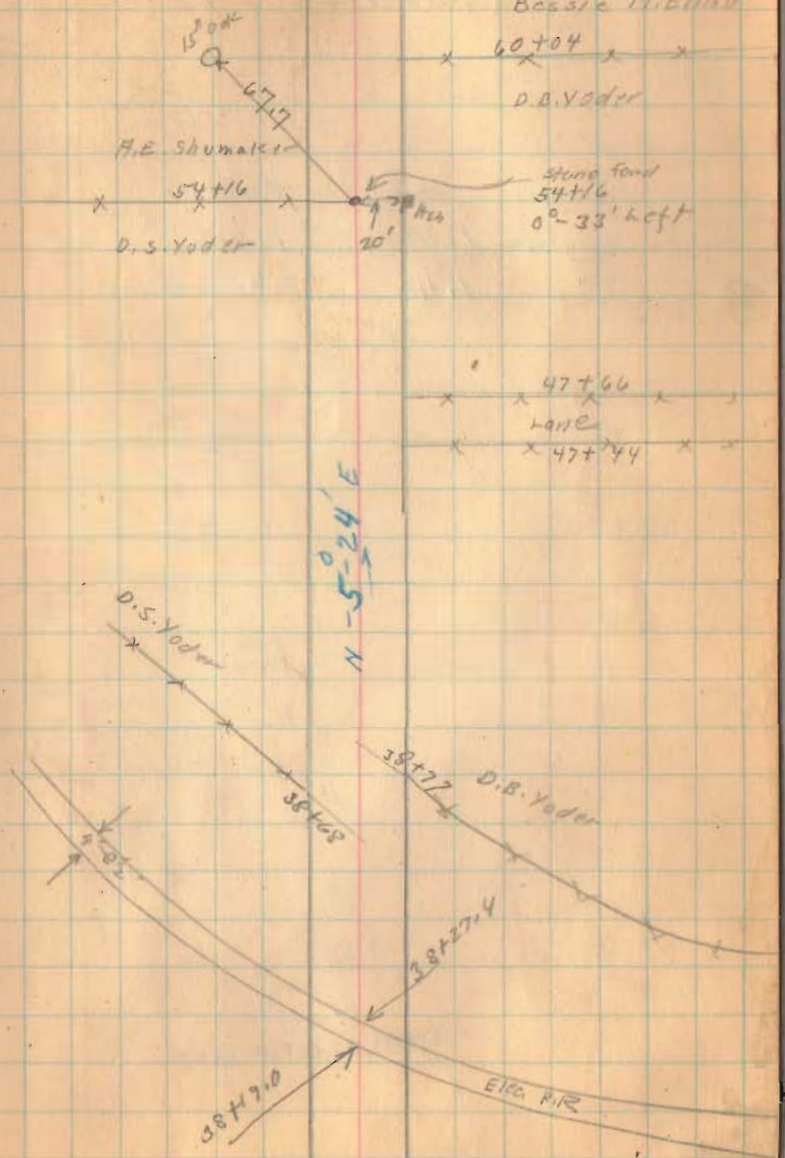

Road. 192

Length	7421	Feet.
Length	1.40549	Miles
"	1.40	"

73+00

69+00

65+00

61+00

55+00

(1698)
INDEXED ON MAP

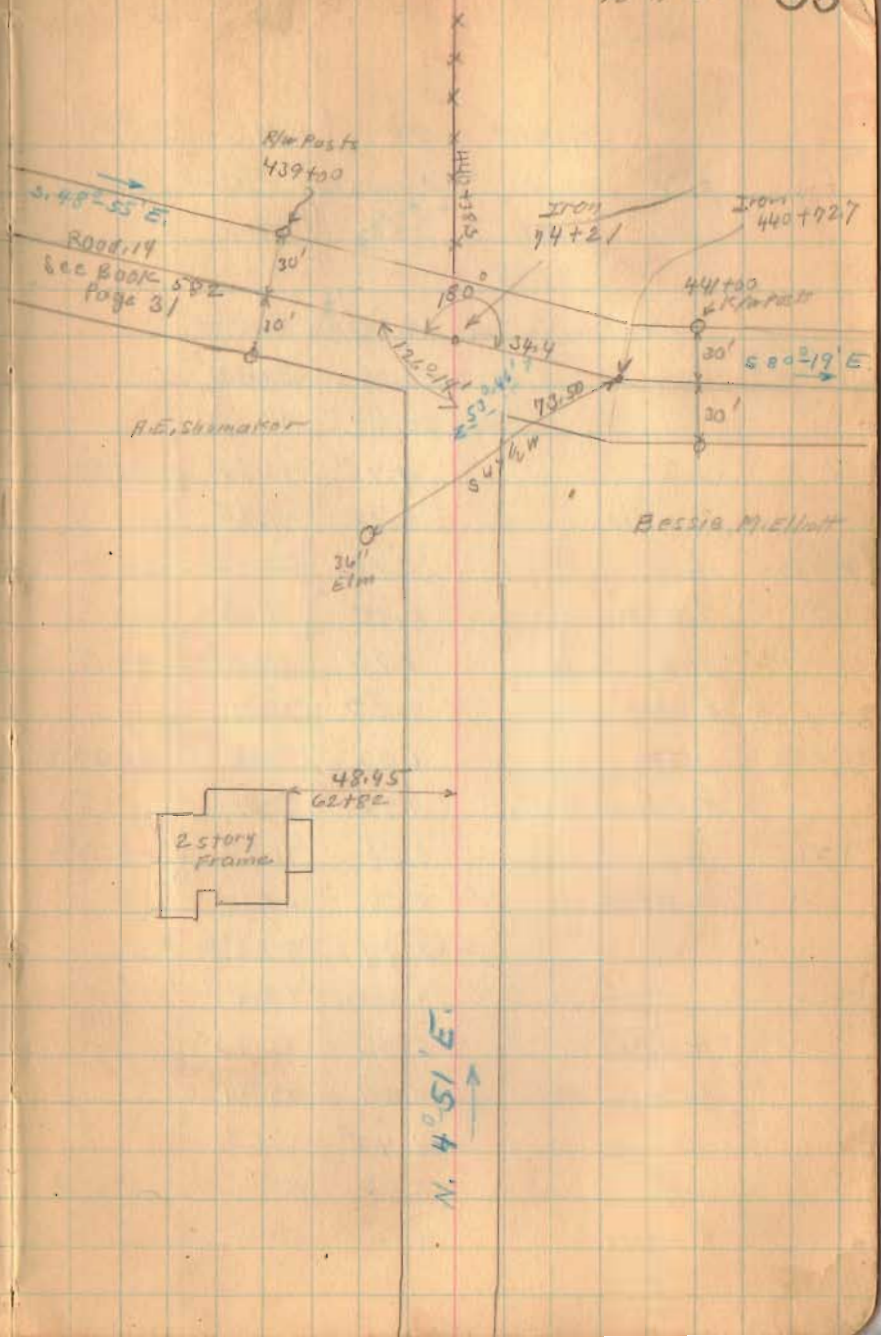

Road. 194

See Page 20

(1674)

INDEXED ON MAP

May-28-1936
Cleared
F. Wright
E. Cole

38

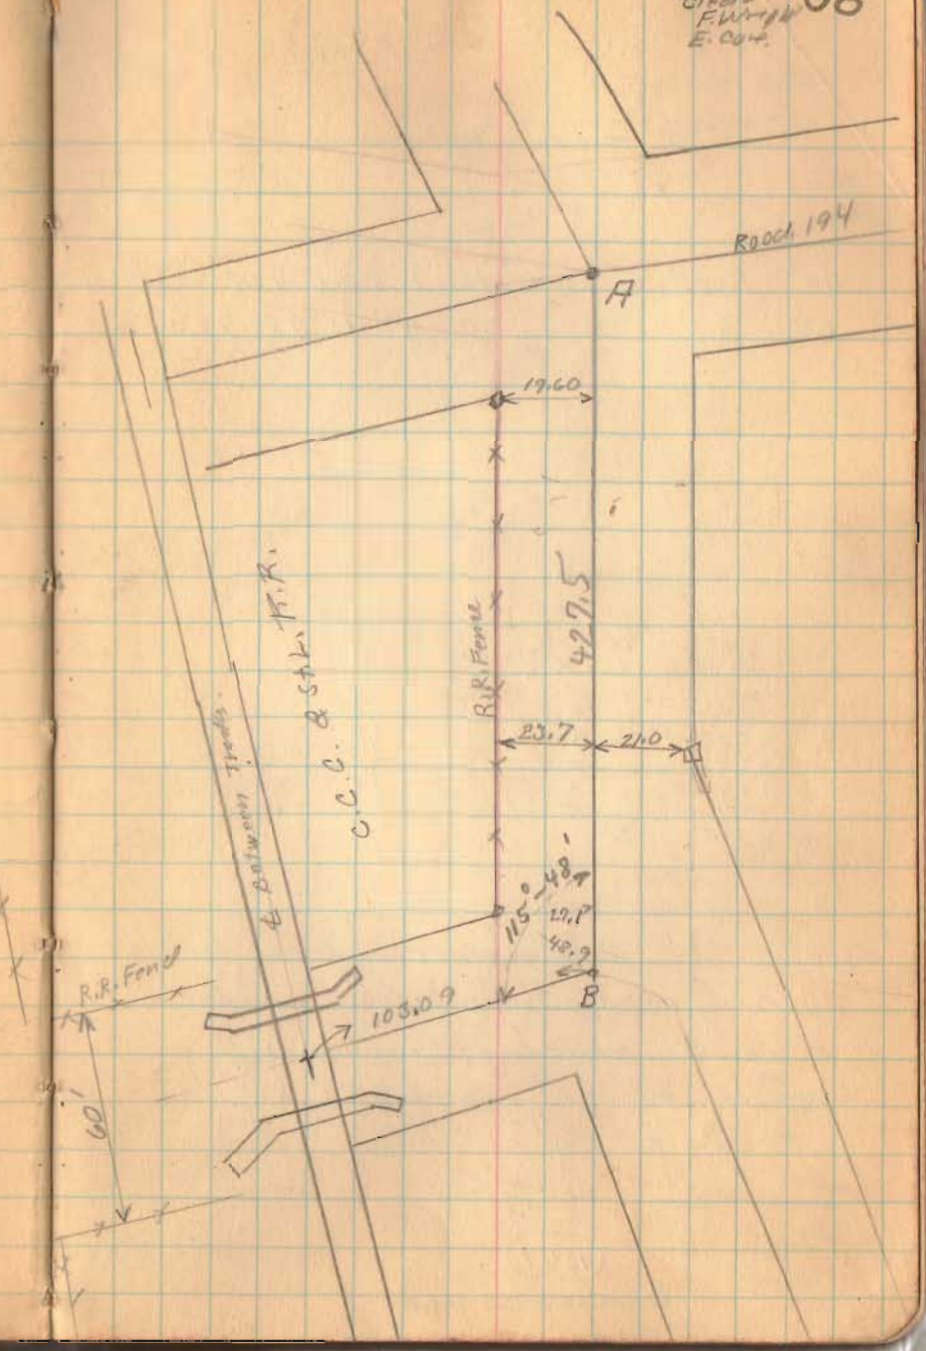

This road is now S.R. 559 E.C.P. 10-7-87

Road 159

Zane Township

40' Road Record No. 1 Page 425-427
40' " " " 3 " 78-79-80

Stakes 30' from ℄

1+00	L-R.
4+00	L-
10+00	L-R.
14+00	L-R.
18+00	L-R.
22+00	L-R.
28+10	L-R.
39+00	L-R.
50+00	L-R
53+00	L-

Staked. 60' - Commissioners to view road June-20-1936 and have a hearing June 27, 1936 in order to get to make width from 40' to 60'

(1347)

INDEXED ON MAP

June 1-1936
Clear-Windy
F. Wright
E. Cox
G. Wilgus

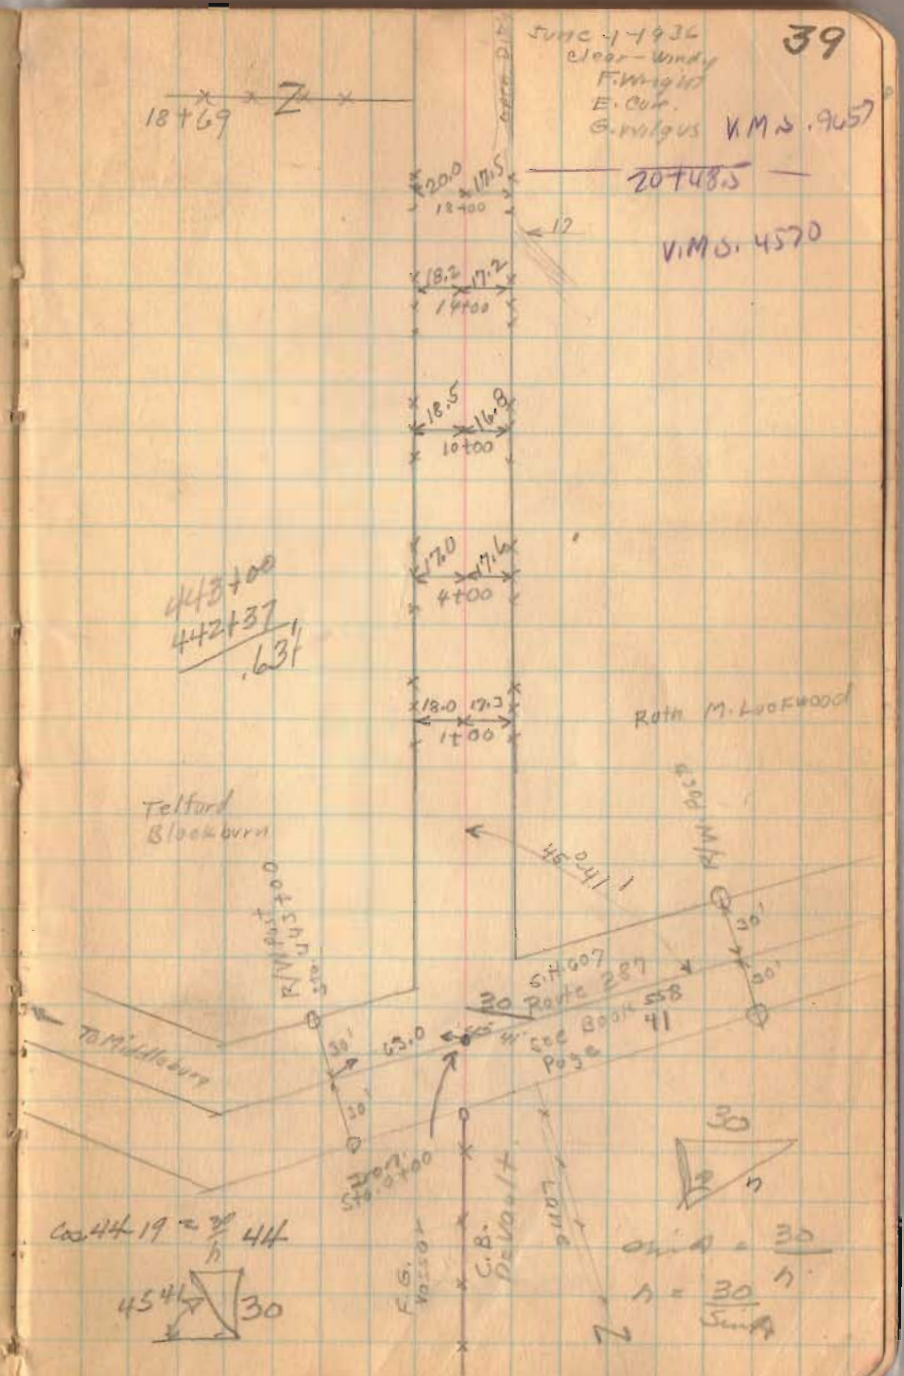

Flood. 159

1347
INDEXED ON MAP

6-1-36

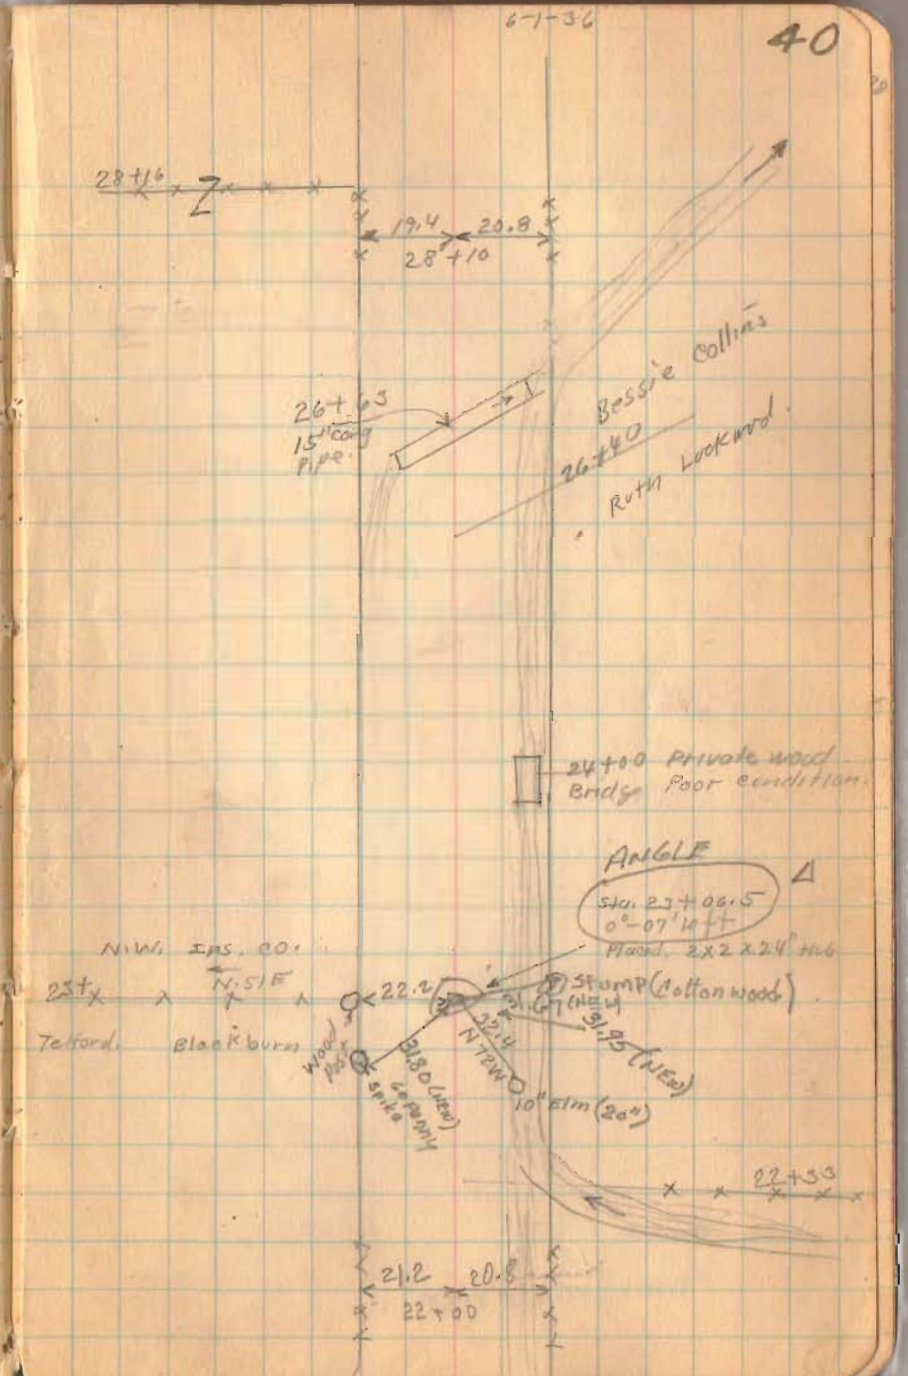

Road. 159

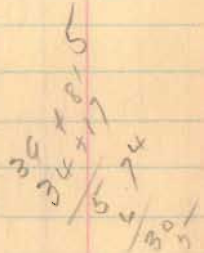

(1347)

INDEXED ON MAP

6-1-36

41

O.H. Rousbe

46+98

Bessie Collins

Sta. 46+98
Placed 2x2x24" Hub
No. Angle

10' Road

18.1

Ella Davm

46+65

Bessie Collins

Bessie Collins

39+81

N.W. Life Ins Co.

V.M.S. 4953

18.5 22.0

39+00

35+50

20" Metal

V.M.S. 7117

Concrete Slab
Bridge No.
159-3.40

34+93

16.1

34+88

34+17

Lane

V.M.S. 7117

29+87

V.M.S 9657

Road. 159

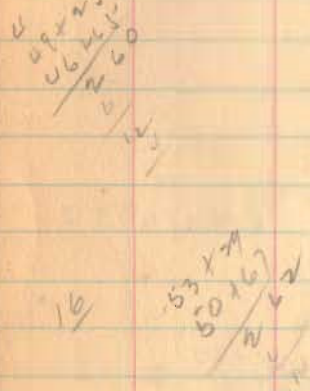

(1347)

INDEXED ON MAP

6-1-36

42

8" sugar 17.7 51+07

8" cattlp 18.8 50+83

6" Locus 19.5 50+67

PHHe

15" cattlp 28.4 50+38

8" Cattlp 50+49 20.1

10" Cedar 20.9 50+40

1 Story Frame

48.6 50+20

10" cedar 20.75 50+16

8" Sugar 18.3 49+96

49+77

6" cattlp 18.7 49+70

6" cattlp 19.1 49+55

End of Road 18.0 49+25

8" Appl 24.0 48+91

8" Appl 23.35 48+85

6" Pear 22.18 48+62

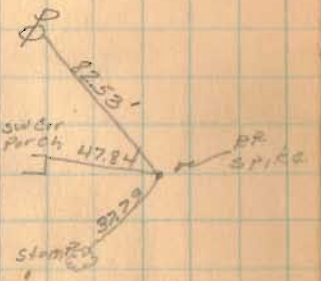

Pat

Road. 159

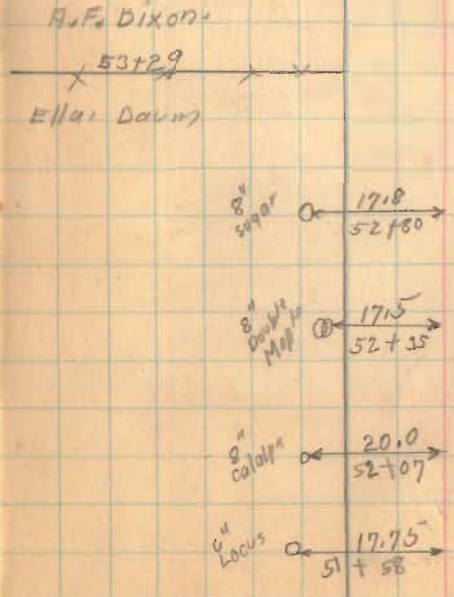

(1347)
INDEXED ON MAP

Road. 159

Length 6491 Feet
Length 1.22993559 Miles.
Length 1.23 Miles

(1347)
UNDRAW ON MAP

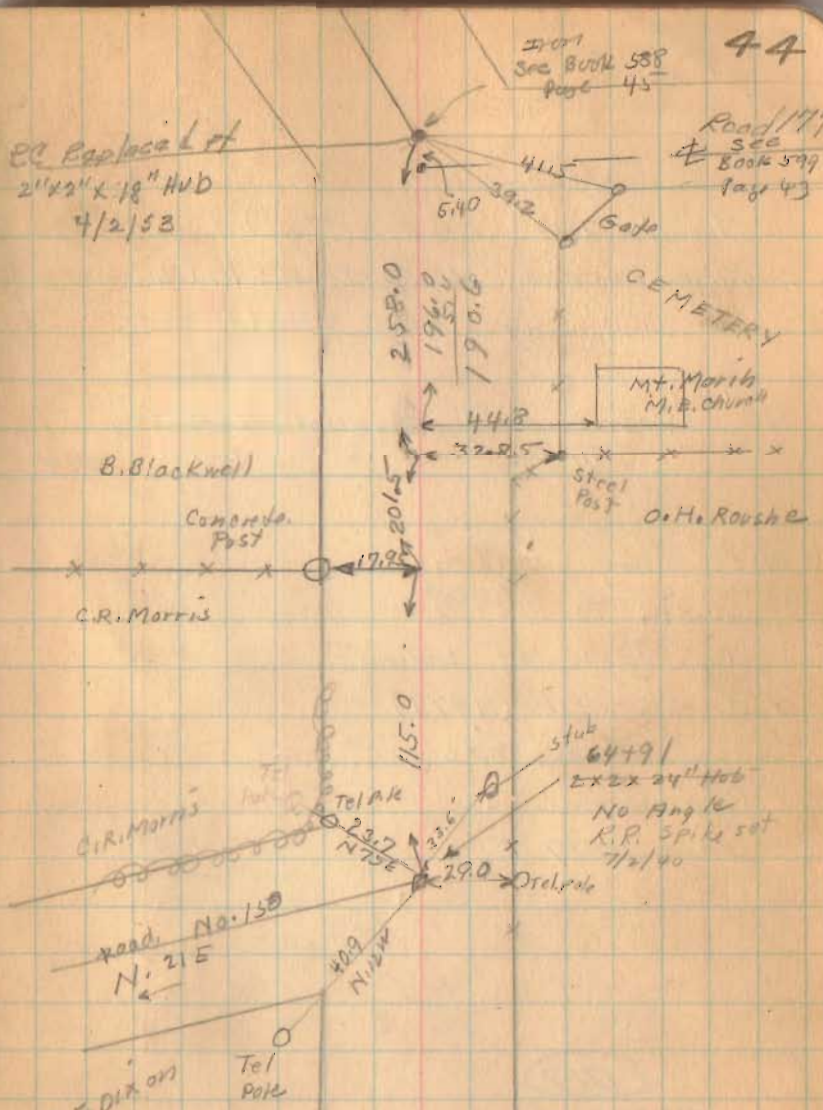

June - 2 - 1934
Clear - Windy
F. Wright
E. Lord
G. Wright
C. Richardson
Earl Coomer

Road. 67

Miami Twp. Pike (1866)

Pike Record No. 3 Page 51. (No Pike width)

40' Comissioners Journal No. 9 Pag 151
" " " " 274

Note my station
60+32 To 68+33
is Part of Indian
Creek Pike (1874)
and is 50' mds
Pike Record. 3
Page 507

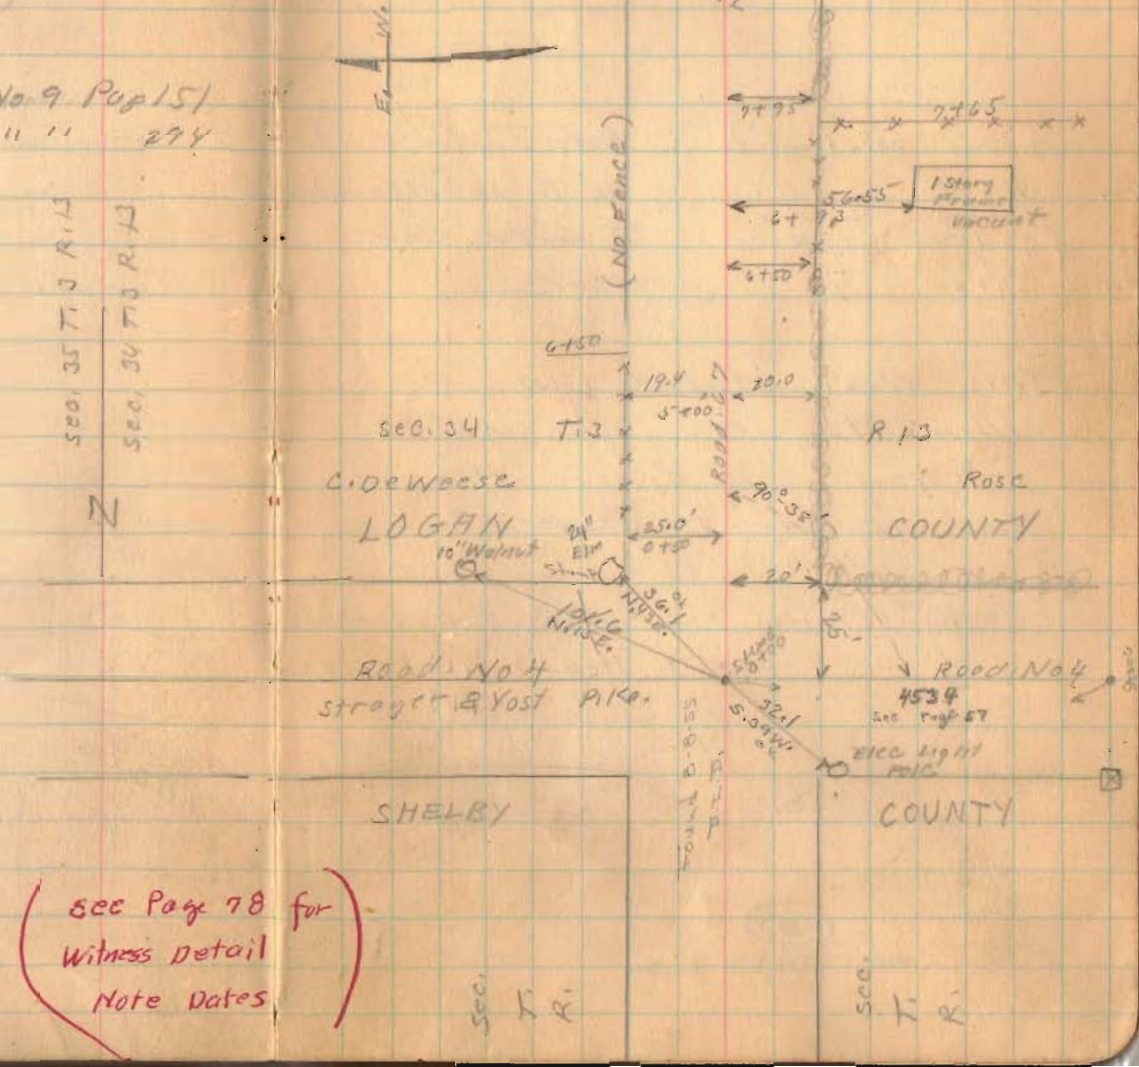

1217

INDEXED ON MAP

Note. Section corners in Shelby Co. at every sta. 0+00

(See Page 78 for Witness Detail Note Dates)

Road. 67

Stakes 30' from ℄ — Proposed Width of 60' To be obtained To make state Road.

2+00	L.-R.
21+00	L.-R.
38+50	L.-R.
48+00	L.-
69+00	L.-

This was staked in order to get 60' right of way in order to turn it over to state

Commissioners to View June 22-1936
" Hear " 27-1936

(1267)
INDEXED ON MAP

6-2-36
6-3-36

June-3-1936
Cool-Cloudy
F. Wright
E. Cook
Geo Wilgus
C. Richardson
Bert Coomer

Bridge Concrete Slab.

17.25
22+79.5
16.5
22+53.5

22+01 Z
Drive

2 Story Frame (Natural)

57.5
21+35

Z 20+76

John H. Offenbecker

17+82

℄ Lane 17+75
C. DeWeese

John H. Offenbecker

17+75

Rose

20.7
12+00

Road. 67

(1717)

INDEXED ON MAP

6-2-36
6-3-36

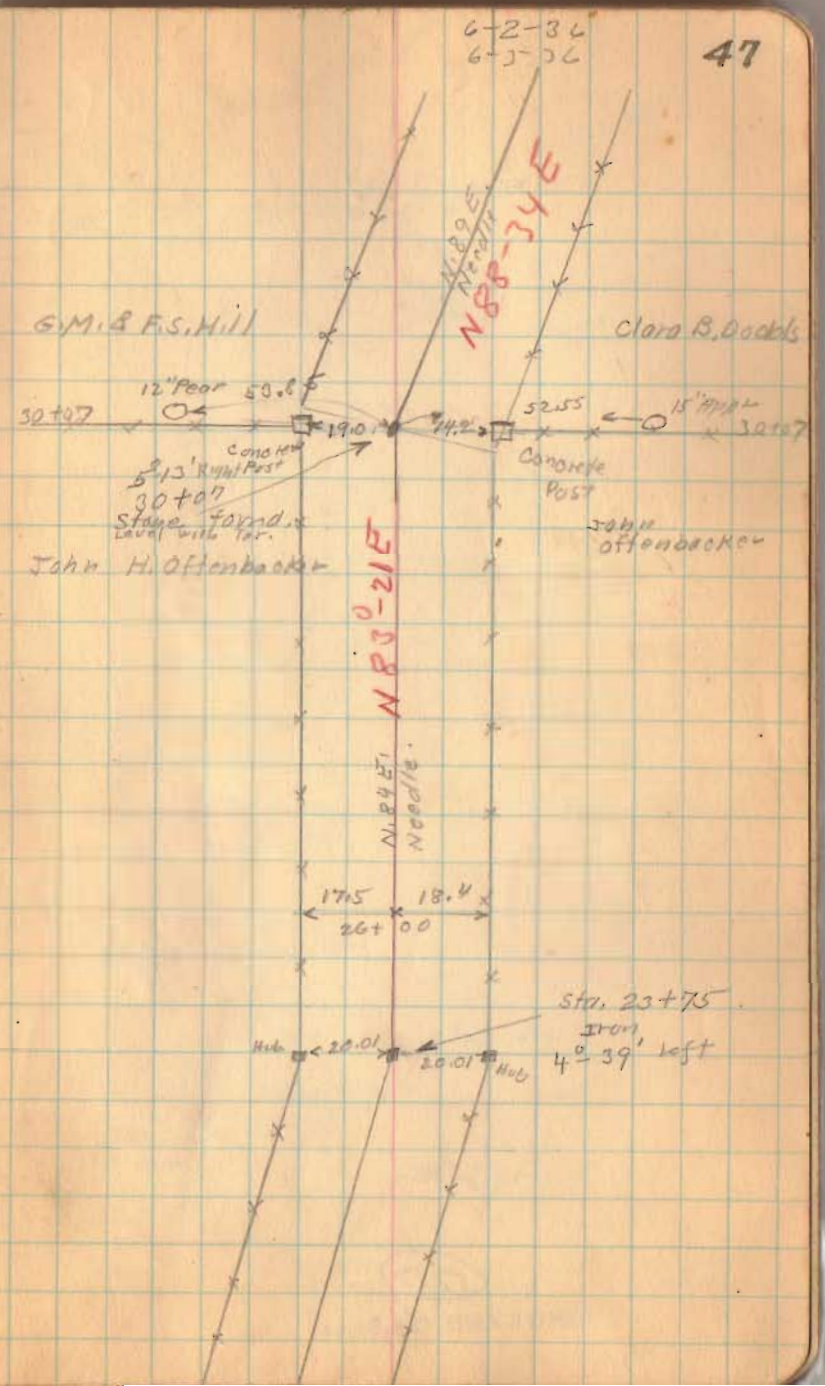

Road. 67

(1717)

INDEXED ON MAP

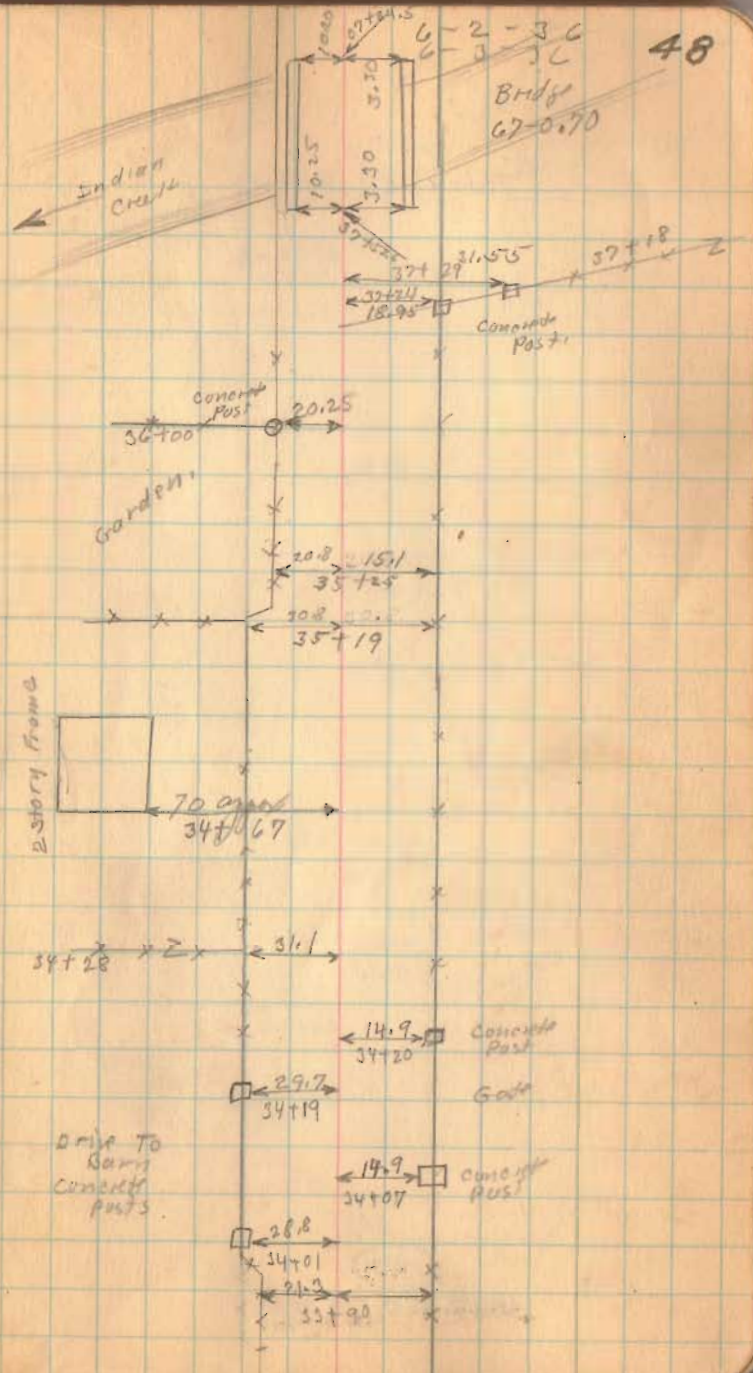

Road. 67

(1717)

INDEXED ON MAF

6-2-36
6-3-36

49

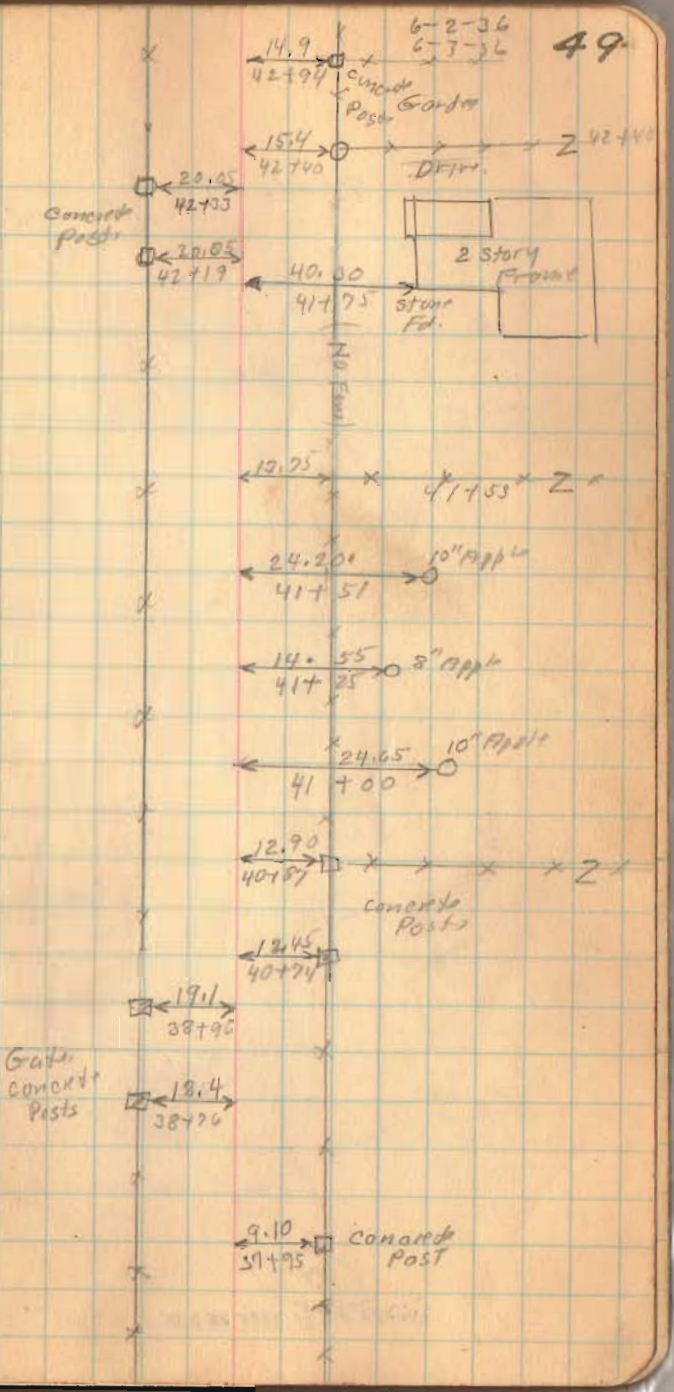

Road. 67

(1717)

INDEXED ON MAP

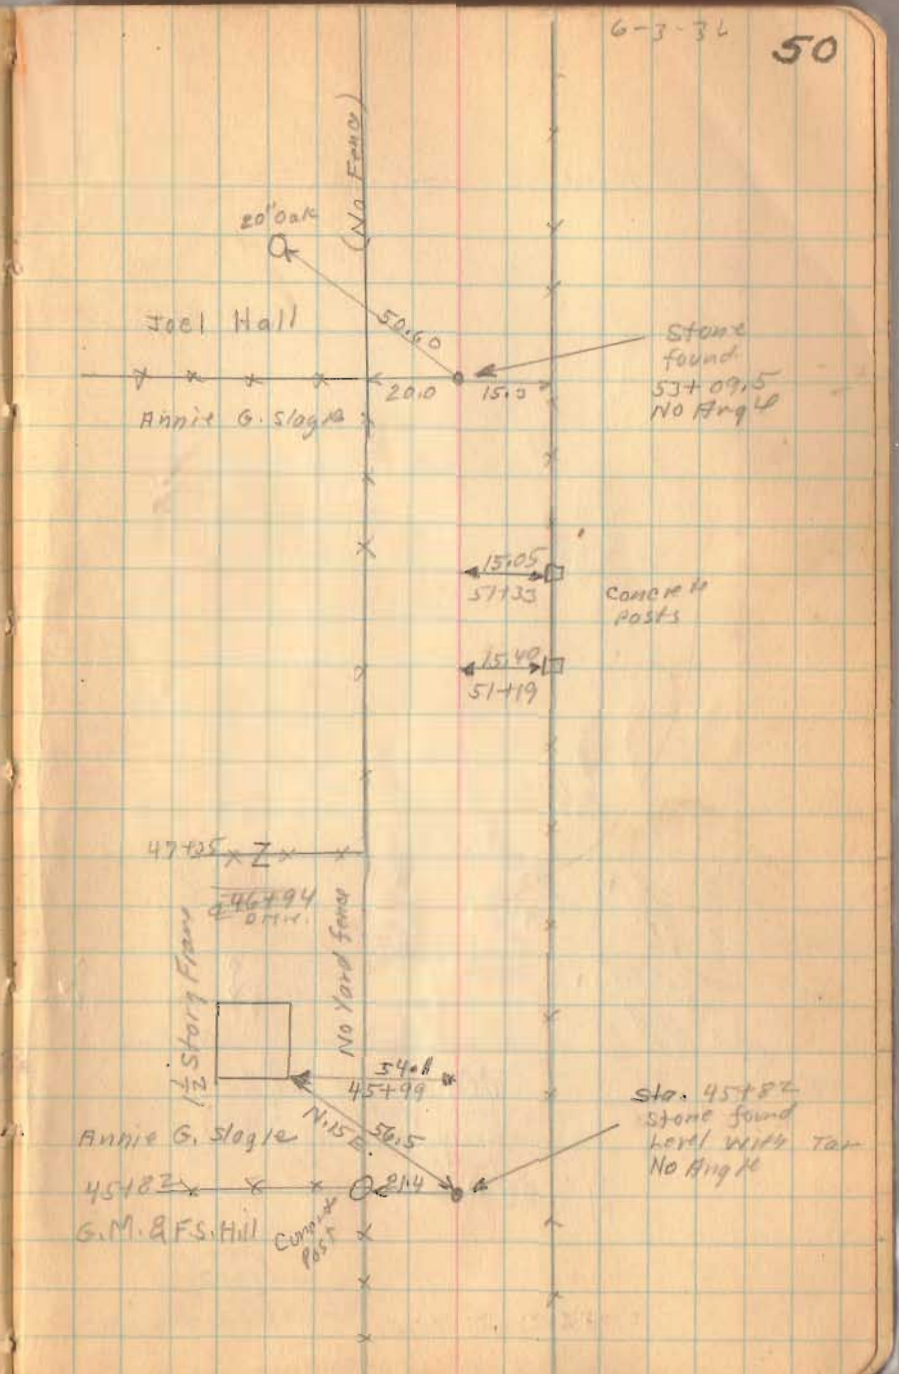

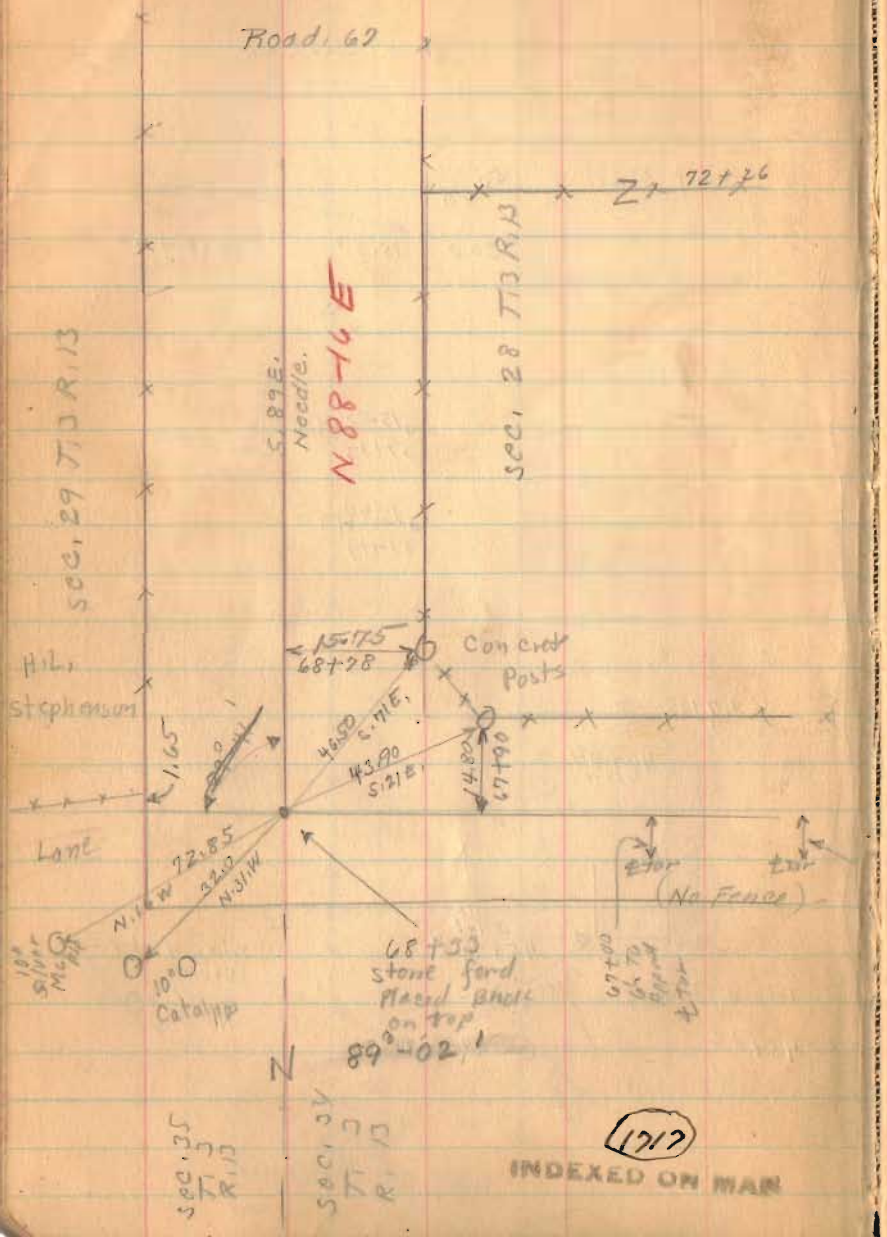
Road. 62
Z 72+76
N 88-14 E
Sec. 28 T13 R13
Sec. 29 T13 R13
S. 89 E. Needle.
15.175
68+28
Concrete Posts
H.L. Stephenson
1.65
Lane
46.50 E. MIE.
43.90 S. 21 E.
14.80
17+90
72.85
32.10
N. 31 W
N. 16 W
10" O
Catalpa
68+33 stone ford Placed angle on top
89°-02'
Etar
Tar
(No Fence)
67+00 6' to Edge of Tar
Sec. 34 T. 13 R. 13
Sec. 35 T. 13 R. 13
(1717)
INDEXED ON MAP

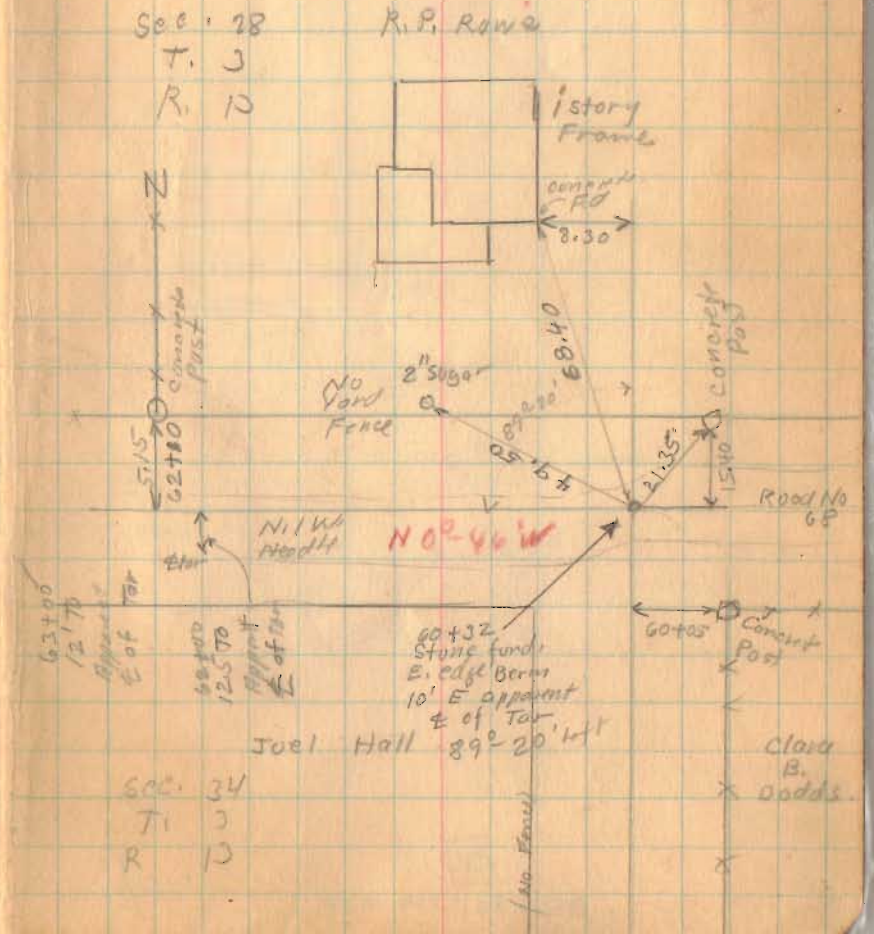
Sec. 28
T. 13
R. 12
R. P. Rowe
1 story Frame
concrete FO
8.30
N
5.15
62+80
Concrete post
No yard Fence
2" Sugar
69.40
87°-20'
87°-16'
21.35
15.40
Concrete Post
Road No 62
N. 1 W. Heath
N 0°-46' W
Etar
Tar
63+00 12.70 Apparent E of Tar
64+00 12.50 Apparent E of Tar
60+32 Stone fund. E. edge Berm 10' E Apparent E of Tar
60+05
Concrete Post
Joel Hall 89°-20'-W
Clara B. Dodds.
Sec. 34 T. 13 R. 12
(No Fence)

Road 67

(1717)

INDEXED ON MAP

June-4-36

Clear

Fine day

F.W. Wright

E. Cone

G. Villars

Earl Coons

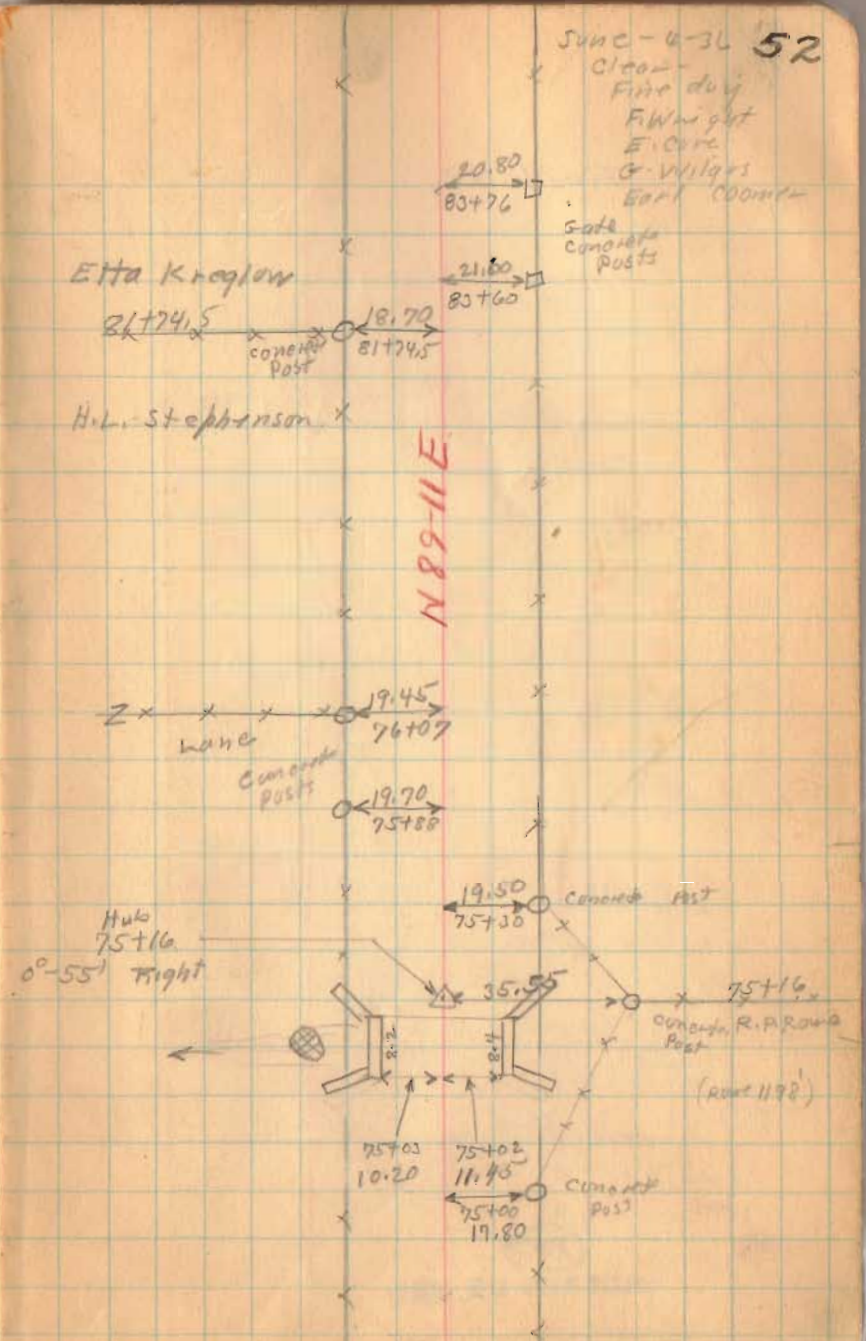

Road 67

(1717)

INDEXED ON MAP

6-4-36

53

(No fence)

90+08

88+46 → Z

Orchard

86+69 Z

Roof

1½ story frame

36.55

85+49

(No fence)

85+10 Z

6-4-36 54

Road 67

95+20
75 16
20 04
0
120

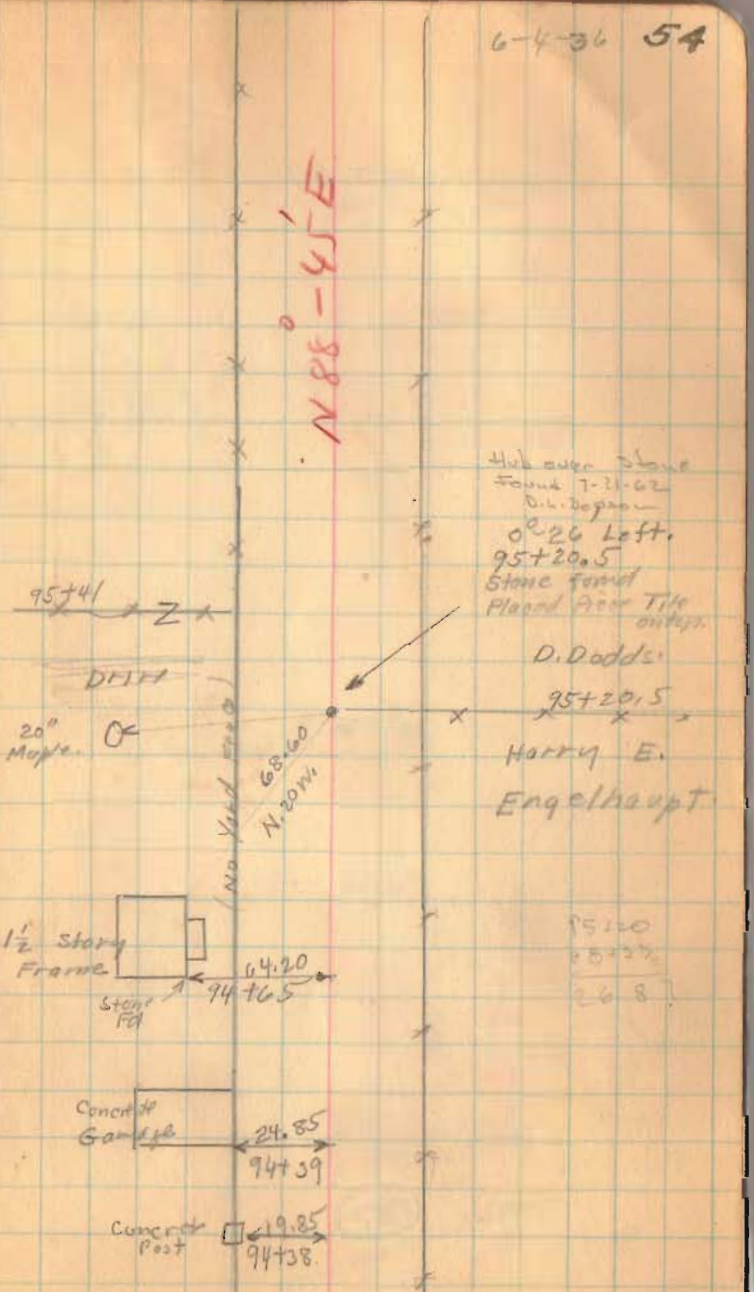

(1712)

INDEXED ON MAP

Road. 67

1+41 1+36 78 / 11 5.4 / 10 6 / 64

W. S. Calland

108+37

Etta Kreglow

19.60 111+78 Concrete Post

22.60 103+50 Concrete Post

Drive To Barn 103+24

18.90 23.25 102+07

Side Post to Corner

No Yard Fence

2 story Brick.

63. 25 101+53

100+80

INDEXED ON MAP (1747)

Road. 69

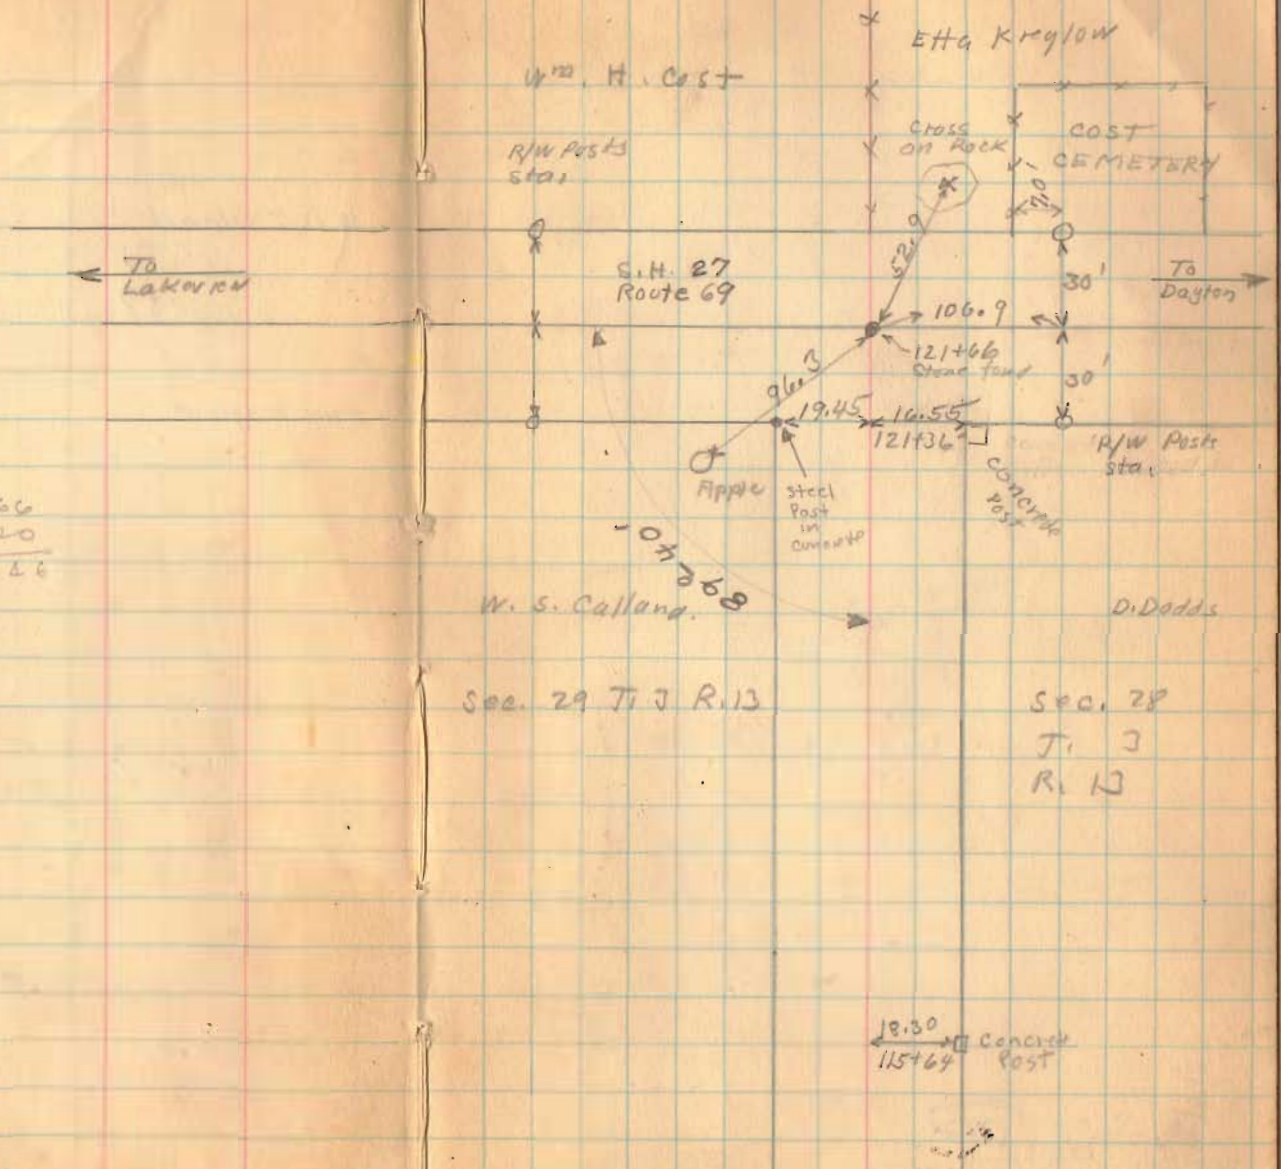

121+66
95+20
26 46

(1717)
INDEXED ON MAP

Road 67

(see Page 45)

(171)

INDEXED ON MAP

6-2-36

58

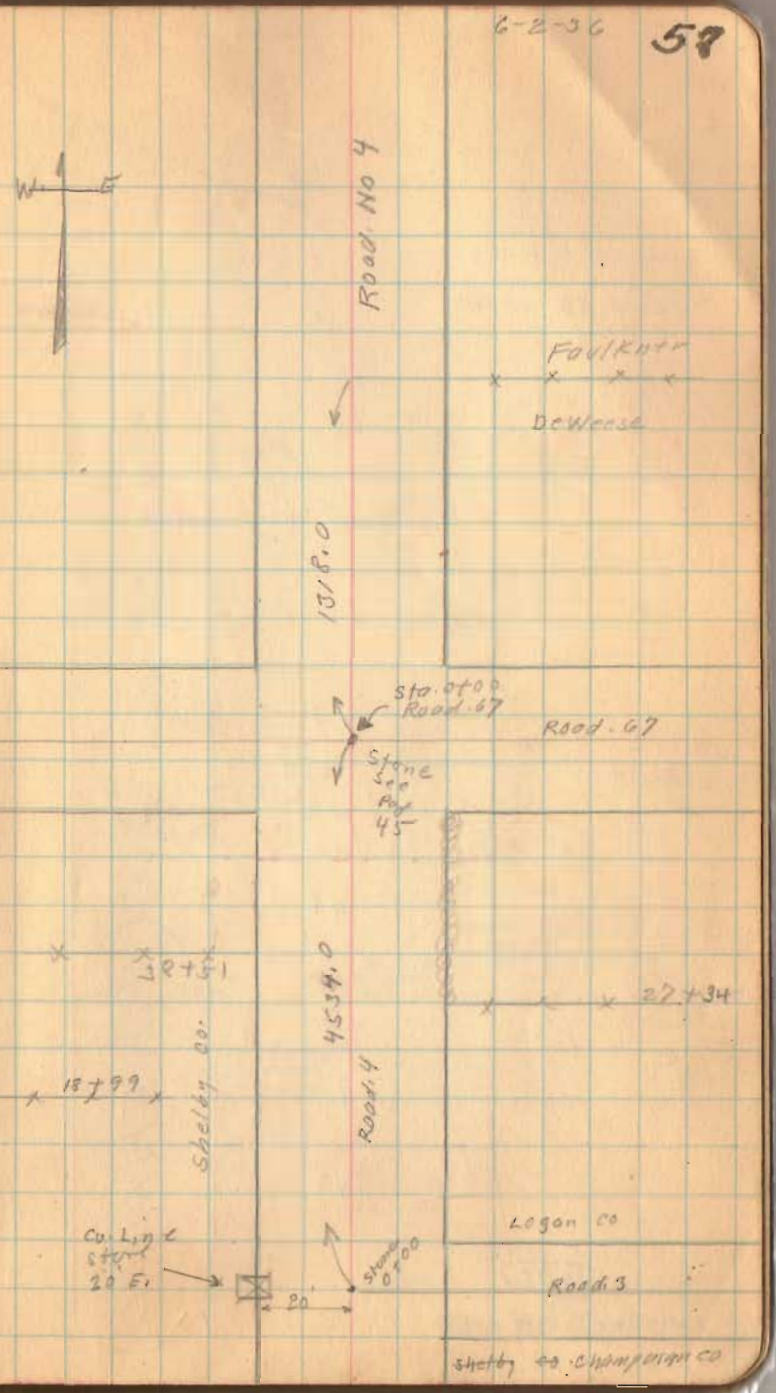

June - 9 - 1936
Warm
I. Wright
J. Montgomery
G. Wilgus
Earl Conner

Road. 106

Set sta. otes from old fences as show which seemed to check O.K.

45

28

Road. 101

44

29

43

30

42

31

41

32

40

33

39

34

Lots 66 X 132 Northwood.

Alley 16½'

Miami St. 60' (NORTHWOOD)

Alley 16½'

21

20

19

18 chimney

17

16

15

4

5

6

7

9

9

10

Walnut st. 82½'

Hub Sta. 0+00

38.0

37.2

S 62° E.

20° sugar

12° sugar

S 27¼° W. needle

S 41° W. 47.5 ft.

47.60 - 1+86.6

Main St. 82½'

- 2+40

Square Concrete Post

35.0 - 3+26

Detroit st 82½'

Ohio Turnpike

43.90 - 3+92

- 4+54

- 5+19

59.6 - 5+40

Brick House

Alley 16½'

(1372)

INDEXED ON MAP

Road. 106

Stakes Placed.

14+00 30' Left 30' Right

60' - Commissioners Journal No. 4 Pg. 137
DEC. 1834

40' - Width reduced — Road Record No 1
Page 159-160 - 1862

staked for 60' in order to
meet state road. Viewed by
Commissioners June-22-1936
Hearing June-24-1936

(1372)

INDEXED ON MAP

6-9-36

59

June-10-1936
cloudy
R Wright
J Montgomery
G Wilgus
Last Corner

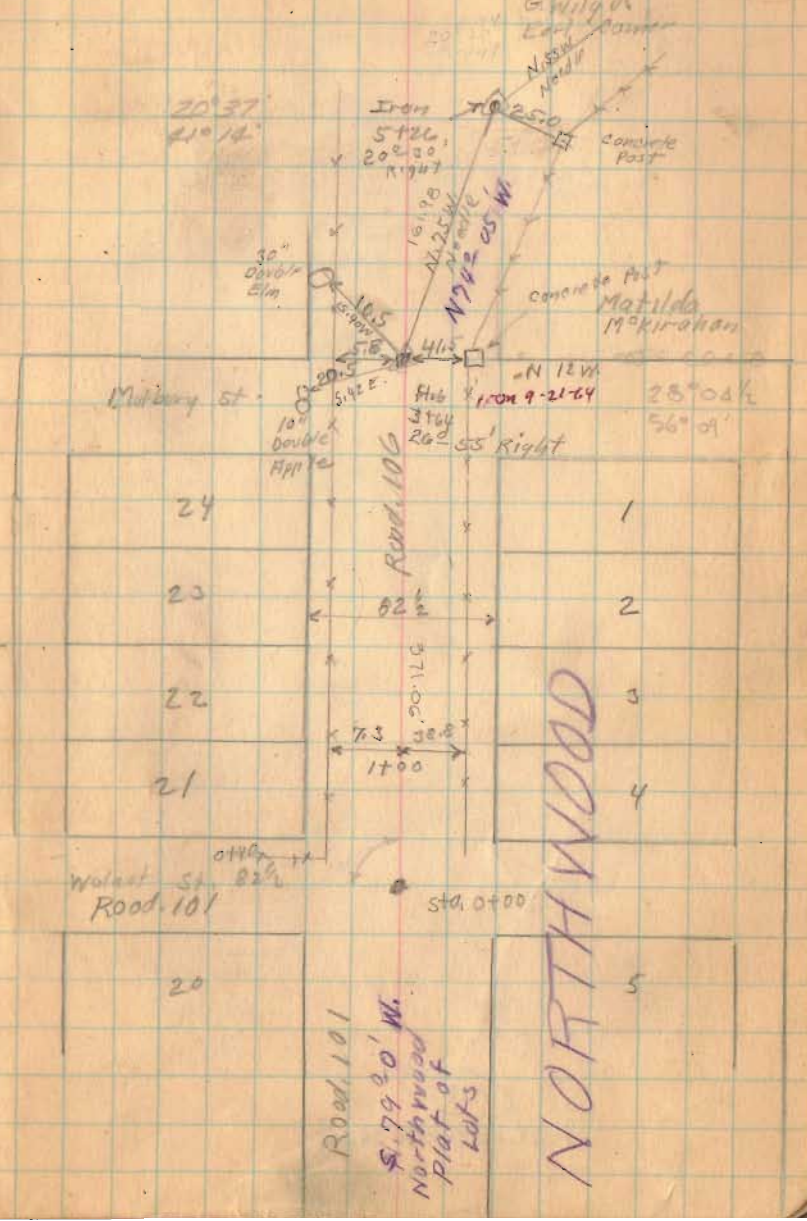

Road. 106

(132)

INDEXED ON MAP

6-10-36

60

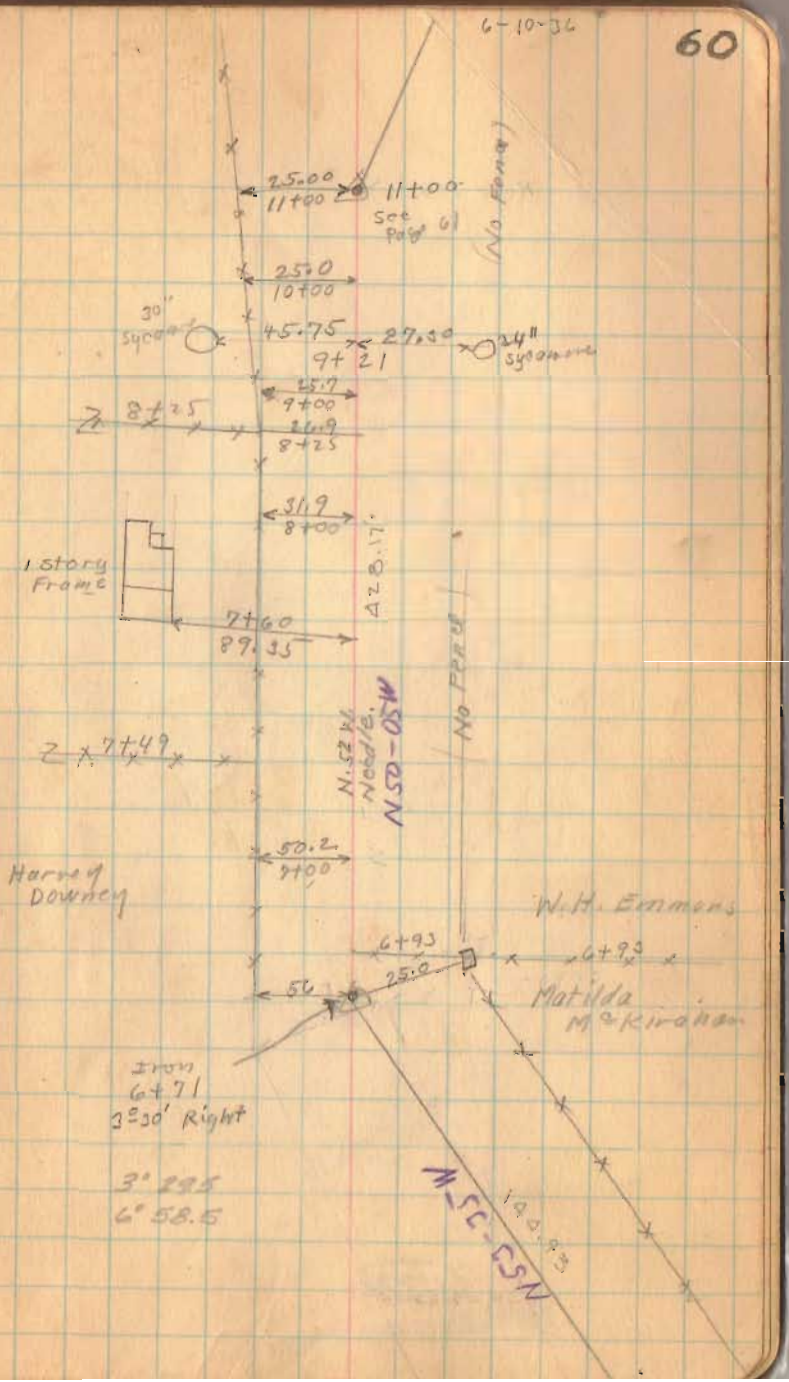

Road 106

(1372)

INDEXED ON MAP

6-10-36

61

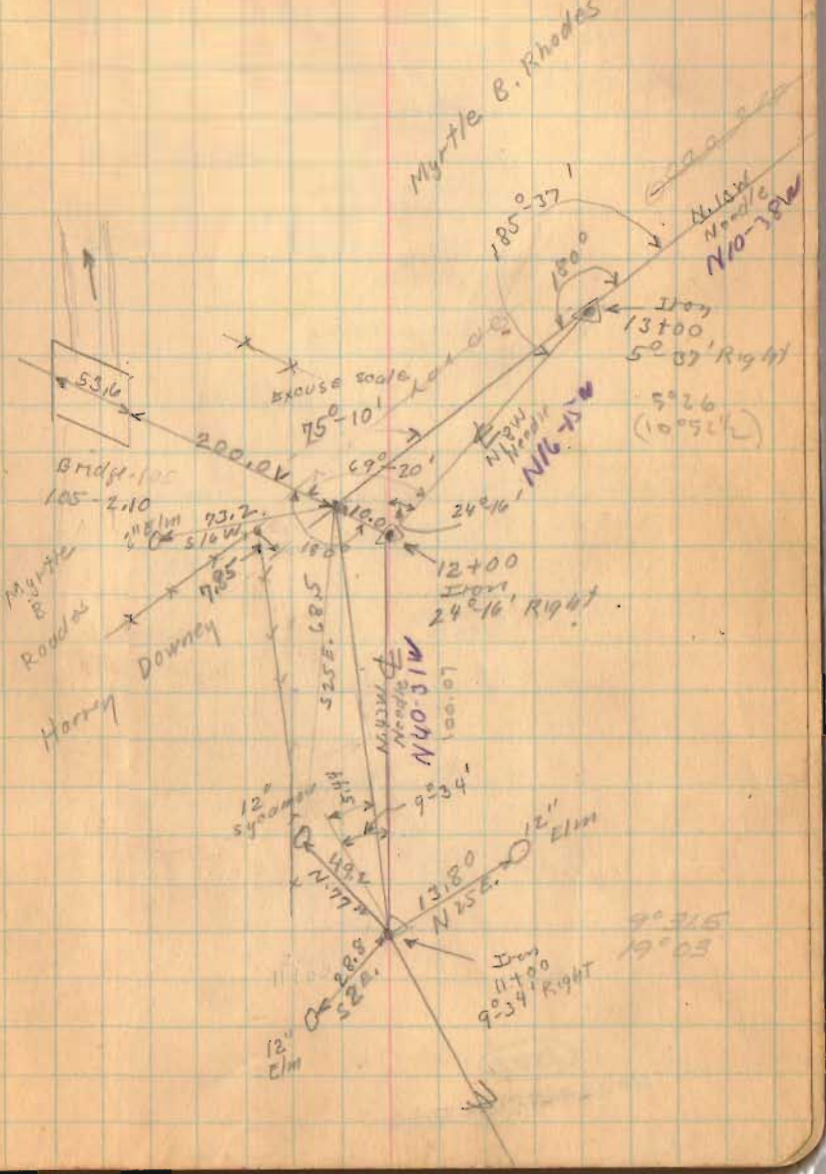

Road. 10C

(1372)
INDEXED ON MAP

6-10-3C

62

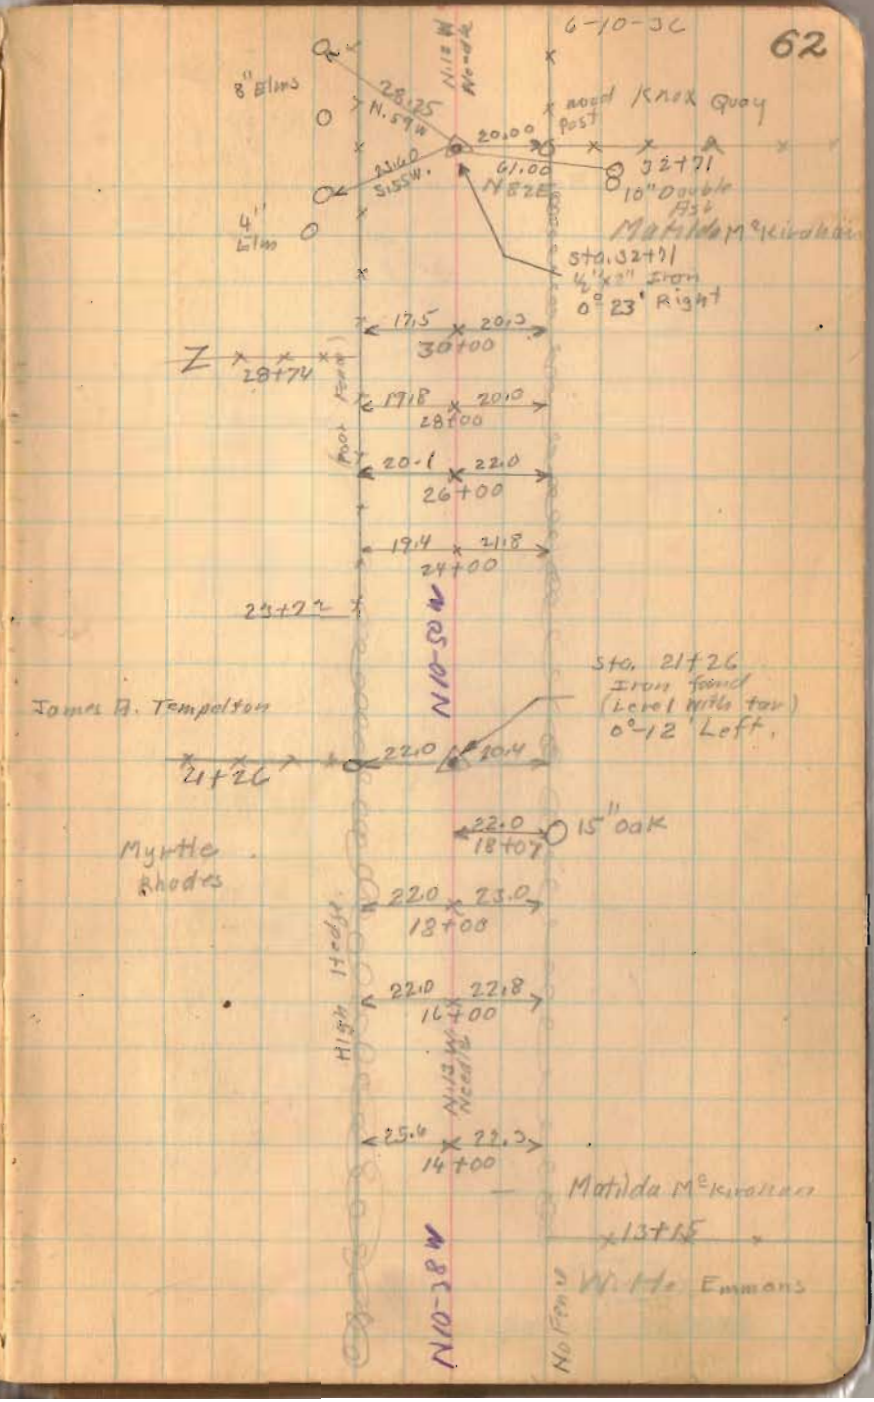

Road: 106

(1372)

INDEXED ON MAP

6-10-36

63

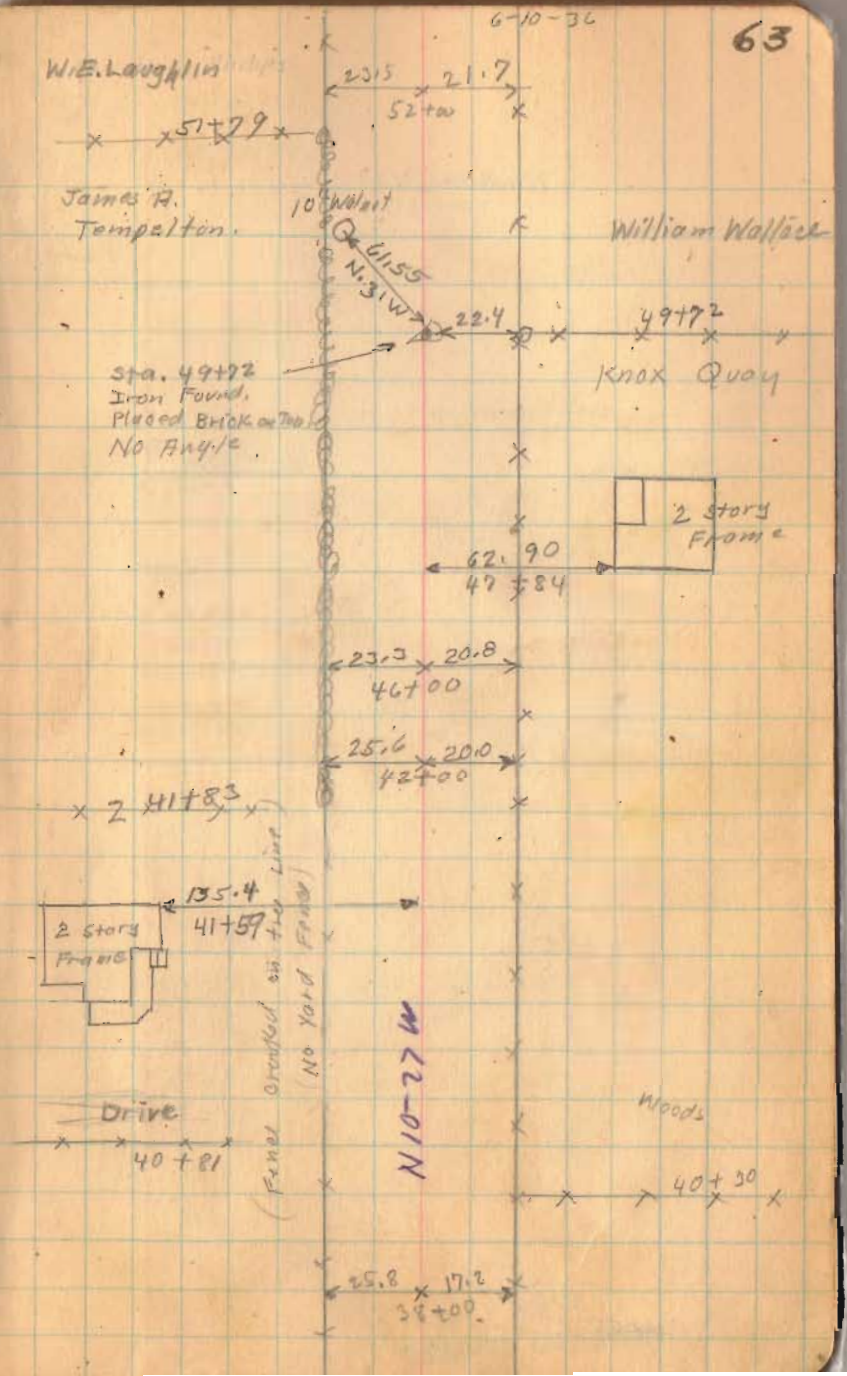

Road 100

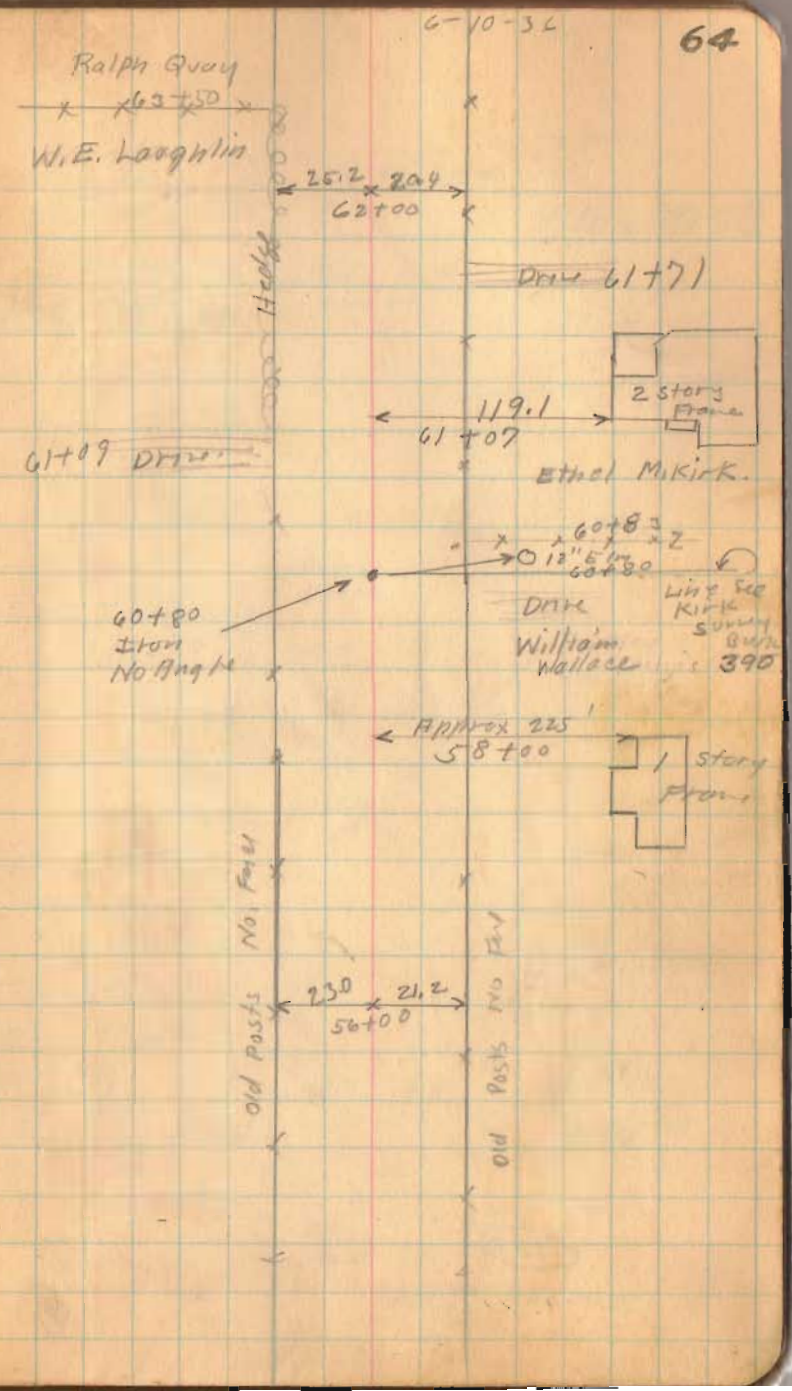

(1372)
INDEXED ON MAP

Road. 106

(1372)

INDEXED ON MAP

C-10-32

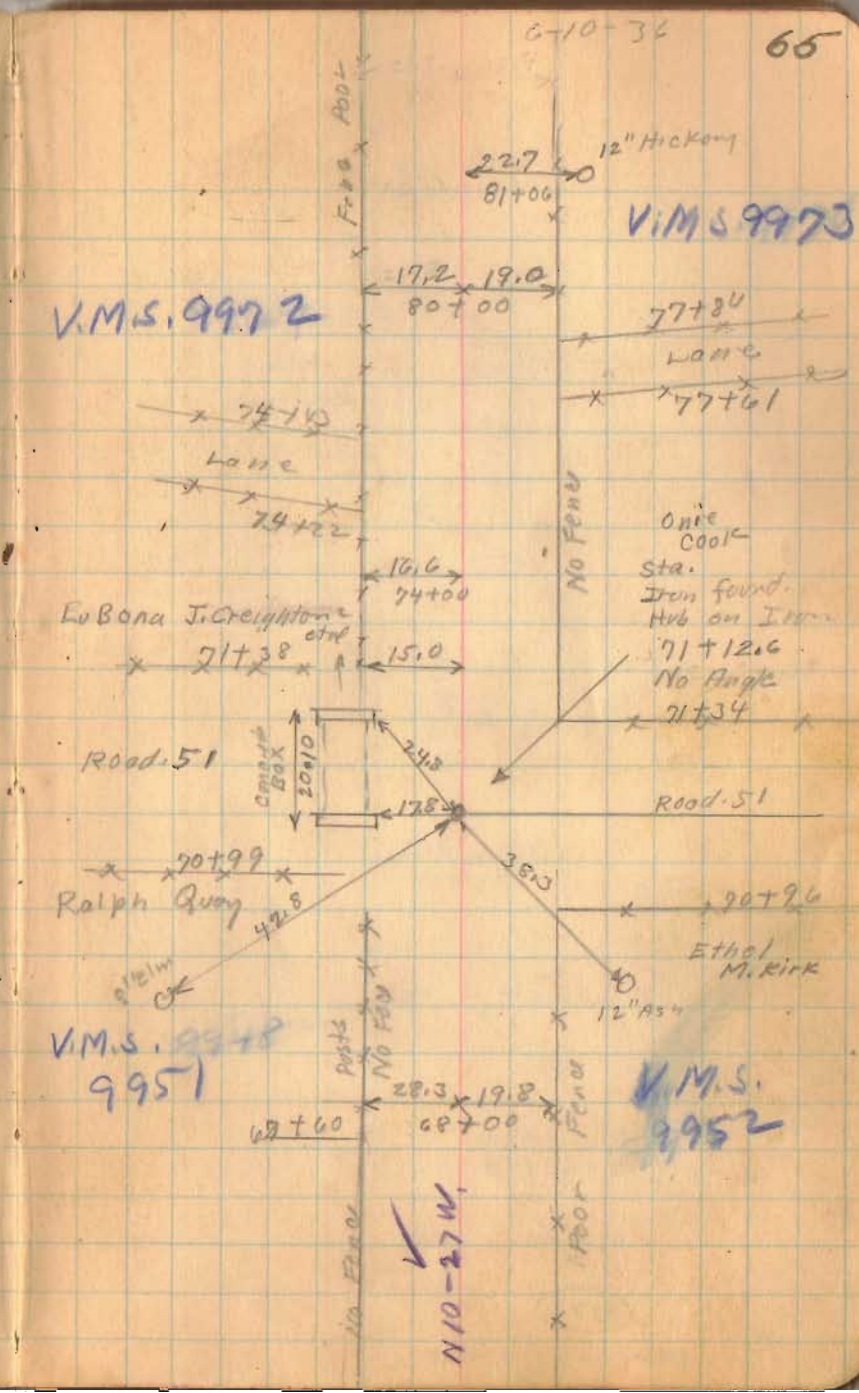

Road. 106

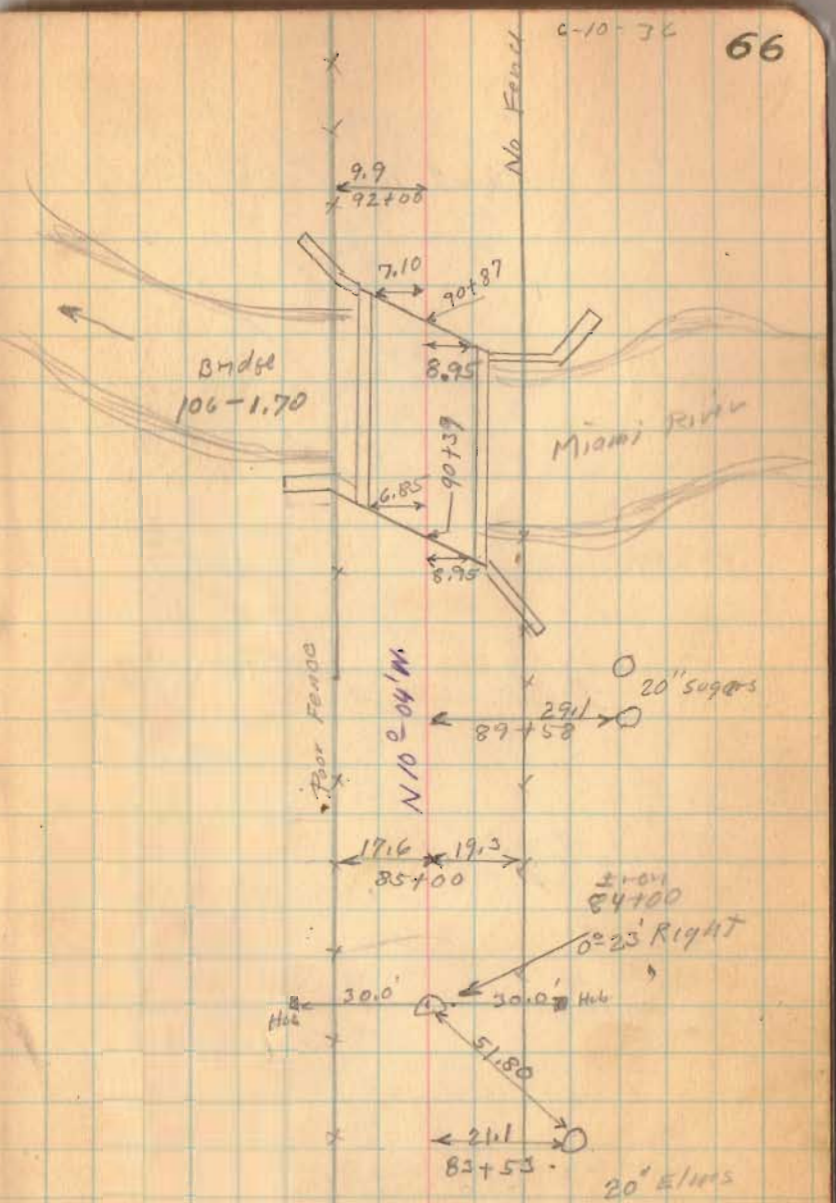

(1372)

INDEXED ON MAP

Road. 106

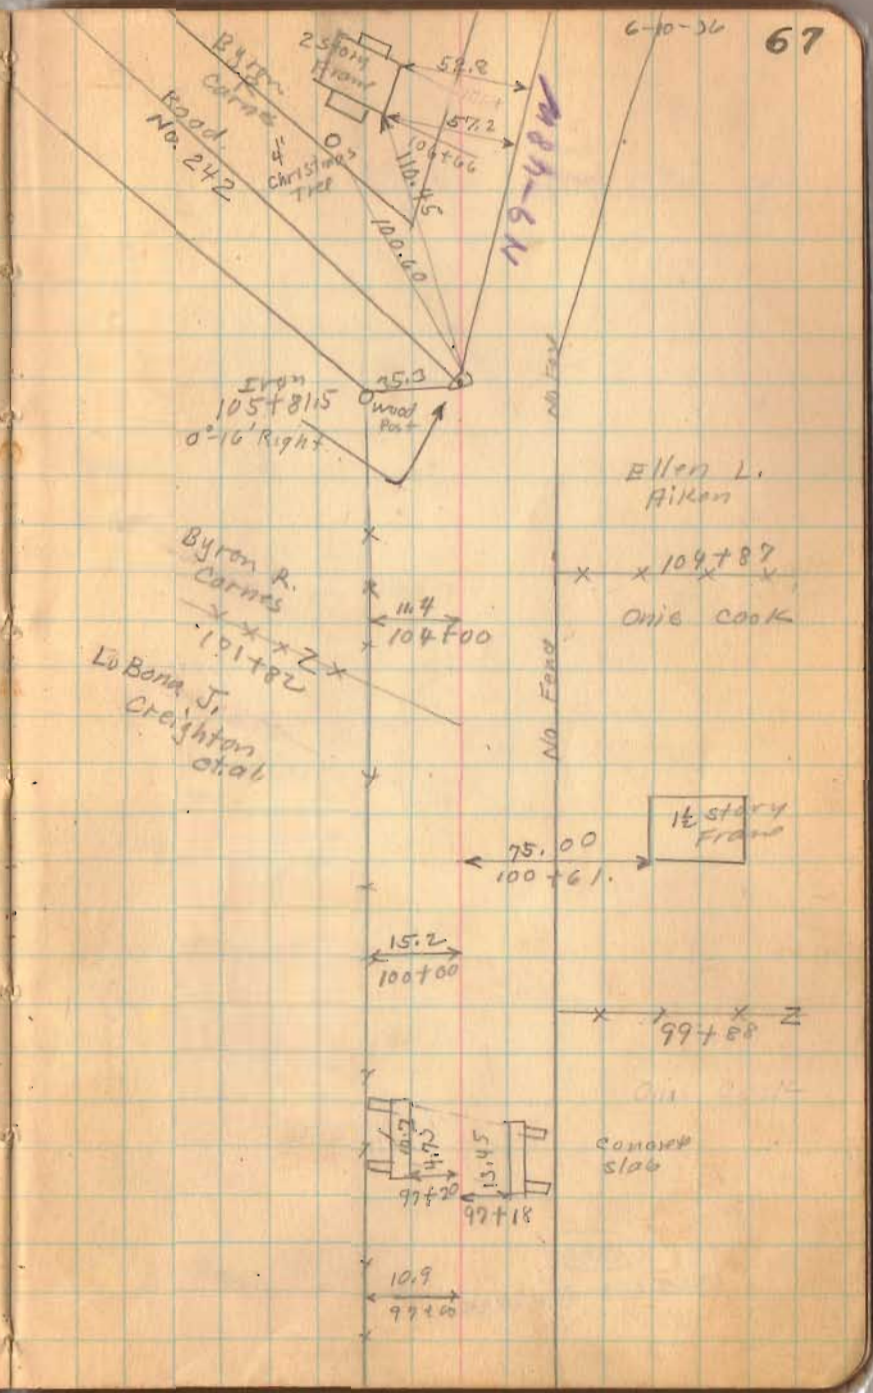

(1372)

INDEXED ON MAP

June - 11 - 1935
Cloudy - Cool
F. Wright
E. Core
J. Montgomery
G. Waldus

Road 106

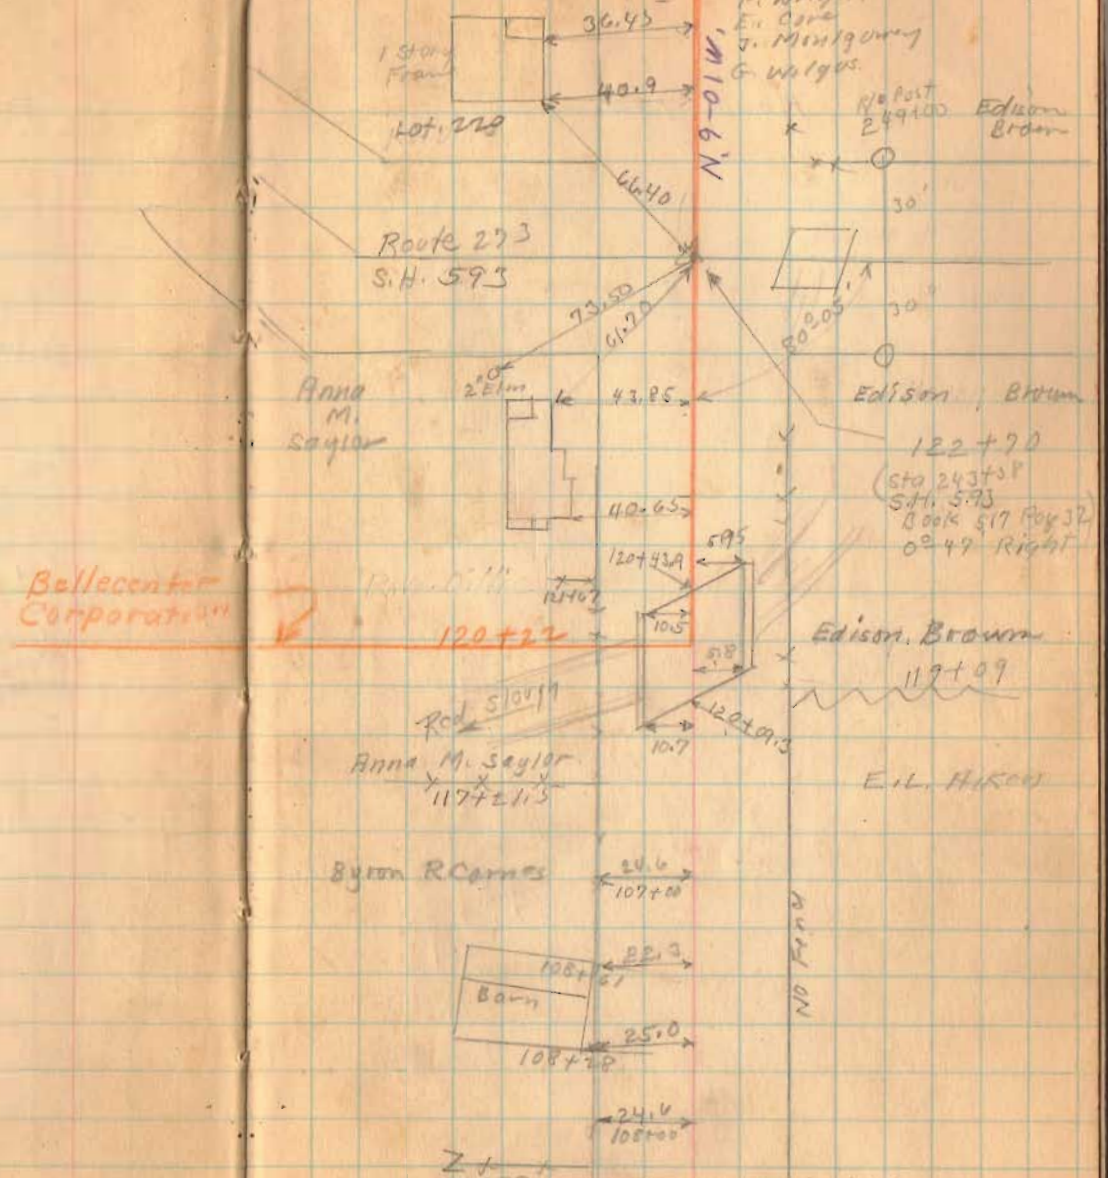

(1372)
INDEXED ON MAP

Road. 10.6

(1372)
INDEXED ON MAP

6-11-36 69

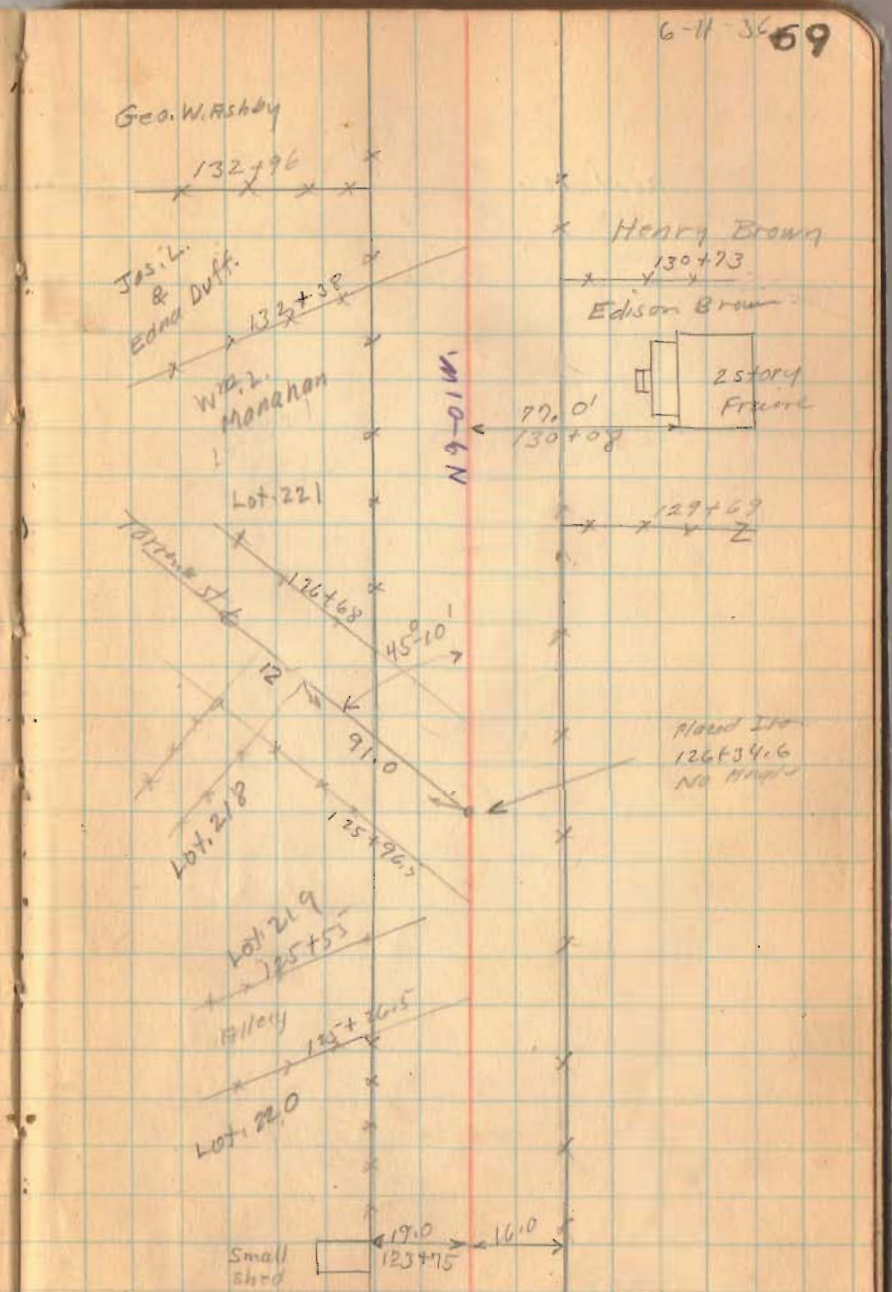

Road. 106

(1372)

INDEXED ON MAP

6-11-36

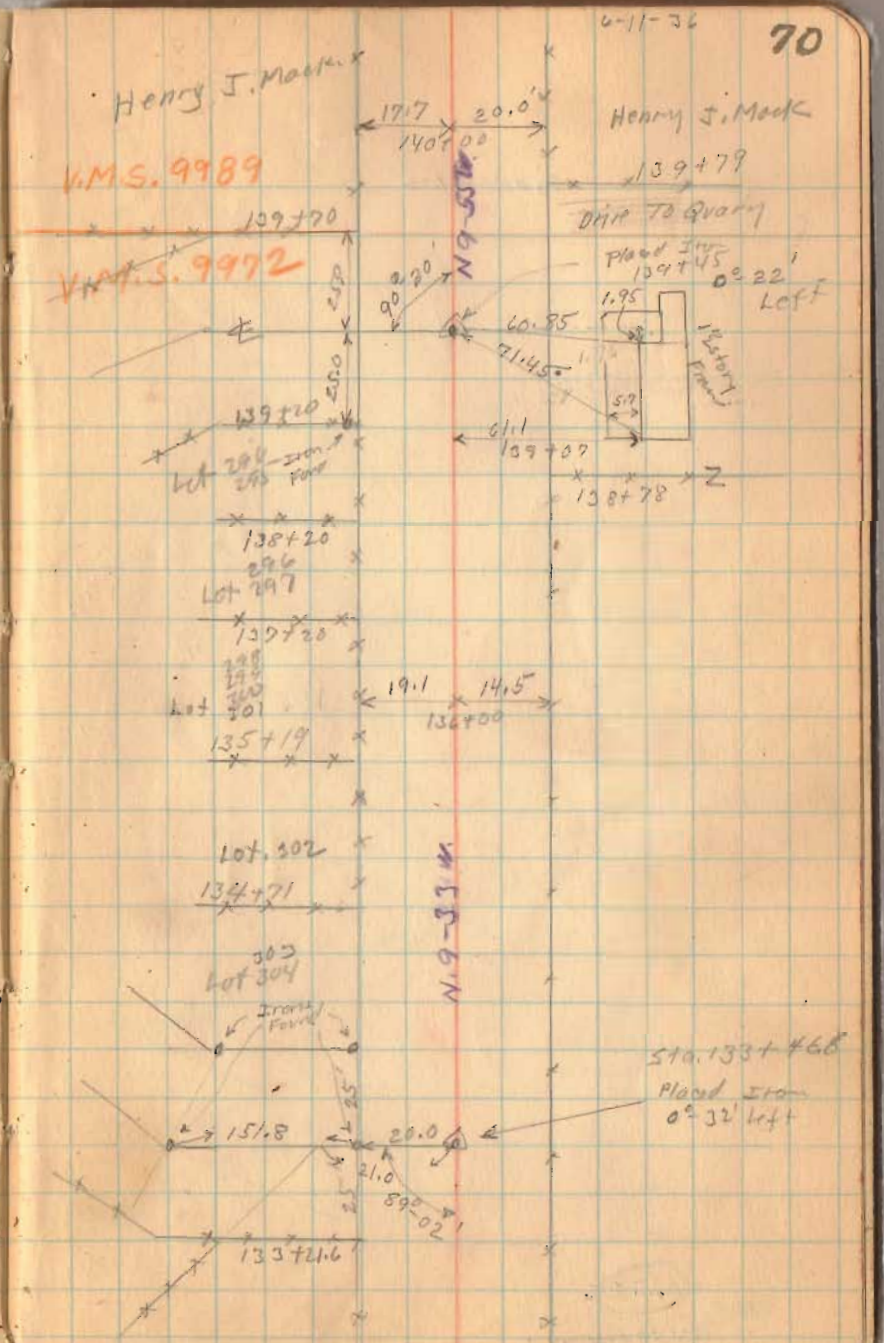

6-11-36

Road 106

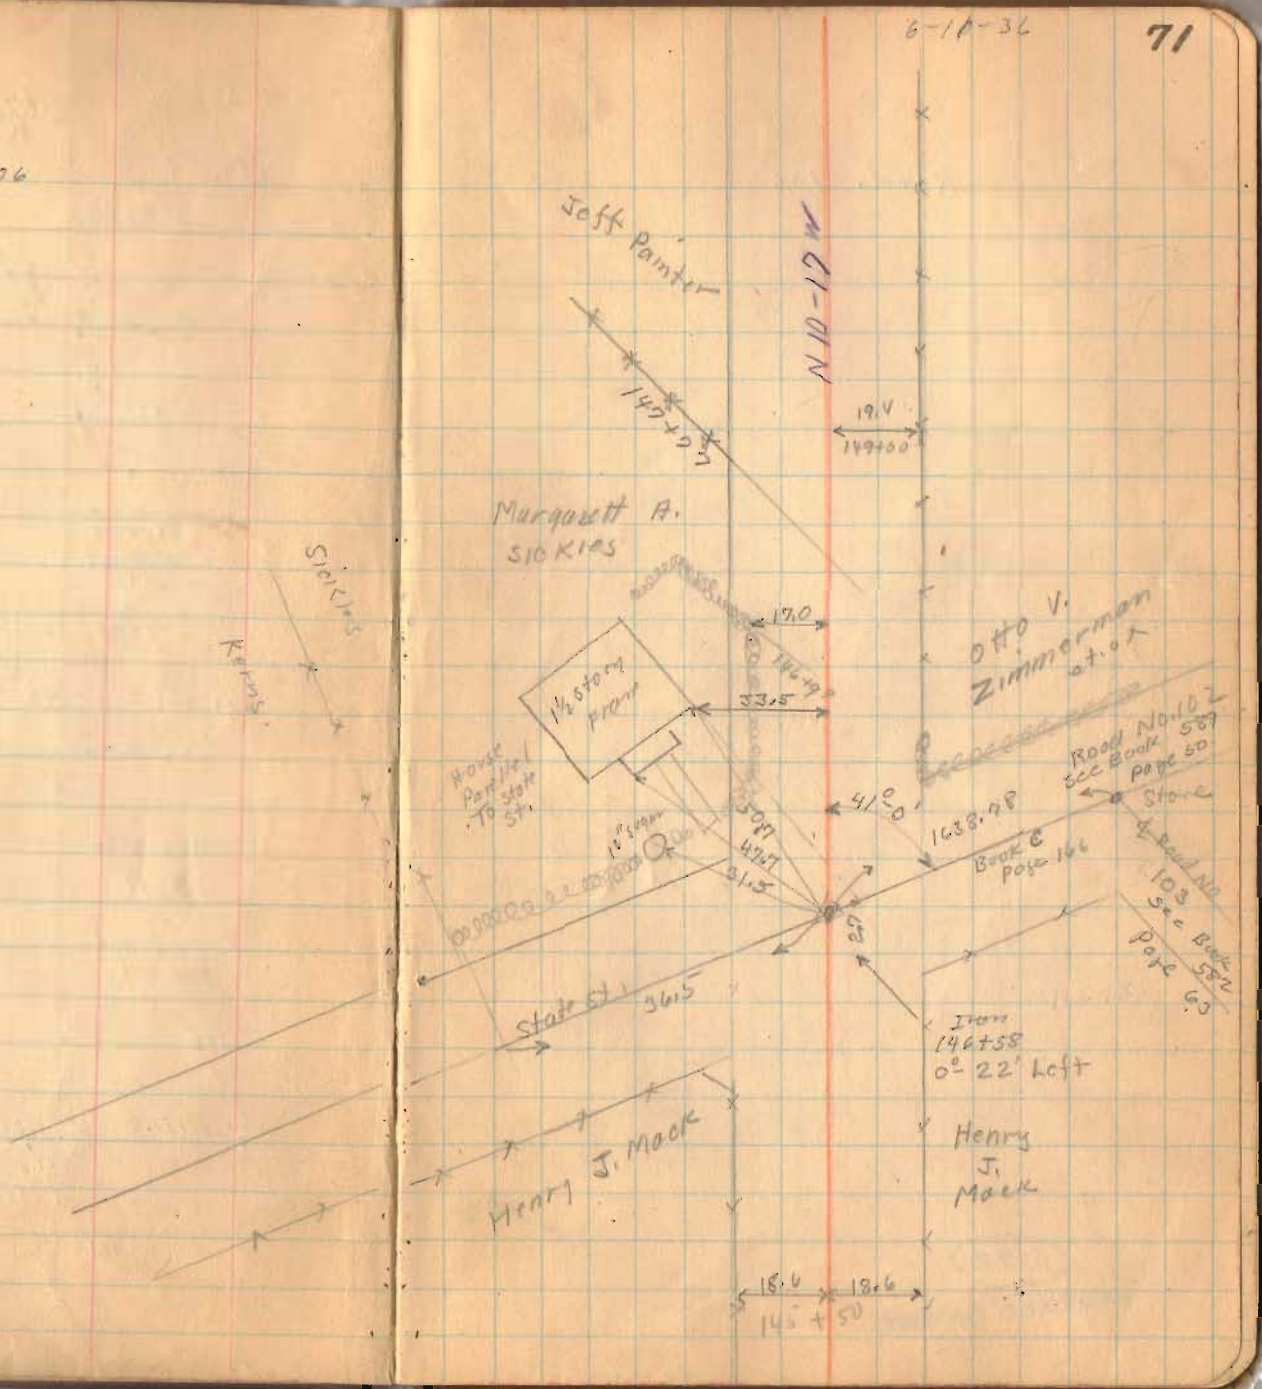

(1372)

INDEXED ON MAP

Roads 106

(1372)

INDEXED

6-11-36

72

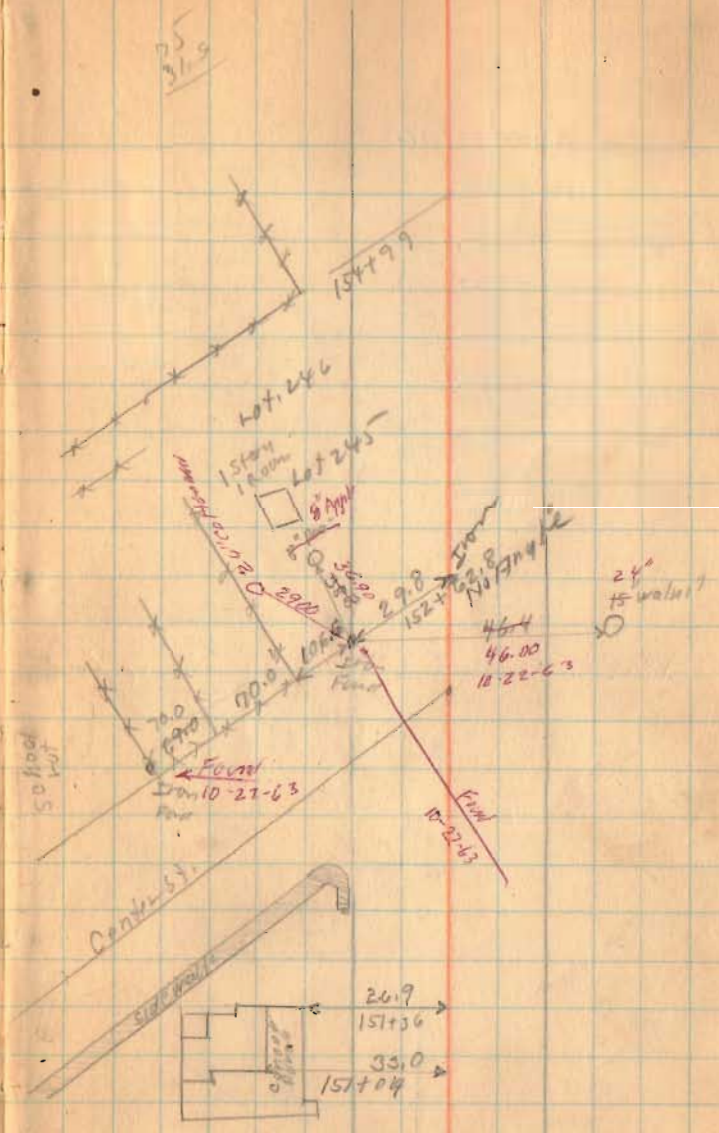

Jeff Painter

Road. 106

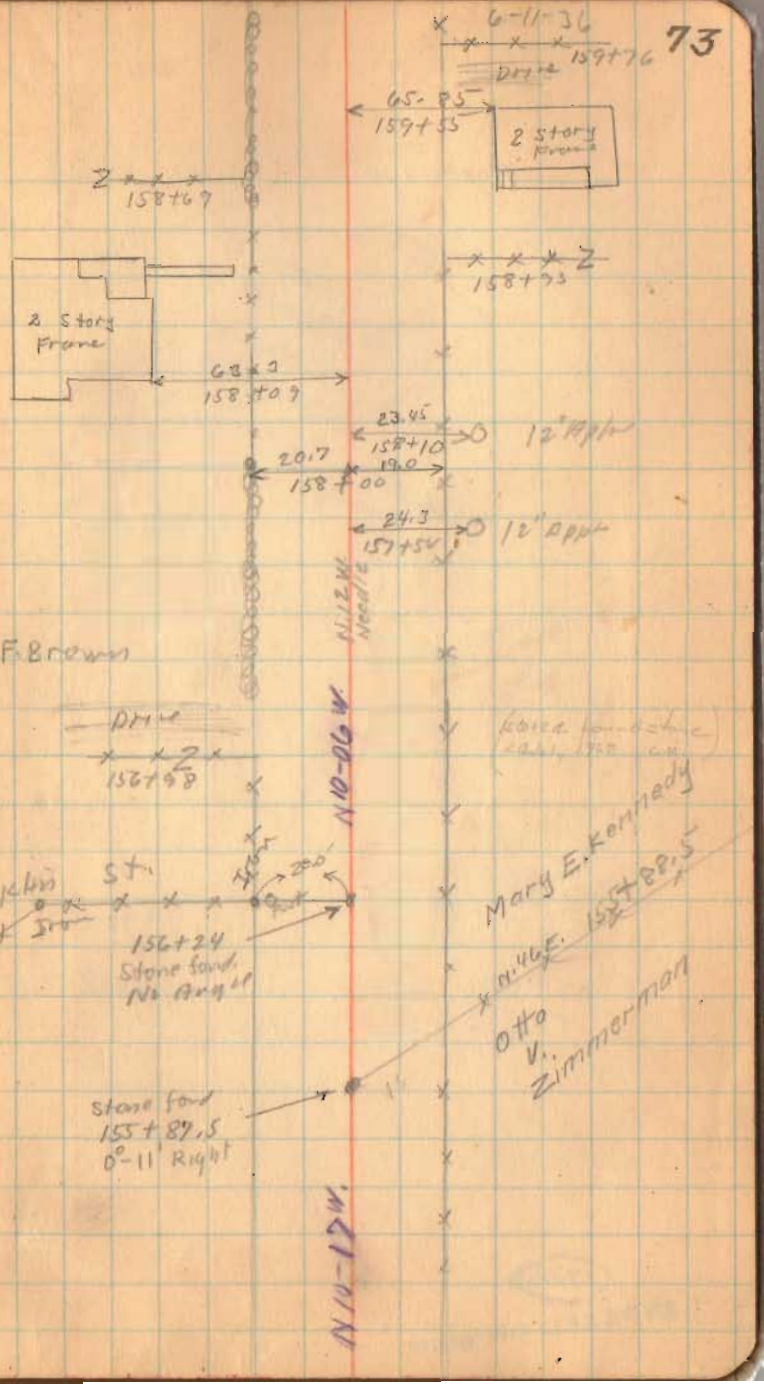

Stones Lot 1.

Iron Pin

(372)

INDEXED ON MAP

Road, 106

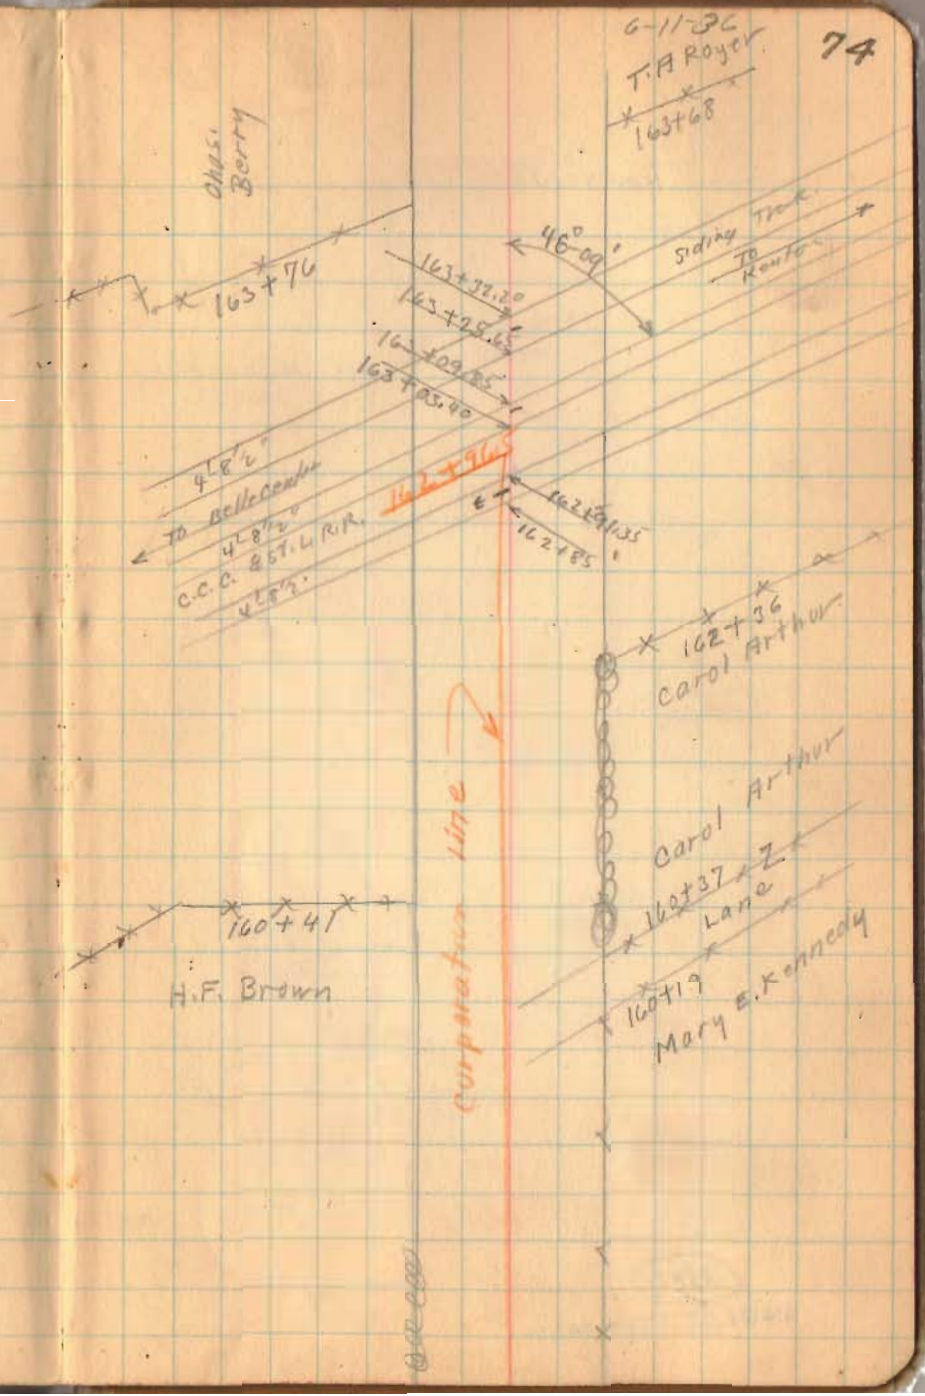

(1372)

INDEXED ON MAP

6-11-36

Road 106

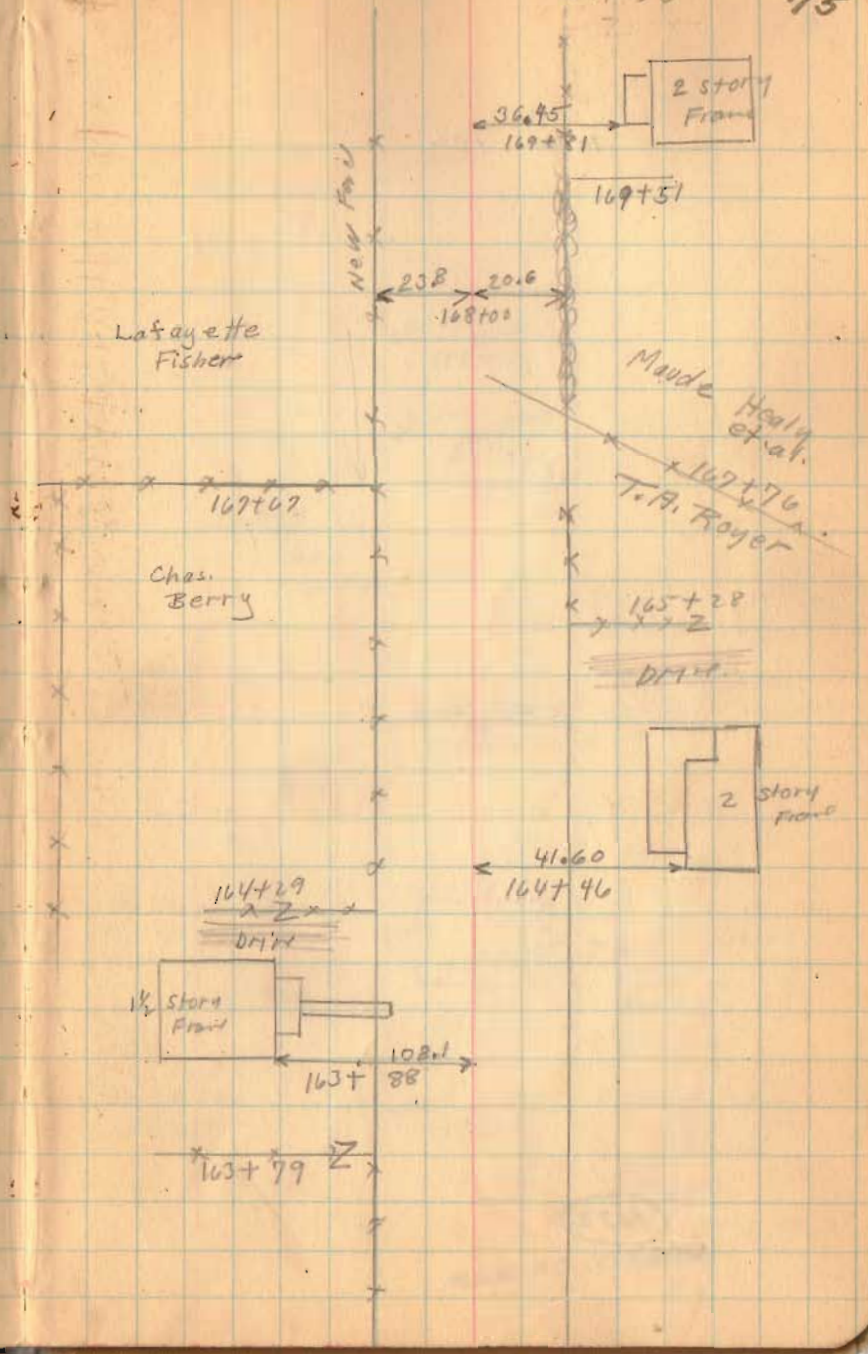

1372

INDEXED ON MAP

Road 106

186+93

28.00 20" cottonwood

186+87

Lane

186+59

21.0 20.3

182+00

20.7 20.3

177+00

176+49

Lane

M. Coe Laughlin

174+31

24.5 20.2

Eliza A. Laughlin

174+00

172+86.5

Otto Zimmerman

etux

Liggett Lateral

9.4 6.6

Bridge No

106-3.85

172+50

172+54

Lafayette

Fisher

23.8 18.0

172+00

Eliza A. Laughlin

171+67

Maude

Healy et al.

Indian

1922

INDEXED ON MAP

Road 106

Length 19523 Feet
" 3.6975 Miles
" 3.70 Miles

(1372)
INDEXED ON MAP

6-11-X

77

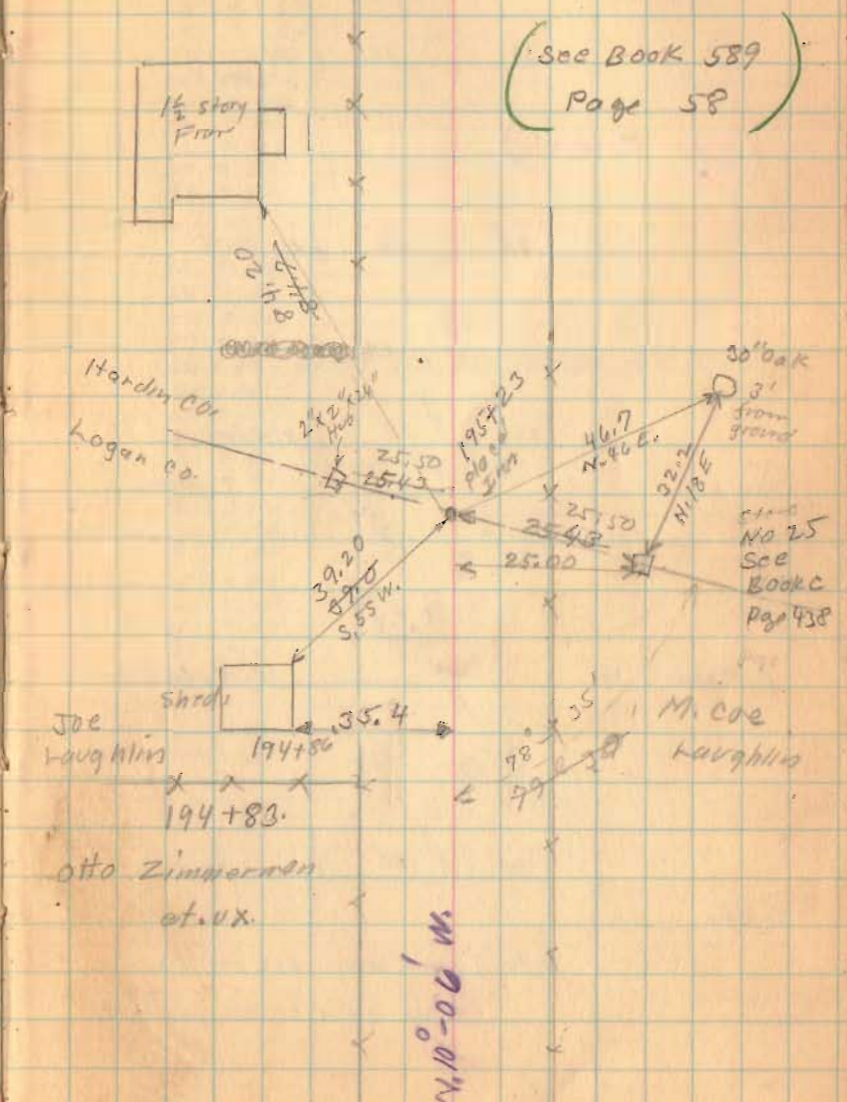

Road 67
(State Route 706)

April-17-1959
F.F. Wright
G.W. Wilcox

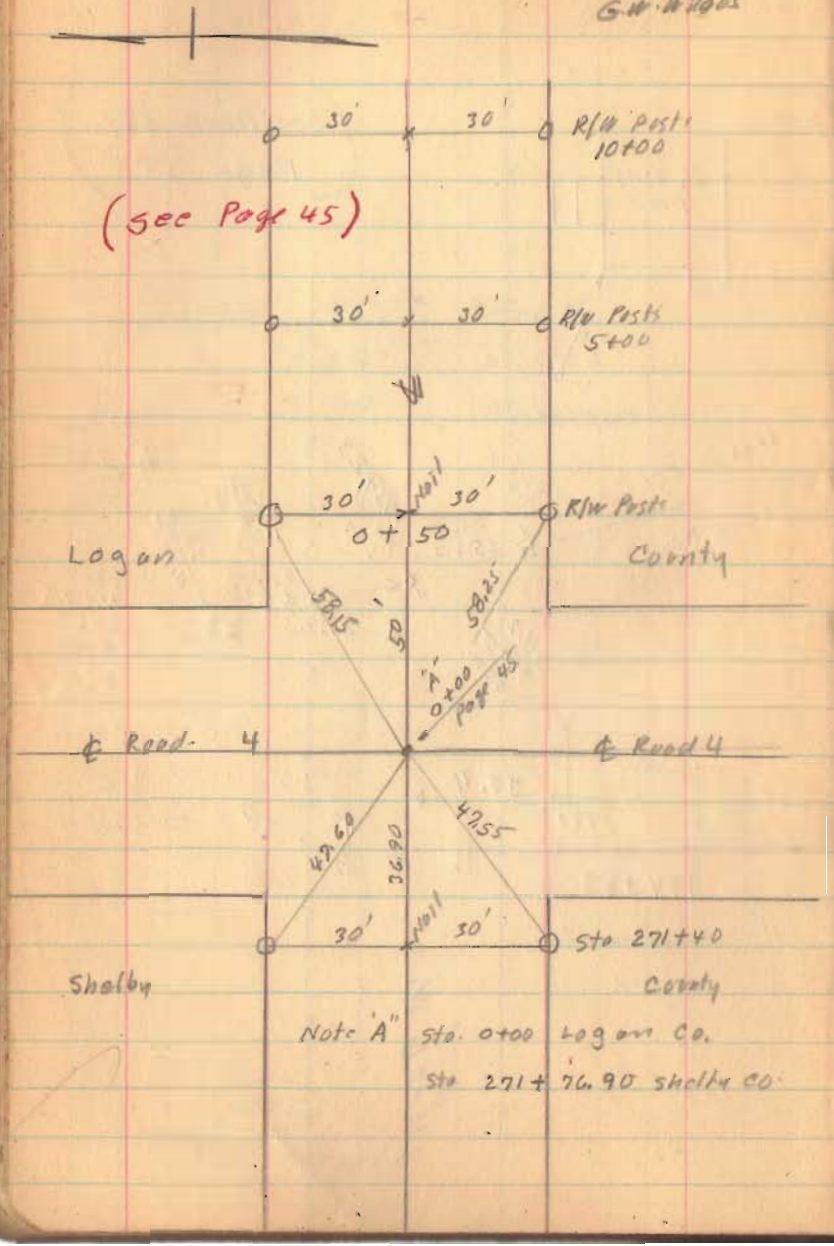

State Route 706
R/W Posts Noted April 18-1959
F.F. Wright
G.W. Wilcox

0 + 50
5 + 00
10 + 00
15 + 00
20 + 00
23 + 00
24 + 00
29 + 50
30 + 50

45 + 00
50 + 00
55 + 00
59 + 00
(60 + 32 Noted R/W Post ends for P.I.)
65 + 00
67 + 00
70 + 00
75 + 00
80 + 00
85 + 00
90 + 00
95 + 00
100 + 00
105 + 00
110 + 00
115 + 00
121 + 00