May 25, 1939
E. Core
M. Janes
C. Tennant
H. Lee
S. Dobie

Road No. 208 Pleasant Township

(Widths)

Station 0+00 To 14+83.7 No Record

Station 14+83.7 To . Width - 30' See Road Record Volume 2 - Page 494.

Station To No Record

Station To ~~40' wide - see Comm. Journal Vol. 10 P. 87~~

Stakes set at 100 foot stations for a 40' Road, as ordered by Mr. Harry Boone.

Township Trustees -
Harry Boone - Logansville
Leo Knight - "
E. S. Burke - "

S. G. Rohrer - Clerk - "

(1811)

INDEXED ON MAP

Road # 208 Pleasant Township

(Summer) May 25, 1939
E. Core
M. Jones
Ten
Lee
Dobie

6

Sta. 0+00. Iron set on E.W. line between line fence E. & Stone W. at Sta. 14+68.7

Set in apparent ℄ Road 11 produced from N.

Stakes set at 100' stations - 40' width

(Sta 7+00 Monuments)

(Sta 1+00 - Monuments)

RESET STA 0+00 3/4/72 -w/ 3/4" ℄ LHG
REF G-2/P8
FB 667/P15

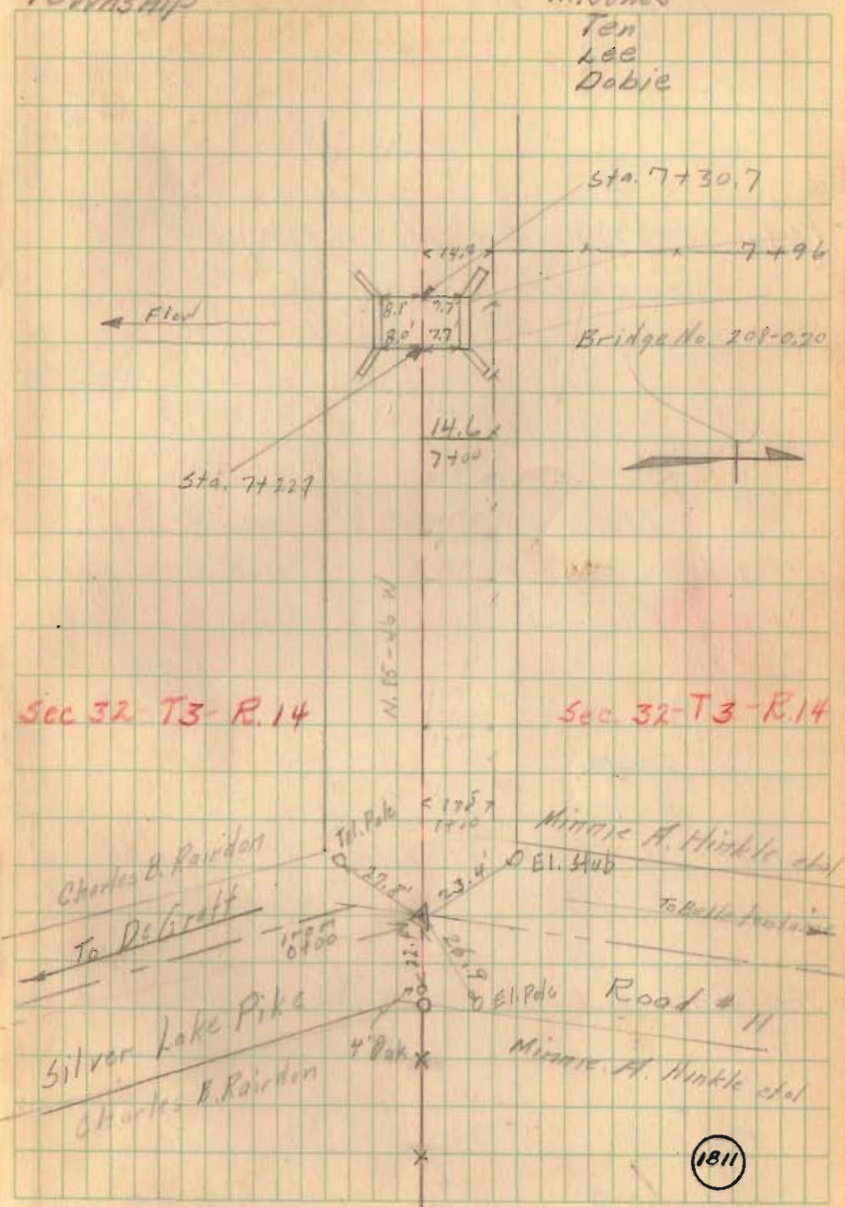

INDEXED ON MAP

May 25, 1927

Road # 208 Pleasant Twp.

(Sta. 15+83.7 P.T. Monuments)

P.C.	Sta-	13+83.7	Iron
P.I-	" -	14+83.7	Hub
P.T.	" -	15+83.7	Iron

Section Line

$\Delta = 89° 47'$
$T = 100'$
$R = 100'$

Stakes placed at 25' intervals on inside of arc only.

(Sta 13+83.7 P.C. Monuments)

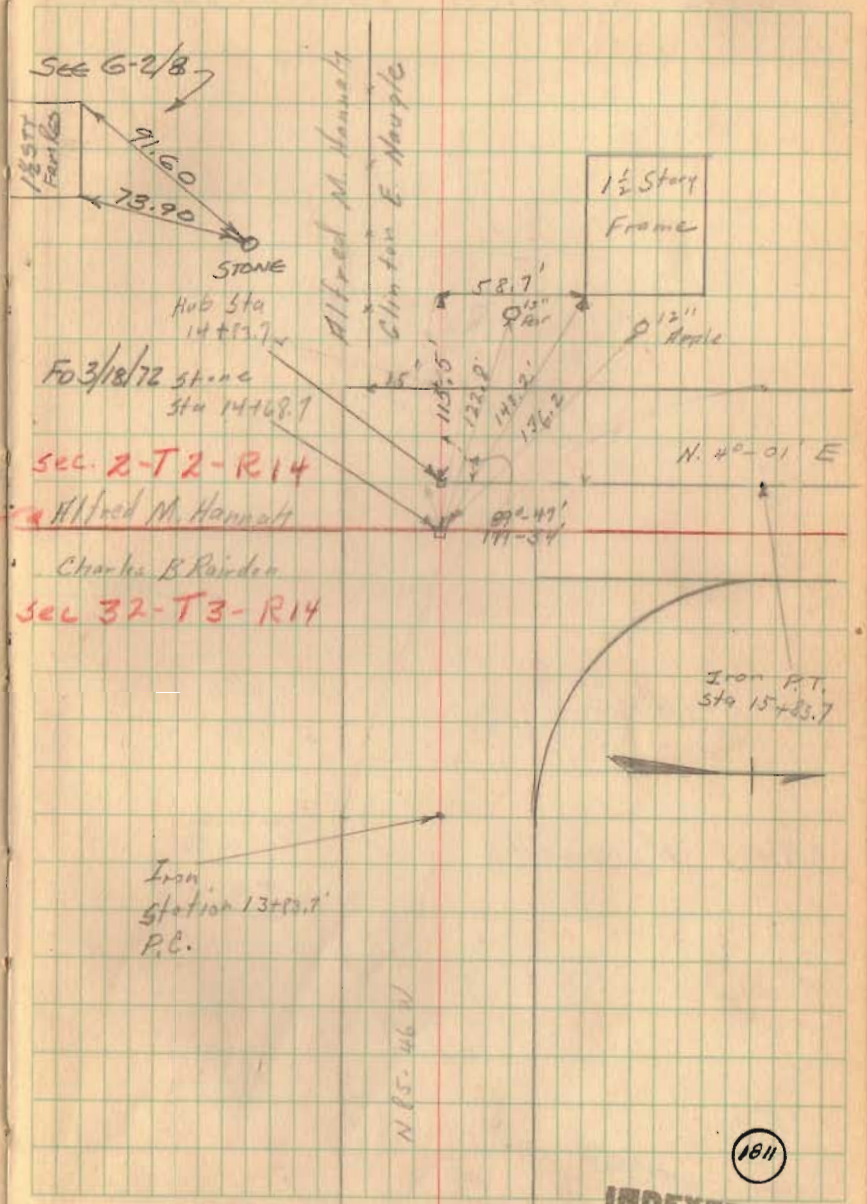

1811

INDEXED ON MAP

Road # 208 Pleasant Township

Fusan
Raindeer

27+00 - Monuments

21+00 Monuments

5/26/39

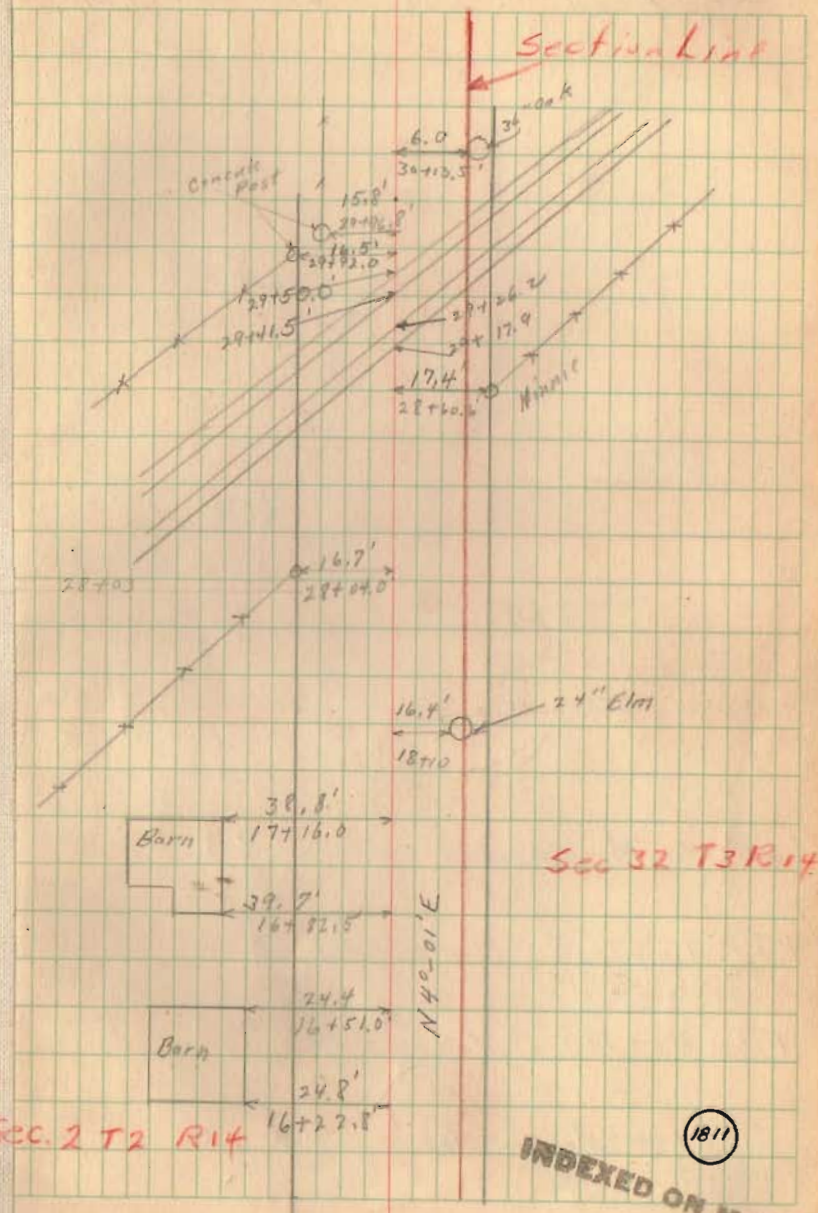

1811

INDEXED ON MAP

Road # 208 Pleasant Twp.

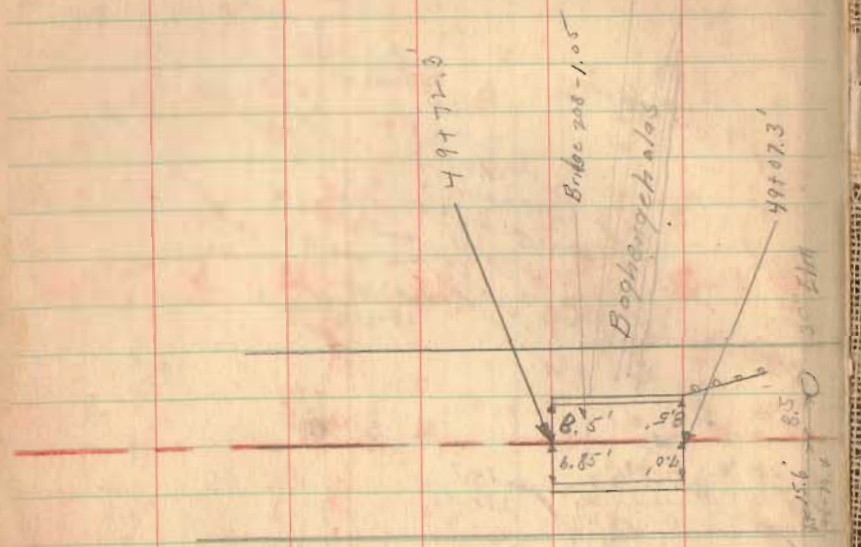

(46+00 Monuments)

(P.T.- 42+71.5 Monuments)

P.C. 40+71.5 (Monuments)

(36+00 Monuments)

(31+00 Monuments)

5/26/39 9

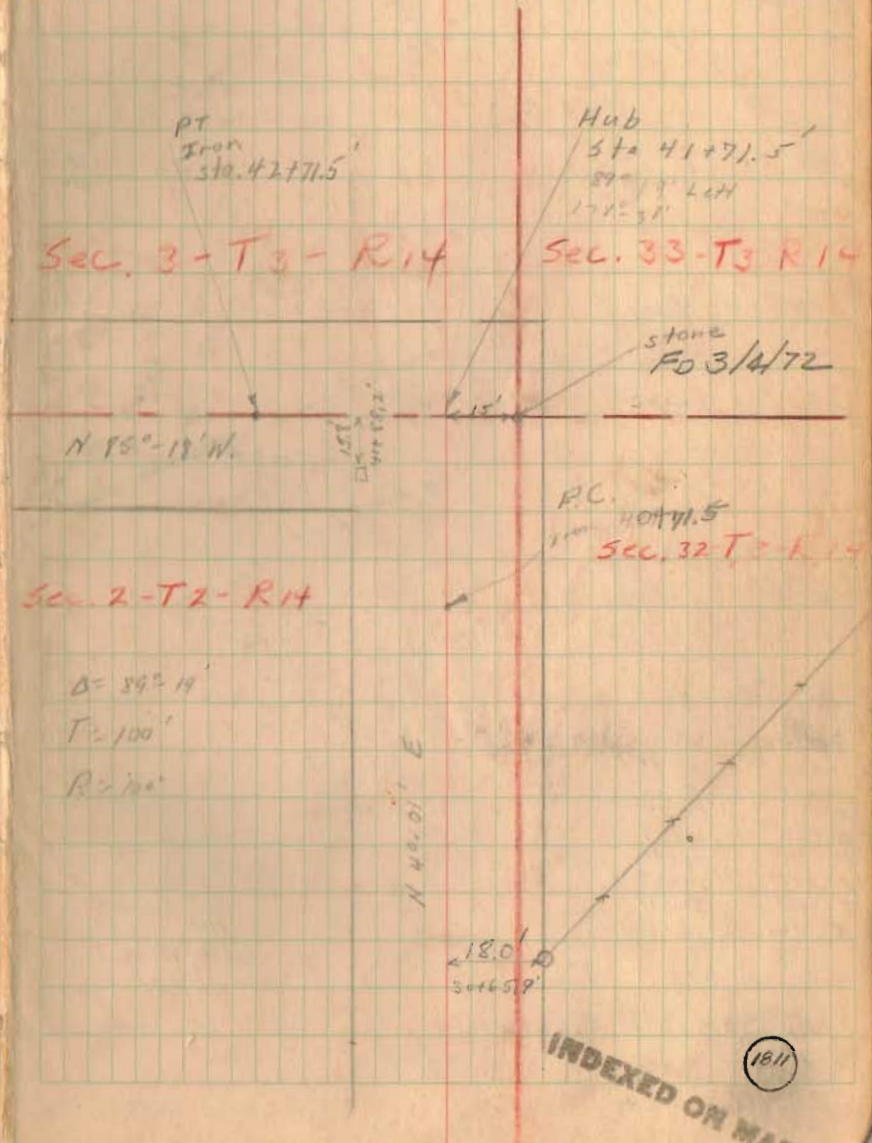

INDEXED ON MAP

1811

6-6-37
Core
Jones
Lee
Tennant
Phillips

INDEXED ON MAP
1811

Road 208 Pleasant.

(63+68.6 Mons.)

(60+58.4 Mons.)

55+00 (Mons.)

Road 210
See Book 601
Page 71

(51+06.9. Mons.)

Deflections

49+30.34	0°
49+50	3°-47'
49+75	8°-29'
50+00	13-14
50+25	17-59
50+50	22-44
50+75	27-29
51+00	32-14
51+69	33-30

Sta - 49+30.3 R.C.
Mon. South side only

H46
Set by Wright
See Bk. 601 P. 71

Deflections

P.C- 60+58.4		
61+00	—	1°-40'
61+50	—	3°-40
62+00	—	5°-40
62+50	—	7°-40
63+00	—	9°-40
63+50	—	11°-40
P.T. 63+68.6	—	12°-25'

Iron. P.I

N.6° E. 36.6

167.8'

P.T. Iron
Sta. 63+68.6

Δ = 24°-49'
D = 8°
T = 157.9
L = 310.2
R = 359.3
E = 17.15

157.9'

P.C. - 60+58.4'
Iron

20.0' Spruce

6.3'

N. 18° E. 134'

P.T. 51+06.9'

Δ = 67°-05'
D = 38°
T = 101.8
L = 176.5
R = 153.6
E = 30.7

67+05
134'-0"
22.5'

S. 67 W.
128.30
12" thorn.

N. 85-18 W.
385'

P.C. 49+30.3'

50.85
5.2 P.C.

Sta. 51+69

15" Cottonwood

Monument set on Section Line - where pieces of brick & old stake were found. 8"x8"x15" - Concrete marked +

P. T. - P.3. East of. Sta 78+53.9 - Set Monument South side only.

20' - East of Sta 78+53.9 Set Monument South Side only

Sta. 76+62.2 Monuments.

Sta. 70+00 Monuments.

6-7-37

Core
Phillips
Dobie
Lee
Tennant

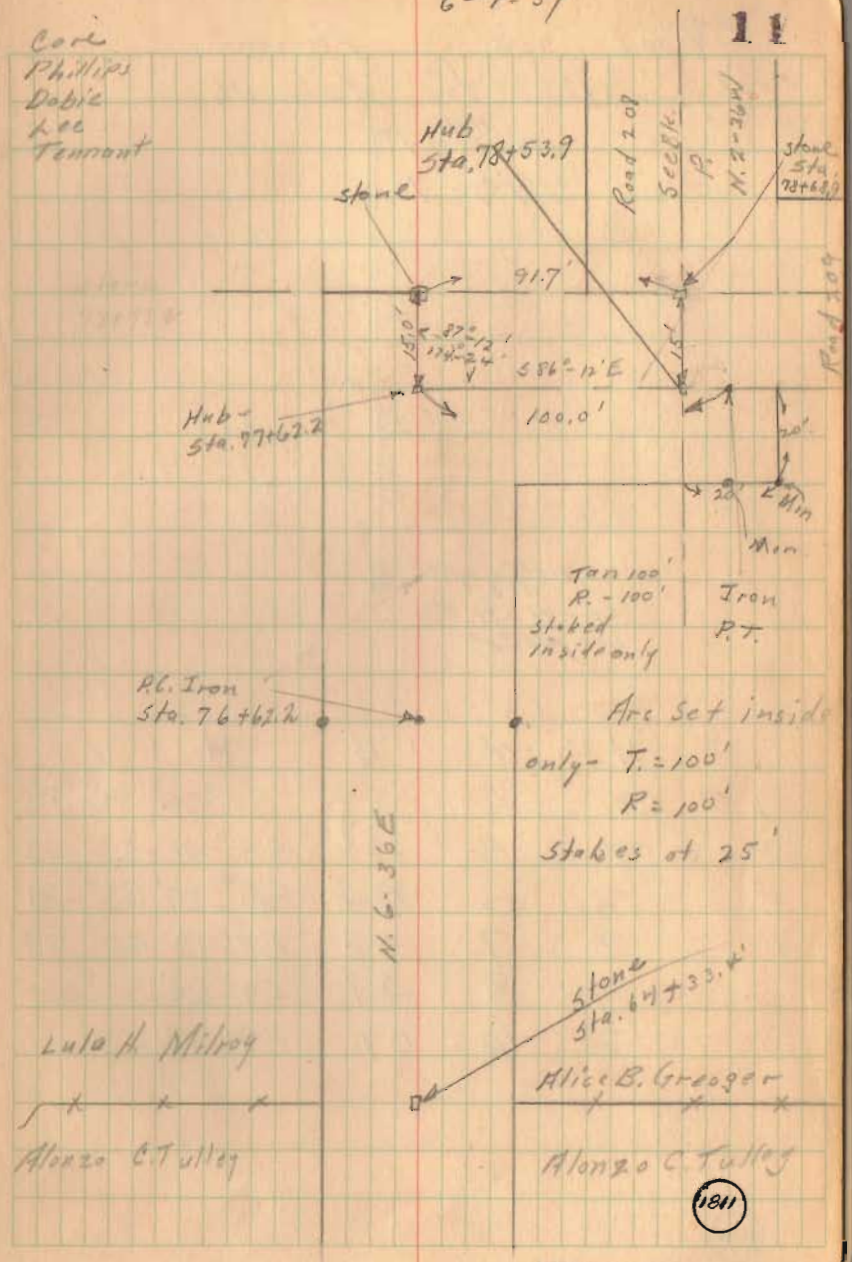

1811

INDEXED ON MAP

Temp 80° F.

Road 208 Pleasant

Observation for Azimuth

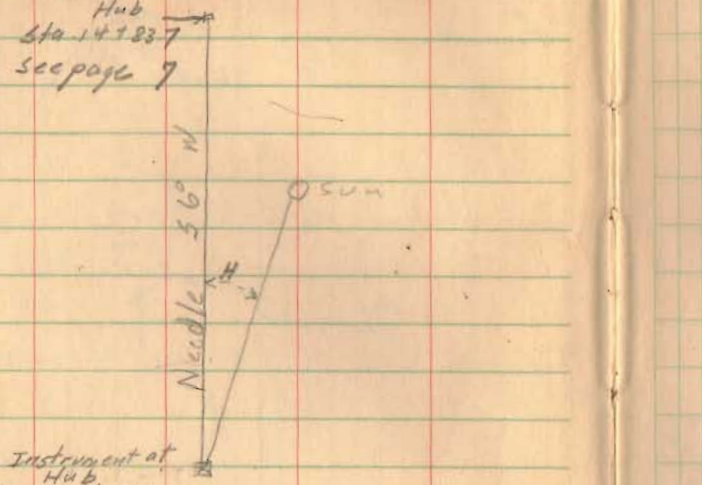

	H	M	S	H	V
1	3	4	38	68°-26'	53°-55'
2	3	5	41	68°-41'	53°-42'
3	3	6	44	68°-57'	53°-31'
4	3	7	52	69°-12'	53°-19'
5	3	8	49	69°-26'	53°-10'
6	3	10	07	69°-44'	52°-55'

June 8, 1938

E. Cork

G. Inckler

1811

INDEXED ON MAP

August 7, 1939
E. Core
M. Jones
J. Inskeep
G. Inskeep

13

Road # 25

Stakes for fence - F.M. Shoats Farm

V.M.S. 3320 - Rushcreek Twp.

Stakes Set 25' from & 50' Road.

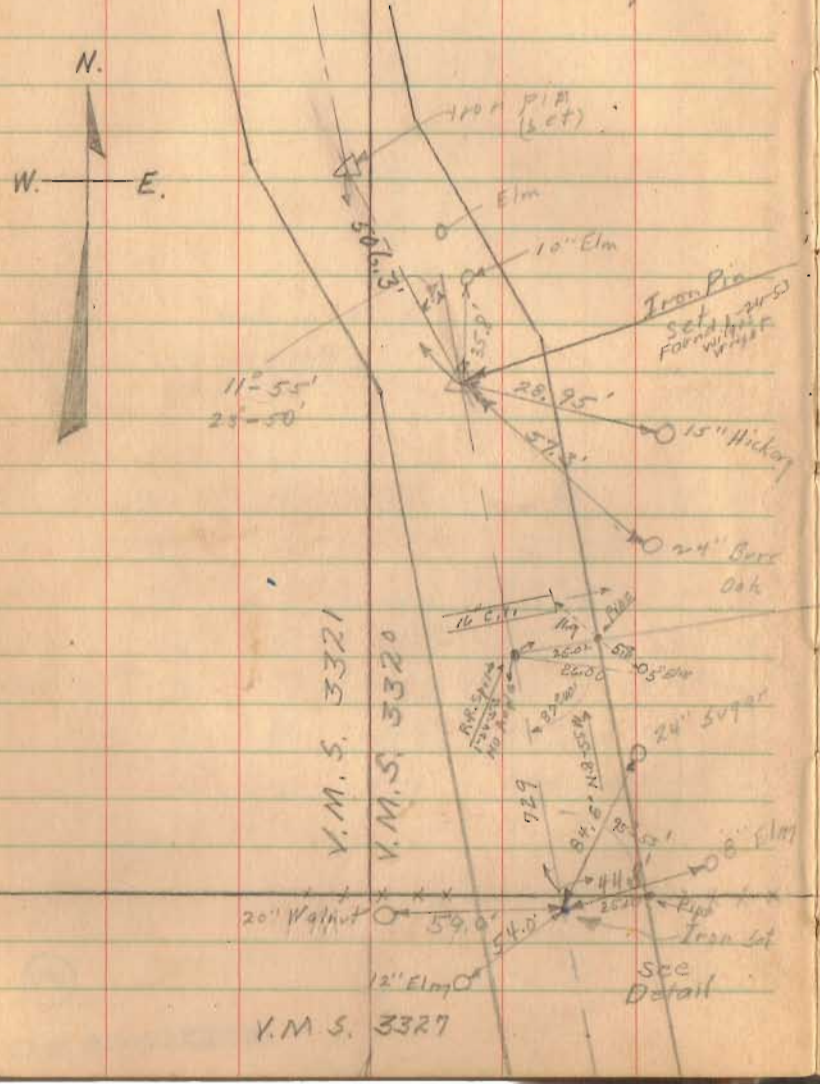

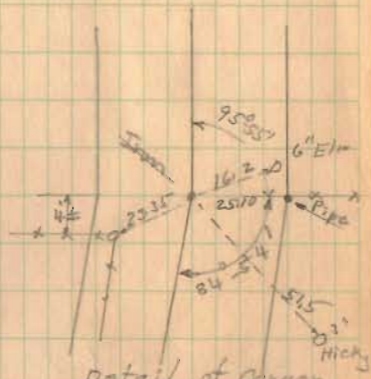

Detail of Corner as Used By Wright & Wilgus

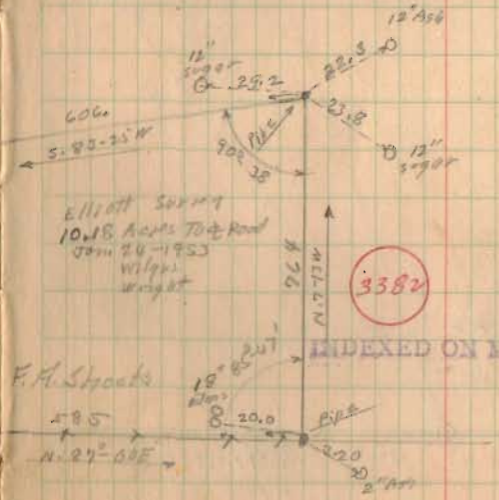

95 55
84 54
179° 109'
180° 49'
D = 49' Left

1812

L.C. Corwin

INDEXED ON MAP

R/W - Pd. 183

15+58.2 — ℄ of Route 33 - S.H. 235.

15+

15+00 - Monuments set

10+00 - Monuments set

3+41

3+00 - Monuments set

0+75 - Monuments set

Sept. 6, 1939

T - C. Keysor

Chain - M. Jones
G. Insteep

24

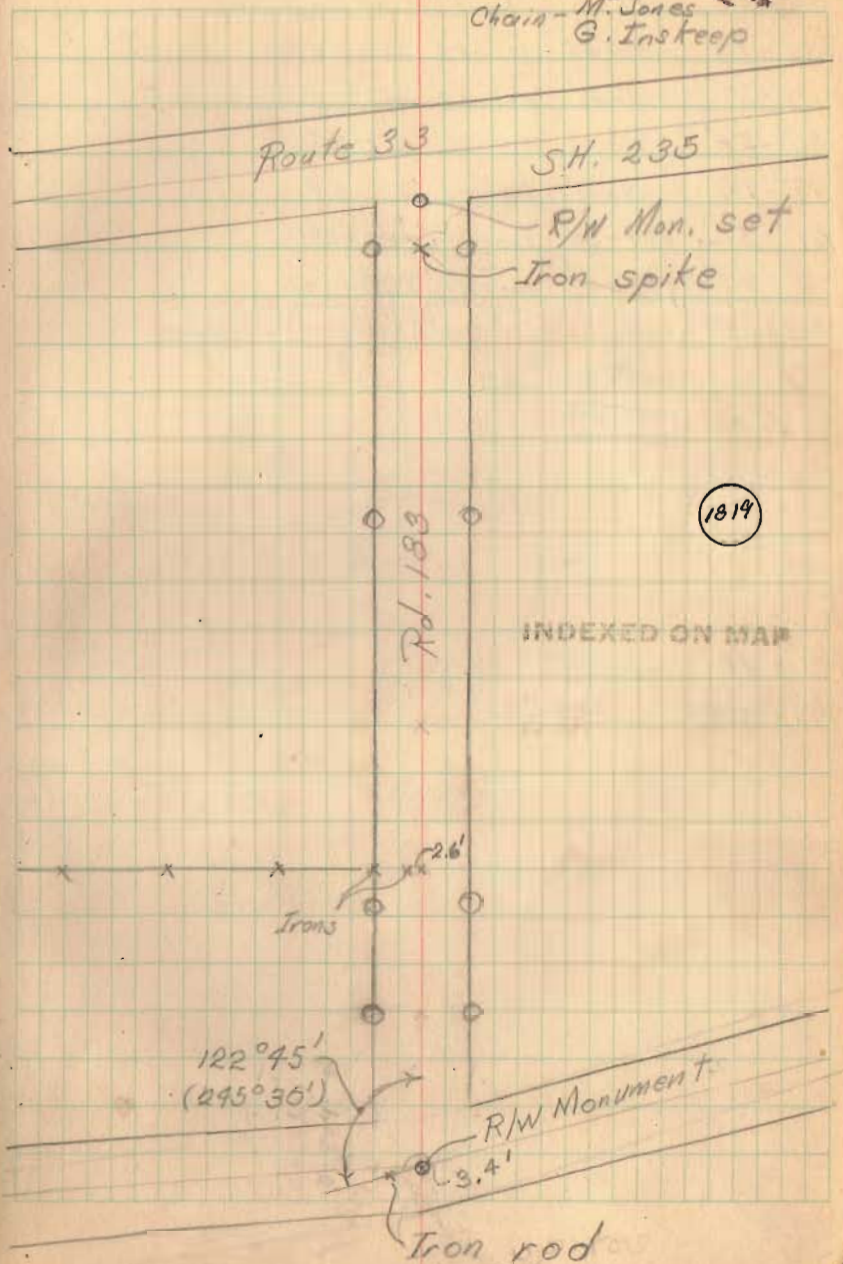

Road 155 - East Liberty - Perry Twp.
VMS 4689

(1820)

INDEXED ON MAP

May. 27, 1943
E. Cone
G. W

30

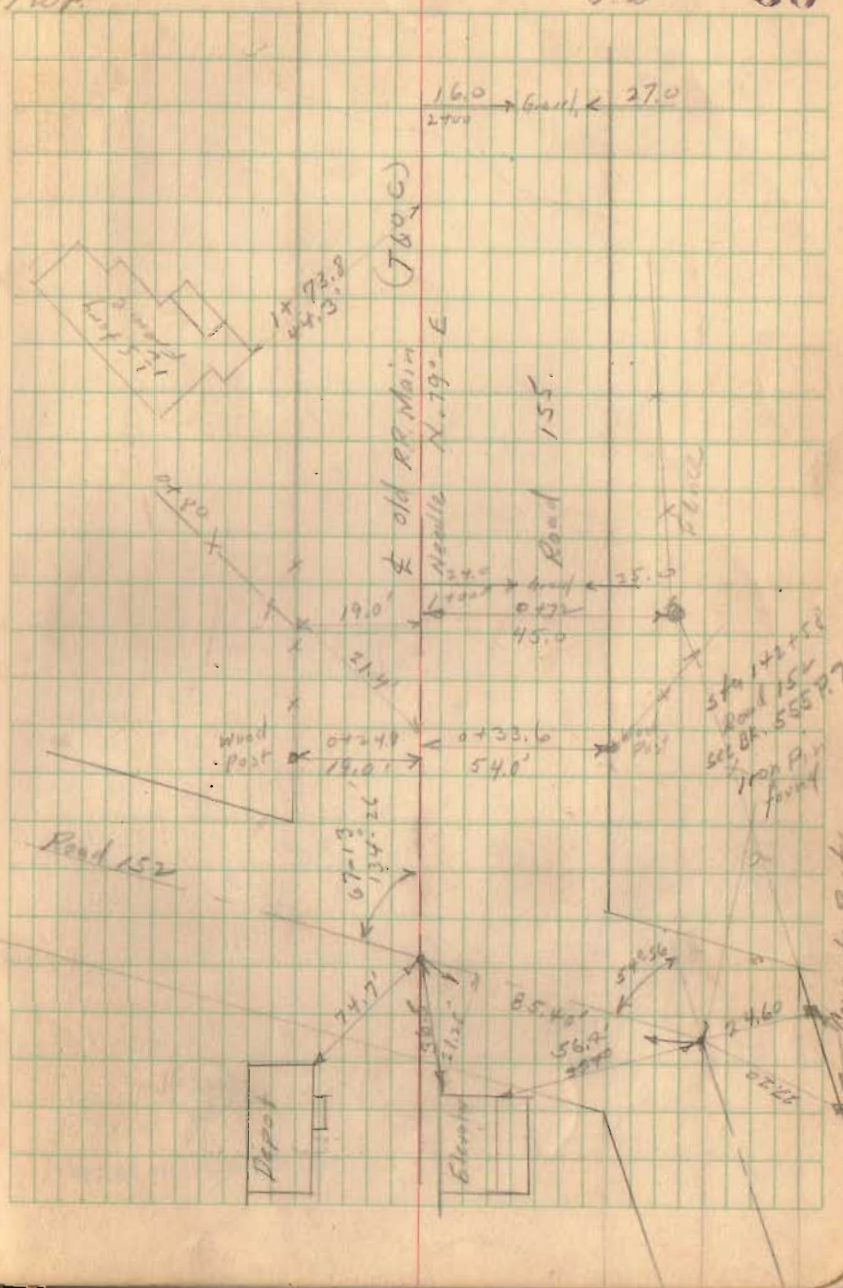

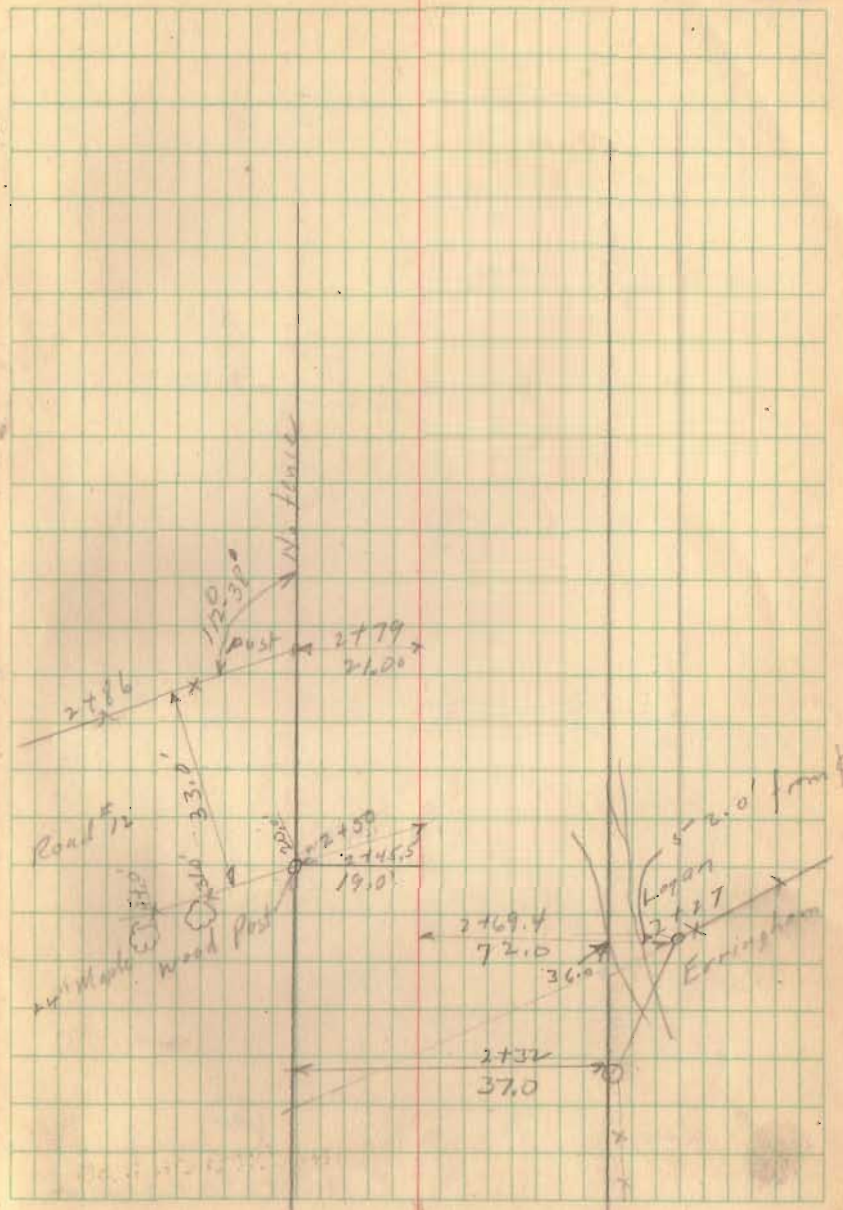

(1820)

INDEXED ON MAP

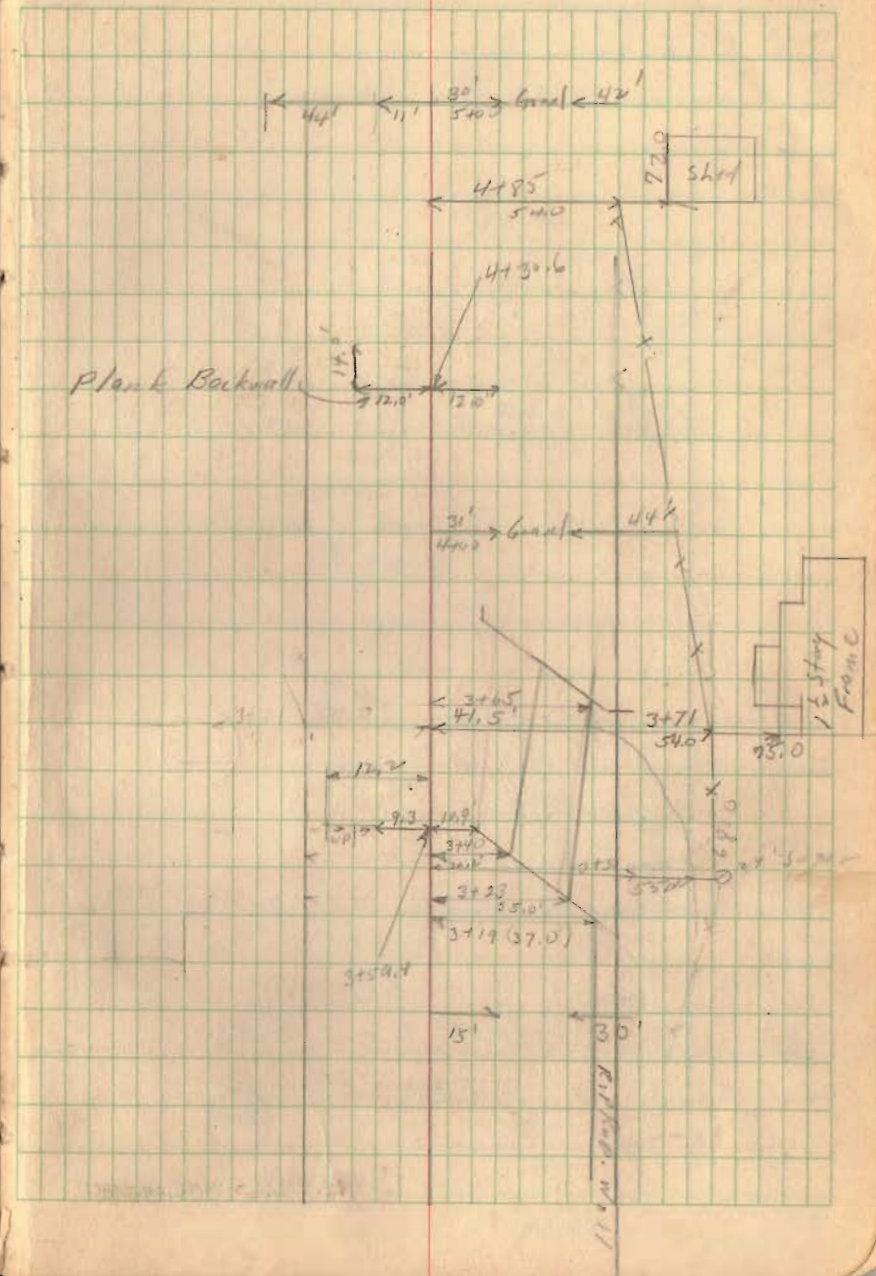

1020
INDEXED ON MAP

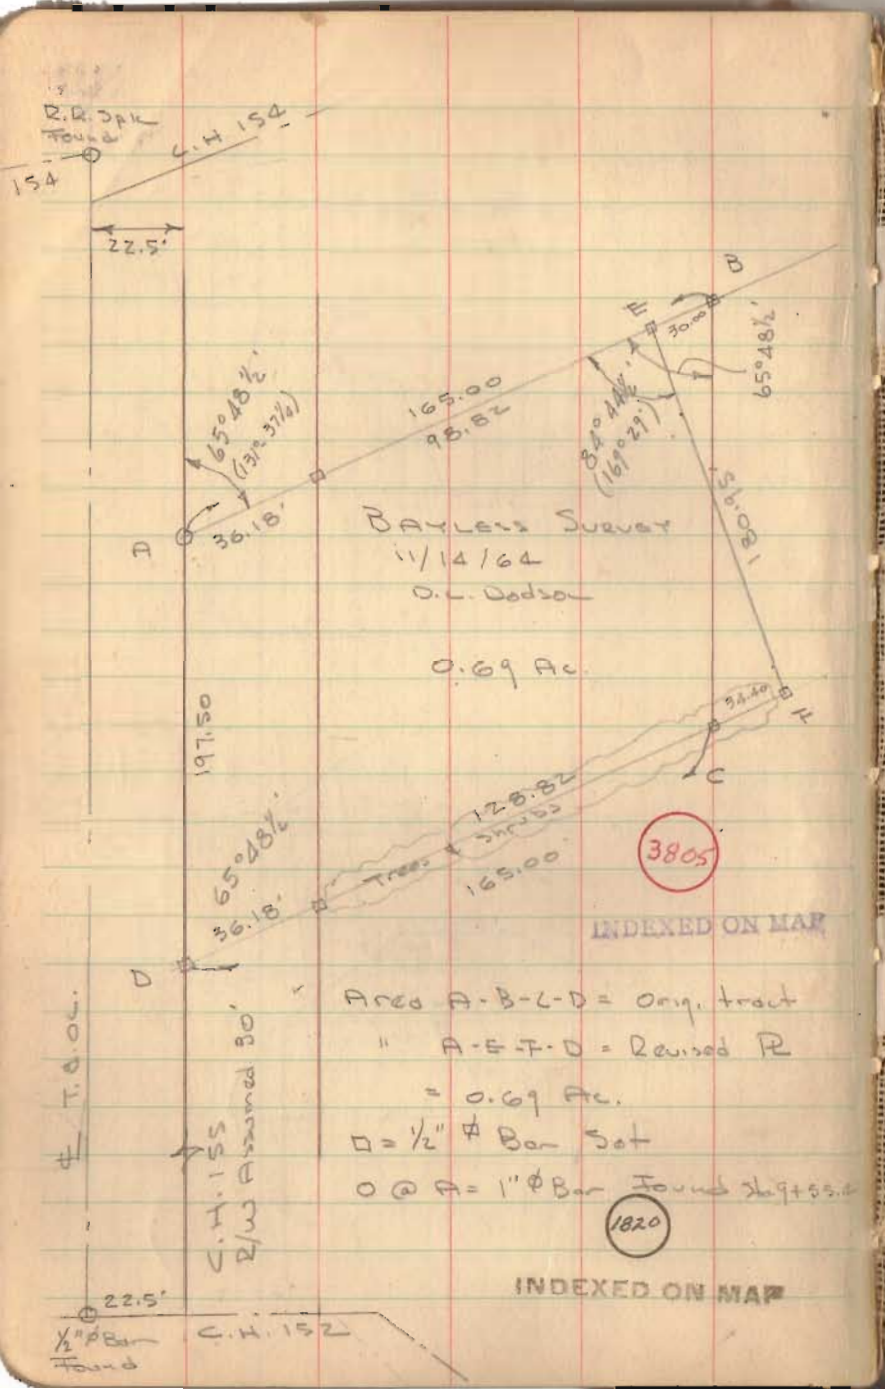
R.R. Spk Found
C.H. 154
154
22.5'
B
E
30.00
65°48½'
84°44½' (169°29')
65°48½' (131°37½)
165.00
98.82
A
36.18'
BAYLESS SURVEY
11/14/64
O.L. Dodson
0.69 Ac.
S 6.08 W
197.50
92.50
H
C
128.82
Trees & Shrubs
65°48½'
36.18'
165.00
3805
INDEXED ON MAP
D
Area A-B-C-D = Orig. tract
= A-E-F-D = Revised R/W
= 0.69 Ac.
□ = ½" ⌀ Bar Set
○ @ A = 1" ⌀ Bar Found
1820
INDEXED ON MAP
P.O.C.
V.I. 155
R/W Assumed 80'
22.5'
½" ⌀ Bar Found
C.H. 152

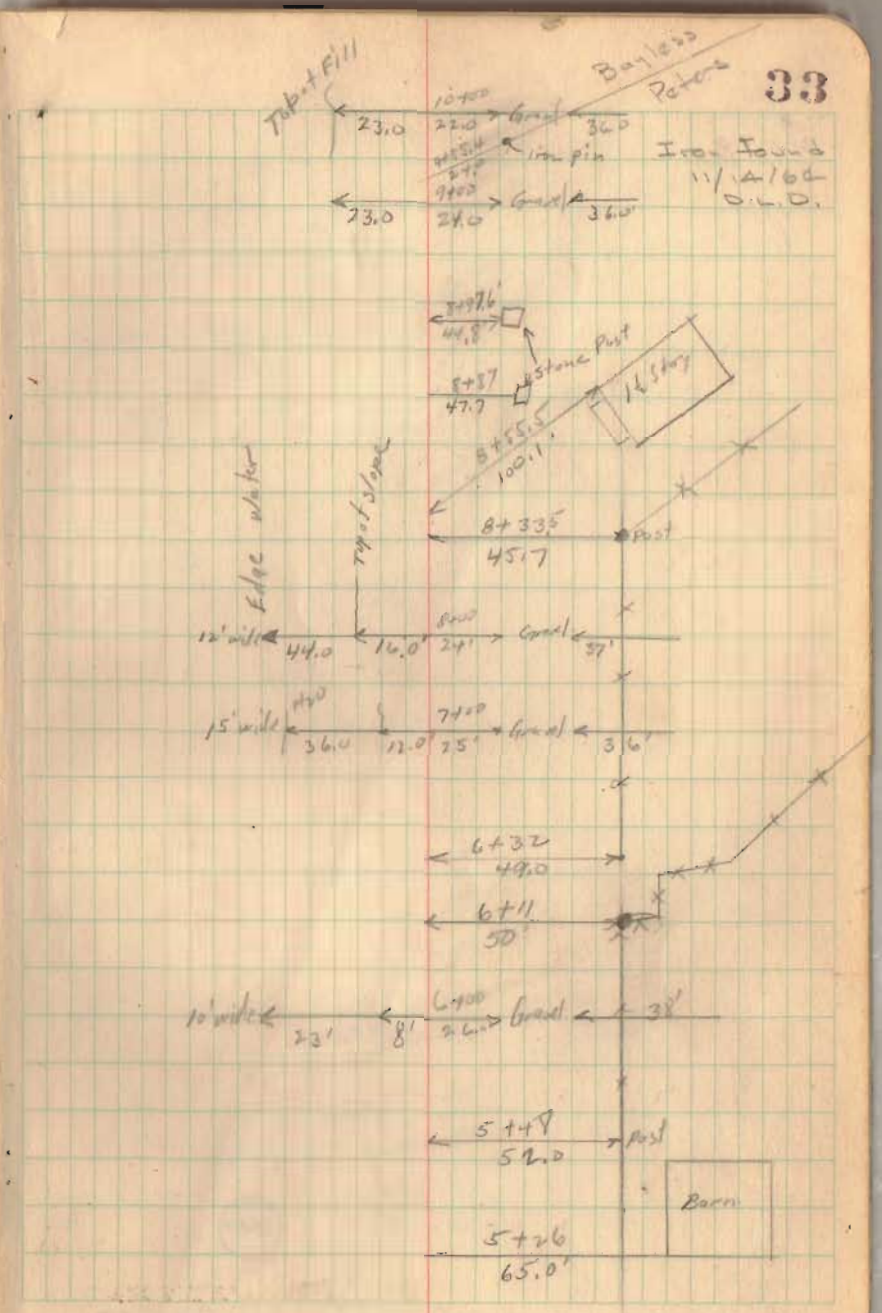
Tub + Fill
10+00
22.0
Gravel
36.0
Bayless Peters
Iron pin
Iron Found 11/14/64 O.L.O.
23.0
24.0
Gravel
36.0
8+97.6'
44.8
Stone Post
5+37
47.7
14 Stone
5+55.5
100.1'
8+33.5
45.7
Post
Edge water
Top of slope
12' wide
44.0
16.0
Road 24'
Gravel
37'
15' wide
36.0
12.0
Road 25'
Gravel
36'
6+32
49.0
6+11
50'
10' wide
23'
8'
Gravel 24'
Gravel
38'
5+49
52.0
Post
Barn
5+26
65.0'

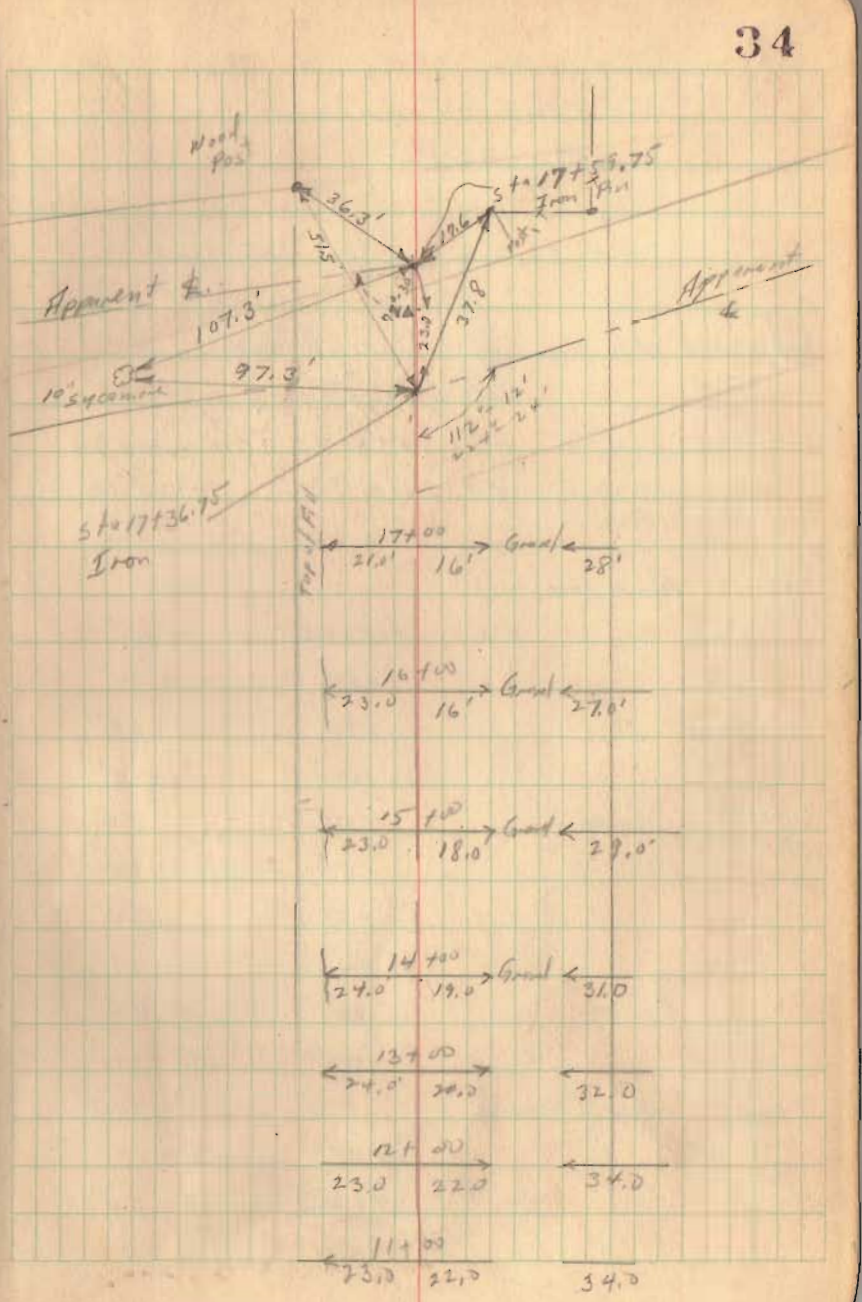

1820

INDEXED ON MAP

Road No. 158

Zane Township

VMS 3680

Stakes set 30' from ℄

R.R. Spikes set ℄ for Mons.

P.T.
14+24.3 Mon. (Hubs Set)

Curve Data.

P.C. = 11+34.3 — Δ = 5°-48'
D = 2°
PI = 12+79.4 — R = 2864.94'
P.T. = 14+24.3 — T = 145.13'
E = 3.67'
L = 290.0'

P.C.
11+34.3 Mon. (Hubs Set)

	P.C.	11+34.3	0°-0'
		11+50	0°-09'
		+75	0°-24'
		12+00	0°-39'
6+00	Mon.	+25	0°-54'
		+50	1°-09'
		+75	1°-24'
		13+00	1°-39'
		+25	1°-54'
		+50	2°-09'
1+00	Mon. (Hubs Set	+75	2°-24'
		14+00	2°-39'
		14+24.3	2°-54'

Clear - Cool

July 2, 1940
E. E. Core
G. W. Wilgus
M. E. Jones
G. G. Instker

35

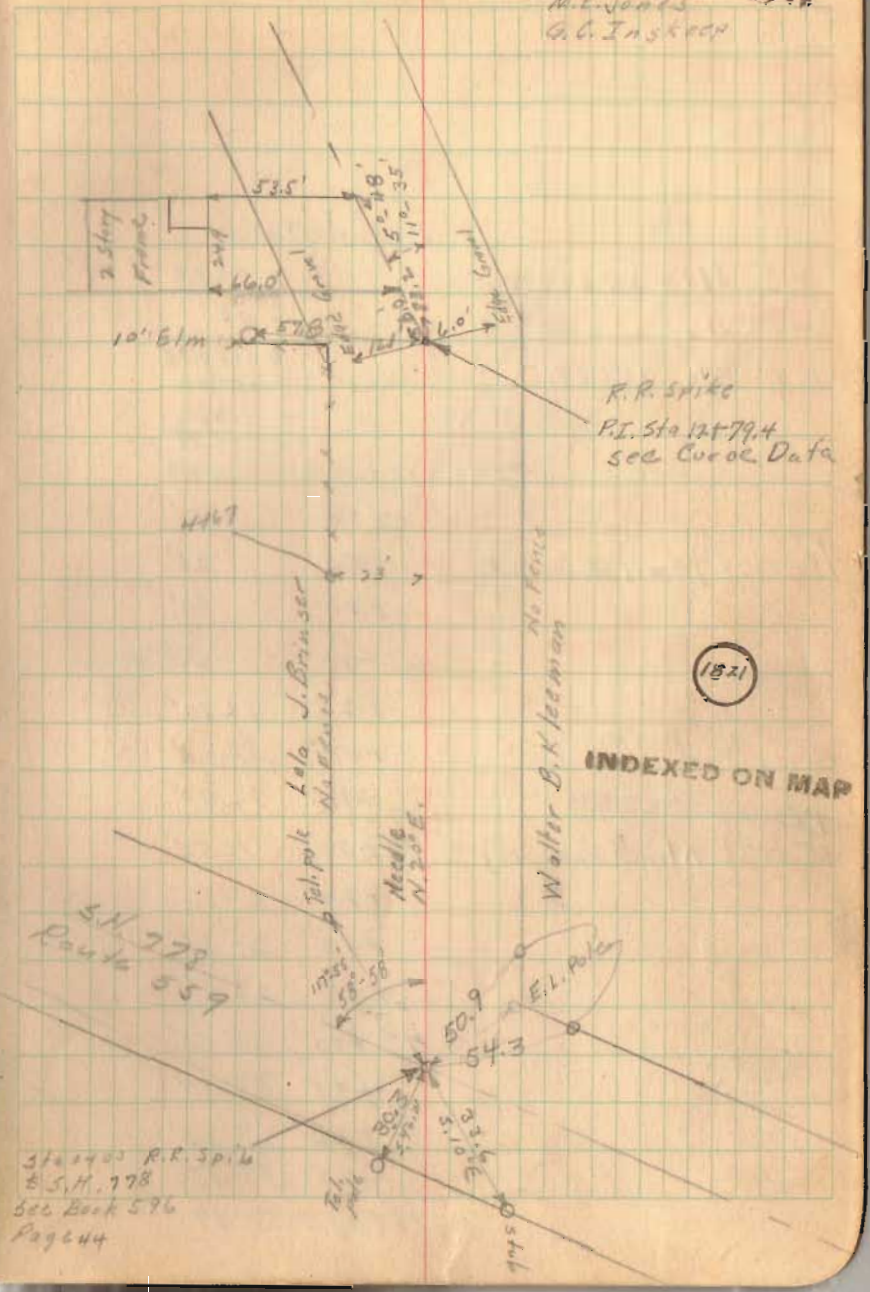

1821

INDEXED ON MAP

Road No. 158

Curve Data

P.C. Sta - 15+07.8 — Δ 7°30'
P.I. Sta 16+98.9 — D 2°
P.T. Sta 18+89.5 — R 2864.93
T 191.09
E 6.36
L 381.69

P.C.	15+07.8	0°0'
	+25	1°
PT 18+89.5 Mon. Hubs Set.	+50	25'
	+75	40'
	16+00	55'
	+25	1°10'
	+50	1°25'
	+75	1°40'
P.C. 15+07.8 Mon (Hubs Set)	17+00	1°55'
	+25	2°10'
	+50	2°25'
	+75	2°40'
	18+00	2°55'
	+25	3°10'
	+50	3°25'
	+75	3°40'
	18+89.5	3°49'

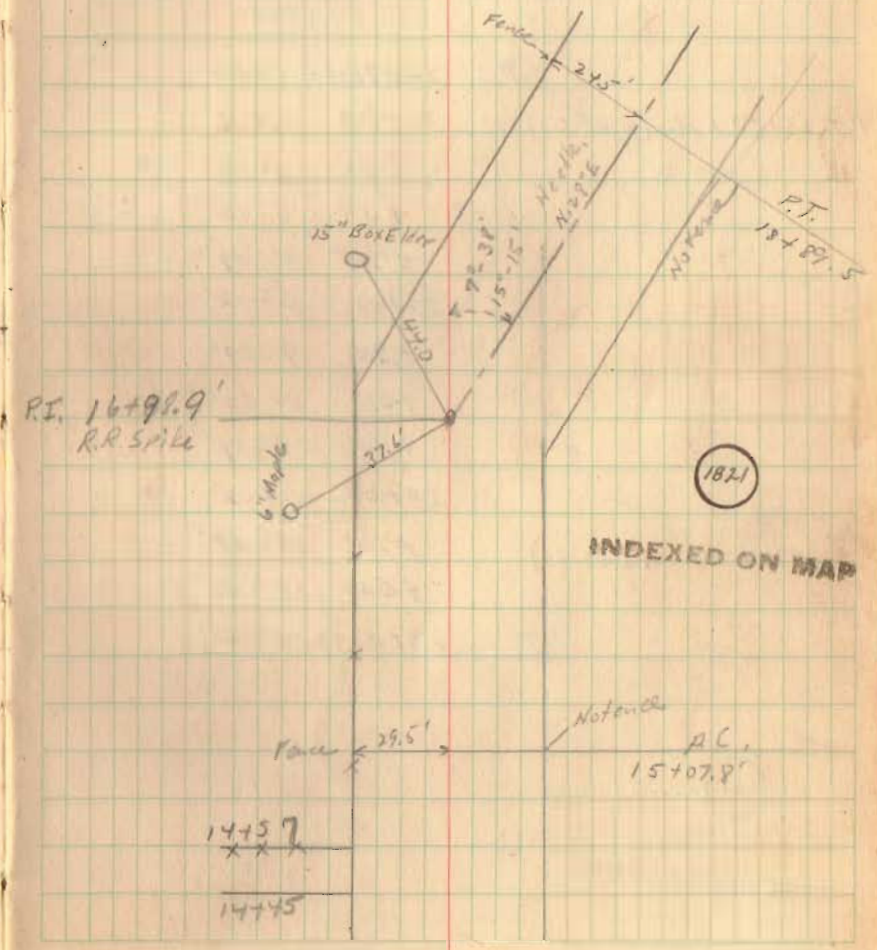

Road No. 158

Curve Data

P.C. Sta 20+76.09
P.I. Sta 22+20.
P.T. Sta 23+57.09

Δ 28° 06'
D 10°
R 573.69
T 144.11
E 17.76
L 281.0

P.C.	20+76.09	0°0'
P.T. 2375.1 Mon (Hubs Set)	21+00	1° 12'
	+25	2° 27'
	+50	3° 42'
	+75	4° 57'
	22+00	6° 12'
	+25	7° 27'
	+50	8° 42'
	+75	9° 57'
	23+00	11° 12'
P.C. 20+76.1 - Mon - (Hubs Set)	+25	12° 27'
	+50	13° 41'
P.T.	23+57.09	14° 08'

7-3-40
Cook
Wilgus
Jones
Inskeep.

37

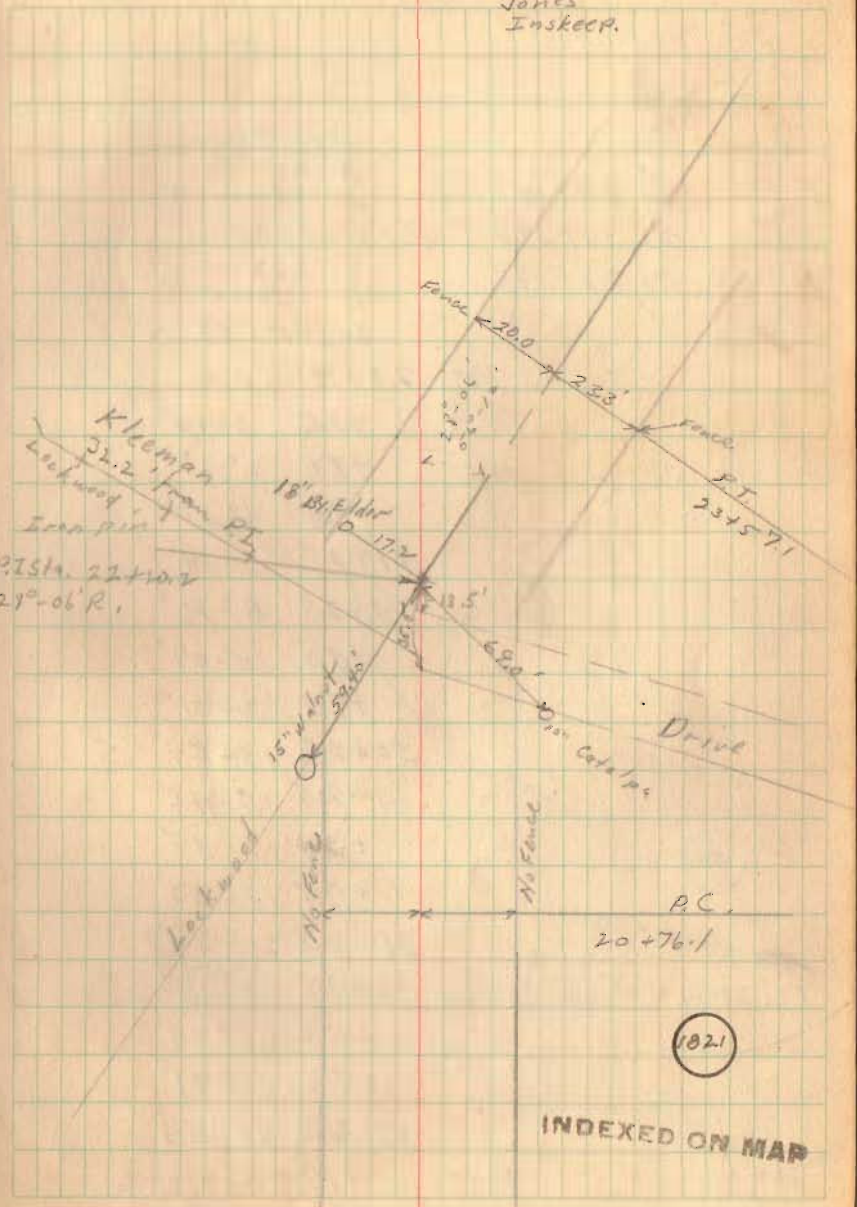

1021

INDEXED ON MAP

Road No. 158

Curve Data

P.C. sta 28+14.7
P.I. sta 30+37.6
P.T. sta 32+17.4

Δ 60° 24'
D 15° 0'
R 383.07
T 222.94
E 60.15
L 402.67

PC	28+14.7	0.0'
	+25	0°-46'
P.T. 32+17.4 (Mon.) (Hubs Set)	+50	2°-39'
	+75	4°-31'
	29+00	6°-24'
	+25	8°-16'
	+50	10°-09'
	+75	12°-01'
	30+00	13°-54'
	+25	15°-46'
	+50	17°-39'
	+75	19°-31'
	31+00	21°-24'
P.C. 28+14.7 Mon. (Hubs Set)	+25	23°-16'
	+50	25°-09'
	+75	27°-01'
	32+00	28°-54'
P.T.	+17.4	30°-12'

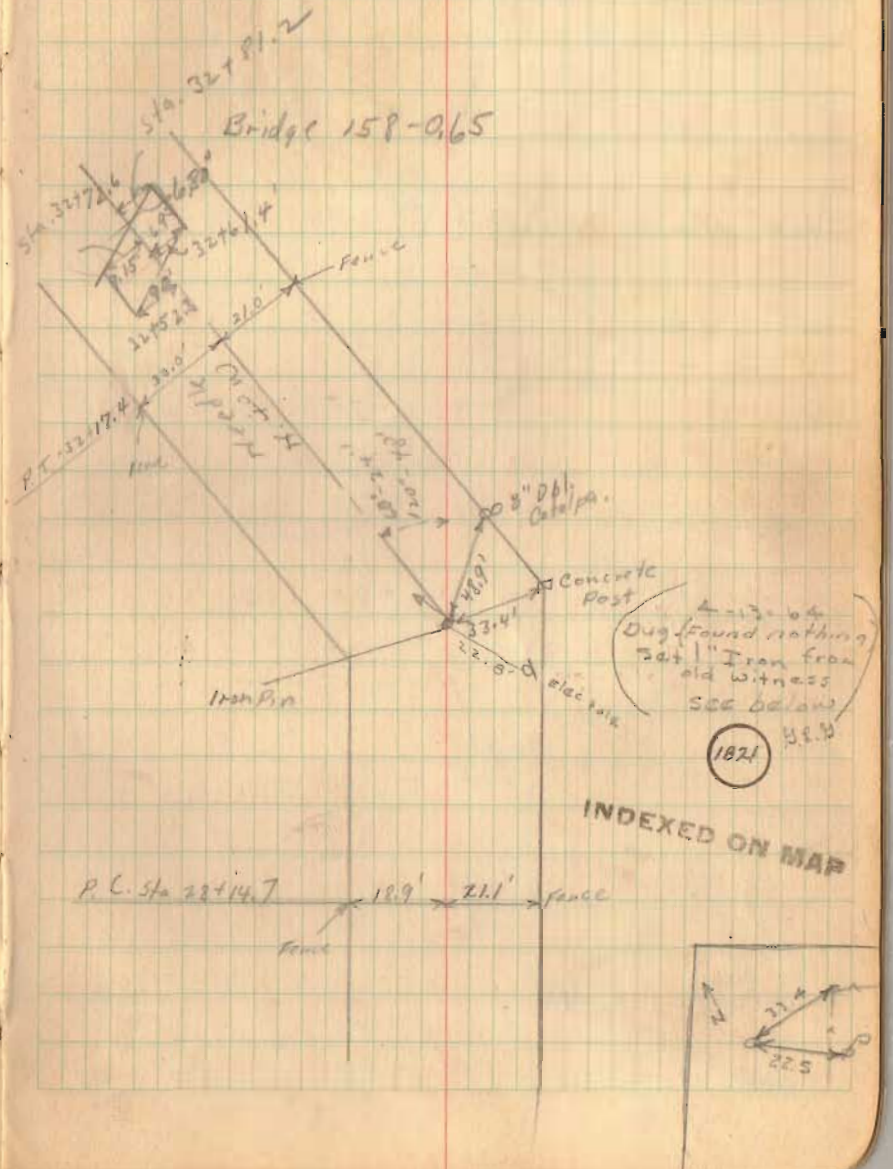

Road No. 168

39+00 Mon. (Hubs Set)

38+00 Mon. (Hubs Set)

7-3-40

39

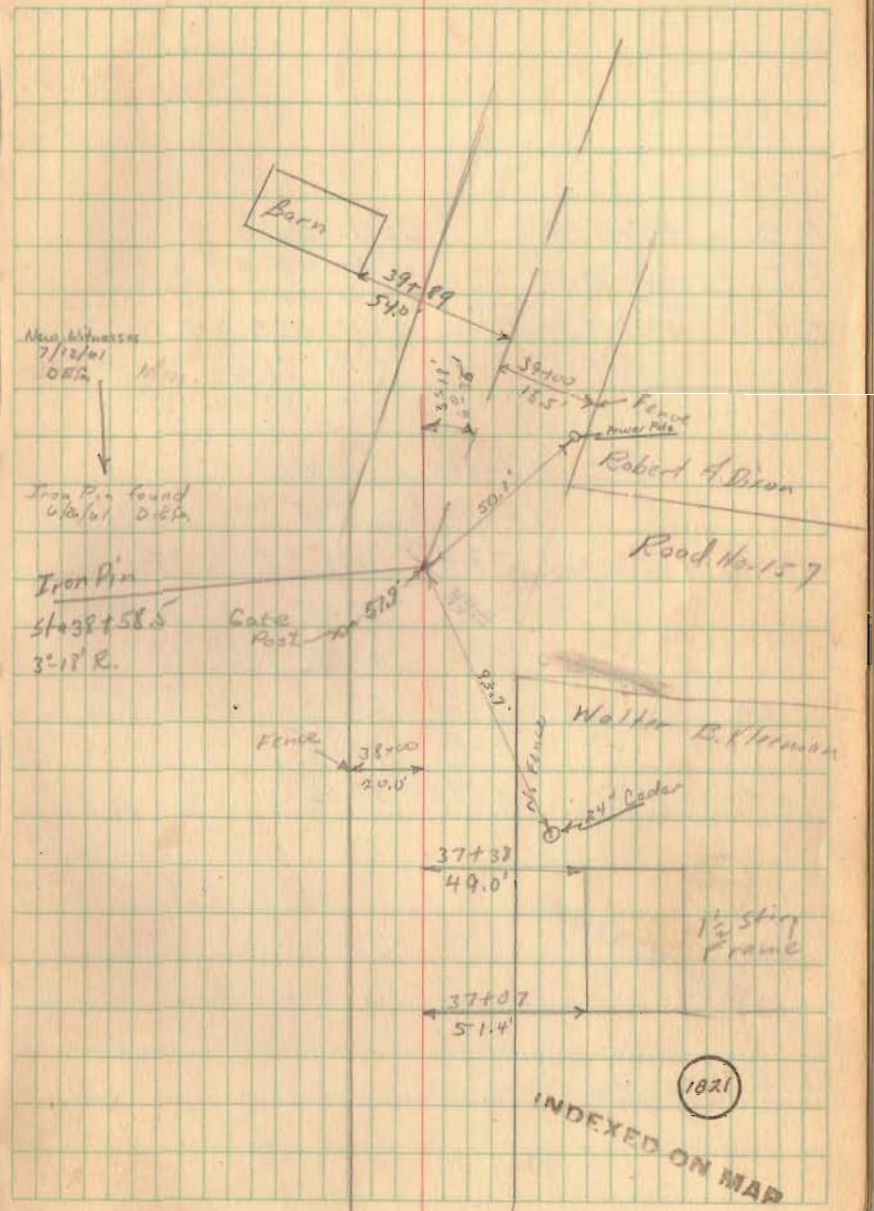

Road No. 158

P.C.	45+98.5	Curve Data
P.I.	46+94.55	Δ 18°-09'
P.T.	47+49.05	D 12°
		R. 478.34
		T 96.06
		L 190.56

P.C.	45+98.5	0°-0
	46+00	0°-05'
P.T. 47+49.1 - Mon (Hubs Set)	+20	1°-35'
	+50	3°-05'
	+75	4°-35'
	47+00	6°-05'
	+25	7°-35'
P.T.	+49.05	9°-02'

P.C. 45+98.5 Mon. (Hubs Set)

94.75
To 30
9°-55

7/5/40

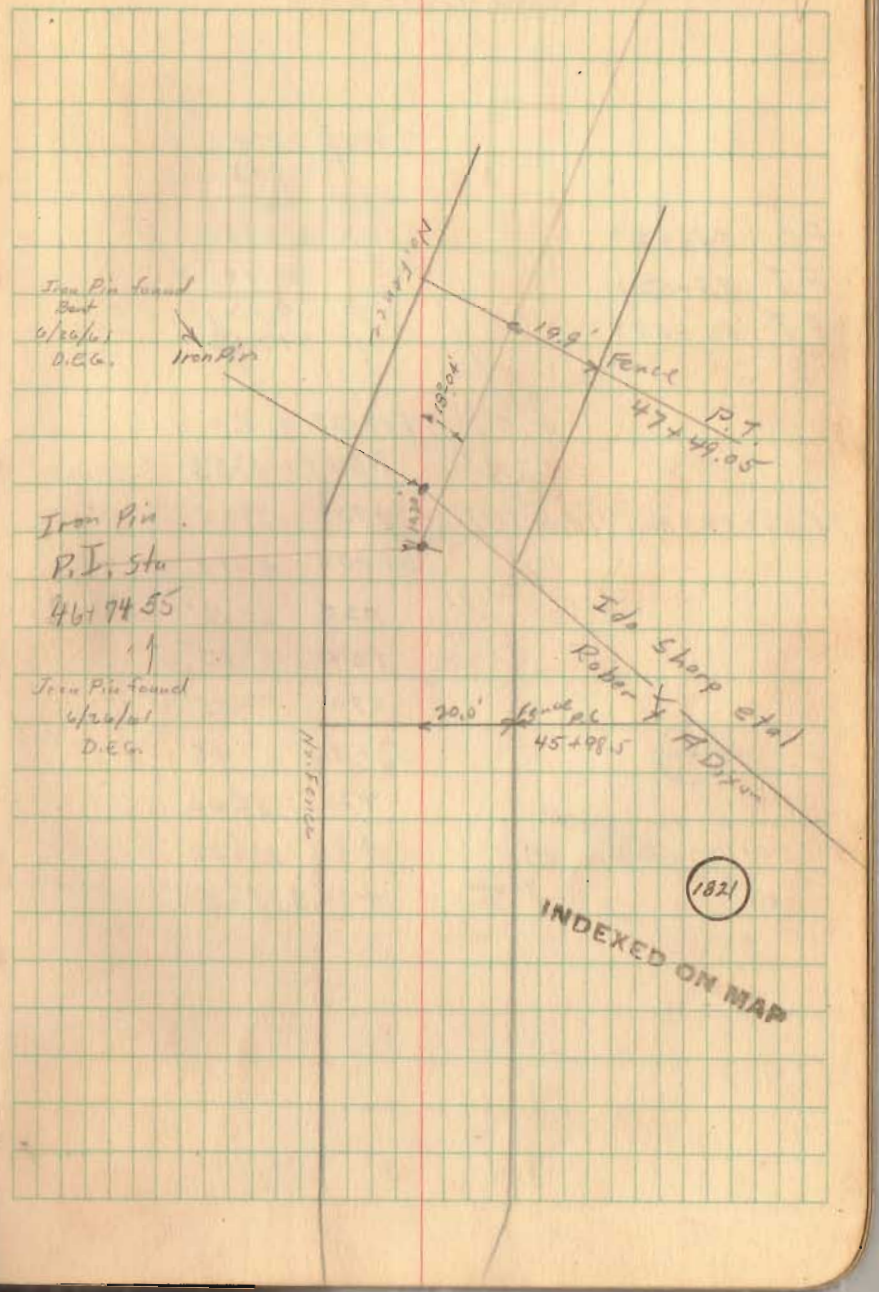

1821
INDEXED ON MAP

Road No. 158

Curve Data

Δ 31°53'
D 15°
R 383.07
T 109.44
E 15.32
L 212.56

P.C. 54+42.7
PI 55+521
PT 56+553

P.C.	54+42.7	0°0'
	+50	0°33'
PT-56+55.3 Mon.-(Hubs Set)	+75	2°25
	55+00	4°18'
	+25	6°10'
	+50	8°03'
	+75	9°55'
	56+00	11°48'
	+25	13°40'
PC. 54+42.7 Mon.(Hubs Set)	+50	15°33'
P.T.	+55.3	15°56'

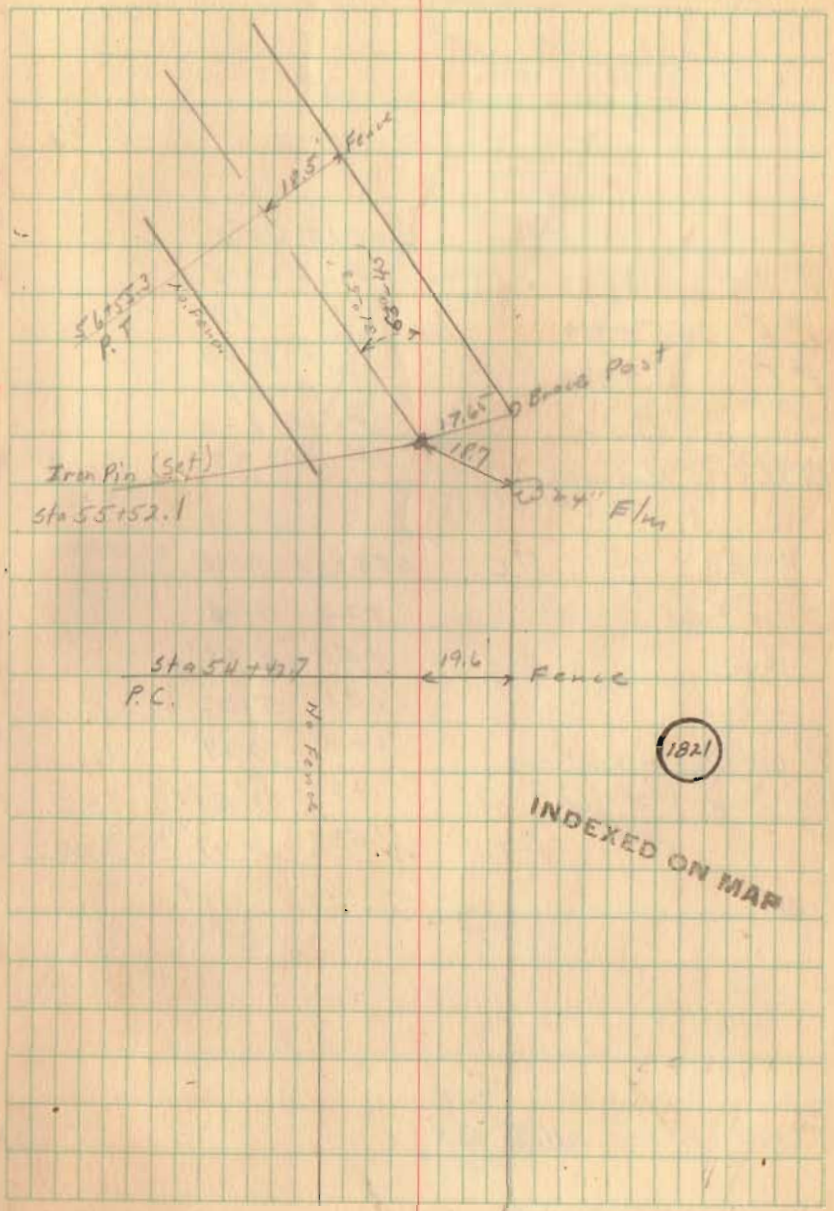

1821

INDEXED ON MAP

Road No. 158

69+79.1
66+37.0
342.1

Curve Data

P.C. 65+23.7
P I 65+81.4
P T 66+37.0
Δ. 22°10'
D. 19°30'
R. 293.26
T. 57.67
E. 5.62
L. 113.33

P.T 66+37.0 Monument - Left side only (Hub set)

P.C.	65+23.7	0°0'
	+25	0°08'
	+50	2°35'
	+75	5°02'
P.C. 65+23.7. Mon - Right only (Hub set)	66+00	7°29'
	+25	9°56'
P.T.	66+37.0	11°07'

63+00 (Mon) Hubs Set

7/5/40

69+79.1
66+37.0
342.1
37.67
379.77

SEE PG. 80 FOR RELOCATION

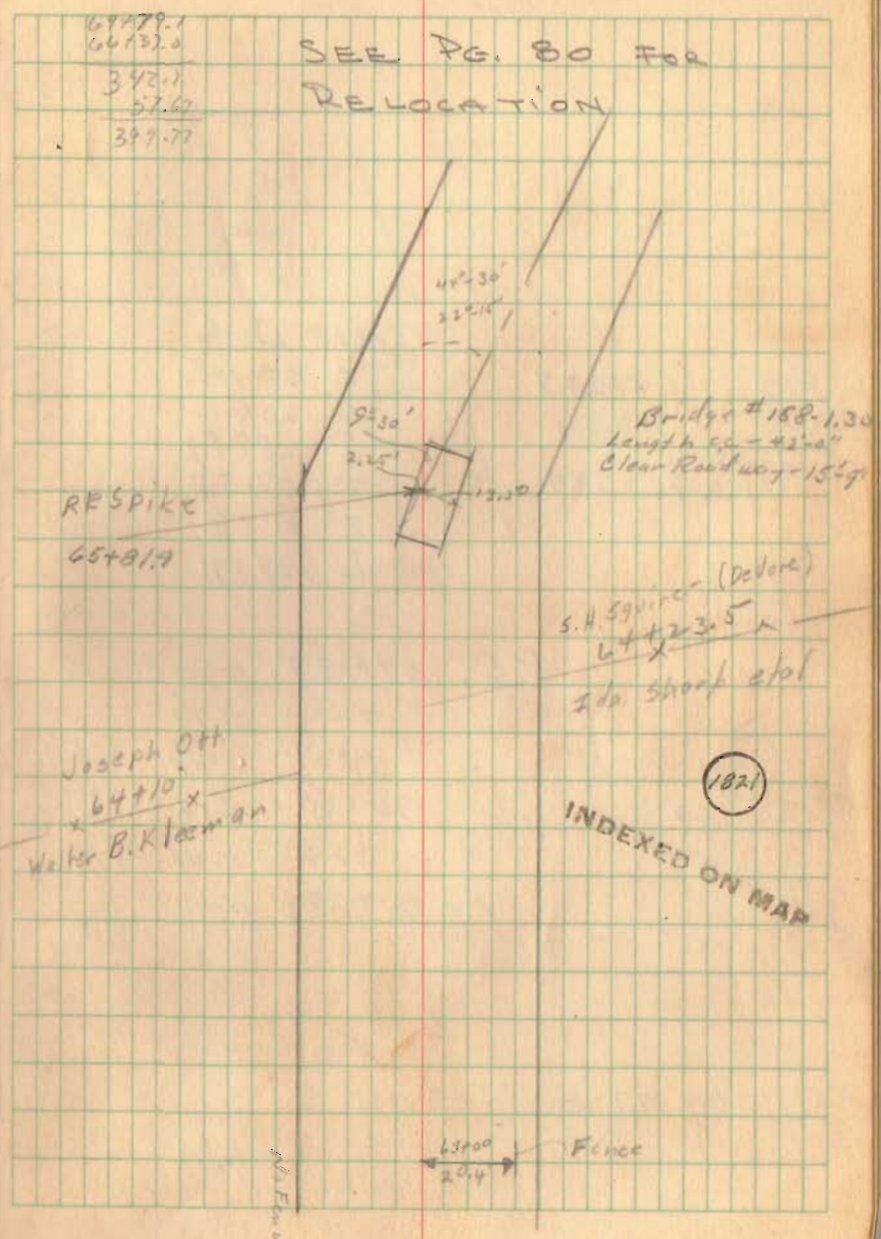

7/6/40

Road No. 158

Curve Data

P.C.	69+27.7	Δ	20°-14'
P.I.	69+79.1	D	20°
P.T.	70+28.9	R	287.94
		T	51.37
		E	4.54
		L	101.17

P.C.	69+27.7	.0	0'
	+50.	2°	-14'
	+75	4°	-44
P.T. 70+28.9 Mon (Hubs Set)	70+00	7°	-14'
	+25	9°	-44'
	P.T. 70+28.9	10°	-07

P.C. Sta. 69+27.7 - Mon. (Hubs Set)

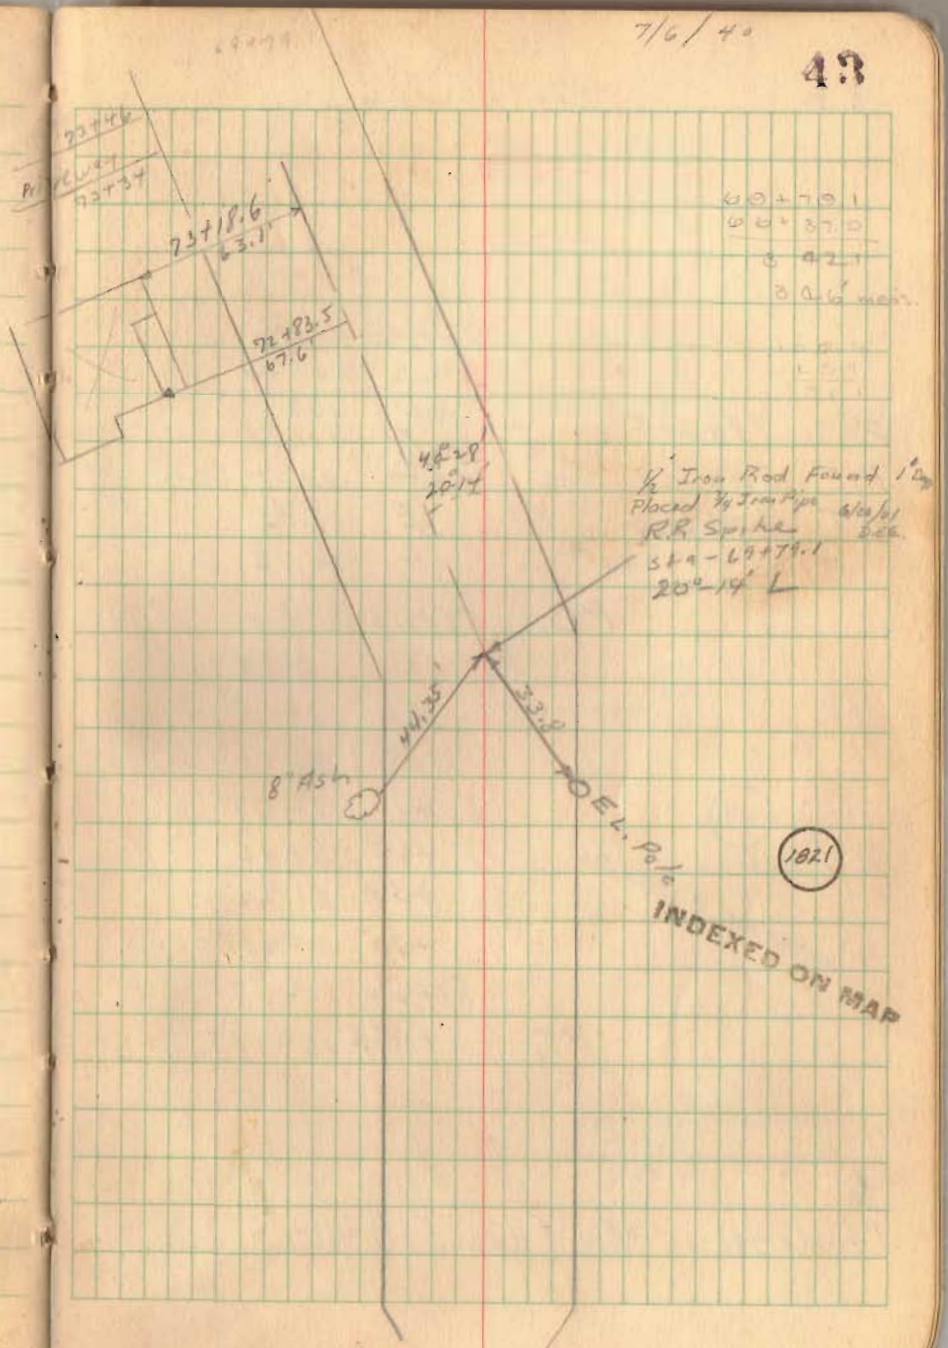

Road No. 15E

100.C
b.m
103.a

Curve Data

Δ	24° 04'
D	13°.
R	441.68
T	94.17
E	9.92
L	186.13

P.C. 79+215
P.I. 80+159
P.T. 81+06.6

PC	79+21.5	0°,0'.
	+25	0°14'
	+50	1°51'
	+75	3°30'
	80+00	5°07'
P.T. - 81+06.6 Mon. (Hubs Set)	+25	6°45'
	+50	8°22'
	+75	10°00'
	81+00	11°37'
P.T.	+06.6	12°04'

P.C. Sta. 79+21.5 - Mon. (Hubs Set)

7/6/00

41

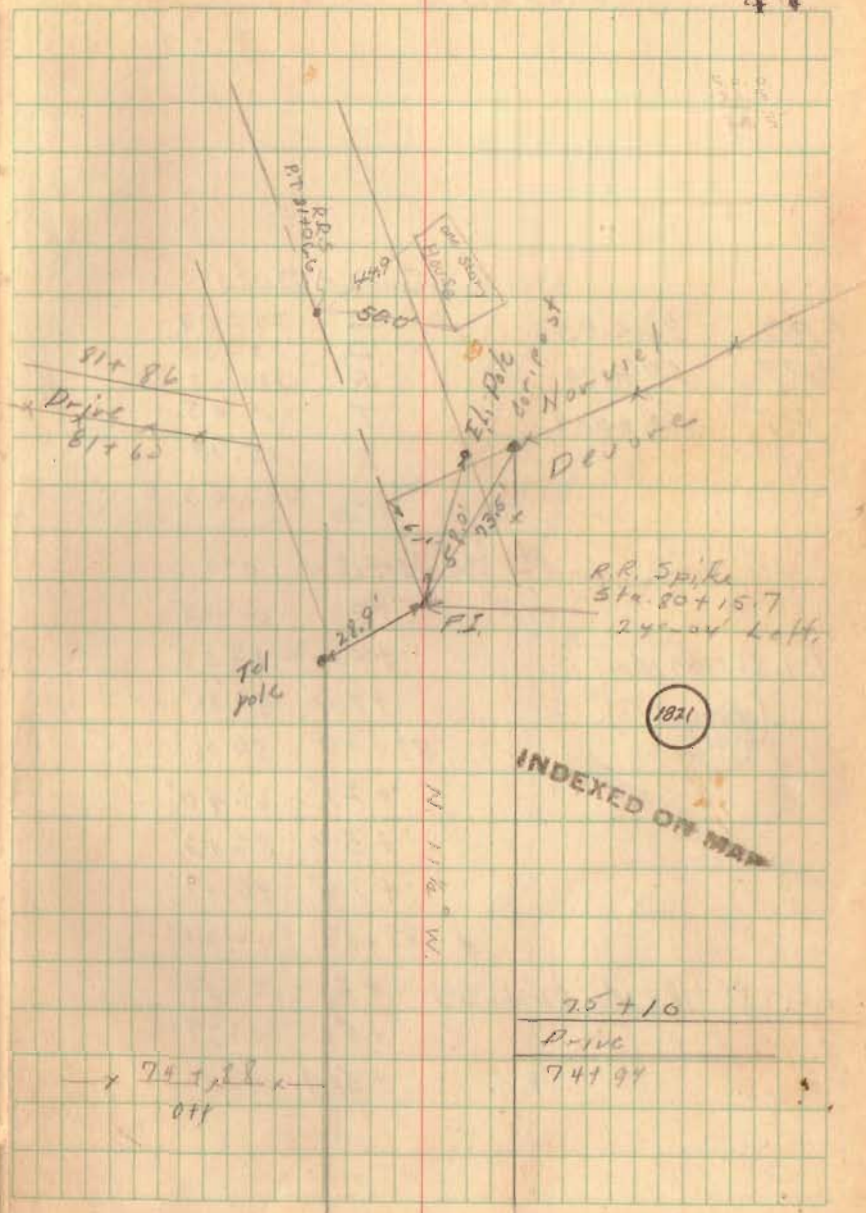

Road No. 158

50.0
18.4
31.6

Curve Data

P.C.	86+18.4	Δ	29°04'
P.I.	87+37.4	D.	12°30'
P.T.	88+50.9	R	459.2.8
		T	119.05
		E	15.18
		L	232.53

P.C.	86+18.4		0°0
	+20		0°25'
P.T. 88+50.9 Mon. (Hubs Set)	+50		1°59'
	+70		3°32'
	87+00		5°06'
	+25		6°40'
	+50		8°13'
	+75		9°47'
	88+00		11°21'
P.C. - 86+18.4 Mon (Hubs Set)	+20		12°55'
	+50.9		14°29'
P.T.	+50.9		14°32'

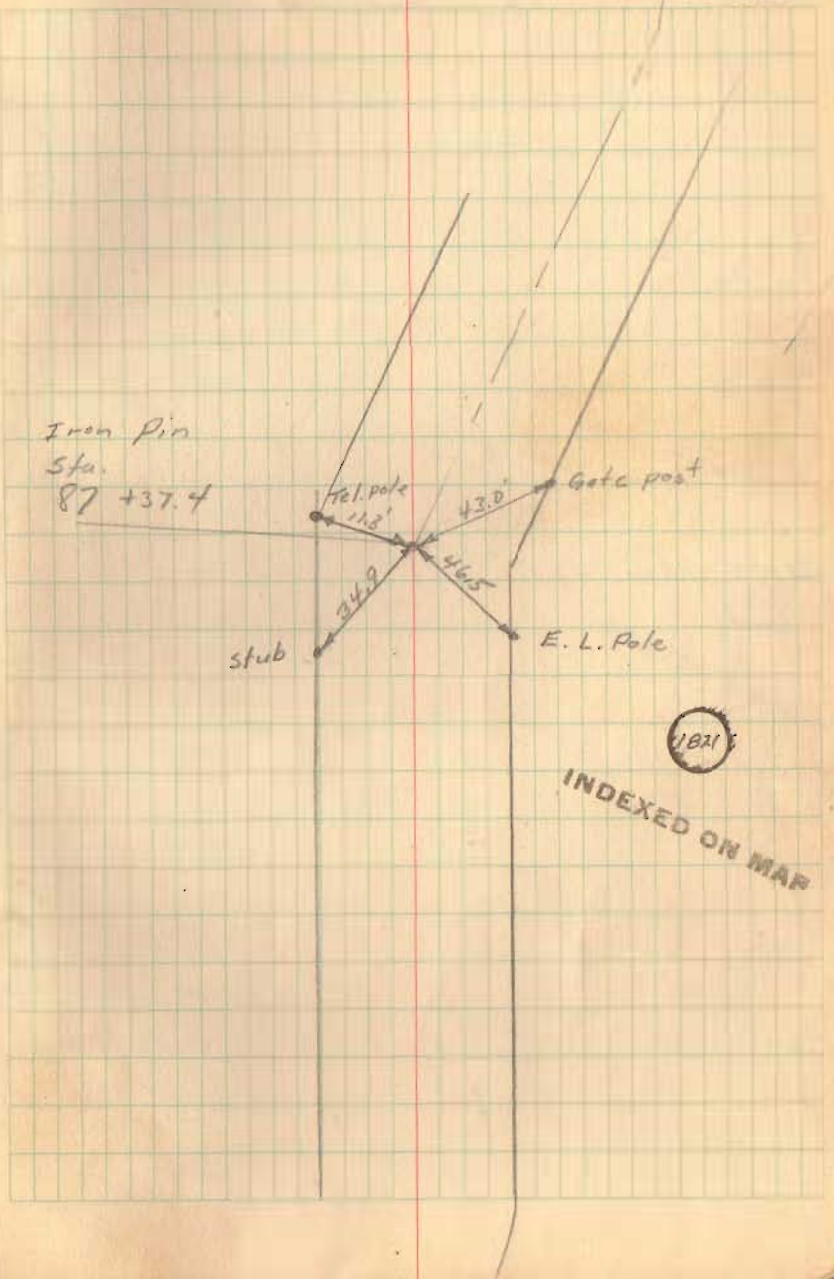

1821
INDEXED ON MAR

Road No. 158- Zone Township

96+00 Mon. (Hubs Set)

92+00 Mon. (Hubs Set)

7/9/20

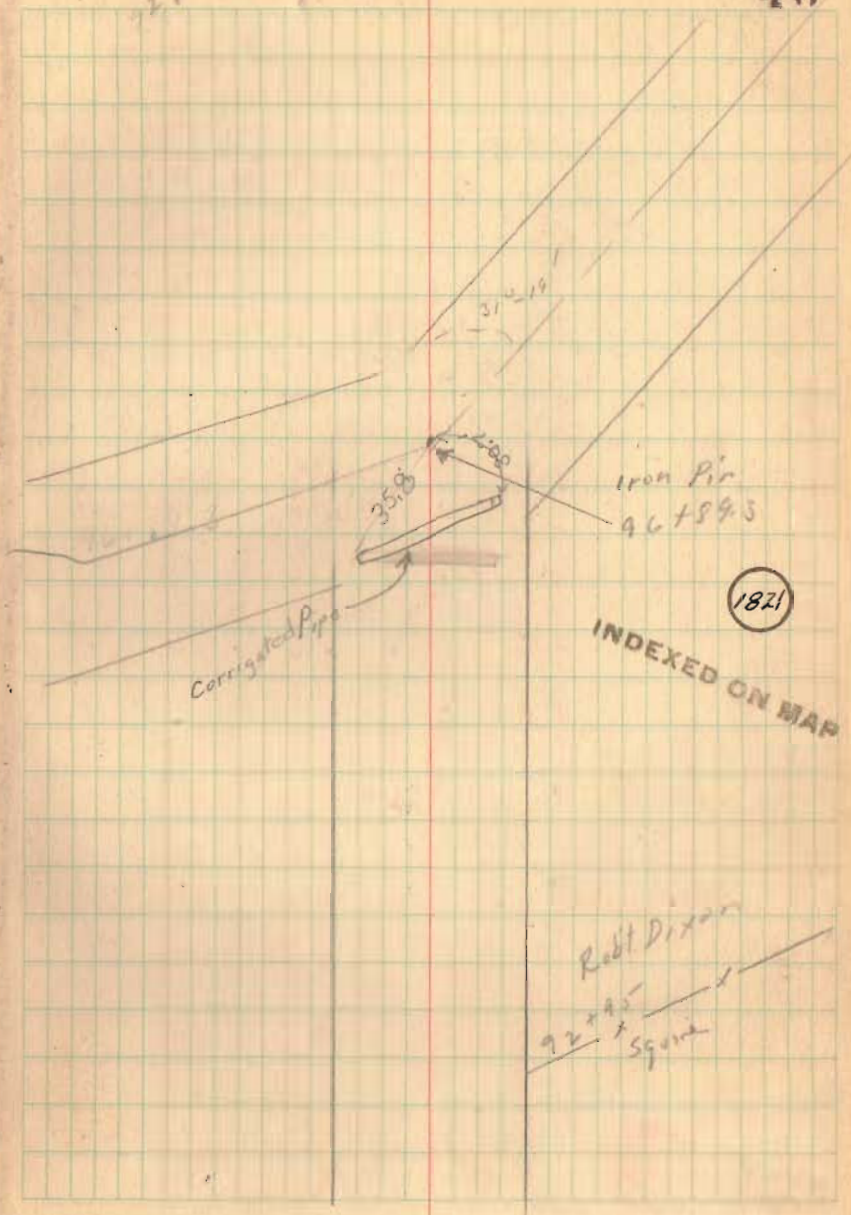

1821

INDEXED ON MAP

E. Liberty Play Ground

See sketch - Next page

B.M.

	+S	HI	−S	Elev
B.M.	7.10	1240.39		1233.29
T.P.	3.65	1231.81	12.23	1228.16
B.M.			2.06	1229.75
T.P.	4.47	1224.24	12.04	1219.77
B.M.			7.65	1216.59

Readings taken on Lines & Stations shown on - sketch (Page 50)

Line	Sta.	Elev.	Self Reading	Rod
	B.M.	1216.59		
0	A	1213.8		
	A+3	12.8		
	A+5	12.9		
	A+7	13.5		
	A+16	14.2		
	A+19	15.6		
	A+32	16.0		
	A+45	15.4		
	A+56	15.5		
	A+79	17.1		
0	B	1218.2		
	B+25	19.0		
	B+40	19.9		
0	B+64	1221.1		

X on N. Wear of concrete top of Cistern S. M. E. Church.

X on N. E. Cor of Concrete Cistern Top N. of School Building

Spike in N. Root 12" Ash. in school yard

INDEXED ON MAP

4358

E. Liberty School Lot

Line	Sta.	Elev.
0	B+91	
1	A	1213.9
1	A+6	12.9
	A+8	13.3
	A+10	12.8
	A+14	12.8
	A+17	14.0
	A+20	15.4
	A+27	15.4
	A+37	14.8
	A+60	15.4
	A+83	15.0
1	B	1215.3
1	B+20	16.4
	B+36	17.0
	B+43	17.2
	B+48	17.3
	B+51	17.4
	B+69	17.7
	B+92	17.9
1	C	1218.0
	C+12	1218.1
	C+17	18.5
	C+23	18.7

0.41 7/9/40

50

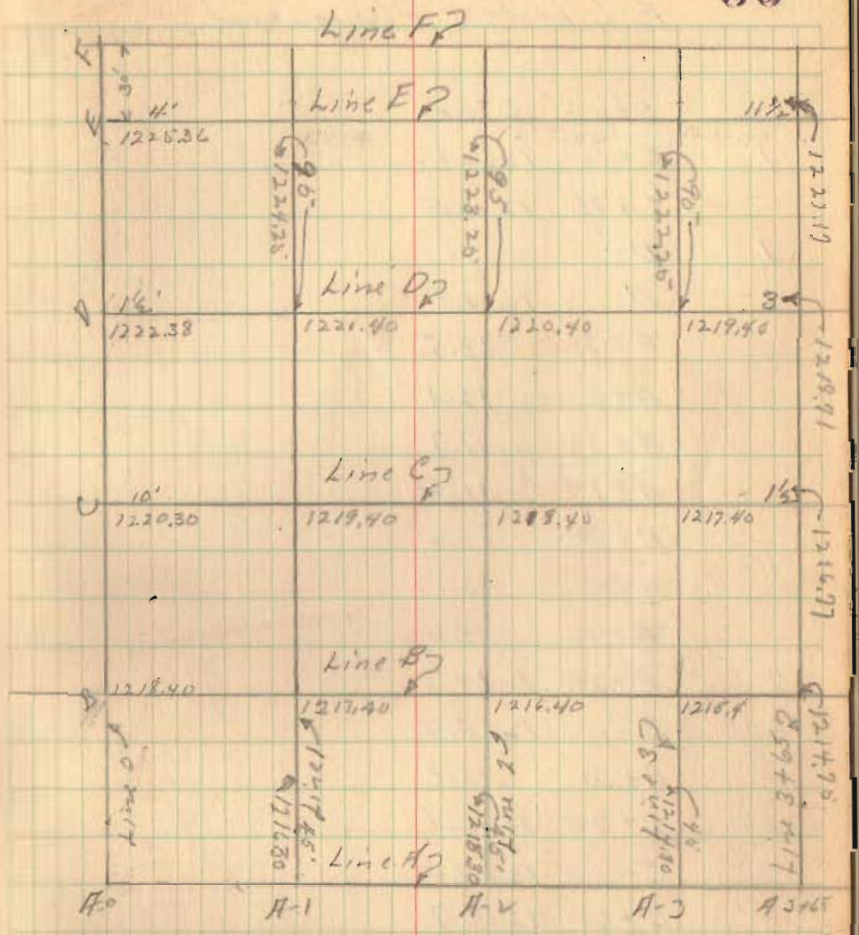

Road No. 201 Union Twp.

Stakes set 20' R&L from ℄

7+00 Mon. (Set)

2+00 Mon. (Set)

(1822)

INDEXED ON MAP

Clear-Hot 7/10/40
E.K. Corle
G.W. Wilgus
M.E. Jones
W.R. Wright

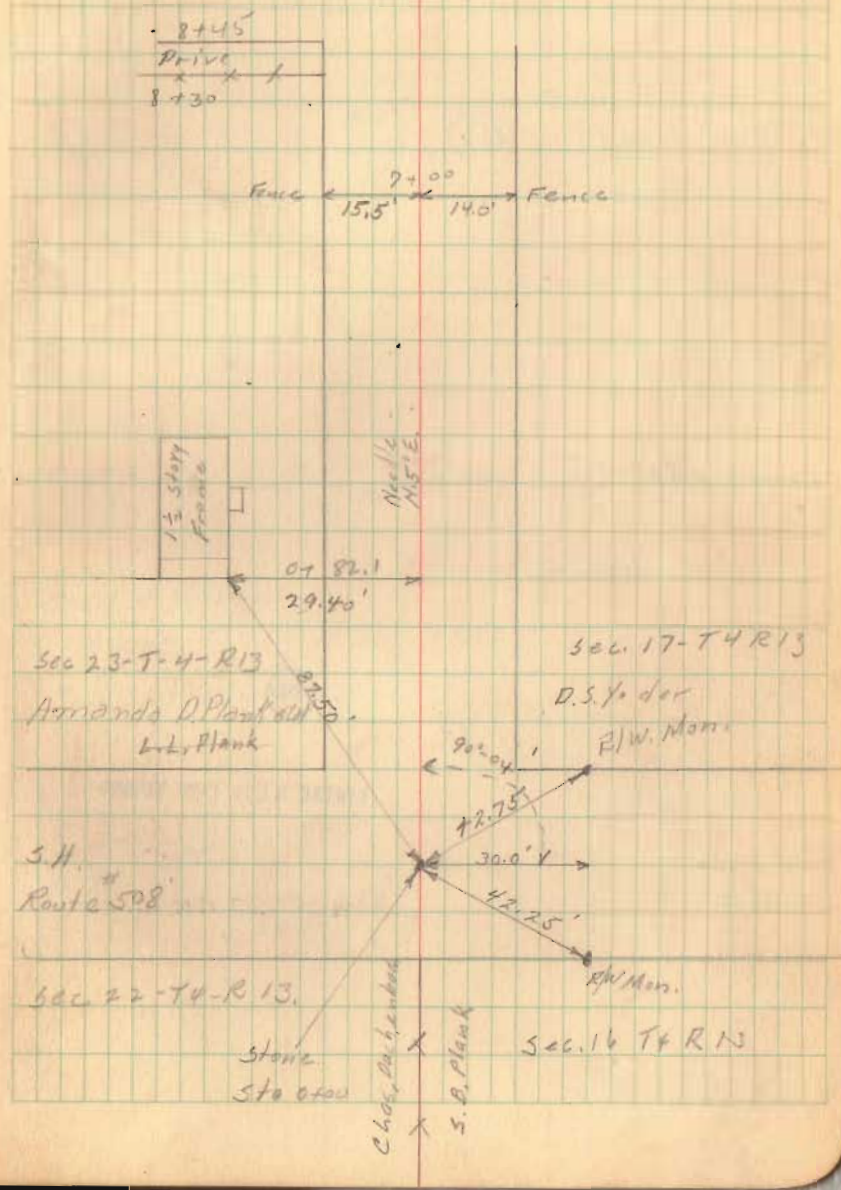

Road No. 201 - Union Twp.

17+00 Mon. (Set)

12+00 Mon. (Set)

(1872)

INDEXED ON MAP

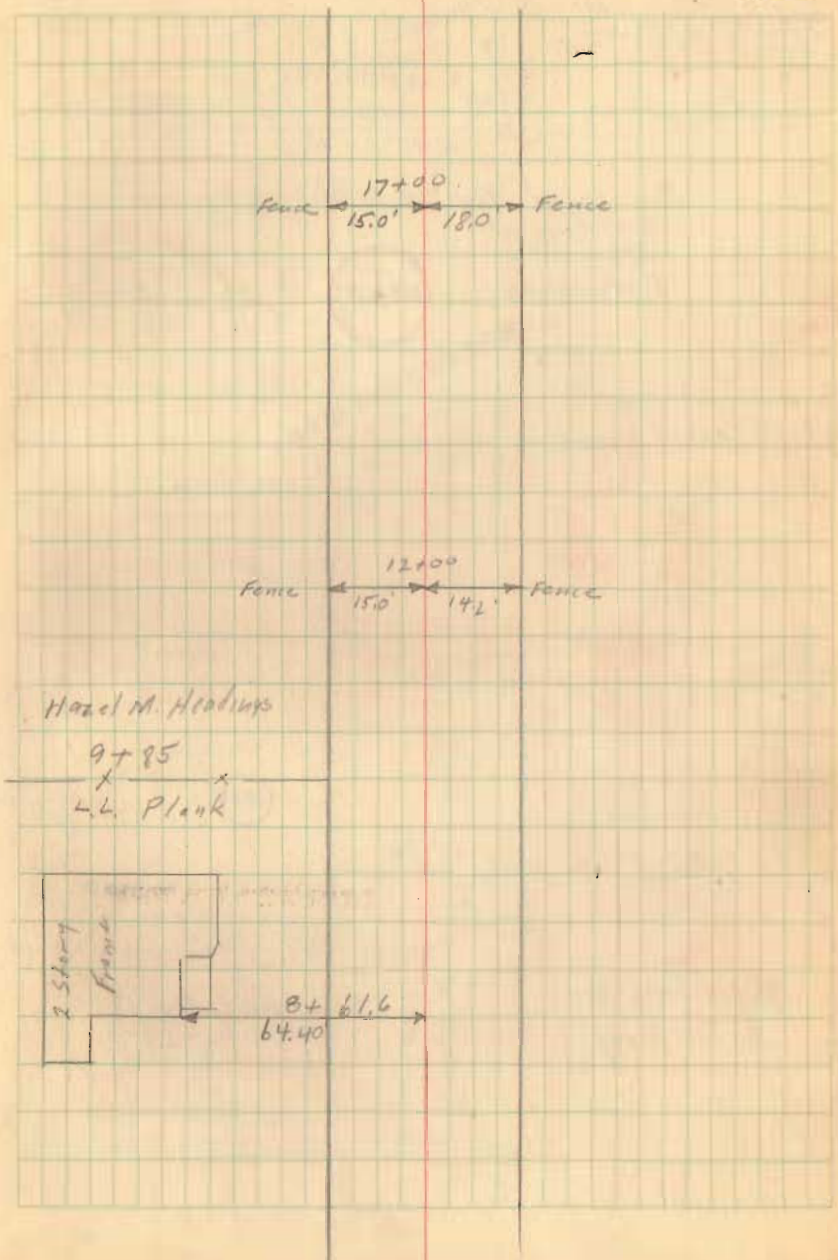

CH# 203

RR Spike

S. 87°-20' E.
140.05'

RR Spike
28+43.15

Description for Church Bldg.

N. 42°-10' E.
178.7'

88°-30'

Church
0.25 A.

91°-30'

90°

90°

75.0'

RR Spike
27+68.15

2'x2' Hub

140.0'

N. 85°-50' W.

N. 4°-10' E.
95.85'

Surveyed Mar. 22, 1956
O. M. Liggett
V. Dettrick
C. Nichols

2145

INDEXED ON MAP

Stone
26+72.9

N. 4°-00' E.

27+00 Mon. (Set

Stone
26+72.9

1822

343.15'

S. 42°-00' W.

26+00 Mon. (Set)

INDEXED ON MAP

Existing Cem.
S. 86°-59' E.
197.2

post

iron

Addition to Cemetery

N. 3°-39' E.
110.44'

Prop. Add. to
0.50 A
Cemetery

110.44'

197.2'

Hub

N. 86°-45' W.

Iron

22+00 Mon. (Set)

28+56.3

Road # 203

RR Spike
Sta. 28+43.15

91°-30'

28+20

28+18
53.75'

Philadelphia
Ev. Lutheran
Church

Walk 6'

167

27+47

27+00

Fence

20.0

41.0

Monument
John W. Hayes
1941

Stone
Sta 26+72.9
0°-10' Right
0°-10'

48.4'

Nelson L. King
et ux

41.1

Cr. Post

26+30

Drive
26+14

26+00

20.0

17.4'

Cemetery
23+31

Hazel M Hastings

Fence

22+00

13.7

17.1

Fence

47+00 Mon. (Set)

42+00 Mon. (Set)

1822

INDEXED ON MAP

36+00 Mon. (Set)

31+00 Mon. (Set)

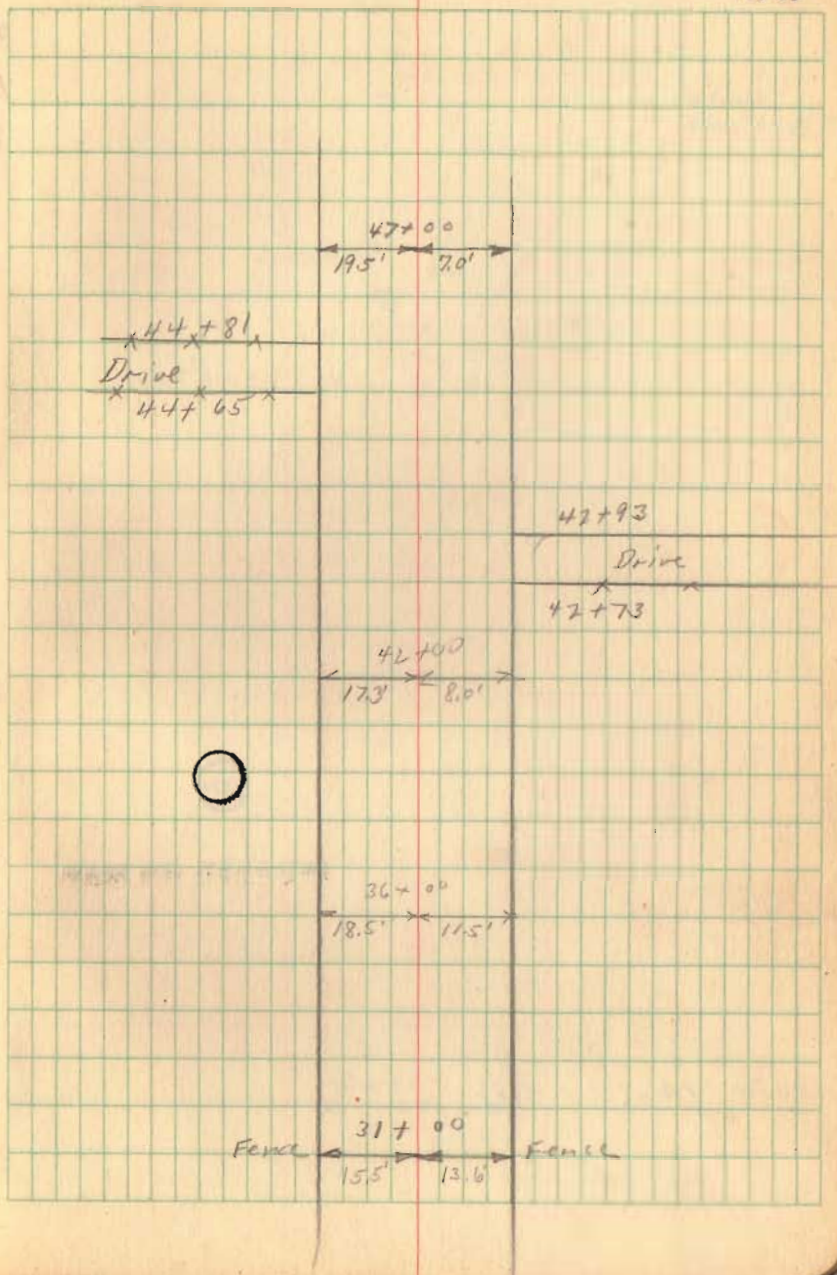

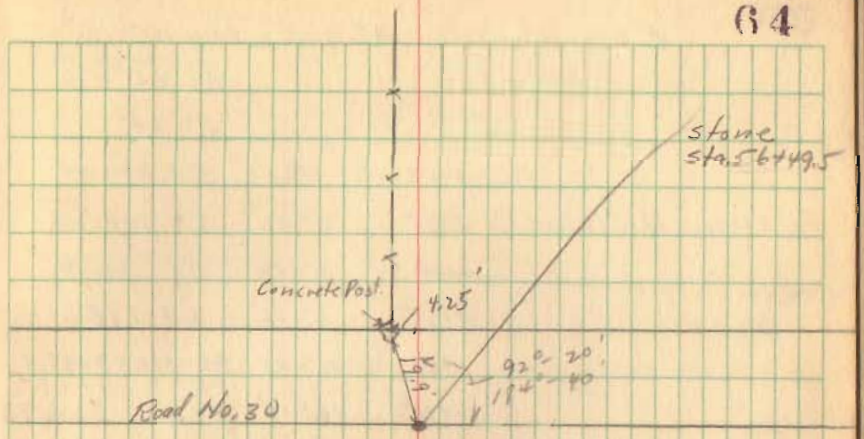

1822

INDEXED ON MAP

54+00 Mon (Set)

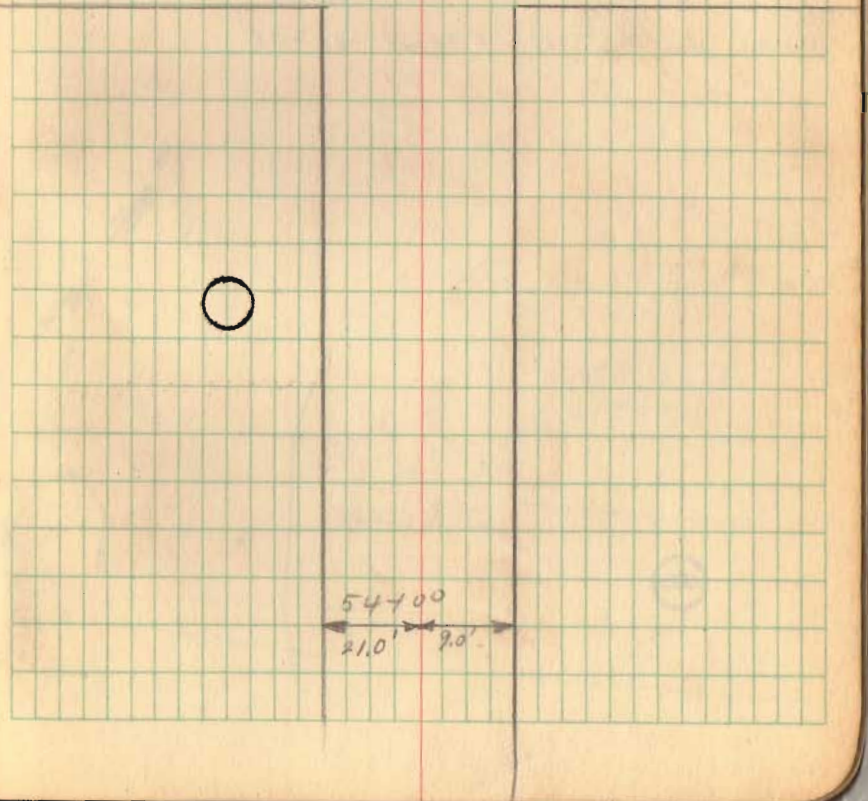

Road No. 34 Miami Township

$\Delta = 45° - 16'$

$D = 24°$

P.C. - 3+58.1	0°-00'	R =	240.49'
P.T. 5+46.7 Mon (Hubs Set) 3+75	2°-02'	T =	100.26
4+00	5°-02'	E =	20.06
4+25	8°-02'	L =	188.61
+50	11°-02'	P.C. - Sta. -	3+58.1
+75	14°-02'	P.I. "	4+58.4
5+00	17°-02'	P.T. =	5+46.7
+25	20°-02'		
P.C. 3+58.1 Mon (Hubs Set) 5+46.7	22°-38'		

1401.88' (Mon. (Hubs Set)

Flows Mill Race

Great Miami River

To Quincy

(1823)

July 23, 1940
E.K. Cook
M.E. Jones
R.H. Reed
M. Nitch

65

45°-31'
45°-16'

Needle N 45° W

Sta 4+58.4
45° 16'

Needle N 45° W

R.R. Spike
5 Sta 0+00

180°-00'
45°-16'

Post 20'

11+00 Mon. (Hubs Set)

7+44.7
5+46.7
97.3
100.2
297.5

(1823)

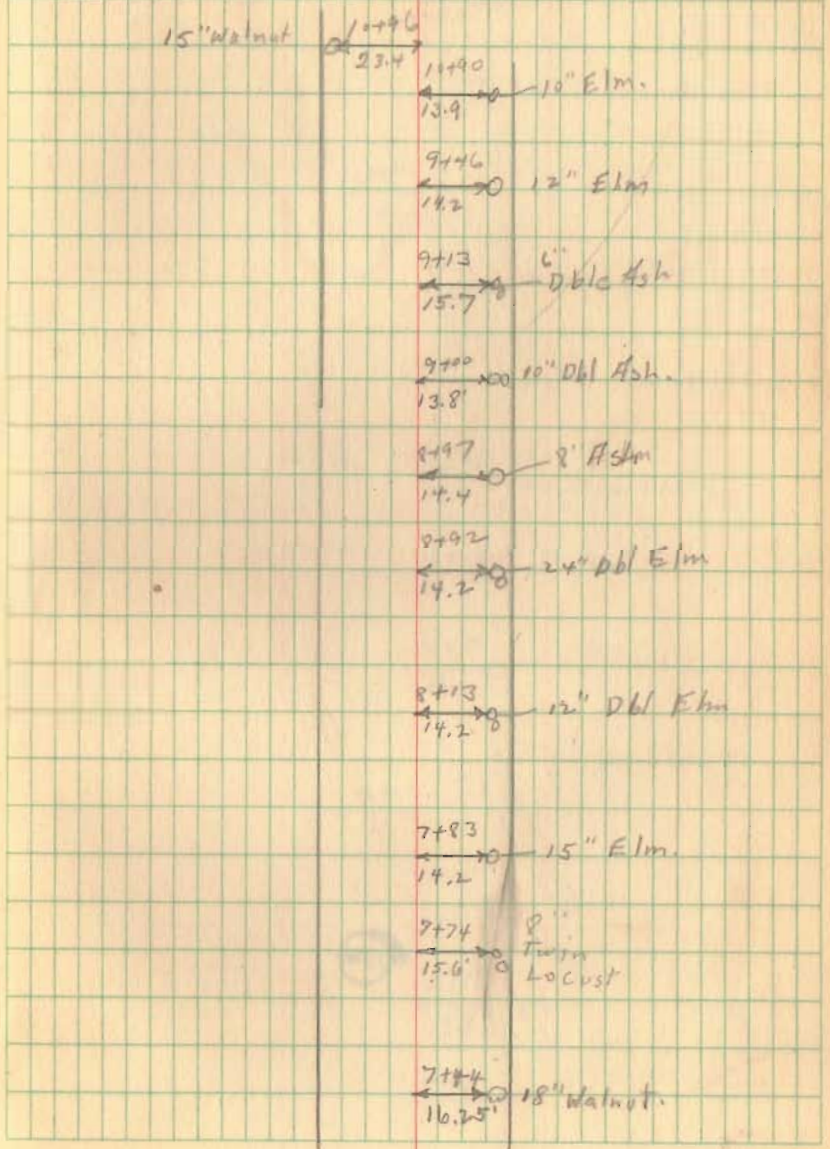

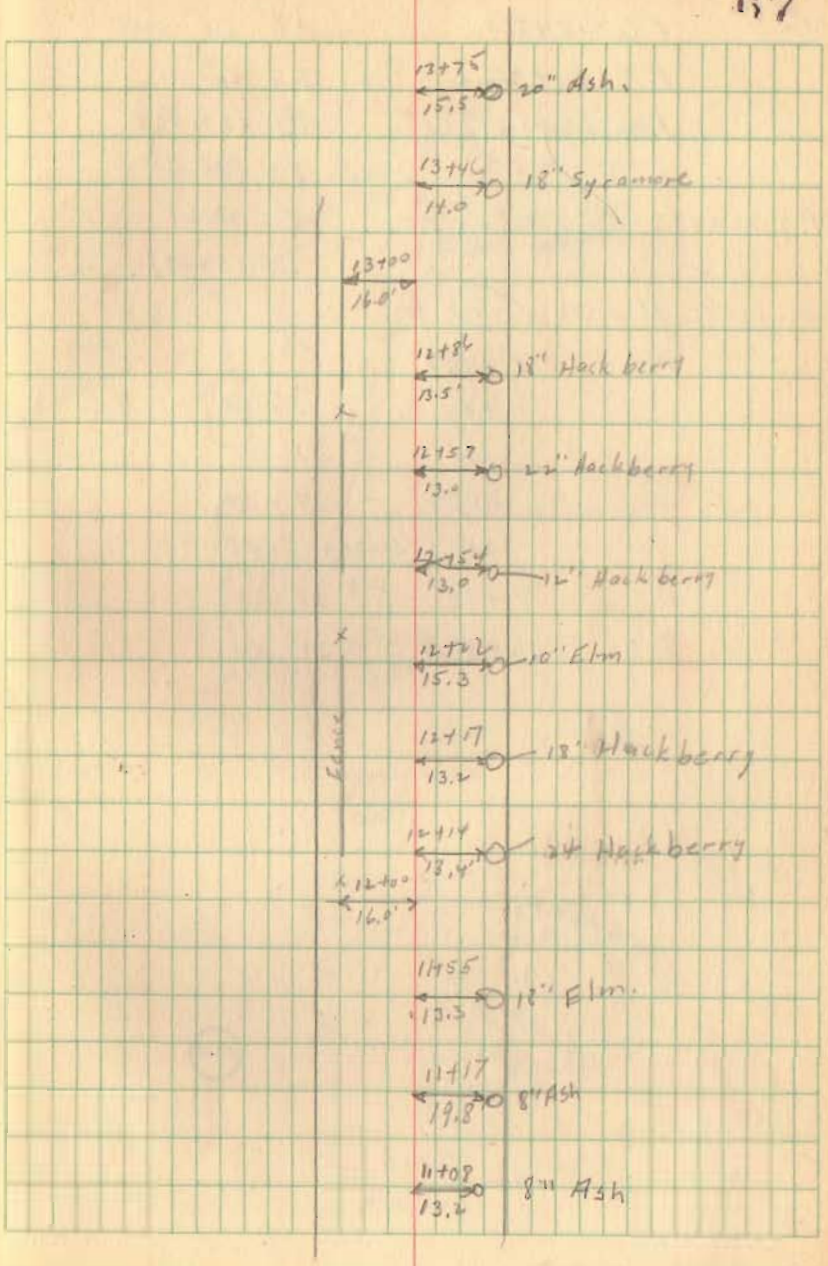
13+75
15.5
20" Ash
13+40
14.0
18" Sycamore
13+00
16.0'
12+84
13.5'
18" Hackberry
12+57
13.0
22" Hackberry
12+45
13.0
12" Hackberry
12+22
15.3
10" Elm
12+17
13.2
18" Hackberry
12+14
18.4'
24" Hackberry
12+00
16.4'
11+55
13.3
12" Elm
11+17
19.8
8" Ash
11+08
13.4
8" Ash

P.I.

P.C. - 15+51.1
P.I = 16+26.6
P.T. = 16+83.9

Δ = 61° - 05'
D = 46°
T = 127.965
T = 75.50
E = 20.61
L = 132.78

P.T. 16+83.9 Mon. Right on Ly (Hub Set)

P.C. - 15+51.1 Mon. (Hubs Set)

P.C. -	15 +51.1	
	+75	- 5° - 30'
	16+00	- 11° - 15'
	+25	- 17° - 00'
	+50	- 22° - 45'
	+75	- 28° - 30'
P.T.	16+83.9	- 30° - 32'

16+26.6
5 46.1
79.9
1° 00.2 6
80.1
1 8

(1823)

2 Pipes
177.85
Drd. 0.96

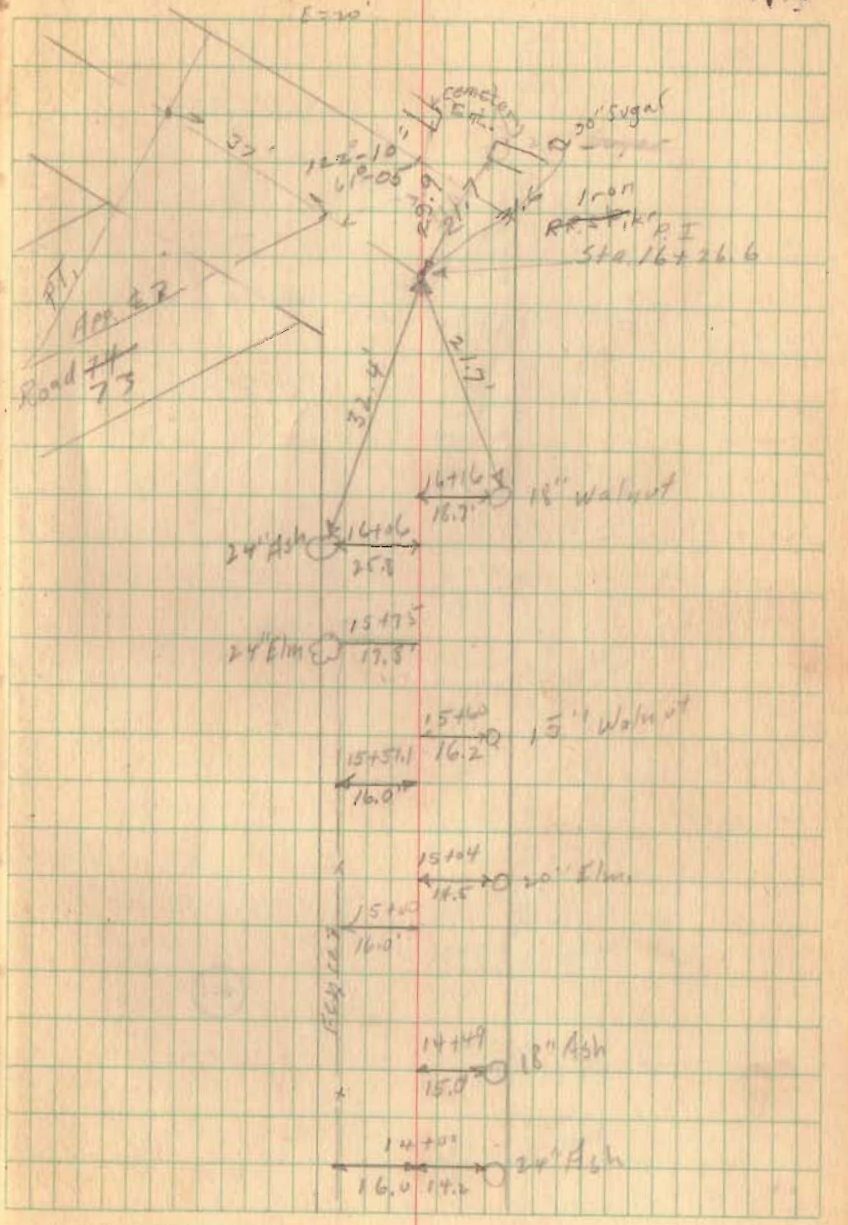

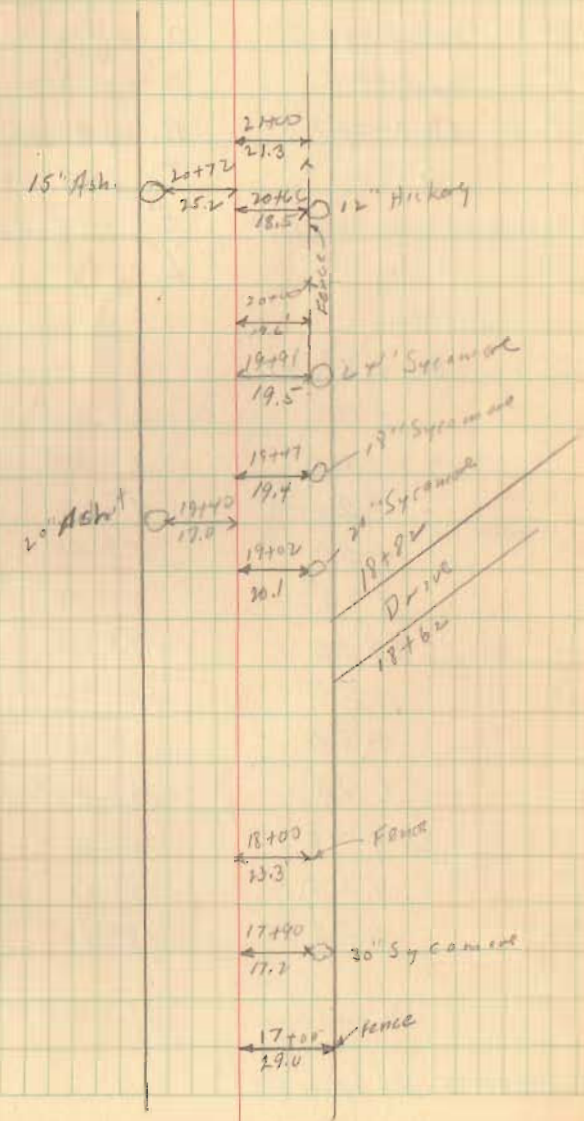
21+00
21.3
15" Ash
21+72
25.2
20+46
18.5
12" Hickory
Fence
20+00
19.2
19+91
19.5
24" Sycamore
19+47
19.4
18" Sycamore
20" Ash
19+40
19.0
24" Sycamore
19+02
20.1
18+82
Drive
18+62
18+00
Fence
23.3
17+40
17.2
30" Sycamore
17+00
Fence
29.0

1823

P.C.	20+60.37	Δ	37° 12'
P.I.	22+09	D	13° 0
P.T	23+46.52	R.	441.684
		T	148.63
P.T. - 23+46.52 - Mon. (Hubs Set)		E	24.35
		L	286.15

P.C.	20+60.37	
	+75	0° 52'
	21+00	2° 35
	+20	4° 12'
	+50	5° 50'
	+75	7° 27
	22+00	9° 05'
	+25	10° 42'
	+50	12° 20'
	+75	13° 57'
	23+00	15° 35'
	+25	17° 12'
P.T.	+46.62	18° 36'

(1823)

P.C. - 20+60.37 - Mon (Hubs Set)

77

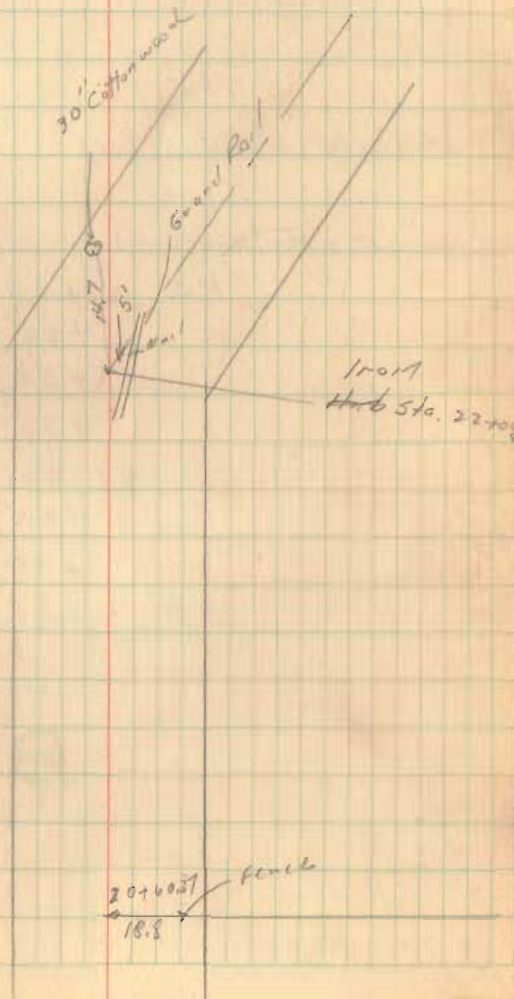

P.C. 26+163
P.I. 26+93.8
P.T. 27+68.6

Δ 24° 21'
D 16° 0'
R 359.26
T 77.51
E 8.26
L 152.19

P.T. Sta 27+68.5 - Mon (Hubs Set)

P.C. - Sta 26+16.3 Mon (Hubs Set)

P.C.	26+16.3	
	+20	0° 42'
	+50	2° 42'
	+70	4° 42'
	27+00	6° 42'
	+20	8° 42
	+40	10° 42
P.T.	+68.0	12° 10' 30"

(1823)

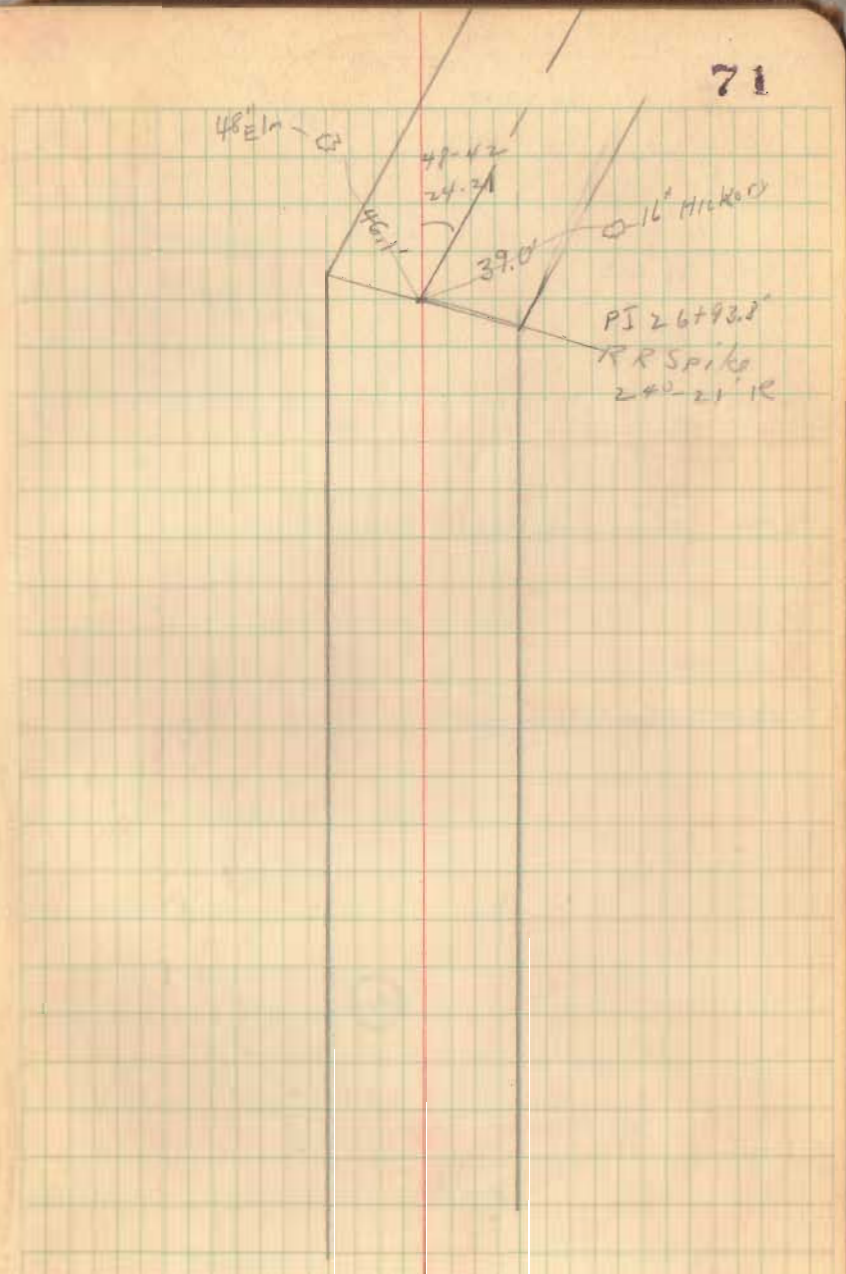

179-16.20

20 23.10

Cor.
Section Stones

See Book 655
Page 1A.

38+00 Mon (Hubs Set)

33+00 Mon (Hubs Set)

1823

27 65.5
27
26 91.0

Pleasant Twp Sec. 15 T. 1 R. 8

72

Twp line & Section Line

179-38'-20"
179-16-20

Stone
& Sec. Cor.

Sec. 22. T1-R8

Iron Pin
Sta. 58+23.10

Miami Twp.

29+25
Drive
29+09

28+00
Drive
27+75

28+00
18.2'
Post

Marion Drive - Five Parks Allotment

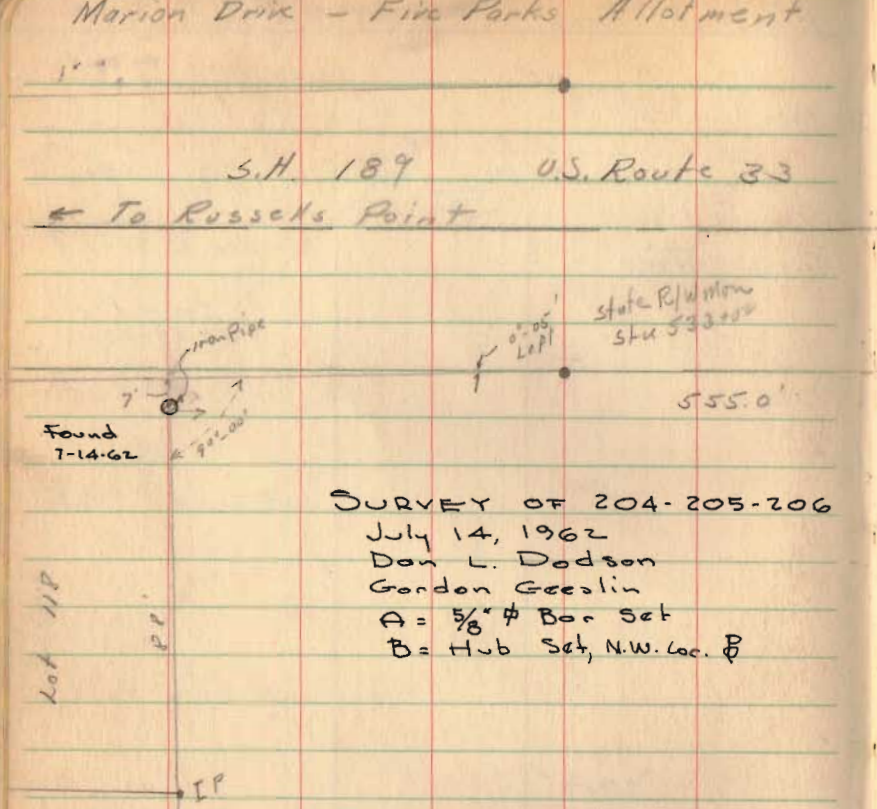

SURVEY OF 204-205-206
July 14, 1962
Don L. Dodson
Gordon Geeslin
A = 5/8" ϕ Bar Set
B = Hub Set, N.W. Loc. ϕ

INDEXED ON MAP
1826
INDEXED ON MAP

Nov. 7, 1940
E. Core
G. Wilgus
M. Jones

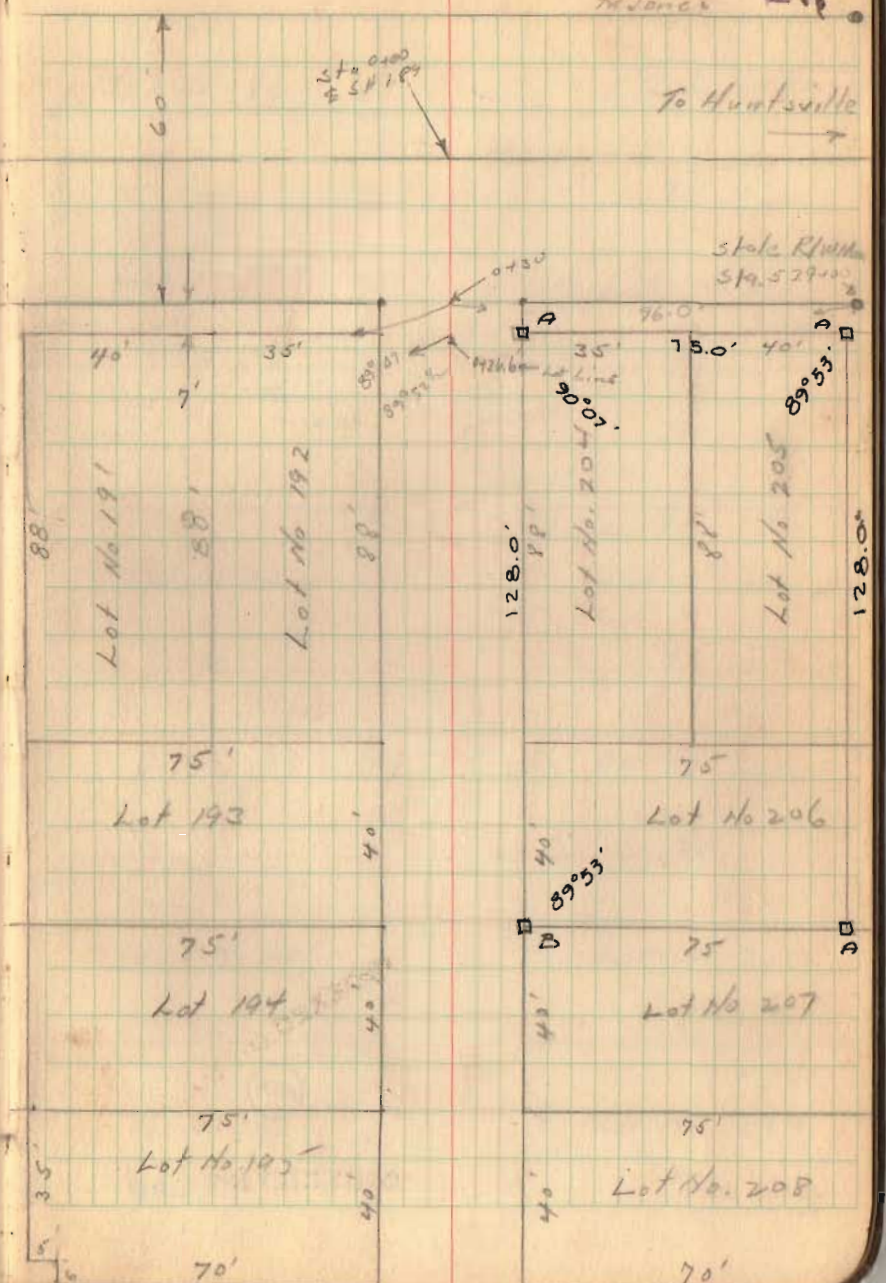

Marion Drive – 5' Parks Allot.

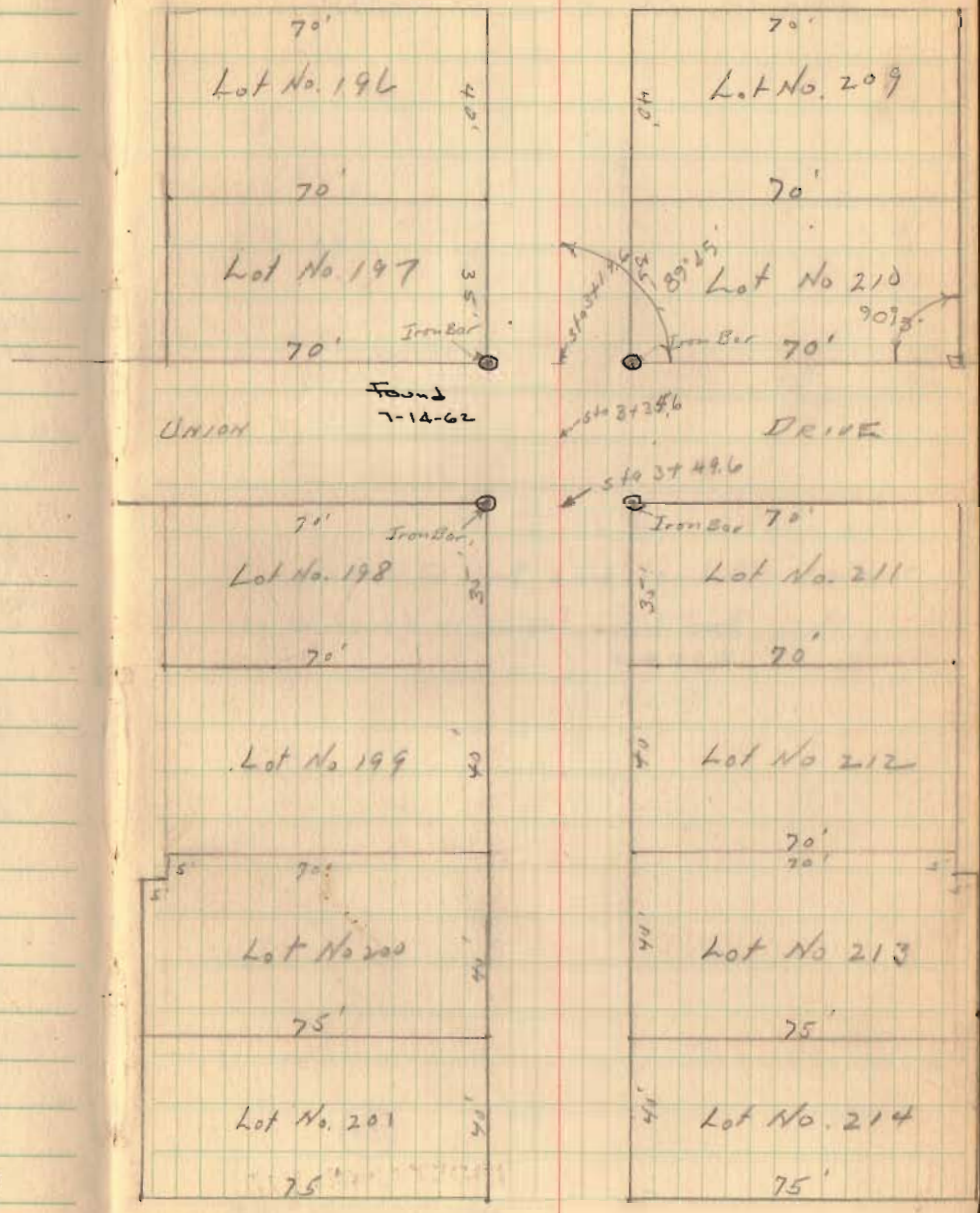

1826

INDEXED ON MAP

Marion Drive 5 Parks

7-14-62 - Did not find Bars @ 6+04.6

Bar found laying in fence W. of 6+04.6

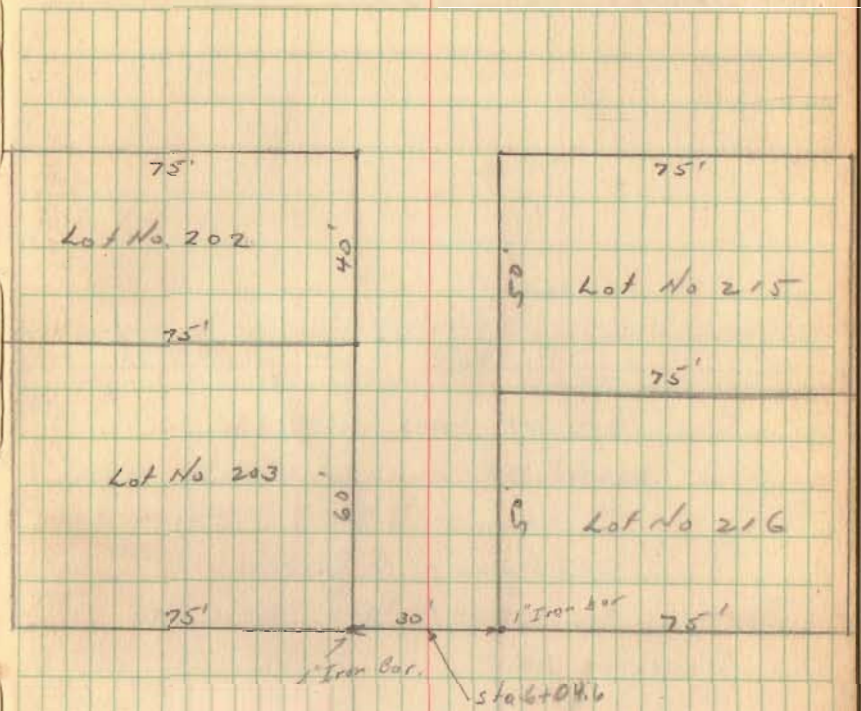

1826

INDEXED ON MAP

Montgomery Drive S. Parks Allotment

Survey of Lots 220-221
By order of County Commissioners
Party: D. Dodson – D. Tevis Aug. 11, 1962
T. Tillman – O. Ricketts
Survey to locate lots sold at Sheriff's sale

Found 1" I. Bars @ S.E. Cor. 208 & S.E. Cor. 221 & S.W. Cor. 233 evidently set Nov. 8, 1940
Did not look for other possible irons!

1027

INDEXED ON MAP

Nov. 8, 1940
E.K. Cox
G.W. Wilgus
M.E. Jones

76

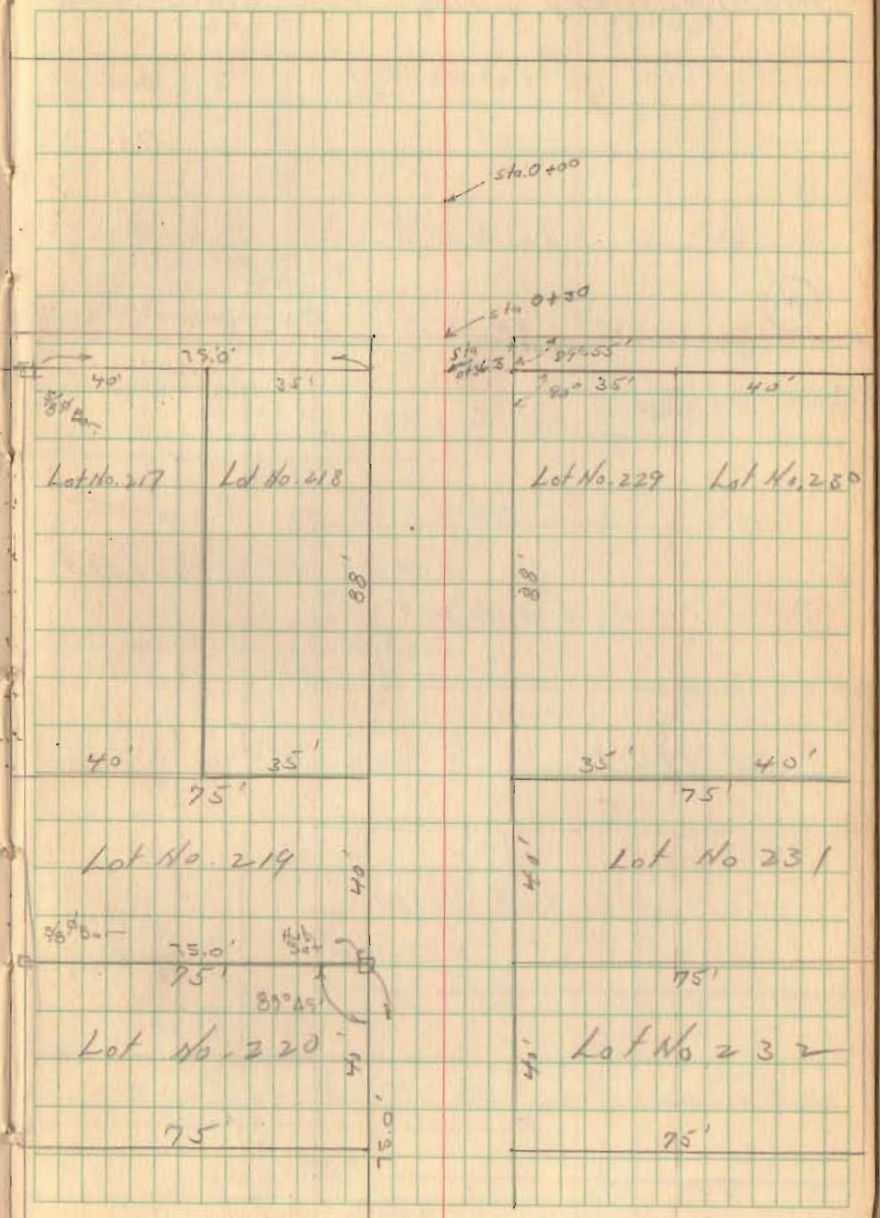

Nov. 8, 1940
E Cox
G Wilgus
H Jones.

Montgomery Drive - Five Parks Allotment

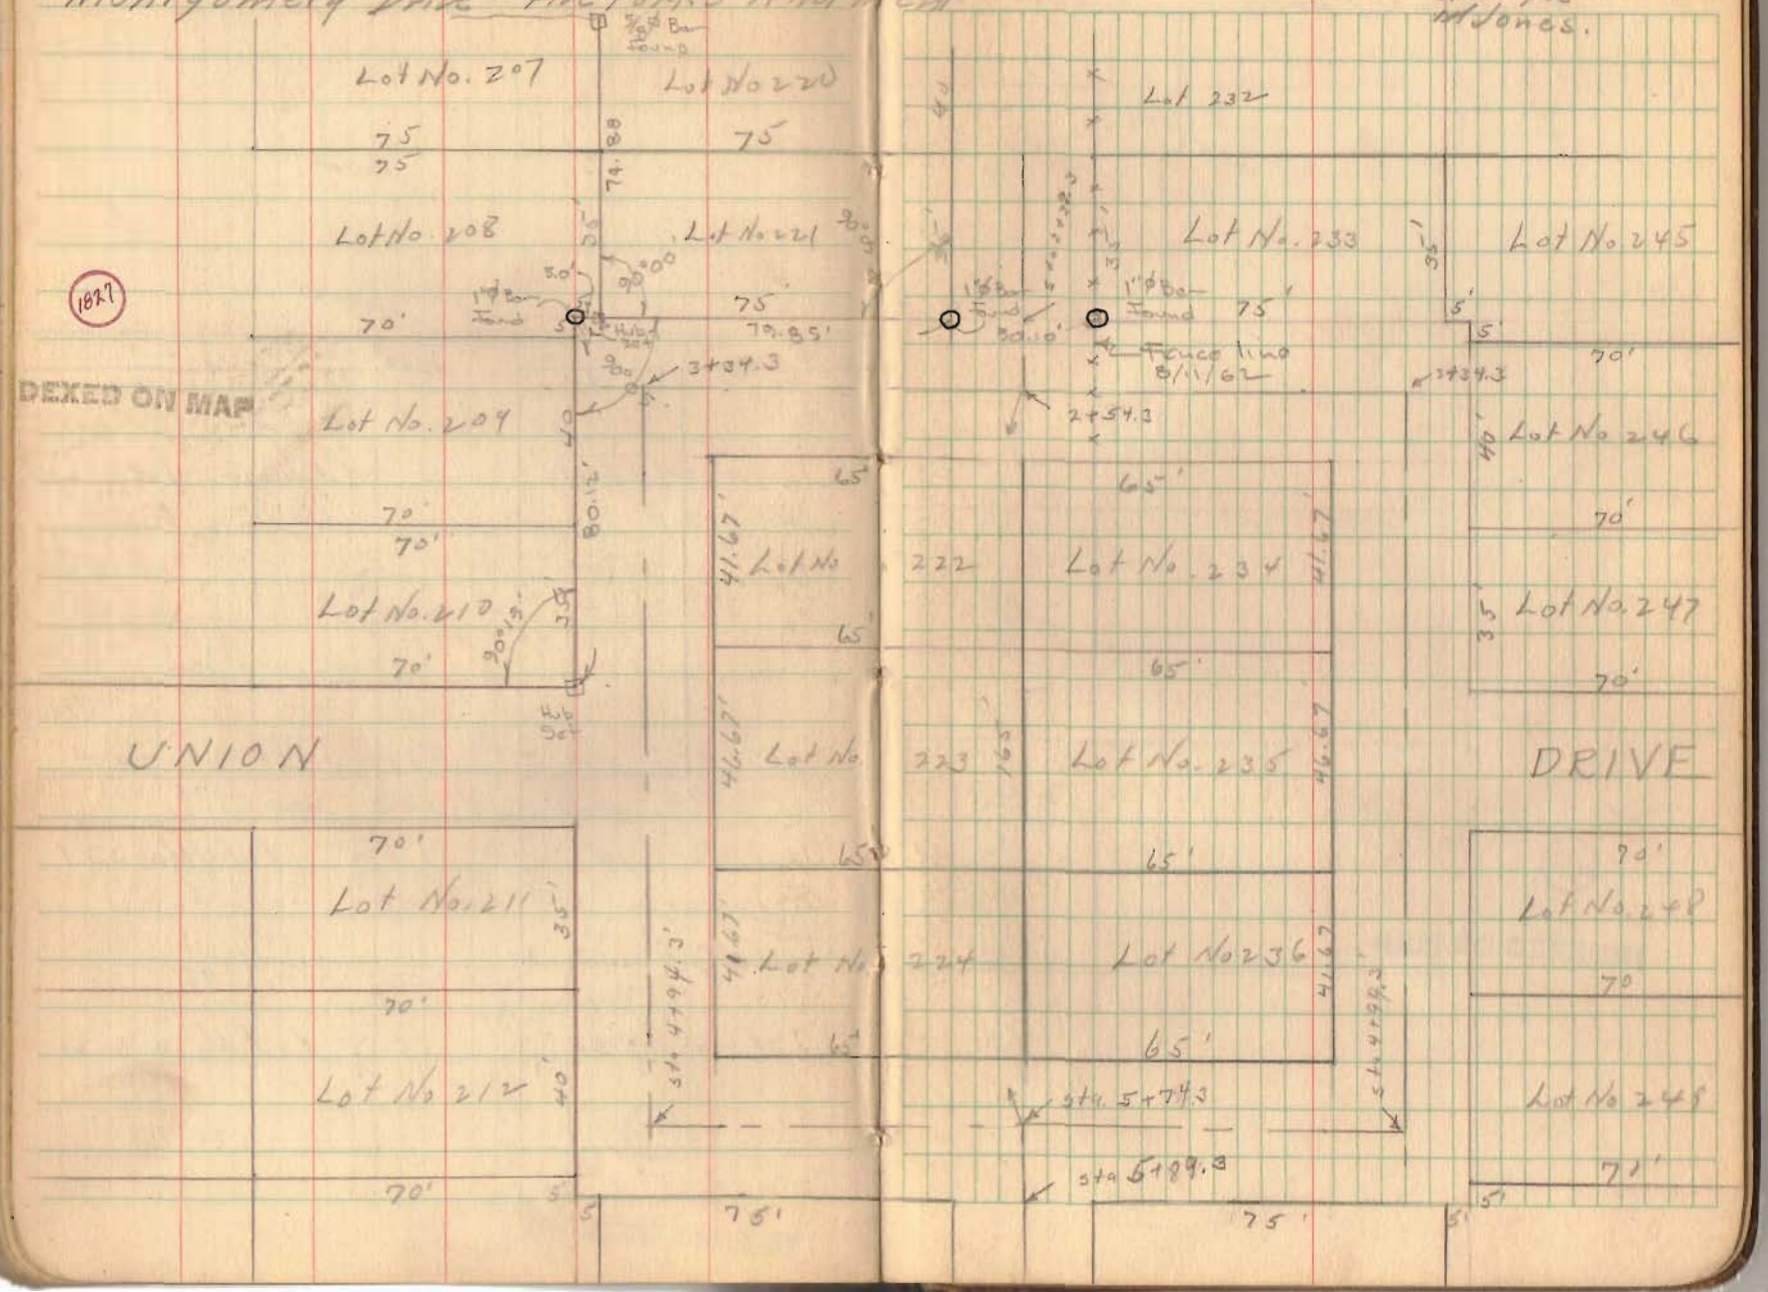

Montgomery Drive — Five Parks Allotment — 75

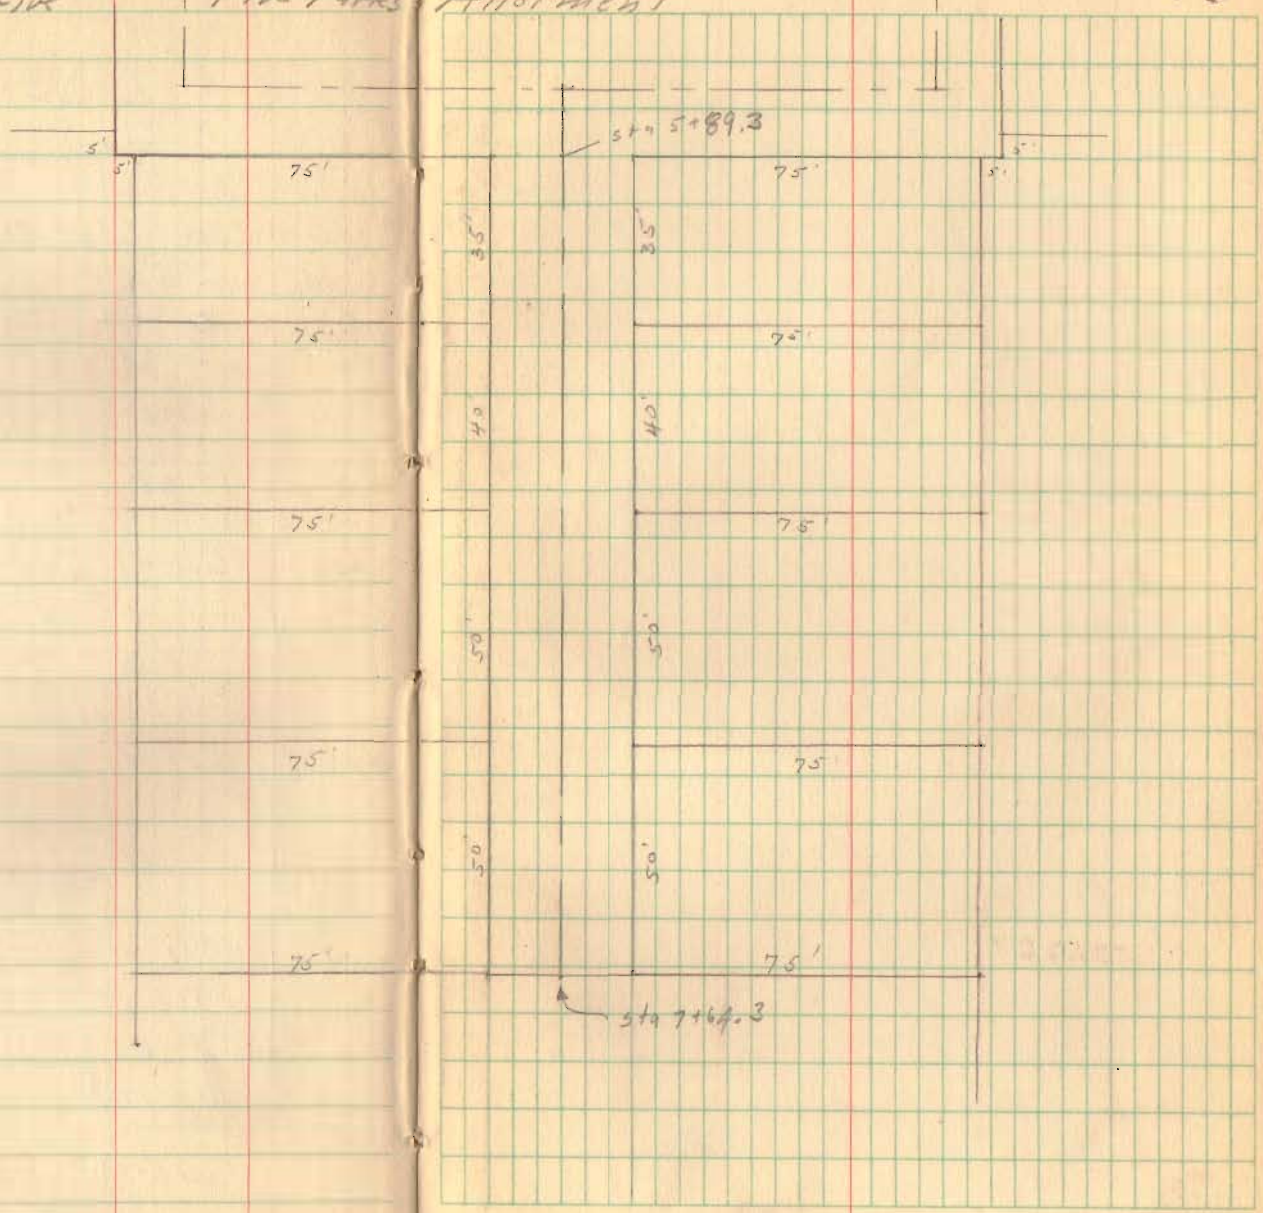

1827

INDEXED ON MAP

PROPOSED RELOCATION
C. H. No. 158

SEE PG. 42-43 THIS BOOK

PT 70+51.26 (Back) = 70+59.23 (Ahead)

69+69.85 ½" ø Bar Found - Set ¾" Pipe
Old Sta. 69+79.1

PC 68+88.15

67+00 Prop. ℄ New Structure

64+47 R Fence - Ida Sharp - Burdeno Rush

PT 62+01.32

61+00.00 New P.I. 1" ø Bar Set

PC 59+98.12

Mon. to be Set

Sta.	Left	Right	Date Set
60+41.79		29.19'	
61+54.32	41.00'		
62+01.32	40.00'	40.00'	
68+88.15	40.00'	40.00	
70+51.26	40.00'	40.00	
72+00	30.00'	30.00'	

Dodson
Gilbert
Smith
Hotertine

Δ = 8°-09'-20"
D = 5°-00'
R = 1148.92'
T = 81.70
L = 163.11'

P.I. ¾" pipe Set
69+69.85
8°-09'-20" Lt.

Old P.I.
68+81.4

67+00

Rush
R Fence 64+47
Sharp

Δ = 10°-09'-40"
D = 5°-00'
R = 1145.92'
T = 101.88'
L = 203.20'

3601

INDEXED ON MAP

P.I. Sta. 61+00.00
10°-09'-40" Rt.