


sta. 174+21 2 ft south of North edge  
of water.

900 bits 41' south of N edge of  
water 110' West

mit 30' North of N edge of water  
90 East

172+41 sand line

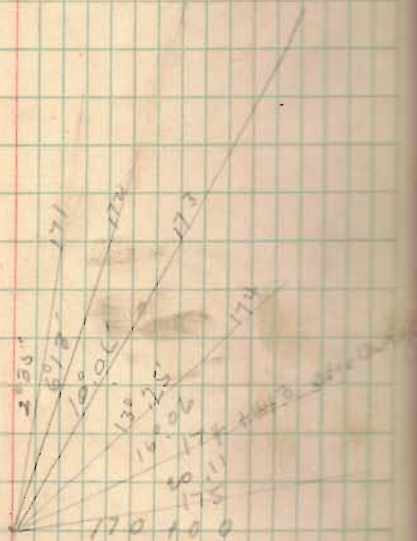

59°

178+253  
= 176+95

30°

175+00 edge



C.H. 130

	1932	E.K. Bridge	Hugh Bayer	Richard Shultz	Bright Gossard	B.O. Downing	Chas. Downing	Ross Hattin	Irwin Wickerham
Tues	4/22	1	1	1	1	1	1	1	1
Wed	23	1	1	1	1	1	1	1	1
Thurs	24				1	1	1	1	1

Lunch  
 40<sup>95</sup>  
 45¢

Paid By  
 Bridge  
 "

Livery

states

Work

Moments  
 130 Sec. D  
 130 " D  
 130 " D

500-2X1  
 Logan Co.

10.42.32 Bridge 208+50

			Grade
N.M. rail 2nd sp.	<del>5.45</del> 102.87	5.45	98.42 88.33
Dr. Floor		4.45	99.42
East N		4.62	99.25 88.33
N. West Way sth		5.84	98.01 88.33
Channel		11.63	92.24
SE stump 1 pm.		7.25	96.62 88.33
Bot. Ring.		2.87	100.00

10074  
445  
105.19  
5.45  
99.74

2.41  
7.81  
10.51

88.33  
12.87  
100.74 : 87  
99.02  
1.32

10.09

10.92

9.68

7.29

100  
3.87  
103.87



50' Girder sta 173 + 31

181

1042.16

10497

NW	3.51	101.46	92.92	8.54
NE	282	101.15	92.92	8.23
SE	321	101.76	92.92	8.84
SW	328	101.69	92.92	8.77
	800	96.97		
Brace Posts	0.32	104.65		

025  
104.90

554 99.36 92.92 6.44

0.31  
104.96

0.31  
94.92 10.04

10465  
105.06

10465

481 100.24 92.92 2.32

10470  
05

482  
834  
131.6

92.92  
9054  
2.35

96.97  
42.92  
5.05

104.90  
11.45  
93.45

105.05  
92.92  
12.13  
7

0.34

105.00  
12.75  
92.25

Culvert 127+14

Center Rd 4.7  
 Ditch East 9.8  
 side Ditch 9.0  
 side Ditch 10.4

Culvert 30+42

Cent Rd 5.1  
 East 10.6  
 side Ditch 9.4  
 Ditch W. 10.7

Grade Cut

Q Rd	100.00	483 ✓	95.17	
East		8.80	91.20	91.70
West		9.80	90.20	
side Ditch W		9.29	90.71	
Top West		7.51	92.49	
Top East		7.81	92.19	
stk East		7.16	92.84	91.60 1.24
stk West		6.30	93.70	92.16 1.54

9 9"  
 9 9"  
 $\frac{3.50}{9.33}$

7.66  
 4.83  
 2.83

37  
 19  
 56  
 91.60  
 92.46

91.88  
 3.50  
 95.38

108.09

N.E. seat	4.95	103.14	
N.W. seat	4.88	103.21	
S.W. seat	4.90	103.19	made 103.18
S.E. seat	4.92	103.17	
B.N.	108.09	3.44	104.65
<sup>S.E.</sup> Top of wing	2.51	105.58	
	7.41	set nail in piling	100.68

491  
21  
7.41



33/1.0 1033

69  $\frac{13}{39}$ 

170

Alw. Trade Centre Floor

Top stake E 18'	637	73.63	92.34	C 1.24
Chain East	7.68	92.32	92.0	
Chain center	8.98	90.02	91.5	
Chain west	9.15	90.85	91.0	
Top west 25'	762	92.38	90.310	2.07

493 95.07



60 ft span = 5200  
 30 ft span 4000

O.T.P.  
 347

226 I.P. Andrews A. Line

# EITH'S RAILROAD CURVE TABLES.

Published by KEUFFEL & ESSER CO., New York.

Entered according to Act of Congress in the year 1883,  
 by W. Keuffel & H. Esser, in the office of the Librarian of Congress,  
 in Washington, D. C.

Copyright, 1902, by Keuffel & Esser Co.

## HOW TO USE KEITH'S TABLES.

### EXAMPLE.

Wanted a Curve with an Ext. of about 12 ft. Angle  
 of Intersection or I. P. =  $23^{\circ} 20'$  to the R. at Station  
 542+72.

Ext. in Tab. IV opposite  $23^{\circ} 20' = 120.87$   
 $120.87 \div 12 = 10.07$ . Say a  $10^{\circ}$  Curve.

Tan. in Tab. IV opp.  $23^{\circ} 20' = 1183.1$   
 $1183.1 \div 10 = 118.31$ .

Tab. V correction for A.  $23^{\circ} 20'$  for a  $10^{\circ}$  Cur. = 0.16  
 $118.31 + 0.16 = 118.47 =$  corrected Tangent.

(If corrected Ext. is required find in same way)  
 Ang.  $23^{\circ} 20' = 23.33^{\circ} \div 10 = 2.3333 =$  L. C.

$2^{\circ} 19\frac{1}{2}' =$ def. for sta.	542	I. P. = sta.	542+72
$4^{\circ} 49\frac{1}{2}' =$ " " "	+50	Tan. =	118.47
$7^{\circ} 19\frac{1}{2}' =$ " " "	543	B. C. = sta.	541+53.53
$9^{\circ} 49\frac{1}{2}' =$ " " "	+50	L. C. =	2.33.33
$11^{\circ} 40' =$ " " "	543+	E. C. = Sta.	543+86.86
	86.86		

$100 - 53.53 = 46.47 \times 3' (\text{def. for 1 ft. of } 10^{\circ} \text{ Cur.}) = 139.41' =$   
 $2^{\circ} 19\frac{1}{2}' =$  def. for sta. 542.

Def. for 50 ft. =  $2^{\circ} 30'$  for a  $10^{\circ}$  Curve.

Def. for 36.86 ft. =  $1^{\circ} 50\frac{1}{2}'$  for a  $10^{\circ}$  Curve.

(These tables are published in Field Books of  
 KEUFFEL & ESSER CO., New York, N. Y.)

