


L-56-A

L-56-A

FED. RD. DIVISION	STATE	PROJECT
2	OHIO	

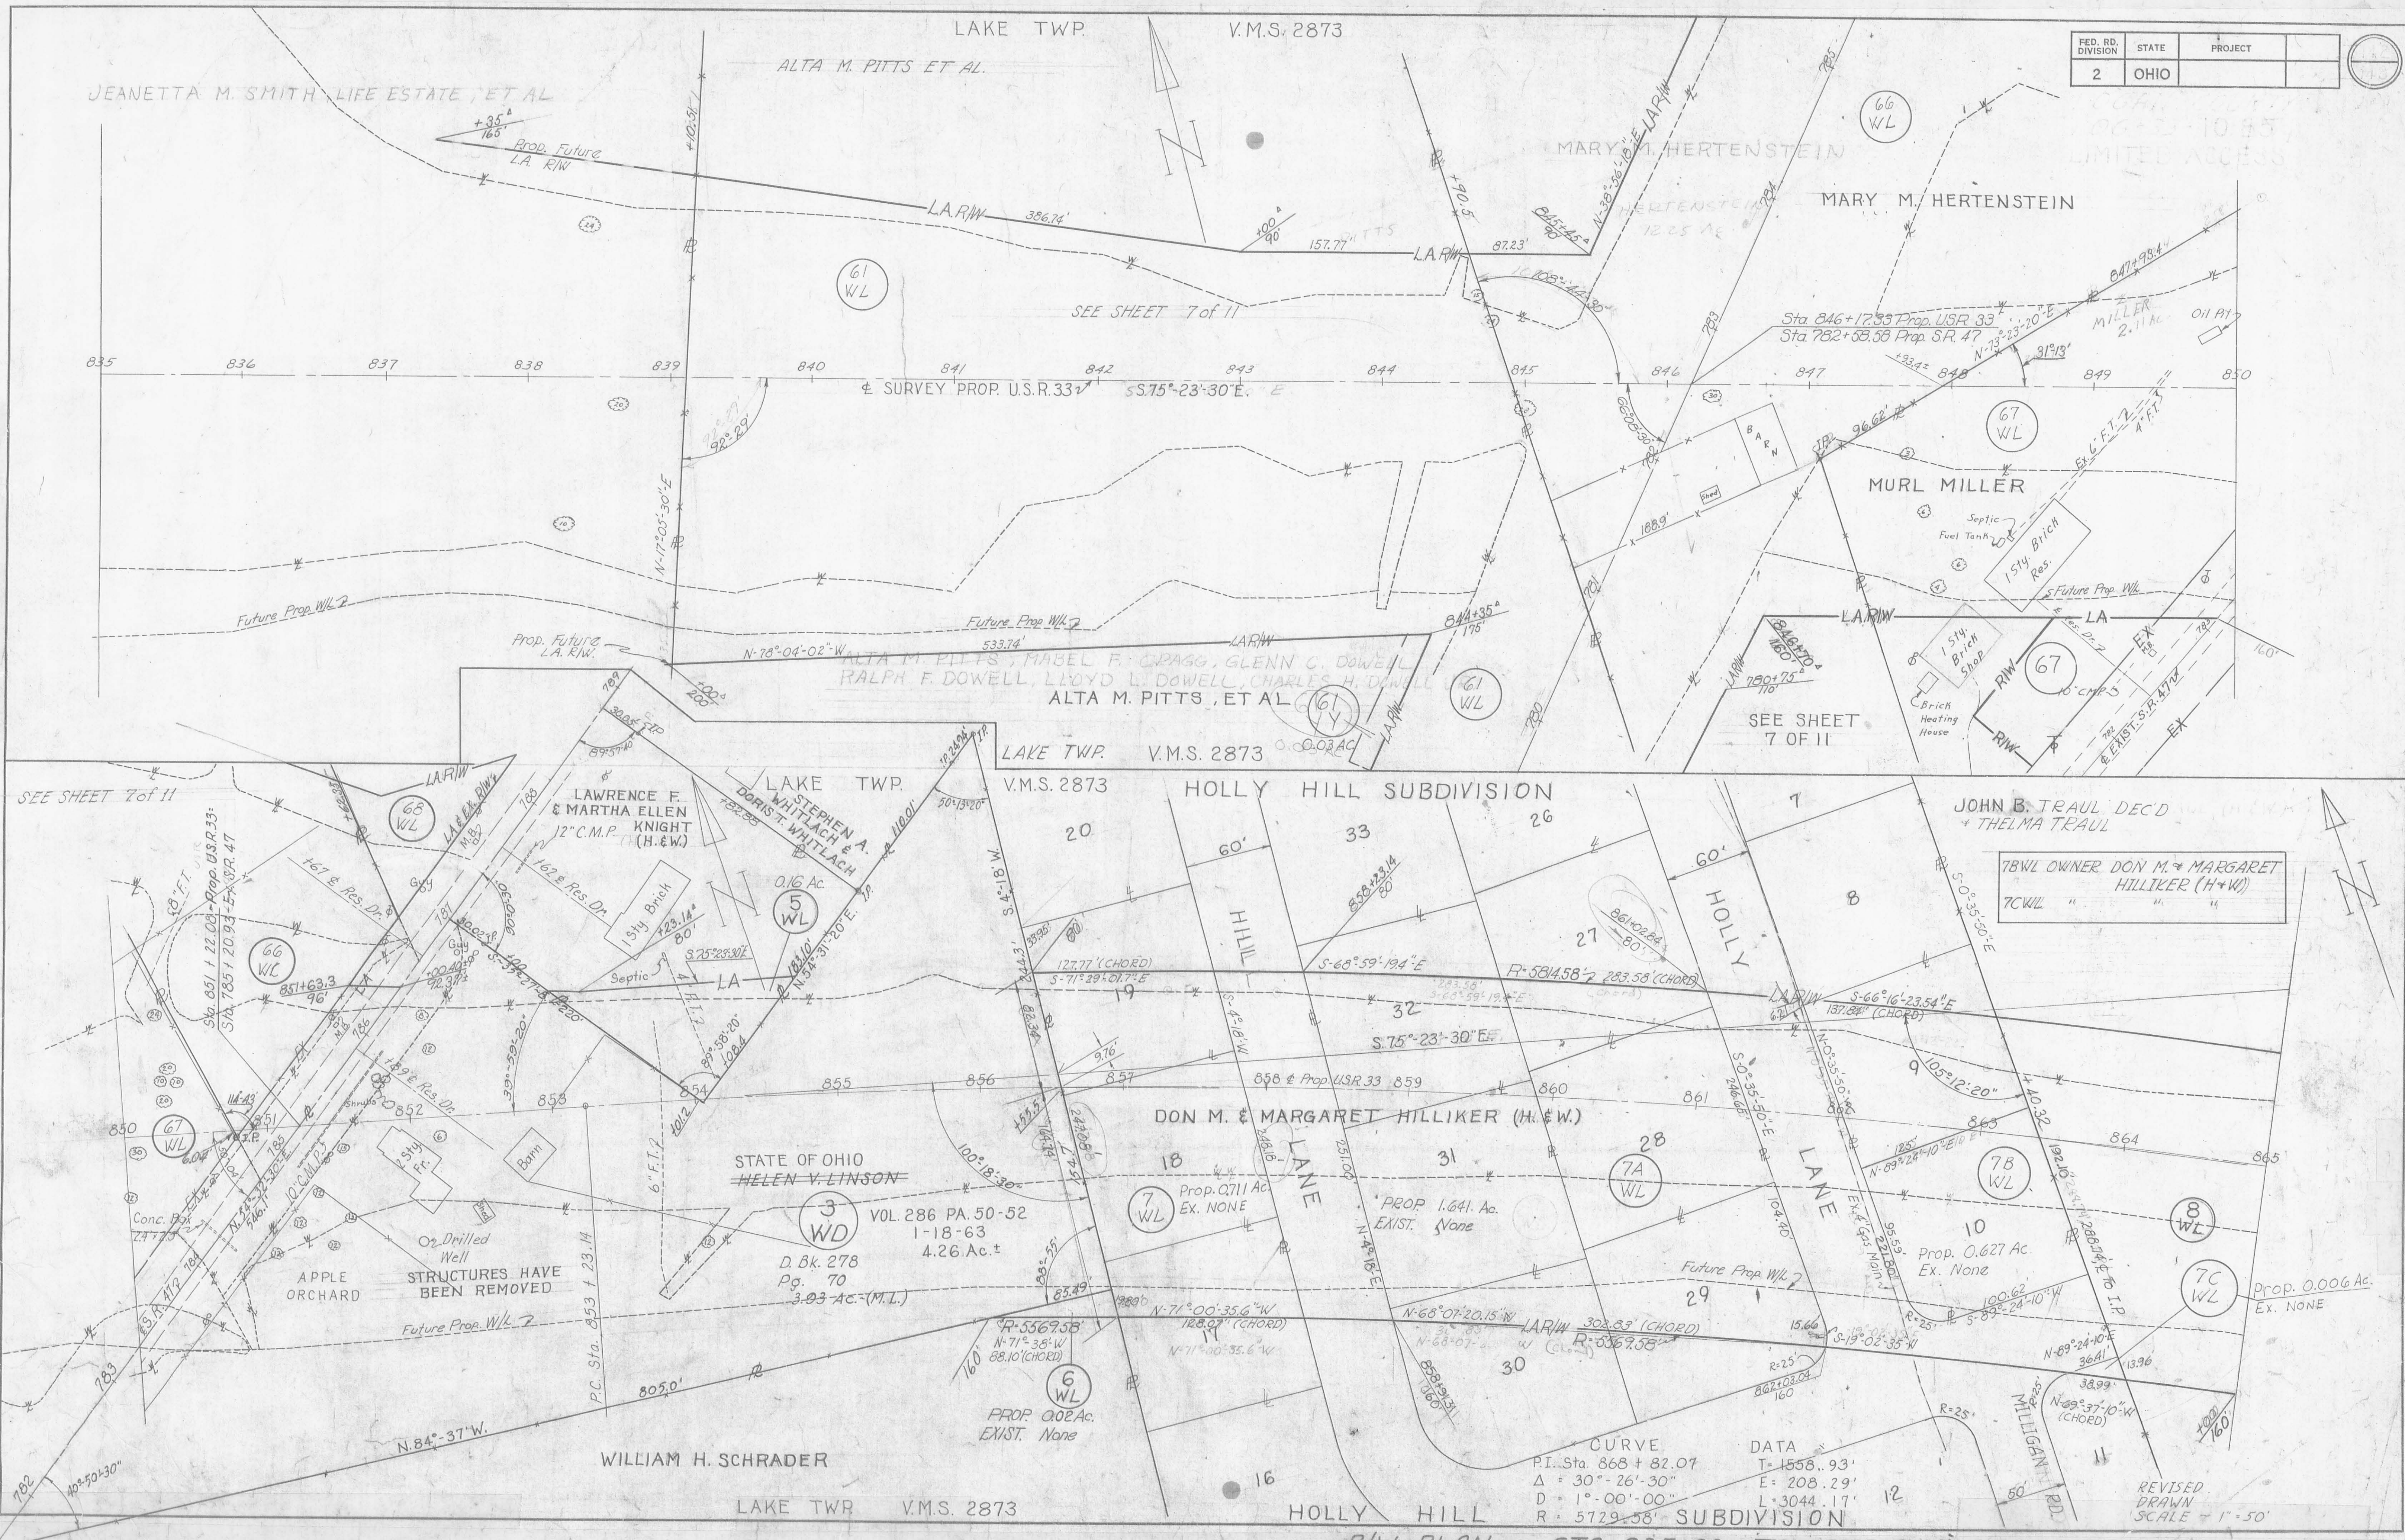

CURVE DATA	
P.I. Sta. 868 + 82.07	T = 1558.93'
$\Delta = 30^\circ - 26' - 30''$	E = 208.29'
D = 1° - 00' - 00"	L = 3044.17'
R = 5729.58'	

REVISED DRAWN SCALE = 1" = 50'

R/W PLAN - STA 835+00 TO STA 865+00