

Surveyed for Ephraim Ralph 651 acres  
of land on part of a Military Warrant  
No. 4096 on the waters of Cherokee-  
mans run; beginning at an ash, black  
and red oak, northeast corner to Joseph  
Hites survey No. 9884 and Northwest  
corner to Walter Luns survey No. 9885  
thence N. 12. W. 392 poles to a hickory  
beech, black ash, and three horsebeans  
thence S. 78. W. 265 poles to a hickory and  
two red oaks northeast corner to Thomas  
Persons survey No. 9906, thence with  
his line S. 12. E. 392 poles to a double  
ironwood southeast corner to said  
Persons survey; thence with a line of Hites survey N. 77° 20' E  
265 poles to the beginning.

No. 9906

651, acres

Levi D Tharp 3  
Hulkiak Rosebag 3 C.C.  
Wilson S Thompson M.h.r.

Samuel Farmer J.S.  
January 10<sup>th</sup> 1820  
March 16<sup>th</sup> 1821

No. 9906

333, acres

Surveyed for Thomas Person 333 acres of land on a Mil-  
itary Warrant No 5448 on the waters of big Miami  
Beginning at a white oak and ash southeast corner  
of Simon Sommers survey No. 9905 northeast corner  
to Mark Hardins survey No. 9883 and Northwest  
corner to Joseph Hites survey No. 9884; thence with  
Hites line N. 77° 20' E 135 poles to a double ironwood  
thence N. 12. W. 395 poles to a hickory and two red  
oaks; thence S. 78. W. 135 poles to a hickory and  
sugar tree northeast corner to Sommers said sur-  
vey; thence with his line S. 12. E. 395 poles cross-  
ing a branch at 126 poles to the beginning.

Levi D Tharp 3  
Hulkiak Rosebag 3 C.C.  
Wilson S Thompson M.h.r.

Samuel Farmer J.S.  
January 10<sup>th</sup> 1820  
March 16<sup>th</sup> 1821

Aug 971

150 acres.

Surveyed for Nathaniel Beale 150 acres of land  
on part of a Military warrant No 5835 on the  
waters of Big Kiamie; beginning at a buck  
eye and ash northeast corner to Michael Bow-  
yers survey No. 9950 and Northwest corner to  
Bowers survey No. 9951, thence N. 12 W. 140° poles to two beeches  
whence S. 78. W. 171 to an elm and buckeye in a line of Temple  
and others survey No. 9971, thence with said line S. 12. E. 140°  
poles to a beech, elm and buckeye, southeast corner to said Tem-  
ple and others survey, in the line of Bowers survey No. 9950;  
thence with said line S. 78. E. 178 poles to the beginning.


Livi D. Sharp  
Michael Roselag B.C.C.

Wilson L. Thompson M.R.

Samuel Ferrer D.S.

March 2<sup>nd</sup> 1820

March 15.<sup>th</sup> 1821

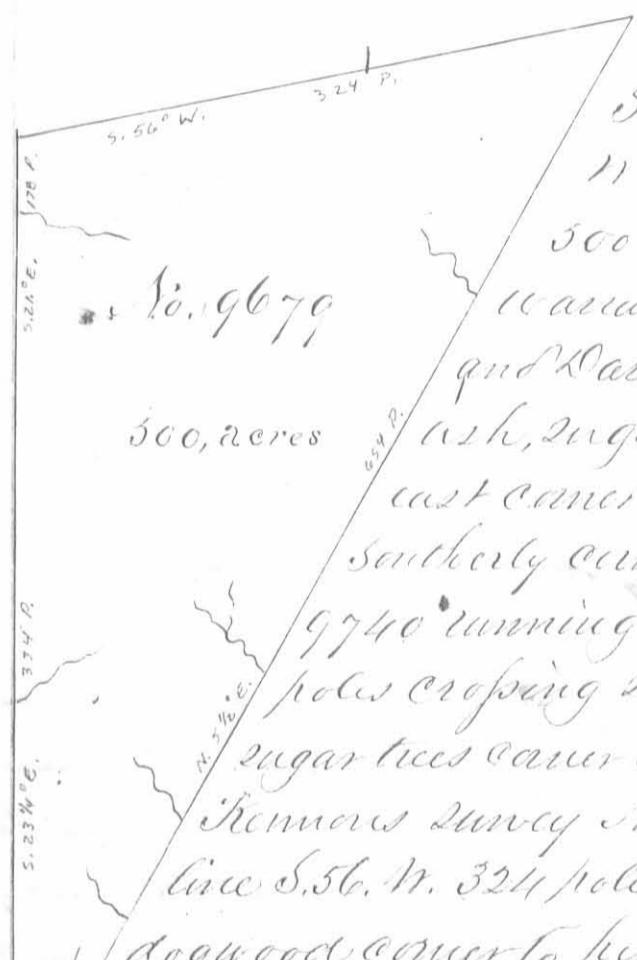


Surveyed for Joseph and Benjamin  
W. Saad and Thomas Howell Esq.  
500 acres of land on part of a Military  
warrant No. 5880 on the waters of Hadrior  
and Parlys creek: Beginning at a live  
ash, sugar tree and two dead mulberries, south  
east corner to Augustine J. Smith's survey No. 3230  
southerly corner to Walter Duns survey No. 9657 &  
9740 running with said Duns line N. 55. E. 654  
poles crossing several branches to a red oak and two  
sugar trees corner to his survey in the line of Richard  
Kennons survey No. 11570; thence with said Kennons  
line S. 56. W. 324 poles to three sugar trees, a lynn and  
dogwood corner to his survey in the line of said Smith's  
survey No. 3228, thence with said Smith's line S. 21. E. 178  
poles crossing a branch to two sugar trees, southeast cor-  
ner to said survey; thence with the line of said Smith's first  
mentioned survey S. 23 1/4 E. 334 poles crossing several bran-  
ches to the beginning.

William Sharp  
Joshua Crain B.C.C.

Samuel Sharp M.R.

James Galloway jun<sup>r</sup> D.S.

November 20<sup>th</sup> 1819

July 25<sup>th</sup> 1820

Surveyed for Thomas Boone,  
700 acres of land on part of  
a military warrant No 64  
on the waters of Big Miami.  
Beginning at an ash beech  
and red oak, south east cor-  
ner to Ephraim Raef's sur-  
vey No. 9906 and Northwest  
corner to Walter Duns Survey  
No 9985; thence with Duns

line N. 77 E. 400 poles to three burr oaks and a beech on the  
North side of a swamp, northeast corner to said Duns survey,  
thence N. 12 W. 278 poles to a stake, thence S. 78 W. 400 poles to  
a stake in Raef's line; thence with his line S. 12 E. 283 poles  
with the course of a branch to the beginning.

Levi D. Sharp  
Hezekiah Rockbag B. C. C.

Wilson S. Thompson M. H. R.

Samuel Fower D. S.  
January 10. 1820  
December 8. 1820

Surveyed for Thomas Boone  
272 acres of land on part of a  
military warrant No 64 on  
the waters of big Miami; be-  
ginning at a hickory, beech

black ash and three haubeans Northeast corner to Ephraim Raef's  
survey No 9906; thence with his line S. 12 E. 109 poles to a stake  
northwest corner to said Boone's survey No 9907 for 700 acres  
thence with his line N. 78 E. 400 poles to a stake in a line of  
Chiswell Barnett's survey No. 9908 and Northeast corner to  
said Boone's survey; thence with Barnett's line N. 12 W. 109 poles  
to a sugar tree hickory, haubean and two beeches Southeast  
corner to Henry Meafies survey No. 9932, thence with his line  
S. 78 W. 400 poles closing a branch at 330 poles to the beginning

Levi D. Sharp  
Hezekiah Rockbag B. C. C.  
Wilson S. Thompson M. H. R.

No. 9907  
272, acres

Samuel Fower D. S.  
January 10<sup>th</sup> 1820  
December 8. 1820

Surveyed for Henry Mapie  
1000 acres of land on three Mil-  
itary Warrants and part of two  
others; No. 5094. 5199. 4069. 5203  
5204. 5208. 5364. 78 acres on 5207  
and 22 acres on 5372 on the wa-  
ters of Big Miami; beginning  
at a hickory, ash, beech and  
hornbeam southeast corner to  
James Taylors survey No 9931  
and Northwest corner to Thomas  
Bounds survey 109907, thence  
with his line N. 78 E. 400 poles

crossing a branch at 70 poles to two beeches a sugar tree and  
hornbeam, thence N. 12 W. 400 poles to a red oak and beech;  
thence S. 78 W. 400 poles to three elms on the bank of a branch  
thence S. 12 E. 400 poles crossing the branch at 90 poles to the  
beginning.

Levi D. Tharp 3  
Hickiah Rosebag 3 G.C.  
Wilson L. Thompson M.R.


Samuel Ferrer Q.S.  
January 18<sup>th</sup> 1820  
December 7<sup>th</sup> 1820

Surveyed for James Barton  
500 acres of land in part of a  
Military warrant No 6053  
on the waters of Big Miami:  
Beginning at three beeches  
southeast corner of James and  
William Taylors survey No 9954 and for the east corner to  
Wallaces survey No 9934 thence N 78 E. 400 poles crossing  
Sandusky road to two beeches; thence N. 12 W. 200 poles cross-  
ing a branch at 126 poles to a stake, thence S. 78 W. 400  
poles crossing two branches to a stake in a line of said Tay-  
lors survey, thence with said line S. 12 E. 200 poles crossing  
a branch at 20 poles to the beginning.

Levi D. Tharp 3  
Hickiah Rosebag 3 G.C.  
Wilson L. Thompson M.R.

No. 9955  
S. 78 W.  
500 acres

Samuel Ferrer Q.S.  
February 28<sup>th</sup> 1820  
December 8<sup>th</sup> 1820

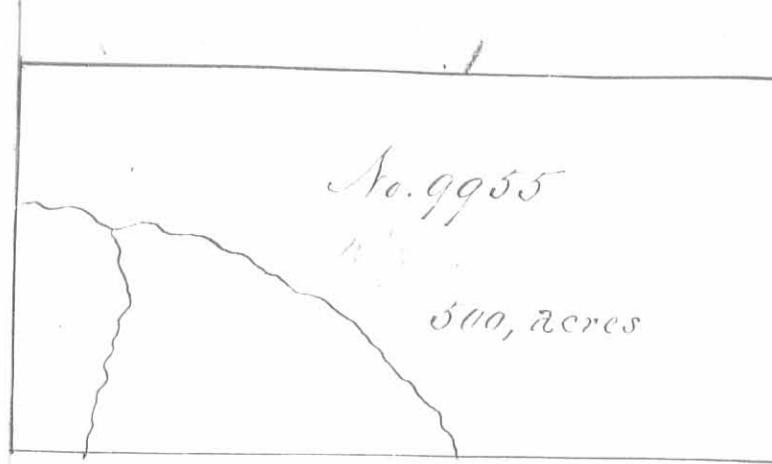

Surveyed for James Barton 500 acres of land on part of a Military War-rant No. 6053 on the waters of Big Miami; beginning at three beeches northeast corner of James and William Taylor's survey No. 9954, thence S. 78 E. 400 poles to a hickory beech and sugar tree, thence S. 12 E. 200 poles to a stake northeast corner to said Bartons survey No. 9955; thence S. 78 W. 400 poles to a stake northwest corner to said survey in a line of said Taylors survey; thence with said line S. 12 E. 200 poles crossing a branch at 130 poles to the beginning.

Levi D. Tharp  
Hezekiah Rosebag & C.C.  
Wilson S. Thompson M.R.





Samuel Force D.S.  
February 28. 1820  
December 8<sup>th</sup> 1820

Surveyed for George Clark as 1000 acres of land on part of a Military No. 5382 on big Miami and Cherokee main run: Beginning at a Burr oak and beech northeast corner of Walter Burns Entry No. 9925, 1200 poles N from the intersection of Roberts line with the Greenville Treaty line, thence N. 78 E. 400 poles crossing the run at 203 at 214 and at 236 poles to a bur oak and elm northeast corner to Nathan Reeder.

Survey No. 9927; thence N. 12 W. 400 poles crossing the Miami at 248 poles to two buckeyes and two sugar trees; thence S. 78 W. 400 poles crossing the Miami at 190 poles and several times afterwards, leaving it at 256 poles to an ironwood and two beeches on the south side of Miami; thence S. 12 E. 400 poles crossing the run at 214 poles to the beginning.

Levi D. Tharp  
Hezekiah Rosebag & C.C.  
Wilson S. Thompson M.R.

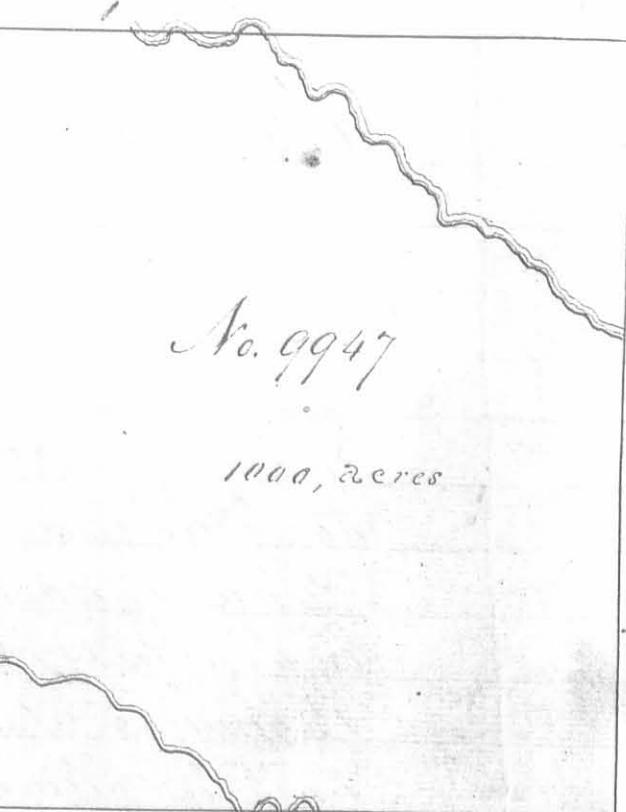





Samuel Force D.S.  
January 26. 1820  
December 8<sup>th</sup> 1820

No. 9948

1000, acres

Surveyed for George Clark 1000 acres of land on part of two "military warrants, 278 acres on No. 3382 and 722 acres on No. 5514 on the waters of Big Miami; beginning at a bur oak and elm southeast corner of said Clark's Survey No. 9947, thence N. 78 E. 400 poles to four oaks north west corner to Robert Means entry No. 9929, thence N. 12 W. 400 poles crossing main branch of Miami to three beeches thence S. 78 W. 400 poles to two sugar trees and two beeches a. northeast corner to Clark and others survey; thence with said line S. 12 E. 400 poles crossing the branch at 152 poles to the beginning.

Lori D Sharp  
Hilkiah Rosebag 3 C.C.

Wilson L Thompson M.k.r.

Samuel Forrester Q.S.  
January 27<sup>th</sup> 1820  
December 8<sup>th</sup> 1820

Surveyed for George Clark, Thomas Miller appt and the Representatives of Thomas Christie 600 acres of land on part of three Military warrants; Clark 175 acres on No. 5513 Miller 200 acres on No. 3538 and Christie 225 acres on No. 6044 on the waters of big Miami; beginning at a sugar tree, hickory hornbeam and two beeches southeast corner of Henry Majestic's Survey No. 9932 and Northwest corner to Christie's Bassett Survey No. 9908; thence with Bassett's line N. 78 E. 240 poles to a stake; thence N. 12 W. 400 poles crossing a branch to a stake; thence S. 78 W. 240 poles to a red oak and beech north east corner to Majestic's said Survey; thence with his line S. 12 E. 400 poles crossing a branch to the beginning.

Lori D Sharp  
Hilkiah Rosebag 3 C.C.  
Wilson L Thompson M.k.r.

No. 9933

600, acres

Samuel Forrester Q.S.  
January 19<sup>th</sup> 1820  
December 9<sup>th</sup> 1820

No. 9933

400, acres

Surveyed for the representatives of Thomas Christie 400 acres of land or part of a Military Warrant No. 6044 on the waters of Big Miami: Beginning at a red oak, elm and sugar tree Northeast corner to Chiswell Parcells survey No. 9908 and Northwest corner to Taylor and others survey No. 9909, thence N. 12. W. 400 poles along a drain at 184 and a branch at 292 poles to three bushes; thence S. 78 W. 160 poles to a stake northeast corner to Clark and others survey No. 9933 for 600 acres; thence with their line S. 12. E. 400 poles crossing the branch to a stake south east corner to said survey in a line of Chiswell Parcells survey No. 9908; thence with said line N. 78 E. 160 poles to the beginning.

Levi D. Sharp  
Hezekiah Rosebag  
William L. Thompson Mfr.

Samuel Forrer D.S.  
January 29<sup>th</sup> 1820  
December 9<sup>th</sup> 1820

No. 9933

200, acres

Surveyed for Thomas Keller up a 200 acres of land on part of a Military Warrant No. 3838 on the waters of the Big Miami: Beginning at a stake in the line of Chiswell Parcells survey No. 9908, Southwest corner to the representatives of Thomas Christie's survey No. 9933; thence with Christie's line N. 12. W. 400 poles along a branch to a stake Northwest corner to said survey; thence S. 78 W. 80 poles to a stake Northeast corner to Clark and Christie's survey No. 9933; thence with their line S. 12. E. 400 poles crossing a branch to a stake southeast corner to said survey in Parcells' said survey; thence N. 78 E. 80 poles to the beginning

Levi D. Sharp  
Hezekiah Rosebag  
William L. Thompson Mfr.

Sam. Forrer D.S.  
December 28<sup>th</sup> 1822  
January 28<sup>th</sup> 1823

No. 9933

400, acres

Surveyed for George Clark &c<sup>a</sup> and the representatives  
of Thomas Christie 400 acres of land on part of  
two Military Warrants, Clark 175 acres on No.  
5513 and Christie 225 acres on & to 6044 on the  
waters of Big Miami: Beginning at a sugar  
tree, hickory, hair beam and two beeches south-  
east corner to Henry Mapies survey No. 9932  
and Northwest corner to Chivell Barnells sur-  
vey No. 9908; thence with Barnells line N. 78°  
E. 160 poles to a stake, thence N. 12. W. 400 poles  
crossing a branch to a stake; thence S. 78 W. 160  
poles to a red oak and beech northeast corner to  
said Mapies said Survey; thence with his line  
S. 12 E. 400 poles crossing a branch to the beginning.

Lori D' Sharp      3  
Hilkiah Rosebag 3 C.C.

Wilson S. Thompson M.k.r.

Sam'l Forrer D.S.  
December 28<sup>th</sup> 1822.  
January 28<sup>th</sup> 1823

Surveyed for the representatives of  
Wicroughly Gibbs, John Gibbs and  
Mark Vanderwall 959 acres  
of land on part of three Military  
Warrants; the representatives of Gibbs  
370 acres on No. 5404, John Gibbs  
500 acres on No. 4916 and Van-  
derwall 89 acres on No. 139 on the  
waters of Boches Creek: Beginning at  
a beech and two sugar trees south  
east corner to James Taylor's sur-  
vey No. 9914 and Northeast

No. 9915

959, acres

corner to Ransdale and others survey No. 9893; thence with the line  
of Survey No. 9893 N. 78 E. 400 poles, crossing a branch at 358  
poles to an ash sugar tree and lynn northeast corner to said sur-  
vey; thence N. 12 W. 383 poles to a Maple ash and spanish oak;  
thence S. 78 W. 400 to a beech and two sugar trees northeast corner  
to Taylors said Survey; thence with his line S. 12 E. 383 poles to the  
beginning.

Lori D' Sharp      3  
Hilkiah Rosebag 3  
Wilson S. Thompson M.k.r.

Samuel Forrer D.S.  
January 14<sup>th</sup> 1820  
March 9<sup>th</sup> 1821

Surveyor for Walter Duwafre 502 acres of land on part  
of nine Military warrants, 200 acres on No 5885 64 acres  
on No. 5749, 8 acres on No 6124, 80 acres on No 5887. 11  
acres on No. 5963, 13 acres on No 6064 6 acres on No 5765  
72 acres on No 5916, and 48 acres on No 6173 on the waters  
of Mad River: Beginning at two white oaks, south-  
easterly corner to Holland Haneys


Survey No 3222 and Northwesterly corner  
corner to said Haneys survey No 3224  
thence with the line of survey No 3222  
N. 21 W. 320 poles to a black oak and  
hickory Northwesterly corner corner to Survey  
No 3222, thence S. 69 W. 68 poles crossing a  
spring branch at 34 poles to a white oak  
and red oak the most southerly corner to said  
Duns survey No. 9592, 9618 & 10075, thence A 86.

or 45 poles to two hickories and a white oak corner to Duns said  
Survey in the line of Anthony Singletors Survey No. 4943, thence  
with said line S. 20 E. 198 poles crossing a branch at 97 poles to  
two white oaks and a black walnut easterly corner to Single-  
tors said survey, thence with another of his lines S. 70 W. 190 poles  
to three black oaks from one root his south easterly corner in  
the line of Samuel Finleys survey No. 4193 & 4525, thence with  
said line S. 20 E 133 poles to a black oak and hickory in said  
line a Northerly corner to Jadock Walkers survey No 6516  
thence N. 70 E. 100 poles to a hickory the most northerly corner  
to Walkers said survey; thence S. 20 E. 182 poles crossing a small  
branch at 123 poles to a stake in the line of Thomas Wor-  
thingtons survey No 4479 and easterly corner to Walkers said  
survey; thence with Worthington's line N. 70 E 80 poles, crossing  
the prairie branch at 20 poles to a stake in said line, thence  
A. 21 W. 121 poles crossing the prairie branch to two black oaks  
thence N. 69 E 127 poles crossing the prairie branch at 40 poles  
to three hickories in the line of said Haneys survey No. 3224  
thence with said line A. 21 W. 54 poles to the beginning.

Cawley Pope

Train Recd at 3. 06

Aaron Hunt M.h.r.

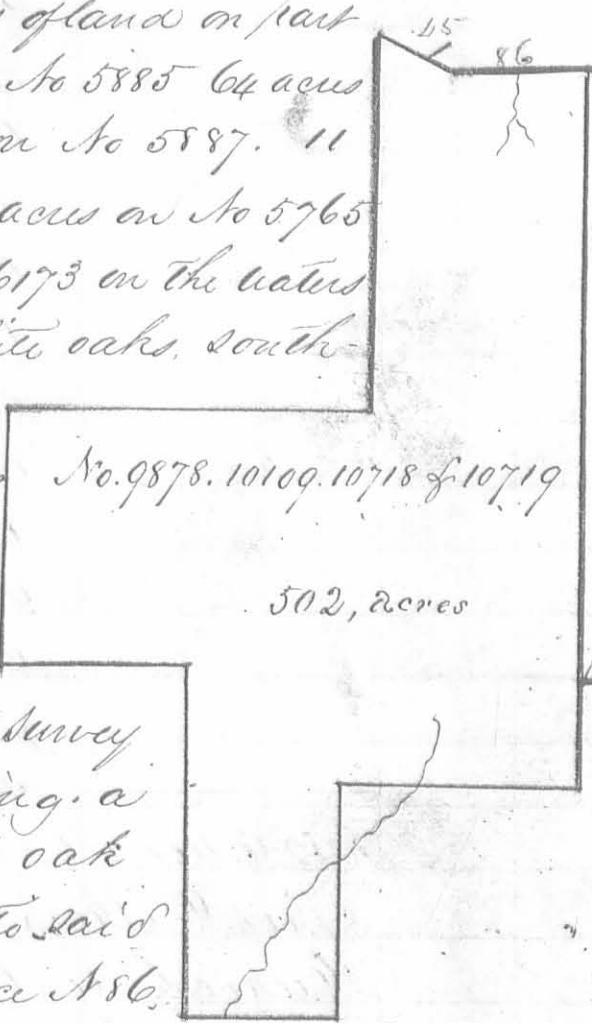

No. 9878. 10109. 10718 & 10719

502, acres

Thomas J. McArthur Q.S.

July 2<sup>nd</sup> 1821

July 21<sup>st</sup> 1821

No. 9990

Surveyed for Ephraim Raefle  
1000 acres of land on part of a  
Military Warrant No. 4906 on  
the waters of the Big Miami:  
Beginning at a small ash and  
two beches southeast corner of  
Thomas Oerton Survey No. 9989  
thence N. 78 E. 400 poles crooping  
the main branch of Miami at  
144 poles to a beech sugar tree  
and dogwood northeast corner  
of Robert Meaus Survey No.  
9973, thence N. 12. W. 400 poles  
crooping the branch at 240 poles to an elm and two live oaks  
thence S. 78. N. 400 poles crooping a branch at 342 poles to two  
beches, thence S. 12. E. 400 poles with the line of said Oerton  
survey to the beginning.

Levi D. Sharp  
Nikiah Roselrag  
Wilson L. Thompson M.h.s.

Samuel Forre D.S.  
March 9<sup>th</sup> 1820  
July 21<sup>st</sup> 1820


Surveyed for Oliver Barrett, 481 acres of land  
on part of a Military warrant No. 2257 on the  
waters of big Miami and Rush Creek; beginning  
at three live oaks and a beech southeast corner  
to Thomas Bourne's survey No. 9907 and northeast  
corner to Walter Davis survey No. 9885, thence  
with a line of entry No. 9886 N. 77 $\frac{1}{2}$  E. 199 $\frac{1}{2}$   
poles to a stake; thence N. 12. W. 385 poles  
crooping a small branch to a stake; thence  
S. 78. W. 199 $\frac{1}{2}$  poles to a live beam, sugar tree  
hickory and two beches, northeast corner  
to said Bourne's survey; thence with his  
line S. 12. E. 387 poles crooping a branch to the beginning.

Levi D. Sharp  
Nikiah Roselrag  
Wilson L. Thompson M.h.s.

Samuel Forre D.S.  
January 10<sup>th</sup> 1820  
December 12<sup>th</sup> 1820

No. 9908

481, acres

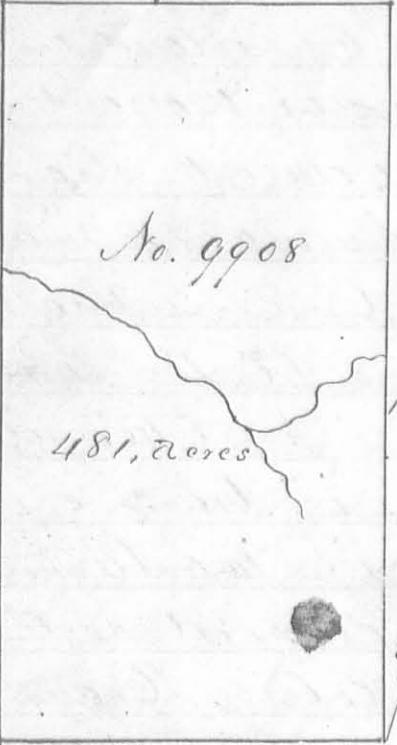

Surveyed for Chiswick Barrett 481 acres of land on part of a military warrant No 2237 on the waters of big Miami and Rush creek: Beginning at a blue ash and beech northwest corner of site and others survey No. 9887; thence N 12 W. 383 poles to a red oak elm and sugar tree; thence S. 78 W. 200 $\frac{1}{2}$  poles to a stake northeast corner to said Barrett and others survey No. 9908; thence with his line S 12 E. 383 poles crossing a small branch to a stake southeast corner to Barrett said survey in a line of Entry No 9886, thence with said line S. 77 $\frac{1}{2}$  E. 200 $\frac{1}{2}$  poles to the beginning.

Levi D Tharp  
Hilkiah Roselrag  
Woron L Thompson M.h.r.

Samuel Force D.S.  
January 10<sup>th</sup> 1820  
December 12<sup>th</sup> 1820

Surveyed for Charles Lewis 1000 acres of land on part of a military warrant No. 4688 on the waters of Big Miami; beginning at a sugar tree and hickory southeast corner of Robert Means survey No. 9928 and Northwest corner to Simon Sommers survey No. 9005; thence with Sommers line S. 78 E. 400 poles to a hickory and sugar tree northeast corner to survey No. 9905, thence N 12 W.

400 poles to an elm and three dogwoods; thence S. 78 W. 400 poles to a stake in a field Northeast corner to said Means survey No. 9930, thence with his line S 12 E. 400 poles crossing a branch at 138 and one at 372 poles to the beginning.

Levi D Tharp  
Hilkiah Roselrag  
Woron L Thompson M.h.r.

No. 9930  
1000. acres

Samuel Force D.S.  
January 18<sup>th</sup> 1820  
December 11<sup>th</sup> 1820

Surveyed for James Taylor a/sr and William Robinson and James Morrison ass't 351 $\frac{1}{6}$  acres of land on part of two military warrants, Taylor and Robinson 444 $\frac{1}{6}$  acres on No 5330 and Morrison 106 $\frac{1}{3}$  acres on No 5343 on the waters of Big Miami; beginning at two beeches northeast corner to the representatives of Robert Young's survey No 9970; thence with said Young's line S. 78 W. 221 poles to a hickory and elm Southeast corner to William Robinson's survey No 9987; thence with his line N 12 W 400 poles crossing a drain at 112 and North fork of Miami at 316 poles to two ironwoods and a beech northeast corner to said Robinson's survey; thence N. 78 E. 221 poles crossing the fork at 100 poles to a beech; thence S. 12 E. 400 poles to the beginning.

Sam'l D. Tharp  
Milikiah Roselrag

Mic'm L. Thompson M.h.s.

Samuel Forrer Q.S.  
May 7<sup>th</sup> 1820  
March 9<sup>th</sup> 1821


Surveyed for Thomas Overton 1000 acres of land on part of a Military warrant No. 44 on the waters of Big Miami: Beginning at an Elm and Hackberry Southeast corner of the representatives of Nathaniel Burwick and others, survey No 9988; thence N. 78 E. 400 poles crossing Hales Trail at 250 poles to a small ash and two beeches; thence North 12 W 400 poles crossing a branch at 200 poles to two beeches; thence S. 78 W 400 poles to three beeches; thence S. 12 E. 400 poles to the beginning.

Sam'l D. Tharp  
Milikiah Roselrag 366.  
Mic'm L. Thompson M.h.s.

No. 9989

1000, acres

Sam'l Forrer Q.S.  
March 9<sup>th</sup> 1820  
July 21<sup>st</sup> 1820

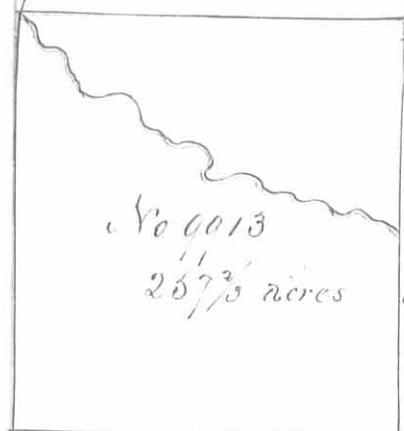



Surveyed for John Swan and James Taylor upon  
25 1/3 acres of land on part of a Military Warrant -  
No. 3451 on Boker creek; beginning at a buckeye  
bur oak, ash and hickory on the bank of the creek, north  
east corner to Nicholas Galia's survey No. 9912, thence  
S. 78° E. 200 poles to two beeches; thence S. 12° E. 213 poles  
crossing the creek to bur oak and lynn; thence S. 78°  
W. 200 poles to two beeches and two small beeches northeast corner to  
John Pidd's survey No. 9013 in Galia's line; thence with said line N.  
12° W. 213 poles to the beginning.

Lori D. Thorpe  
Hilkiah Rosebag 3 C.C.  
William L. Thompson M.C.R.


Samuel Foster Q.S.  
January 15<sup>th</sup> 1820  
March 12<sup>th</sup> 1821

Surveyed for John Swan and James Taylor upon 25 1/3 acres  
of land on part of a Military Warrant No. 3451 on Boker creek;  
beginning at a hickory and two beeches northeast corner to Willis  
and others survey No. 9913; thence S. 12° W. 213 poles to a buckeye  
and two ashes on the west edge of a small pond; thence S. 78° W. 200  
poles to two beeches northeast corner to said Swan and Taylor &  
others survey No. 9913, thence with their line S. 12° E. 213 poles to a  
bur oak and lynn southeast corner of said survey; thence with Willis and others  
line S. 78° E. 200 poles crossing Boker creek at 46 rods to the beginning.

Lori D. Thorpe  
Hilkiah Rosebag 3 C.C.  
William L. Thompson M.C.R.

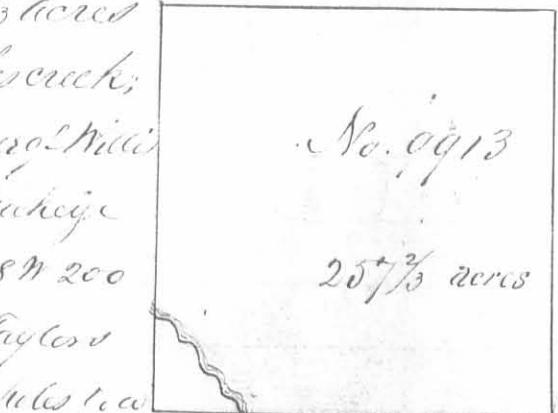

Samuel Foster Q.S.  
January 12<sup>th</sup> 1820  
March 12<sup>th</sup> 1821

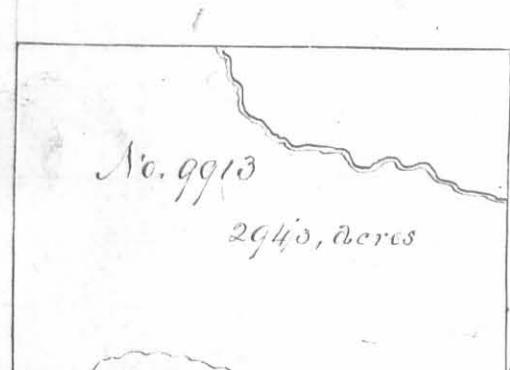

No. 9913  

Surveyed for the proprietors of John Willis, George  
Hanning and John Pidd 29 4/5 acres of land on  
the following Military Warrant; Willis 14 4/5  
acres on part of No. 5464, Hanning 50 acres on  
part of No. 545 and Pidd 100 acres on part  
of No. 3855 on Boker creek; beginning at an  
ash cherry tree and box elder on the bank of a branch northwest corner to James Taylor's sur-  
vey No. 9892; thence N. 12° W. 170 poles crossing Boker creek at 84 poles to a hickory and  
two beeches; thence S. 78° W. 259 poles crossing the creek at 154 poles to three small beeches  
thence S. 12° E. 170 poles to a beech and three lynes in the north line of William Roberts  
and others survey No. 9891, thence with said line S. 78° E. 259 poles to the beginning.

Lori D. Thorpe  
Hilkiah Rosebag 3 C.C.  
William L. Thompson M.C.R.

Samuel Foster Q.S.  
January 12<sup>th</sup> 1820  
March 12<sup>th</sup> 1821

No. 9913

106, acres

Surveyed for John Podd 100 acres of land on part of a Military Warrant No. 5355 on the water of Bokes Creek; beginning at three beeches southeast corner to Nicholas Galiferro's survey No. 9912 and northwest corner to William Hobart and others survey No. 9891, thence with their line S. 75. E. 94 poles to a beech and lynn; thence N. 12. W. 170 poles to an ironwood and two small beeches; thence S. 75. N. 94 poles to a buckey and two small beeches in said Galiferro's line; thence with said line S. 12. E. 170 poles to the beginning.

Levi D. Sharp  
Hilkiah Rosebag B.C.

Wilson L. Thompson M.R.

Samuel Ferrier Q.S.  
January 12<sup>th</sup> 1820  
March 13<sup>th</sup> 1821

Surveyed for George Heming 50 acres of land on part of a Military Warrant No. 5145 on the water of Bokes Creek; beginning at a beech and lynn southeast corner to John Podd's survey No. 9913 in the north line of William Hobart and others survey No. 9891. 94 poles from the North west corner of said survey; thence with said line S. 78. E. 47 poles to a beech and three lynes southeast corner to Willi's Heming and Podd's survey No. 9913; thence with their line S. 12. N. 170 poles to three small beeches in a line of Swan and Taylors survey No. 9010; thence with their line S. 78. W. 47 poles to an ironwood and two small beeches northeast corner to John Podd's and Survey; thence with said line S. 12. E. 170 poles to the beginning.

Levi D. Sharp  
Hilkiah Rosebag B.C.

Wilson L. Thompson M.R.

Samuel Ferrier Q.S.  
January 12<sup>th</sup> 1820  
March 13<sup>th</sup> 1821

No. 9893

472, acres

Surveyed for Maria and John C. Rawdale heirs, and James Taylor 472 acres of land on part of a Military Warrant No. 5426 on the water of Bokes Creek; beginning at a lynn and two beeches southeast corner of James Taylor's survey No. 9892 in the boundary line; thence with said line S. 78. E. 189 poles to three small ironwoods; thence N. 12. W. 400 poles crossing Bokes creek to a sugar tree and two beeches; thence S. 78. W. 189 poles to a beech and two sugar trees, northeast corner to said Taylor's survey; thence S. 12. W. 400 poles crossing the creek as 166 poles to the beginning.

Levi D. Sharp  
Hilkiah Rosebag B.C.

Wilson L. Thompson M.R.

Samuel Ferrier Q.S.  
January 6<sup>th</sup> 1820  
March 13<sup>th</sup> 1821

No. 9893

528, acres

Surveyed for Maria and John C. Ransdale heirs, and James Taylor ap<sup>e</sup> and Charles Scott 528 acres of land on part of two Military Warrants Rawdale and Taylor 472 acres on No. 5426 and Scott 56 acres on No. 5436 on the waters of Boke creek; beginning at three small ironwood southeast corner to Rawdale and Taylors survey No. 9893, in the boundary line; thence N. 78 E. 211 poles to a sugar tree and beech; thence N. 12 W. 400 poles crossing Boke creek at 84 and a branch at 120 poles to an ash and sugar tree and lynn; thence S. 78 W. 211 poles crossing a branch at 42 poles to a sugar tree and two beeches northeast corner to Rawdale and Taylors said survey; thence with their line 812 E. 400 poles crossing the creek to the beginning.

Sam'l D. Sharp  
Hezekiah Rosebrag & Co.

Wilson L. Thompson M.k.r.

Samuel Foster Q.S.  
January 6<sup>th</sup> 1820  
March 13<sup>th</sup> 1821

Surveyed for James Taylor ap<sup>e</sup> 1000 acres of land on part of a Military Warrant No. 5434 on the waters of Boke Creek: Beginning at an ash hornbeam and two beeches in the Greenville tract line southeast corner to William Roberts and others survey No. 9891 therewith said tract line N. 78 E. 400 poles to a lynn and beech thence N. 12 W. 400 poles crossing a branch at 334 poles to a beech and two sugar trees, thence S. 78 W. 400 poles crossing the branch to an ash, cherry tree and box elder on the bank of a branch; thence S. 12 W. 400 poles to the beginning.

Sam'l D. Sharp  
Hezekiah Rosebrag & Co  
Wilson L. Thompson M.k.r.


No. 9892

1000, acres

Samuel Foster Q.S.  
January 5<sup>th</sup> 1820  
March 14<sup>th</sup> 1821

No. 9929

1000 acres

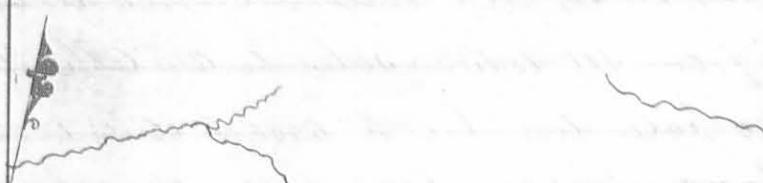

Surveyed for Robert Means of  
1000 acres of land on part of a mili-  
tary warrant No. 5351 on the wa-  
ters of Big Miami: Beginning at  
a black ash, hickory and elm  
northeast corner to Robert Gam-  
bles Survey No. 9904, thence  
with his line N. 78° E. 400 poles  
crossing a branch at 140 poles  
and Rudd's road at 274 poles  
to a hickory and sugar tree  
thence N. 12° W. 400 poles cross-  
ing a small branch at 22  
and one at 262 poles to a white oak and black oak both  
dead in Robert Armstrong's field; thence S. 75° W. 400 poles crossing  
a prairie from 22 to 316 poles and a swamp from 316 to 356 poles  
to four arms, thence S. 12° E. 400 poles crossing the prairie from 106  
to 336 and a small branch at 338 poles to the beginning.

George Henry 3.

James Henry 3 C. C.

Benjamin McCulloch M. k. r.


Thomas J. McCullow Q. S.

January 18<sup>th</sup> 1821

March 30<sup>th</sup> 1821

Surveyed for Robert Means of  
1000 acres of land on part of a  
Military warrant No. 5351 on  
the waters of Scioto: Beginning  
at two sugar tree, hickory and  
beech, Northeast corner to James  
Burton's survey No. 9955 and  
southeast corner to Francis Morris  
Survey No. 9976, thence N. 12° W.  
400 poles crossing a small branch  
at 48 and one at 81 poles to three  
beeches and a sugar tree, thence  
N. 78° E. 400 poles crossing a drain  
at 136 and a Sandusky road at 240 poles to a bar oak, buck and  
small blue ash; thence S. 12° E. 400 poles crossing a branch at 346 poles to two beeches  
thence S. 78° W. 400 poles crossing the Sandusky road at 230 a branch at 302 one at 314 and  
at 348 poles to the beginning.

James Henry

Thomas H. Kellogg 3 C. C.

James G. Donaldson M. k. r.

No. 9977

1000 acres





Thomas J. McCullow Q. S.

January 22<sup>nd</sup> 1821

March 30<sup>th</sup> 1821

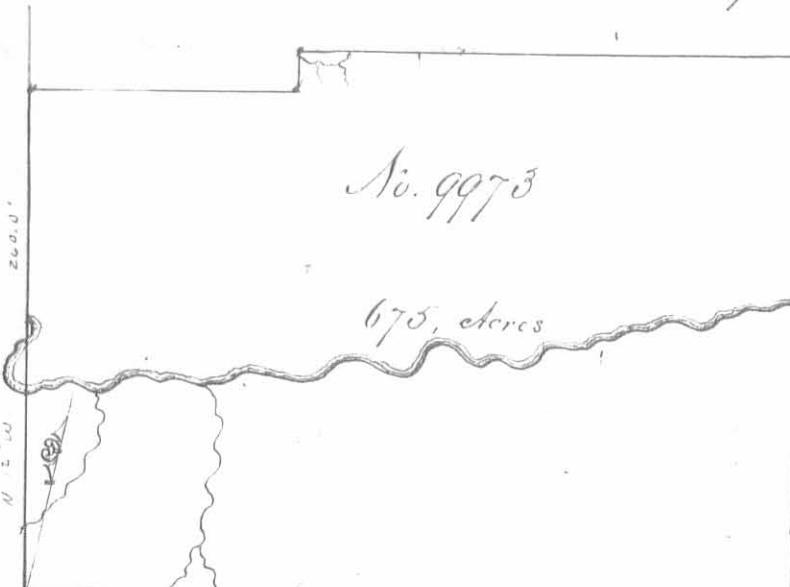

Surveyed for Robert Means above 675 acres of land on part of three Military Warrants, 400 acres on No. 5383, 200 acres on No 5184 and 75 acres on No 5169 on Big Miami: Beginning at a beech ash and buckeye southeast corner to the representatives of John Gil- lion and others entry No 9972; thence with their line N 12 W. 260 poles crossing a small branch at 36 and the Miami from 110 to 132 poles to an ash sugar tree and oak; thence N. 78. E. 140 poles to a beech and small ironwood; thence N. 12 W. 16 poles crossing a branch at 12 poles to an ash and elm in a swamp; thence N. 78 E. 260 poles crossing a branch at 21 a beaver pond at 24 to 30 poles to a hickory, buckeye and two beeches; thence S. 12. E. 276 poles crossing the Miami at 126 poles to two beeches and a sugar tree; thence S. 78. W. 400 poles crossing the middle fork of Miami at 290 and a spring branch at 310 poles to the beginning.


George Henry 3  
James Henry 3 66

Benjamin McCollum M.k.r.

Thomas J. McArthur Q.S.  
January 15<sup>th</sup> 1821  
March 30<sup>th</sup> 1821.

Surveyed for Robert Means above 1000 acres of land on a Military Warrant No. 5359 and 666 $\frac{2}{3}$  acres on part of No. 5351 on Rush Creek; beginning at four beeches and a white ash south east corner to Alexander Parkers survey No 9958; thence with his line N. 12. W. 400 poles crossing Rush creek at 90 and a branch at 222 poles to three elms and two buckeyes; thence N. 78. E. 400 poles to a white oak a small beech, ironwood and sugar tree; thence S. 12. E. 400 poles crossing the creek at 150 a branch at 296 and one at 387 poles to a red oak small sugar tree and small beech; thence S. 78. W. 400 poles crossing a branch at 10 poles to the beginning.

James Henry 3  
Thomas A. Kellogg 3 C.6.  
James E. Donaldson M.k.r.

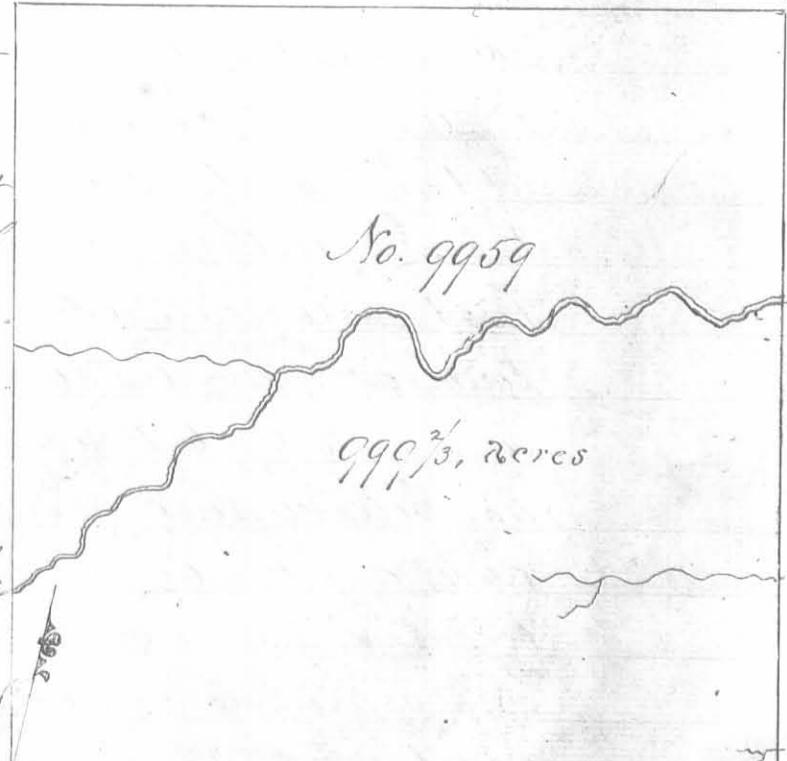

Thomas J. McArthur Q.S.  
February 2<sup>nd</sup> 1821  
March 30<sup>th</sup> 1821

Surveyed for James Taylor ap<sup>w</sup>  
1000 acres of land on the following  
military warrants 888 $\frac{2}{3}$  acres  
on No. 5392- 100 acres on No. 5376  
and 11 $\frac{1}{3}$  acres on part of No. 5372  
on the waters of big Miami;  
beginning at a hickory and sugar tree southeast corner to Charles  
Lewis survey No. 9930 and north  
west corner to Pierce and Ralph  
survey No. 9906, thence with a  
line of No. 9906 N. 78. E. 400 poles  
crossing a branch at 316 to a

hickory, beech ash and hawbeam; thence N. 12. W. 400 poles crossing  
a branch at 310 poles to three elms on the bank of a said branch  
thence S. 78. W. 400 poles to an elm and three dogwoods northeast  
corner to Lewis said Survey; thence with said line S. 12. E. 400 poles  
to the beginning.

Hezekiah Rosebag

Levi D. Sharp - C. O.

Wilson J. Thompson M. R.

Sam'l Forrer Q. S.

January 18<sup>th</sup> 1820

Surveyed for Hubbard Myall execu-  
tor 280 acres of land on two military  
warrants No. 6262 and 6265 on  
the waters of Rush Creek: beginning  
at a red oak, elm and sugar tree southeast corner to George Clark's  
survey No. 9933; thence with a line of Taylor and others survey  
No. 9909 N. 78. E. 395 poles to a sugar tree; thence N. 12. E. 1134 poles  
to a sugar tree and iron wood; thence S. 78. W. 395 poles cross-  
ing a branch of big Miami at 267 at 335 poles to a red oak  
beech and sugar tree; thence S. 12. E. 1134 poles to the begin-  
ning.

Levi D. Sharp

Hezekiah Rosebag C. O.

Wilson J. Thompson M. R.

No. 9934

280, acres

N. 78 E. 395

Samuel Forrer Q. S.

January 20<sup>th</sup> 1820

January 27<sup>th</sup> 1821

No. 9934

716 $\frac{2}{3}$ , acres

Surveyed for the representatives of David Wallace 716 $\frac{2}{3}$  acres of land on part of a military warrant No 5888 on the waters of Rush creek and big Miami; beginning at a red oak beech and sugar tree North west corner to Hubbard Wyatts survey No. 9934 in the line of George Clark's Survey No 9933, thence with said line N.12.W. 286.6 poles to three beeches North east corner of said Survey, thence N.78.E 400 poles to three beeches; thence S.12.E 286.6 poles to a buck, lynn and sugar tree Northwest corner to Wyatts survey No 9934, thence with his line S.78.W. 400 poles crossing a branch of Miami at 272. and one at 340 poles to the beginning.

Levi D Sharp  
Hilkiah Rosebag B.C.


Wilson S Thompson M.k.r

Samuel Forrer D.S.  
January 20<sup>th</sup> 1820  
January 27<sup>th</sup> 1821

Surveyed for Michael Bowyer 1000 acres of land on part of a military warrant No 3224 on the waters of the Big Miami: Beginning at a stake in a field near Solomons town Southeast corner to said Bowyers survey No. 9949 and Northeast corner to Charles Lewis survey No. 9930; thence with said line N.78.E. 400 poles to an elm and three dogwoods; thence N.12.W. 400 poles, crossing a large branch


at 202 poles to a buckeye and ash; thence S.78.W. 400 poles crossing the branch at 280 poles to two hickories Northeast corner to Bowyers said survey; thence with his line S.12.E. 400 poles to the beginning.

Levi D Sharp  
Hilkiah Rosebag B.M.K.R.  
Wilson S Thompson M.k.r

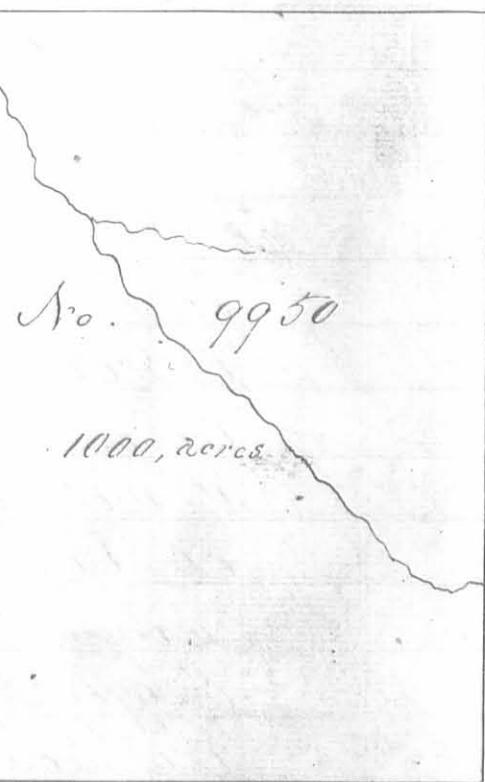

Samuel Forrer D.S.  
January 29<sup>th</sup> 1820  
November 30<sup>th</sup> 1820

194

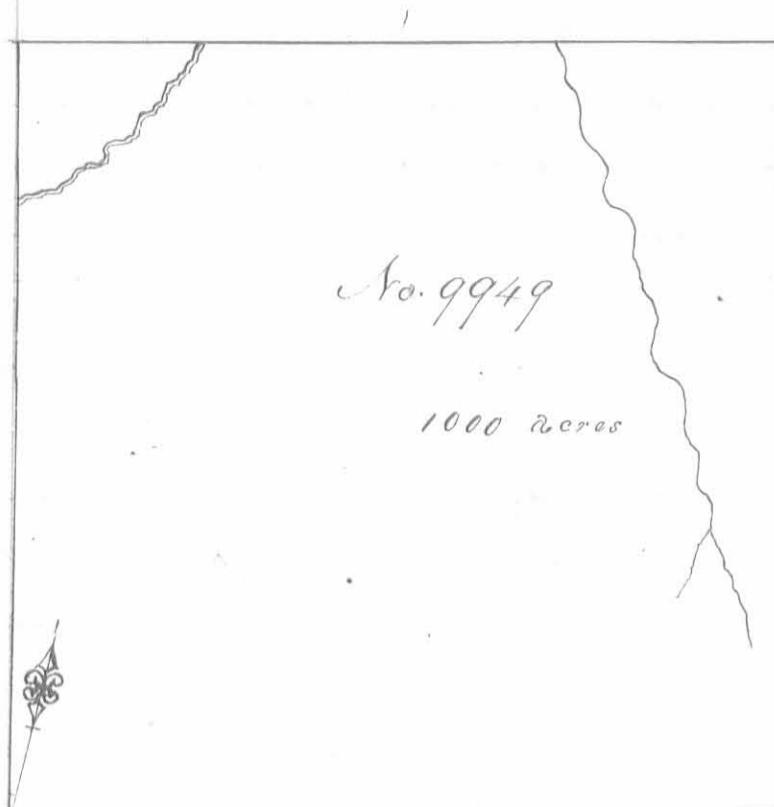

Surveyed for Michael Bouyer  
1000 acres of land on part of a  
Military Warrant No 3224 on  
the big Miami: Beginning at  
four elms southeast corner of  
George Clarks survey No. 9948  
and Northwest corner to Robert  
Means survey No 9929; thence  
with Means line N. 78. E. 400  
poles to a stake in a field; thence  
N 12 W 400 poles to two hickories  
thence S. 78. W. 400 poles crossing  
a branch at 118 poles and the

big Miami at 302 poles to three beeches; thence with Clarks  
line S. 12. E. 400 poles crossing the big Miami to the beginning.

Levi D. Tharp 3  
Kirkiah Rosebag 3 C.C.

Wilson S. Thompson M.L.R.


Samuel Forrey D.S.

January 28<sup>th</sup> 1820

November 30. 1820


Surveyed for Michael Bouyer  
1000 acres of land on part of a  
Military Warrant No 3224  
on the waters of big Miami;  
beginning at an elm and three  
dogwoods; Southeast corner  
of said Bouyers Survey No 9950  
thence with a line of James  
Taylor's survey No 9931 N. 78 E.  
400 poles to three elms on the  
bank of a large branch; thence  
N. 12. W. 400 poles to a beech  
and two buckeyes, thence S. 78. W. 400 poles to an ash and buck-  
eye northeast corner to Survey No 9950, thence with a line of said  
Survey S. 12. E. 400 poles crossing said branch at 198 poles to the  
beginning.

Levi D. Tharp 3  
Kirkiah Rosebag 3 C.C.  
Wilson S. Thompson M.L.R.

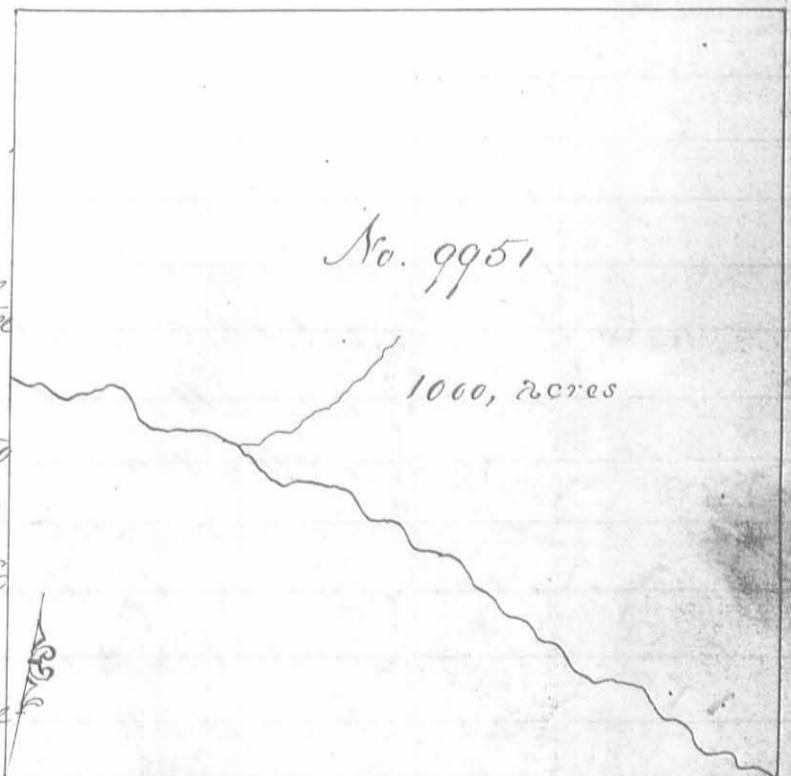

Samuel Forrey D.S.  
Aug 29. 1820  
November 30. 1820

196

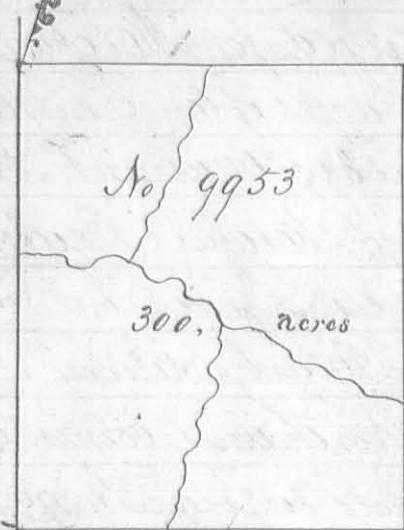


Surveyed for James Fitzpatrick 300 acres of land on part of a Military Warrant No 2858 on the waters of Big Miami; beginning at two beeches and a sugar tree at the Northeast corner of Robert Means entry No 9953; thence with his line S.12 E. 240 poles crossing the middle fork at 96 poles to two beeches corner to Robert Vances 700 acres in  
way; thence with Vance's line N.78 E. 200 poles crossing a branch to a stake, thence with another of Vance's lines N. 12 W. 200 poles crossing a branch to two beeches; thence S.78 W. 200 poles crossing a branch at 100 poles to the beginning.

George Henry 3  
James Henry 3 6.6

Benjamin McCulloch M.h.r.

Thomas S. McArthur D.S.  
January 14<sup>th</sup> 1821

Surveyed for Robert Vance 700 acres of land on part of a Military Warrant No. 850 on the waters of Big Miami: Beginning at a red oak and rock southeast corner to Robert Means entry No 9953, thence N.78 E. 400 poles crossing a bushy prairie at from 200 to 220 poles crossing a branch at 296 and one at 312 poles to three beeches; thence N.12 W. 400 poles crossing a branch at 156 and one at 374 poles to four beeches and a sugar tree; thence S.78 W. 200 poles crossing a small branch

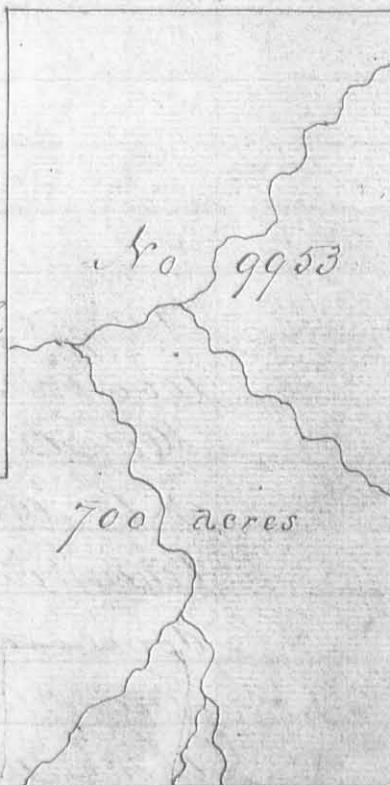


at 24 poles to two beeches corner to James Fitzpatrick 300 acres in way thence with his line S.12 E. 240 poles crossing a small branch to a stake; thence S.78 W. 200 poles crossing a branch to two beeches; thence S.12 E. 200 poles crossing a branch at 122 poles to the beginning.

George Henry 3  
James Henry 3 6.6

Benjamin McCulloch M.h.r.

Thomas S. McArthur D.S.  
January 16<sup>th</sup> 1821  
March 28<sup>th</sup> 1821

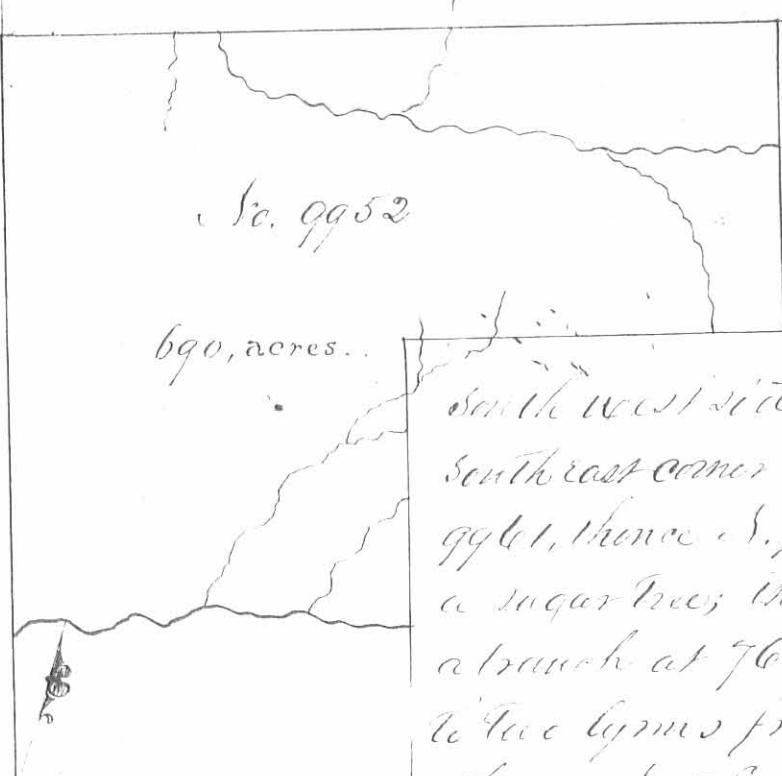

Surveyed for Robert Means  
afer 690 acres of land on a military  
warrant No 5221 and part of No  
5226 on the waters of Big Miami.  
Beginning at three elms corner  
the northeast side and two on  
south west side of the south fork of the Miami  
South east corner of Michael Bowyers Survey No.  
9961, thence S. 78. E. 200 poles to two beeches and  
a sugar tree; thence S. 12. W. 230 poles crossing  
a branch at 76. one at 144 and one at 180 poles  
to two lymns from one root and two beeches  
thence S. 78. E. 200 poles crossing a branch at  
6 one at 46 and one at 104 poles to a beech and ironwood; thence  
S. 12. W. 165 poles crossing a large branch at 60 poles to two beeches  
and a sugar tree; thence S. 78. W. 400 poles crossing a small branch  
at 172 a large branch at 290 and a branch at 310 poles to a  
beech ash and buckeye; thence S. 12. E. 395 poles crossing a branch  
at 326 poles to the beginning.

John McCay

Samuel Sappier, S. C. O.

J. B. M. Wilcox Clerk.

Thos J. K. Arthur D. S.

June 12<sup>th</sup> 1821

July 20<sup>th</sup> 1821

Surveyed for Robert Means afer 287 $\frac{2}{3}$  acres of land on  
part of a military warrant No. 5101 on the waters of  
the Big Miami; beginning at two beeches and a sugar  
tree south east corner to said Means Survey No. 9952 of  
690 acres in the line of Henry Koafers Survey No.  
9982; thence with said line S. 78. E. 200 poles to a  
red oak and beech Northeast corner to Koafers said Survey; thence  
N. 12. W. 230 poles crossing a branch at 34 poles to a beech and iron  
wood corner to Means said Survey; thence with his line S. 78. W. 200  
poles crossing a branch at 38 one at 156 and one at 194 poles to two  
lymnis from one root and two beeches; thence with another of his  
lines S. 12. E. 230 poles crossing a branch at 50 and one at 154 poles  
to the beginning.

John McCay


Samuel Sappier, S. C. O.

J. B. M. Wilcox Clerk.

Thomas J. K. Arthur D. S.

June 12<sup>th</sup> 1821

July 20<sup>th</sup>

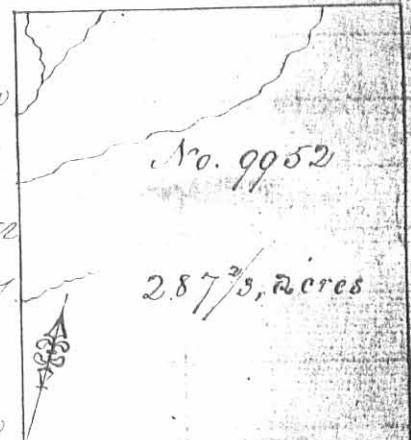

Survey for the expenses of Nathaniel Burnell 361 acres of land on part of a Military Warrant No. 5348 on the waters of Big Miami; beginning at two beeches south east corner to James Taylor and others Survey No. 9987 and Northwest corner to Knipfle and others Survey No. 9971; thence with their line N. 98.8° 255 poles to an ash and elm on the bank of a small branch; thence S. 12 N. 226 poles to an ash and two beeches; thence S. 78 E. 255 poles to three beeches in a line of Survey No. 9987; thence with said line S. 12 E. 226 poles to the beginning.

Leti Q. Tharp  
Hilkiah Rosebag B.C.C.  
Wilson L. Thompson M.R.C.

Samuel Forrester D.S.  
March 9<sup>th</sup> 1820.  
March 15<sup>th</sup> 1821.

Surveyed for the expenses of Nathaniel Burnell 361 acres of land on part of a Military Warrant No. 5348 on the waters of Big Miami; beginning at an ash and two beeches North east corner of them, and other side west No. 9971; thence S. 12 N. 400, poles to three beeches, thence S. 78.10.144° poles to two beeches. Northeast corner of Ash & Beech Survey No. 9988; thence with their line and the line of said Burnell's Survey S. 12 E. 400, poles to an ash and elm, Southeast corner to Burnell's said Survey; thence with a line of Survey No. 9971. S. 78 E. 144° poles to the beginning.

Leti Q. Tharp  
Hilkiah Rosebag B.C.C.  
Wilson L. Thompson M.R.C.

Samuel Forrester D.S.  
March 9<sup>th</sup> 1820.  
March 15<sup>th</sup> 1821.

No. 9988 & 9997  
352.3 acres

Survey for Ash & Beech 352.3 acres of land on part of a Military Warrant No. 1348 on the waters of Big Miami; beginning at three beeches Northwest corner to Nathaniel Burnell's Survey No. 9988 in the line of Taylor and Harrison's Survey No. 9987; thence with said line S. 12 N. 220° poles passing the Northeast corner of Survey No. 9987 at 174, poles to three beeches, thence S. 78 E. 255° poles to a small beech; thence S. 12 E. 220° poles to an ash and two beeches Northeast corner to Burnell's said Survey; thence with his line S. 78 N. 255° poles to the beginning.

Leti Q. Tharp  
Hilkiah Rosebag B.C.C.  
Wilson L. Thompson M.R.C.

Samuel Forrester D.S.  
March 9<sup>th</sup> 1820.  
June 27<sup>th</sup> 1821.

Surveyed for James Taylor and William Taylor 999 $\frac{2}{3}$  acres of land on part of a military warrant and part of one James 111 acres part of No. 5440 and William 888 $\frac{2}{3}$  acres on No. 5453 on the waters of big Neamis beginning at three beeches south east corner to Robert Vance and others survey No. 9953 and North west corner to Wallace and others survey No. 9934; thence with their line N. 78. E. 400 poles

to three beeches; thence N. 12 W. 400 poles crossing a branch at 180 and one at 330 poles to three beeches; thence S. 78 N 400 poles enclosing a branch at 92 poles to a sugar tree and three beeches north east corner to said Vance and others survey; thence with their line S. 12 E. 400 poles to the beginning.

See D Tharp  
Hilkiah Rosebrag B.C.

Nelson L Thompson M.k.r.


Samuel Forrer D.S.  
January 31<sup>st</sup> 1820  
March 14<sup>th</sup> 1821

Surveyed for James Wright 1000 acres of land on part of a military warrant No. 2740 on the waters of Scodote; beginning at two beeches southeast corner of James Buntous Survey No. 9955 and Northwest corner to Dun and Harrisons survey No. 9955, thence N. 78 E. 400 poles to two ashes and an elm; thence N. 12 W. 400 poles to two beeches; thence S. 78 W. 400 poles to a hickory, beech and sugar tree Northeast corner to Buntous said survey; thence with his line S. 12 E. 400 poles to the beginning.

See D Tharp  
Hilkiah Rosebrag B.C.  
Nelson L Thompson M.k.r.

No. 9956  
1000, acres

Samuel Forrer D.S.  
January 30<sup>th</sup>, 1820  
July 28<sup>th</sup>, 1820

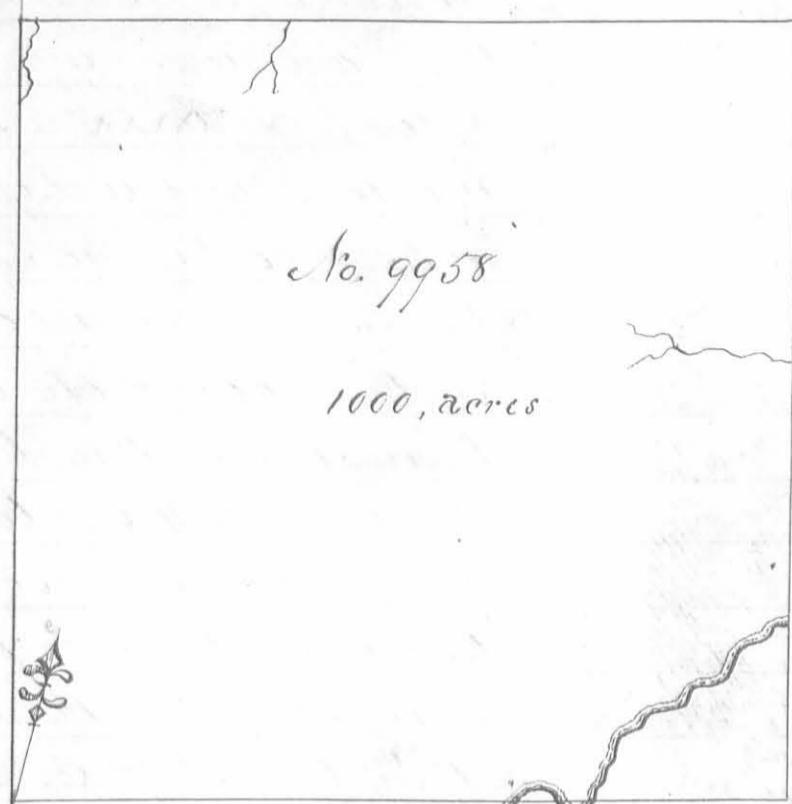

Surveyed for Alexander Parker  
acri 1000 acres of land on part of a  
Military Warrant No. 735 on Rush  
creek: Beginning at two beeches  
and a sugar tree North east corner  
to Rowland Madison's survey No.  
9938; thence N. 12. W. 400 poles  
cropping several small branches  
to a stake; thence N. 78 E. 400  
poles cropping a small branch  
at 8 and one at 144 poles to two  
buckeyes; thence S. 12 E. 400 poles  
cropping a branch at 178 and Rush  
creek at 310 poles to four beches and a hickory oak; thence S. 78 W. 400  
poles cropping the creek at 101 at 118 and at 142 poles to the beginning.  
Simon Hager 3  
Abraham Hager 3 C.C.  
Abner Chapman M.k.r.

Thomas J. McArthur D.S.

January 26<sup>th</sup> 1821

March 30<sup>th</sup> 1821

Surveyed for the Representatives of  
Francis Taylor and James Taylor  
acri 1000 acres of land on the following  
Military Warrants: Rept of F. Tay.  
for 888 $\frac{2}{3}$  acres on No. 5445, James  
Taylor 100 acres on No. 5276 and 11 $\frac{1}{3}$   
acres on No. 5372 in the forks of  
Big Miami: Beginning at two  
sugar trees and a buckeye South  
east corner to Jones and other survey  
No. 9968; thence N. 78 E. 400 poles  
to three beches northeast corner to  
George Clark's survey No. 9948; thence N. 12. W. 400 poles to a hickory  
lawn and sugar tree; thence S. 78 W. 400 poles to two sugar trees and two  
buckeyes northeast corner to Jones and other survey; thence S. 12. E. 400  
poles to the beginning.

Lori D. Sharp 3  
Millicah Roselrag 3 C.C.  
Wilson S. Thompson M.k.r.

No. 9969

1000, acres

Sam'l Forre D.S.  
March 1<sup>st</sup> 1820  
July 21<sup>st</sup> 1820