Belle Center

Alley between Center St + Franklin St.

Note: See pgs. 72 + 8 for other surveys in this vicinity.

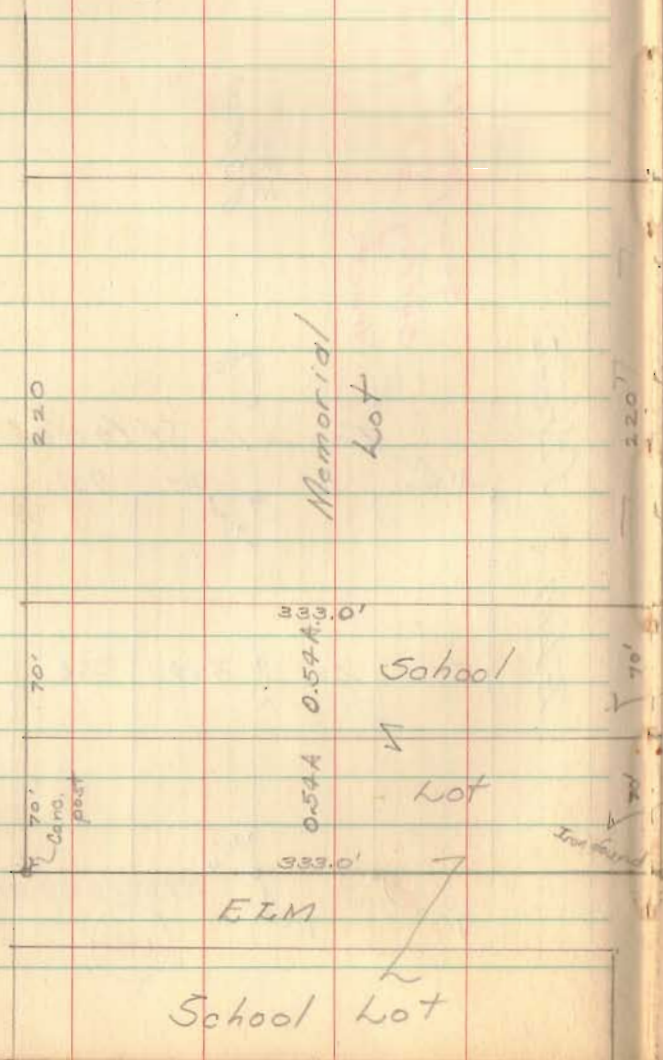

Party:— C. Keyser G. Wilgus D. Dodson

May 9, 1957

8

See FB 996 pg 72-3 for survey CH #106.

INDEXED ON MAP
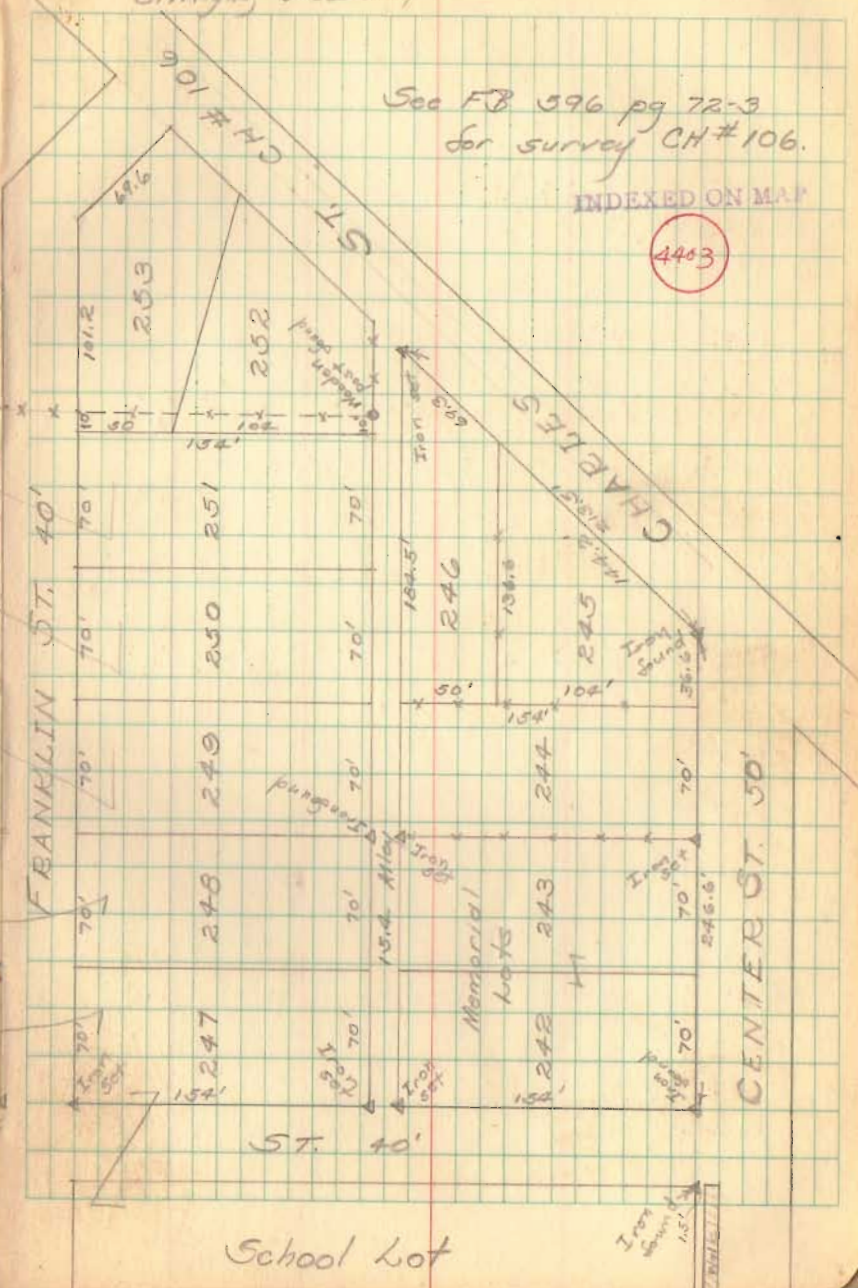
4403