John Moriarty Survey, April 14 & 24 1914

Part SE 1/4 Sec 34. T4. R14.

STATION.	ALIGNMENT.	DEFLECTION.	REMARKS

Washington St. comm S 84½ E

Center Washington Ave E/E Line Sec 34 at center old oregon gate post at S. side of gate, Iron pin 1" dia x 2¼ set here, Mrt.

Sec line Sec 34 = S 5½ W. Huston's S line = 51'

Start at iron pin 30" 20½' center Washington Ave N. W. Moriarty 60 = a W. E. & N. R. R. Co Lane tract. Thence S 84½ E on center Wash Ave at 102' set pin pin 1" x 2½ at N W. John Moriarty & NE & Elm Bay 595.8' " " " 1" x 2¼ " N W. & W. Huston 50 still N E & Moriarty 645.4 Sec line at Middle Magnolia post S. post & NE & W. C. Huston E. line Silas Roberts heirs 23a.

(2) Start at iron pin NE & N.R. & Co Lane & W W. & W. Ave center of Washington Ave. Thence S 5¼ W. on Sec line between Arie S Lane & W W. & John Moriarty at 162 at St 18 SW & Arie S & W W. & John Moriarty 491 & Iron pin at old SW & John Moriarty = of & SE Cor. Lane.

(3) Start at center Washington Ave E/E Line Sec 34. 645.8 = a Thence south Sec line S 5½ W.
at 338.5 S E & Huston = e.
" 478.5 S W & Roberts heirs
(4) Start at e = 338.5 of (3) Sec line Moriarty and Arie S. Lane S 84½ W at 51 pass f. S W & Huston at 86 & g. iron pin
(5) Start at g. S 56½ W. at 204' to N edge old mill race = h
(6) " " h at N 75¼ W. at 267' to N edge old mill pond = i
(7) " " i S 77½ W = 346 Iron pin = M. = S E & land sold to Lane at 142'. j = old S W & John Moriarty & S E & Jn M. to Lane
(8) start at z = S E & Thos Day's N ½ W. at 279.5 on N W & [illegible]

Plat John Moriarty Survey

Stationers, St. Louis, Mo. Part S.E. 1/4 Sec. 34 T4. R14.

TOPOGRAPHY.

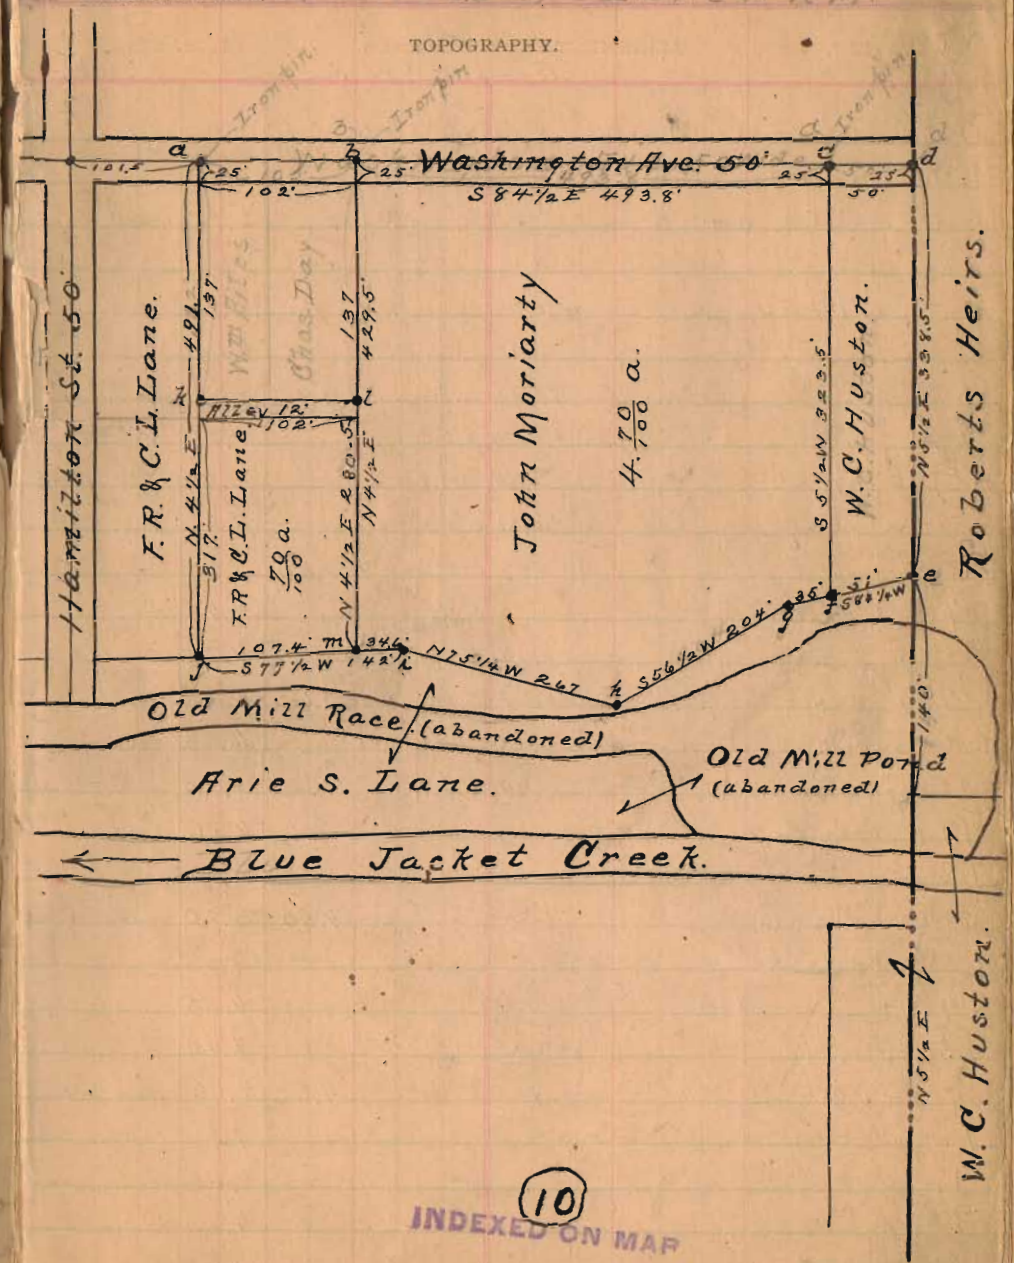

(10)

INDEXED ON MAP