Ritter Ditch Work. Concluded

STATION.		ALIGNMENT.	DEFLECTION.	REMARKS
Ritter Ditch Lateral #2 "B"			Grade 0 to 8 = .30 per Sta.	
Sta. 0 S	& S ℄	19.23	0 to 57½ = 8" tile	Plug
0 . 9.23		10.00	10.00 Bottom tile settled	
"	5.32	13.90	10.00 Oplug.	3.90
0+57½	5.33	13.90	10.17 Angle S 7 I 3 Sta 0 of Lat 3	3.73
1 "	5.48	13.75	10.30	3.45
2 "	5.22	14.01	10.60	3.41
3 "	4.92	14.31	10.90	3.41
3+66½	4.73	14.50	11.10 0+57½ to 3+66½ = 6"	3.40
4 "	4.71	14.52	11.20	3.32
5 "	4.81	14.42	11.50	2.92
" 5.66	℄	20.08		
6 "	5.45	14.63	11.80	2.83
7 "	5.55	14.53	12.10	2.43
8 "	5.27	14.81	12.40 End 1 foot of line pipe	2.41
			3+66½ to 8 = 5" Tile	
	℄	19.23	"B"	
Lateral # 3 . 0			4+34 = 6" Tile	Plug
0 " 5.32		13.90	10.17 Sta 0+57½ of Sta 0	3.73
1 "	5.02	14.21	10.47 Grade. 0 to 8 = .30 per Sta.	3.74
2 "	4.56	14.67	10.77	3.90
3 "	4.49	14.74	11.07	3.67
4 "	4.63	14.60	11.37	3.23
" 5.48	℄	20.08	4+34 to end = 5" Tile	
4+34 "	5.38	14.70	11.47	3.23
5 "	5.28	14.80	11.67	3.13
6 "	5.42	14.66	11.97	2.69
7 "	5.68	14.40	12.27	2.13
8 "	5.11	14.97	12.57 End 3 foot from pipe line	2.40

Folsom Dum. Lot 2934

67

Stationers, St. Louis, Mo.

15 Hick S 27 E 39.7
10 Cot Wd N 47 E 17

TOPOGRAPHY.

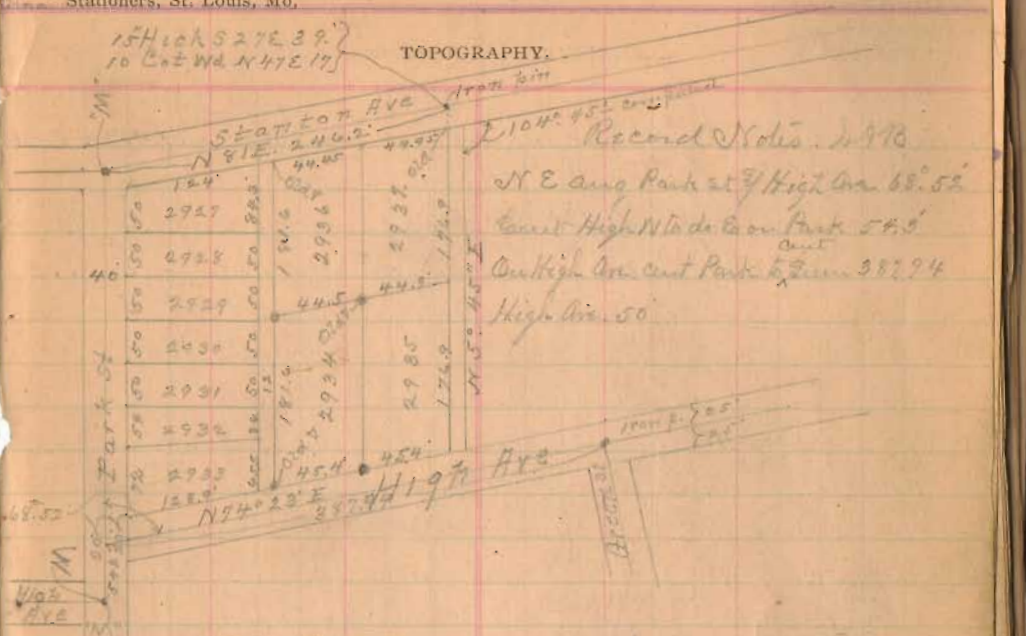

Record Notes. Lot 2934

N E and Park at ℄ High Ave 68.52
East High Ave and Park 54.5
Out
High Ave. 50

May 1st 1916 Coasted corners of Lot 2934 for
Surveyor ℄ Florine Folsom.

Field Notes

and Park at
Set Iron over mon "M" center High Ave marked and flag at
mon "M" Center Stanton Ave & Park Street and R 68.52'
at 163.2' and 2 left 0.5 E. more N 20' and
Found old stake at S of Lot 2934, and N E Lot 2934, and S of Lot 2936
and N E Lot 2937. Run line from old ℄ S of Lot 2934 to old ℄ N of Lot 2936
and set nail ℄ at 18.6 S of old ℄ at N of Lot 2936. Also Measure
from old ℄ of Lot 2937 along lot line East side lots 2937 & 2935
at 177' South set pole, run line from nail ℄ to pole at 177 ft. Found
Stake well defined of old ℄ N E Lot 2934 at 44.5 ft. nail ℄ the old Side
Measure east along North High Ave from old ℄ S of Lot 2934, and set
nail ℄ S E Lot 2934 at 45.4'

(28)

INDEXED ON MAP