(898) IP

Kenyon survey
Bellefontaine
on Rush Ave
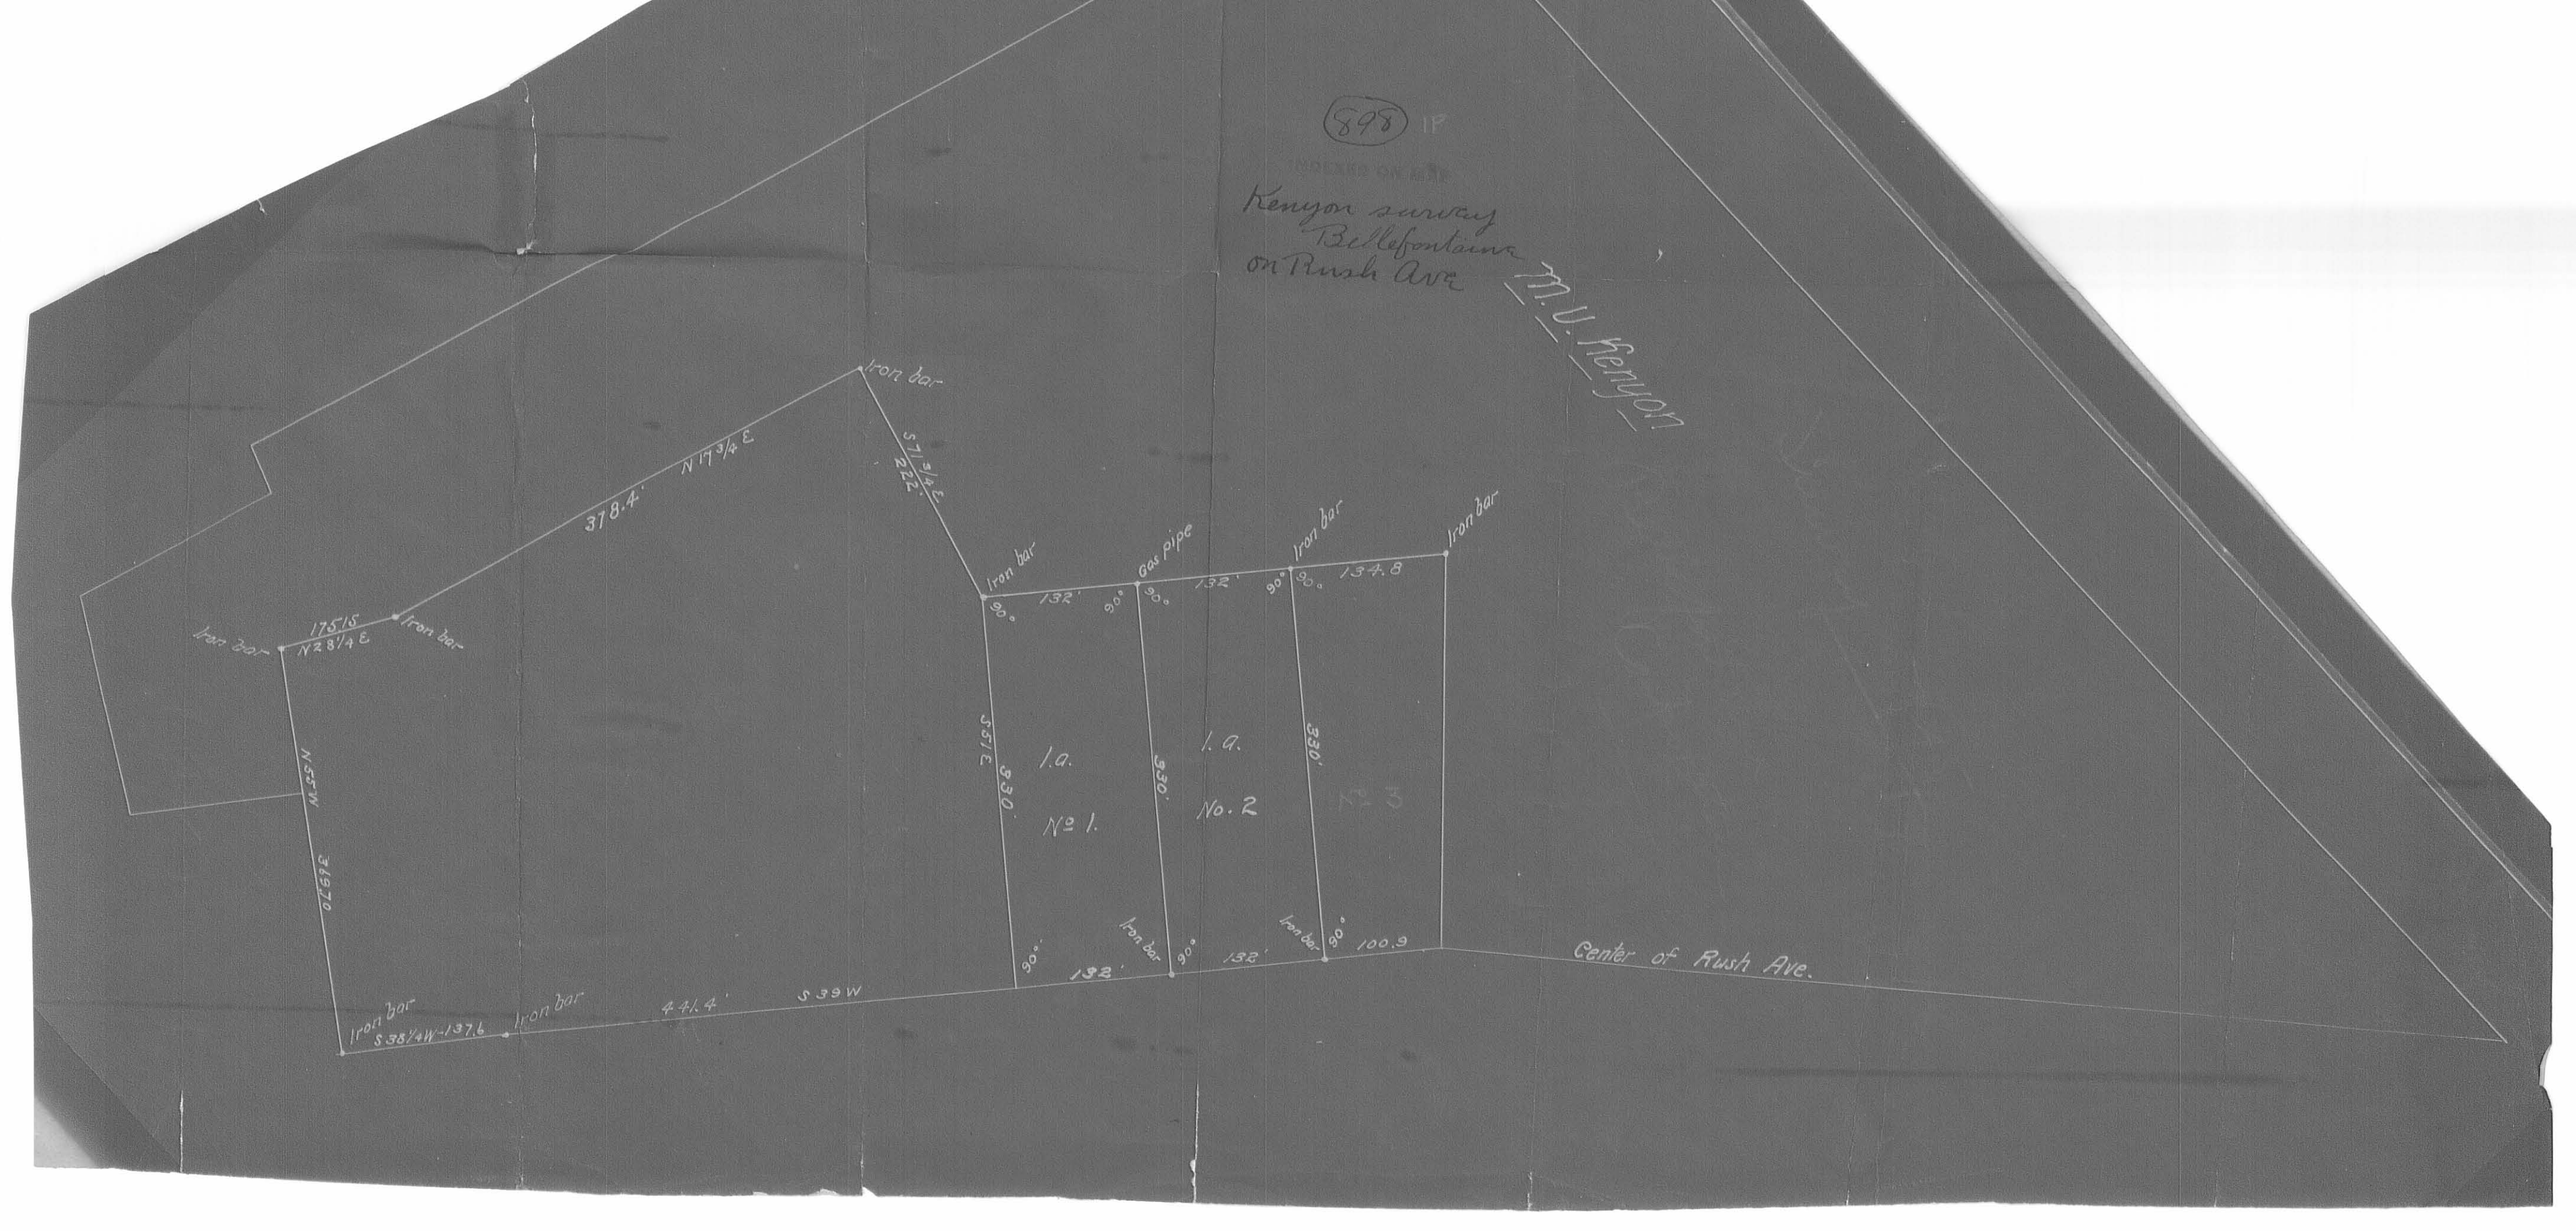
M.V. Kenyon