


"Alley Line" Water Works Switch

Scale 100' pr 1" Nov. 20th 1922.

1" Gas Pipe Line
For Manhole Cauter
Approved 2-9-1924

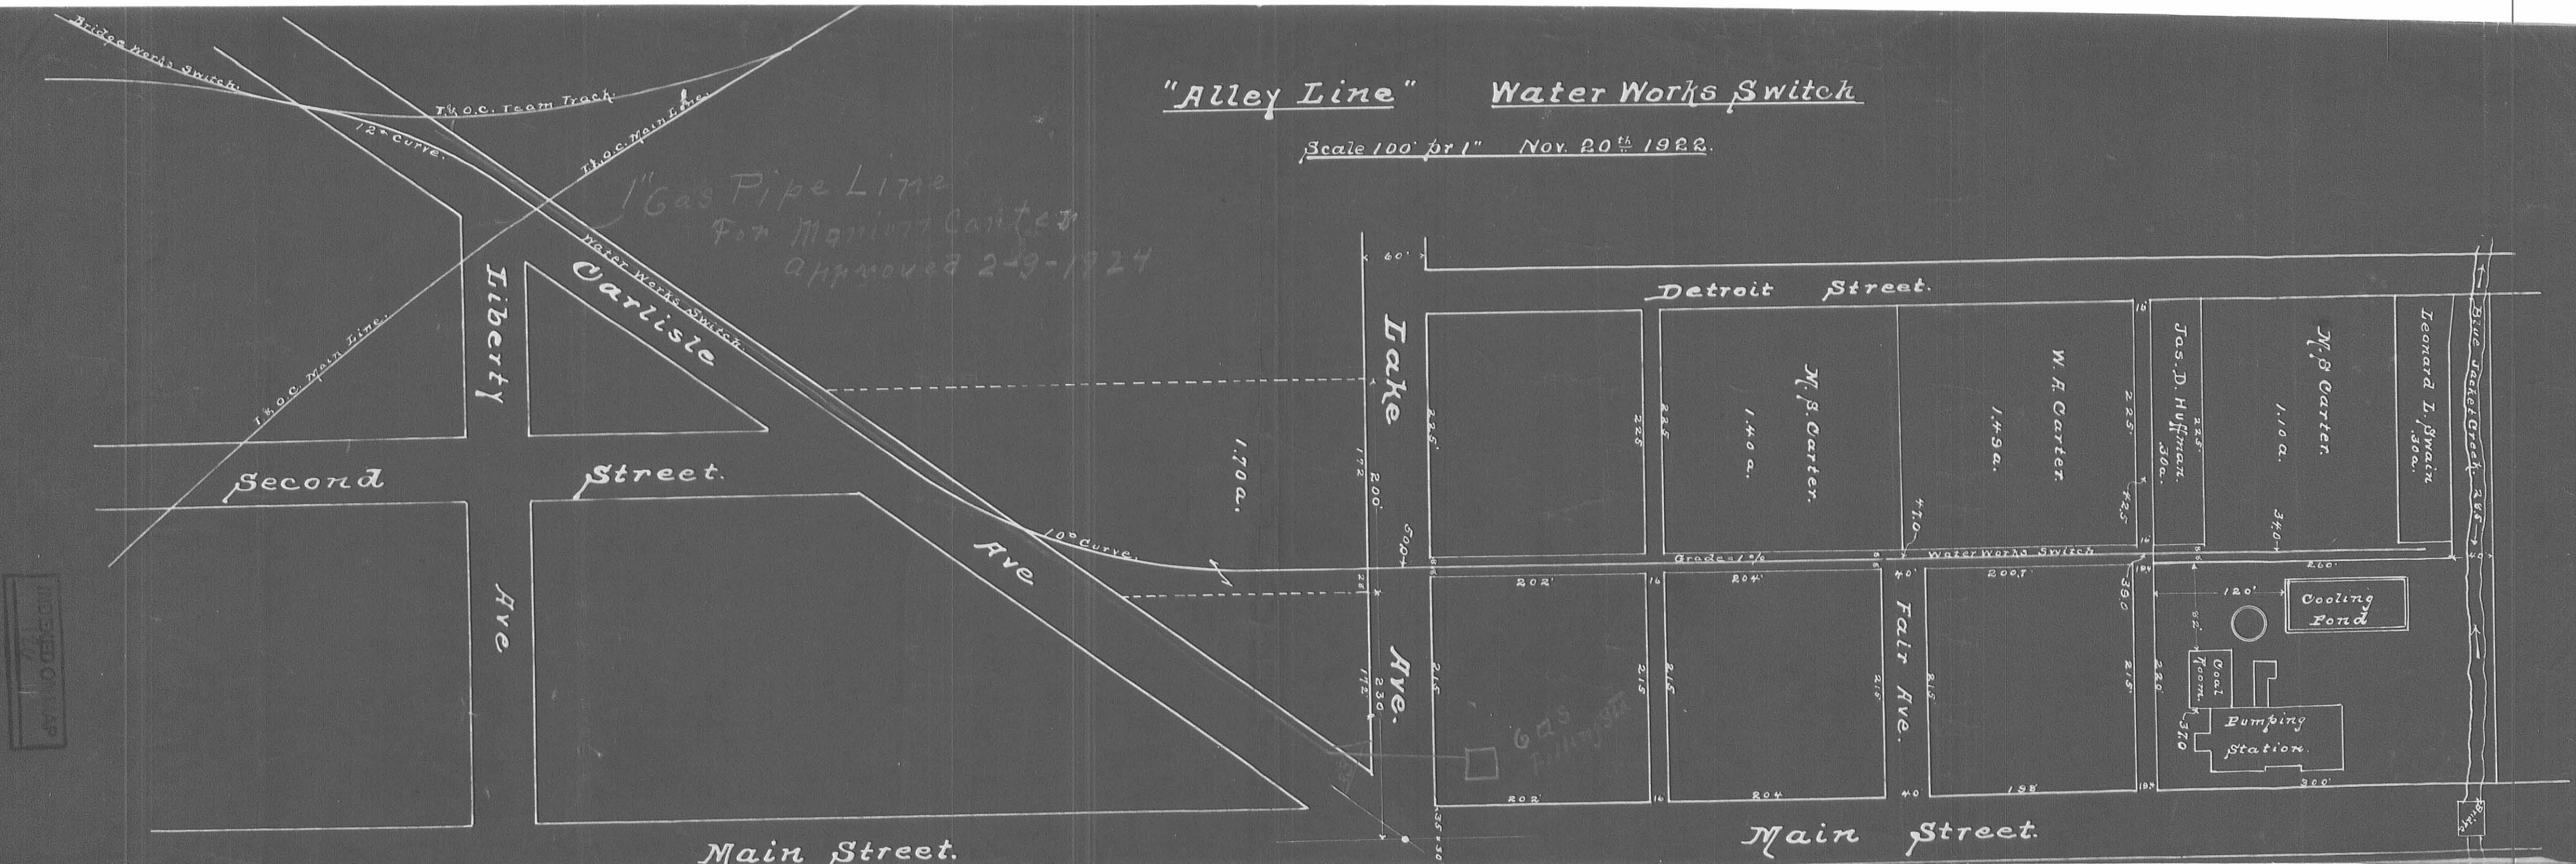

RECORDED ON 11-29-22