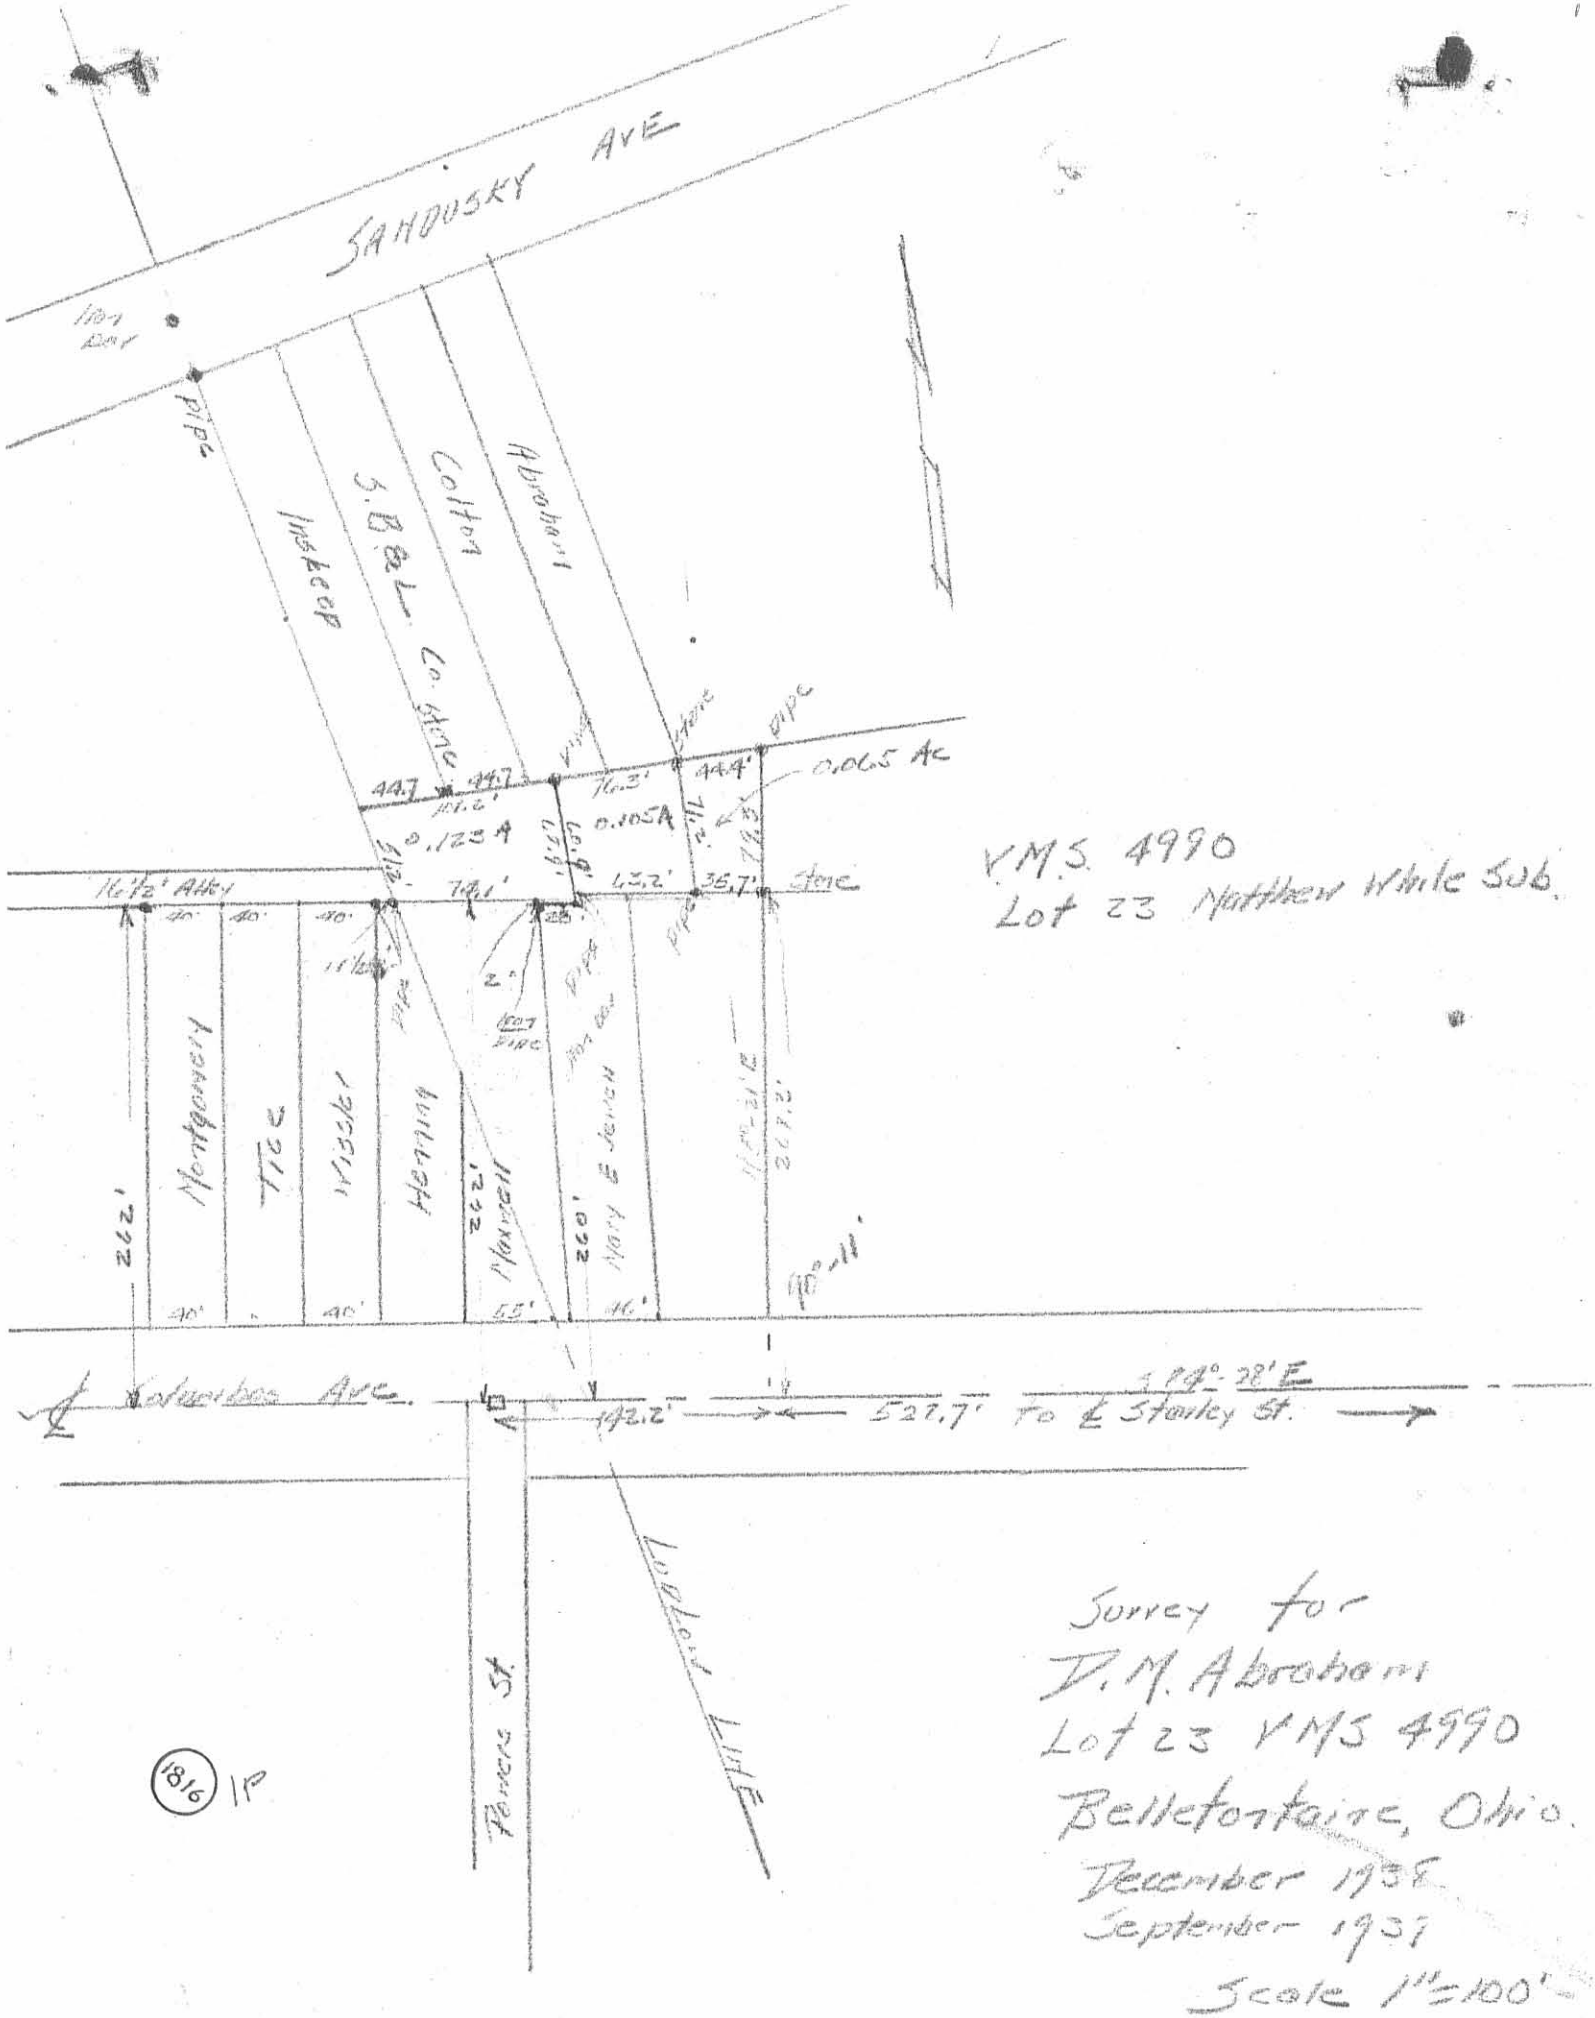
SANDUSKY AVE
Iron Bar
Pipe
Inskeep
S.B.&L. Co. Stone
Colton
Abraham
Stone
Pipe
0.065 Ac
44.7
44.7
76.3'
44.4'
0.123 A
0.105 A
16½' Alley
74.1'
63.2'
35.7'
Stone
Montgomery
Tice
Wissler
Henning
Maxwell
Mary E Jewell
262'
262'
260'
90°-11'
Columbus Ave.
142.2'
527.7' to ℄ Stanley St.
Powers St.
Lodlow Line
V.M.S. 4990
Lot 23 Matthew White Sub.
Survey for
D. M. Abraham
Lot 23 VMS 4990
Bellefontaine, Ohio.
December 1938
September 1937
Scale 1"=100'
1816
1P