SURVEY OF LOT FOR
J.M. Abraham
Part of 4990 in Bellefontaine at Sandusky Ave
and Ludlow 6-17-22

Set iron at I.P. at ℄ Sandusky and Ludlow. Flag at + Sandusky and Stanley. Measure east on ℄ Sandusky 10' for west line of Abraham.

NE angle Sandusky and Ludlow 88°-45' 177°30' (drawked)

Set iron pins 5/8" x 15" at each corner of lot as stony

Hot

℄ Beam 1st 4 P.M. to 7 P.M. ±6

C.N. Hysteep. Roy Abraham. J.M. Abraham.

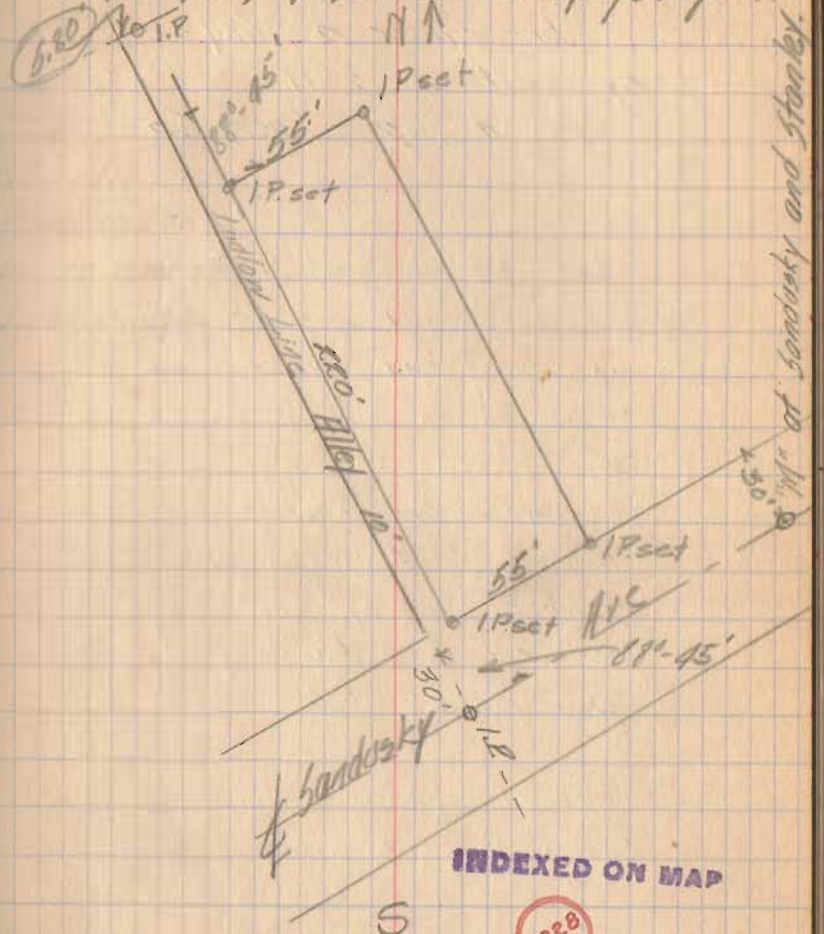

INDEXED ON MAP
2228