C. A Hosteen
C. C. Huskey 11/1/37 4/4/38

Survey for S. A Assn.
Part of Matthew White's
Sub of V.M.S. 4990
Bellefontaine, Ohio.

A C.L. Marker (found) CD 78.8'
B 2" x 2" wood stake (found) AB ~~218.4~~ 222.6'
C iron pipe (set)
D N.E. cor property (scratched ✝ of abutment (set)
E 4" x 4" concrete "N" (found)
F 2" x 2" oak stake - tack (found).
G iron pipe on CD extended 2' north
D E 131'. Set stake at ½ DE

Angles shown are from record plot of Grandi Sub

1925

2/131

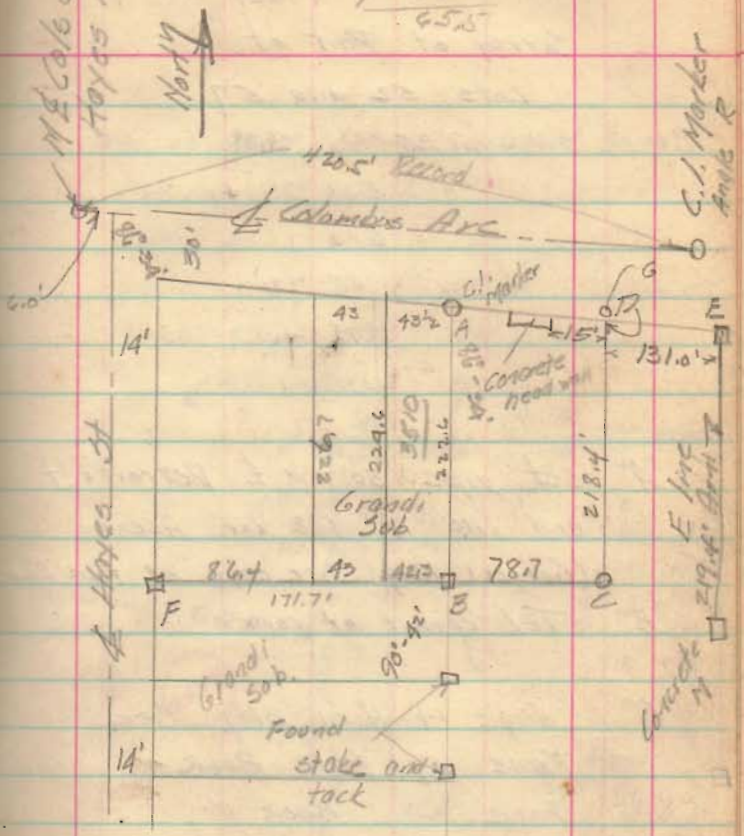

222.4
218.4
1441
220.5
78.7
15435
15440
176
15435
17353.35

435/17353 (.395 = 0.40 Ac.
1305
4300
3915
3850

2277

INDEXED ON MAP