Survey of 60'x147.6'
in V M3 5245
N of and adjoining Lot No 3526
Indian Park Belletontaine
for Belletontaine Dev. Co.

CAI - CAM JCW JHI 21
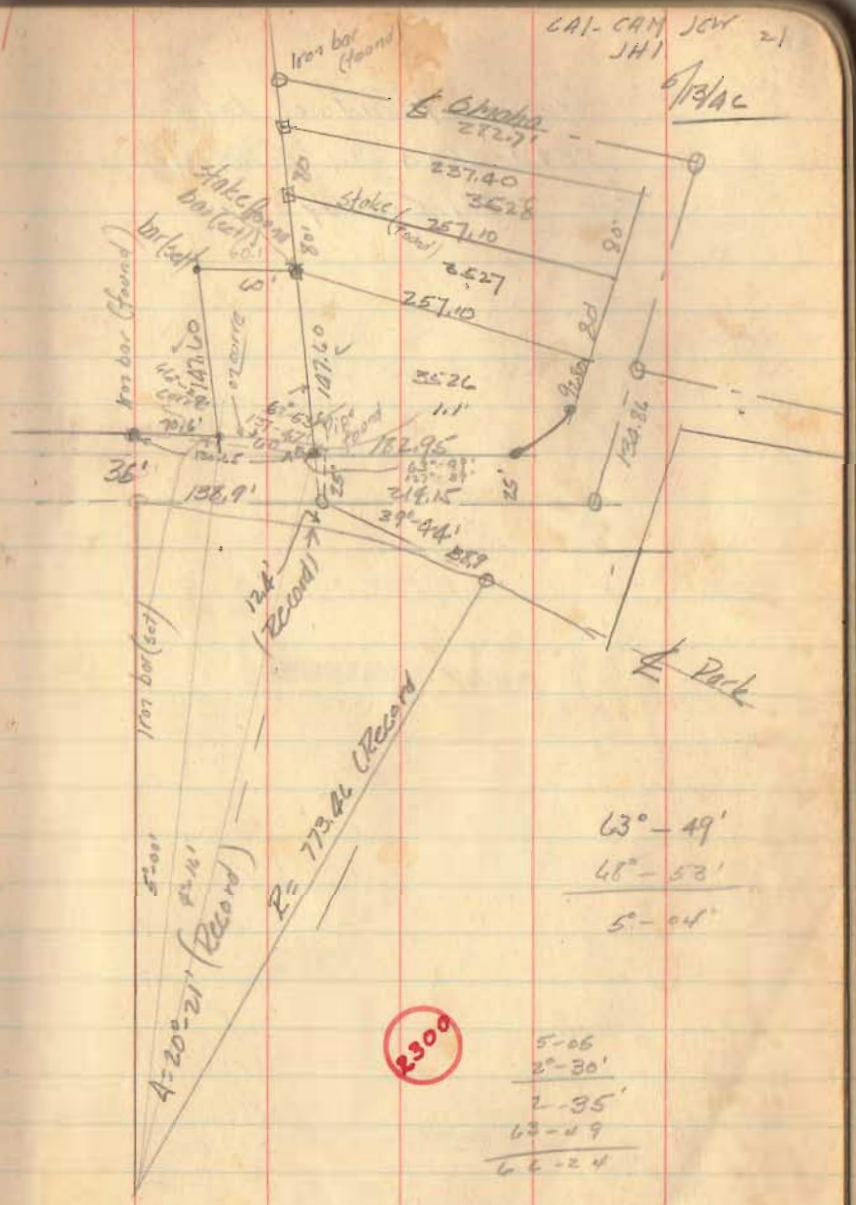
6/13/46