Survey of Lots
Bellefontaine for
The Bellefontaine Development Co

	From	To	Plat	Meas	
On Cols	℄ Elm	℄ Det	501.5		
On Det	℄ Cols	℄ Chillicot	526.5		
On Chillicothe	℄ Det	℄ Elm	501.5		
On Elm	℄ Chillicothe	℄ Cols	526.5	529.4	+ 2.9'

529.4
526.5
2/2.9
1.45

30
220
8.25
1.45
259.70

CA Inskeep
CA Miller
Don Ferry

9-13-46

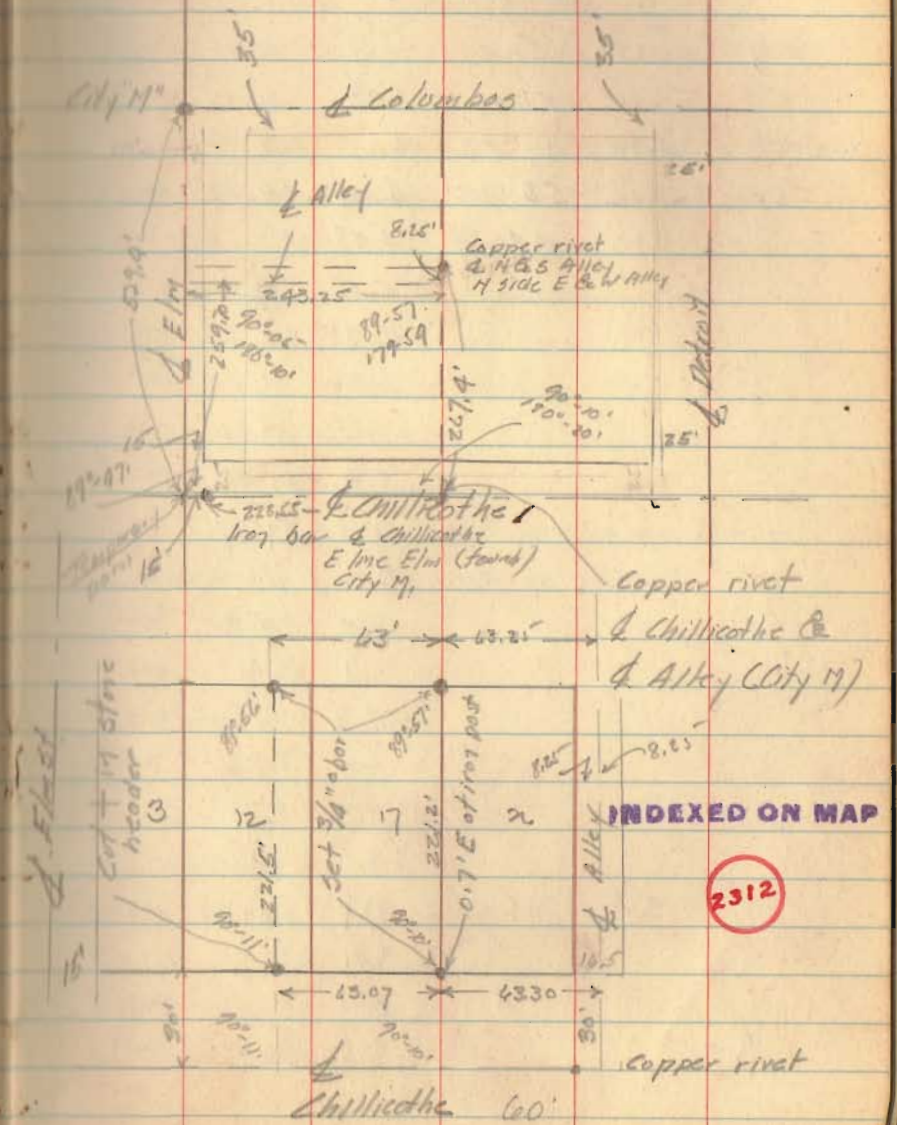

INDEXED ON MAP

2312