

SCALE: 1" = 40'

E. I. FOREMAN SURVEY
 LOT No. 664
 CITY OF BELLEFONTAINE
 V.M.S. 4990
 LAKE TOWNSHIP
 LOGAN COUNTY, OHIO
 JUNE 8, 1968

STREET CENTERS
 A - 3/8" IRON BAR, MONUMENT BOX.
 B - 3/4" IRON BOLT, NO MONUMENT BOX.
 C - 3/4" IRON BOLT, MONUMENT BOX.
 D - 1" IRON PIN, MONUMENT BOX.

• - 3/8" IRON BAR SET.

REFERENCES:
 HOGES EAST GROVE ADDITION.
 PLAT BOOK A VOL. I PAGE 10 - APRIL 7, 1869.
 STREET CENTERS - CITY OF BELLEFONTAINE.

SURVEYED AND PLATTED BY:
 DANIEL E. GILBERT, P.S.
 REG. SURV. No. 5402
 428 N. MADRIVER ST
 BELLEFONTAINE, OHIO 43311

47240

$$\begin{array}{r} 19.04 \\ 1.068 \\ \hline 15232 \\ 1424 \\ \hline 1904 \end{array}$$

$$\begin{array}{r} 1.068 \\ 18.5 \\ \hline 6340 \\ 1068 \\ \hline 112148 \end{array}$$

$$2033472$$

center Grant to center Nelson
Meas.

255'-6 1/2"

surplus = 2"

Plat

20' - 4"

50' - 10 1/2"

50' - 10 1/2"

11' - 2 1/2"

50' - 10 1/2"

50' - 10 1/2"

20' - 4"

255' - 4 1/2"

	9366	60.000	6406
6728		56196	6406
		38040	32.03
		37464	
		57680	

Center San. to Center

Meas
378.5

Plat

32.03

150.

16.

150.

30.50

378.53

$$\begin{array}{r} 15.080 \\ 9.366 \\ \hline 56140 \\ 56196 \end{array}$$

On Grant

32.03

150.00

182.03

Set nail at 190 not on Grant.

On Center

Grant to Nelson

Plat

255' - 4 1/2"

Meas.

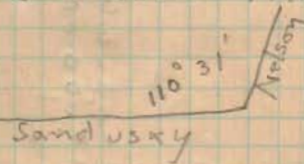
255' - 4 1/2"

On Nelson
Sandusky to Nelson

378' - 6" meas.

Plat = 378' - 6"

sum

110° 31' 

4240