Cooper Ave. Survey. July. 1916.

References.

A: Iron Pin. cent. Eastern & Ludlow. B Iron pin. cent. Cooper & Ludlow
C: " " " Auburn & " D, E & F: Iron pins cent Cooper.
G: Origal stone. marble. cent alley, South side Cooper.
H: Iron Pin. E. side 16' alley & S. side Cooper. N.W. cor. Jos. Costin.
I: " " cent Cooper. East & in line W. side 18' alley.
J: " " " " & Liberty
At D. Angle Right (south) 2°.12'. At F. Ang. R. (south) 0°.4'
" H. Center line produced from East strikes east line of alley 7.6' north of iron pin & 7.9' south of center Cooper Ave.
At iron pin I. cent. line Cooper Ave East is 8.5' South of cent. line Cooper Ave. West, at W. line of 18' alley.
B: S.W. cor. fda stone 1.S.F. Rec. N. of E 36.8'
" Top screw Hyd. S.W 26.15'; Iron pin, center Auburn & Ludlow. S. 51.84'
D: S.W. cor. fda. 1½ S.F. N.E. 26.5'; S.E. cor. 1½ S.F. N.W. 31.5'; N.E. cor. fda. 1.S.F. S.W. 46.75' N. edge S. Walk. S 10.1'
E: Willow 15" N.W. 14.1'; N.W. cor. fda. 2.S.F. S.E. 43.1'
" On W. line Lot 955 & cent. Cooper Ave.
F: Apple tree N.W. 28.3'; N.E cor. fda. 1.S.F. S.W. 46'; S.E. cor. fda. 1.S.F. N.W. 34' Black Walnut. 12" di. S.W. 44.2'
G: Original stone. marble. S. side Cooper Ave & cent. of alley. (leans south)
H: N.E. cor. 2.S.F. S.W. 18.9'; Catalpa tree 12" S.E. 14.5'
I: S.W. cor. fda. 1.S.F. N.E. 35.8'; Elect. L't Stubb. S.E. 18.2'; Catalpa tree 2" di. S. of W. 22.3'; Tel. pole N. 24'
J: Box elder 9" di. N.W. 50.5'; S.W. cor. stone fda. of W. part of 2.S.F. N.E. 62.58'
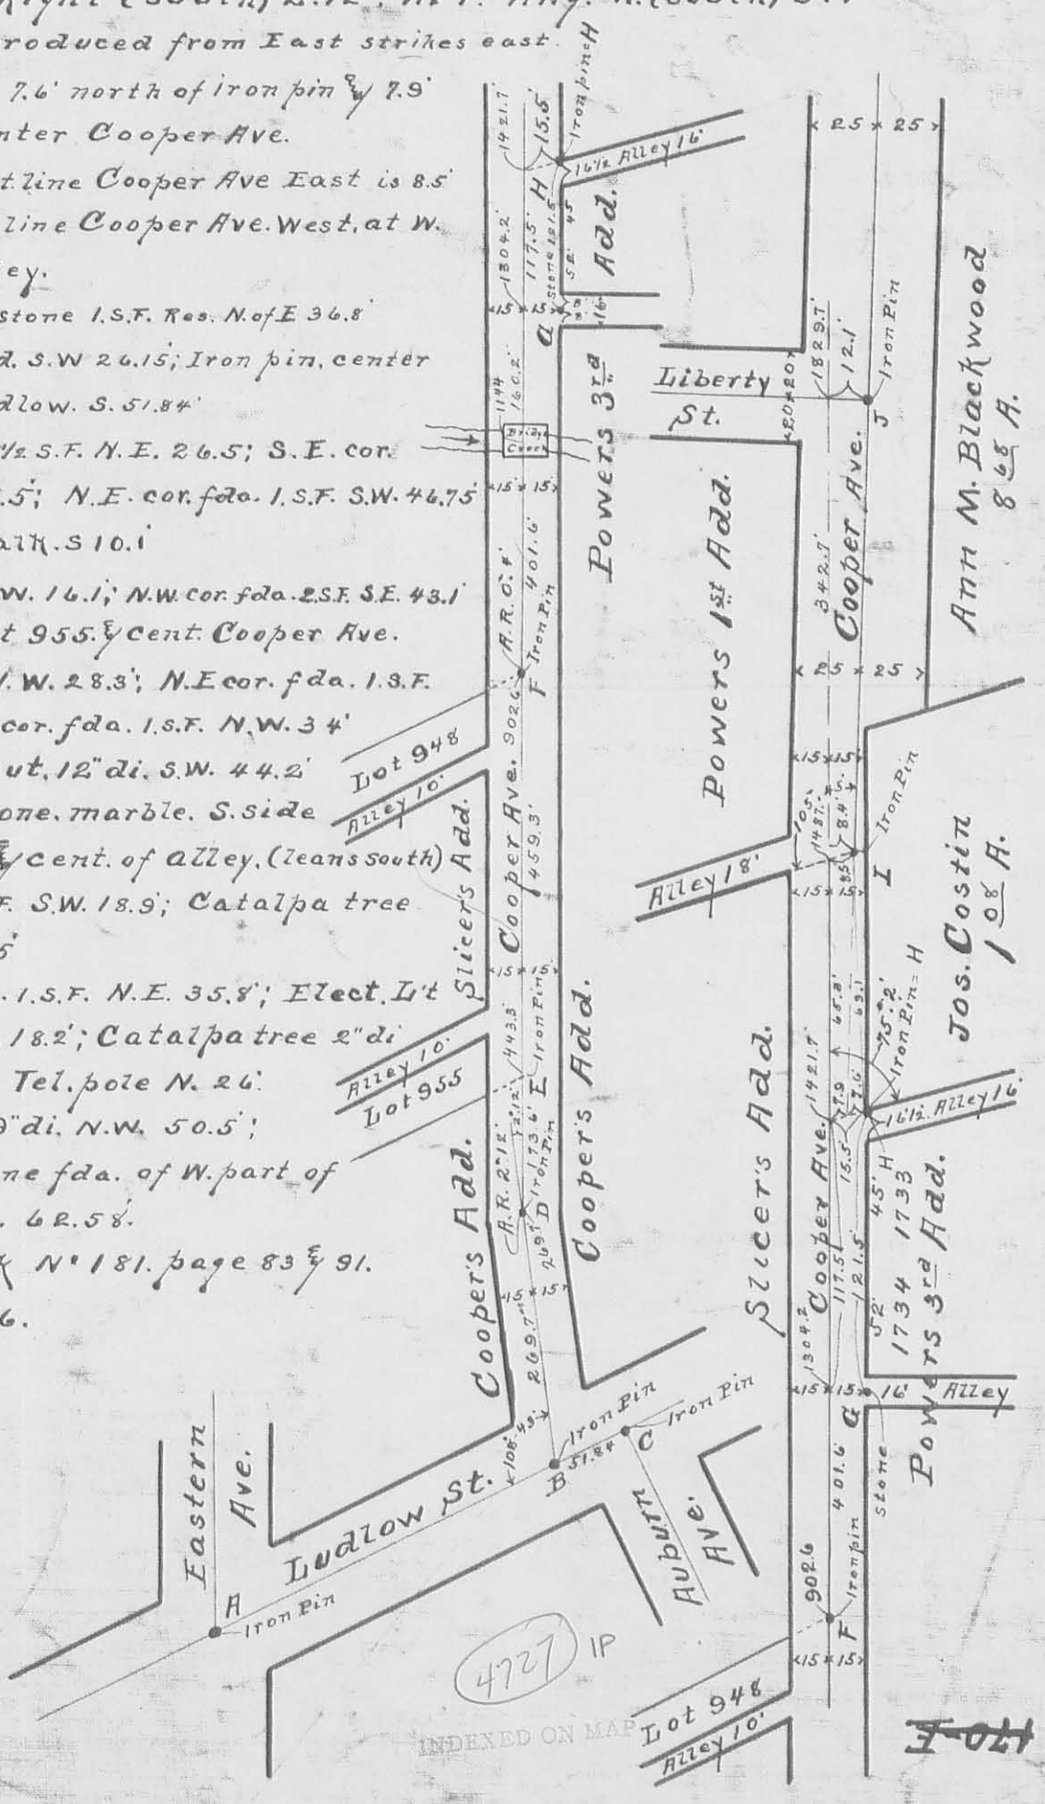
See Book N° 181. page 83 & 91.
July 1916.