HARVEY WELLS SURVEY
LOT 542 - BELLEFONTAINE, O.

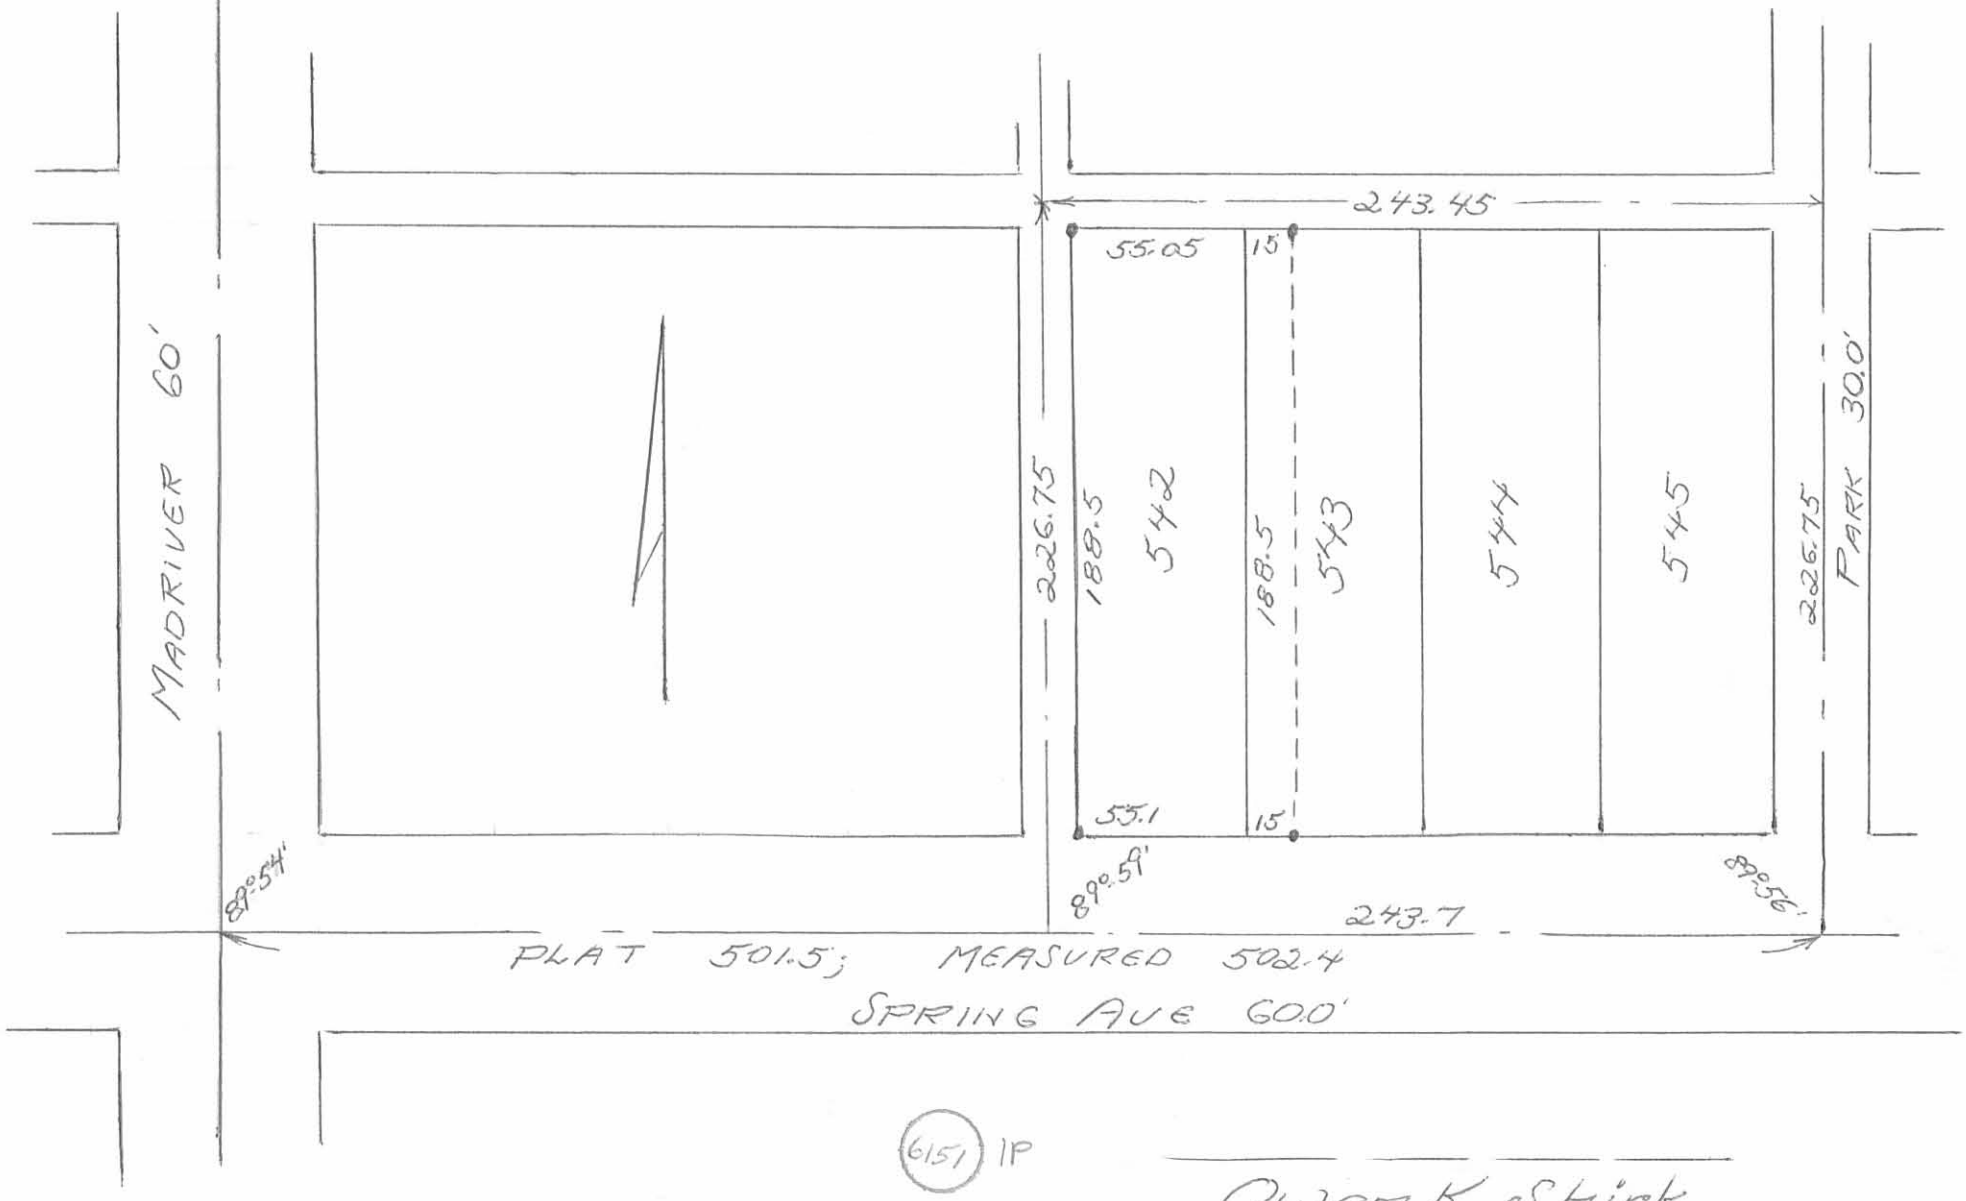

(6151) IP

INDEXED ON MAP

Owen K. Shirk
Surveyor 4271
Surveyed: 2-21-72