

Received 7-15-88

LESLIE H. GEESLIN
REGISTERED SURVEYOR NO. 5248
P. O. BOX 274
RUSHSVLVANIA, OHIO 43347

TELEPHONE: (513) 468-2793

PUGH SURVEY

July, 1988

The following described real estate situated in the State of Ohio, County of Logan, Township of Lake, being part of Virginia Military Survey 4478 and more particularly described as follows: *City of Bellefontaine*

Beginning at a 1 inch iron pipe in the east line of Donald F. Mills' 2.64 acre tract as described in D. B. Vol. 407 Page 675 at the northwest corner of Lot 3621 of Sparks Addition.


Thence with said Mills' east line N. 5° 10' E. 6.00 feet to a 0.625 inch iron bar.

Thence S. 81° 51' 42" E. (this bearing is assumed and all other bearings are from angles and distances measured in this field survey) 129.61 feet to a 1" iron pipe at the northeast corner of said Lot 3621 in the west line of Summit Drive.

Thence with the north line of said Lot 3621 N. 84° 31' W. 129.44 feet to the place of beginning.

Containing 0.01 acre more or less.

The above described 0.01 acre tract being on the south side of Richard D. Norton's 0.44 acre tract as described in D. B. Vol. 293 Page 164.

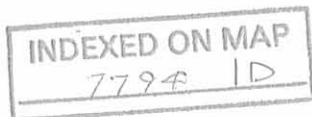

Leslie H. Geeslin

RICHARD D. NOERTON
0.44 AC.
DB VOL 293 PAGE 164

DONALD F. MILLS
2.64 AC.
DB VOL 407 PG 675

N. 5° 10' E.

S. 81° 51' 42" E. 129.61'
6.00' 389 S.F. 0.01 AC.
N. 84° 31' W. 129.44'

SPARKS ADDITION
LOT 3621
GARIS PUGH
DB VOL 371 PG 195

SUMMIT DRIVE

SURVEY OF 0.01 AC. TRACT
IN VIRGINIA MILITARY SURVEY
4478, LAKE TOWNSHIP, LOGAN
COUNTY, OHIO IN THE CITY
OF BELLEFONTAINE FOR
GARIS PUGH.

JULY, 1988

SCALE: 1" = 20'

LEGEND:

- = 5/8" IRON BARESET
- ⊙ = 1" PIPE FOUND



INDEXED ON MAP
7794 IP

Leslie H. Geeslin
LESLIE H. GEESLIN
RUSHSVANANIA, OHIO