REC'D 4-24-96 SMY

MAP ROOM

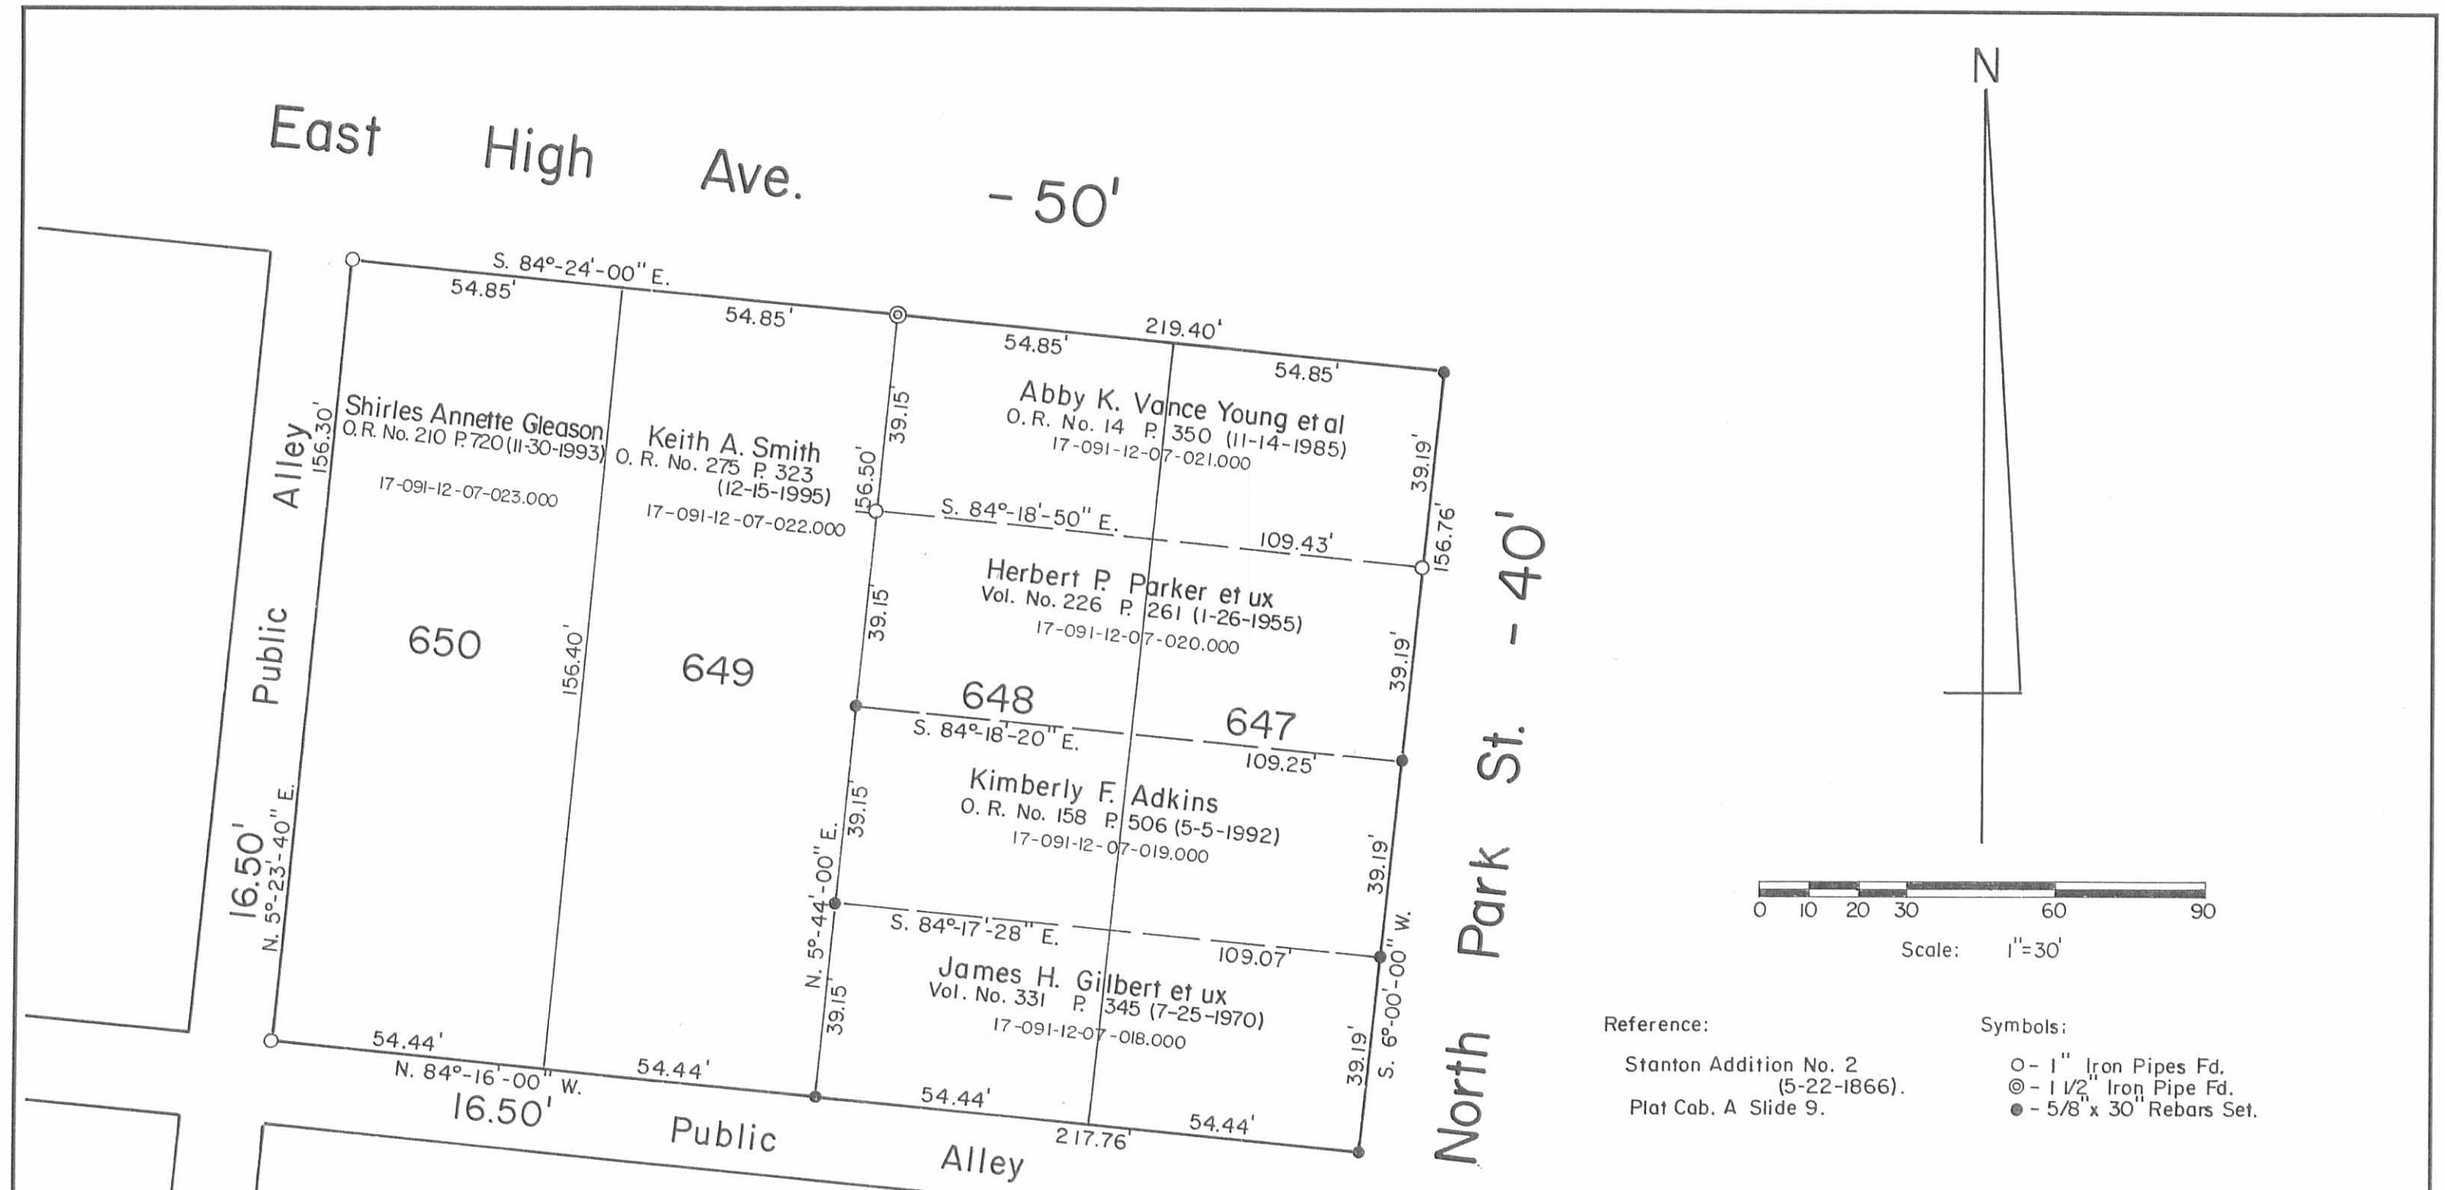

Reference:

Stanton Addition No. 2
(5-22-1866).
Plat Cab. A Slide 9.

Symbols:

○ - 1" Iron Pipes Fd.
◎ - 1 1/2" Iron Pipe Fd.
● - 5/8" x 30" Rebars Set.

INDEXED ON MAP
9069 IP

STATE OF OHIO
DANIEL E. GILBERT
5402
PROFESSIONAL SURVEYOR

Kimberly F. Adkins (Carman) Survey- Part of Lots No. 647-648,
Stanton Addition No. 2, City of Bellefontaine,
Lake Township, Logan County, Ohio.

SCALE: 1" = 30'	APPROVED BY:	DRAWN BY DEG
DATE: 4-19-1996		REVISED

Daniel E. Gilbert

Daniel E. Gilbert, P.S.
Reg. Sur. No. 5402

DRAWING NUMBER
096-022