REA CEMETERY
BLOOMFIELD TWP.
SEC. 27 T-7 R-8

RESURVEY OF LOTS

DEED VOL	PAGE	DATE
32	231	June 1857
59	414	Nov. 1879
87	570	Oct 14 1889

LOTS STAKED AS SHOWN ON W.A. GINN'S PLAT DATED 1891, AS DRAWN BY H.D. NOTESTINE IN 1929

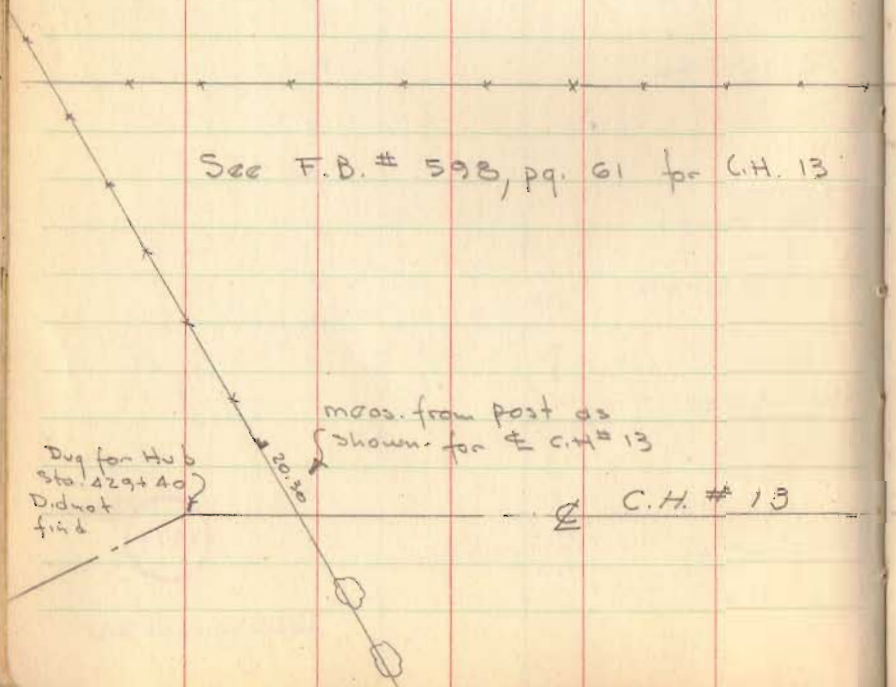

See F.B. # 598, pg. 61 for C.H. 13

Dodson
Cina
H. Notestine
J. Hover
T. Madden

Sept. 8-9, 1961

□ = Hub Set

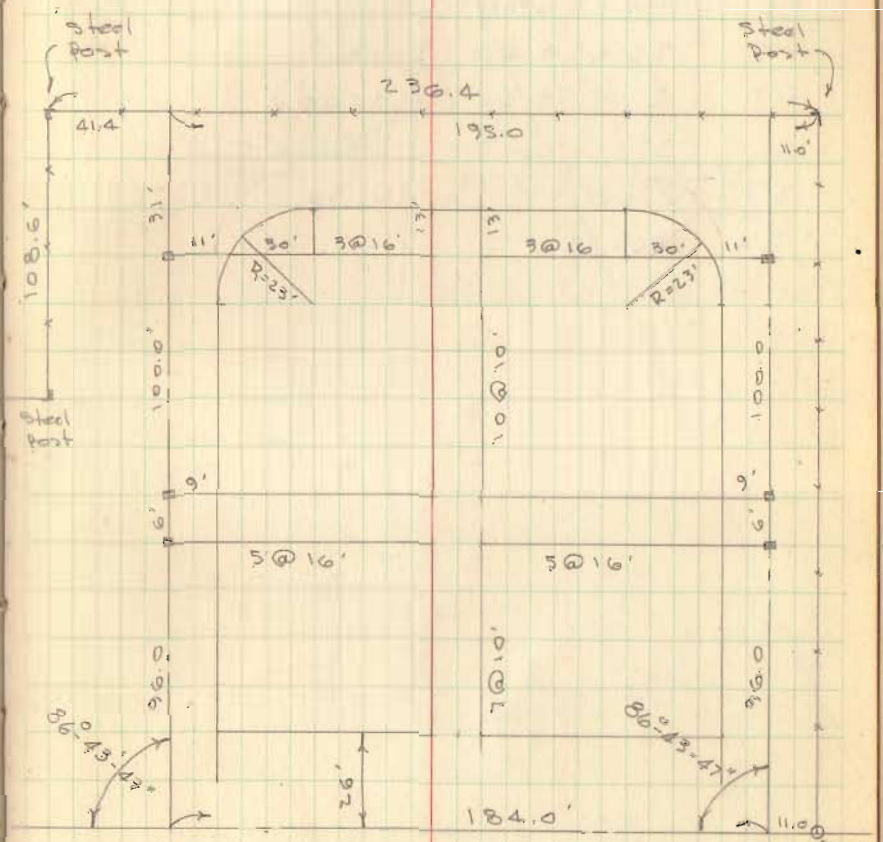

2699

INDEXED ON MAP