




Road 121 (Bakescreek Top)

Bellecenter - Whitetown Extension

40' East of Road 19

 

Road 121

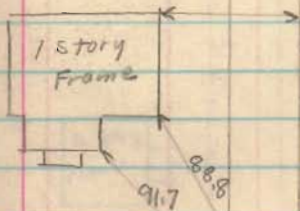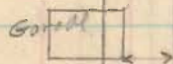

Road 19

Road 19

see Book 572
Page 64

7.33

Store



29.0

Concrete
Post

Road 40

see Book 582
Page 61

Road. 121

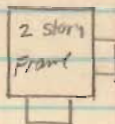
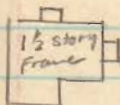
Dill
Kernels

st.


x > x >

x > x >

Road 121

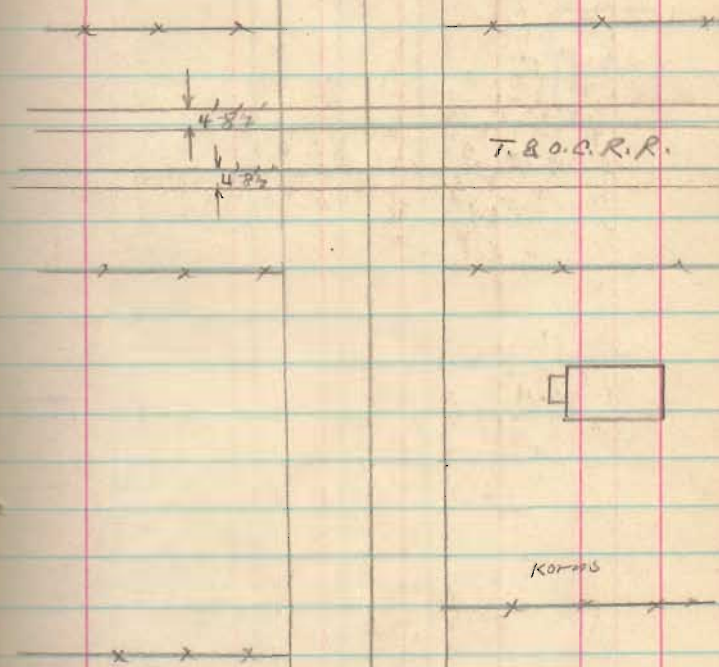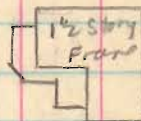


Road 121

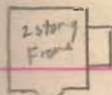

swalm

J. d. Ansley

P.D. winter

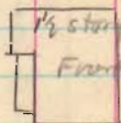



P.D. winters

J.O. Korms

J.O. Ansley

J.O. Korms

Road 121

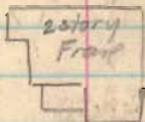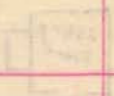

E. Limes



E. Limes



E. C. Potman




J. O. Ansley





Elmer C. Potman





Chas. N. Frederick

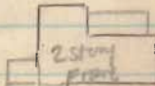




Road 121

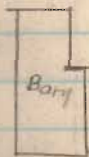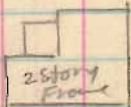

Road 121

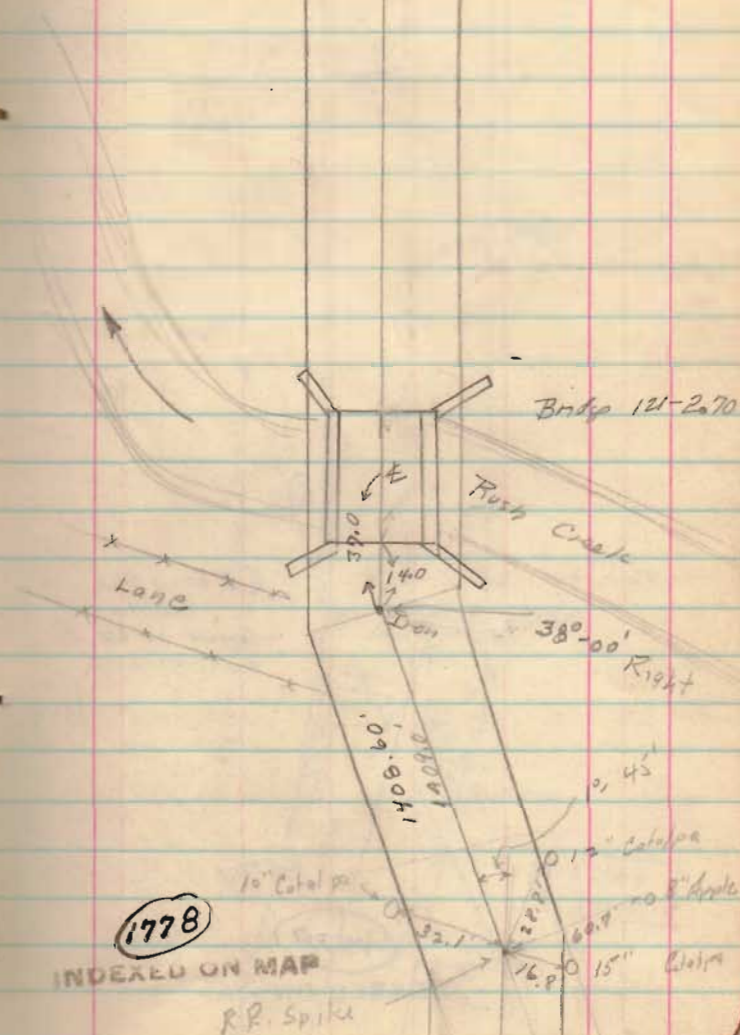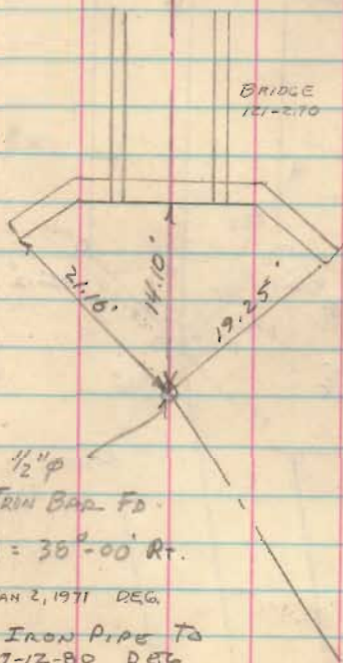

Road 121

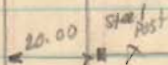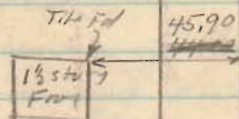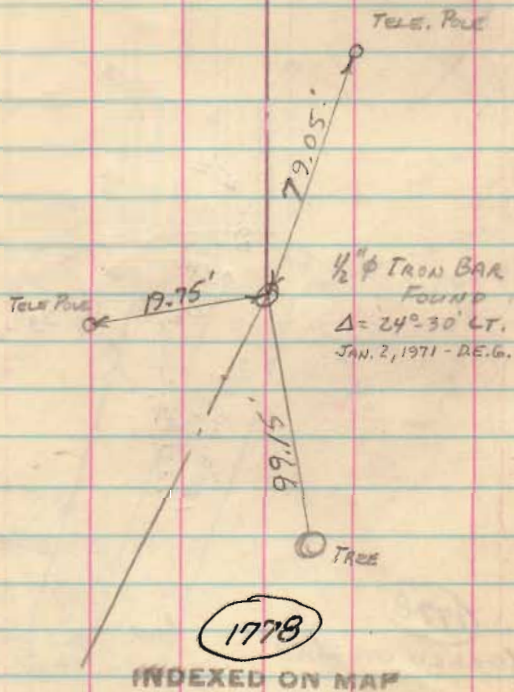

Stakes for Frame Survey

