

**APPROVED**

8-13-13

HARDIN COUNTY  
LOGAN COUNTY

TAYLOR CREEK TOWNSHIP  
BOKESCREEK TOWNSHIP

RUSHCREEK TOWNSHIP  
BOKESCREEK TOWNSHIP

TOWNSHIP ROAD 115 (60')  
(BASIS FOR BEARINGS)  
S 102°28'00" E 1781.12'


MICHAEL L. JACOBS AND  
JANNETTE E. JACOBS  
57.83 ACRES  
O.R. 554, PG. 128  
TRACT FOUR, PARCEL 2

DITCH

716.06'  
S 79°30'00" W

29.99'

PAUL L. TERRILL, TRUSTEE  
96.67 ACRES  
O.R. 230, PG. 405

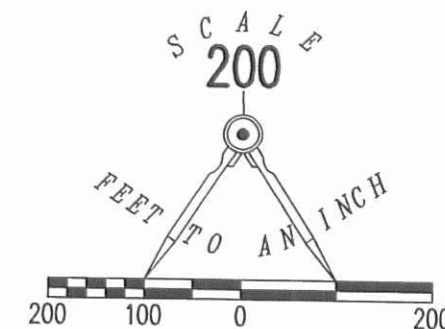


LEGEND:

- ⊙ 1/2 INCH IRON PIPE FOUND
- ⊠ 1/4 INCH IRON ROD FOUND IN CONCRETE
- 5/8 INCH IRON ROD SET WITH PLASTIC I.D. CAP STAMPED "LSM 7437"

RETRACEMENT SURVEY OF THE  
SOUTH LINE OF THE  
MICHAEL L. JACOBS AND  
JANNETTE E. JACOBS  
57.83 ACRE TRACT  
OFFICIAL RECORD 554, PAGE 128  
TRACT FOUR, PARCEL 2  
VIRGINIA MILITARY SURVEY 9978  
BOKESCREEK TOWNSHIP  
LOGAN COUNTY, OHIO

SURVEYED BY:

*William K. Bruce*  
WILLIAM K. BRUCE  
PROFESSIONAL SURVEYOR 7437  
JULY 25, 2013

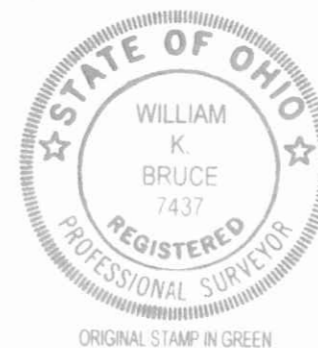

COPYRIGHT 2013 BY:  
LEE SURVEYING & MAPPING CO., INC.  
117 North Madriver Street  
BELLEFONTAINE, OHIO 43311  
(937) 593-7335  
WWW.LSMINC.US  
surveys@lsminc.us  
KSS D0713 55820713 L-5582-3

2 WORKING DAYS  
**BEFORE YOU DIG**  
CALL TOLL FREE **800-362-2764**  
OHIO UTILITIES PROTECTION SERVICE.

INDEXED ON MAP

9666 1P