

Temperance St.

East Liberty

V.M.S. 4689

Temperance St. 60'

stakes placed 30' from E 1-2-3-4-5 etc.


1686

INDEXED ON MAP

Sept. 18, 1935

clear  
F. Wright  
E. Coe  
J. Montgomery

68

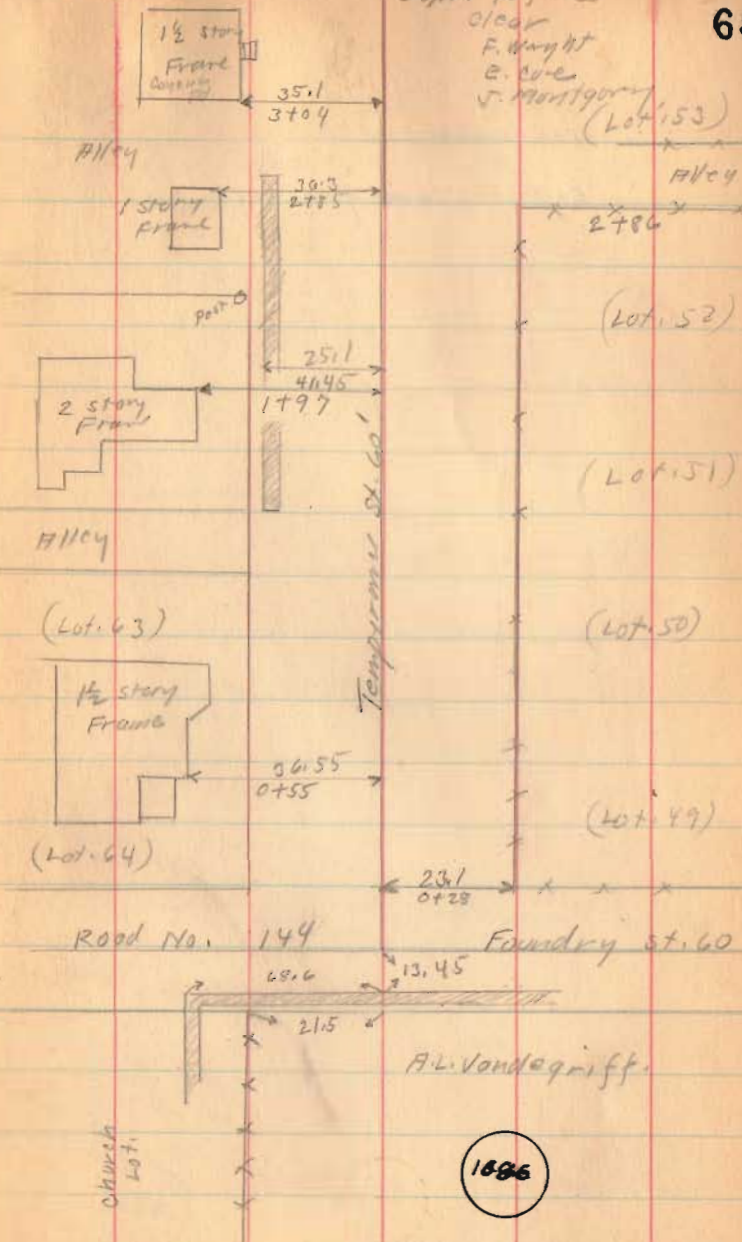


1686

INDEXED ON MAP

Temperance St.

East Liberty

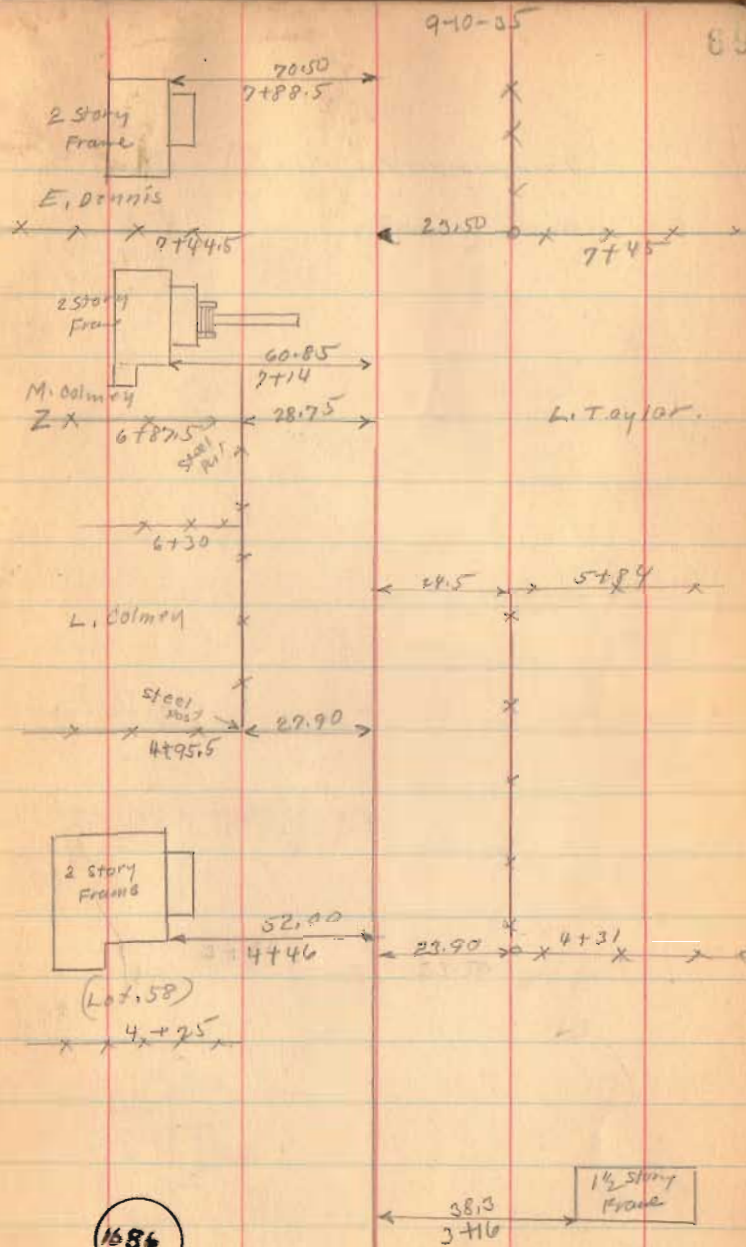


Temperance St.

East Liberty

9-10-35

70

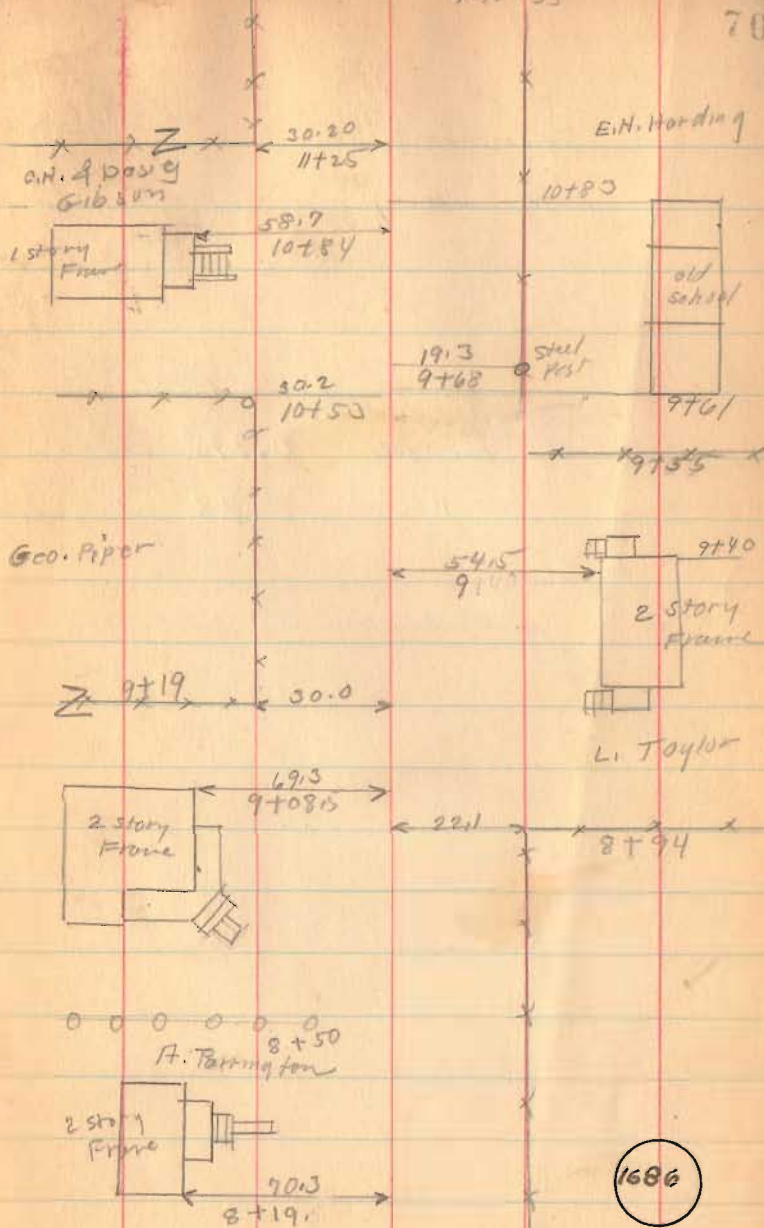

INDEXED ON MAP

Temperance St

East Liberty

Length 1452 Feet

Length 0.275 Miles

" 0.28 "

9-10-33

71

