

Lee Surveying and Mapping Co.



Farm Surveys • Lot Surveys • Descriptions • Subdivisions

855 EAST SANDUSKY AVENUE
BELLEFONTAINE, OHIO 43311

CLAYTON M. LEE, P. S.
(513) 593-5780

Gregory Hillard

Being a tract of land off the Northwest corner of that 89 acres described in Volume 352, Page 126 and located in the N E $\frac{1}{4}$ of the N. W. $\frac{1}{4}$ of Section 27, T-3, R-14, Harrison Township, Logan County, Ohio and better described as follows:

Beginning at an iron rod set in the center-line of Township Road 206, said point being on the north line of Section 27 and lying a distance of 1319.65 feet from the Northwest corner of said Section 27.

THENCE, with the North line of Section 27, N 88° -00' E, a distance of 760.0 feet to an iron rod set at a corner post.

THENCE, along a fence, S 0° -38'-30" W, a distance of 673.4 feet, to an iron rod.

THENCE, N 88° -57' W, a distance of 732.4 feet to an iron rod set on the west property line of said 89 acres.

THENCE, with said West property line, N 1° -47' W, a distance of 633.7 feet to the point of beginning. Containing 11.19 acres.


Last previous record, Volume 352, Page 126..

Surveyed Feb. 26, 1976 by

Clayton M. Lee

Clayton M. Lee

Reg. Surveyor 6181

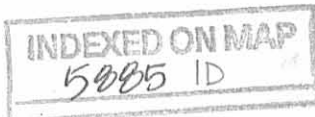

P. BELL
132.34 AC.

TWP. RD. 206

MON. 319.65

1319.65'

TO NW COR OF SEC. 27

N 88°-00' E

760.0'

SEC. 28

SEC. 27

N 1°-47' W

633.7'

11.19 ACRES

S 0°-38'-30" W

673.4'

NORTH



SCALE 1" = 200'

SURVEY BY

Clayton M. Lee
CLAYTON M. LEE
REG. SURVEYOR 6181

GREGORY A. & DEBRA L. HILLARD
89 AC. (VOL. 352, PG. 126)

5885 IP

INDEXED ON MAP

SURVEY OF 11.19 ACRES IN
NE 1/4 OF NW 1/4 OF SEC. 27, T-3, R-14
HARRISON TWP.
LOGAN CO., OHIO

2-26-76