

Ricks to Hurley Survey Description

November, 1972

Being situated in the Village of Huntsville, McArthur Township,
Logan County, Ohio; and being a part of V.M.S. #9903 - 9928.

Beginning at the intersection of the center of State Route 274 (the
north corporation line of Huntsville) with the east line of said V.M.S.
#9903 - 9928 (also the center of Lima Street).

Thence with the east line of V.M.S.#9903 - 9928 S 12° - 00'E
971.55 feet to the southeast corner of a 0.18 acre tract. Said point is
the beginning point for this description.

Thence continuing with the east line of V.M.S.#9903 - 9928 S 12° - 00'E
78.0 feet.

Thence S 78° - 00'W 198.2 feet to a iron, passing thru a iron at
30.0 feet.


Thence N 11° - 30'W 78.0 feet to a iron at the southwest corner
of said 0.18 acre tract.

Thence N 78° - 00'E 197.5 feet to the place of beginning, passing
thru a iron at 167.5 feet.

Being all of a 0.30 acre tract.

Owen K. Shirk

Surveyor 4271

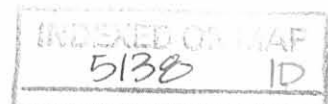

RICKS TO HURLEY SURVEY

McARTHUR TWP., LOGAN CO., HUNTSVILLE, OHIO

V.M.S. 9903-9928 ;

1" = 50'

STATE ROUTE 274



Owen K. Shirk

Surveyor 4271

Nov. 24, 1972

INDEXED ON MAP
5138 1P