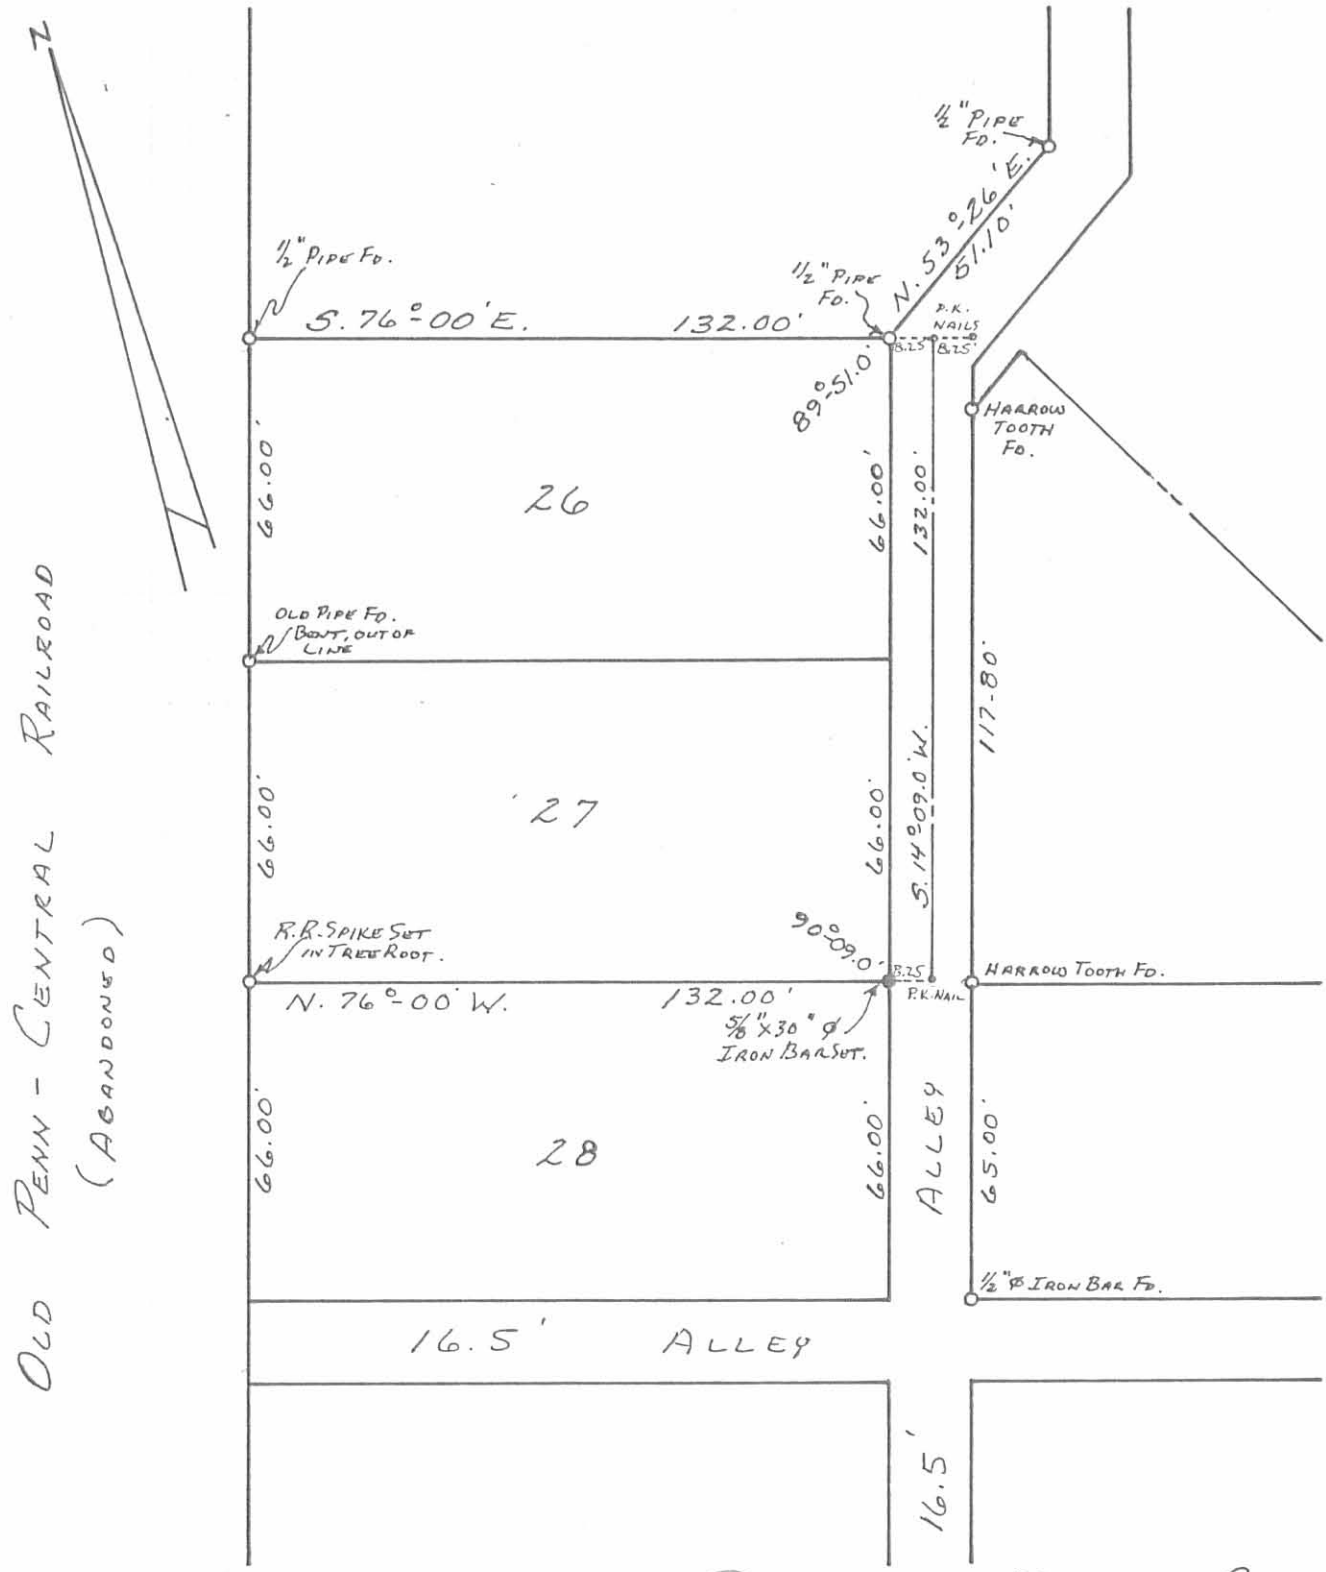


7041 IP

INDEXED ON MAP

MUSSMAUL SURVEY
NORTH LINE OF LOT NO. 28
VILLAGE OF HUNTSVILLE
V.M.S. NO. 9904
MC ARTHUR TOWNSHIP
LOGAN COUNTY, OHIO
JUNE 2, 1984

SCALE: 1" = 40'

SURVEY AND PLATTED BY:
DANIEL E. GILBERT, P.S.
REG. SUR. NO. 5402
105 ORGAN ST.
BELLEFONTAINE, OHIO 43311