33.5
28.8

5.6

Gr. = 1228.8
FL = 1228.07

10" V.S.P.
riser

41'

1243.84
12.06
1231.78
3.72
1235.50
6.67
1228.83
4.76
1224.07

1243.84
14.05
1229.79

D. Dodson
V. Detrick
C. Nicholls

July 31, 1953
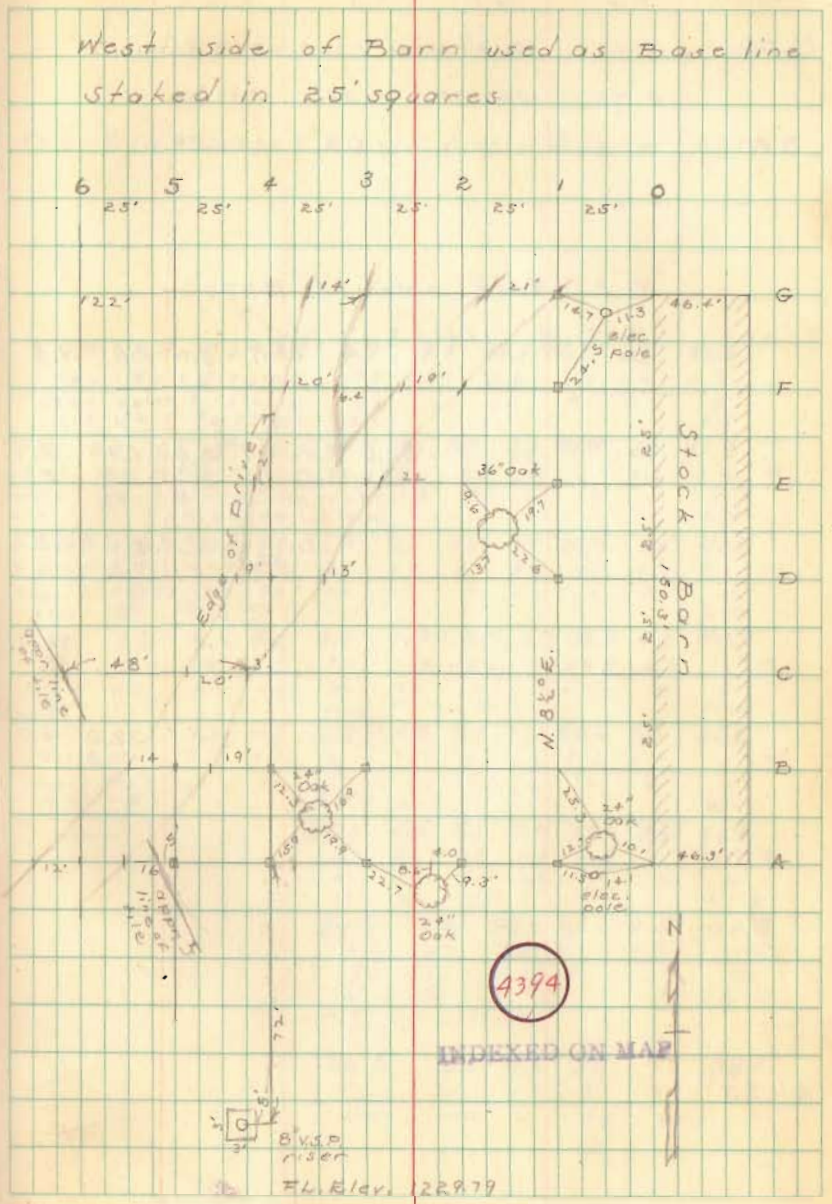
West side of Barn used as Base line
Staked in 25' squares.