


4th Mo. (April) 19th 1830 - (Surveyor No. 131)

8244

Surveyed 96 acres of land for James
 Crew and Martin Marmion, administrators of
 William Zane dec'd in obedience to an order of
 the court of common pleas of Logan County
 Beginning at Sugartruss and buck, south west
 corner to Marmion's 5 acres which he purchased of
 said William Zane; thence $s 75^{\circ} \frac{3}{4} E$, crossing a road
 at $3^{\frac{1}{2}}$, and a spring branch at 35 poles, 76.7 poles
 to a stone touch, Sugartruss and iron wood, $s 88^{\circ}$
 corner to said Marmion's lot of land; thence $s 75^{\circ} \frac{3}{4} W$
 crossing a small branch at 27 , and a road at 57
 poles, Mad River at 123 poles, 187 poles to the centre
 of the Spring branch, which formerly ran by the
 Sawmill; thence down the branch with its meanders
 to where the line between

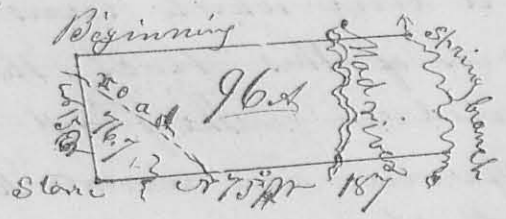

the heirs of Robert
 Armstrong and
 William Zane crosses
 said branch; thence

$s 75^{\circ} 45' E$, crossing Mad River at 115 poles to the be-
 ginning containing 96 acres $s 75^{\circ} 45'$ part of survey
 no 3107 in the name of the Rep. of James Calderwood

Robt. M. Marmion } 66
 Benjn. Butler }
 Ja. Crew }
 witnesses

Ja. Marmion C. L. 6

8245

7th Mo. (July) 31st 1830 - (Surveyor No. 132)

Surveyed 10 1/4 acres for Robert Patterson; Beginning at
 a stake in the centre of the road or street, in the south
 line on the south side of Bellefontaine; thence with
 with said line, west 68 poles to a stake in the east line
 of John Powell's land; thence south 95.9
 poles to a stake, the centre corner of
 section 34 Town 4 Range 14 N.W.



thence east 68 poles to a stake in the
 road from Bellefontaine to Urbana;
 thence with said road north 95.9 poles to the
 beginning; Robert & Melrose Christy Thurtz 66; Ja. Marmion C. L. 6