Lot # 31

Couples Addition

Lakeview Ohio

Plat Book Vol. 2 pg. #1

Hobart L. Niece

July 25, 1953 85° nice day

D. I. Dodson & Chas. Nicholls

Note —

East line Main st. = E. edge of sidewalk

Meas. dist. between sidewalks - used ½ this dist. as centerline of Main - Harrison & Elm Streets

Meas. From Iron pin S.W. cor. Lot # (See Lo. Co. Engineers F.B. # 608 pg. 21 & 2) Point "K" of F.F.N. Survey) to the S.W. cor. lot # 28 - 66.25 + 66.25 + 50 = 182.5'

Note: Dedicated Plat of Couples 2nd Addition shows lot 31 as being 65' Frontage - this is an Error - Lot # 31 is not a part of Couples 2nd Addition

INDEXED ON MAP
440

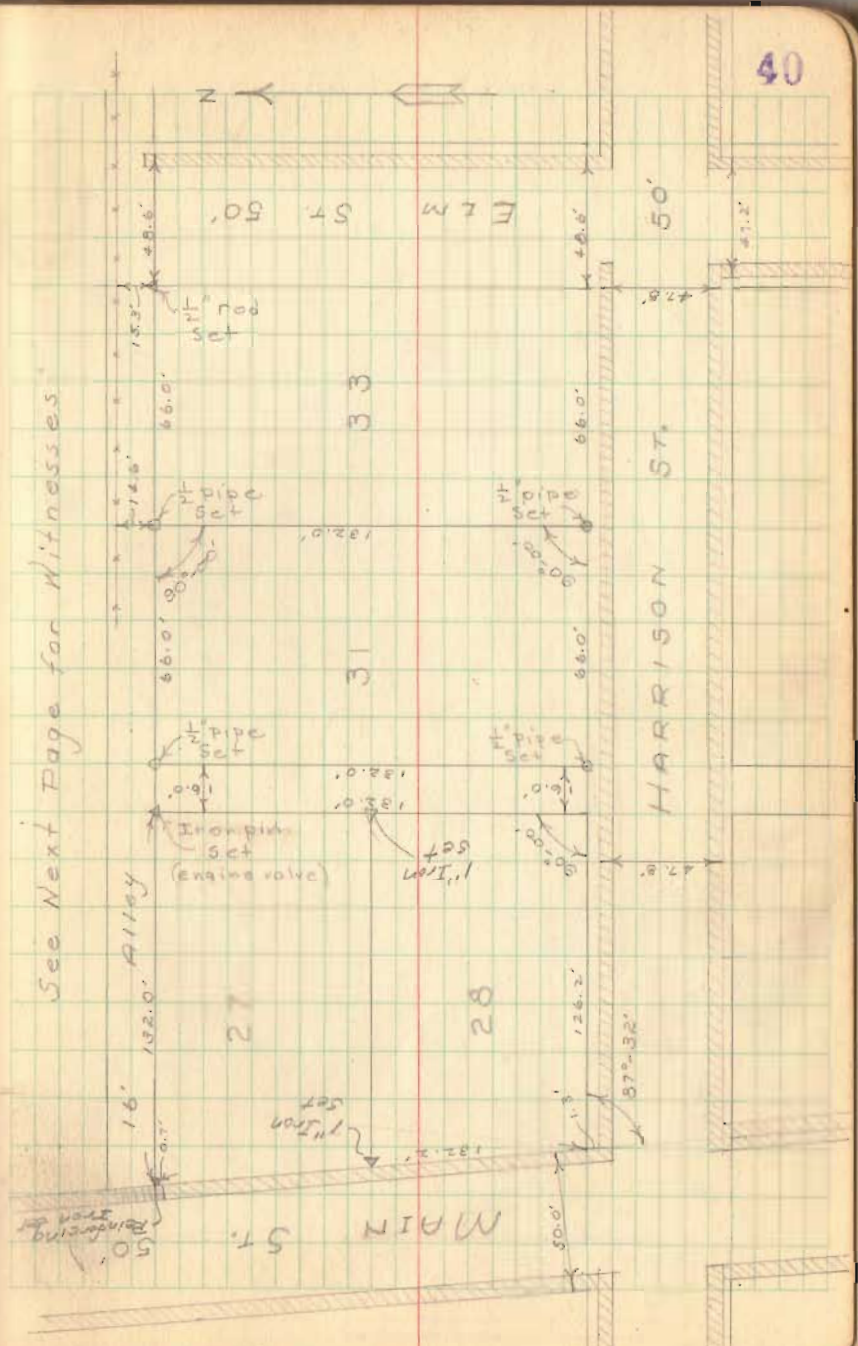

Lot # 31 - (cont'd)
Couples Addition

July 25, 1953
85°

41

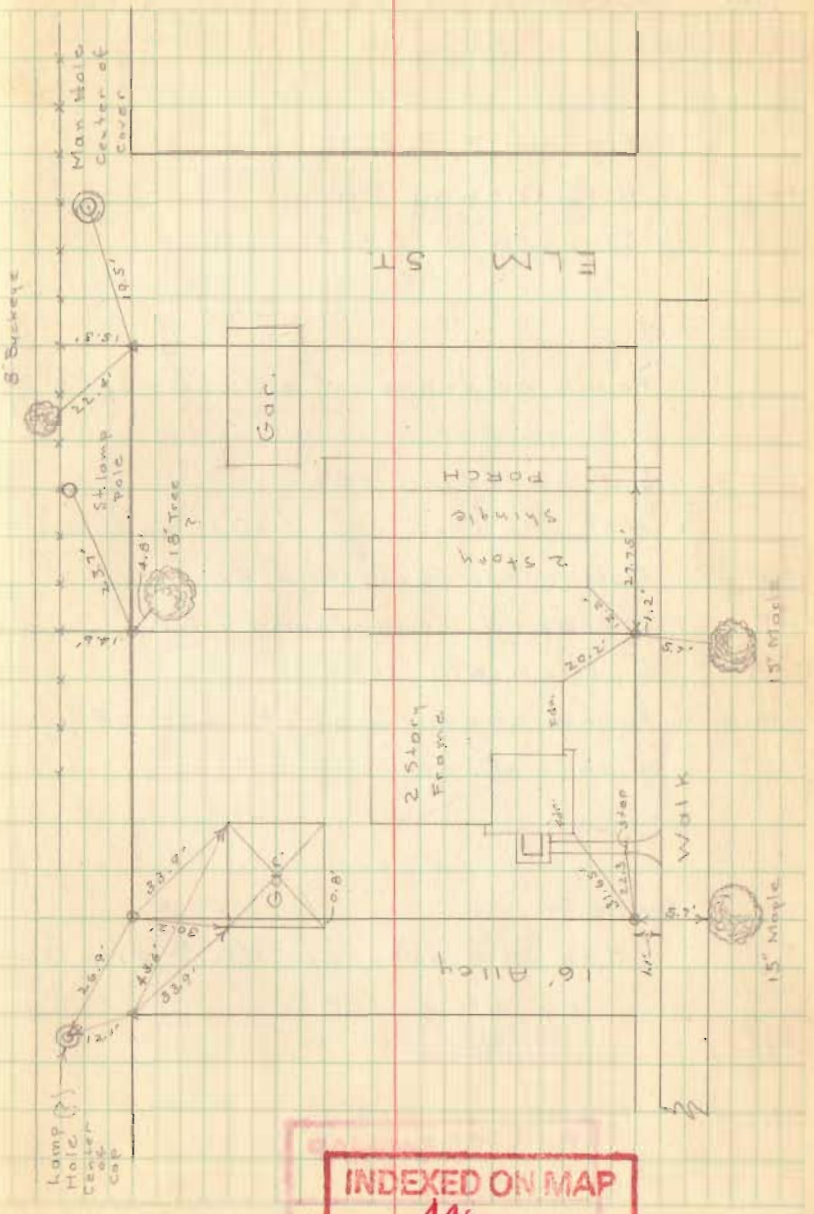

INDEXED ON MAP
446