Survey for Claude Brubaker

Lake View

S 34, T 6, S R 8 E

See page 18 - this book

See survey by W. A. Montgomery)

A	Iron	Post	(Found)
B	Iron	bar	(Found)
C	Iron	Pipe	(Set)
D	Iron	Pipe	(Set)
E	Iron	Pipe	(Set 3-20-37 by CAI)
F	Iron	Pipe	(Set 3-20-37 by CAI)
G	Iron	Pipe	(Set 3-20-37 by CAI)
H	Iron	Pipe	(Set)
I	Iron	Post	(Found)
J	Iron	pipe	(Found)
K	Iron	pipe	(Found)
L	Nail	in walk	(Found)

Deed description in red and yellow

" " N. G.

C. A. Inskeep 9-4-37
J. H. Inskeep 9-7-37
G. C. Inskeep

North

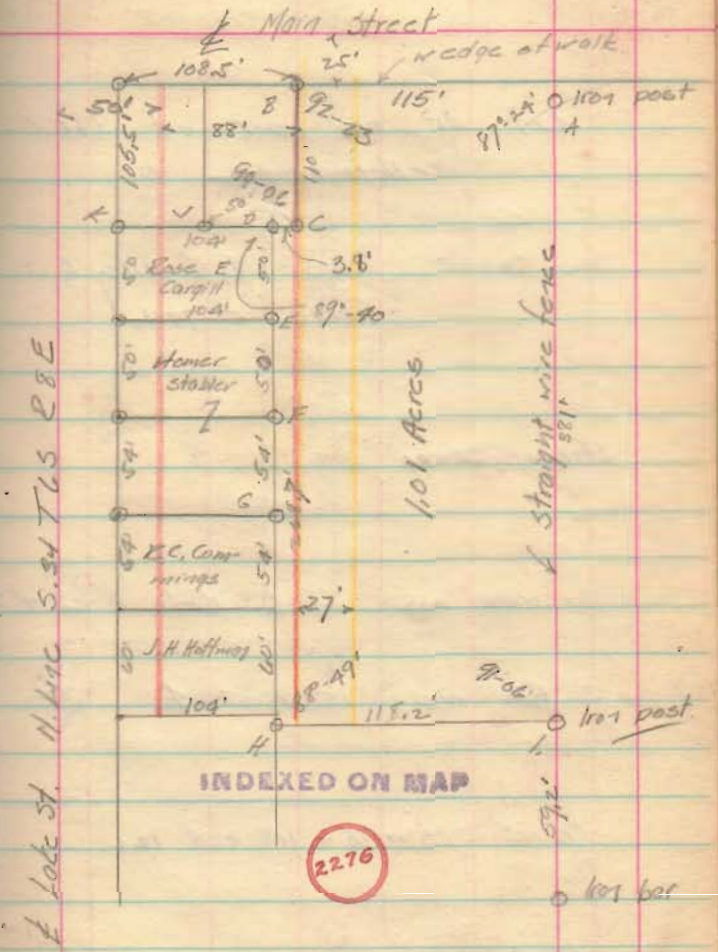

Deed of Farmer Banking Co to Joseph C. Brubaker dated 6-29-37 recorded in Book 157 Page 231 describes LV only 115' x 24 rds (3¾') beginning 50' S of ℄ N.H. Pike