The following described land in the Village of Lakeview, Stokes Township, Logan County, Ohio and being in Section 27 Town 6 S. Range 8 E.

Beg inning at an iron in the East side of Oak Street and at the south side of a ten foot Public Alley. Said Alley being adjacent to and south of Lot Number 63.

Thence with the East side of Oak Street S. 14 - 28' E. 50.00 feet to an iron said iron being the true beginning point of this surevy.

Thence N. 840 - 39' E. 74.50 feet to an iron in the west side of ten foot private right of way. The last described line being ten feet south of an parellel to the south side of a 0.13 acre tract now in the name of Ted Metcalf.

Thence with the west side of said ten foot private right of way S. 1 - 55' E. 47.00 feet to an iron.

Thence S. 85 - 08' W. 64.30 feet to an iron in the east side of Oak Street.

Thence with the east side of Oak Street N. 140 - 28' W. 47.00 feet to the place of beginning.


The above described tract contains 0.07 of ane acre.

County Engineer Logan



IMDEXED ON MAR



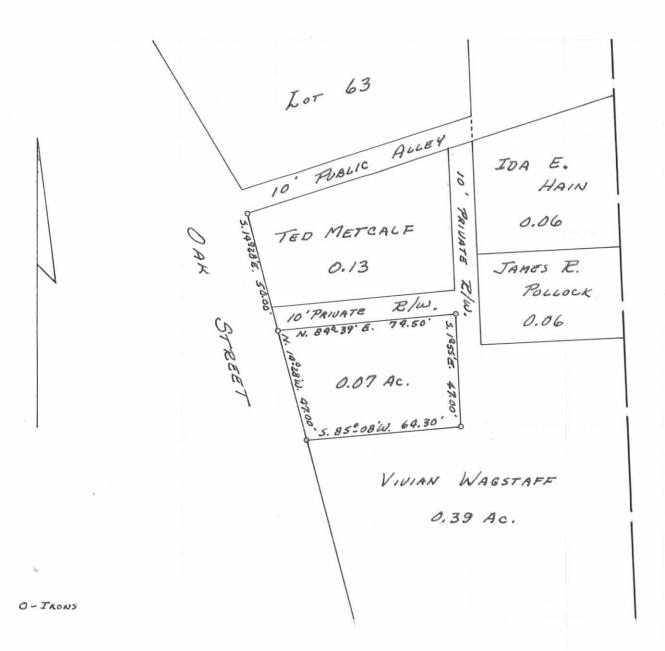

WAGGSTAFF SURVEY

SEC. 27 T.GS. R.BE.

VILLAGE OF LAKEDIEW

STOKES TOWNSHIP

ZOGAN COUNTY, OHIO

SURVEYED BY F.F. WRIGHT

JULY 1965

SCALE: 1"= 40'

DRAWN BY D.EG. 8/26/65 38ZZ IP