Garrison Surveying } chain carriers

R. P. STUDLEY & Co., Manufacturi

STATION.	ALIGNMENT.	DEFLECTION.	REMARKS.

Shirk Harmon land S 44 3/4 E from 6 9/4

(1) Start 25' E of d. 72.00 a. S 9/4 Harmon land. Random line
Thence N 5 1/2 E with W line Harmon land
at 1346 1/2 - 2 post on Shirk 10 a.
" " pt stake in random line.
" Spicks corner pt 7 in random line
" 2636 N 83 1/2 E Allen Derr land, set 25 W
" 2640 set 7 in dis line N 9 1/2 E Allie Derr 8/al. 1/4 sec. Corner to
1320 drive old boiler 4" x 24" = 2 C at 25 W of Road line at nine feet
(2) Start at stake = 2640 of (1) Thence with Road line
S 85 1/2 E with public road 8/ Shirk Sec 2.
at 836 1 pass S 9 1/2 E 15 a in line of pine fence N.
" 1332 " 82 " iron pin in fence road
" 1771 - line cross Shirk & N W 1/4 school lot set at 7 N 85 1/2 E
" " set 7 in dis line
(3) Start at 25 E of 7 1771 of (2) S 5 1/4 W from 1/4 to 1/2
at 100 1/4 set bolt 7 1/2 x 10" in east track Central Pike = 1/2 W. 20'
" 1320 set 7 for dist. At 1326 1/2 set 7 middle line of W. sec
" 2653 arbor feet one fence E.W. 7 N.
fall 33' E of one chord dis. = 8 D roads
at 26. From 1/4 S 5 1/4 W. 1004'. From 1/2 to 3 mile one fence 1649

(4) Start 25 W of ten post 2653 of (3). N 84 1/2 W = N 8 1/4 W.
at 1122 - cut line on S line Harmon one fence = C
17 1/2 fall 2.0 1/2 N 8 7 = dip S = 4 1/2 = d.

(5) Start at iron pin (fence 1320 of W line on dis line 2 to 2
S 84 1/2 E on line Shirk. At 20 set stone at 20 ft ash 6 to
at 1540 set iron pin 5/8" x 18" in mound Central Pike = 1/2
1776 Quincy Edwards N 9 1/2 W at 1324 1/2 - 2 of 5 1/2 = Quincy 5 to 1

Section 2. Town 3. Range 14.
In Liberty & Union Townships Harmon Surv

53

TOPOGRAPHY.

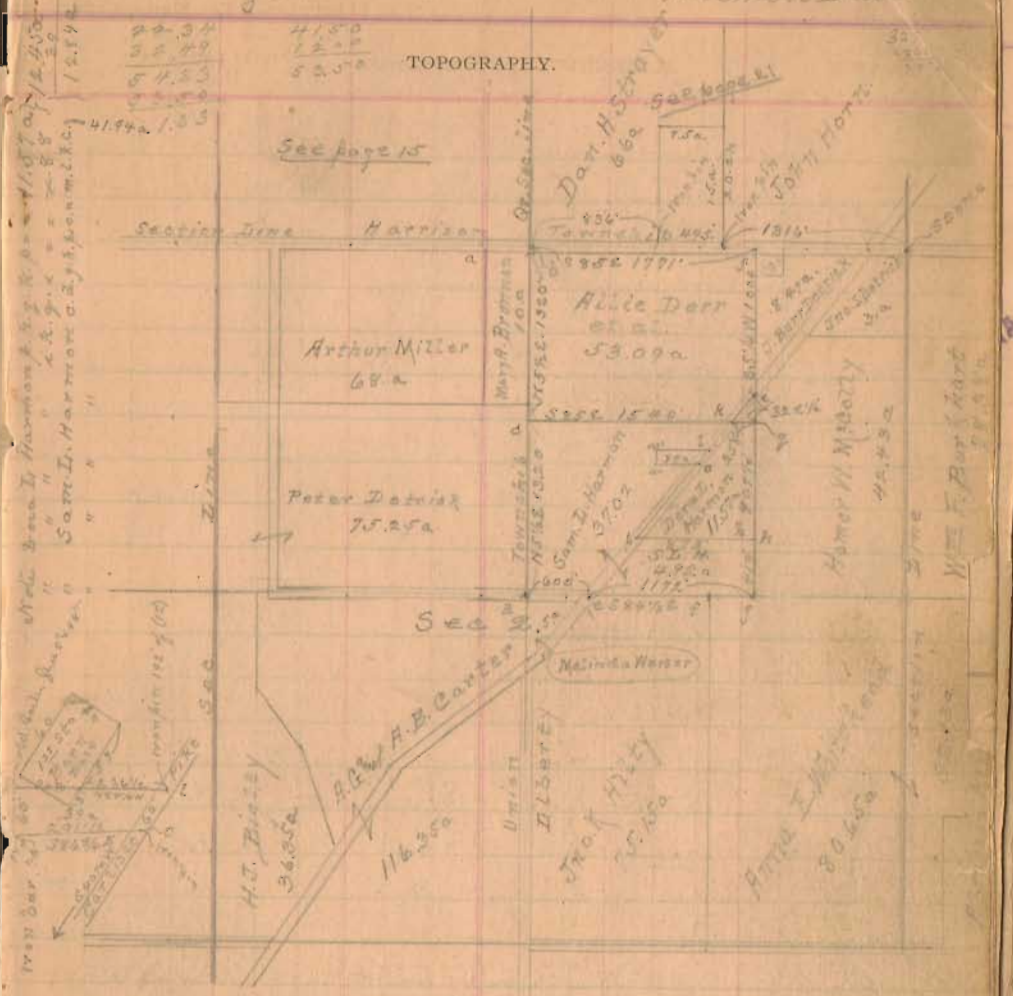

(12) Apr 29 - 6 Start at iron pin 1/4 post = 11.02 7 (11) Thence on line of
fence K & P S 40 1/2 W 192 set iron pin 6 x 36 pts from 1/4 N C 2 on A. 39 a
13 Start at 192 of (12) N 84 1/2 W on N line 2 on A Harmon 39 a
at 236 1/2 stake 6 pts from 2 on A at 3 E of 89 1/4. At 327 set 8 NW 1/4 39 a
(14) Start at 327 of (13) S 5 1/4 W. at 60' set 7 S W 1/4 39 a
(15) " Start at pin 192 of (12). S 40 1/2 W mitt pike at 60' set iron pin SE 1/4 39 a
(16) Start at 7 at 60' of (15) S 84 1/2 E on Shirk 39 a. at 2 8 1/2 iron pin in fence
at 60 of (15)

See page 48 Notes
" " 79 plat

22

INDEXED ON M