Hamer Survey
Liberty Twp.
Sec. 32 T 4 R 14

125

INDEXED ON MAP

March 28 1925
Montgomery
Keller

West Liberty Pike.

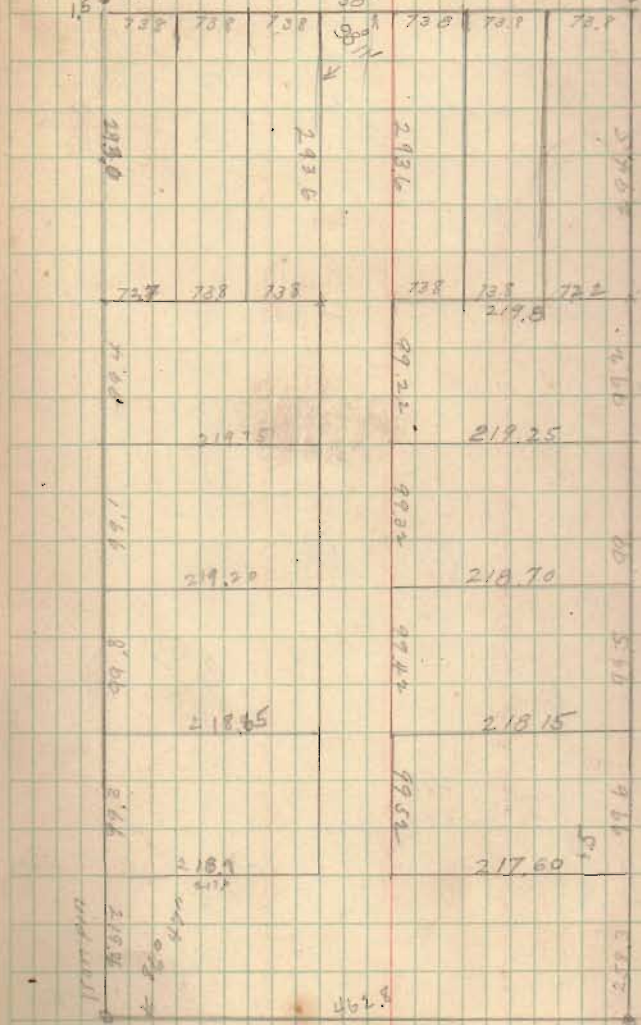
Iron pin
30'
15
1.5
738
738
738