Surveyed for

Dr. Ed. Henning et-al

Pt. Sec. 4, T. 4, R. 14 and Pt. Sec. 34, T. 5, R. 13

Liberty Township

May 28, 1907

(161)

INDEXED ON MAP

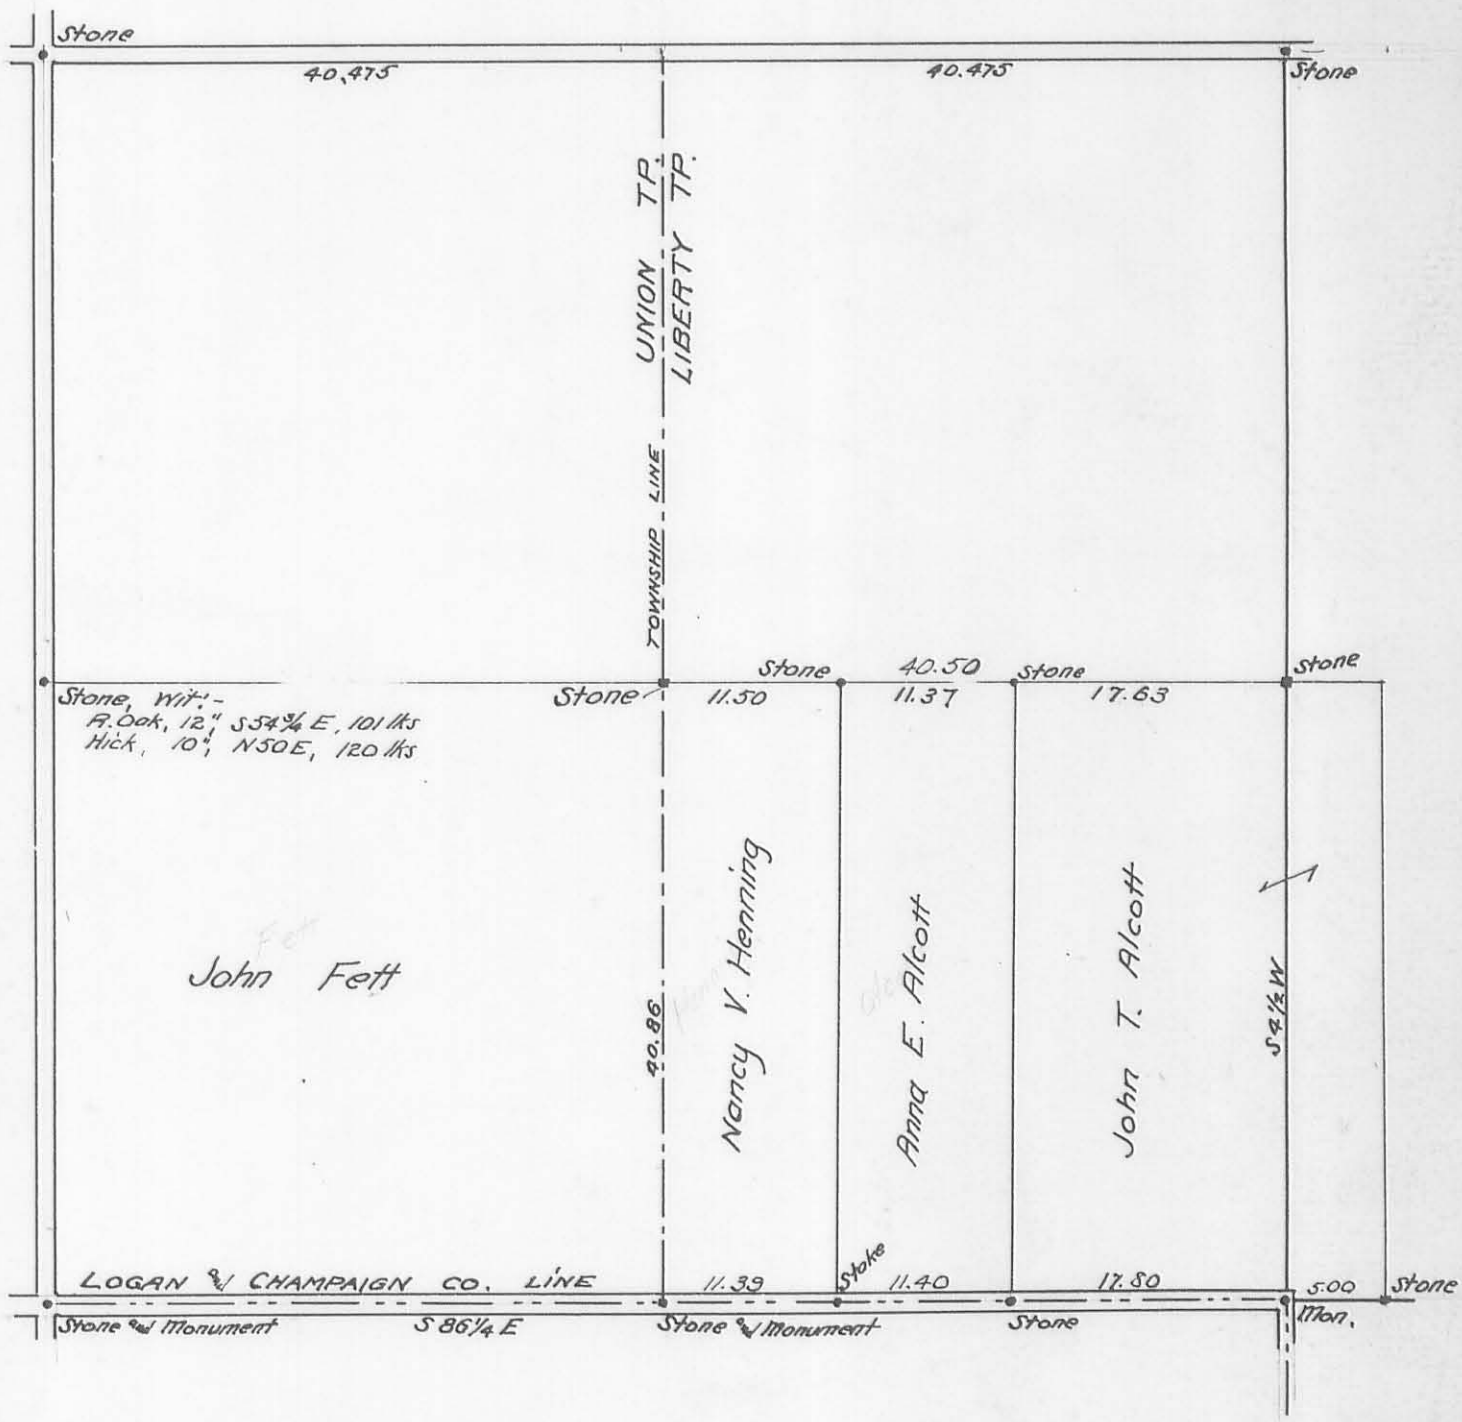

Field Notes Book 55
Pages 11-12

Dr. Henning – Alcott 1907

Cor. Co. Line – S 86¼ E

Mens. E. from SW < Liberty Tp.
Set stake for dist. at 11.00
" " " 20.00
at 22.77 fence ⊥ Rr.
" 39.45 " " ", E. side driveway
" 40.89 stone at < Sec
at 22.49½ set stone for < Alcott
at 11.39, E. Line Henning,
Set < from old wit. stump
Set stake

at 11.39 Random N 4 E
at 17.66 stake for dist.
at 30.00 " " "
at 40.00 " " "
" 40.13 fence ⊥ S

at 40.70 Set stone in line
from old wit. 63 lks E. of
Random. reading 63 lks. Sine 40.70

11.

4-4-13 Liberty Tp.

Cor. E. line Sec, S 4½ W

Cor Line Fett & Henning N 4½ E

Found old stone at cent. E.
line of Sec, at 8 E < Yoder
Set Rr. 20', random N 85¼ W
at 17.66. stake
" 30.00
" 40.00
" 40.13 fence ⊥ S
at 29.00 set stone NE < Henning
at 81.11 Came on 32' N of
stone in road, NW < Fett,
32 – 20 = 12 Northing
wit. stone NW < Fett
Red Oak 12" S 54¾ E 101.1 lks
Hick 10", N 50 E, 120 lks

+ 81.11
40.56 at 40.56 Set stone
NE < Fett
Corrected line comes 12" N. of N.
side of Fetty anchor post

(161) INDEXED ON MAP

Mill Book D 1-37

Fields E. line ——— 40.86
+ 40.80
20.43

Fence line 40.55
+ 40.55
20.28

at SE ¼ Sec 4.
Commence at Co. line Mon
S 84½ E with fence line
at 5.00 set stone, SE ¼ Sec 4

at 13.71 fence N. with Yoders
garden gate
at 19.99 Amos Y's fence
at 40.51 set stake for dist. ¼ line
at fence at S. side of pike
at 40.81 cent road and (about)
in N. line Sec; cross and 11 links
W. of Tp. line

(161) INDEXED ON MAP

Book D Page 7

Commence stone NE ¼ Sec 4.
Meas. W. along pike
at 40.20 cent tel. pole
Stone stone in X road NW ¼ Sec 4
Meas E. at 40.73 cent tel pole
40.20 + 40.73 = 80.93 ÷ 2 = 40.46½
Set stake for Tp line at 40.46½
Set stone at Fields ¼, 5 links E
Wood Alcott Stone 2¾ links E