C.H. No. 101

60' R/W

See Bk. C pg. 148

Recds. from stone @ 49 & 274, North 1140.5' for ℄ C.H. 101, used this point & stone @ E. line of Hoon for ℄ C.H. 101, stakes set for elec. pole line - 30' S. of ℄.

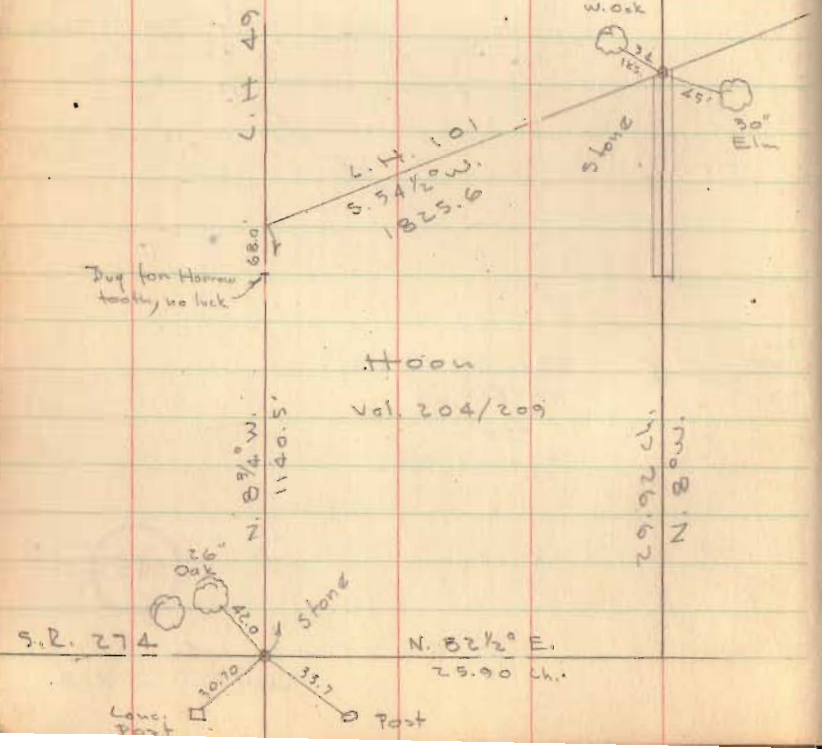

Dodson
Gilbert
Tevis

March 10, 1958

Snow

Distances & Bearings From Deeds

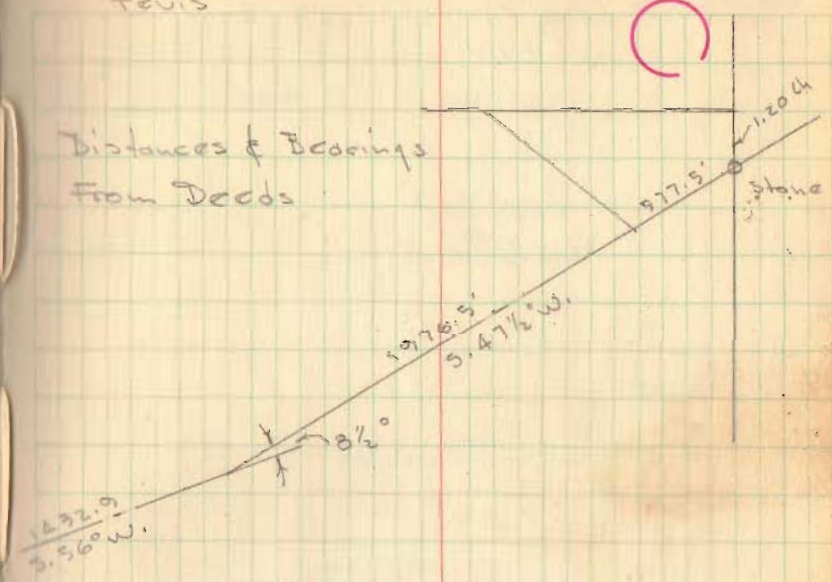

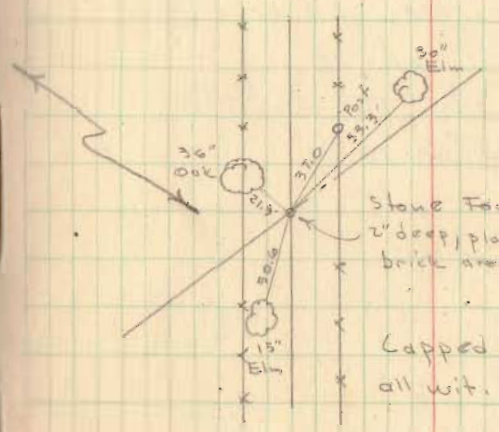

FB 702

3457

INDEXED ON MAP