INDEXED ON MAP (19)

T. 3. R. 13.
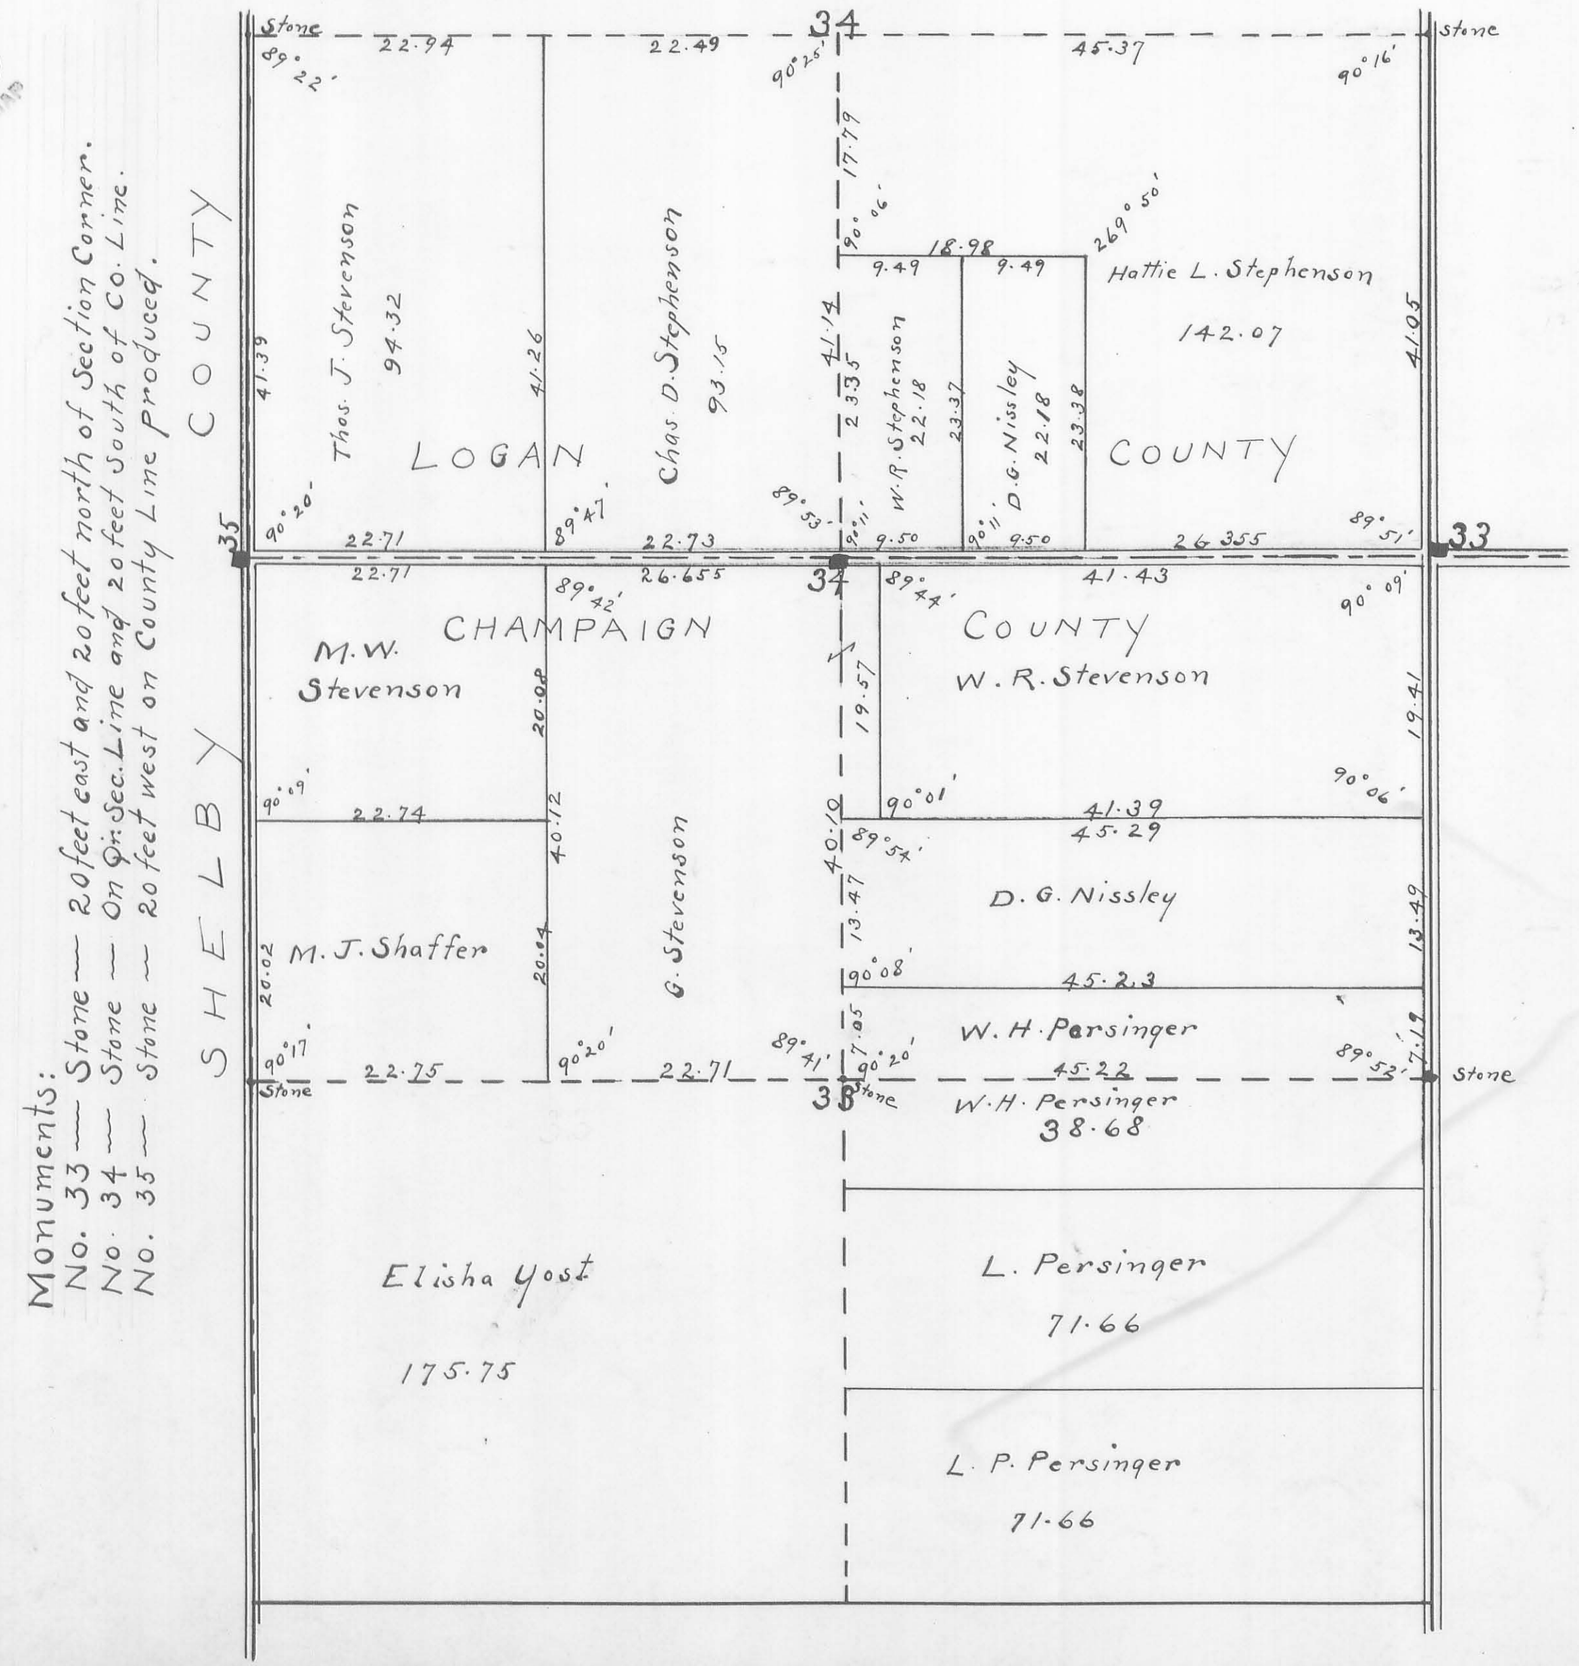
Monuments:
No. 33 — Stone — 20 feet east and 20 feet north of Section Corner.
No. 34 — Stone — On Qr. Sec. Line and 20 feet South of Co. Line.
No. 35 — Stone — 20 feet west on County Line Produced.