


SHELBY CO. OHIO.
SALEM TWP.
LOGAN CO. OHIO.
PLEASANT TWP.

Revised

RIGHT OF WAY AND TRACK MAP
DETROIT, TOLEDO & IRONTON R.R.
Station 3504+00 To Station 3609+00
SCALE 1" = 200 FT. JUNE 20, 1938
OFFICE OF CHIEF ENGINEER


NOTE: Stationing subtract 10835.0 ft. to obtain new mileage 2052 miles

DETROIT TOLEDO AND IRONTON RAILROAD
THE ANN ARBOR RAILROAD
18200 MICHIGAN AVENUE, SANDUSKY, MICHIGAN 44871
IT IS MUTUALLY UNDERSTOOD THAT THE DTLR RR AND/OR
AA RR ARE NOT RESPONSIBLE FOR ANY ERRORS, OMISSIONS
AND/OR DISCREPANCIES THAT MAY EXIST ON THIS PRINT.
OFFICE OF THE CHIEF ENGINEER
DATE 4-21-70




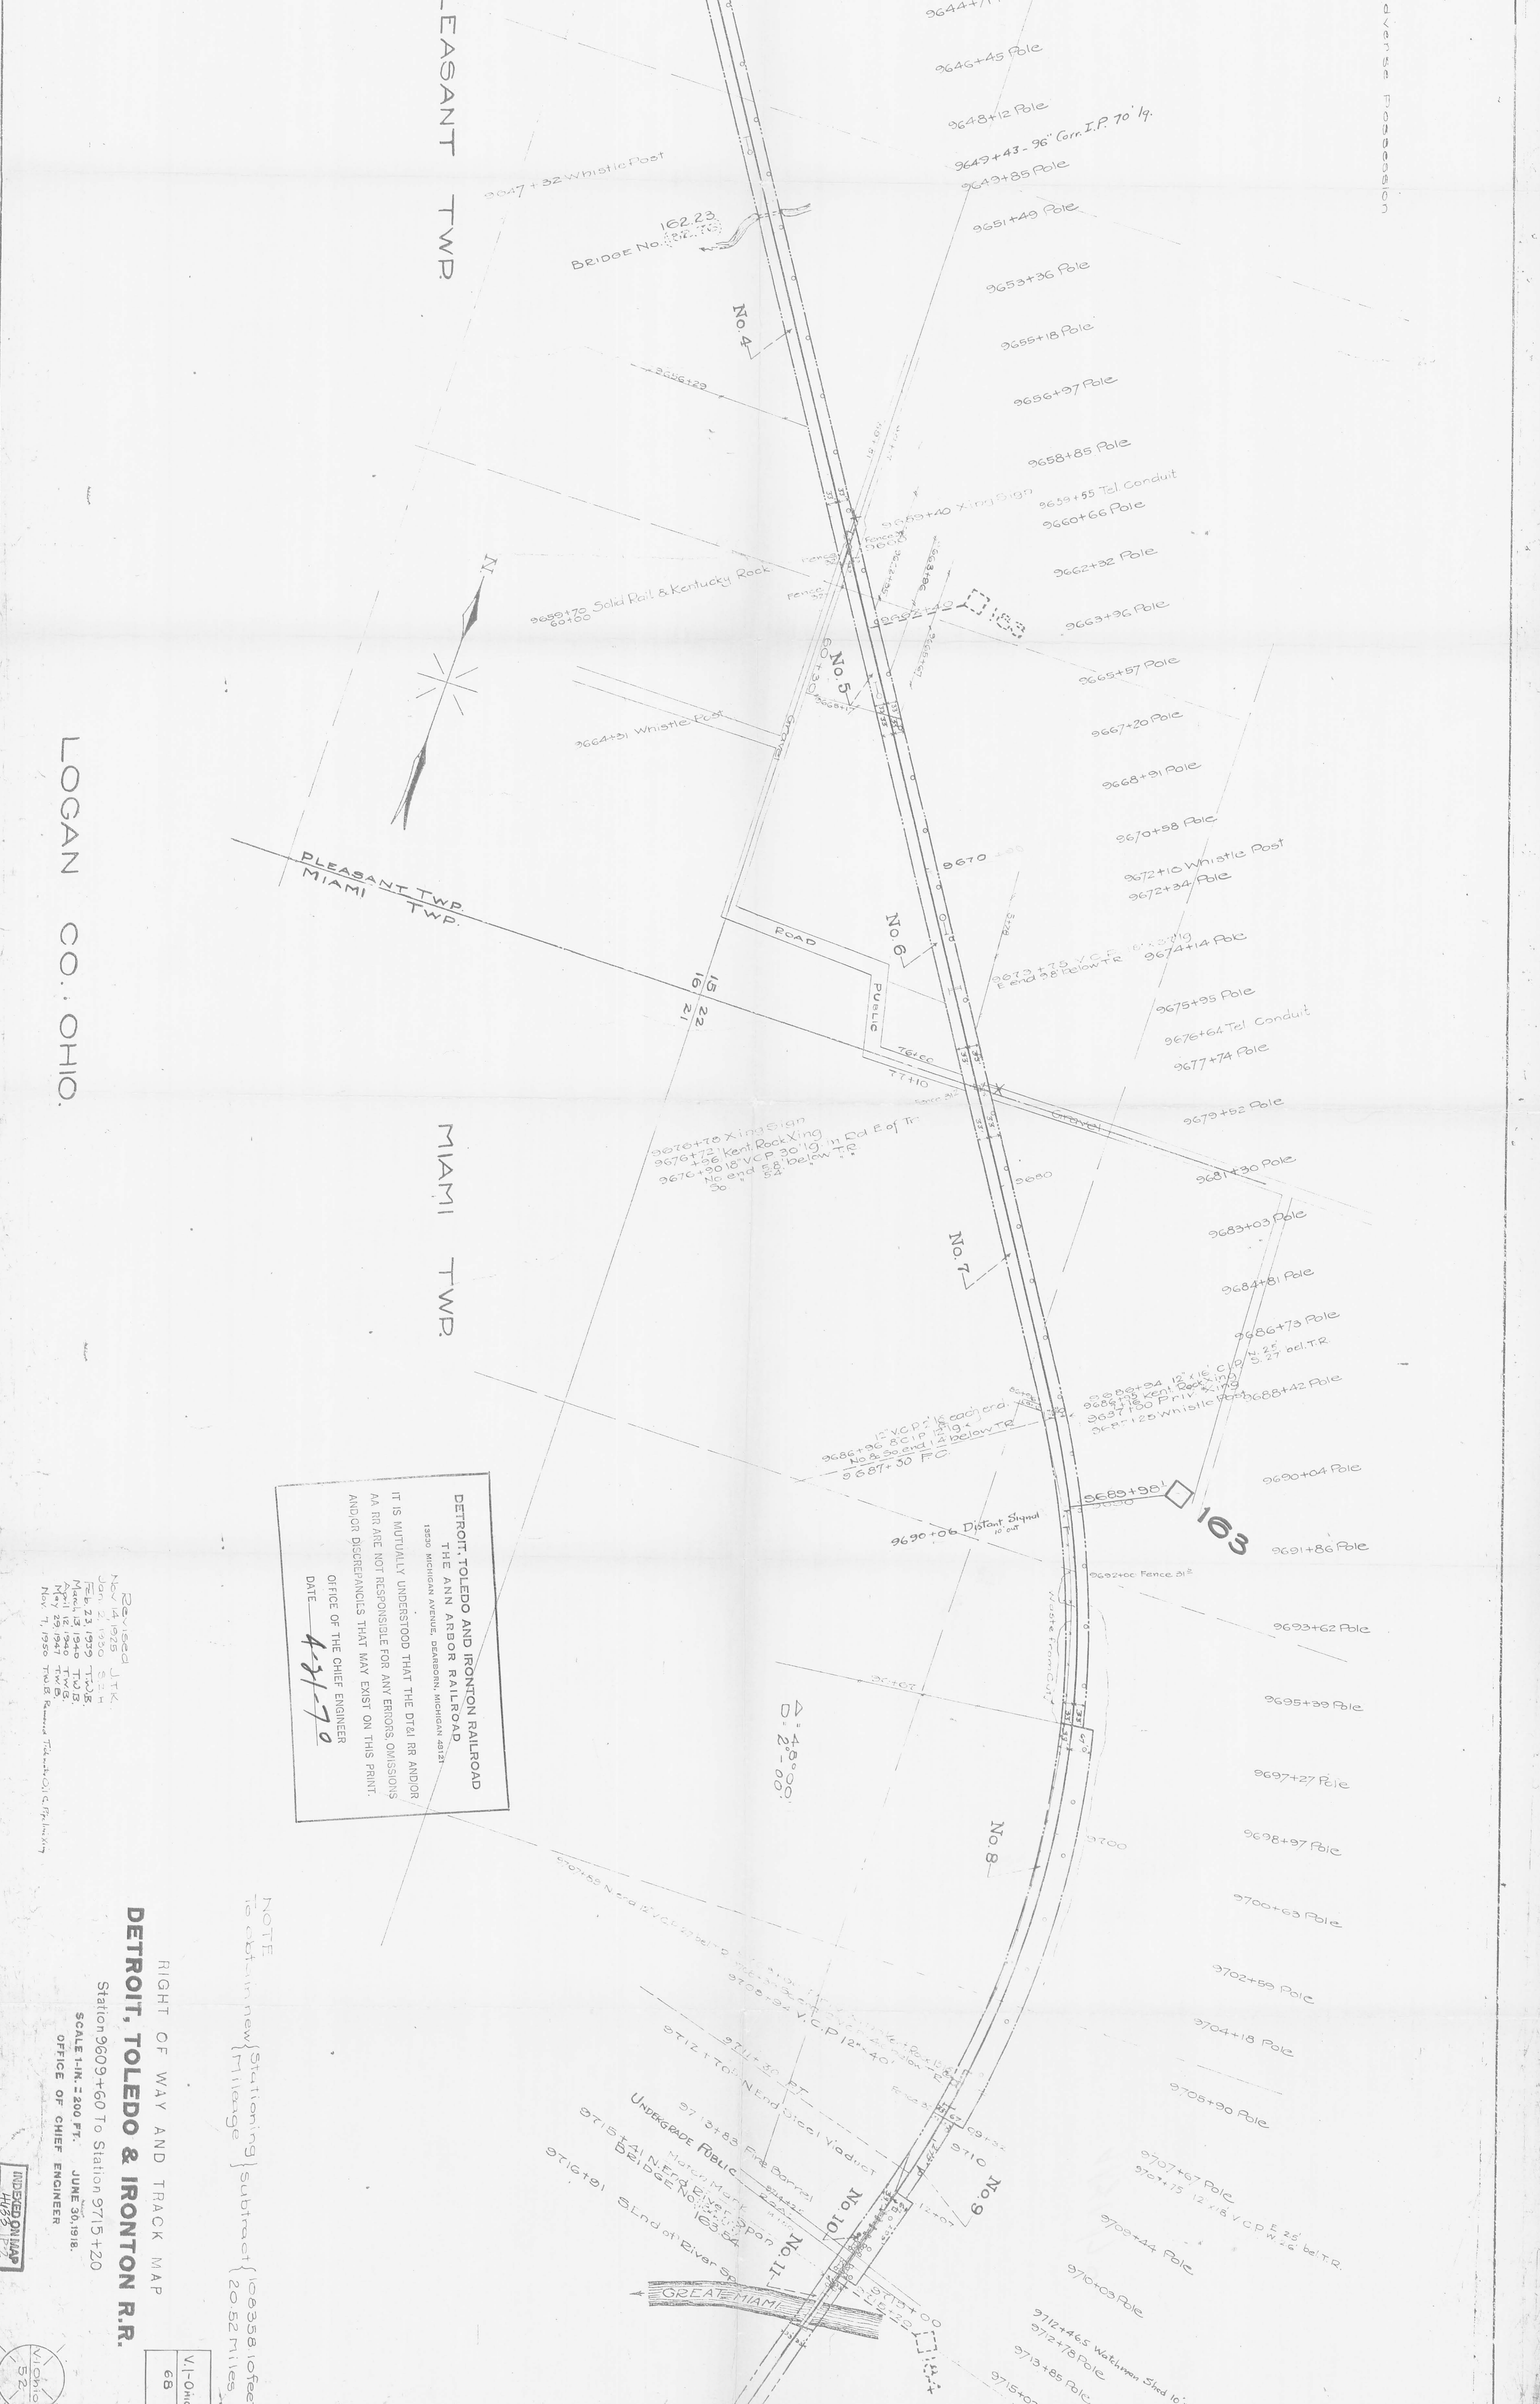


DETROIT TOLEDO AND IRONTON RAILROAD
 THE ANN ARBOR RAILROAD
 18300 Michigan Avenue, Dearborn, Michigan 48123
 IT IS MUTUALLY UNDERSTOOD THAT THE DT&I RR AND/OR
 AA RR ARE NOT RESPONSIBLE FOR ANY ERRORS, OMISSIONS
 AND/OR DISCREPANCIES THAT MAY EXIST ON THIS PRINT.
 OFFICE OF THE CHIEF ENGINEER
 DATE: **4-21-70**

NOTE
 from the stationing on this map.

RIGHT OF WAY AND TRACK MAP
DETROIT, TOLEDO & IRONTON R.R.
 Station 9609+60 To Station 9715+20
 OFFICE OF CHIEF ENGINEER

INDEXED MAP 68
 V.L. Ohio
 52

 

FENCE SCHEDULE
 Kind of Fence
 Height
 Material
 Post Length
 Spacing
 Gate
 Remarks

NOTE:
 Stationing subtract { 108358.10ft }
 To obtain new mileage { 2052.2 miles }

DETROIT TOLEDO AND IRONTON RAILROAD
 13200 MICHIGAN AVENUE, DETROIT, MICHIGAN 48221
 IT IS NATURALLY UNDERSTOOD THAT THE DT&I RR AND/OR
 AA RR ARE NOT RESPONSIBLE FOR ANY ERRORS, OMISSIONS
 AND/OR DISCREPANCIES THAT MAY EXIST ON THIS PRINT.
 OFFICE OF THE CHIEF ENGINEER
 DATE 4/31/70


LOGAN CO. OHIO
MIAMI TWP.

RIGHT OF WAY AND TRACK MAP
DETROIT, TOLEDO & IRONTON R.R.
 Station 9715+20 To Station 9820+00
 SCALE 1/4" = 250 FT. JUNE 30, 1970
 OFFICE OF CHIEF ENGINEER

DETROIT TOLEDO AND IRONTON RAILROAD
 13200 MICHIGAN AVENUE, DETROIT, MICHIGAN 48221
 IT IS NATURALLY UNDERSTOOD THAT THE DT&I RR AND/OR
 AA RR ARE NOT RESPONSIBLE FOR ANY ERRORS, OMISSIONS
 AND/OR DISCREPANCIES THAT MAY EXIST ON THIS PRINT.
 OFFICE OF THE CHIEF ENGINEER
 DATE 4/31/70

V.L.-Ohio
 69


 

LOGAN CO. OHIO.

CHAMPAIGN CO. OHIO.

MIAMI TWP.

ADAMS TWP.

DETROIT, TOLEDO AND IRONTON RAILROAD
THE ANN ARBOR RAILROAD
 1880 Michigan Avenue, Dearborn, Michigan 48121
 IT IS MUTUALLY UNDERSTOOD THAT THE DATA AND/OR
 PLAN ARE NOT RESPONSIBLE FOR ANY ERRORS, OMISSIONS,
 AND/OR DISCREPANCIES THAT MAY EXIST ON THIS PRINT.
 Office of the Chief Engineer
 DATE: 4/8/70

RIGHT OF WAY AND TRACK MAP
DETROIT, TOLEDO & IRONTON R.R.
 Stationing 9920+80 To Station 9926+40
 SCALE 1" = 200 FT. JUNE 30/1948
 OFFICE OF CHIEF ENGINEER

ML-Ohio
 70

