John Thomas Surv. Exi. Apr 1916
Monroe Twp. A fine day

STATION.	ALIGNMENT.	DEFLECTION.	REMARKS

Note. Take course of N. line Surv 10091 from NE ∠ = S 74¼ W
Find stone 4's of old fence on surv line E/10 N of and from
(1) Start at apparent cent road and on line old fence N. at NE
∠ Surv 10091 = a, S 24¾ E with public road
at 106 cross bridge over small Branch Course
" 15.68 center of road running SE & NW from due east = 3
which by measure is the SE ∠ W.A. Liles land as per his deed
(2) Start 2.0 N of stone in W line Thomas & at cor Thomas & 10 S of cent
road on hillside on top hill & 6.0 ft. east of big W line Thomas old
Thence N 75¼ E with public road & line Grimes land
at 415½ cent T ∠ to Thomas & SE ∠ Benj Grimes = A
" 721. N. Oak 30" di at NE ∠ Surv 4479 = e
(3) Random at T at 10 R of 415½ of (2) = d
Thence N 13¾ W. at 396 pass in T ∠ at prin fence cor SW ∠ ch. W
fall 11 E of T at 396. dist N. E and E course N 13¾ W
W. ∠ of T. ; S W ∠ stone for a Bap Ch. N 220. The SW ∠ of church is
15 N. & 12½ E. (parallel to E. side of church) from ∠ of ∠ Thomas & E ∠ church
(4) Start at T 396 of 3. N 13¾ E. at 82.5 cent T with fence passing
& SE ∠ Church lot. W. to SE ∠ stone for church N 84½ W 42.2
(5) Start at T 82.5 of (4) Thence with E line Church lot
N 5½ E. at 216 Cement corner corner lot at ∠ prin
fence SE ∠ cemetery lot = N. in W. line Thomas
at 264 cent T SW ∠ W.A. Liles & NW ∠ John Thomas
in E line Cemetery lot = i
(6) Start at T 264 of (5) Thence with W line John Thomas
N 8 3¼ E. at 200 cent public road at cent road
at 1950 cent branch on road to E mill
" 2100 Leave pub road at 2277 cent T. 3 S of N bridge
" 2296 strike line (1) at 1459. being 3 S of NE ∠ Thomas

S. Stationers, St. Louis, Mo.

TOPOGRAPHY.

INDEXED ON MAP (29)

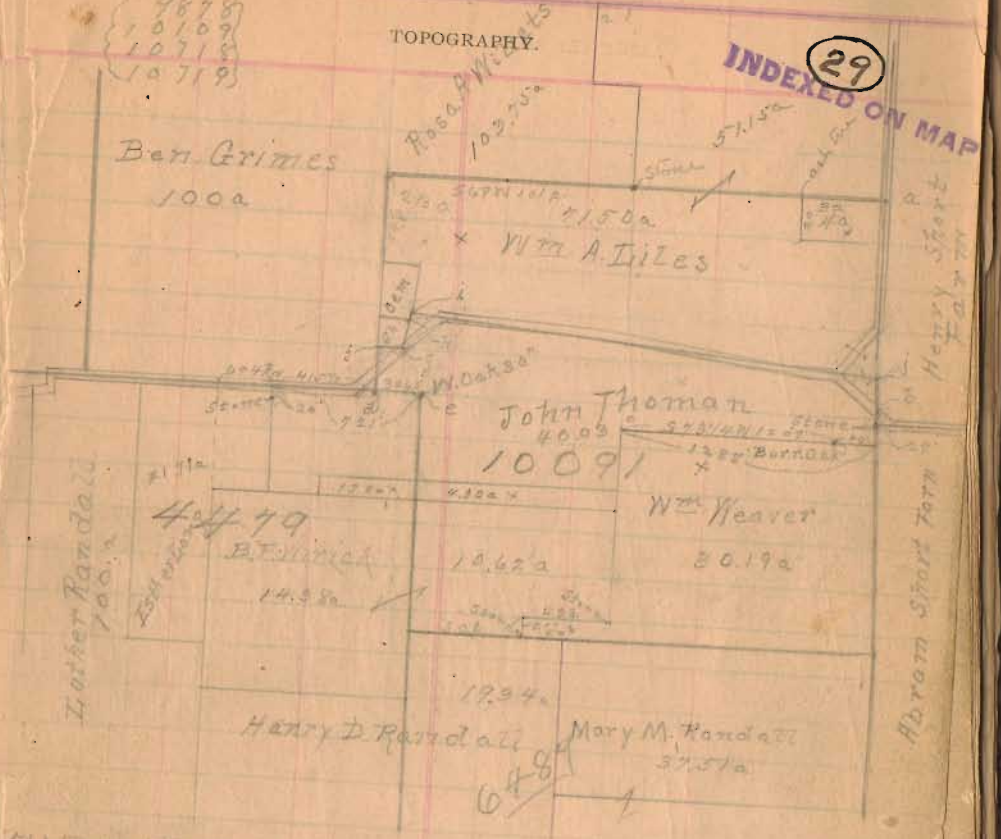

7) Start at T 2277 of (6) and 3' S of N line Thomas & 19' W. of E line John Thomas N 7-S 25¾ E 459 to
Thence S 25 E. at 492. pass 25 E of stone S W ∠ Henry
Short farm & NW ∠ Adam Short
at 459 S line John Thomas & 25 W of his SE ∠.
8) Start at line S W ∠ Henry Short. S 25¾ E 27' to SE ∠ Thomas
and N 73½ E 20' from T at 459 of 7
Start at T 23 of (8) & SE ∠ John Thomas in E line Surv 10091
& NW ∠ W.m Weaver 30.19a Thence N 73½ W. 1288 to W
at 79 small Sen Oak old line tree and corner Thomas
" 1288 strike R = N 6' from ∠ post on line NW ∠ W Weaver
preservation at SW ∠ Thomas in Mon
E 604 13