May-8-1924
cloudy

Wright
Smocker.

Piatt Survey (Monroe Twp.) Survey # 4492

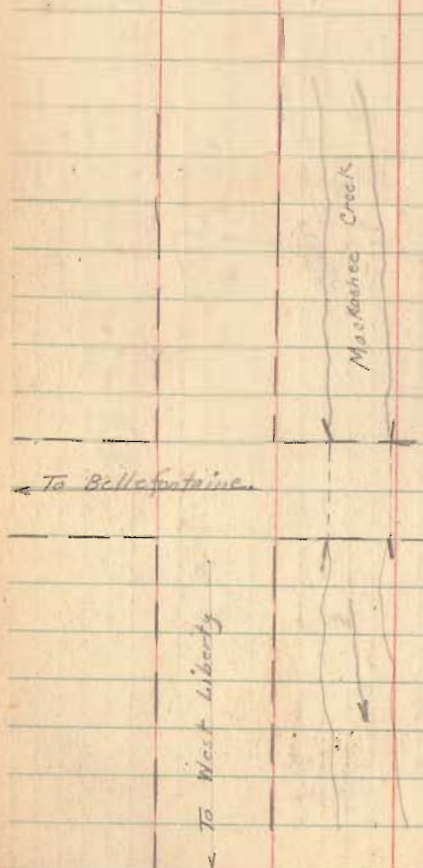

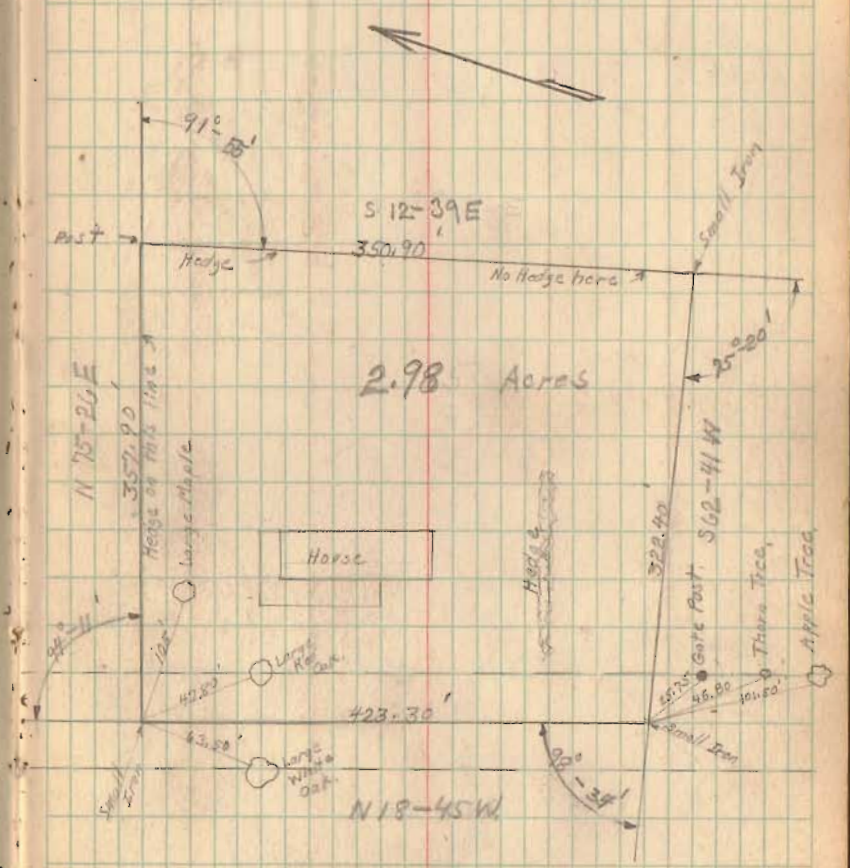

81

INDEXED ON MAP