











MONROE TWP

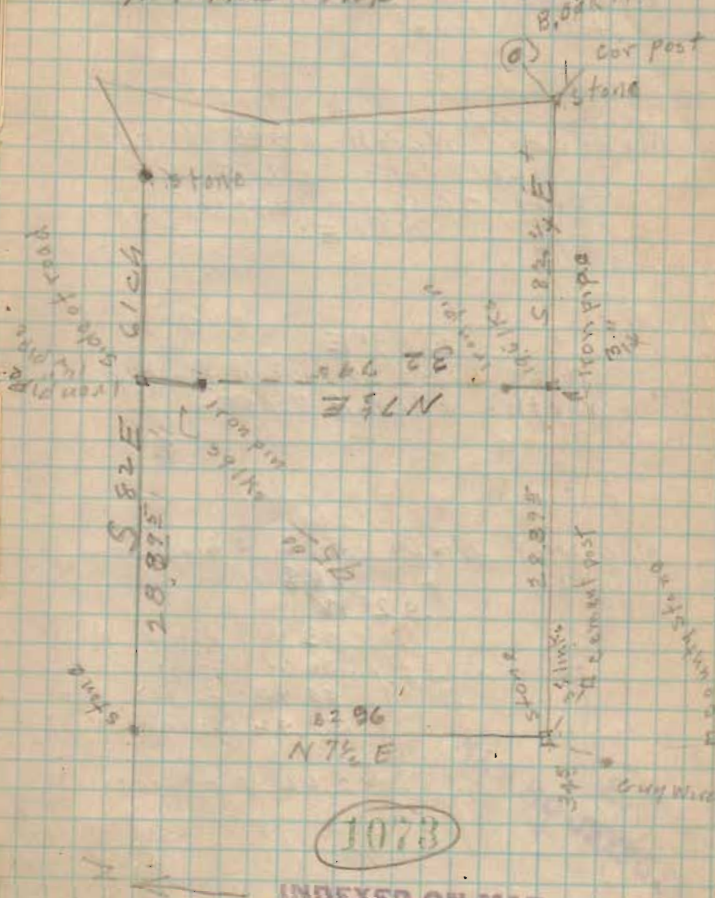


INDEXED ON MAP