8/13/38 C.A. Inskeep
M. Jones
8/15/38 R. J. Kinnard
G. Wilgus

Road 28 Monroe Twp.
at Line between VMS 3223
and VMS 3226
at Road 163

Random line from store
corner to Surveys 3223, 3224,
3225, 3226 – walnut stump SW. 7.5'
original witness tree. Needle N 79E

0+00	stake	"C"
17+71.9	hub	east edge corn field
26+19.2	hub	W side road 28
30+64.4	hub	N. side road 163
41+08	hub	S side road 163
47+00	hub	
51+66.4	hub	
53+76.5	hub	

53°-25 130-33 10-35-50
53°-39 130-04 10-41-25
53°-37 129-28 10-42-05
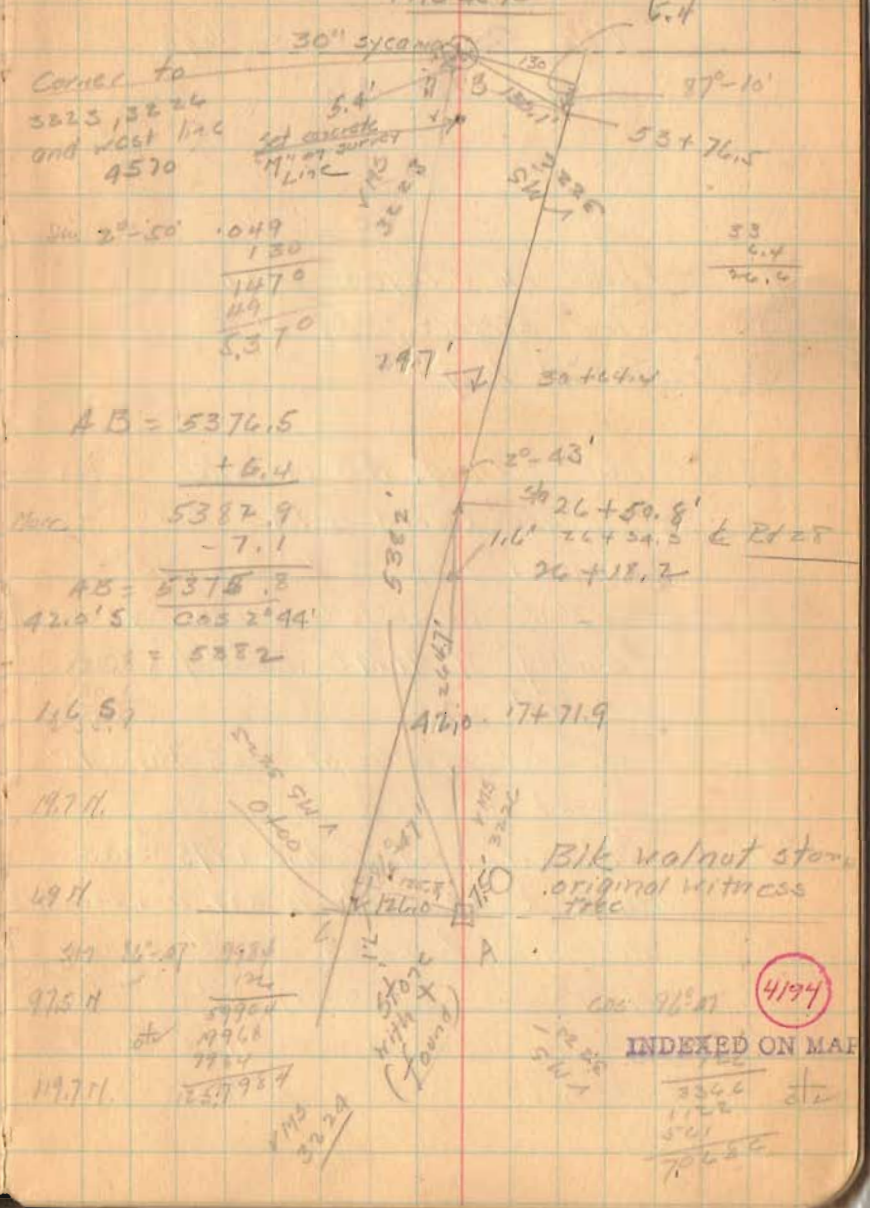
Mamie Prall
VMS 4570