


17 D^o. No. 1 Feb. 8th 1824

Survey 8:98

17

(8116) Surveyed for Benjn. Schuler, beginning at the South west corner of the S.W. qr. of sec. 31 Town. 3 Range 11 (C. W.) a white oak 26 inches in diam. $145^{\circ} 6$ 10 links dist. thence east 160 poles to a stake in the prairie at the centre of said sec. thence west 160 poles to a white oak 30 inches in diam. $170^{\circ} 6$ 10 links dist. thence west 160 poles to a bot. oak 12 inches in diam. $1849^{\circ} 8$ 16 links dist; thence with the west line of said sec. 70 poles to the beginning containing 70 acres, the south side of the S.W. qr. of said section

William Blairs
for Schuler { 66

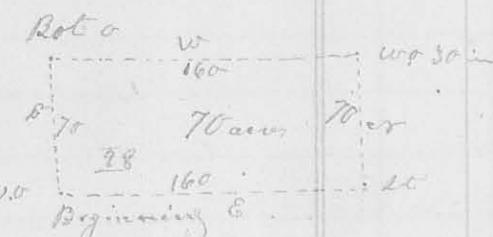

J. McNamee
Surveyor of L.C.

(8118)

11th M^o. 10th 1824

✓ Survey No. 29.

Surveyed and divided 132 acres for Edmund & David charmed beginning at a poplar and lynn the South east corner to Thomas Thwaits Lumber r^e 11661 on the water of Mill River thence $\approx 165^{\circ} 6$ W (one fourth of a degree westerly variation from the original line crossing a small branch a 64 poles, one at 166 poles) 164 poles to an ash and sugar tree (here I mark a hickory) thence $\approx 15^{\circ} E$ (crossing a branch at 12 poles, one at 64 poles) 115 poles to a sugar tree & elm thence $\approx 75^{\circ} E$ (a degree westerly variation from the original line) crossing a branch at 71 poles, one at 88 poles 162 poles to a sugar tree and hickory, thence $\approx 15^{\circ} W$

140 poles to the beginning containing 132 acres in the S.E. corner of said Thwaits said

Survey — The partition line begins at a lynn branch & sugar tree in the South line of this survey

71.7 poles from from the South east corner; thence $\approx 15^{\circ} E$ crossing a branch at 20 poles 106 poles to 2 branches & small sugar tree in the north line, dividing the survey into 2 equal parts of 66 acres William & Christopher Smith 66 J. McNamee S.C.

