Young Survey

Pleasant Twp

Sec. 16-10 T 2-14

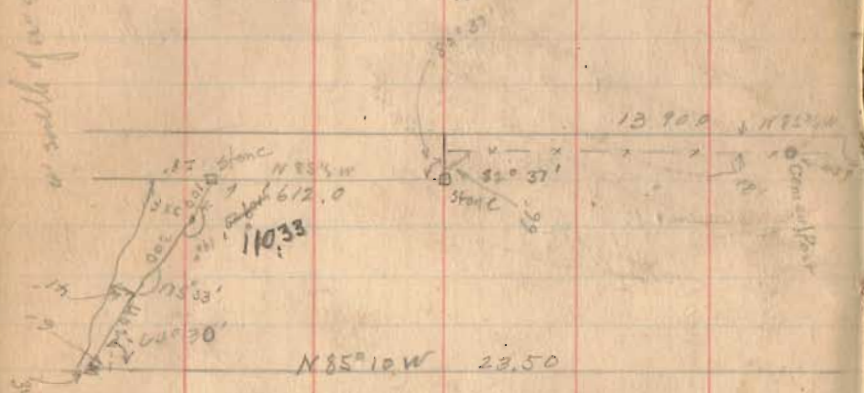

707
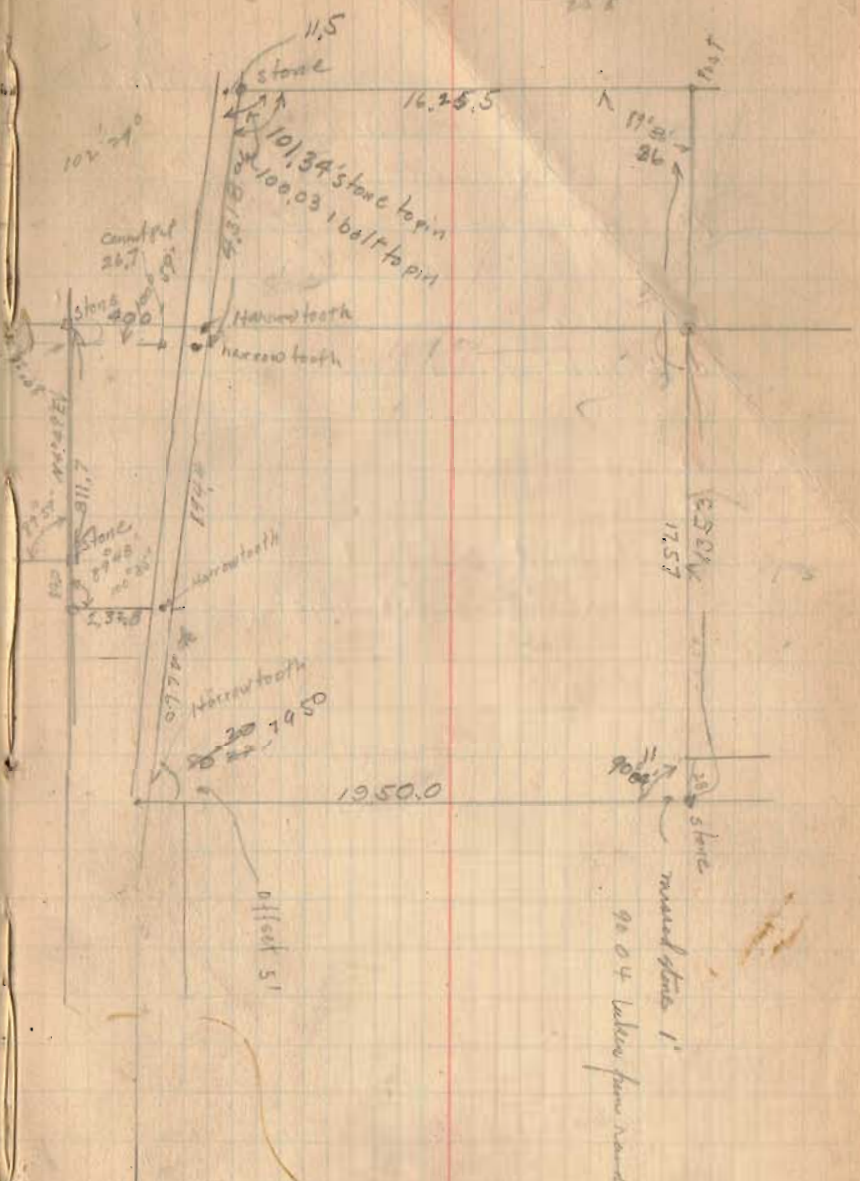
INDEXED ON MAP